


**APPROACH SLAB PLAN**

SCALE 1 : 50

~~\*INSTALL BENCH MARK DISC FLUSH WITH TOP OF PAVEMENT AND 150 CLEAR FROM EDGES OF APPROACH SLAB. TYPICAL ALL FOUR OUTSIDE CORNERS OF APPROACH SLABS AS SHOWN. VAQT SHALL SUPPLY DISCS. COST FOR INSTALLATION SHALL BE INCIDENTAL TO ITEM 501.34, "CONCRETE, HIGH PERFORMANCE CLASS B".~~

~~\*THIS WORK ELIMINATED.~~

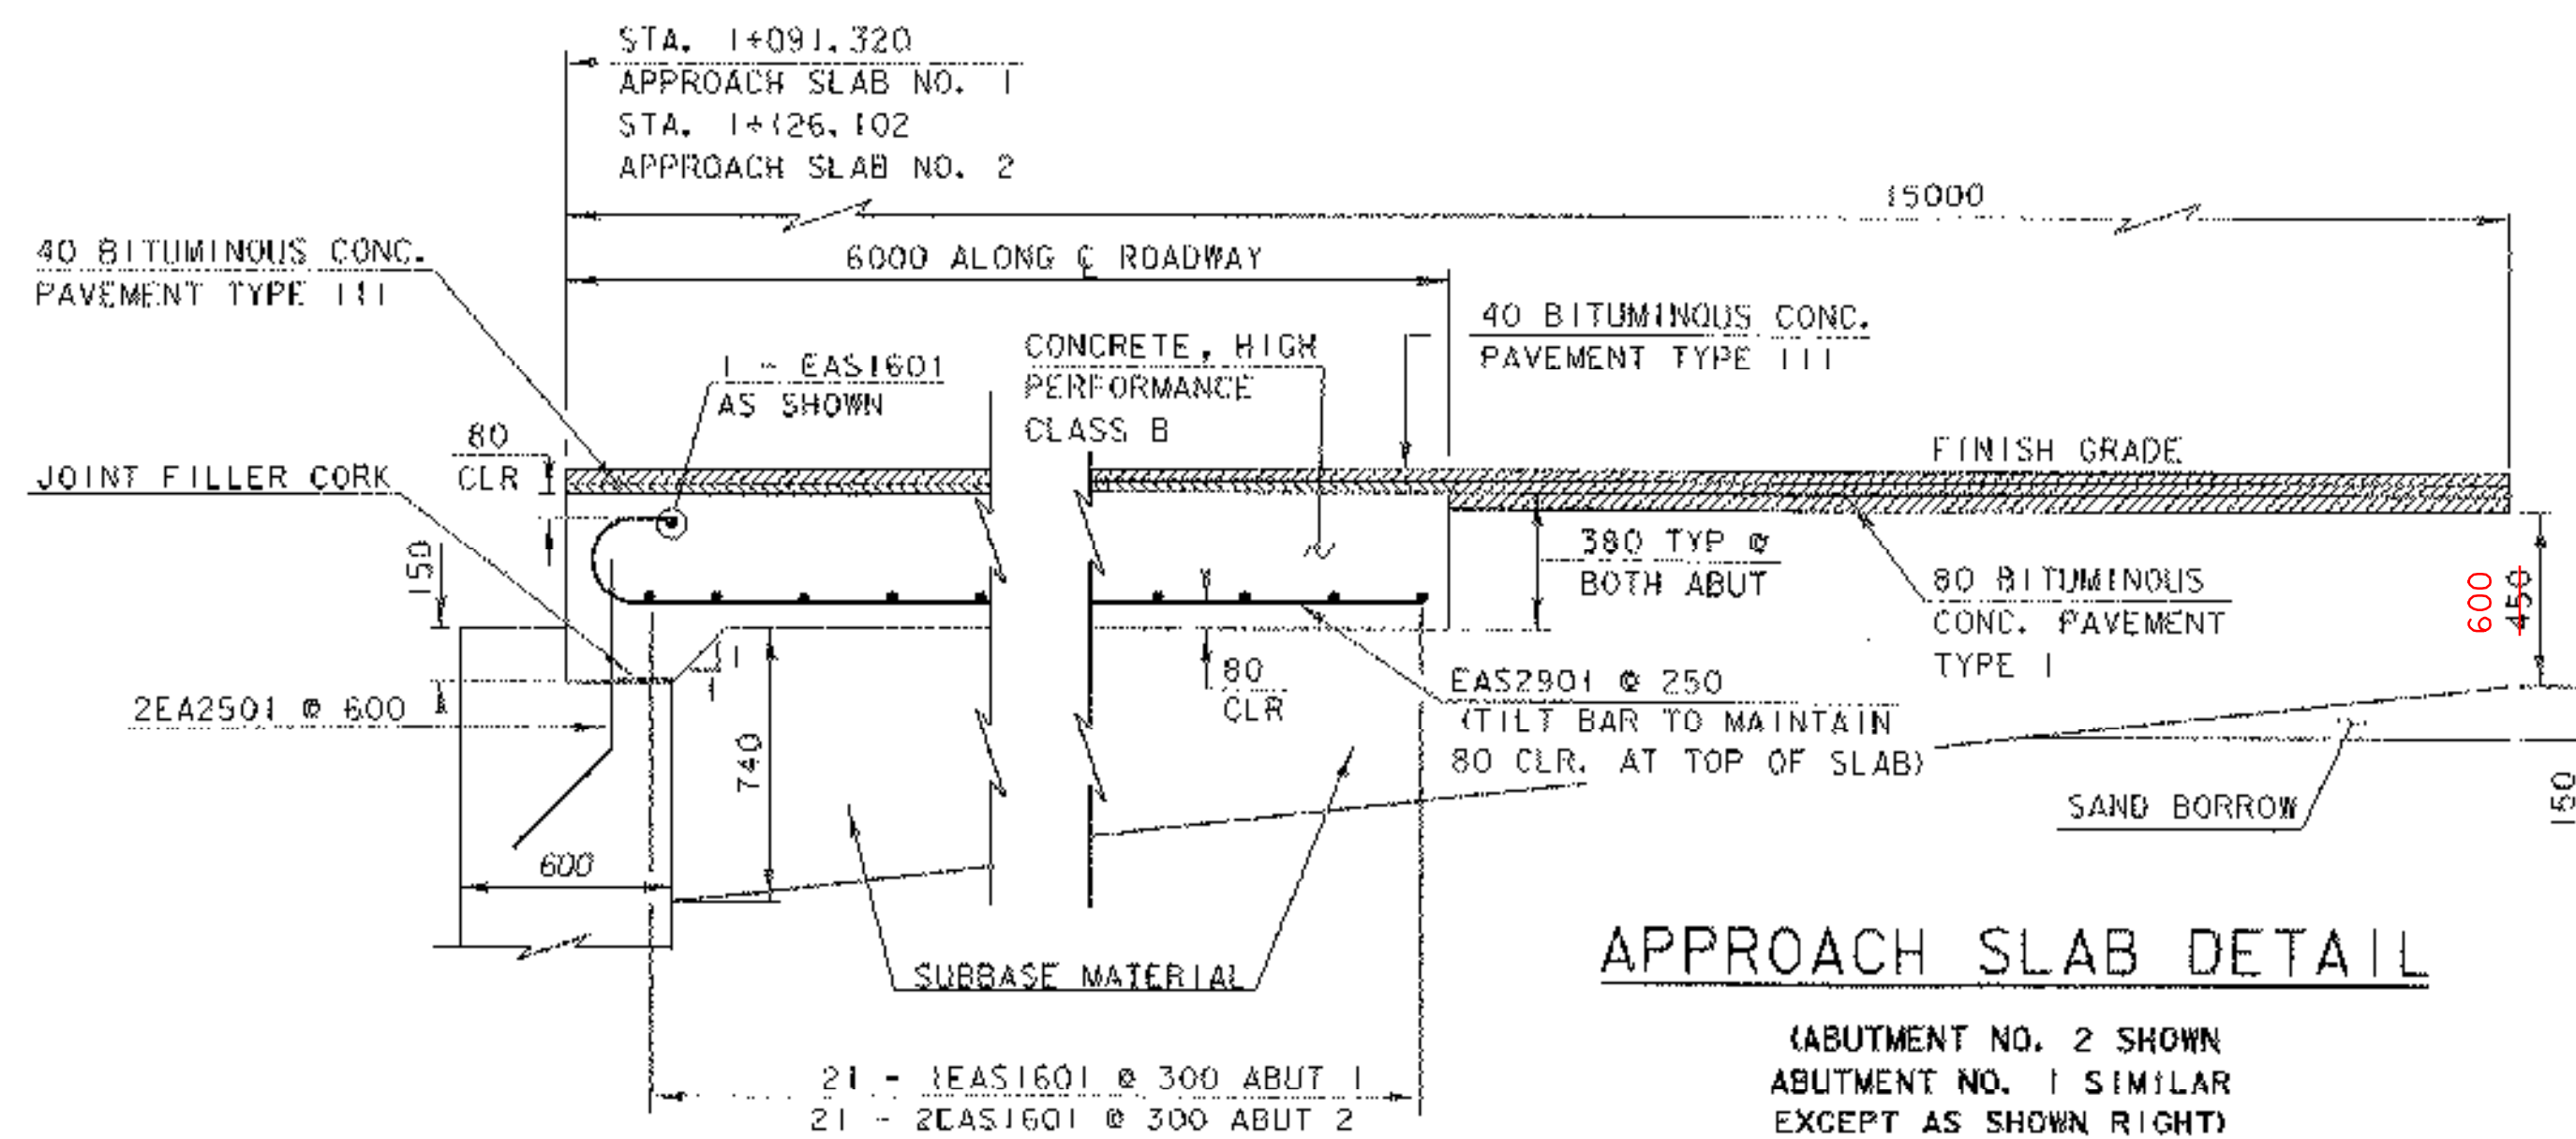


**APPROACH SLAB DETAIL**

(ABUTMENT NO. 2 SHOWN  
ABUTMENT NO. 1 SIMILAR  
EXCEPT AS SHOWN RIGHT)

SCALE 1 : 20

\*SEE SHEET 75 OF 90  
FOR PROPER SUBBASE  
DETAIL AT ABUTMENTS

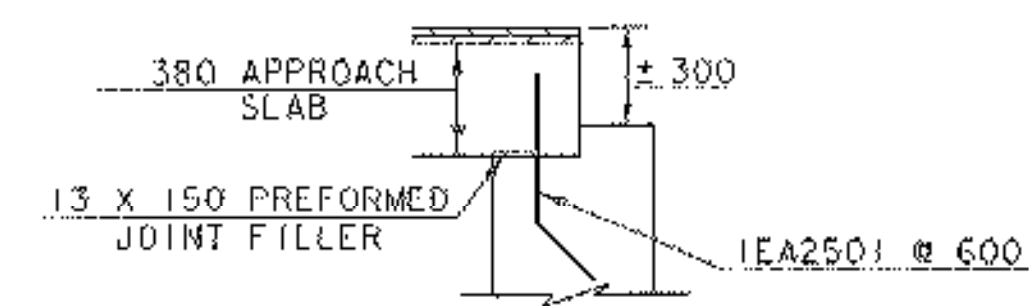

**ABUTMENT NO. 1 DETAIL**

NOT TO SCALE

SHEET NAME: <b>APPROACH SLAB DETAILS</b>	
PROJECT NAME: <b>LEICESTER</b>	HIGHWAY NO.: <b>TH 1</b>
PROJECT NUMBER: <b>BRF 0160(3)S</b>	BRIDGE NO.: <b>6</b>
	OVER: <b>OTTER CREEK</b>
FILE NAME: 95J288\Structures\sJ288sup.dgn	PLOT DATE: <b>17-AUG-2005</b>
PROJECT MANAGER: <b>R. R. WHITCOMB</b>	DRAWN BY: <b>T. FILLBACH</b>
DESIGNED BY: <b>C. CARLSON</b>	(PARM NAME: sJ288asd.i
BRIDGE SHEET NUMBER:	SHEET <b>55</b> OF <b>90</b>