
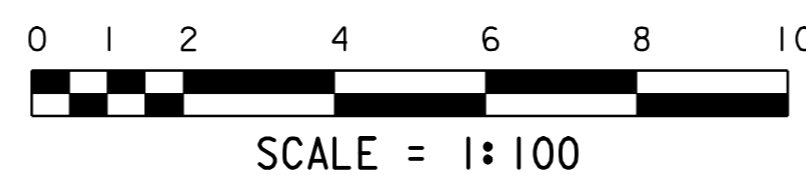
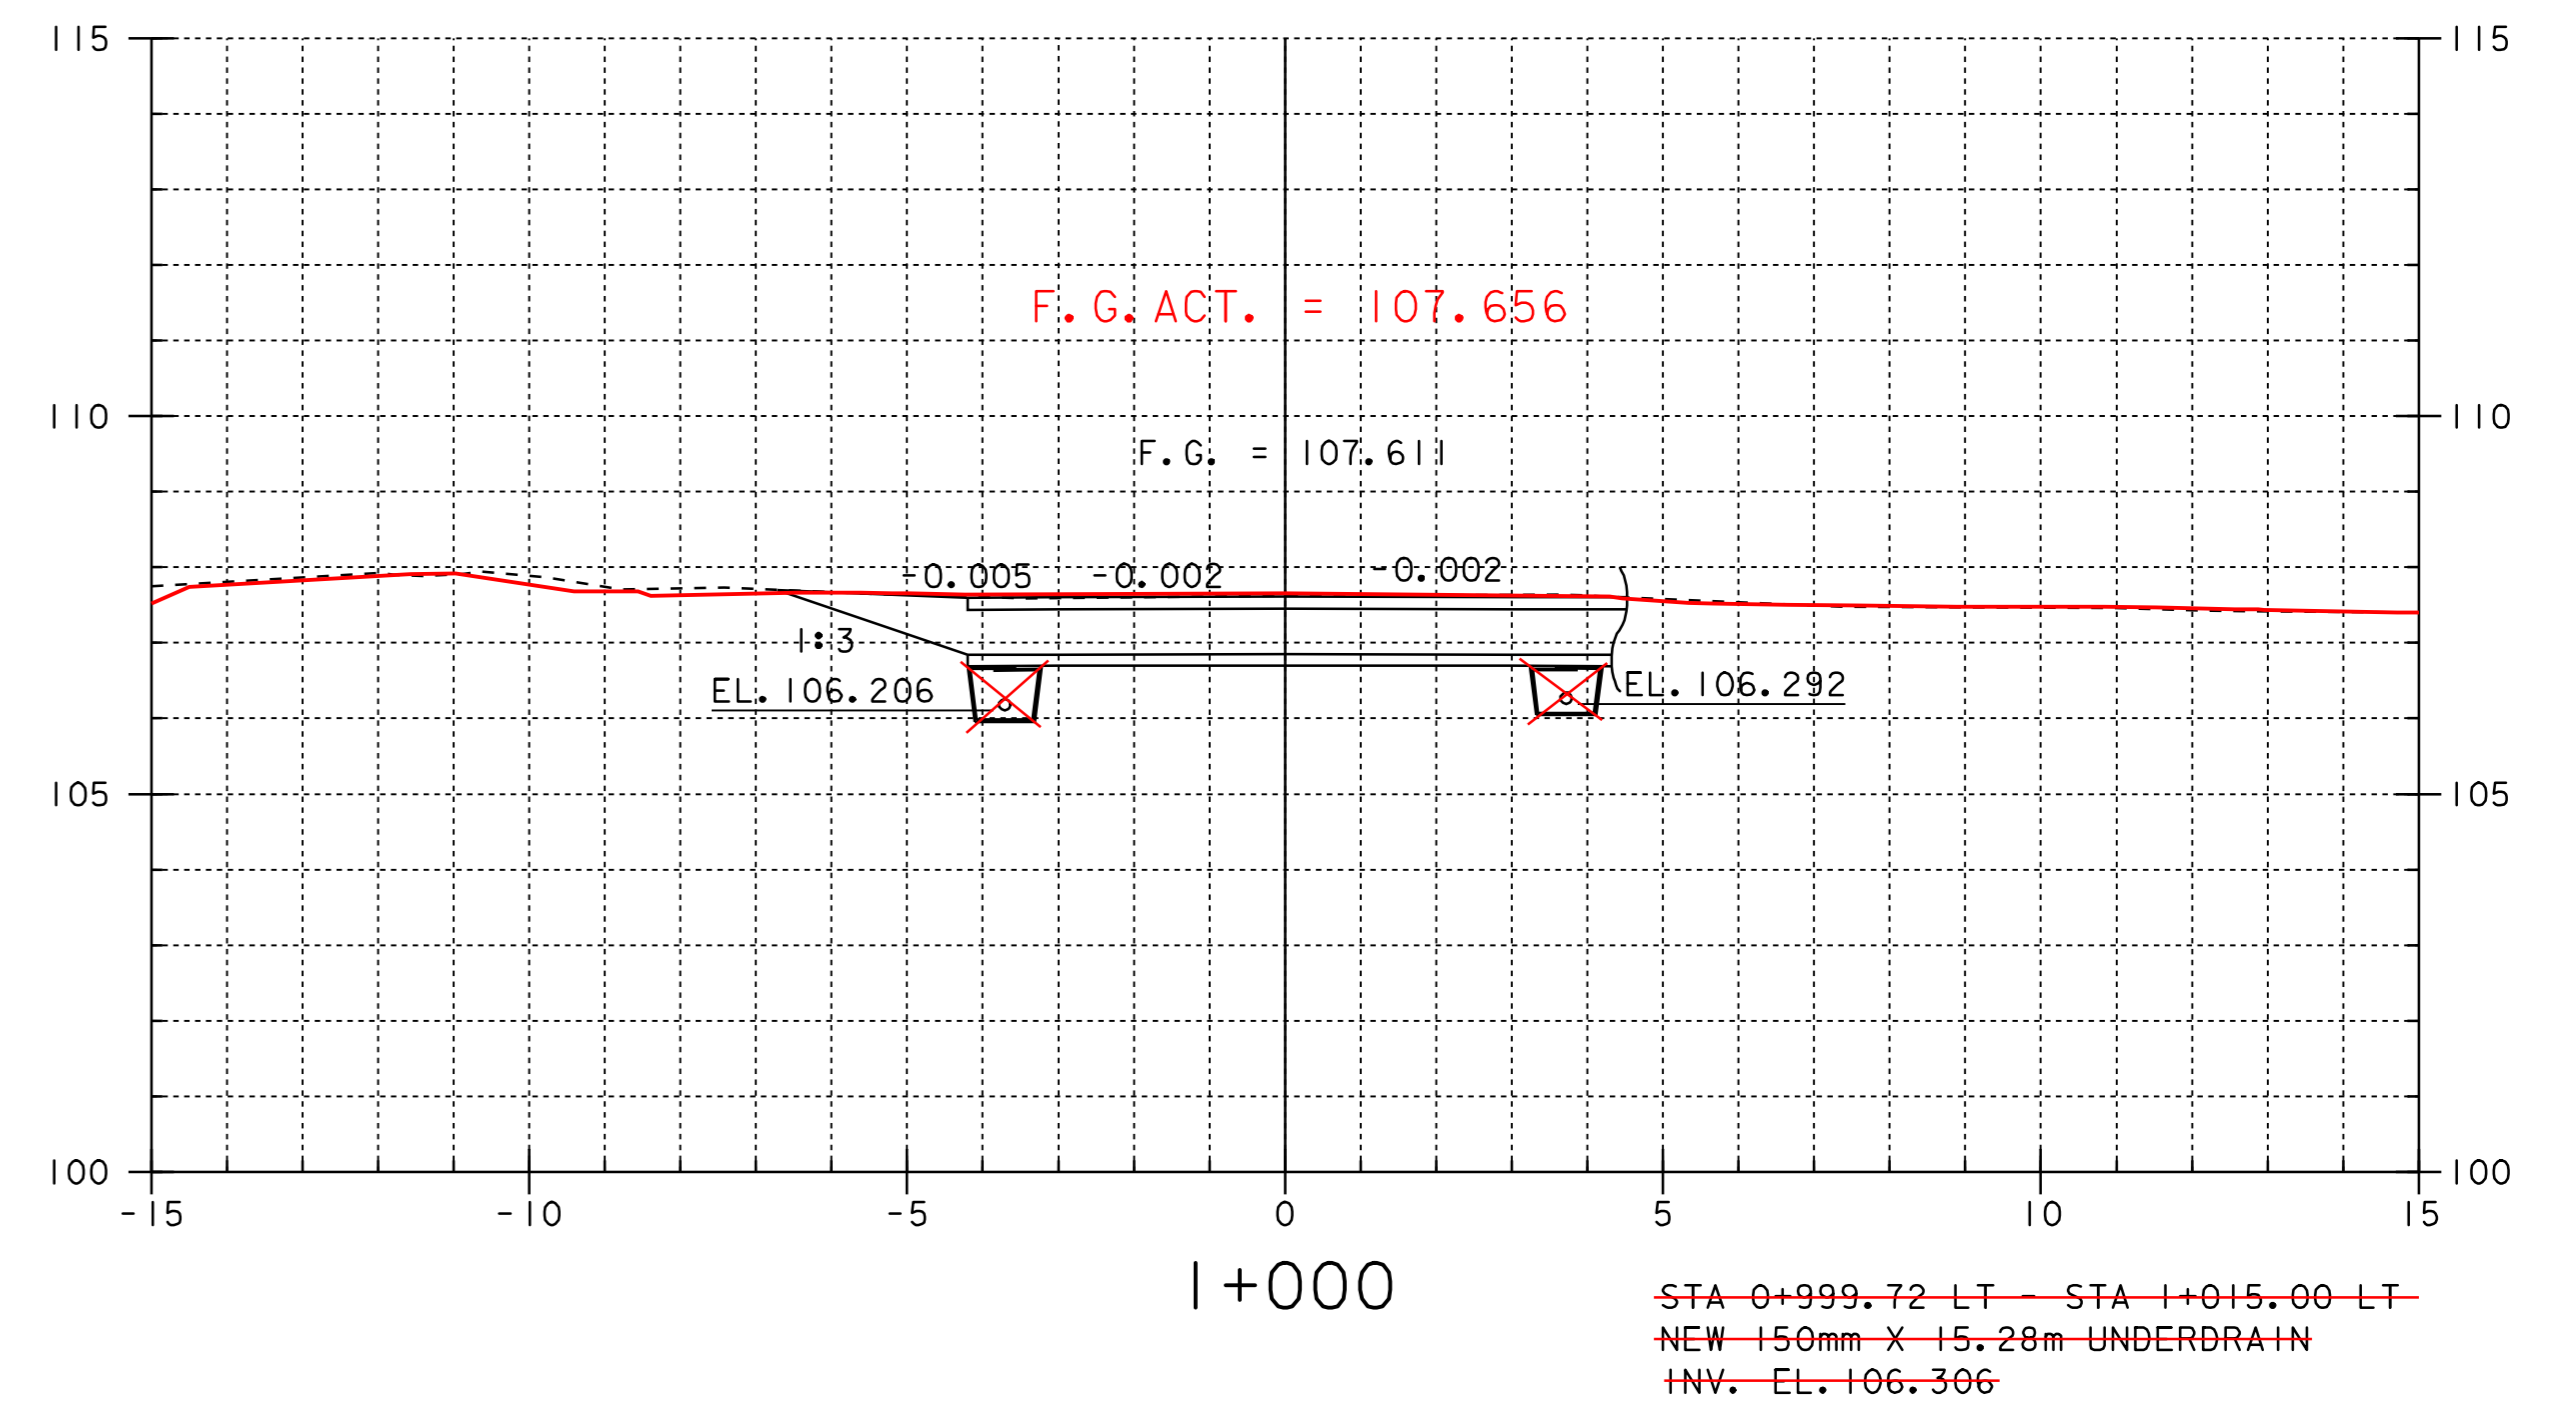
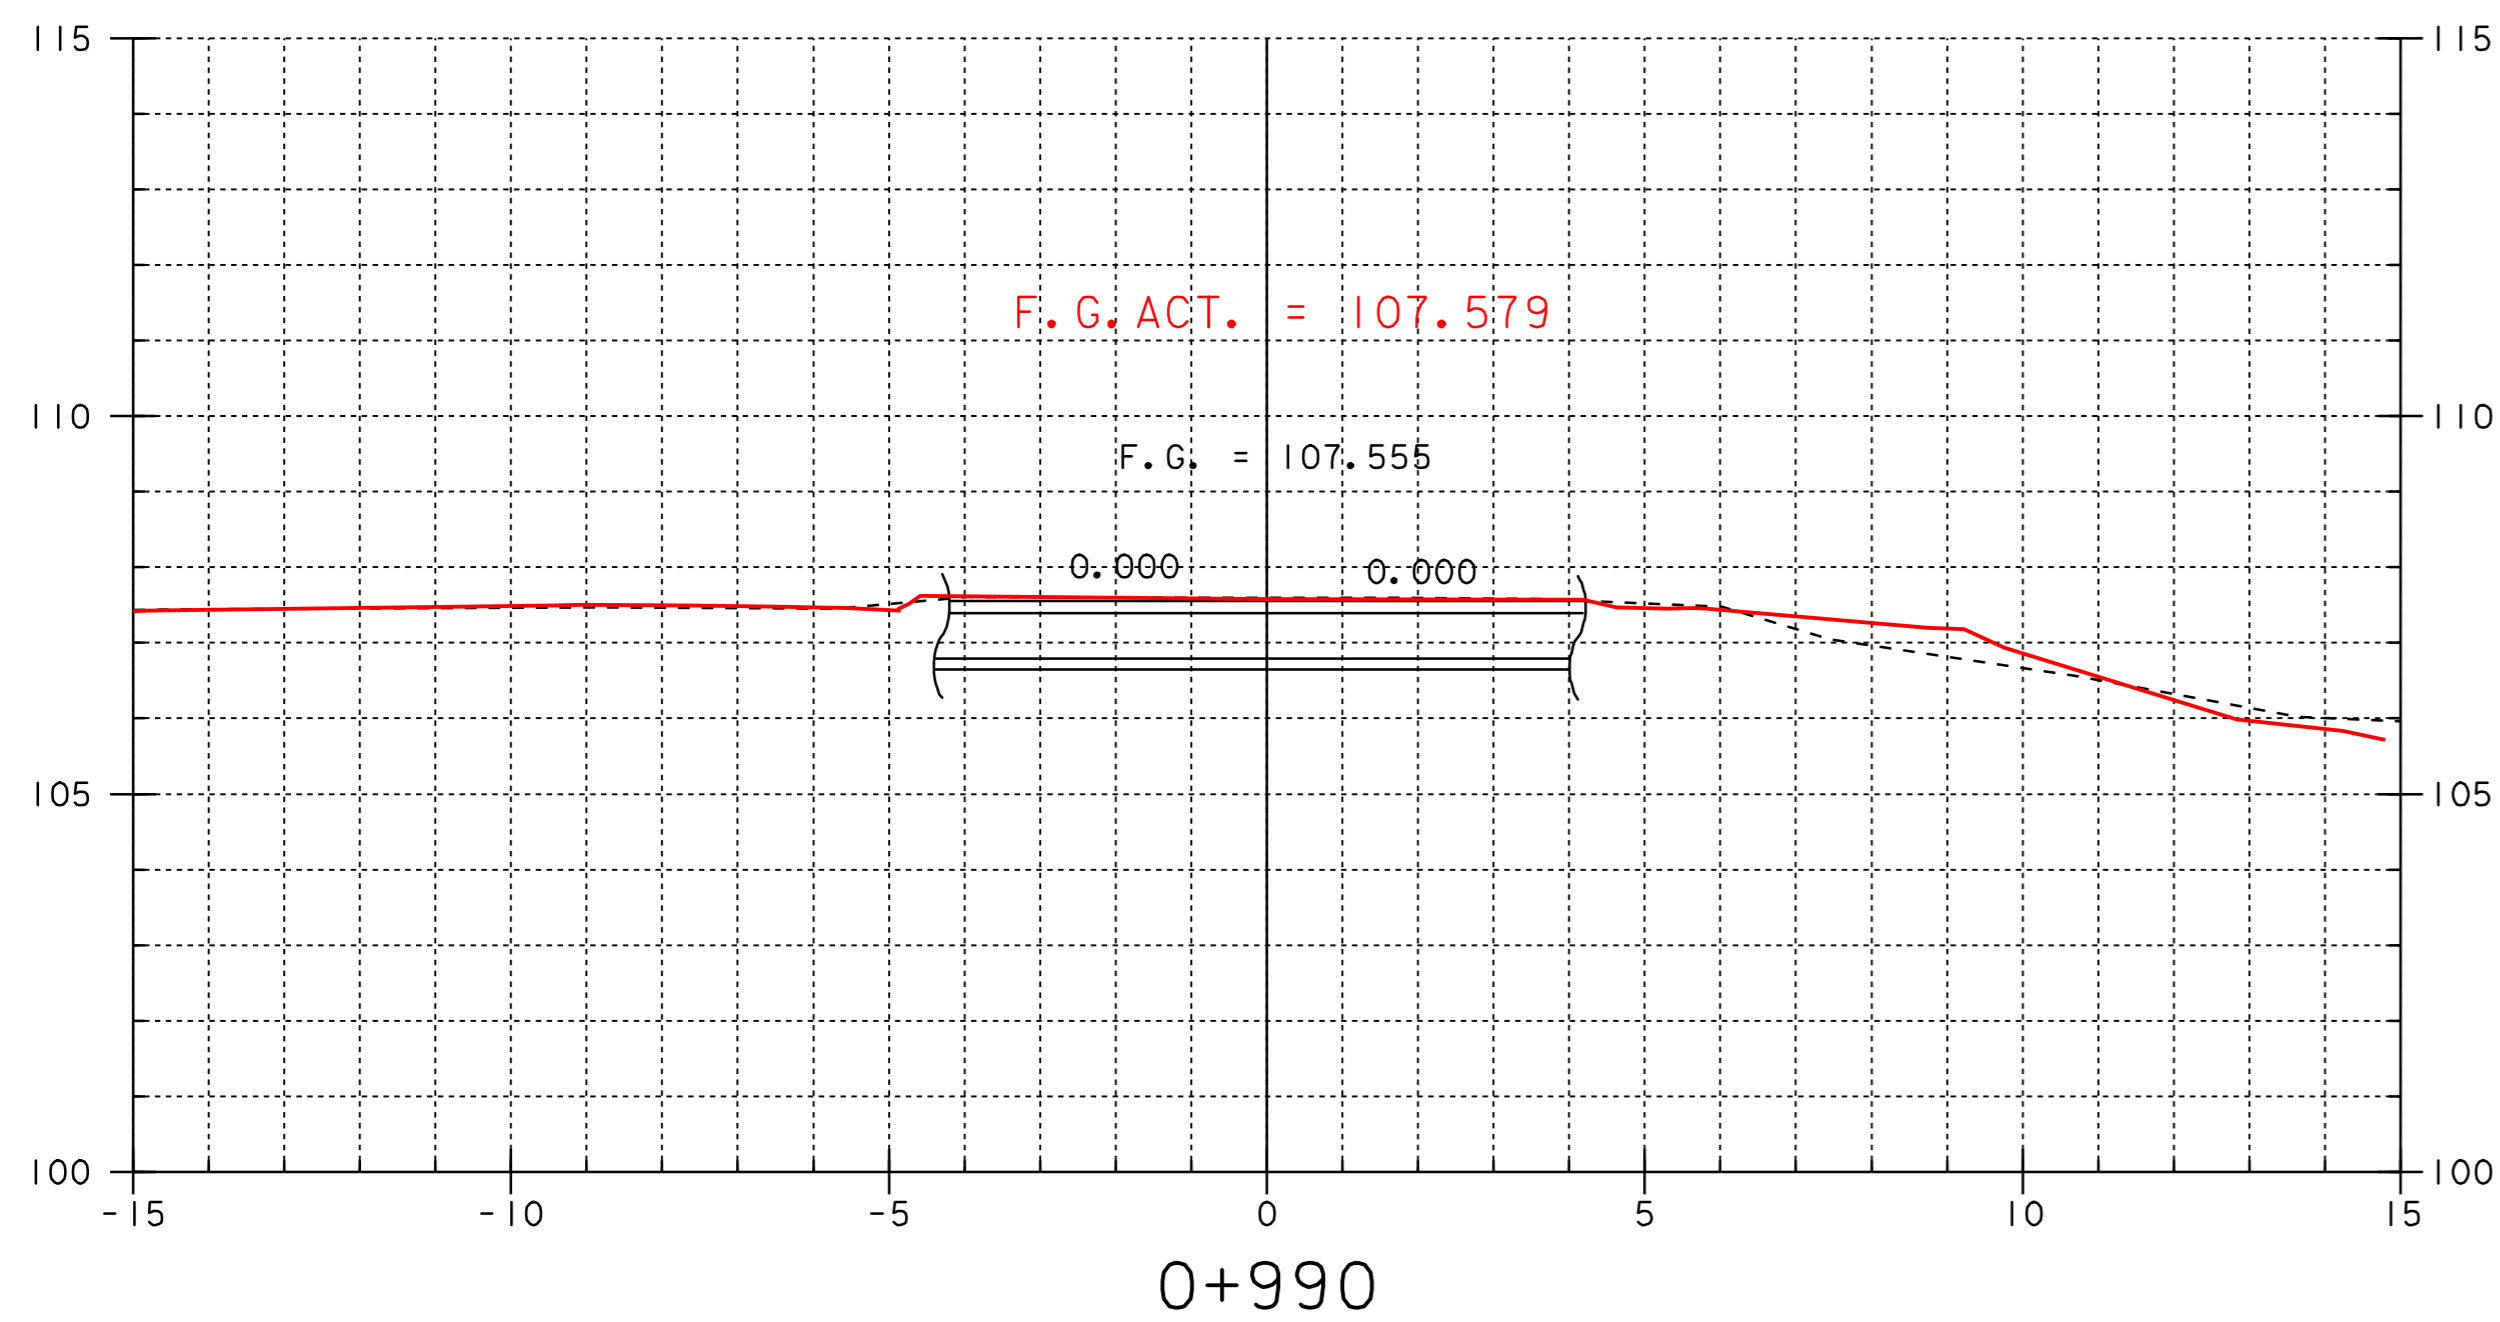
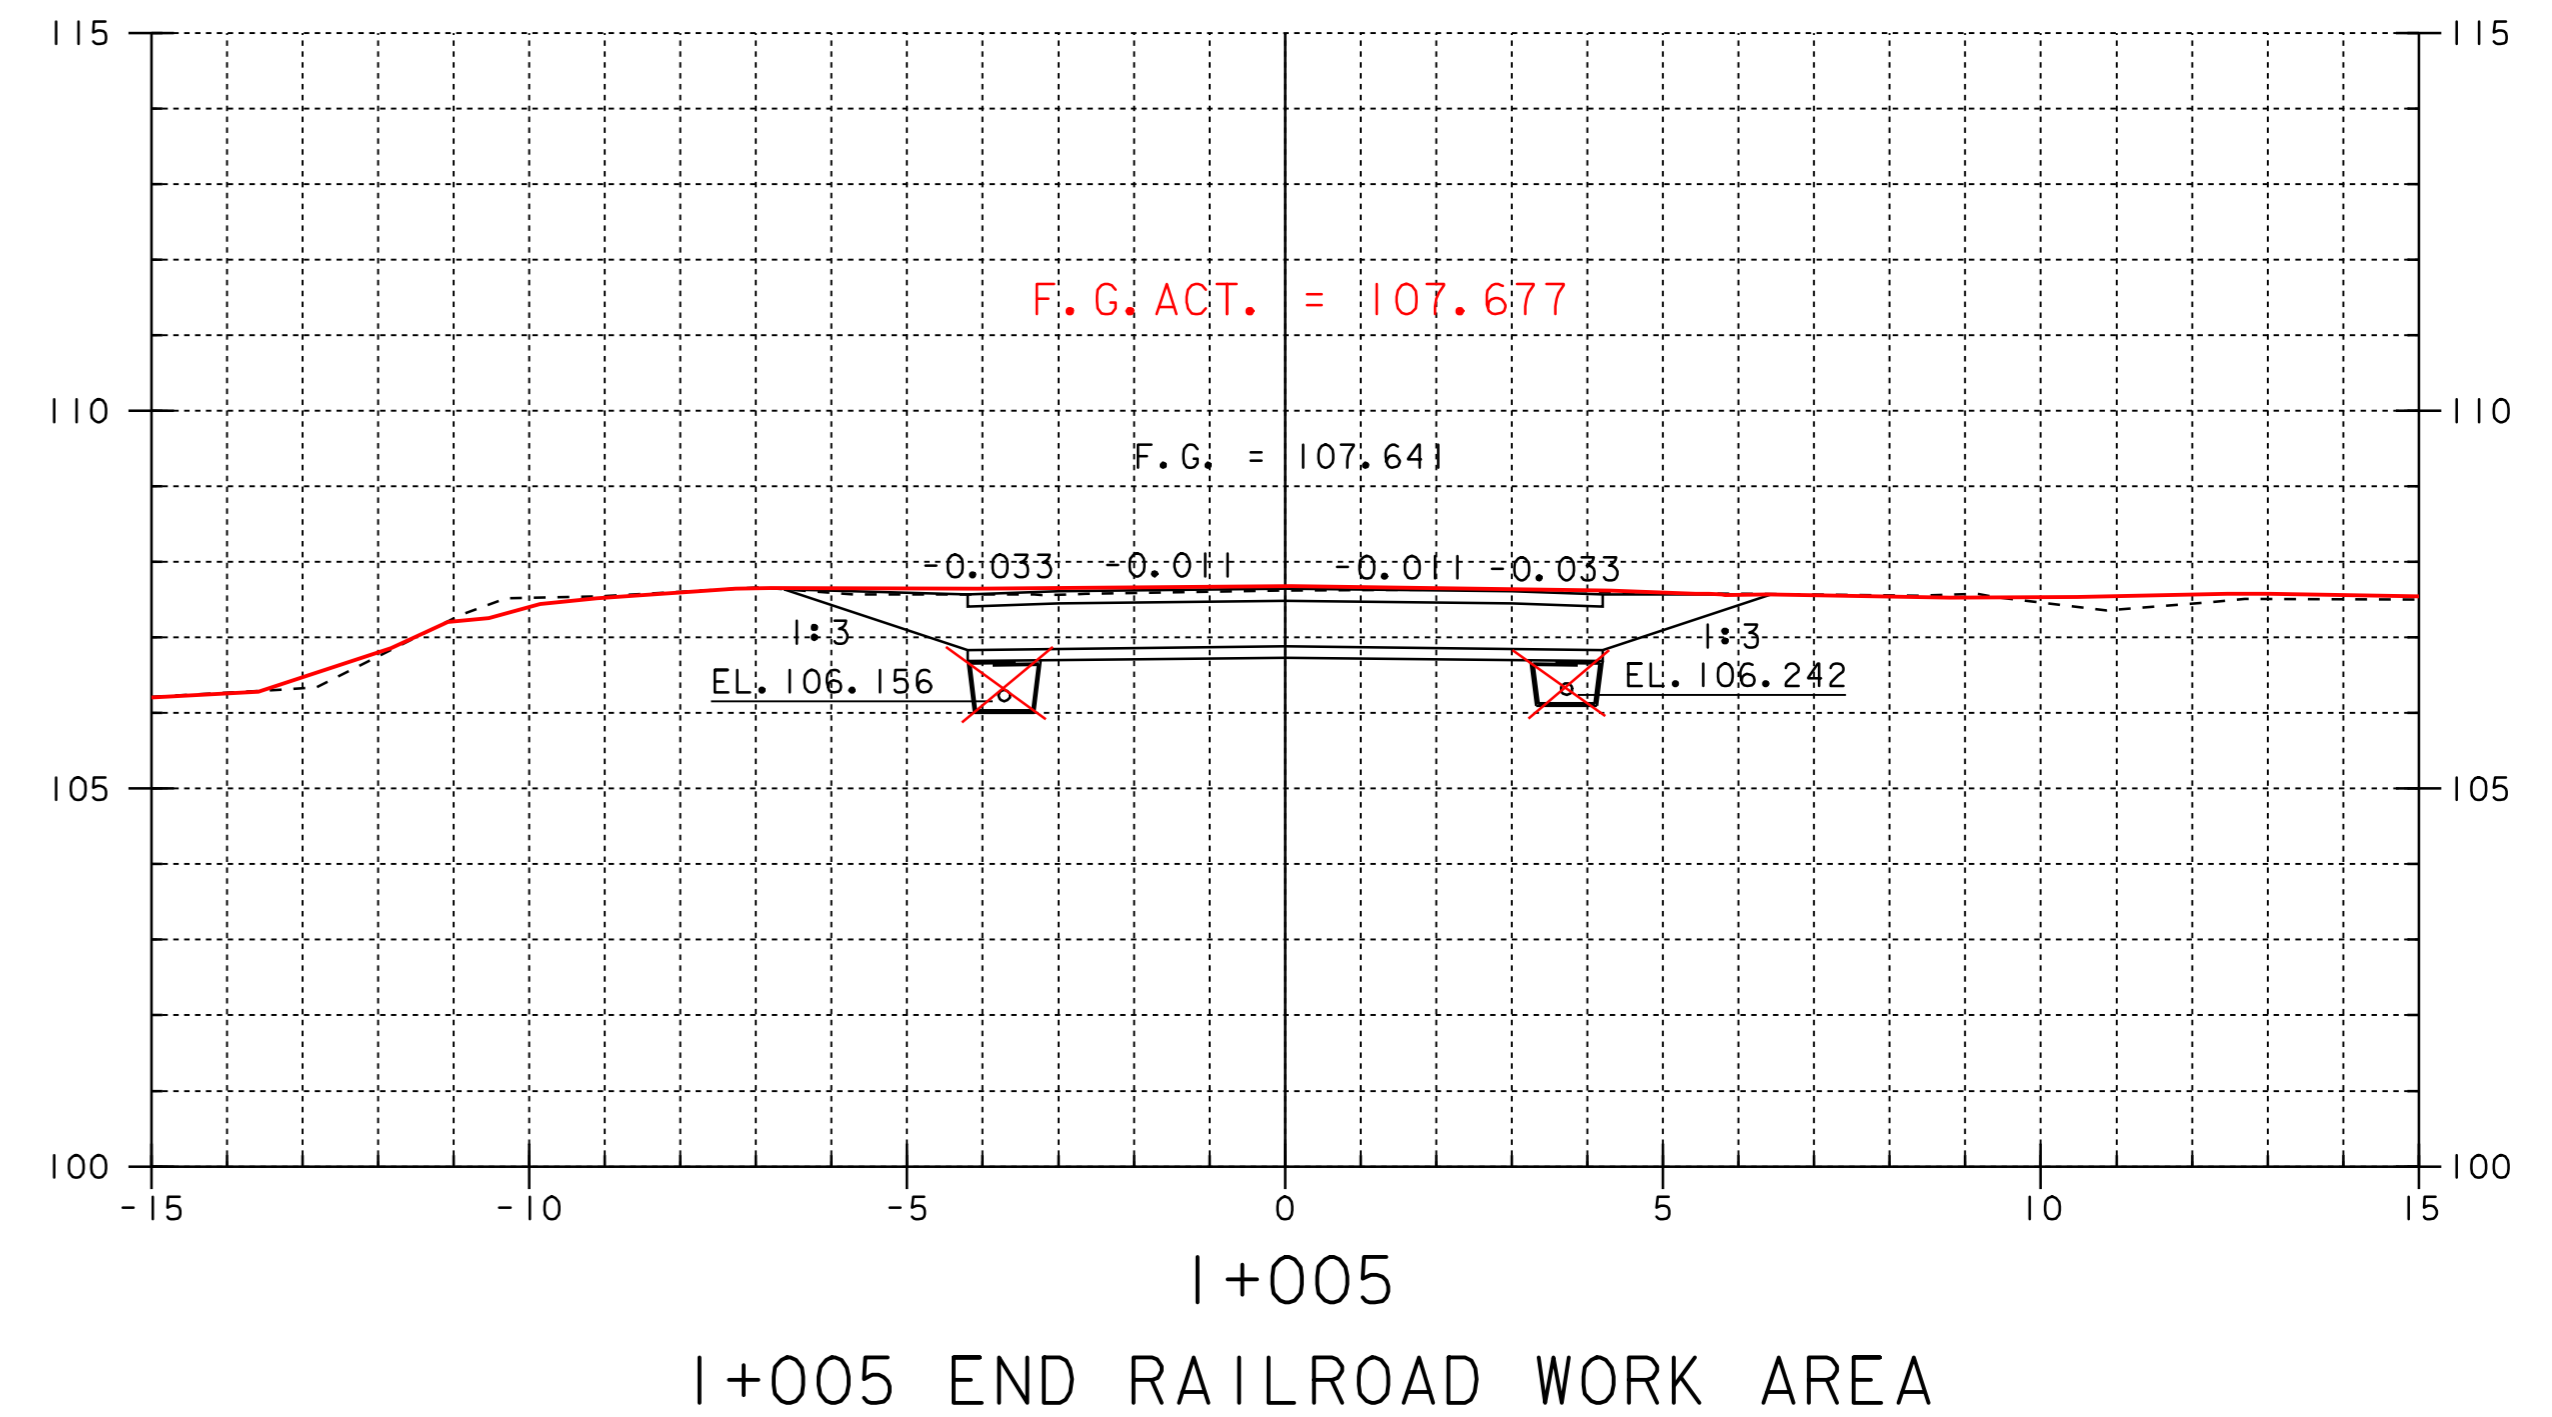


UNDERDRAIN TYPICAL SECTION
NOT TO SCALE

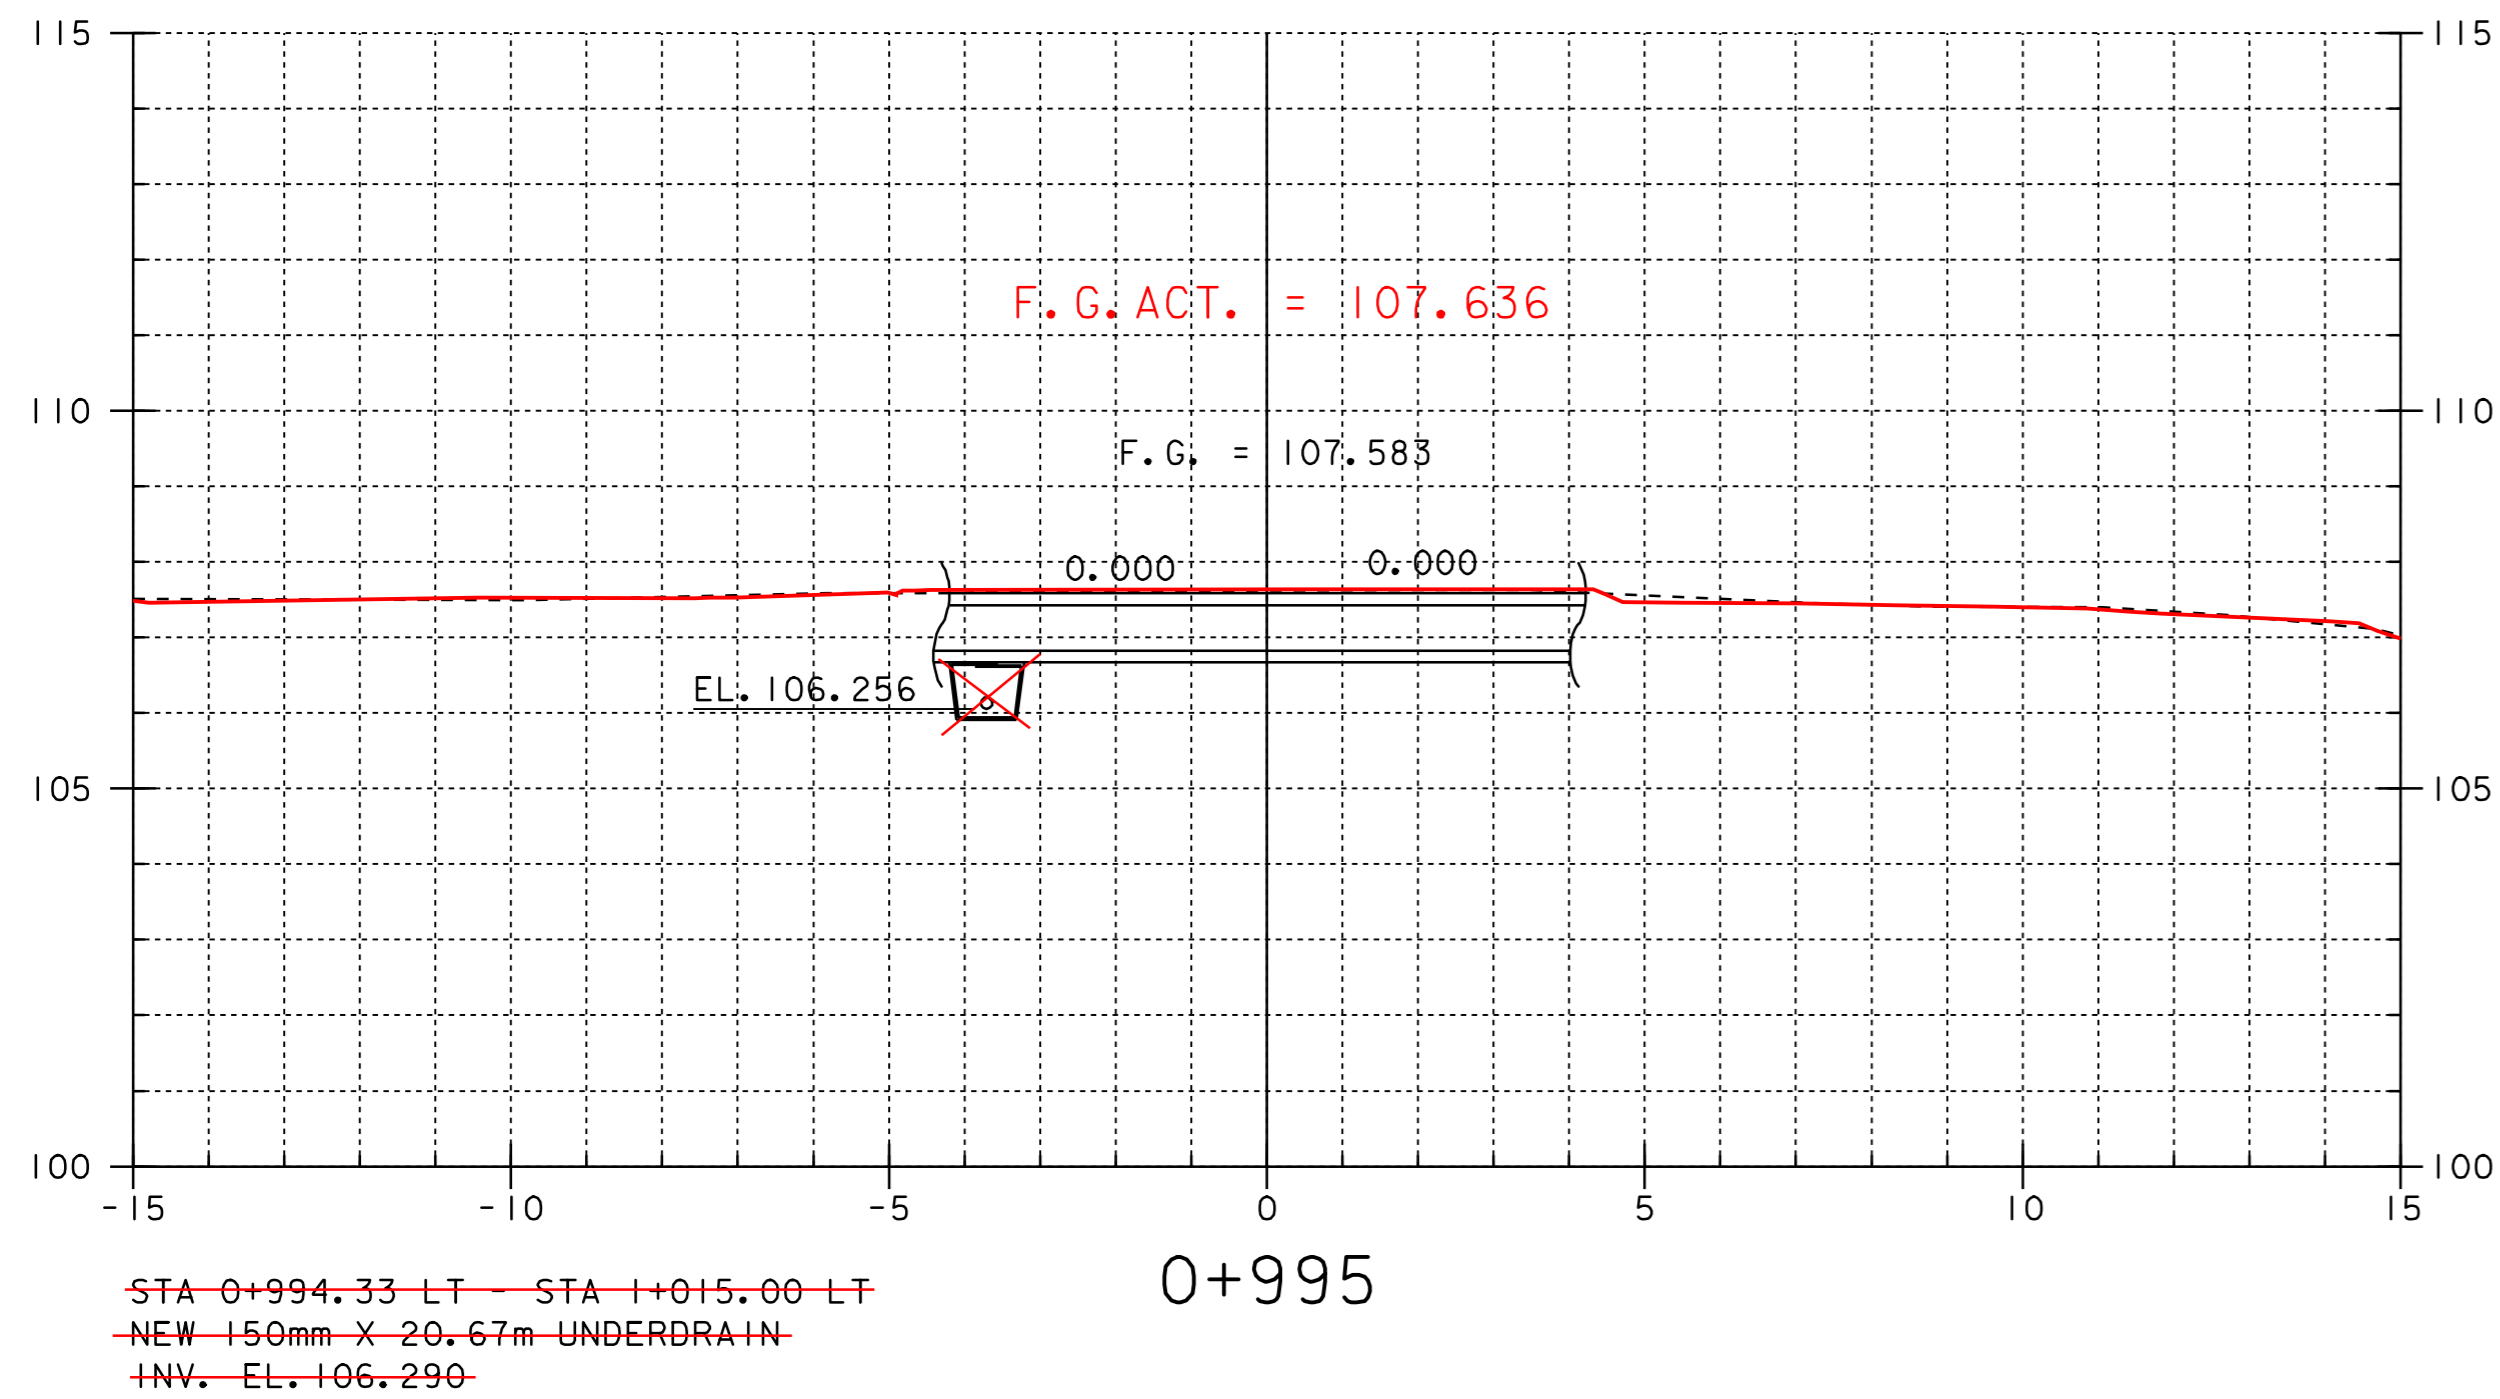

SHEET NAME: <u>MAINLINE CROSS SECTIONS</u>	
PROJECT NAME: <u>LEICESTER</u>	HIGHWAY NO.: <u>EAS_0160</u>
PROJECT NUMBER: <u>BRE_0160(3)S</u>	BRIDGE NO.: <u>6</u>
	OVER: <u>QUIER CREEK</u>
FILE NAME: <u>95J288\Structures\sj288xsl.dgn</u>	PLOT DATE: <u>02-OCT-2008 11:00</u>
PROJECT MANAGER: <u>B.B.WHITCOMB</u>	DRAWN BY: <u>J.GILMORE</u>
DESIGNED BY: <u>C.CARLSON</u>	IPARM NAME: <u>sj088dr3.i</u>
	SHEET <u>10</u> OF <u>90</u>