


I+230
END PROJECT
BEGIN APPROACH

STA I+225.000 RIGHT
END UNCLASS. CHANNEL EXCAVATION
END GEOTEXTILE FABRIC FILTER
END STONE FILL, TYPE III
END GRUBBING MATERIAL

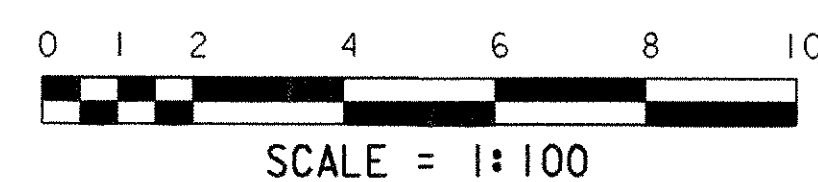

SHEET NAME: MAINLINE CROSS SECTIONS	
PROJECT NAME: LEICESTER	HIGHWAY NO.: FAS 0160
PROJECT NUMBER: BRF 0160(3)S	BRIDGE NO.: 6
	OVER: OTTER CREEK
FILE NAME: 95j288\Structures\sj288xsl.dgn	PLOT DATE: 17-AUG-2005
PROJECT MANAGER: R. R. WHITCOMB	DRAWN BY: J. GILMORE
DESIGNED BY: C. CARLSON	IPARM NAME: sj088d12.1
	SHEET 79 OF 90