


- STA 2+006.000 LEFT
- ~~BEGIN UNCLASS. CHANNEL EXCAVATION~~
- ~~BEGIN GEOTEXTILE FABRIC FILTER~~
- ~~BEGIN STONE FILL, TYPE III~~
- ~~BEGIN GRUBBING MATERIAL~~
- ITEMS ELIMINATED BY WRITTEN ORDER #10

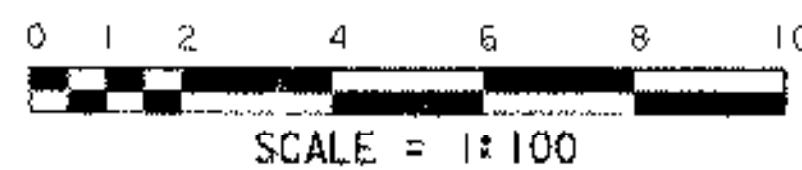

SHEET NAME: SIDELINE CROSS SECTIONS	
PROJECT NAME: LEICESTER	HIGHWAY NO.: FAS 0160
PROJECT NUMBER: BRF 0160(3)S	BRIDGE NO.: 6
	OVER: OTTER CREEK
FILE NAME: 95j288\structures\sj288xsl.dgn	PLOT DATE: 17-AUG-2005
PROJECT MANAGER: R. R. WHITCOMB	DRAWN BY: J. GILMORE
DESIGNED BY: C. CARLSON	IPARM NAME: sj088s.d1
	SHEET 80 OF 90