
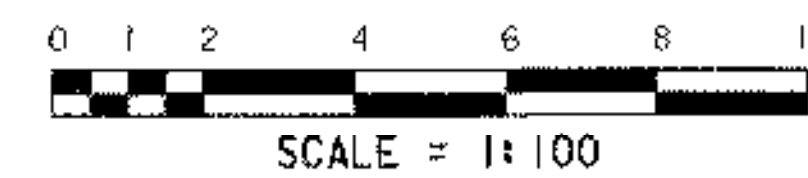


§ STA 2+017
 END UNCLASS. CHANNEL EXCAVATION
 END GEOTEXTILE FILTER FABRIC
 END STONE FILL, TYPE III
 END GRUBBING MATERIAL

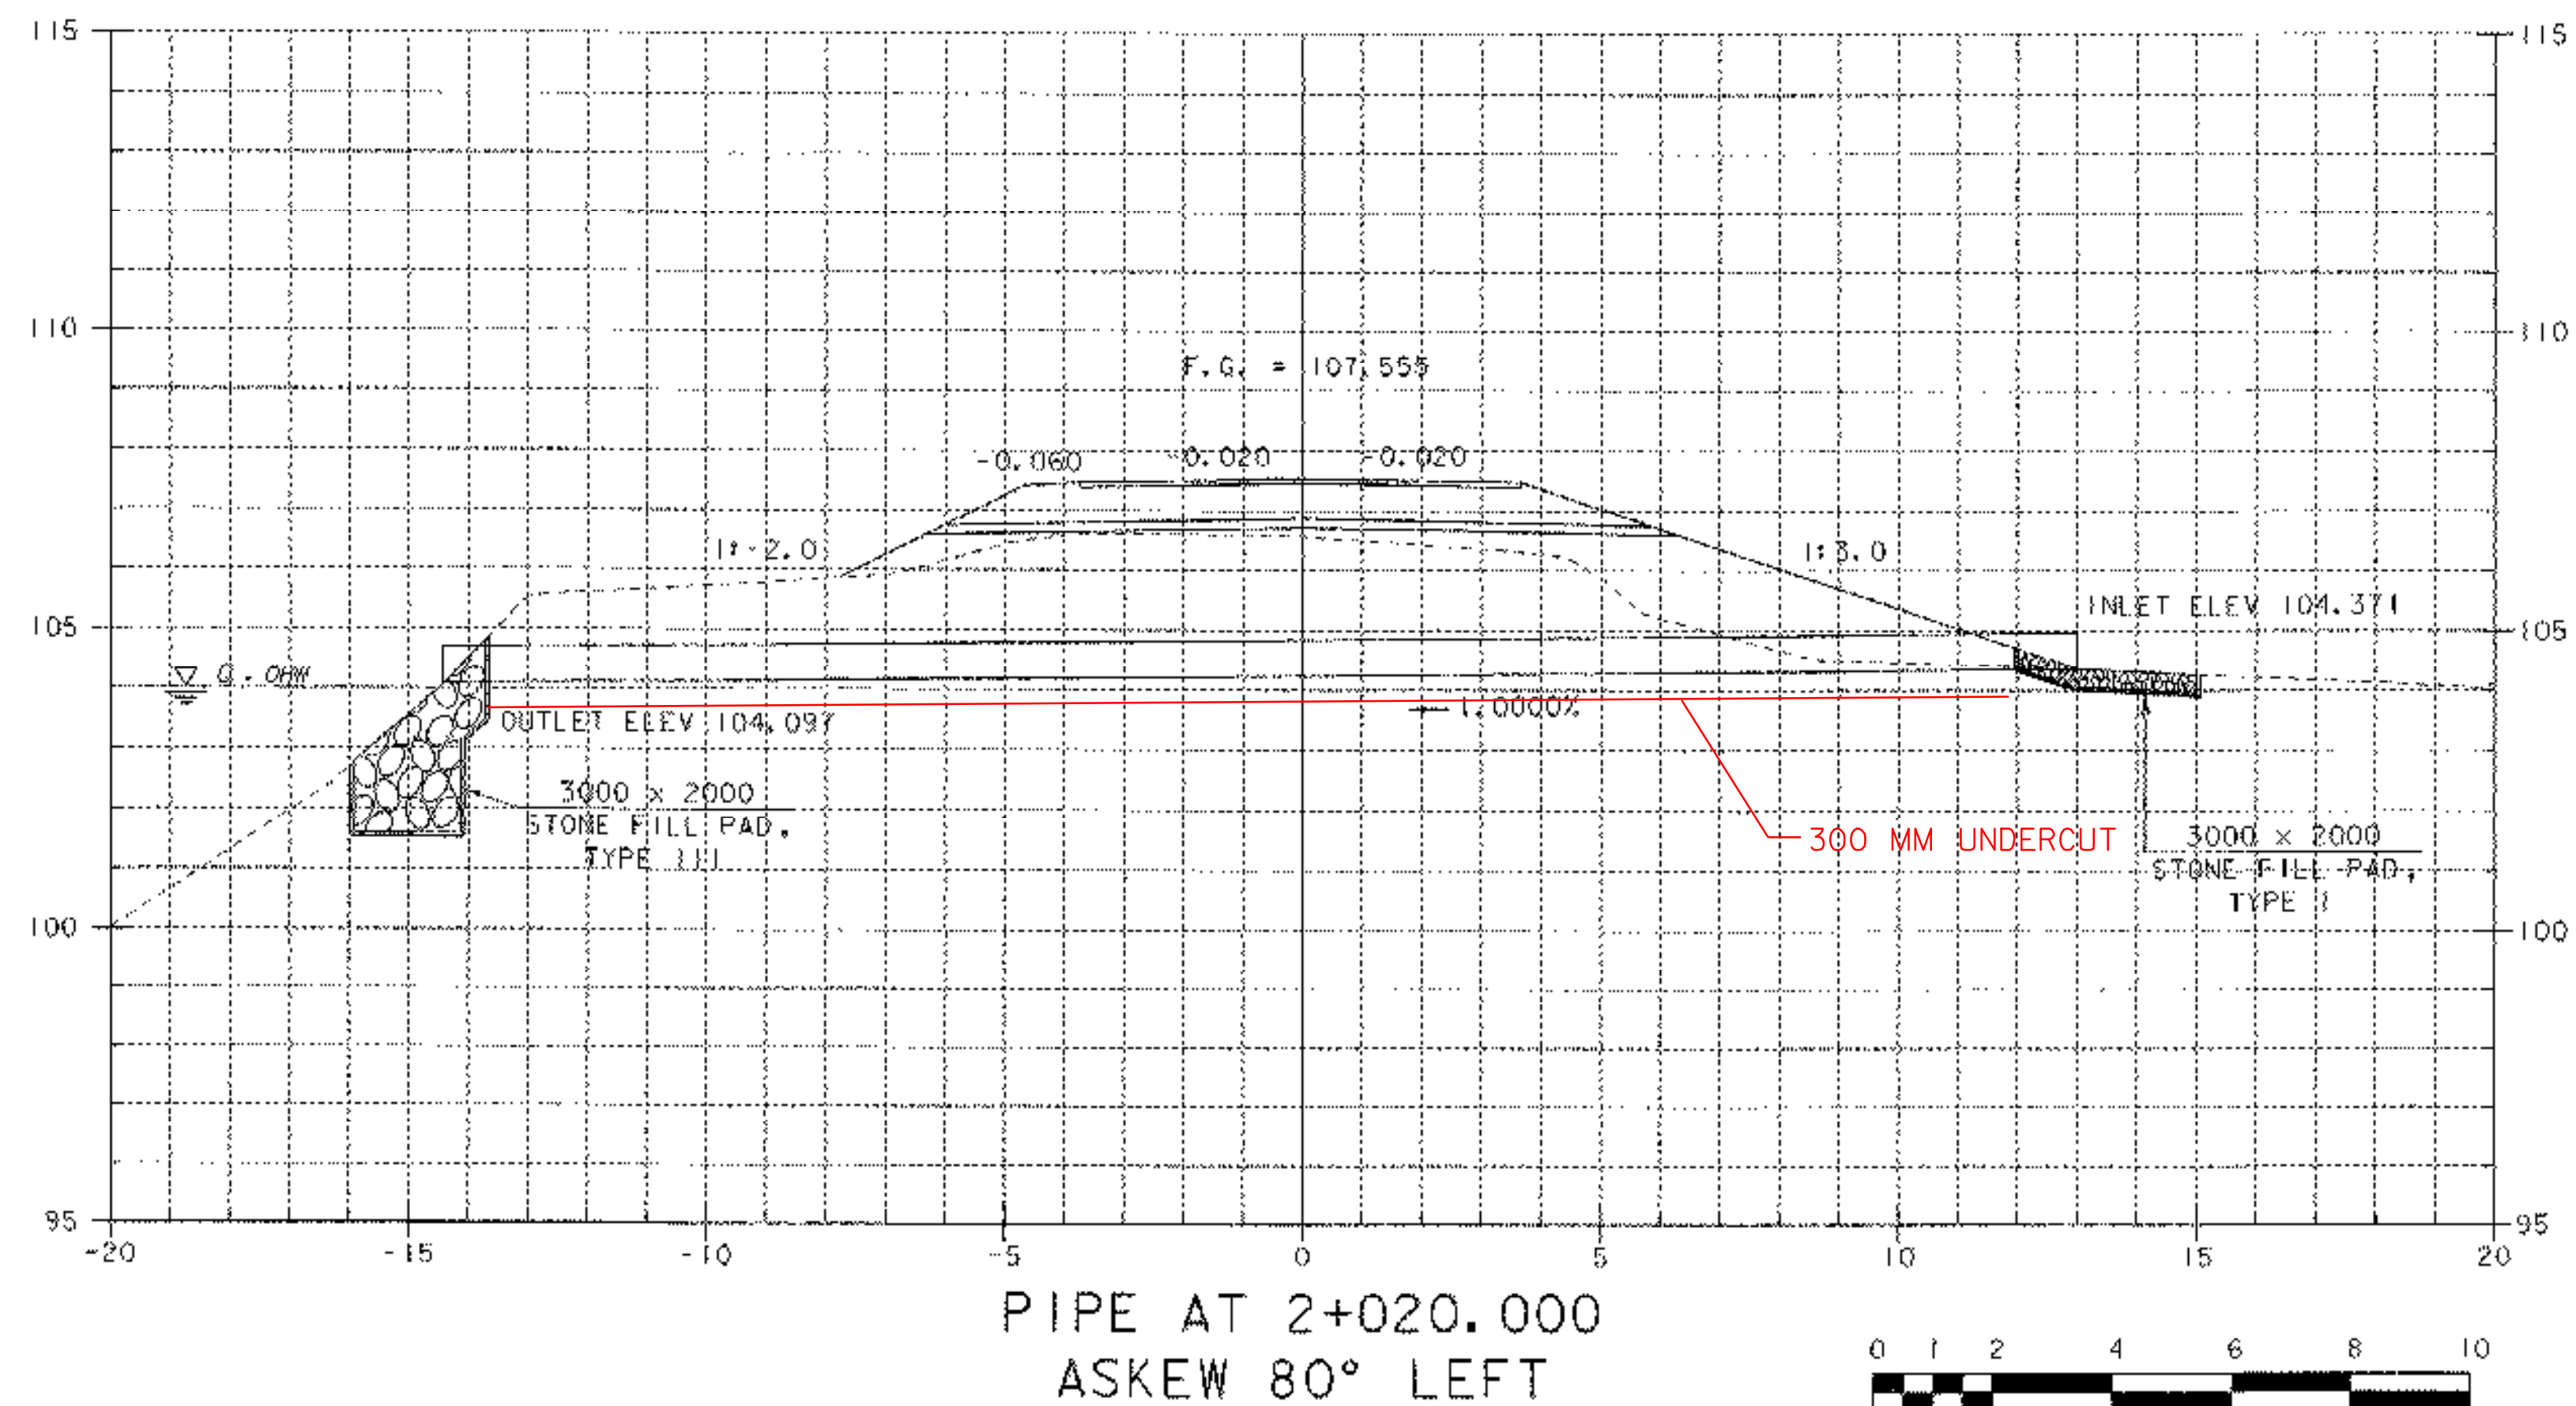

SHEET NAME: SIDELINE CROSS SECTIONS	
PROJECT NAME: LEICESTER	HIGHWAY NO.: FAS 0160
PROJECT NUMBER: BRF 0160(3)S	BRIDGE NO.: 6
	OVER: OTTER CREEK
FILE NAME: 95J288\Structures\sj288\sl.dgn	PLOT DATE: 17-AUG-2005
PROJECT MANAGER: R. R. WHITCOMB	DRAWN BY: J. GILMORE
DESIGNED BY: C. CARLSON	IPARM NAME: sj088sx2.1
	SHEET 81 OF 90