


4+986.00

FOOTING
101.500

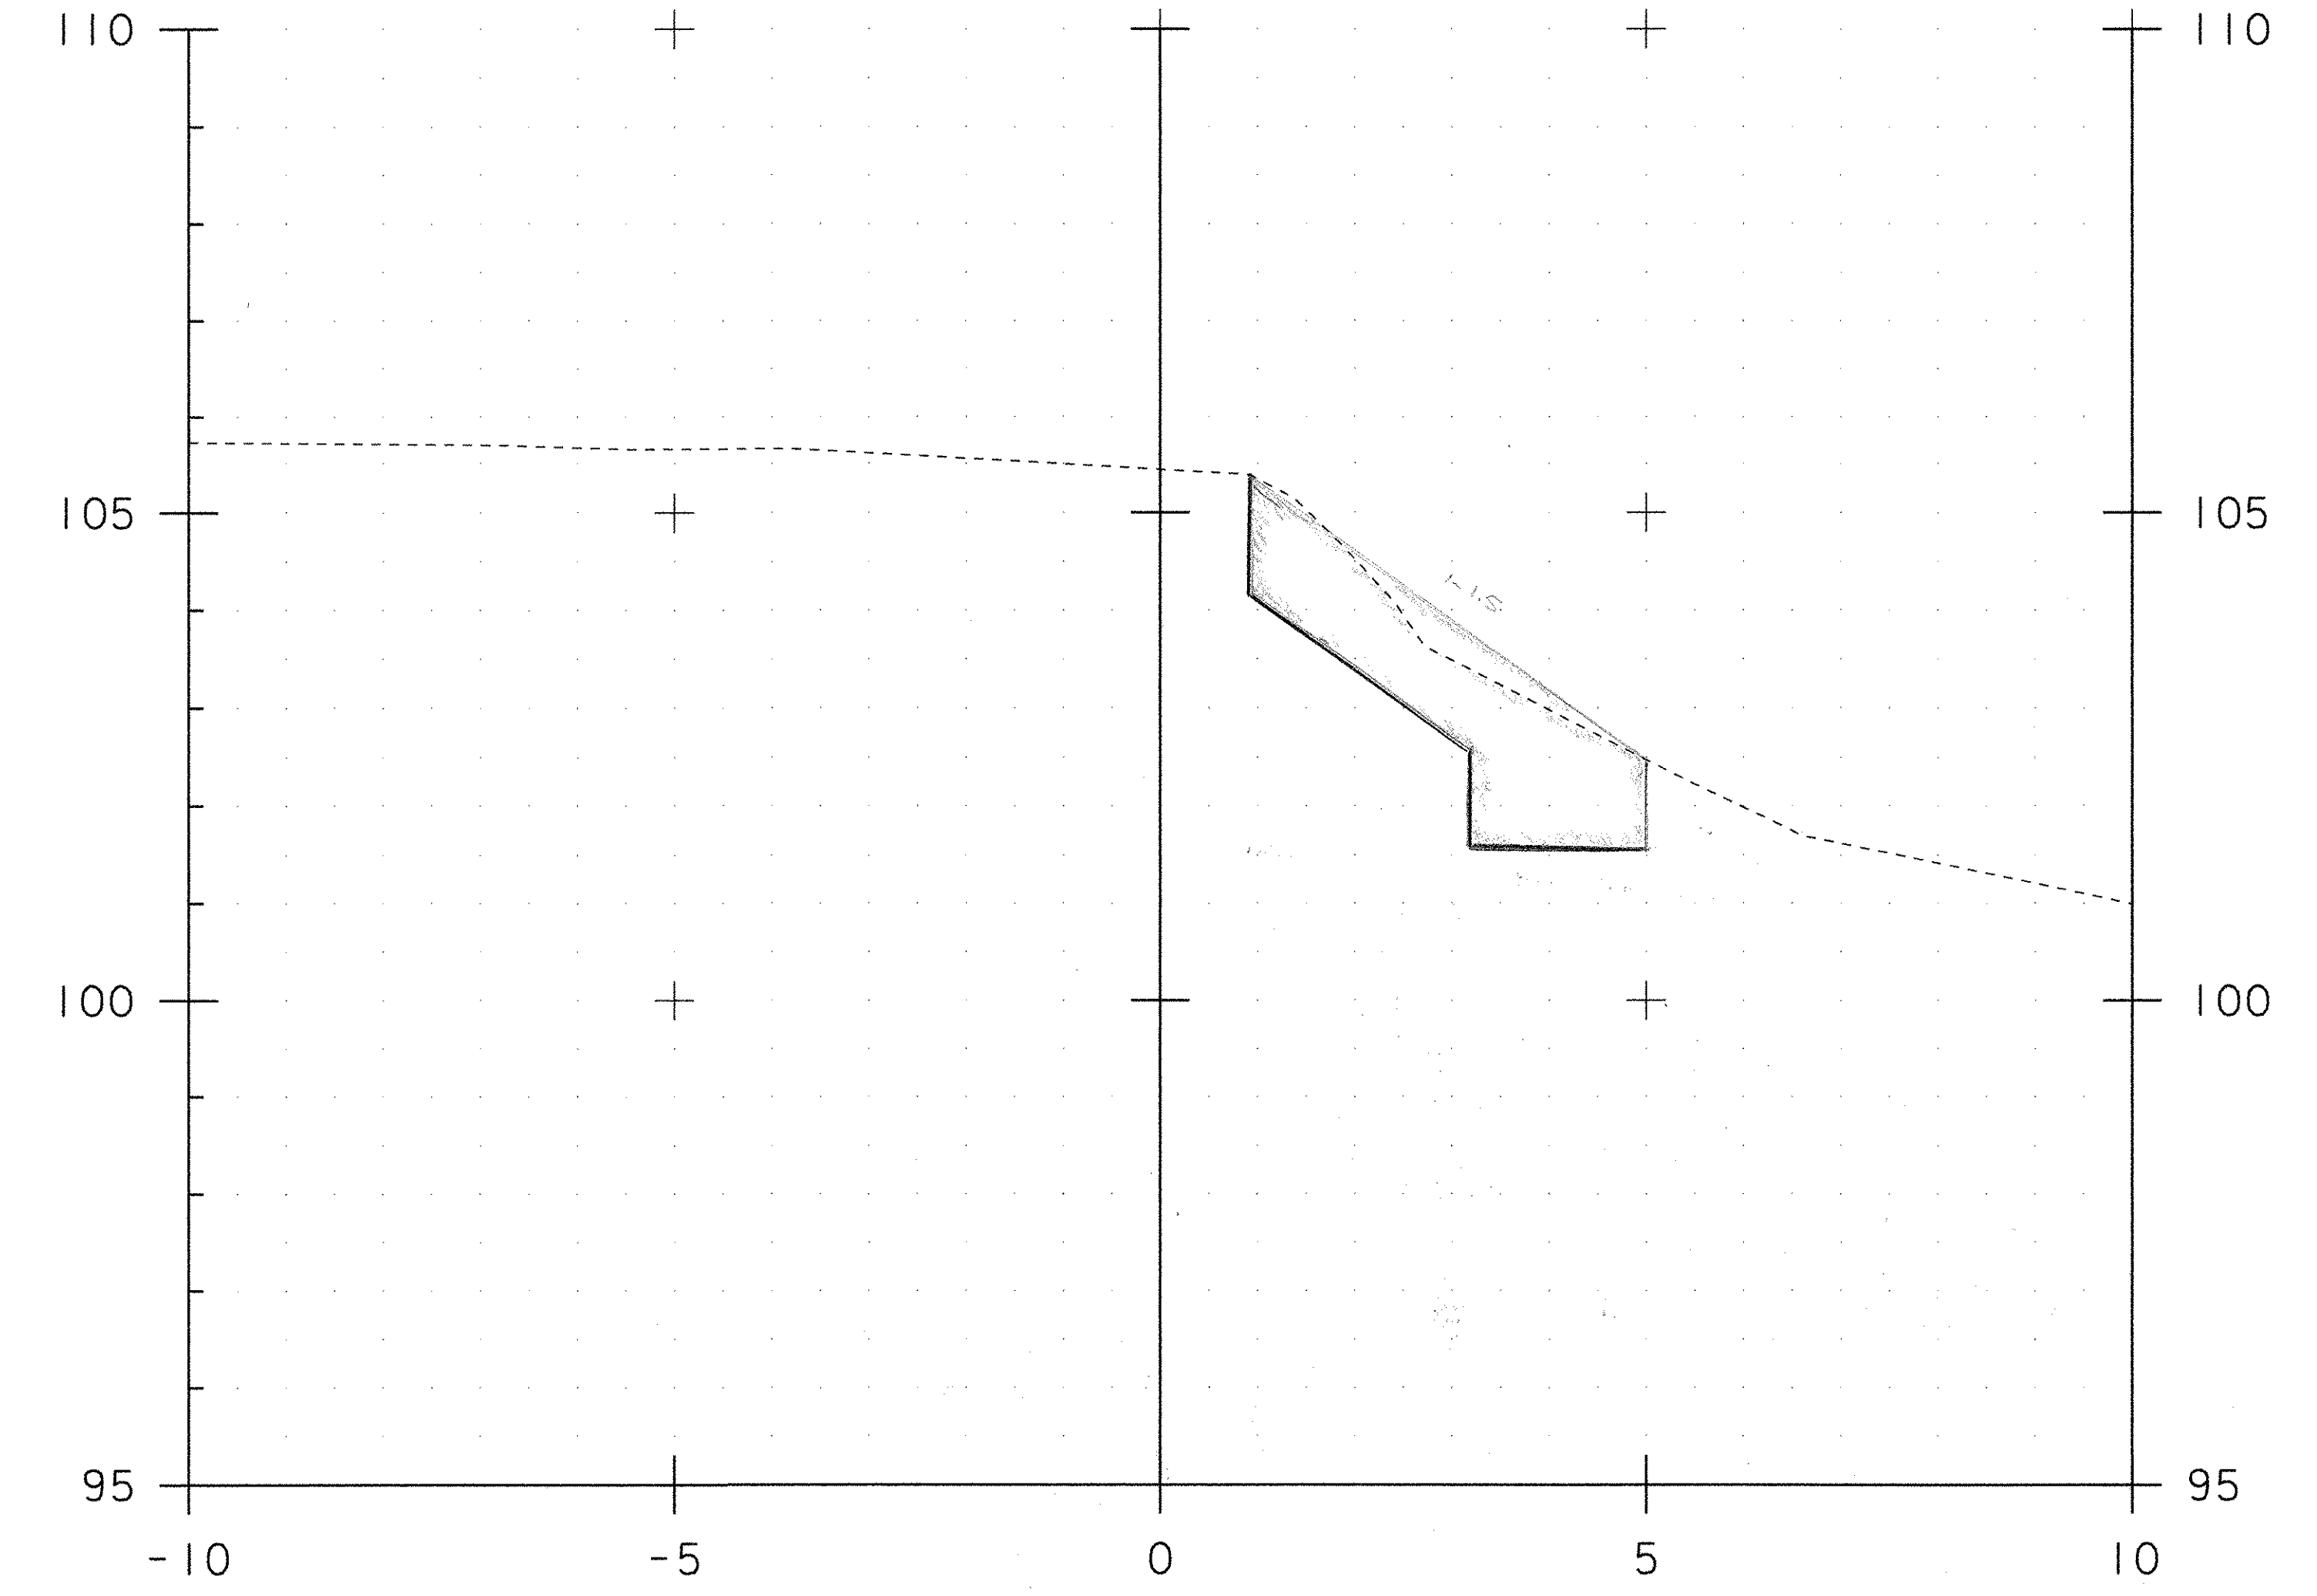

4+988.00

BEGIN UNCL. CHAN EXC (BUTT) = 4.67 m² ✓ PC 2-29-07
 BEGIN STONE FILL TYPE III (BUTT) = 5.34 m² ✓
 BEGIN GEO. UNDER STONE FILL (BUTT) = 6.7 M

PROJECT NAME:	Leicester	PLOT DATE:	01-NOV-2005
PROJECT NUMBER:	BRF 0160(3)S	DRAWN BY:	R. Bullock
FILE NAME:		CHECKED BY:	
PROJECT LEADER:		SHEET 1	OF 8
DESIGNED BY:	D91 AB1		