


OUTSIDE CORNER LW# 2

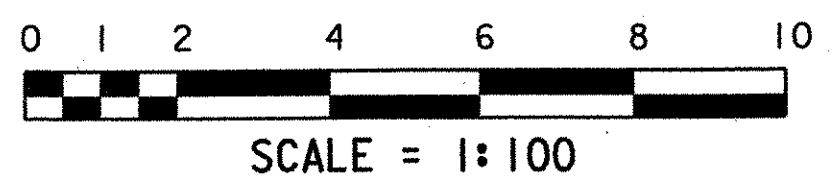

096AB1