


4+994.00

Exc - E & R = 25.15 m² ✓

UNCL GRAN EXC = ~~4.84~~ 4.84 m³ DC 3-5-07
 STONE FILL TYPE III = 6.62 m³
 GRAN BACKFILL = 8.85 m³
 GEO UNDER S.F = 7.1M
 STRUCTURE EXC = 18.79 m²

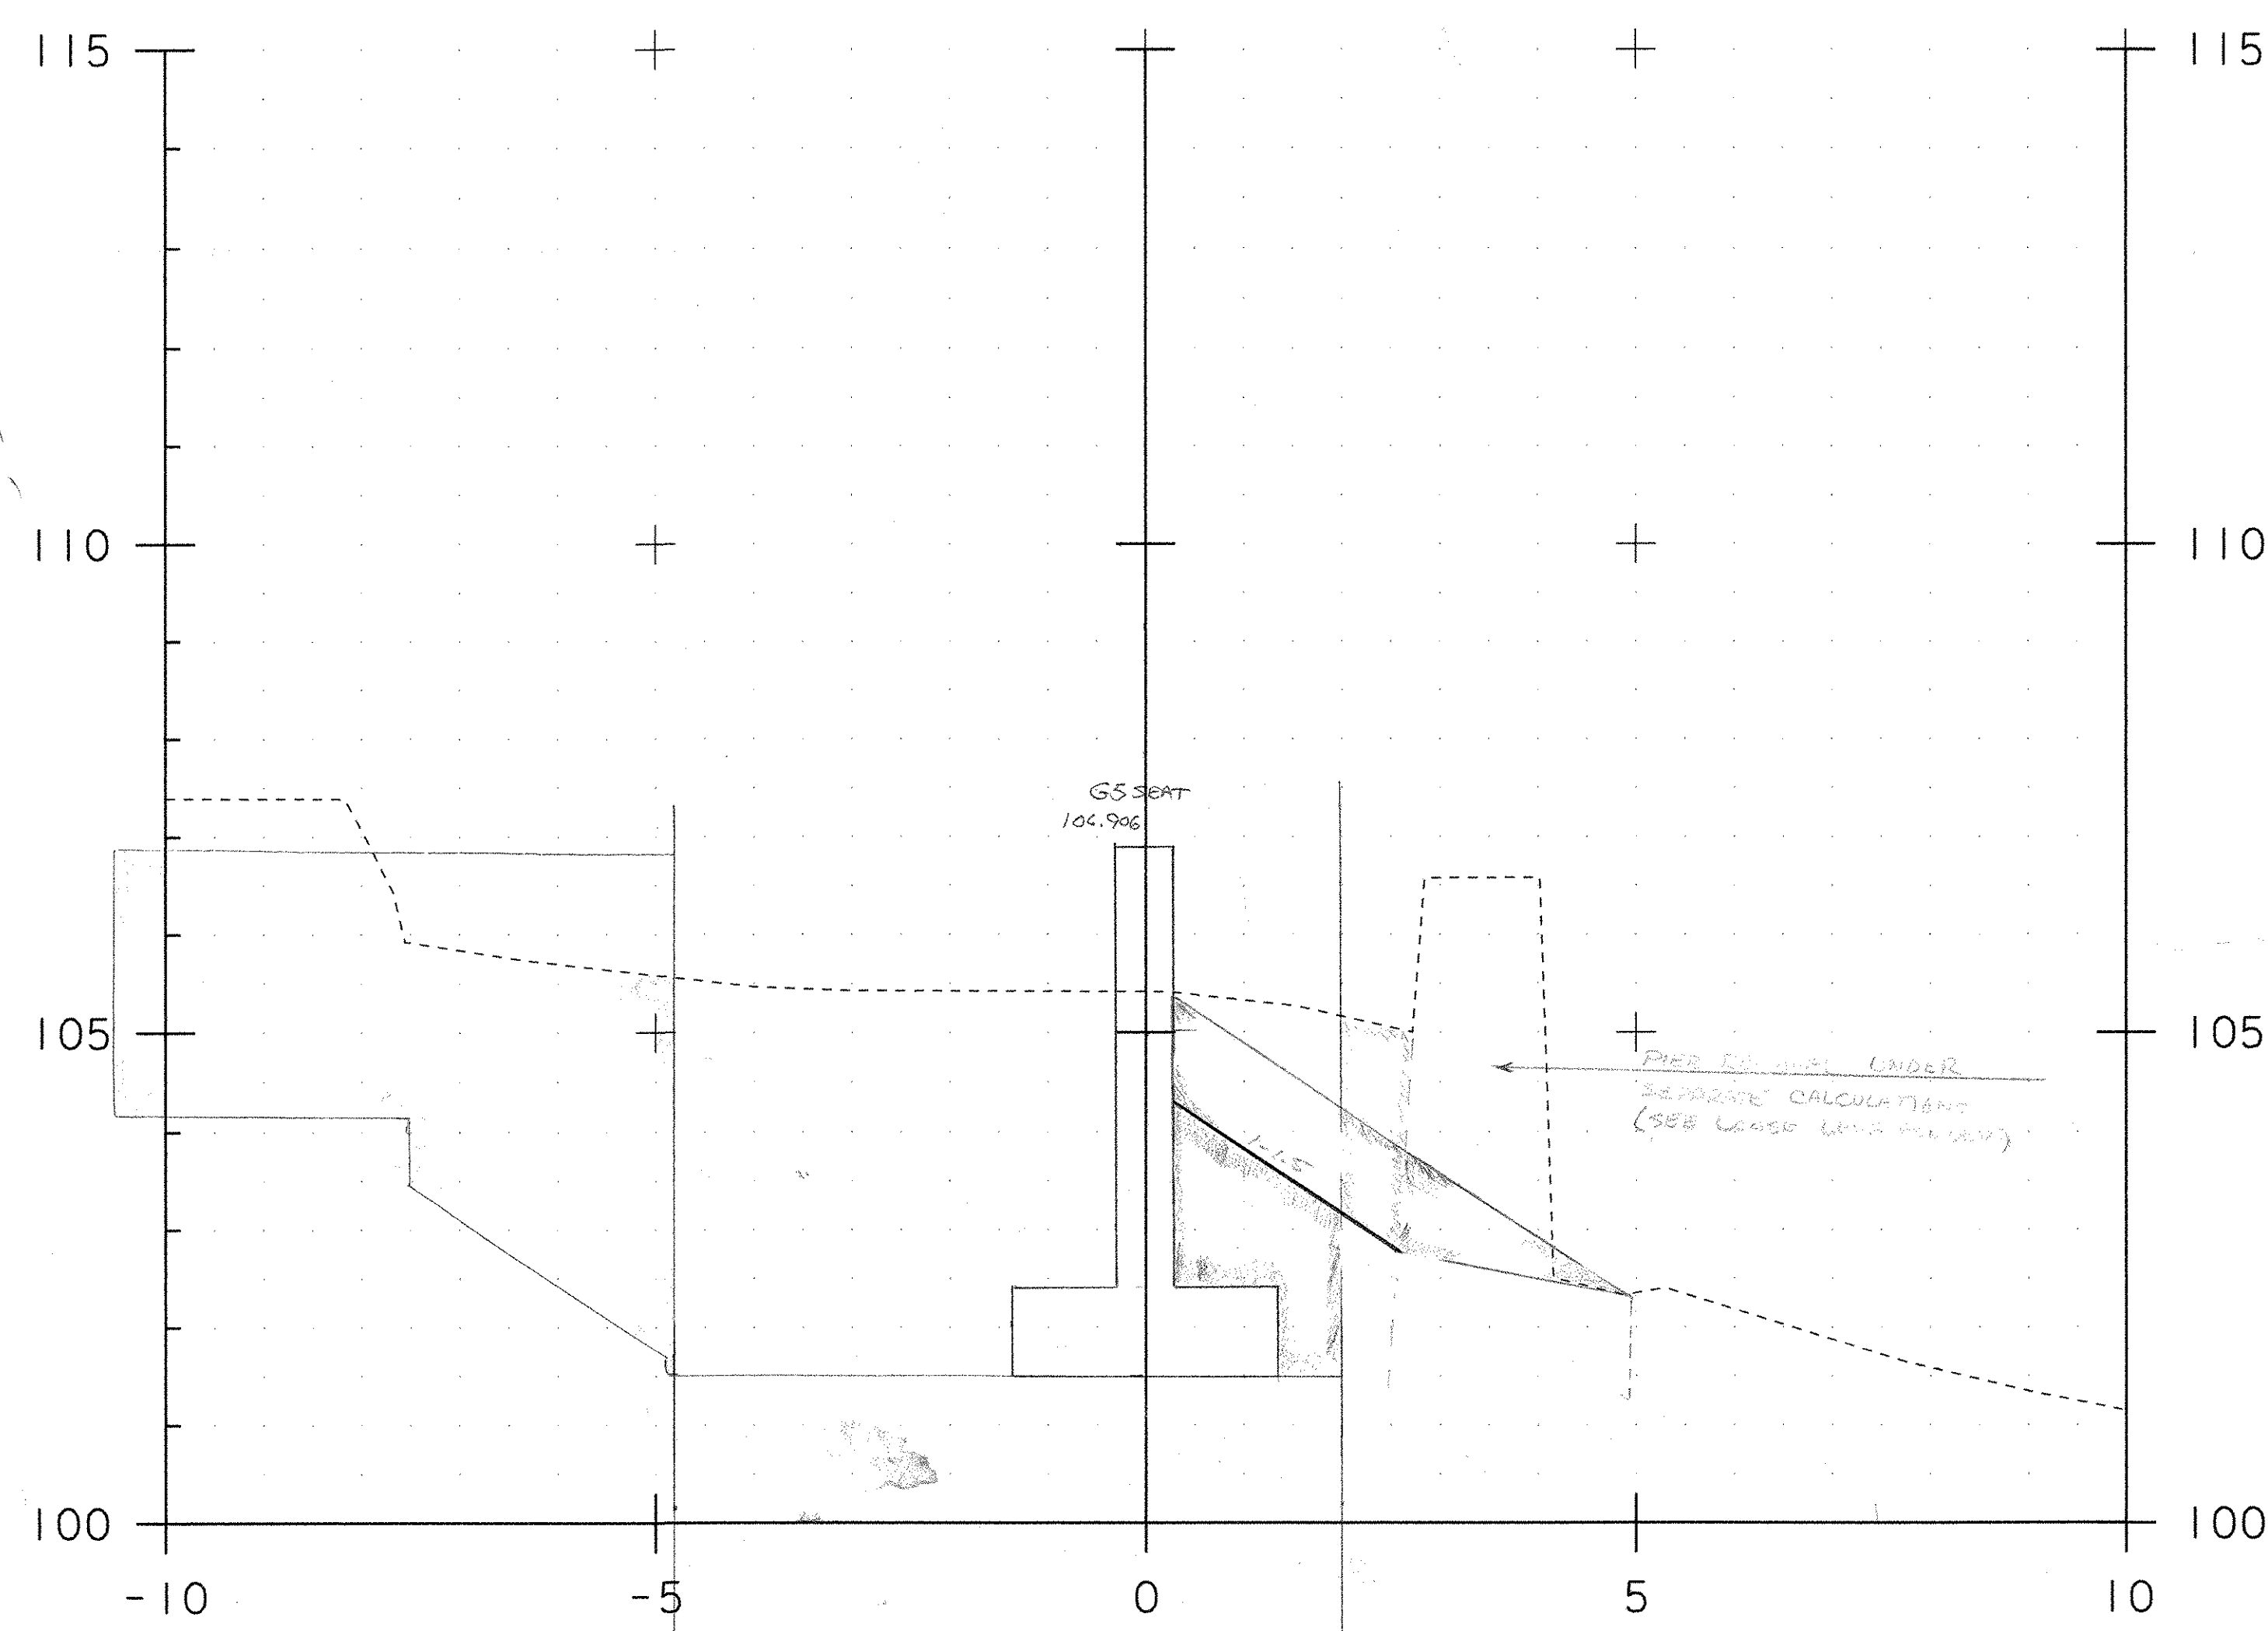

4+996.00

Exc - E & R = 26.50 m² ✓

UNCL GRAN EXC = 1.86 m³ DC 3-5-07
 STONE FILL TYPE III = 3.68 m³
 GRAN BACKFILL = 2.82 m³
 GEO UNDER S.F = 2.7M
 STRUCTURE EXC = 16.22 m²

PROJECT NAME: Leicester
 PROJECT NUMBER: BRF 0160(3)S

FILE NAME: PLOT DATE: 01-NOV-2005
 PROJECT LEADER: DRAWN BY: R. Bullock
 DESIGNED BY: CHECKED BY:
 SHEET 3 OF 8

094431 099 AB1