


4+998.00

Exc - E & R = 1521 m<sup>2</sup>

- ONE CHAN. EXC - 0.97 m<sup>2</sup>
- GRAIN BACKFILL - 3.23 m<sup>2</sup>
- GEO UNDER S.F - 2.6 m
- STONE FILL TYPE III - 3.73 m<sup>2</sup>

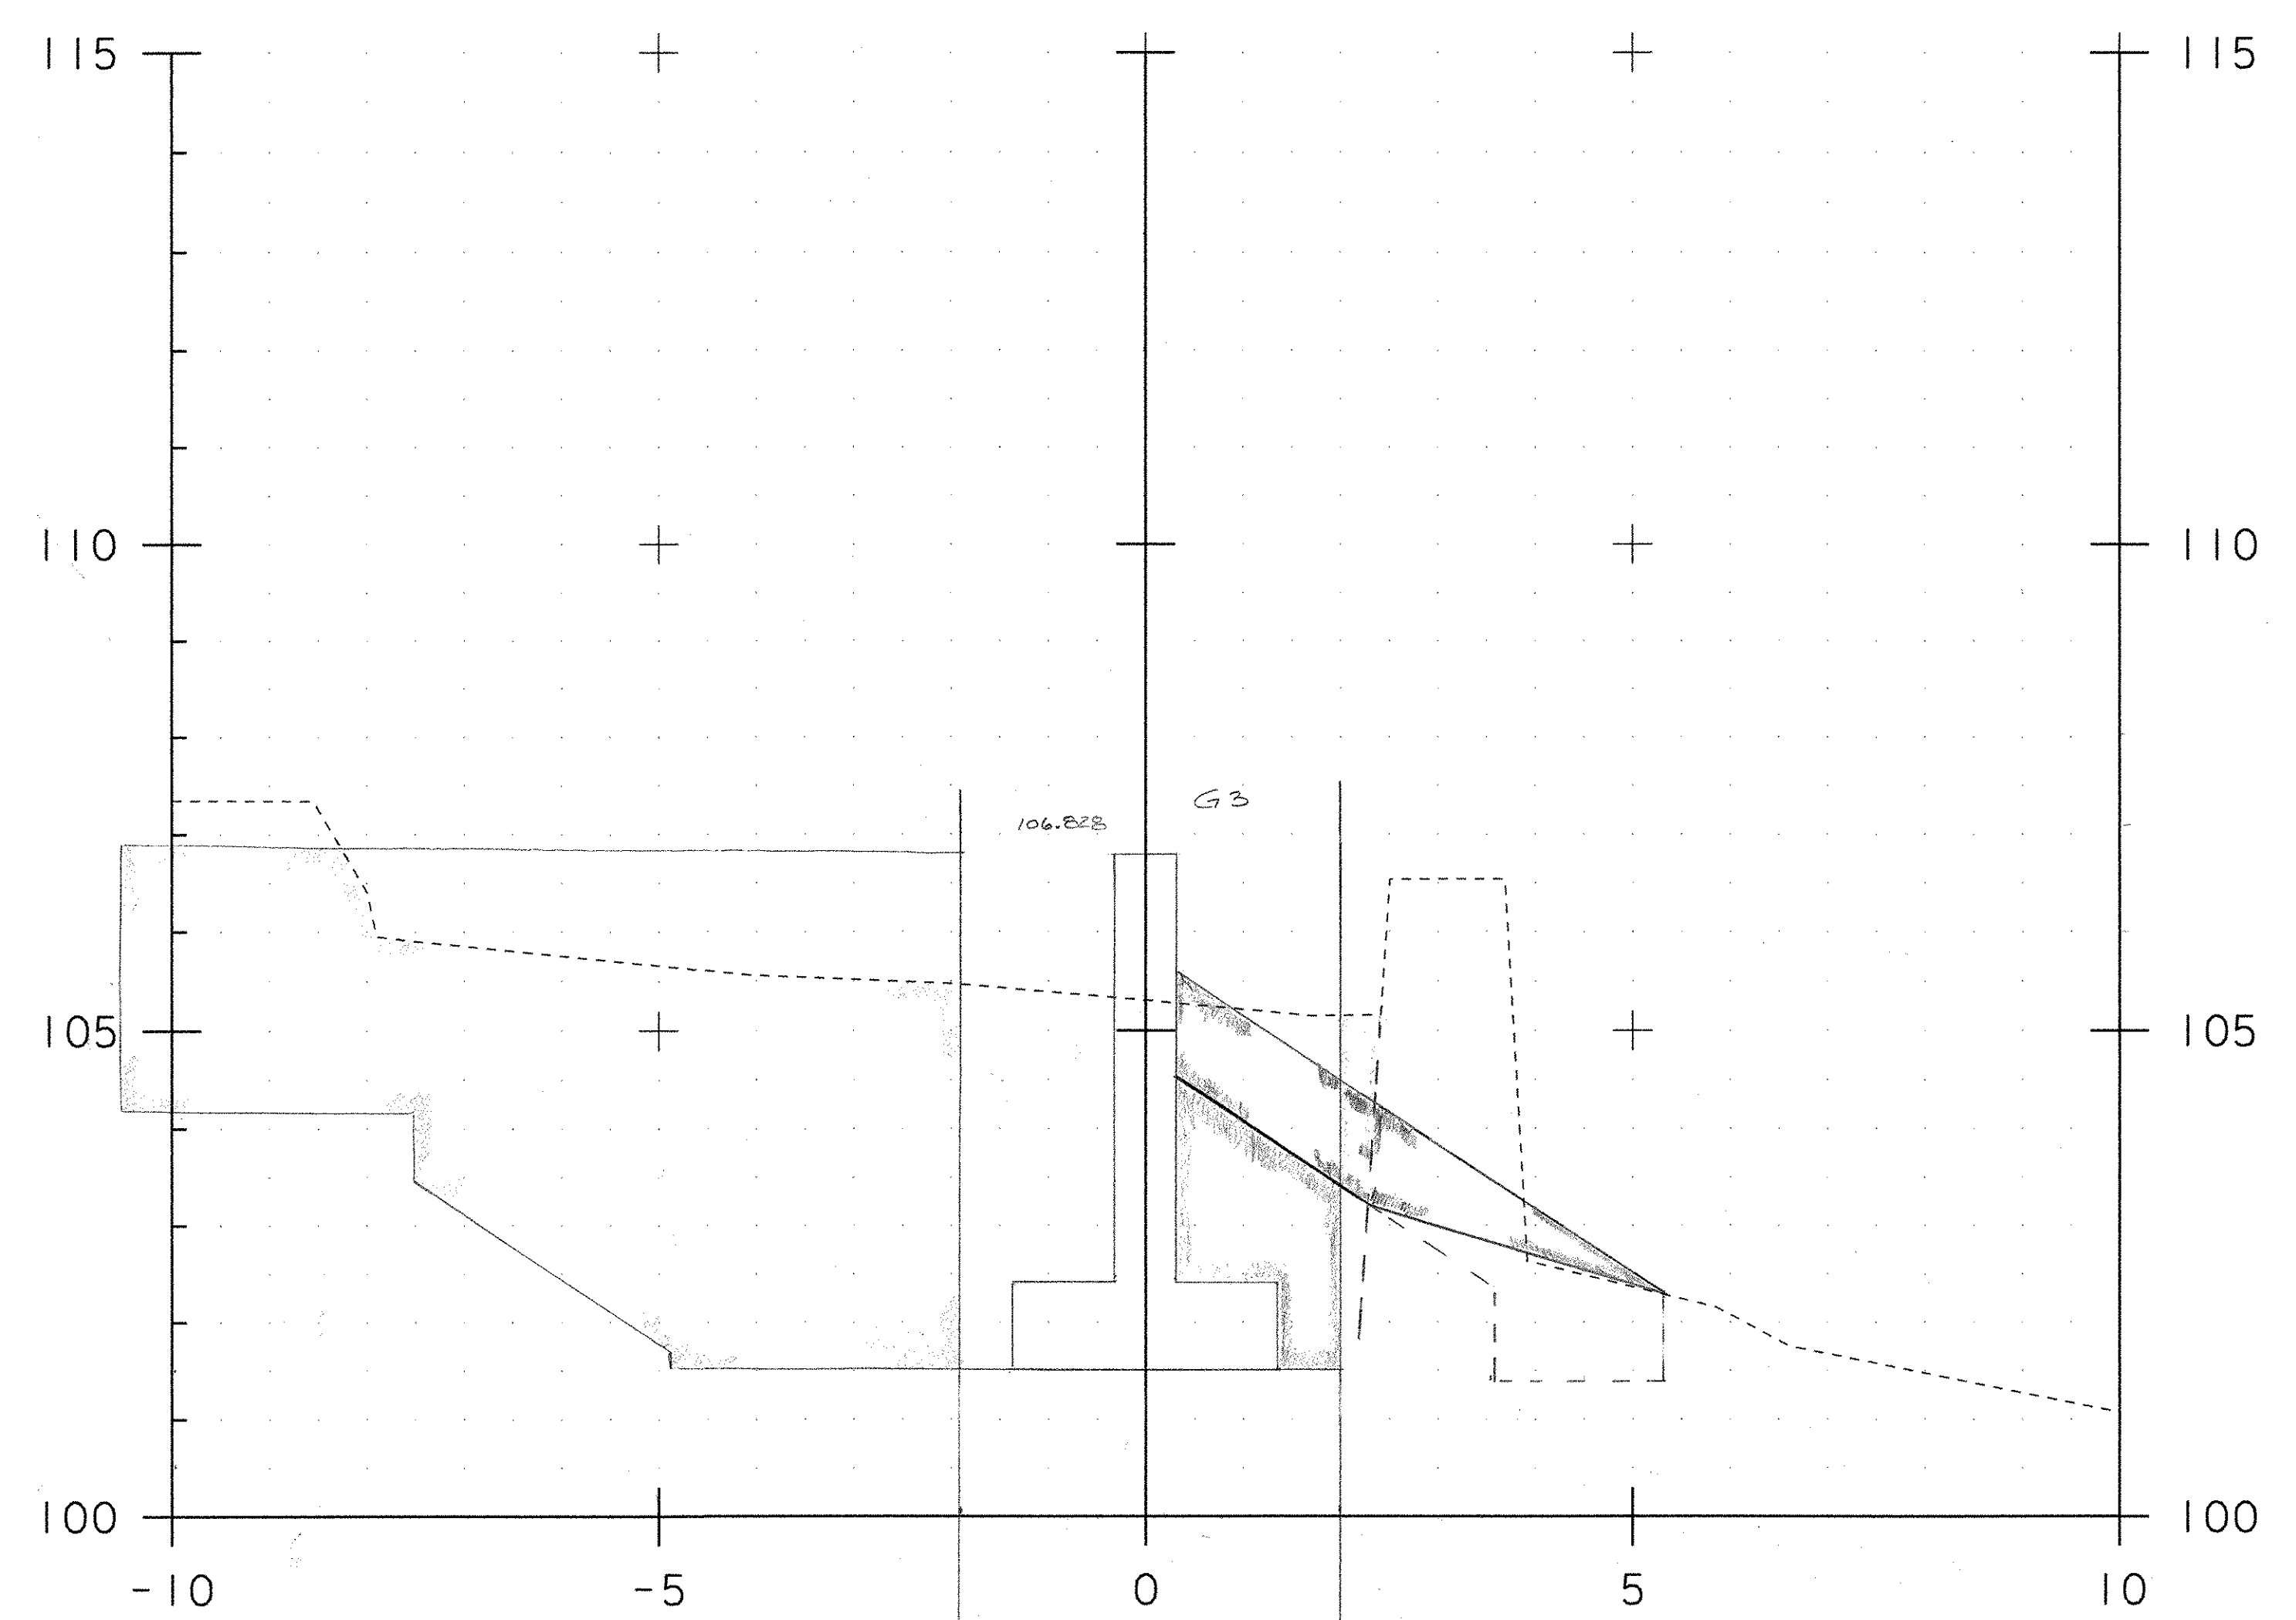

5+000.00

Exc - E & R = 14.82 m<sup>2</sup>

- ONE CHAN. EXC - 0.89 m<sup>2</sup>
- GRAIN BACKFILL - 3.12 m<sup>2</sup>
- GEO UNDER S.F - 2.35 m
- STONE FILL TYPE III - 3.8 m<sup>2</sup>
- STRUCTURE EXC - 28.76 m<sup>2</sup>

PROJECT NAME:	Leicester	PLOT DATE:	01-NOV-2005
PROJECT NUMBER:	BRF 0160(3)S	DRAWN BY:	R. Bullock
FILE NAME:		CHECKED BY:	
PROJECT LEADER:		SHEET 4	OF 8
DESIGNED BY:	100 AB1		