


3

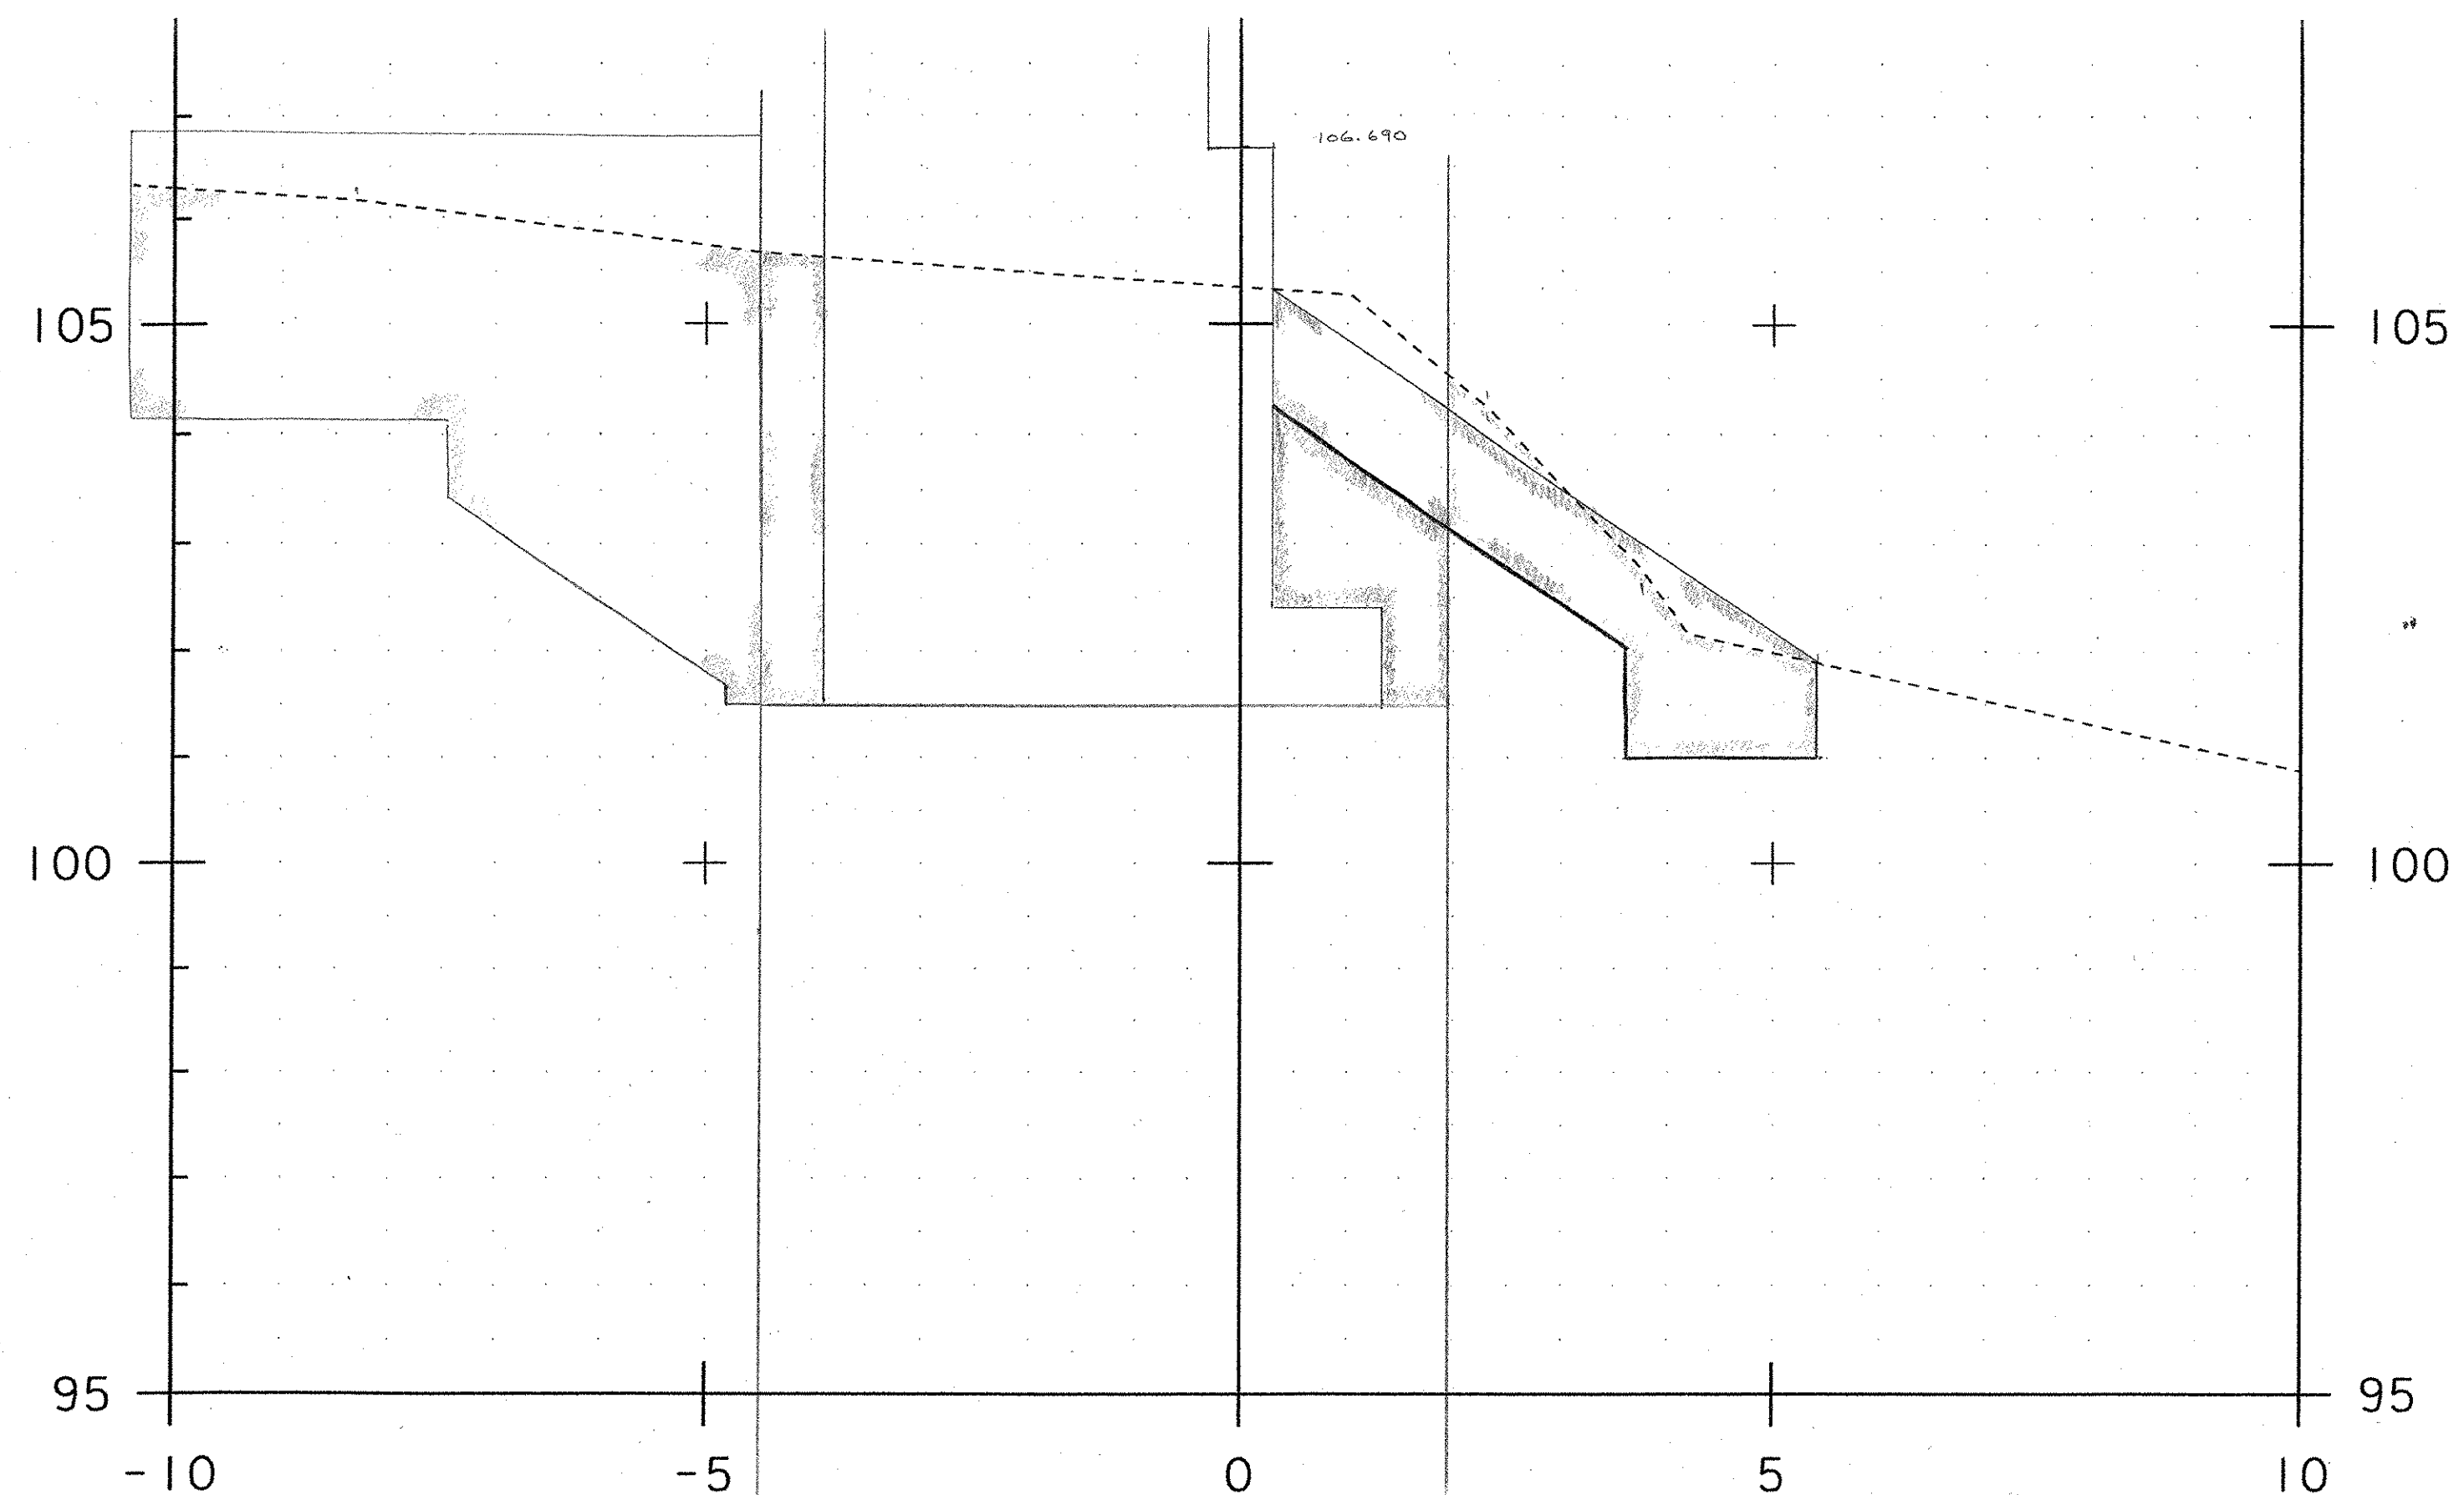

STA 5+005.0 - STRUCTURE EXC -

* 5+005.0 - STRUCTURE EXC ONLY

5+005.40

UNO CHAN EXC - 4.13 M²
 GRAM BACKFILL - 5.23 M²
 STONE FILL TYPE III - 6.55 M²
 GEO UNDER S.F - 6.8 M
 STRUCTURE EXC - ZERO
 WW# 1 CORNER

102 AB1