


Exc - E.P.R =  $\frac{14.62}{41.12} m^2$   
 CONC EXCAV EXC - PIER =  
 GRANULAR BACKFILL -  $2.67 m^2$   
 STONE FILL TYPE III -  $3.70 m^2$   
 GEO UNDER S.F - 2.0M

5+002.00

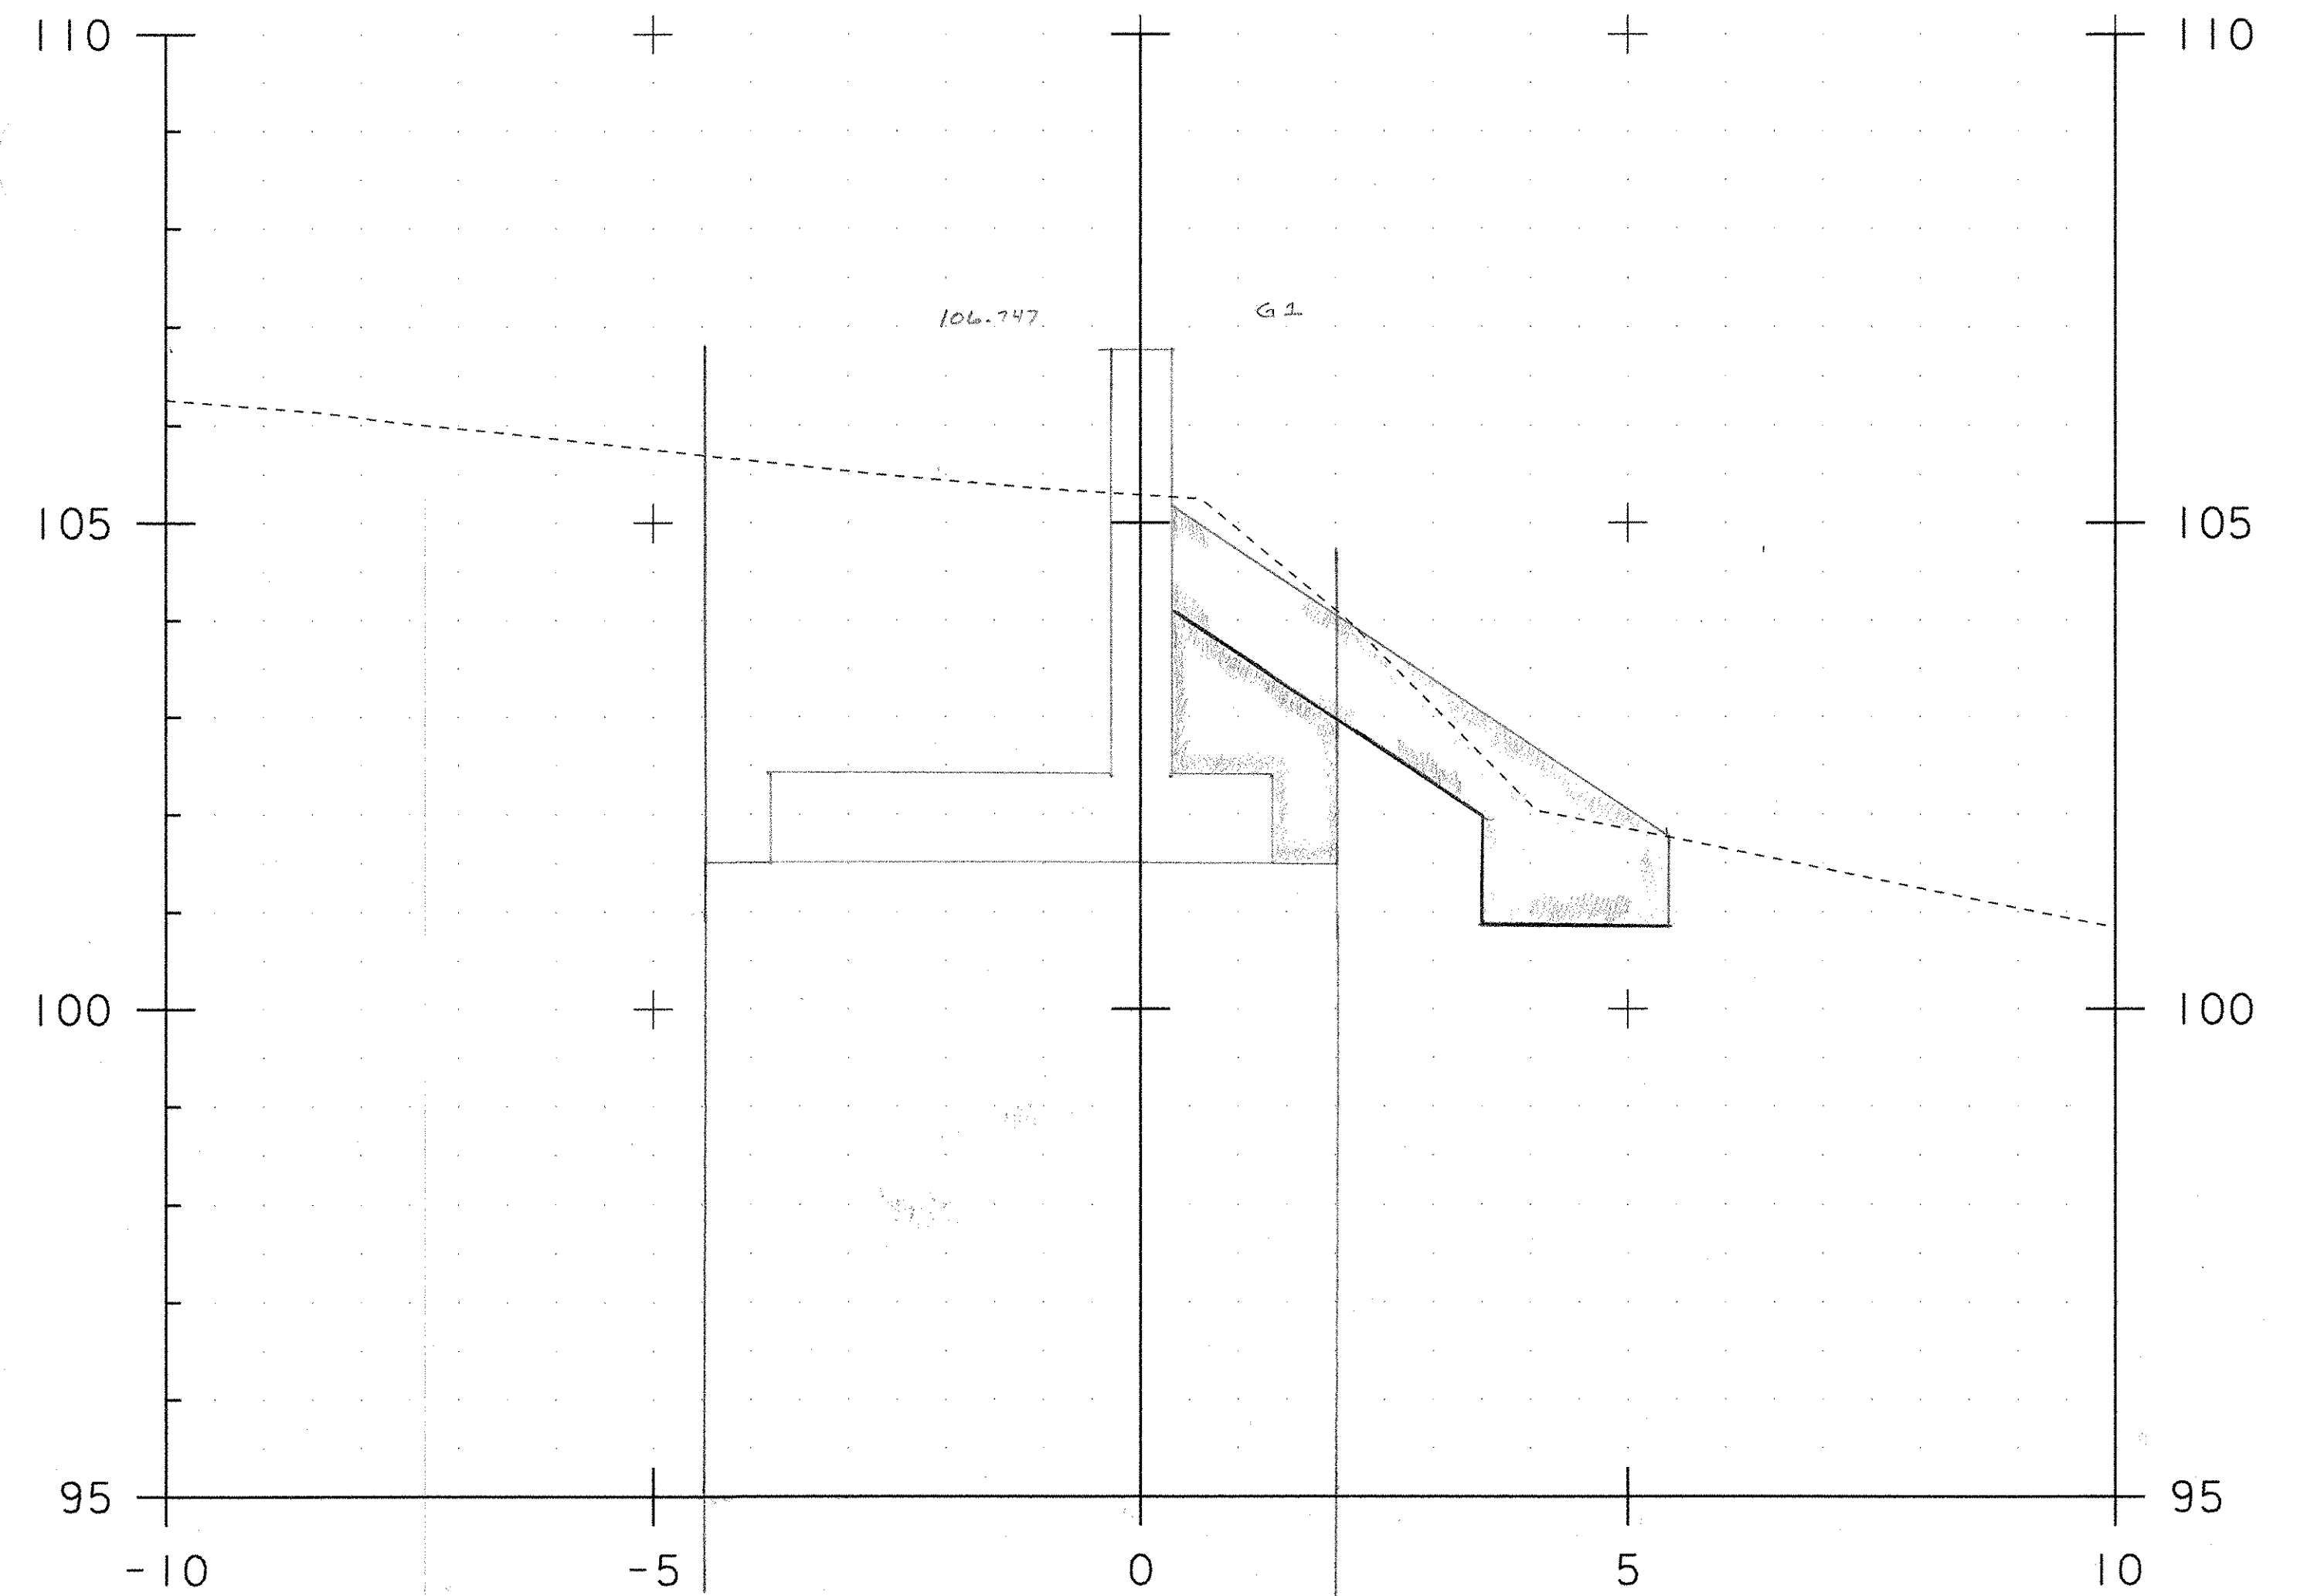

Exc - E.P.R =  $\frac{24.58}{41.12} m^2$   
 CONC EXCAV EXC - PIER =  
 GRAN BACKFILL -  $2.50 m^2$   
 STONE FILL TYPE III -  $6.23 m^2$   
 GEO UNDER S.F - 6.7M

5+004.00

PROJECT NAME:	Licester		
PROJECT NUMBER:	BRF 0160(3)S		
FILE NAME:	DESIGNED BY:	CHECKED BY:	PLOT DATE: 01-NOV-2005
PROJECT LEADER:			DRAWN BY: R. Bullock
			SHEET 5 OF 8

105AB1