


5+011.00

STONE FILL TYPE III - 7.36 m²

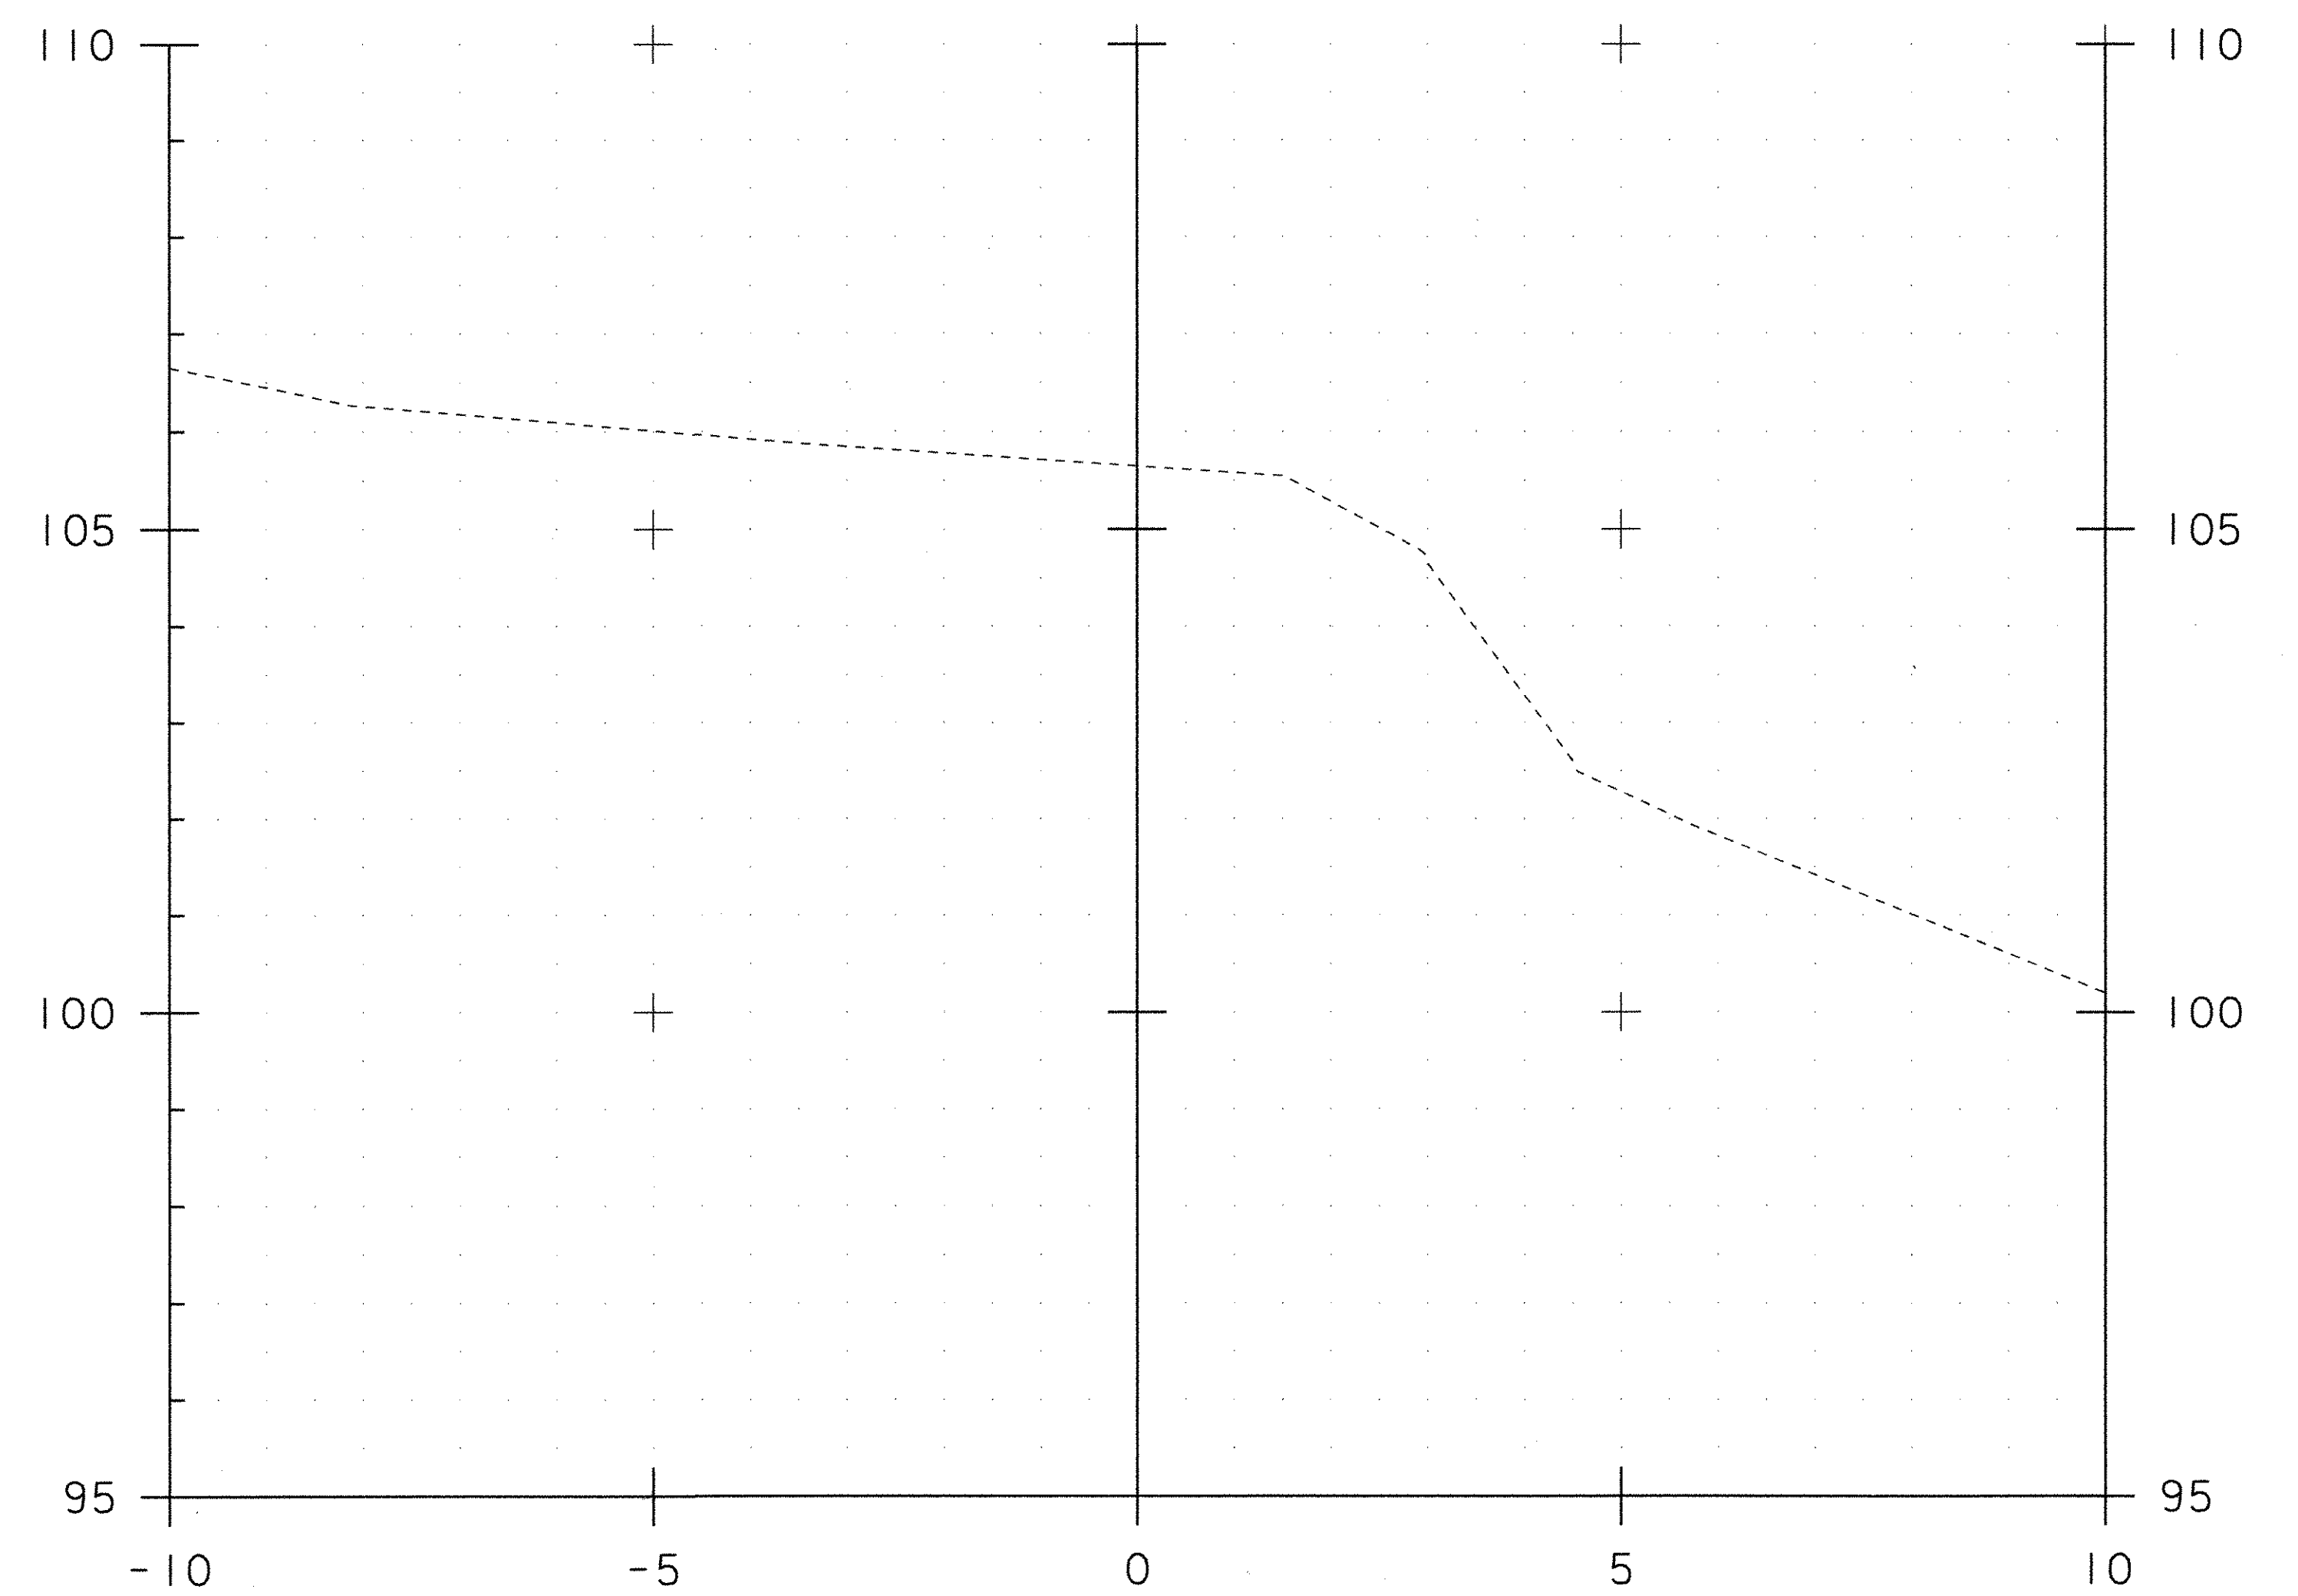

5+014.00

ZERO STONE FILL TYPE III

PROJECT NAME:	Leicester	PLOT DATE:	01-NOV-2005
PROJECT NUMBER:	BRF 0160(3)S	DRAWN BY:	R. Bullock
FILE NAME:		CHECKED BY:	
PROJECT LEADER:		SHEET 7	OF 8
DESIGNED BY:	<i>110</i> <i>AB1</i>		