


9+986.50

ZERO STONE FILL TYPE III
 ZERO UNCLASSIFIED CHAN EXC
 ZERO GEOTEXTILE UNDER STONE FILL

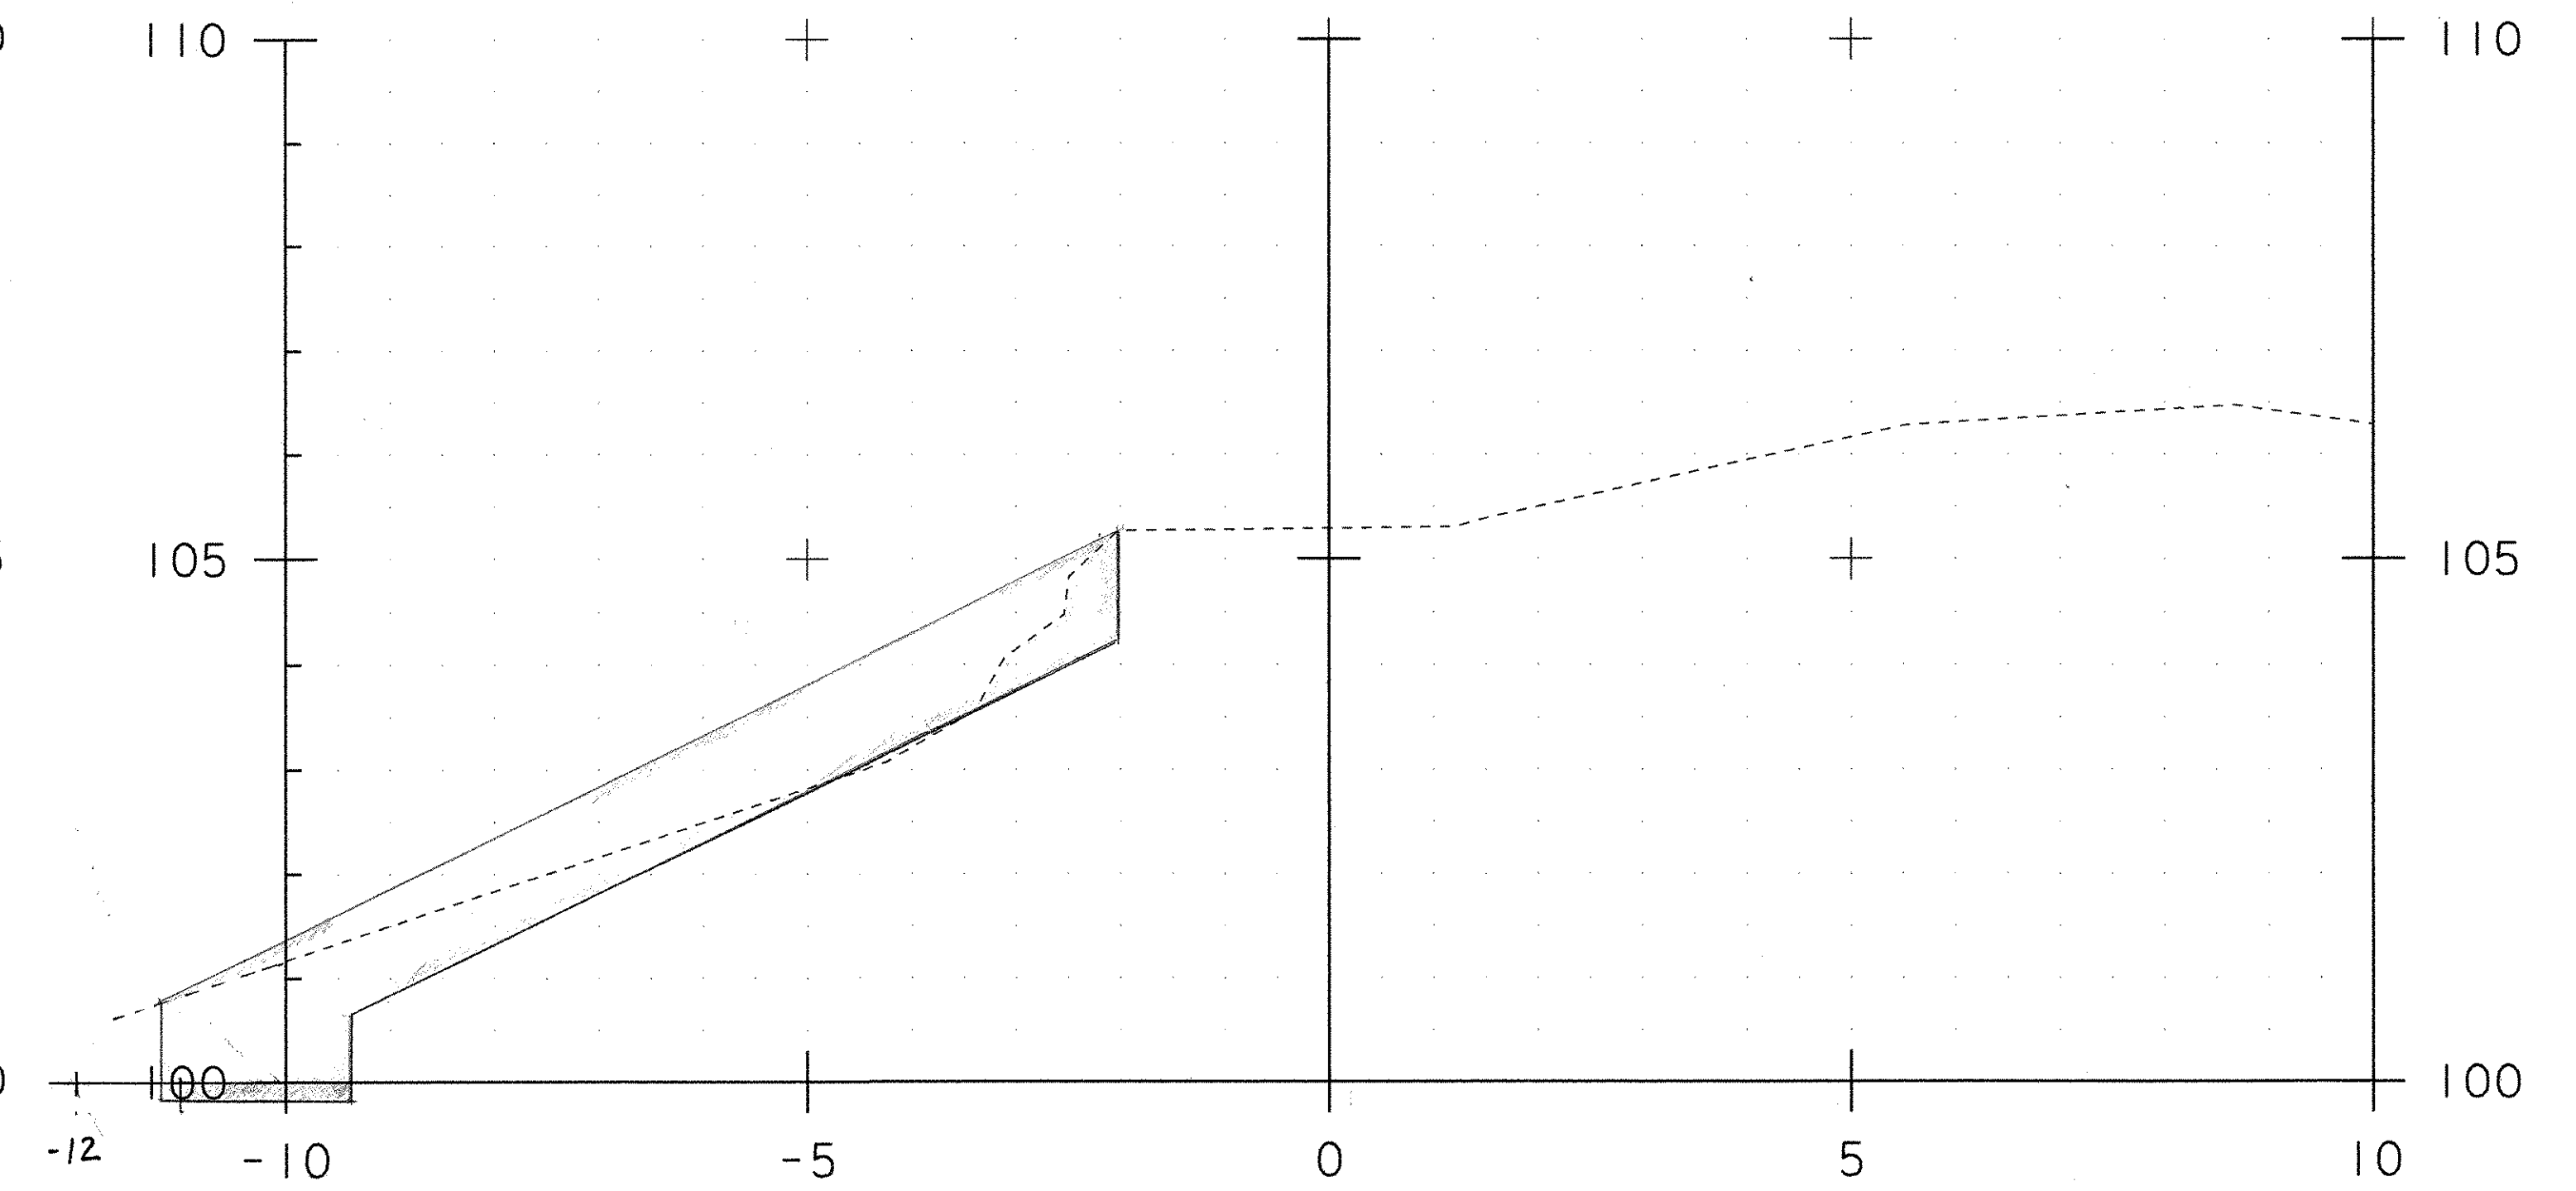

9+988.00

STONE FILL TYPE III - 9.83m³
 LINC CHAN EXC - 4.51m³
 GEO UNDER STONE FILL - 11.8m

PROJECT NAME:	Leicester	PLOT DATE:	01-NOV-2005
PROJECT NUMBER:	BRF 0160(3)S	DRAWN BY:	R. Bullock
FILE NAME:		CHECKED BY:	
PROJECT LEADER:		SHEET 1	OF 7
DESIGNED BY:	<i>ARB</i>		