


9+990.00

STONE FILL TYPE III - 13.37m²
 ONE COFFERDAM - 12.93m²
 GEO UNDER S.F - 16.05M

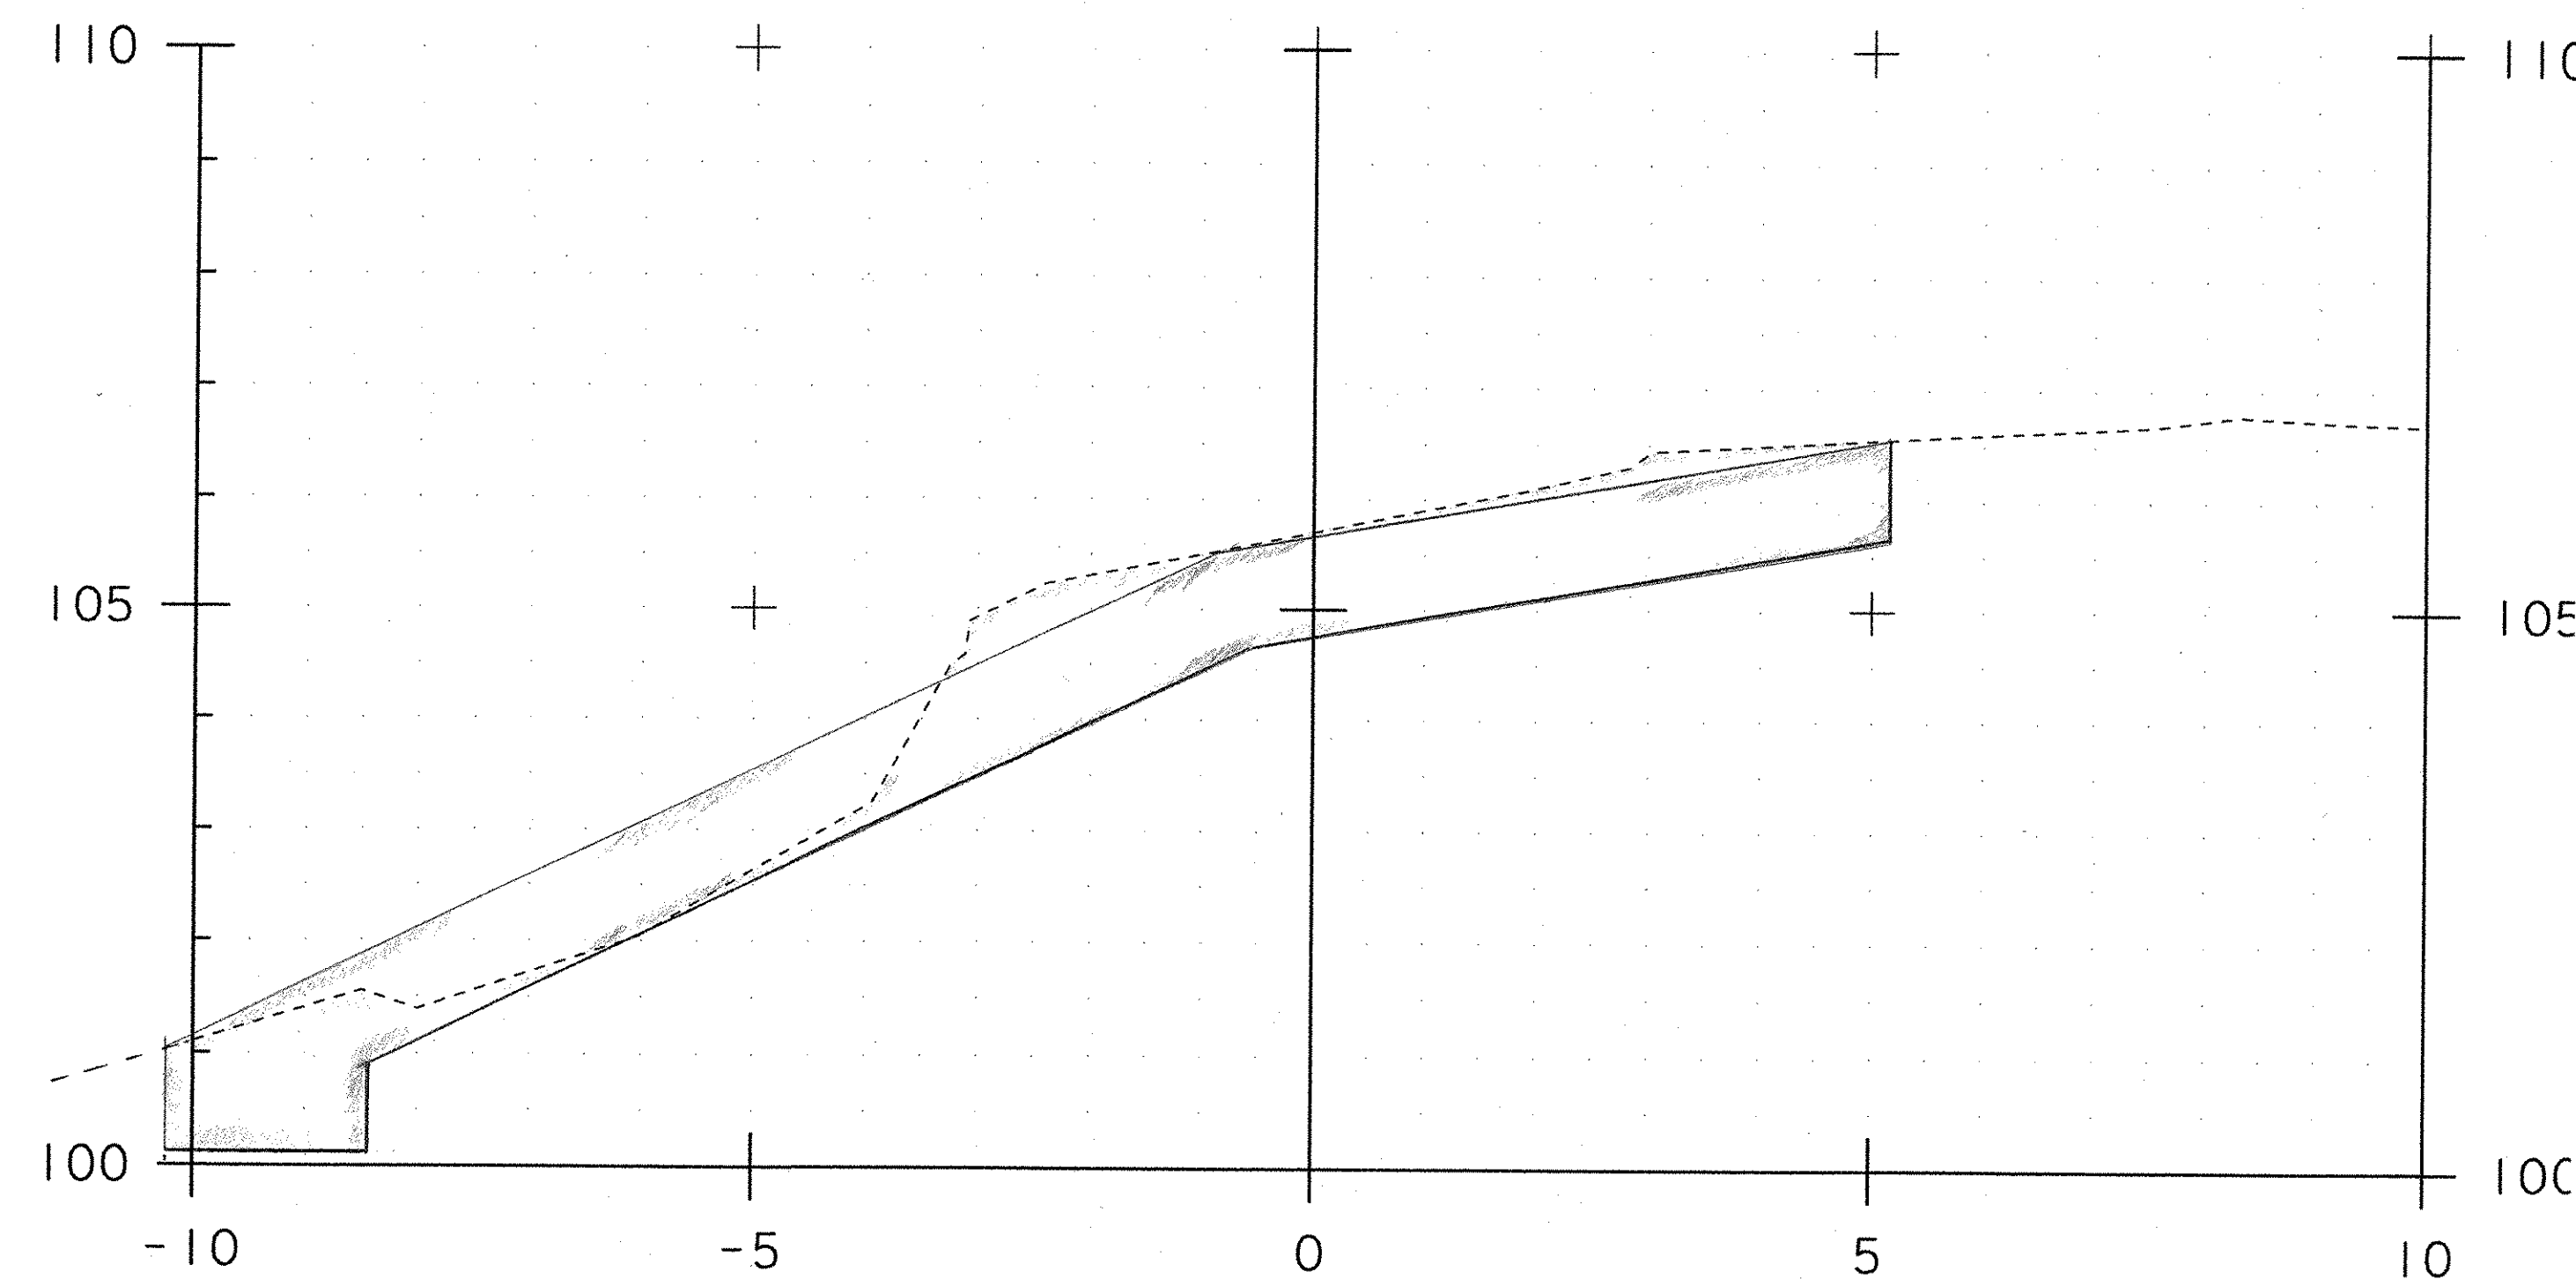

9+992.30

STONE FILL TYPE III - 15.93m²
 ONE COFFERDAM - 12.93m²
 GEO UNDER S.F - 18.3M

ZERO COFFERDAM
 ZERO GRAN. BACKFILL

~~HASE~~

PROJECT NAME:	Leicester	PLOT DATE:	01-NOV-2005
PROJECT NUMBER:	BRF 0160(3)S	DRAWN BY:	R. Bullock
FILE NAME:		CHECKED BY:	
PROJECT LEADER:		SHEET 2	OF 7
DESIGNED BY:	112132		