


EXC- E+R = 26.46 m^2
 STONE FILL TYPE III - 8.15 m^3
 GRANULAR BACKFILL - 5.67 m^3
 GEO UNDER S.F - 8.5 M

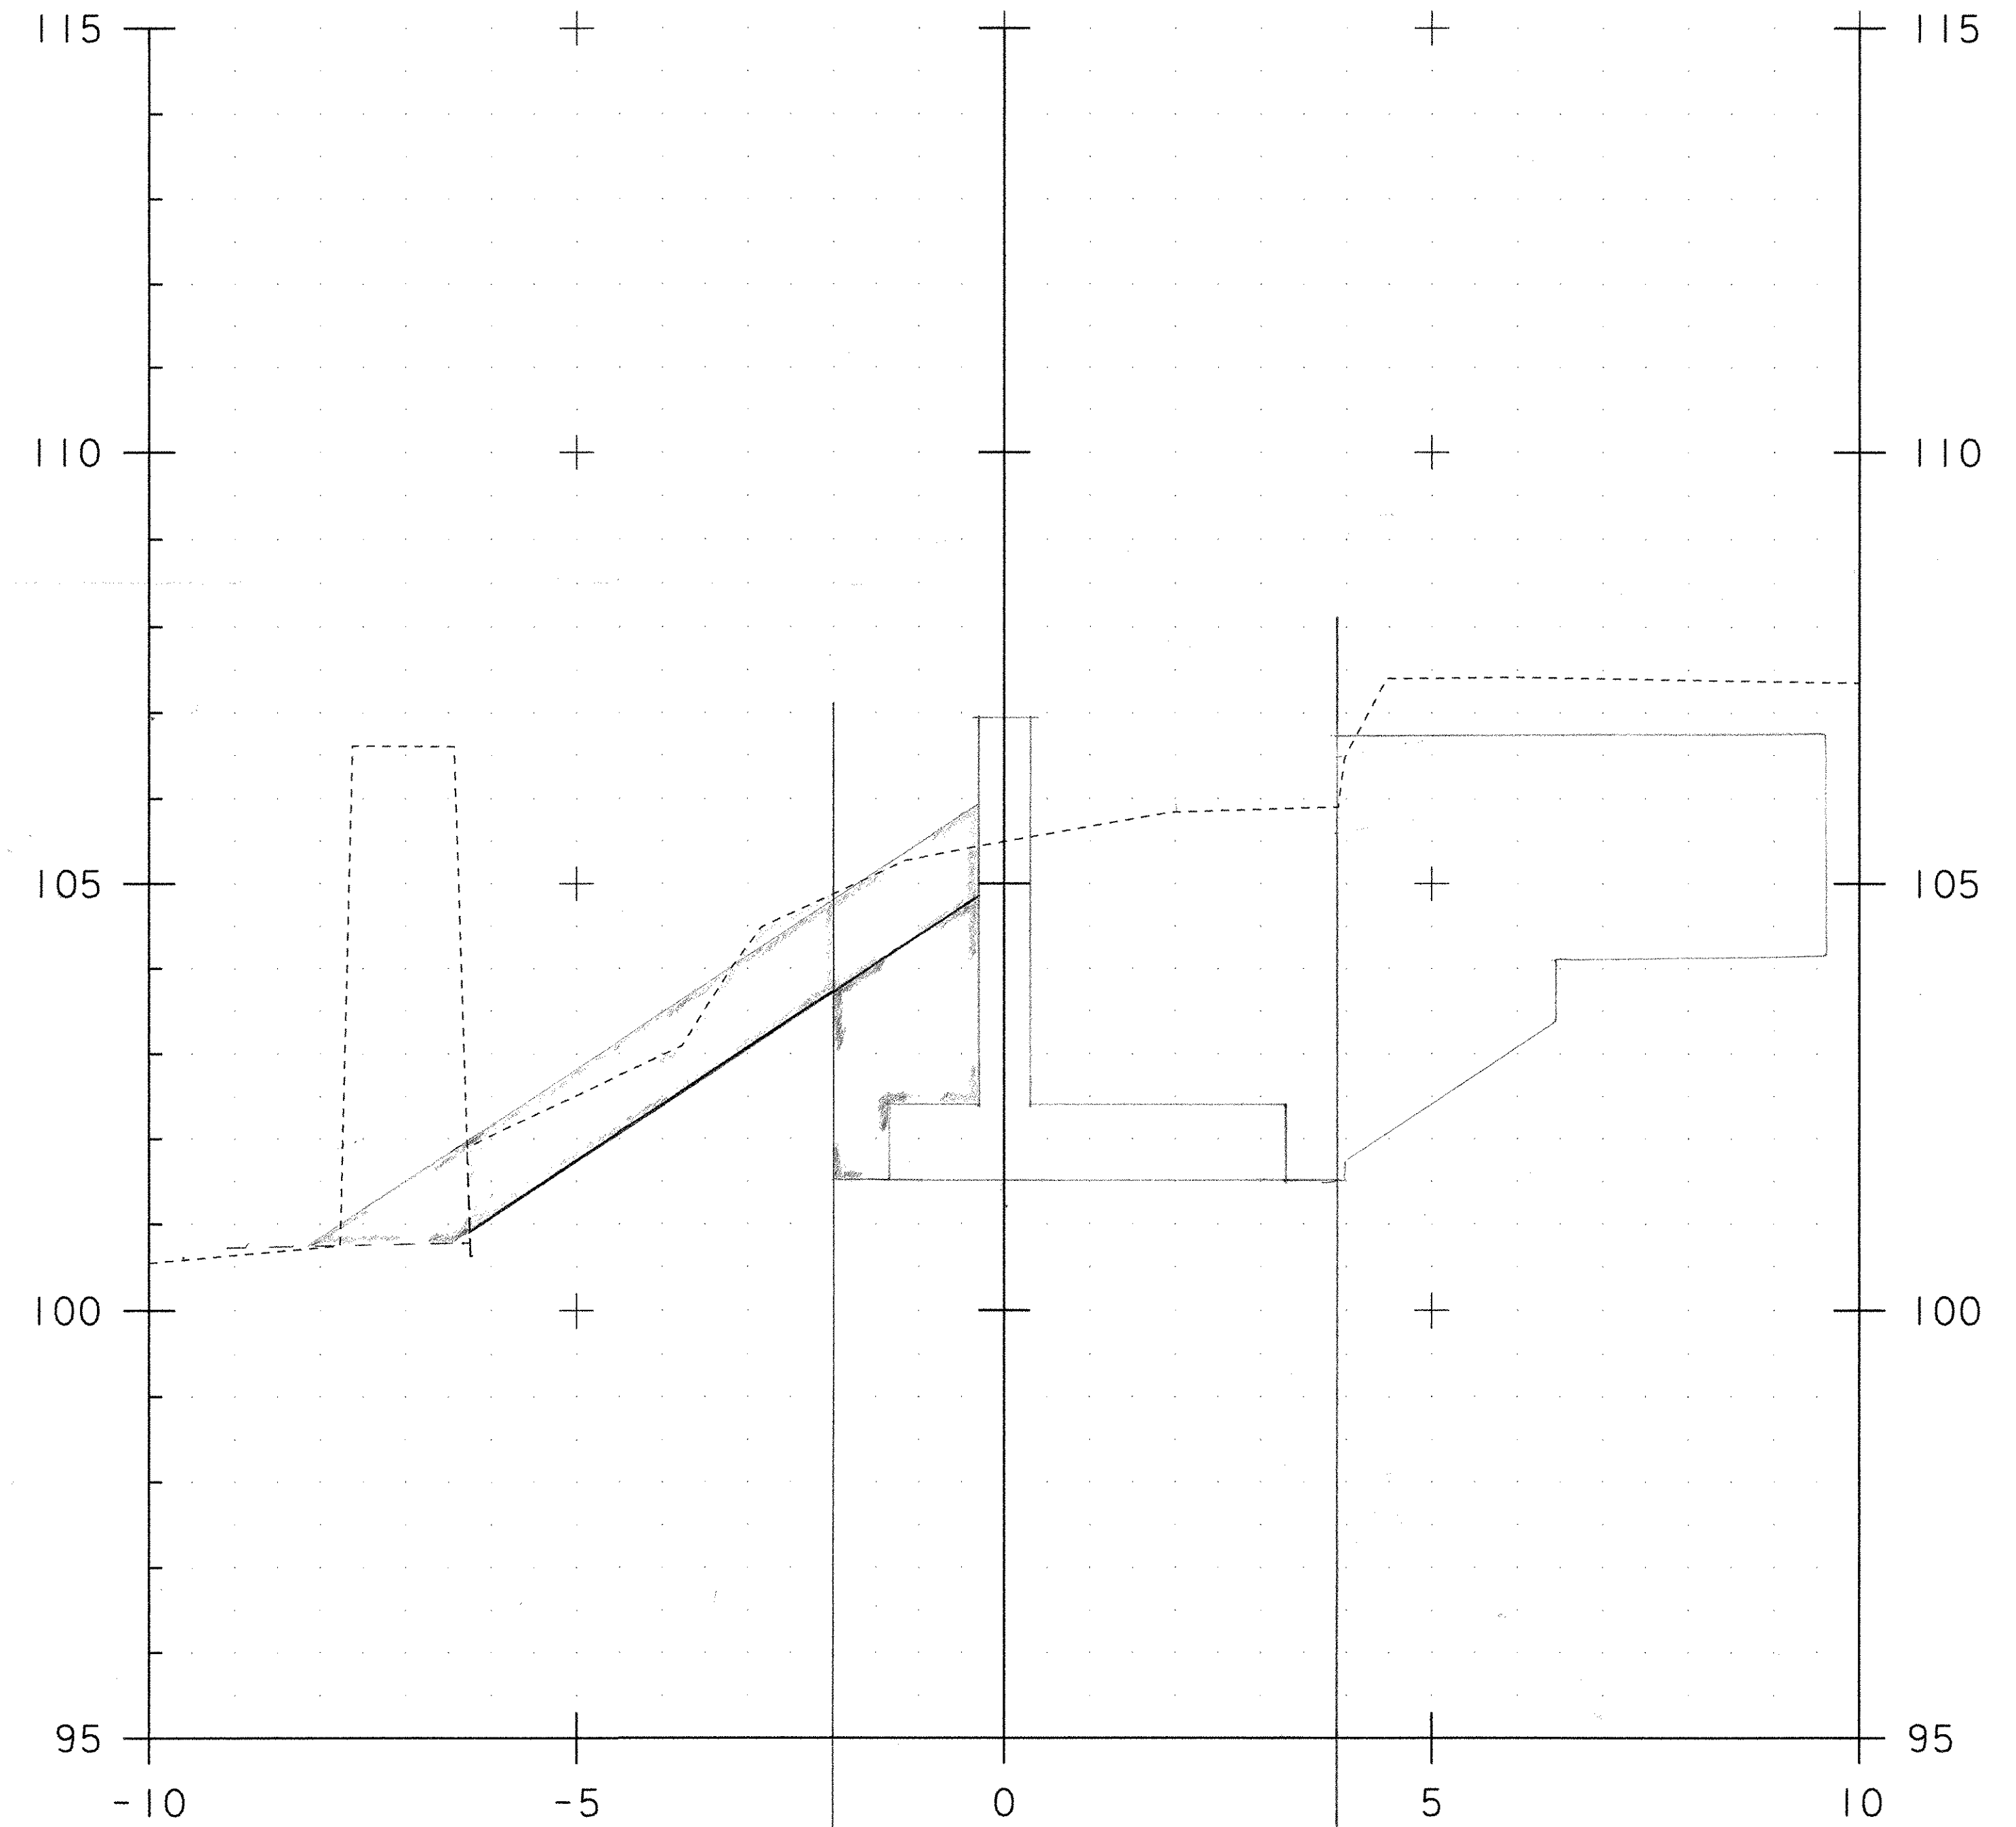

EXC- E+R = 24.11 m^2
 STONE FILL TYPE III - 7.45 m^3
 GRANULAR BACKFILL - 3.76 m^3
 GEO UNDER S.F - 7.1 M

PROJECT NAME:	Leicester	PLOT DATE:	01-NOV-2005
PROJECT NUMBER:	BRF 0160(3)S	DRAWN BY:	R. Bullock
FILE NAME:		CHECKED BY:	
PROJECT LEADER:		SHEET 3	OF 7
DESIGNED BY:			

117
 ABZ