


EXC - E+R = 15.12 m² *2/11/05* *1/20/05*
 9+998.00

STONE FILL TYPE III - 7.16 m³
 LIME STONE FILL - 3.97 m³
 GRANULAR BACKFILL - 3.58 m³
 GEO UNDER S.F - 7.3 M
 STRUCTURE EXC - 27.26 m³

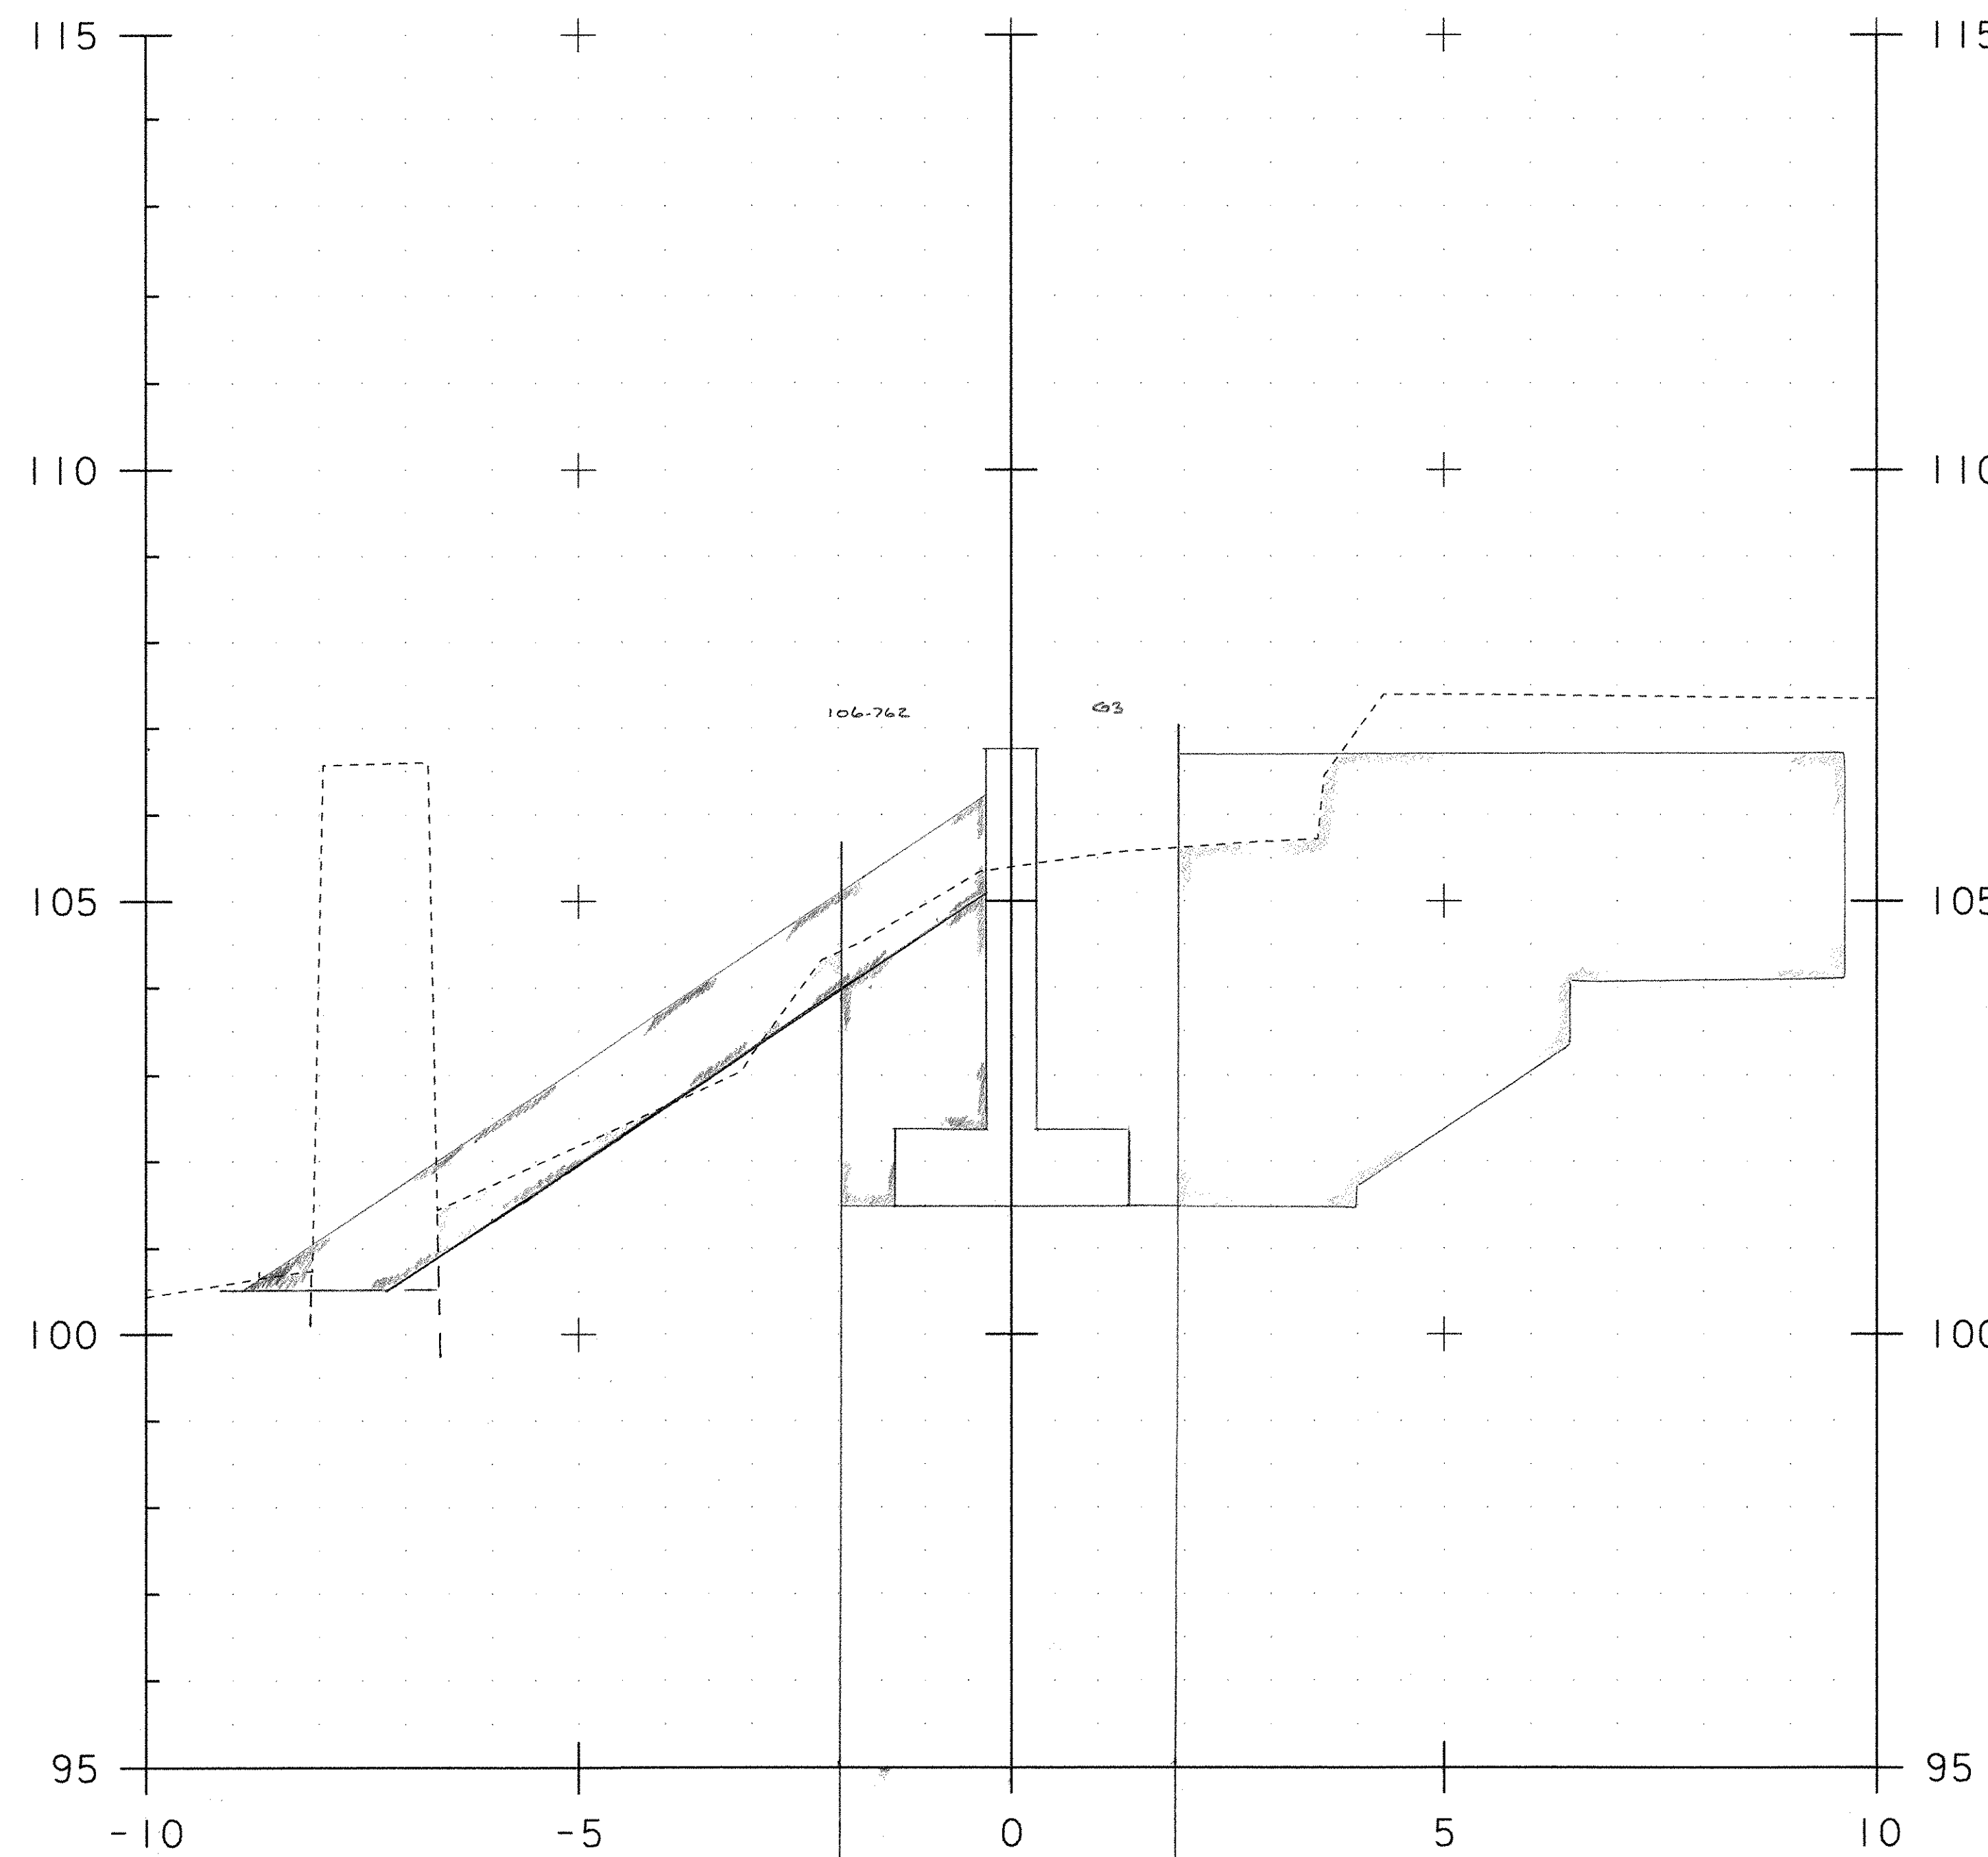

EXC - E+R = 14.64 m² *2/11/05* *1/20/05*
 10+000.00

STONE FILL TYPE III - 8.64 m³
 LIME STONE FILL - 4.0 m³
 GRANULAR BACKFILL - 4.09 m³
 GEO UNDER S.F - 8.3 M
 STRUCTURE EXC - 27.51 m³

PROJECT NAME:	Leicester	PLOT DATE:	01-NOV-2005
PROJECT NUMBER:	BRF 0160(3)S	DRAWN BY:	R. Bullock
FILE NAME:		CHECKED BY:	
PROJECT LEADER:		SHEET 4	OF 7
DESIGNED BY:	<i>120 ABZ</i>		