


Exc - E+R = 14.05 m^2 *old*
 STONE FILL TYPE III = 7.39 m^2
 SAND BACKFILL = 3.73 m^2
 GEO UNDER S.F = 10.0 M
 STRUCTURE EX = 27.59 M

10+002.00

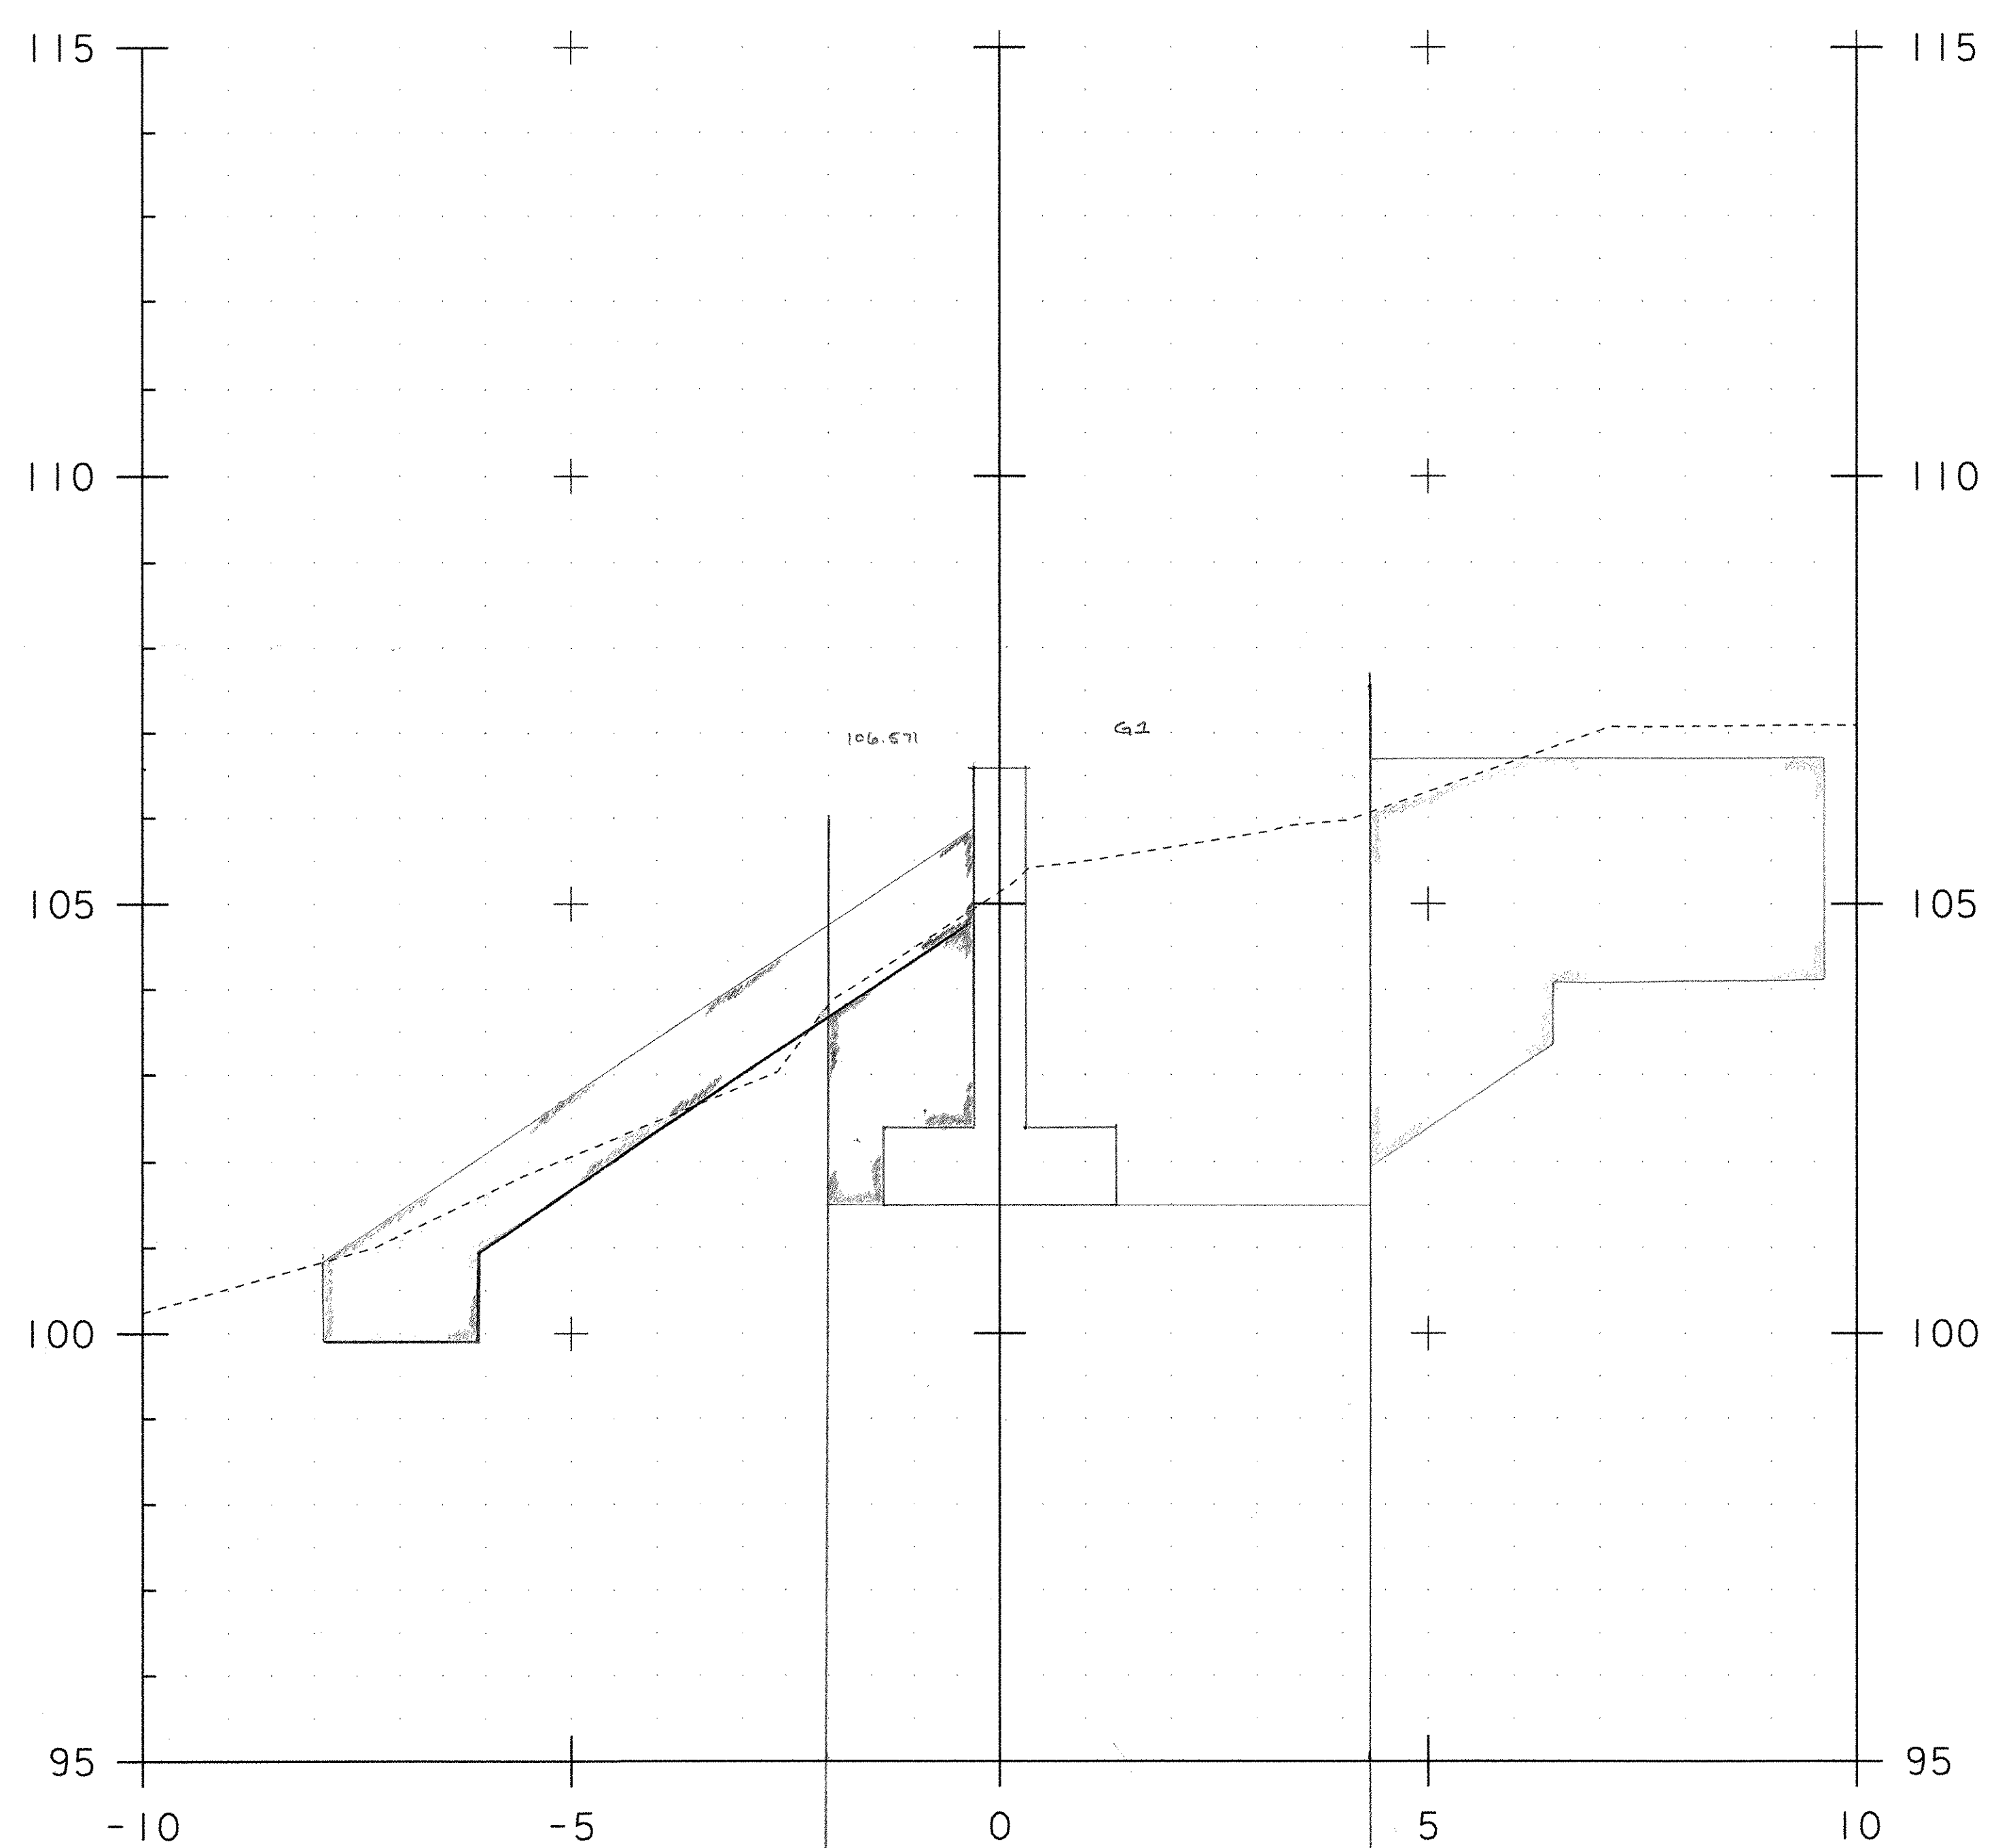

Exc - E+R = 24.03 m^2 *old*
 STONE FILL TYPE III = 8.08 m^2
 SAND BACKFILL = 6.66 m^2
 GEO UNDER S.F = 9.7 M
 STRUCTURE EX = 19.8 M

10+004.00

COFFERDAM Full width (+ wing)

PROJECT NAME:	Leicester	PLOT DATE:	01-NOV-2005
PROJECT NUMBER:	BRF 0160(3)S	DRAWN BY:	R. Bullock
FILE NAME:		CHECKED BY:	
PROJECT LEADER:		SHEET 5	OF 7
DESIGNED BY:			

128A42