


Exc - E+R = 22.12 m^2 *JL* *10/11/05* 10+006.00 * COFFERDAM EXC ONLY

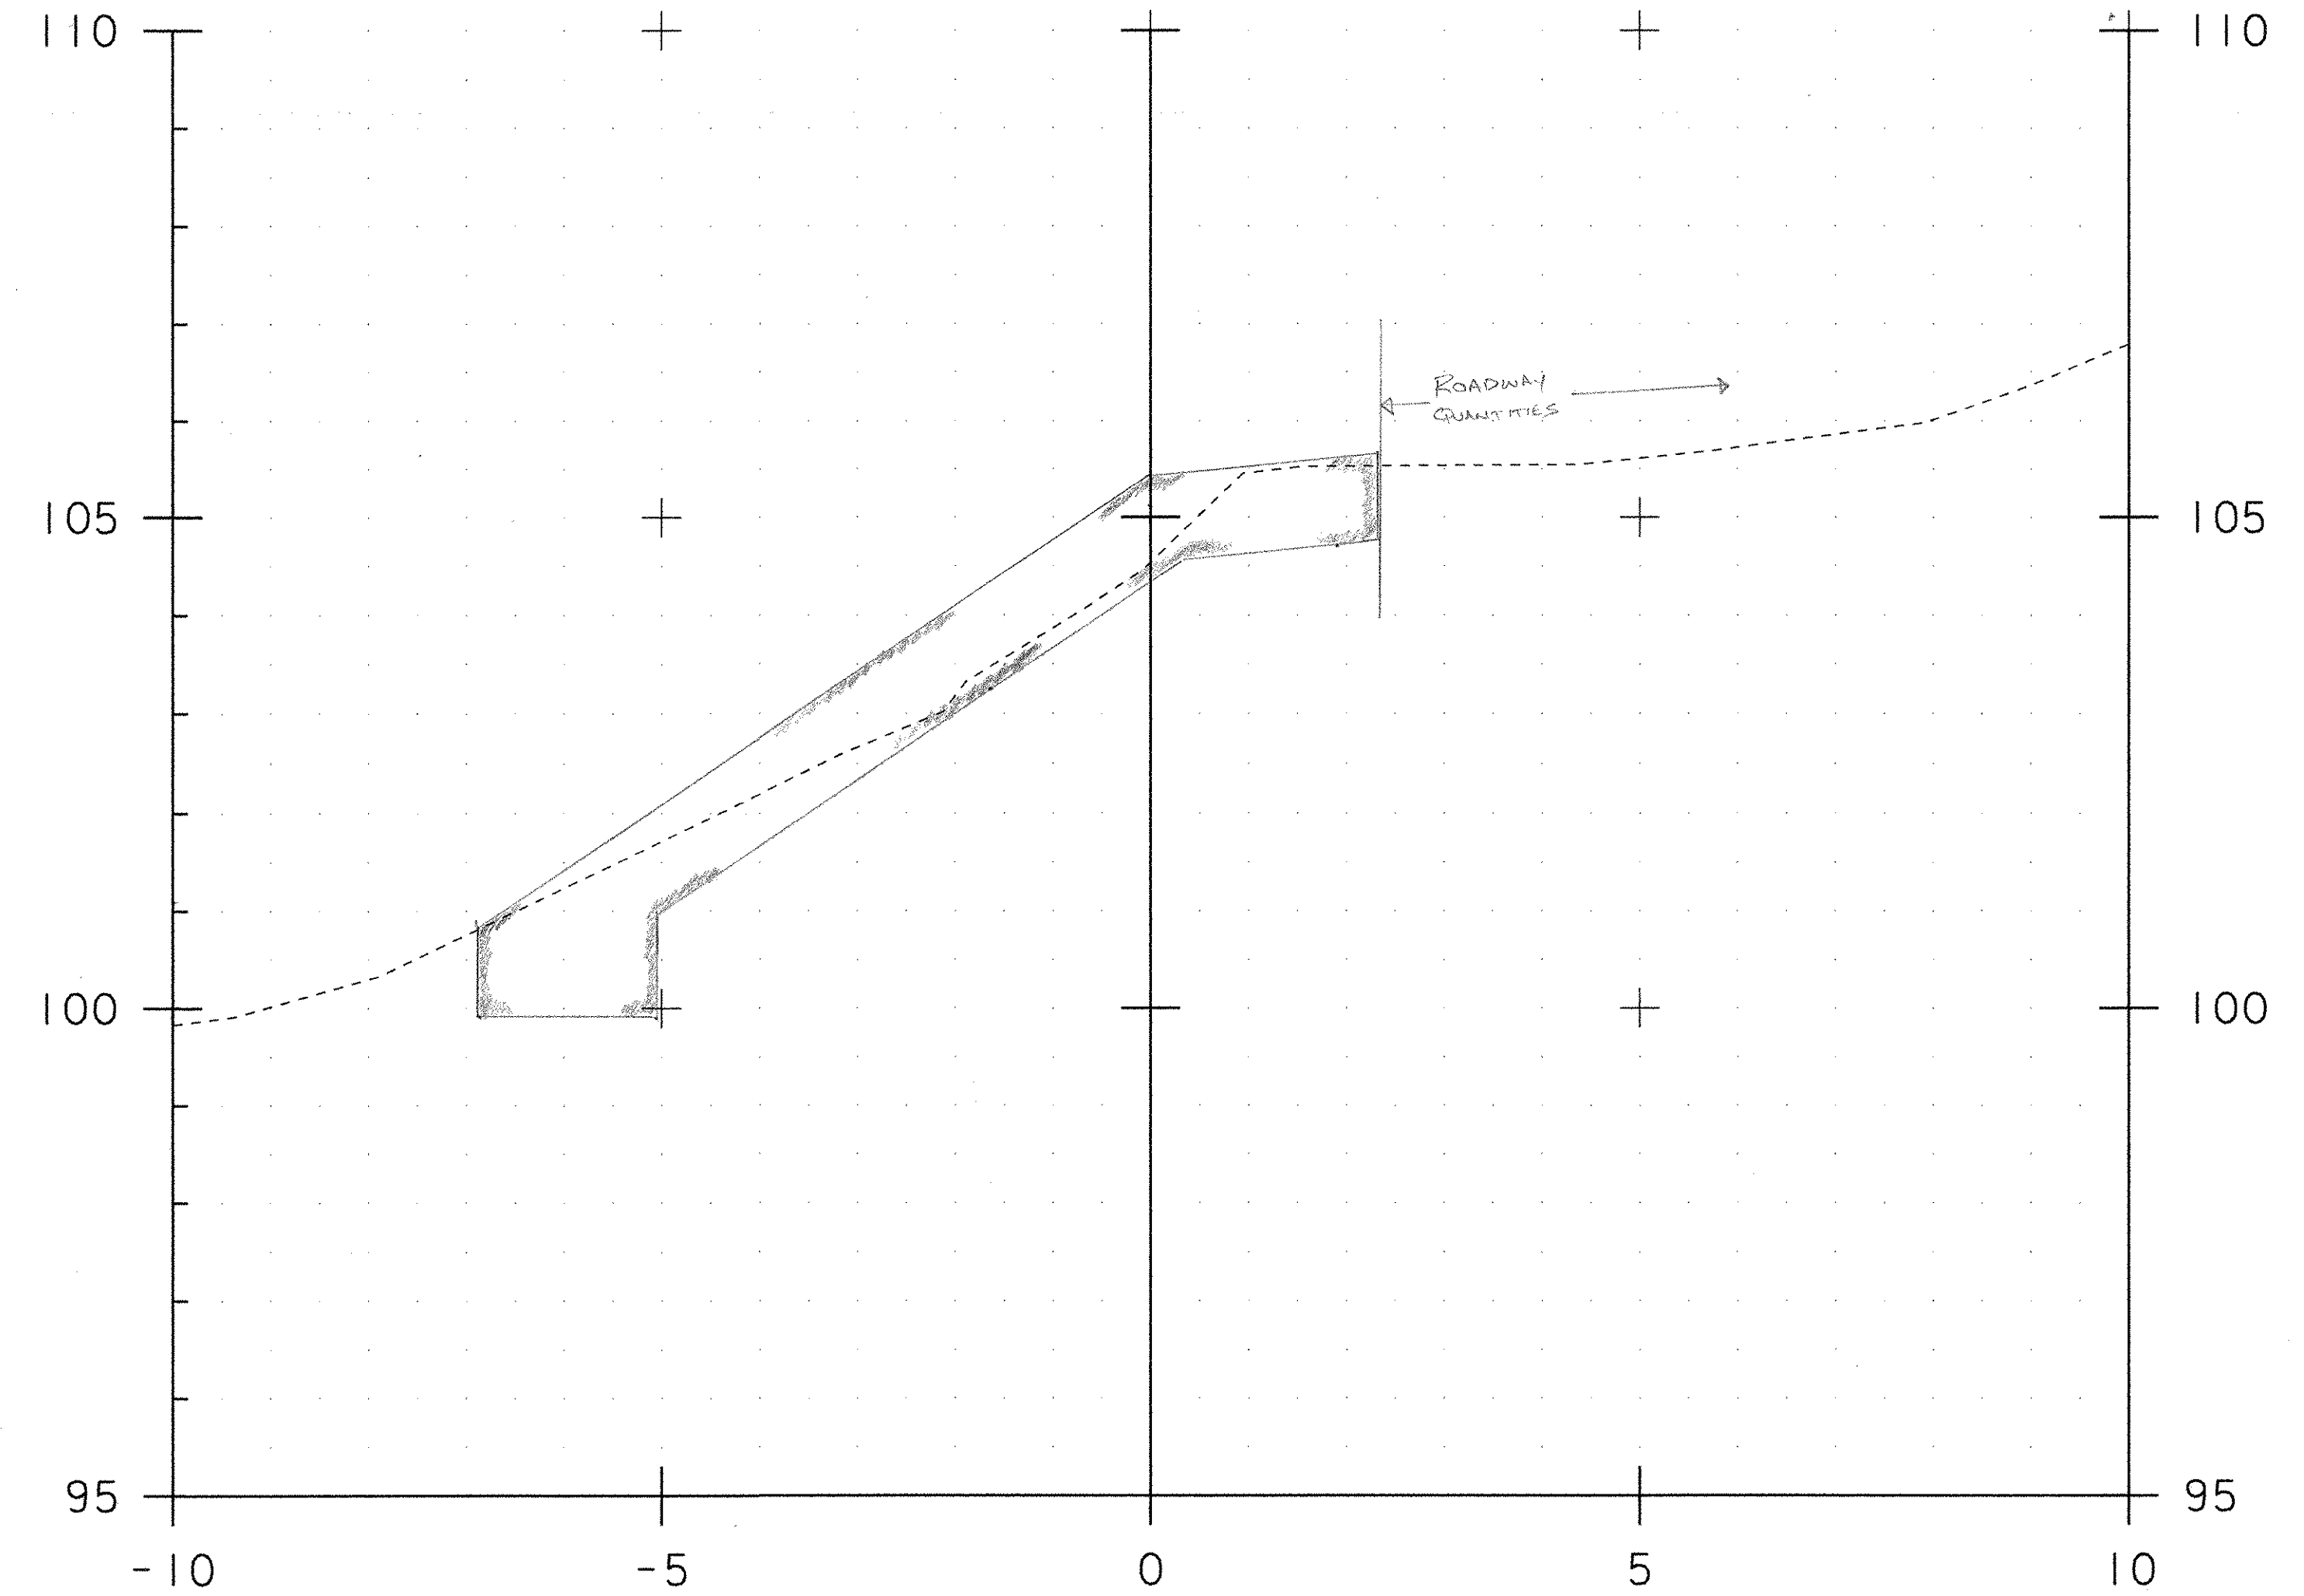

STONE FILL TYPE III - 10.28 m^2 10+008.00

PROJECT NAME:	Leicester	PLOT DATE:	01-NOV-2005
PROJECT NUMBER:	BRF 0160(3)S	DRAWN BY:	R. Bullock
FILE NAME:		CHECKED BY:	
PROJECT LEADER:		DESIGNED BY:	
			SHEET 6 OF 7

129/103