


10+010.00

(BUTT) STONE FILL TYPE III - 7.81M²

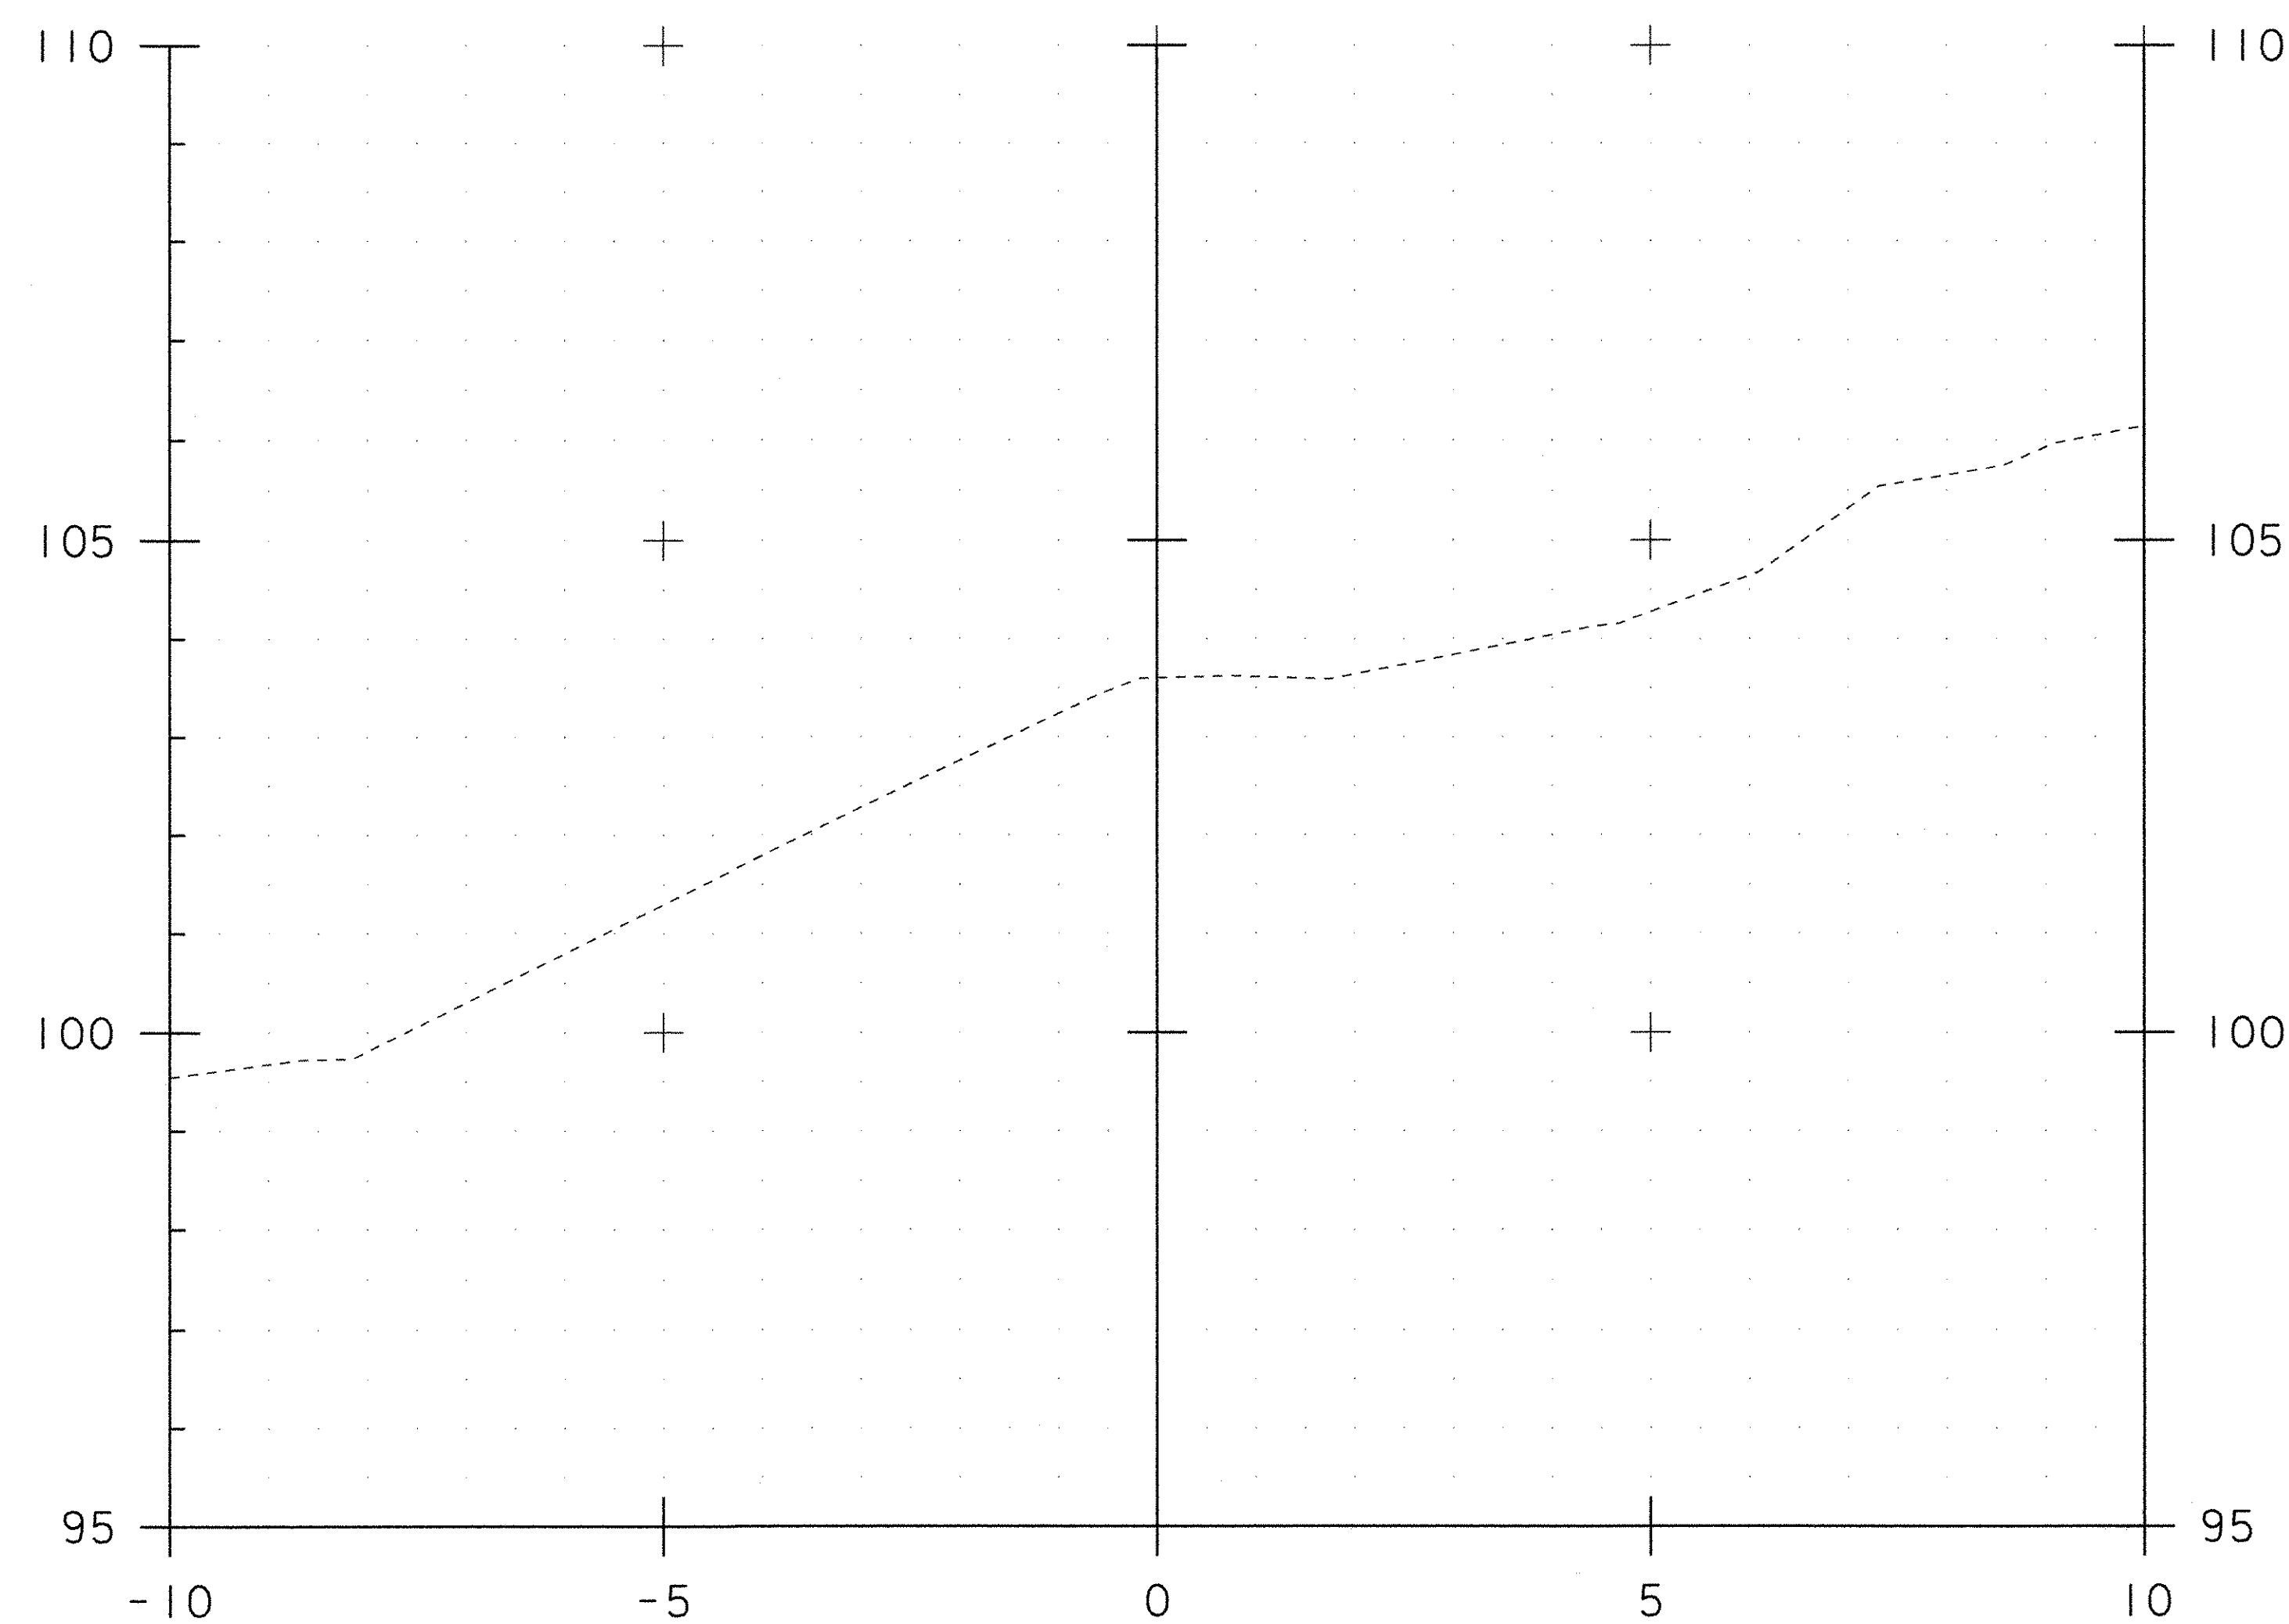

10+012.00

PROJECT NAME:	Leicester	PLOT DATE:	01-NOV-2005
PROJECT NUMBER:	BRF 0160(3)S	DRAWN BY:	R. Bullock
FILE NAME:		CHECKED BY:	
PROJECT LEADER:		SHEET 8	OF 8
DESIGNED BY:			

13
AB2