



CAMBER DIAGRAM FOR 1G1 THRU 5G5

MARK	BL	LE	RE	WL2	WX1	WX2
1G1	33 482	24	12	22 082	11 625	22 295
2G2	33 482	22	14	22 082	11 623	22 297
3G3	33 483	20	15	22 083	11 621	22 299
4G4	33 482	19	17	22 083	11 619	22 301
5G5	33 482	17	19	22 082	11 618	22 302

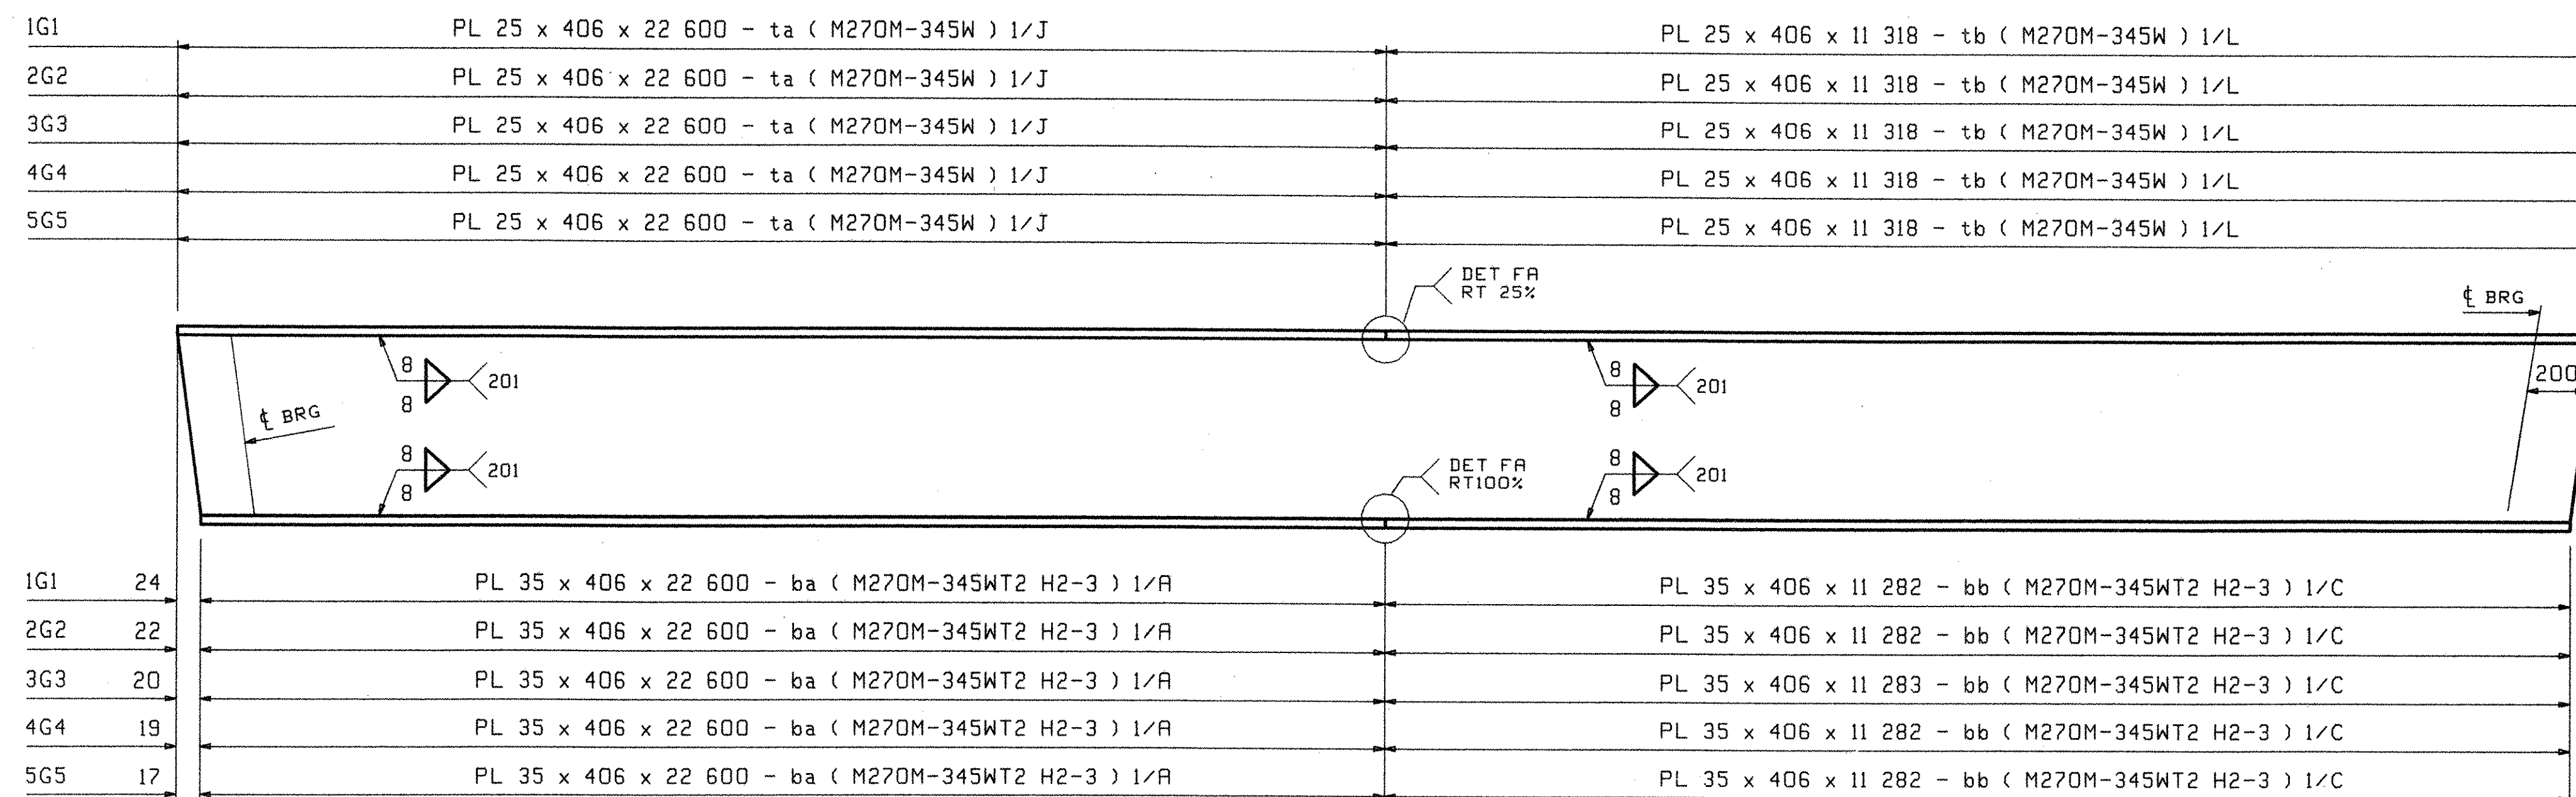

FLANGE DIAGRAM FOR 1G1 THRU 5G5

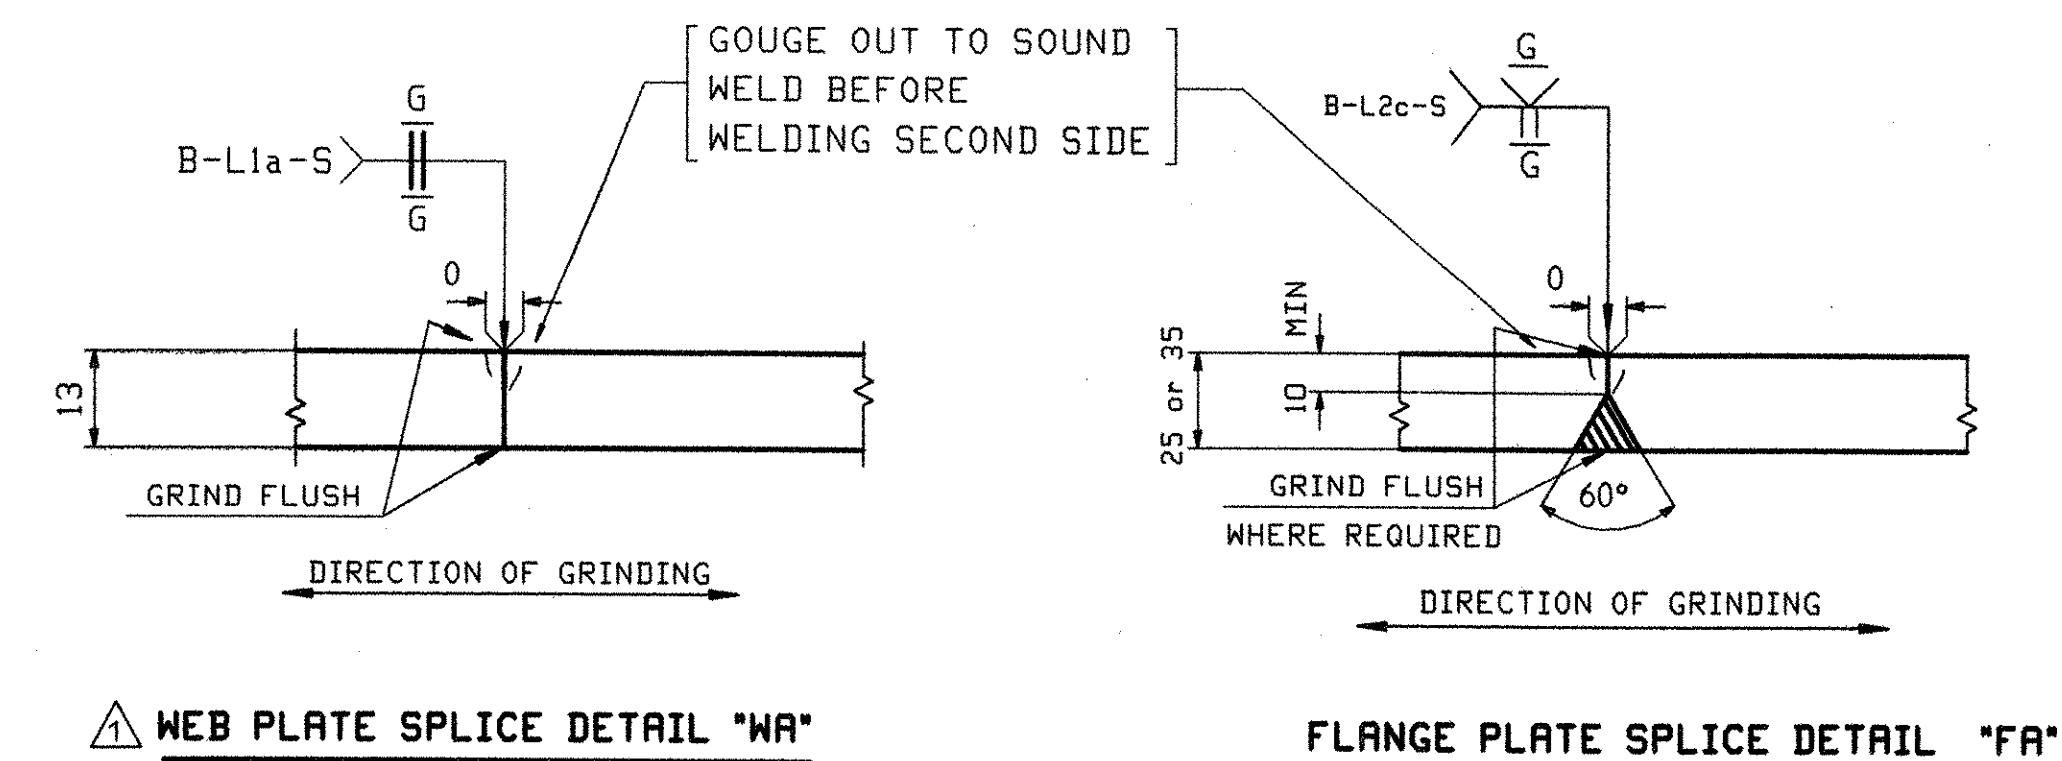

WEB PLATE SPLICE DETAIL "WA"

FLANGE PLATE SPLICE DETAIL "FA"

OUT FOR APPROVAL	2-26-05																		
ISSUED TO SHOP	2-27-06																		
FIELD & OFFICE																			
APPROVAL COMMENTS	2/21	JTB	ELC																
REV.	REMARKS	DATE	DWN	CHK	APP	Q.A.	NO.	DIA.	LGT	TYPE	WASHER								
MATERIAL:	M270M-345W (UN)	ELECTRODES:		HOLE:		SHOP BOLTS:													
SURFACE PREP. & PRINT:																			
SEE DRAWING GNI																			
DESCRIPTION:	CAMBER & FLANGE DIAGRAMS										DRAWN BY	DATE							
JOB:	TH 1 (FAS 160) OVER OTTER CREEK BRIDGE NO. 6 TOWN OF LEICESTER, VERMONT COUNTY OF ADDISON CONTRACTOR: BLOW & COTE										JTB	11/08							
											CHKD BY								
											ELC	12/06							
											APPROV BY								
											SUPERVISOR	W. J. GATTI							
PROJ NO.	BRF 0160(3)S										Q.A.								
CUSTOMER: VT ROT																			
<b>CASCO BAY STEEL STRUCTURES, INC.</b>															JOB NO.	DRG. NO.			
75 SPRING HILL ROAD SACO, MAINE 04072															285	C1			
PHONE (207) 282-7360 FAX. (207) 282-1179															REV.	△			

RECEIVED  
 OK'D BY: JTB OK'D BY: [Signature]  
 MAR 03 2006  
 RESUBMIT APPROVED  
 BY: [Signature] DATE: 3/16/06

NOTES:  
 1. FOR GENERAL NOTES AND WELD DETAILS SEE DWG GNI.  
 2. H2-3 DENOTES MATERIAL SUBJECT TO CHARPY V-NOTCH TEST AT H FREQ. FOR ZONE 2