
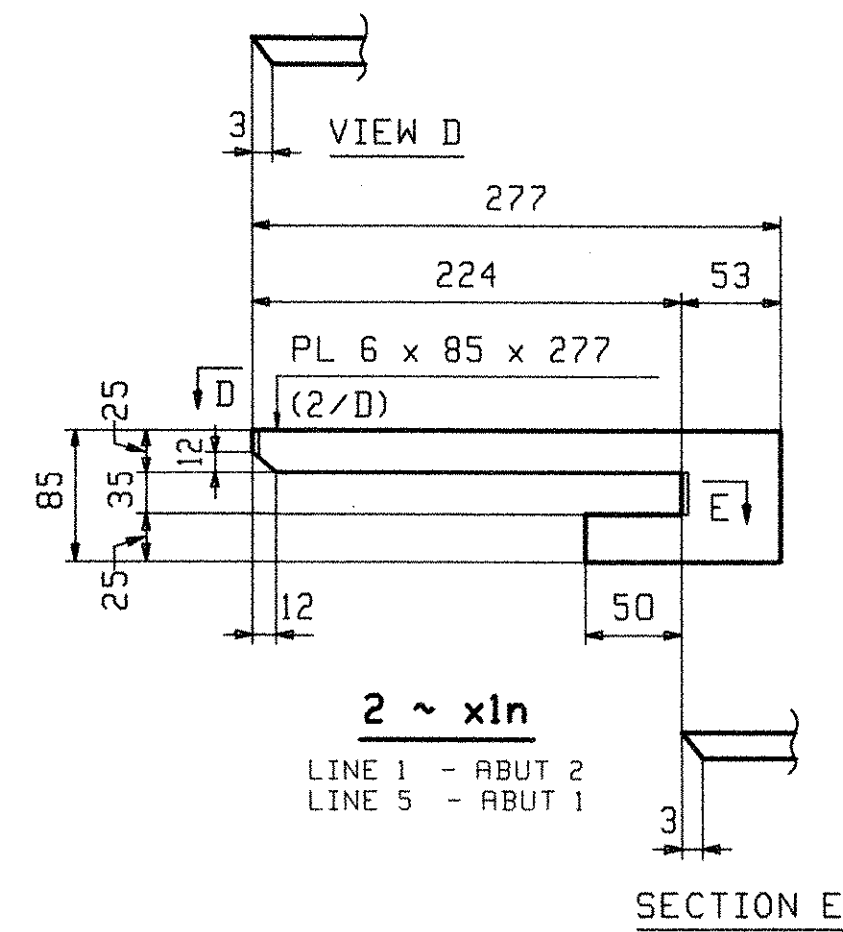


MARK "A"	QTY	(A)	
x1c	16	325	HIGH END
x1d	4	266	DROP - 59
x1f	4	256	DROP - 69
x1g	4	247	DROP - 78
x1k	4	236	DROP - 89 Δ

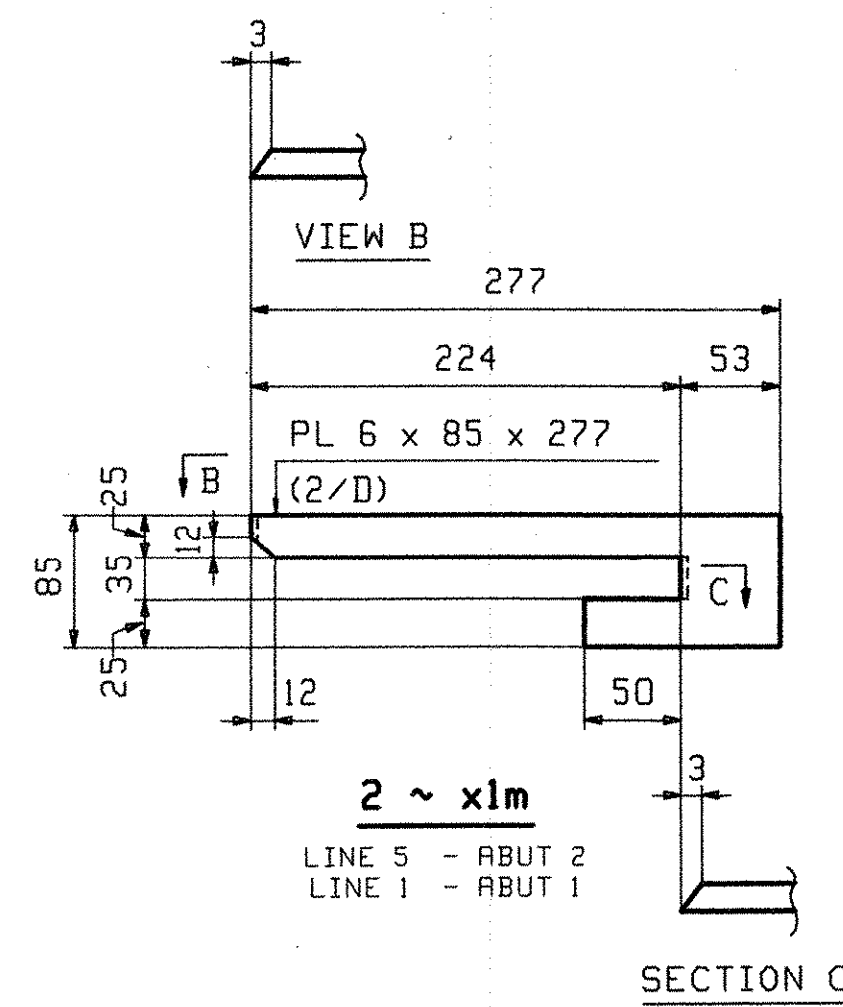

NOTES:
ALL MATERIAL SHALL BE M270M-345W,
ALL BOLT HOLES SHALL BE $\frac{15}{16}$ " ϕ FOR $\frac{7}{8}$ " HSB.
FOR GENERAL NOTES SEE SHEET GNI.

OUT FOR APPROVAL	12-28-05										
OUT FOR APPROVAL	2-27-06										
ISSUED TO SHOP											
FIELD & OFFICE											
Δ APPROVAL COMMENTS	2/21	JTB	ELC								
REV.	REMARKS	DATE	DWN	CHK	APP	Q.A.	NO.	DIA.	LGT	TYPE	WASHER
MATERIAL:	M270M-345W	ELECTRODES:		HOLES:	$\frac{15}{16}$ " ϕ	SHOP BOLTS:	NONE				
SURFACE PREP. & PAINT: SEE DRAWING GNI											
DESCRIPTION:	GIRDER STANDARDS							DRAWN BY	DATE		
JOB:	TH 1 (FAS 160) OVER OTTER CREEK							JTB	11/08		
	BRIDGE NO. 6							CHKD BY			
	TOWN OF LEICESTER, VERMONT							ELC	12/06		
	COUNTY OF ADDISON							APPROV BY			
	CONTRACTOR: BLOW & COTE							SUPERVISOR	W. J. GATTI		
PROJ NO.	BRF D160(3)S							Q.A.			
CUSTOMER: VT AOT											
CASCO BAY STEEL STRUCTURES, INC.											
75 SPRING HILL ROAD	SACO, MAINE 04072					JOB NO.	DRG. NO.				
PHONE (207) 282-7360	FAX. (207) 282-1179					285	X1				
										REV.	Δ

RECEIVED
CK'D BY: *[Signature]* OK'D BY: _____
MAR 03 2006
RESUBMIT: _____ APPROVED: _____
BY: *[Signature]* DATE: 3/6/06