


ONE - GIRDER - 5G5
 FOR GIRDER STANDARD DETAILS SEE DRAWING XI.
 FOR CAMBER DIAGRAM SEE DRAWING C1.
 FOR GENERAL NOTES SEE DRAWING GNI.
 H2-3 DENOTES MATERIAL SUBJECT TO CHARPY V-NOTCH TESTING.

ABM INFO		BILL OF MATERIAL				JOB NO.	DRAWING NO.	REV.	
PAGE	LINE	MARK	QTY	MARK	MATERIAL	LENGTH	REMARKS	WT	PROCUREMENT NOTES
						m			
		5G5	1		GIRDER				1981 kg 2208 lb
1	G		1	wa	PL 13x1220	11 618	(H270M-345HT2)		(H2-3)
1	E		1	wb	PL 13x1220	22 302	(H270M-345HT2)		(H2-3)
1	J		1	ta	PL 25x406	22 600			
1	L		1	tb	PL 25x406	11 318			
1	A		1	ba	PL 35x406	22 600	(H270M-345HT2)		(H2-3)
1	C		1	bb	PL 35x406	11 282	(H270M-345HT2)		(H2-3)
2	B		2	x1a	PL 22x220	1 220			MIE
2	B		2	x1b	PL 22x220	1 220			MIE
2	C		4	x1c	PL 13x178	1 220			
2	D		1	x1m	PL 6x85	0 277			
2	D		1	x1n	PL 6x85	0 277			

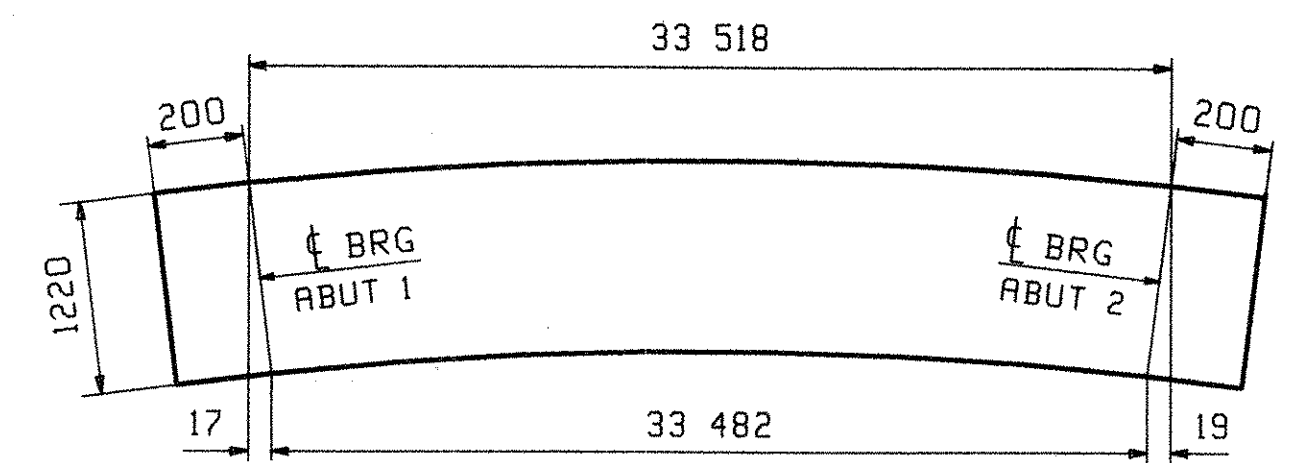

ORIENTATION DIAGRAM
 FOR CAMBER SEE DWG C1

OUT FOR APPROVAL	12-22-05								
OUT FOR APPROVAL	2-27-06								
ISSUED TO SHOP									
FIELD & OFFICE									

REV.	REMARKS	DATE	DWN	CHK	APP	Q.A.	NO.	DIA.	LGT	TYPE	WASHER
	MATERIAL:										
	M270M GR 345W										
	ELECTRODES:										
	HOLES:										
	15										
	16Ø (UN)										
	SHOP BOLTS:										
	NONE										

SURFACE PREP. & PAINT:
 SEE DRAWING GNI

DESCRIPTION:	GIRDER - 5G5	DRAWN BY	DATE
JOB:	TH 1 (FAS 160) OVER OTTER CREEK	JTB	11/08
	BRIDGE NO. 6	CHKD BY	
	TOWN OF LEICESTER, VERMONT	ELC	12/06
	COUNTY OF ADDISON	APPROV BY	
	CONTRACTOR: BLOW & COTE	SUPERVISOR	W. J. GATTI
PROJ NO.	BRF 0160(3)S	Q.A.	
CUSTOMER:	VT ROT		
CASCO BAY STEEL STRUCTURES, INC.		JOB NO.	DRG. NO.
75 SPRING HILL ROAD	SACO, MAINE 04072	285	5
PHONE (207) 282-7360	FAX. (207) 282-1179	REV.	△

RECEIVED
 OK'D BY: [Signature]
 MAR 03 2006
 RESUBMIT APPROVED
 BY: KRW DATE: 3/6/06