



SEE SHEET 2 FOR INDEX OF SHEETS
AND LIST OF STANDARDS.

RECORD PLANS	
CONTRACTOR:	BLOW & COTE - MORRISVILLE, VT
RESIDENT ENGINEER:	DAVID HOSKING
CONSTRUCTION BEGAN:	OCTOBER 31, 2005
CONSTRUCTION COMPLETE:	JUNE 29, 2007
RECORD PLANS BY:	DAVID HOSKING & JUDY GILMORE
I HEREBY CERTIFY THAT ALL THE CONSTRUCTION REQUIRED BY THIS SET OF DRAWINGS HAS BEEN ACCOMPLISHED AS INDICATED HEREIN.	
BY <i>David Hosking</i>	RESIDENT ENGINEER
DATE <i>JUNE 23, 2008</i>	
NOTE: Any further information concerning final quantities, amounts or other details relative to this project may be found at Central Files in the electronic archives.	

STATE OF VERMONT AGENCY OF TRANSPORTATION

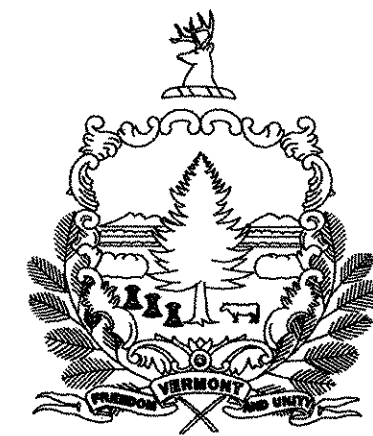

PROPOSED IMPROVEMENT BRIDGE PROJECT

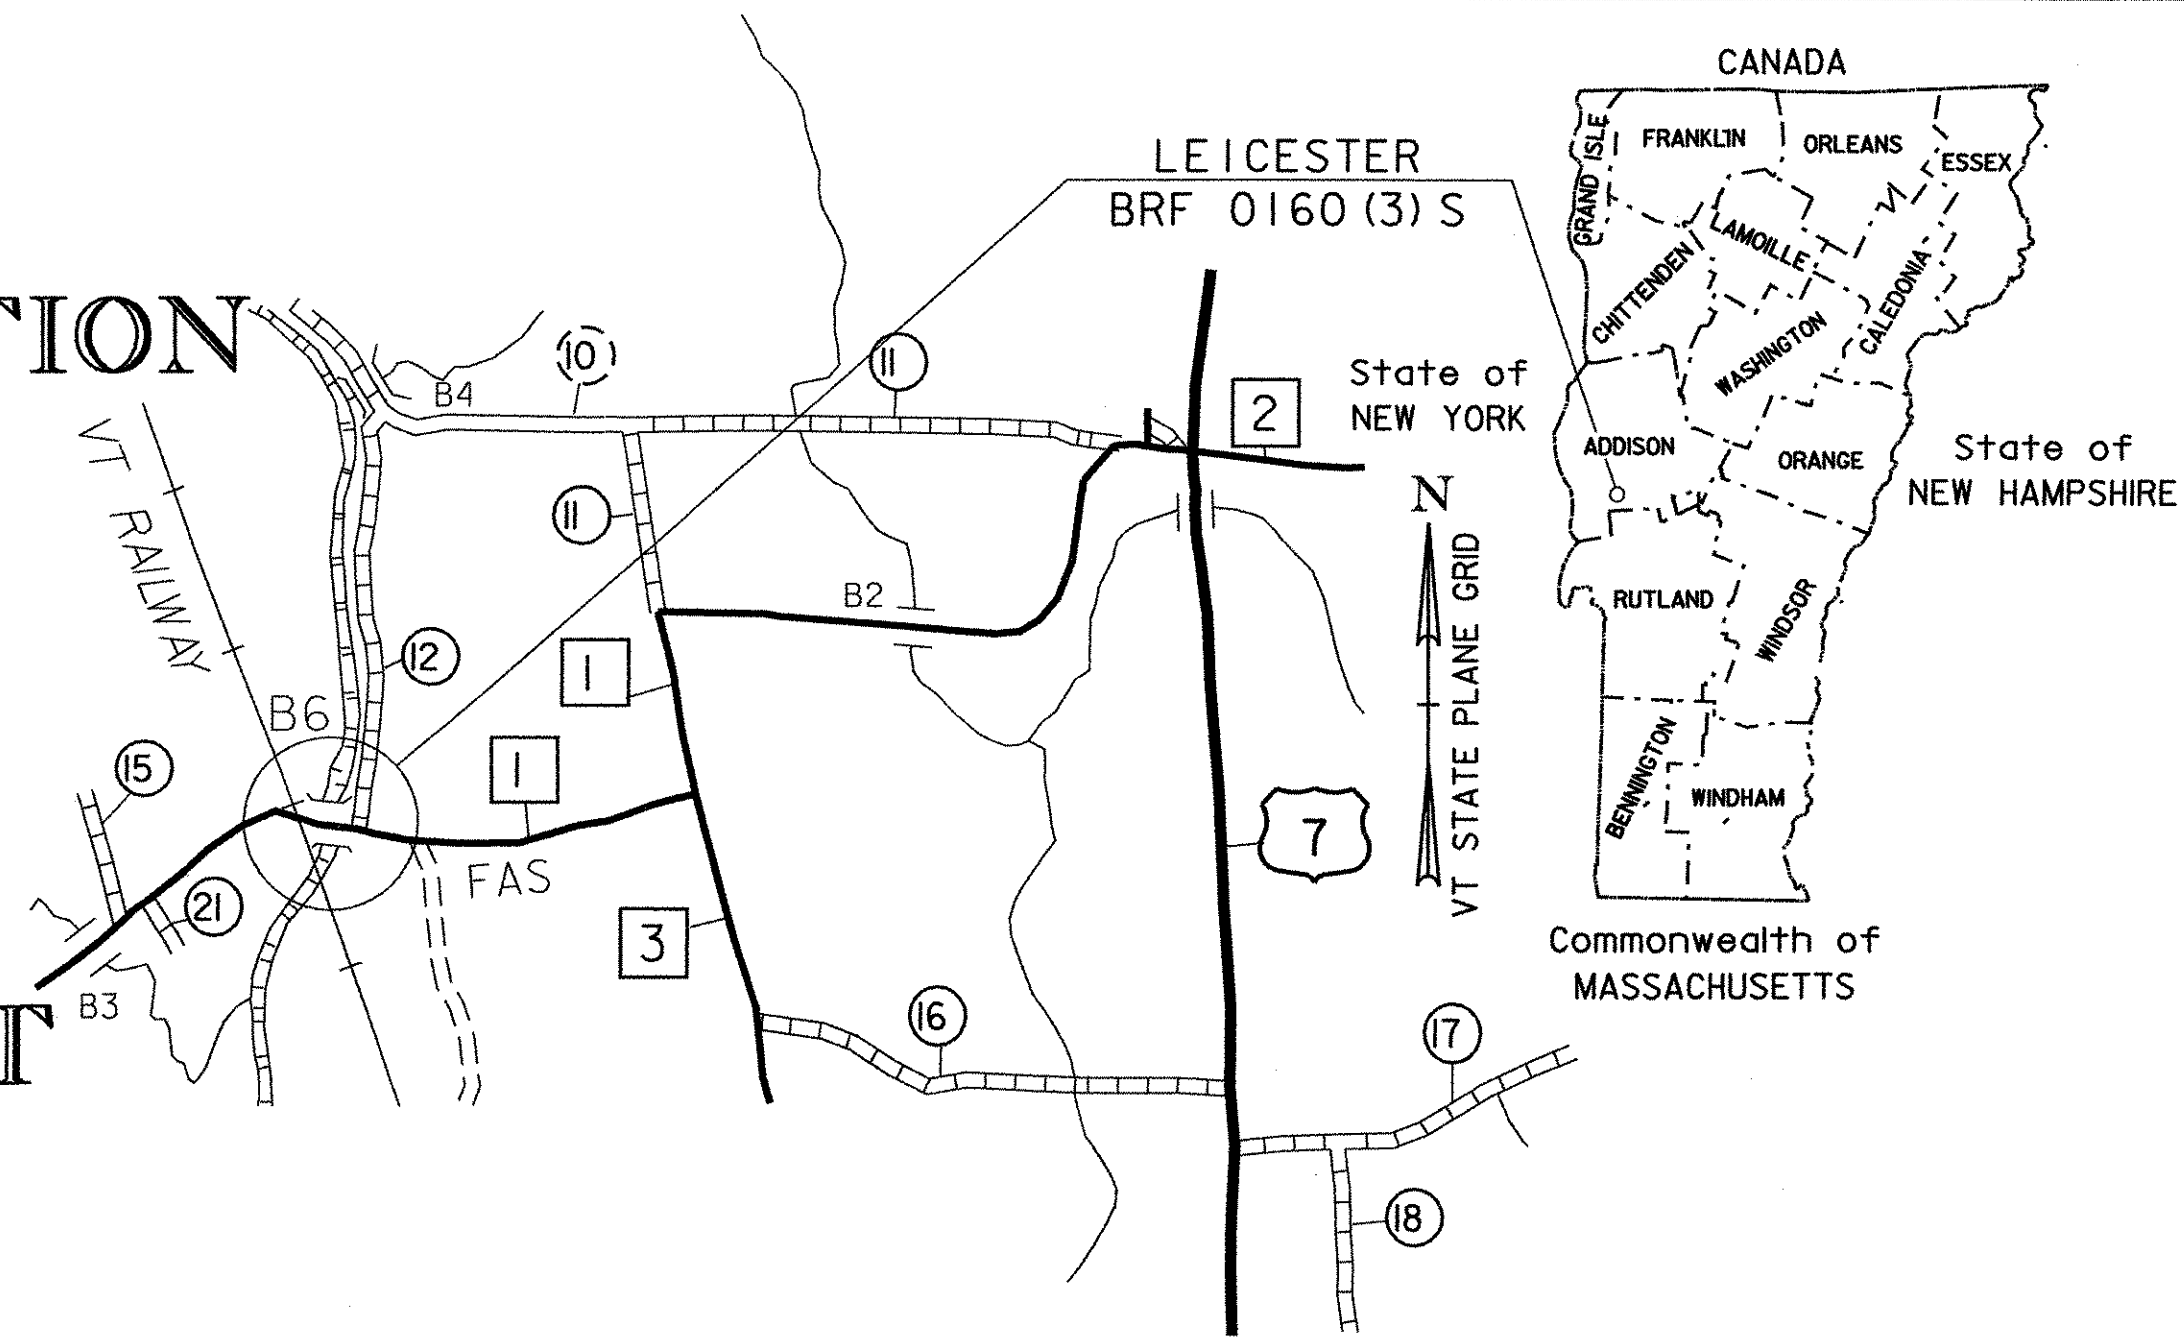

TOWN OF LEICESTER COUNTY OF ADDISON

ROUTE NO : TH 1 (FAS 160) MAJOR COLLECTOR

BRIDGE NO : 6


PROJECT LOCATION : APPROXIMATELY 1.61KM WESTERLY OF THE INTERSECTION OF TH 1 AND TH 3.

PROJECT DESCRIPTION : REPLACEMENT OF THE EXISTING STRUCTURE, INCLUDING NECESSARY ROADWAY AND CHANNEL WORK.

LENGTH OF STRUCTURE : 34.782 METERS.

LENGTH OF ROADWAY : 220.218 METERS.

LENGTH OF PROJECT : 255.000 METERS.

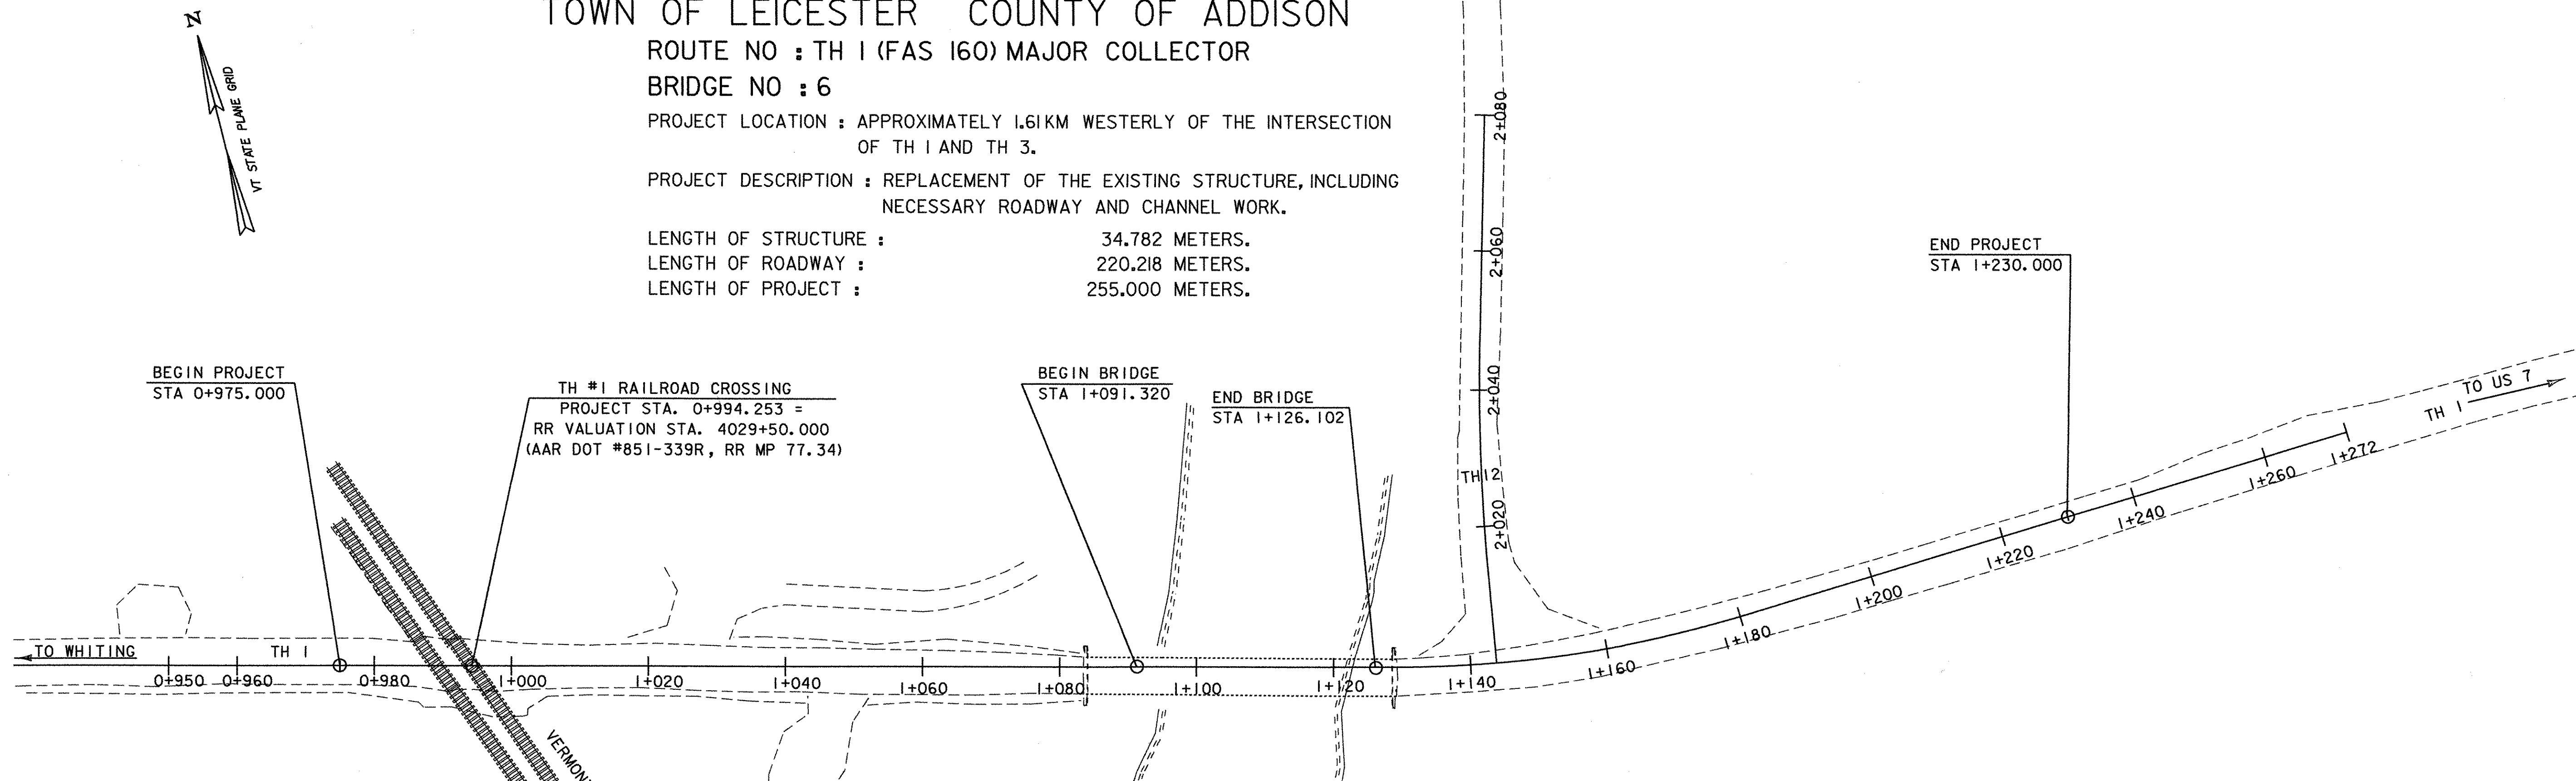

CONVENTIONAL SYMBOLS

COUNTY LINE	
TOWN LINE	
LIMITS OF ACCESS	
POINT OF ACCESS	
FENCE LINE	
STONE WALL	
TRAVELED WAY	
GUARD RAIL	
RAILROAD	
SURVEY LINE	
CULVERT	
POWER POLE	
TELEPHONE POLE	
TREES	
CONTROL OF ACCESS	
PROPERTY LINE	
R.O.W. TAKING LINE	
SLOPE RIGHTS	
TOP OF CUT	
TOE OF SLOPE	

SURVEYED BY : L. ORVIS
SURVEYED DATE : JUNE 1996

DATUM
VERTICAL NAVD88
HORIZONTAL NAD83 (92)

0 10 20 30
SCALE 1:500

Metric

UNLESS NOTED OTHERWISE
STATIONS ARE IN KILOMETERS
ELEVATIONS ARE IN METERS
DIMENSIONS ARE IN MILLIMETERS

THESE PLANS ARE SUBJECT TO SUCH ENGINEERING CHANGES AS MAY BE REQUIRED BY THE FEDERAL HIGHWAY ADMINISTRATION OR THE DIRECTOR OF PROGRAM DEVELOPMENT.

CONSTRUCTION IS TO BE CARRIED ON IN ACCORDANCE WITH THESE PLANS AND THE STANDARD SPECIFICATIONS FOR CONSTRUCTION DATED 2001, AS APPROVED BY THE FEDERAL HIGHWAY ADMINISTRATION ON JANUARY 4, 2001 FOR USE ON THIS PROJECT, INCLUDING ALL SUBSEQUENT REVISIONS AND SUCH REVISED SPECIFICATIONS AND SPECIAL PROVISIONS AS ARE INCORPORATED IN THESE PLANS.

95J288\Structures\sj288bdr.dgn sj288\PL01TED 07-JUL-2005

DIRECTOR OF PROGRAM DEVELOPMENT

APPROVED *Richard Tetreault* DATE 7-15-05

PROJECT MANAGER : ROGER R. WHITCOMB

PROJECT NAME : LEICESTER
PROJECT NUMBER : AC BR 0160 (3) S

SHEET 1 OF 90 SHEETS

PRELIMINARY INFORMATION SHEET



INDEX OF SHEETS

- 1. TITLE SHEET
- 2. PRELIMINARY INFORMATION SHEET
- 3. PROJECT TYPICAL SECTIONS
- 4-5. QUANTITY SHEETS
- 6-9. R.O.W. SHEETS
- 10. TIE SHEET
- 11-13. LAYOUT SHEETS
- 14-17. PROFILE SHEETS
- 18-20. RESOURCE LAYOUT SHEETS
- 21. EROSION CONTROL NARRATIVE
- 22-24. EXISTING CONDITION SITE PLANS
- 25-27. EROSION PREVENTION AND SEDIMENT CONTROL PLANS
- 28-30. FINAL CONDITION SITE PLANS
- 31-35. EROSION CONTROL DETAILS
- 36-37. LINE STRIPING AND SIGN LAYOUT SHEETS
- 38. TRAFFIC SIGN SUMMARY SHEET
- 38a. RAILROAD-HIGHWAY CROSSING DETAILS
- 39. TEMPORARY DETOUR DETAILS
- 40. TEMPORARY DETOUR LAYOUT
- 41-45. BORING INFORMATION SHEETS
- 46. PLAN AND ELEVATION
- 47. GENERAL NOTES
- 48. DECK REINFORCING PLAN
- 49. FRAMING PLAN
- 50. STRUCTURAL STEEL DETAILS
- 51. CURB DETAILS
- 52. BEARING DETAILS
- 53-54. EXPANSION JOINT DETAILS
- 55. APPROACH SLAB DETAILS
- 56-57. NETC BRIDGE RAIL DETAILS
- 58. ABUTMENT NO.1 DETAILS
- 59. ABUTMENT NO.2 DETAILS
- 60. ABUTMENT BACKWALL DETAILS
- 61-62. WINGWALL DETAILS
- 63. FOOTING REINFORCING PLAN
- 64. PILE LAYOUT PLAN
- 65. EPS GEOFOAM BLOCK DETAILS
- 65a. EARTH PRESSURE CELL DETAILS
- 66. REINFORCING STEEL SCHEDULE
- 67. BANKING DIAGRAM SHEET
- 68-79. MAINLINE CROSS SECTIONS
- 80-82. SIDELINE CROSS SECTIONS
- 83. FIELD DRIVE CROSS SECTIONS
- 84-88. CHANNEL CROSS SECTIONS
- 89-90. REFERENCE SHEETS

LIST OF STANDARDS

B-71M	02-01-2004
E-100	01-02-2004
E-101	05-30-2003
E-102	06-30-2003
E-102A	05-01-2004
E-106	03-01-2004
E-107	06-30-2003
E-107A	08-08-1995
E-110	08-08-1995
E-121	08-08-1995
E-142	09-20-1995
E-143	06-15-2004
E-150	05-01-2004
E-152	05-01-2004
E-160	05-20-1999
E-190	06-30-2003
E-193	08-18-1995
G-1M	01-03-2000
G-1dM	01-03-2000
G-18M	06-13-1997
J-3M	06-13-1997

FINAL HYDRAULIC REPORT

HYDROLOGIC DATA

Date: February 2000

DRAINAGE AREA : 1270 sq. km
 CHARACTER OF TERRAIN : Flat at site, to hilly and mountainous upstream, mixed cover.
 STREAM CHARACTERISTICS : Alluvial, sinuous, probably incised, flat slope, wide flood plain.
 NATURE OF STREAMBED : Fine material, mostly clay and silt.

PEAK FLOW DATA

Q 2.33 =	120 cms	Q 50 =	405 cms
Q 10 =	260 cms	Q 100 =	465 cms
Q 25 =	345 cms	Q 500 =	620 cms

DATE OF FLOOD RECORD : November 1927
 ESTIMATED DISCHARGE: 485 cms +/-
 WATER SURFACE ELEV.: 109 m +/-
 NATURAL STREAM VELOCITY: @ Q25 = 1.2 mps
 ICE CONDITIONS : Moderate
 DEBRIS: Low to moderate
 DOES THE STREAM REACH MAXIMUM HIGHWATER ELEV. RAPIDLY? No
 IS ORDINARY RISE RAPID? No
 IS STAGE AFFECTED BY UPSTREAM OR DOWNSTREAM CONDITIONS? Yes
 IF YES, DESCRIBE: Water surface elevations at this site are controlled by a dam downstream approximately 10 miles, in Middlebury. Top of dam at elevation 102.4 m.

WATERSHED STORAGE: * HEADWATERS: * There is a lot of floodplain immediately ABOVE SITE: storage upstream

EXISTING STRUCTURE INFORMATION

STRUCTURE TYPE: 3-span steel beam bridge with concrete deck
 YEAR BUILT: 1932
 CLEAR SPAN(NORMAL TO STREAM): 43 m
 VERTICAL CLEARANCE ABOVE STREAMBED: 6.5 m
 WATERWAY OF FULL OPENING: 181 sq. m
 DISPOSITION OF STRUCTURE: Remove
 TYPE OF MATERIAL UNDER SUBSTRUCTURE: Clay

WATER SURFACE ELEVATIONS AT:

Q2.33 =	105.1 m	VELOCITY=	1.0 mps
Q10 =	106.2 m	"	1.6 mps
Q25 =	106.6 m	"	1.9 mps
Q50 =	107.1 m	"	2.2 mps
Q100 =	107.3 m	"	2.0 mps

LONG TERM STREAMBED CHANGES: None noted.

IS THE ROADWAY OVERTOPPED BELOW Q100: Yes
 FREQUENCY: Q15
 RELIEF ELEVATION: 106.4 m
 DISCHARGE OVER ROAD @Q100: 170 cms

UPSTREAM STRUCTURE

TOWN: Leicester DISTANCE: 122 m
 HIGHWAY#: VT Railway STRUCTURE #: -
 CLEAR SPAN: 49 m CLEAR HEIGHT: 4.0 m +/-
 YEAR BUILT: - FULL WATERWAY: -
 STRUCTURE TYPE: Single span steel truss bridge.

DOWNSTREAM STRUCTURE

TOWN: Salisbury DISTANCE: 4.8 km
 HIGHWAY#: T.H. 1 STRUCTURE #: 8
 CLEAR SPAN: 37 m CLEAR HEIGHT: 7.3 m
 YEAR BUILT: 1865 FULL WATERWAY: -
 STRUCTURE TYPE: Covered Bridge

LOAD FACTOR - LOAD RATING (TONS)

LOADING LEVELS	TRUCK						
	M	MS	3S2	6 AXLE	3A STR.	4A STR.	SA SEMI
INVENTORY	37	57					
POSTED	52	80	90		75	76	85
OPERATING		96	108	121	90	91	

COMMENTS:

TRAFFIC DATA

YEAR	ADT	DHV	% D	% T	ADTT
2002	1150	160	56	2	60
2022	1530	215	56	2	65

20 year ESAL for flexible pavement from 2002 to 2022 : 539,000
 40 year ESAL for flexible pavement from 2002 to 2042 : 1,300,000
 Design Speed : 65 km/h

PROPOSED STRUCTURE

STRUCTURE TYPE: Single span steel girder bridge, with concrete deck.
 CLEAR SPAN(NORMAL TO STREAM): 32.7 m
 VERTICAL CLEARANCE ABOVE STREAMBED: 6.7 m
 WATERWAY OF FULL OPENING: 174 sq. m

WATER SURFACE ELEVATIONS AT:

Q2.33 =	105.1	VELOCITY=	1.0 mps
Q10 =	106.2	"	1.7 mps
Q25 =	106.6	"	2.1 mps
Q50 =	106.9	"	2.2 mps
Q100 =	107.3	"	2.1 mps

IS THE ROADWAY OVERTOPPED BELOW Q100: Yes
 FREQUENCY: Q15
 RELIEF ELEVATION: 106.4
 DISCHARGE OVER ROAD @Q100: 97 cms

AVERAGE LOW ELEVATION OF SUPERSTRUCTURE: 106.8 m
 VERTICAL CLEARANCE: @ Q25 = 0.2 m

SCOUR: Contraction scour = 0.9 m @ Q100, 2.4 m @ Q500

REQUIRED CHANNEL PROTECTION: Stone Fill, Type III

PERMIT INFORMATION

AVERAGE DAILY FLOW: 30 cms DEPTH OR ELEVATION:
 ORDINARY LOW WATER: 15 cms Elev. 103.0 m
 ORDINARY HIGH WATER: 50 cms Elev. 104.0 m

TEMPORARY BRIDGE REQUIREMENTS

STRUCTURE TYPE: Single span bridge
 CLEAR SPAN (NORMAL TO STREAM): 32 m minimum
 VERTICAL CLEARANCE ABOVE STREAMBED: Low steel elev. 106.6 minimum
 WATERWAY AREA OF FULL OPENING: 160 sq. m minimum

ADDITIONAL INFORMATION


Water surface elevations at this site are controlled by a downstream dam in Middlebury. Starting water surface elevations are taken from the 1984 Middlebury Flood Insurance Study. There is a very wide flood plain at this site. The project survey does not extend far enough to accurately model the hydraulics. The information in this report is based on the survey available.

DESIGN CRITERIA

- DESIGN LIVE LOAD AASHTO: MS 22.5
- DESIGN SPAN: 33.50 m
- ALLOWABLE LOAD FOR SPREAD FOOTINGS ON SOIL: N/A ON LEDGE: N/A
- DESIGN LOAD FOR PILING: 600 kN TYPE: HP 360 x 108 ASTM A572/A572M GR 345 ESTIMATED LENGTH: SEE BORING LOGS
- STRUCTURAL STEEL AASHTO M270/M270M GRADE: 345W
- REINFORCING STEEL GRADE: 420
- CONCRETE CLASS A (HPC-A) f'c: 30 Mpa CONCRETE CLASS B (HPC-B) f'c: 25 Mpa
- SOIL UNIT WEIGHT
- DESIGN LOAD FOR SPREAD FOOTINGS ON SOIL: N/A


TRAFFIC MAINTENANCE

- IS TRAFFIC TO BE MAINTAINED? YES
 IF YES, ON EXISTING STRUCTURE? NO
 OR ON TEMPORARY BRIDGE? YES
 ONE OR TWO-WAY TRAVEL? TWO
- TRAFFIC CONTROL SIGNALS REQUIRED? NO

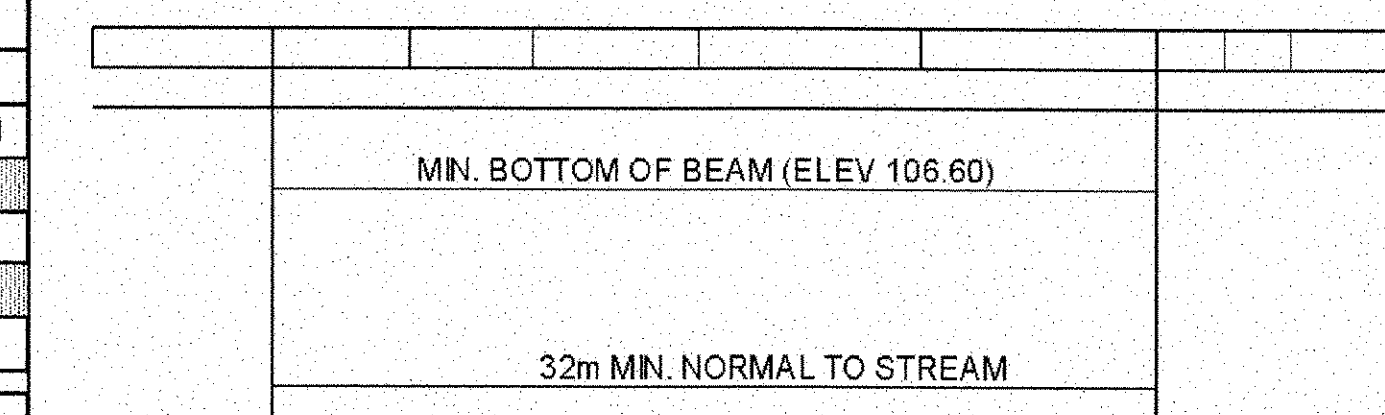


TEMPORARY BRIDGE DETAIL

PROJECT NAME: LEICESTER
 PROJECT NUMBER: BRF 0160(3)S
 FILE NAME: \PW\95\288\Structures\sj288pi.xls PLOT DATE: 04/01/2005
 PROJECT MANAGER: R. R. WHITCOMB DRAWN BY: J. GILMORE
 DESIGNED BY: C. CARLSON CHECKED BY: C. CARLSON
PRELIMINARY INFORMATION SHEET SHEET 2 OF 90

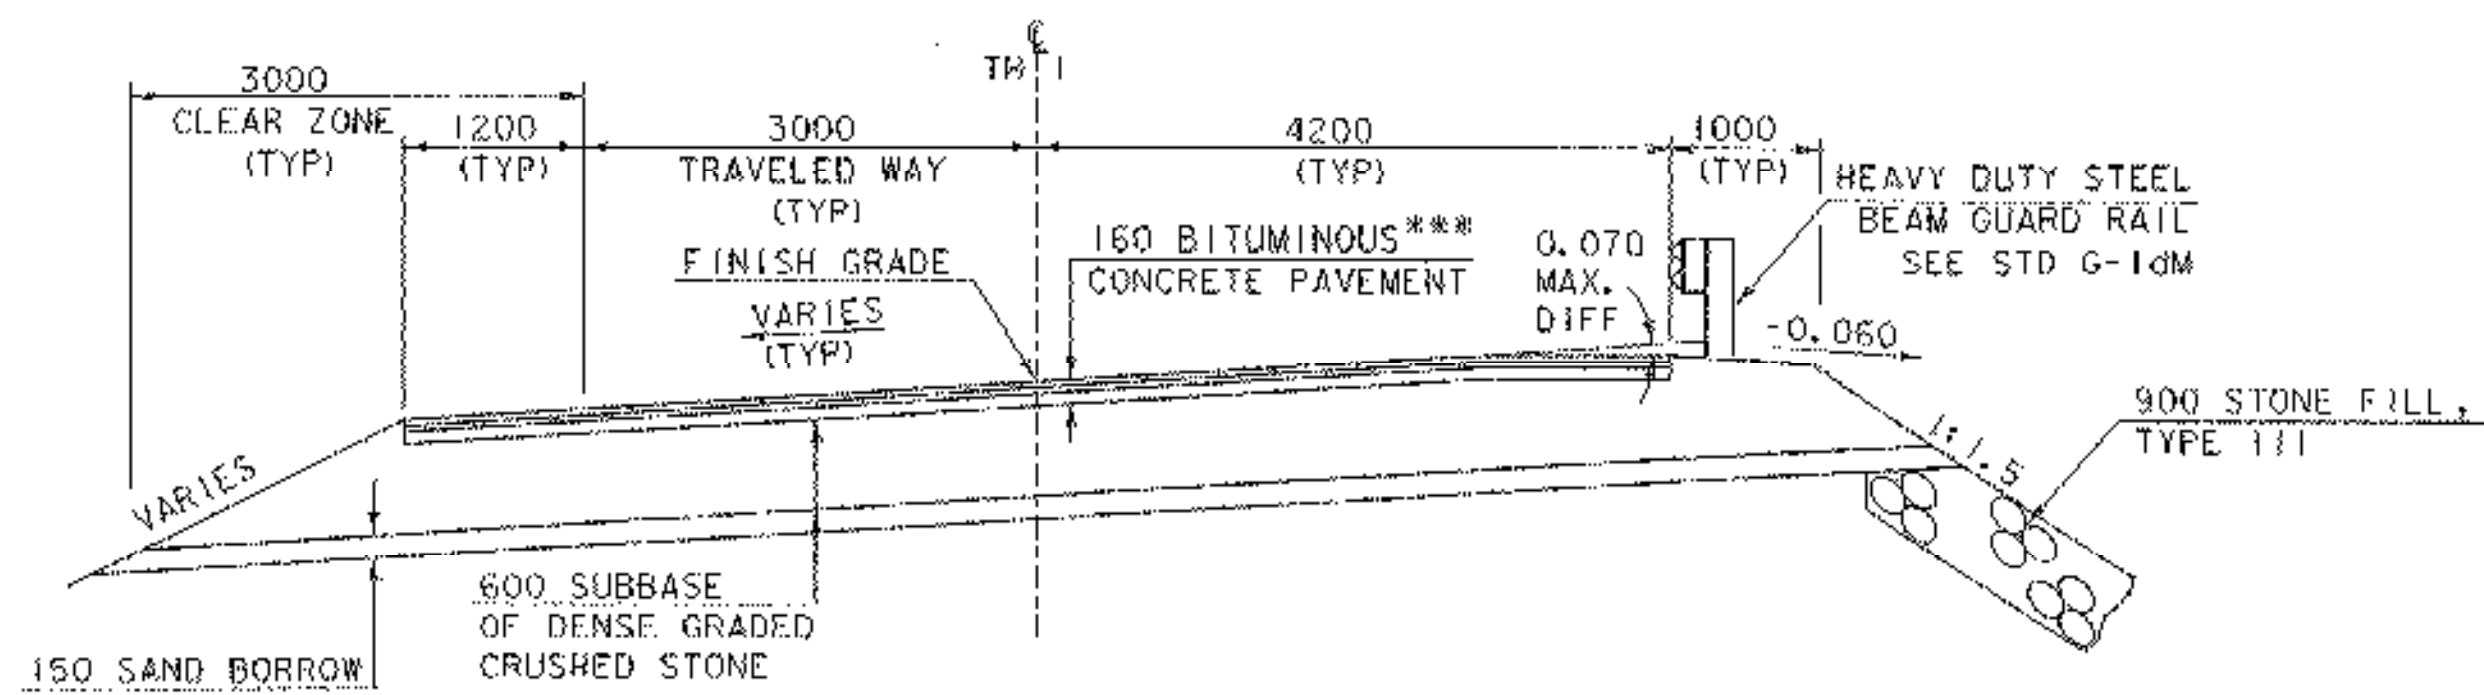


*** 40 BIT. CONC. PVMT. TYPE III
 40 BIT. CONC. PVMT. TYPE III
 80 BIT. CONC. PVMT. TYPE I OR TYPE II


ROADWAY TYPICAL

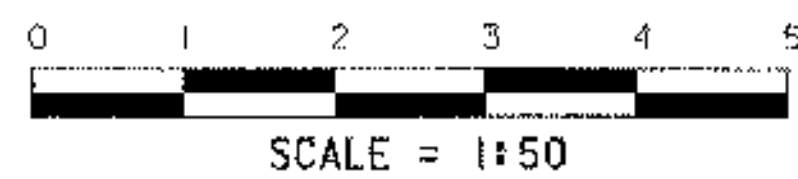

BUILT AS DESIGNED

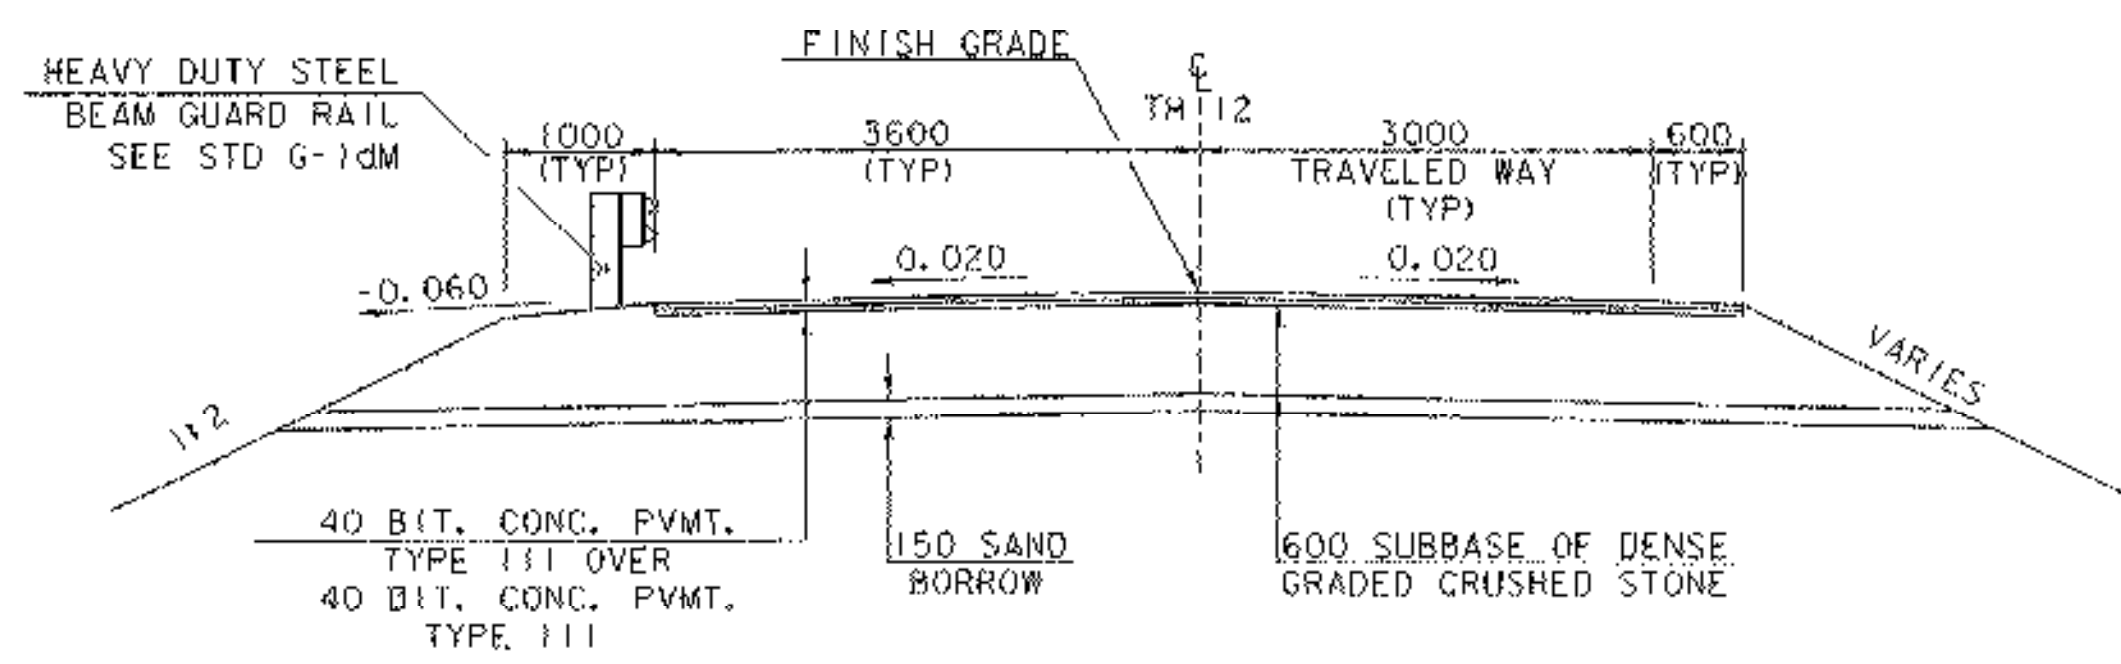


TH 12 TYPICAL

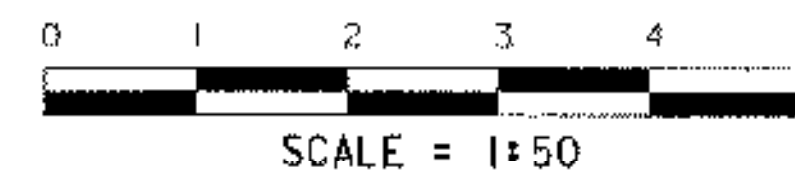


BUILT AS DESIGNED


MATERIAL ITEM	TOLERANCE
PAVEMENT	±5 mm TOTAL THICKNESS
BASE COURSE	±10 mm
SUBBASE	±30 mm
SAND BORROW	±30 mm
GRANULAR BORROW	±30 mm

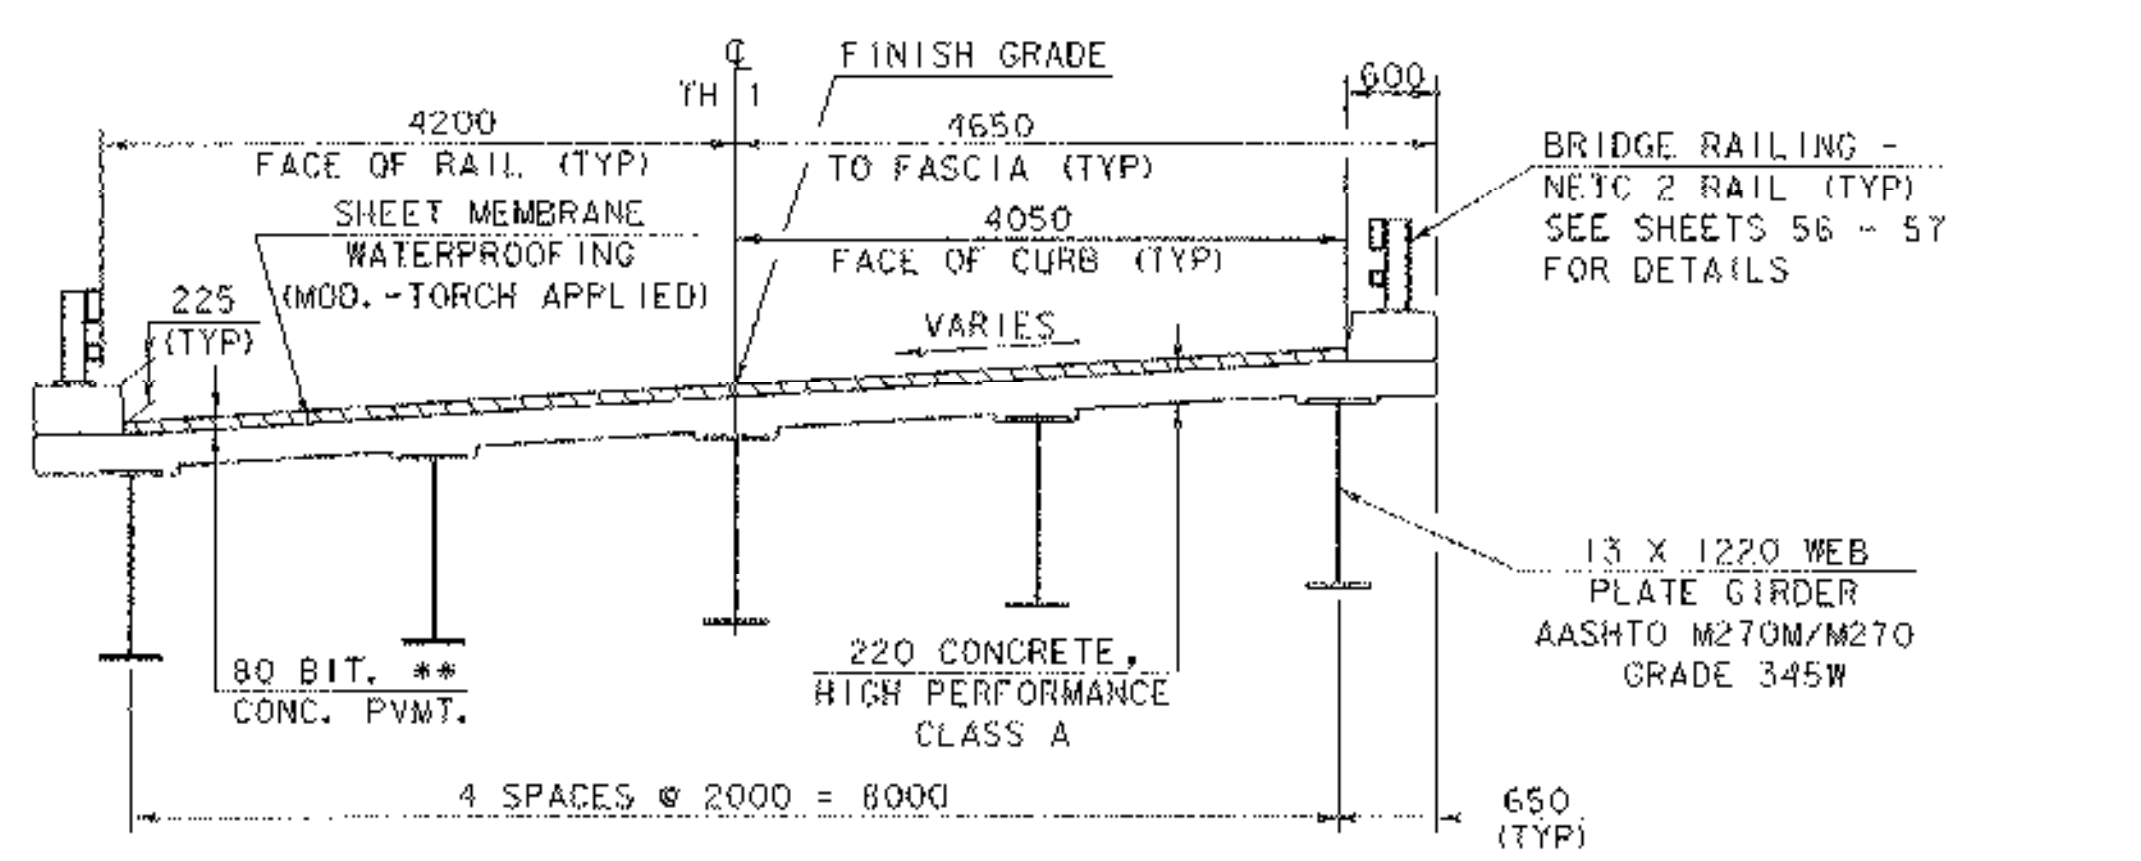

BRIDGE TYPICAL

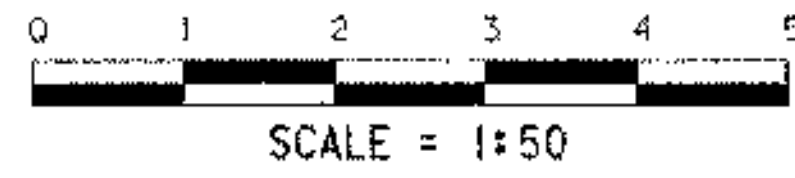


** 40 BIT. CONC. PVMT. TYPE III OVER 40 BIT. CONC. PVMT. TYPE III

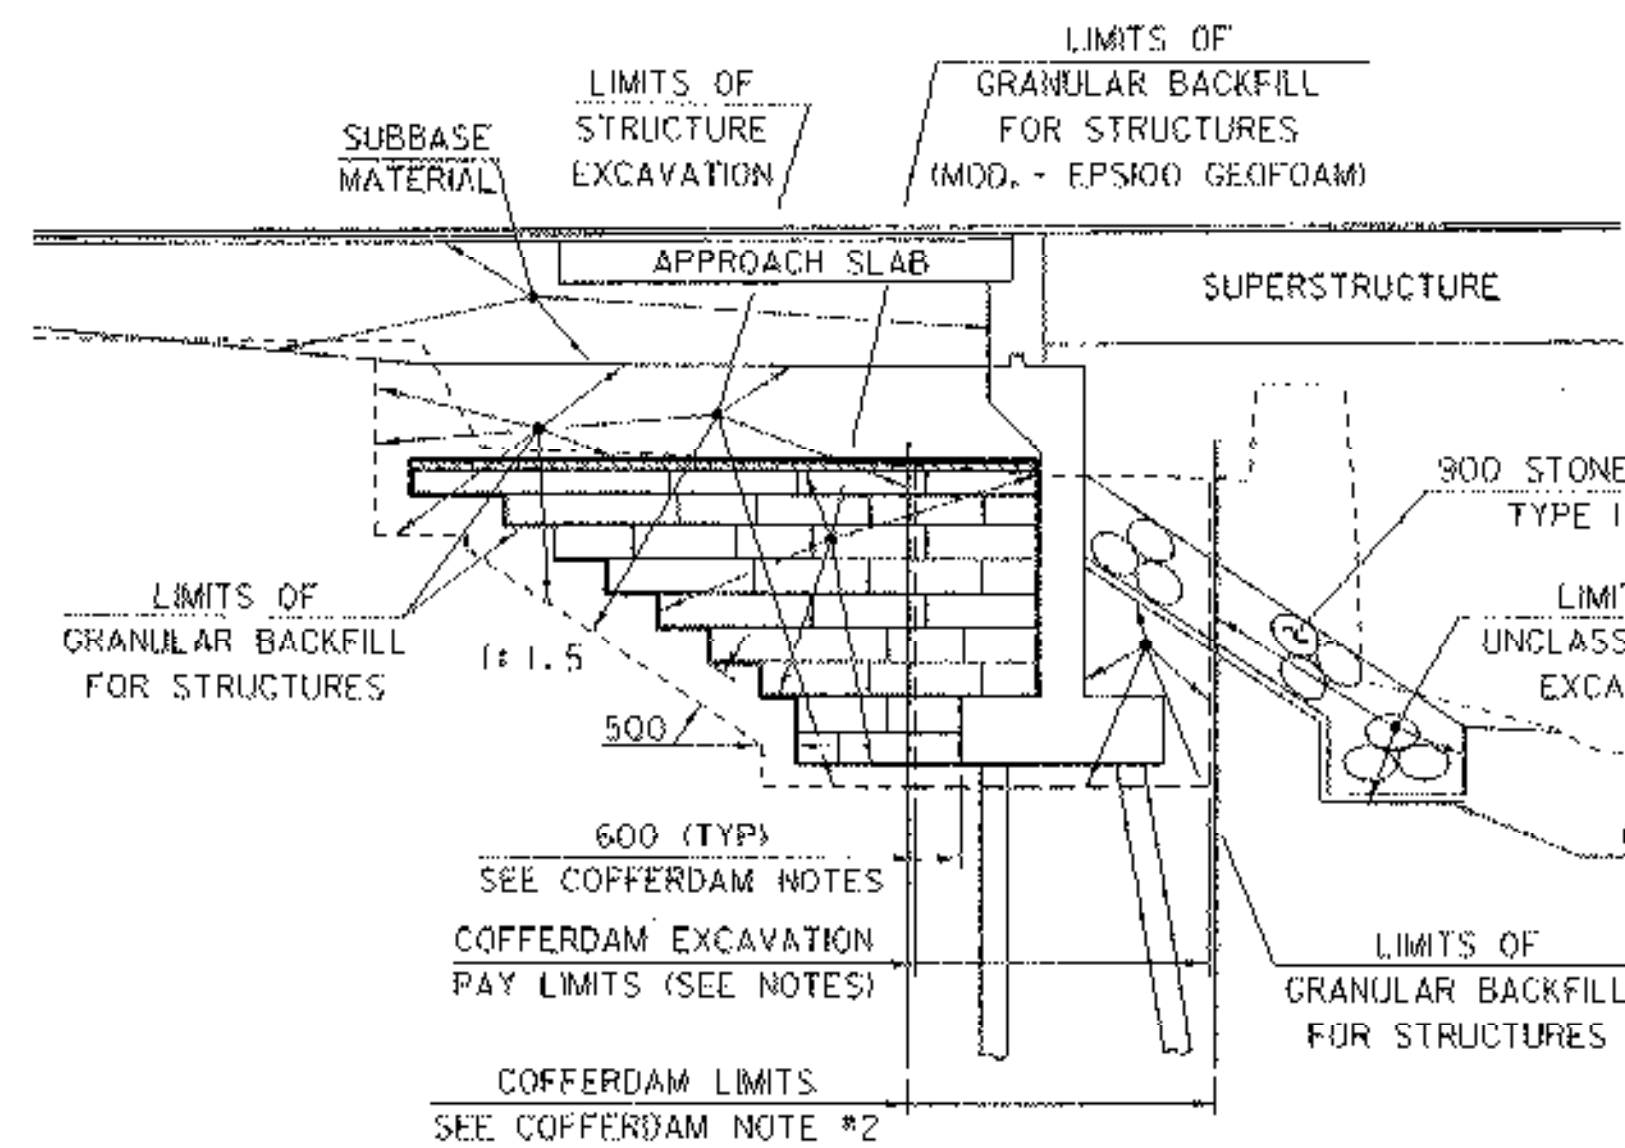

TYPICAL ABUTMENT #1 SECTION

(NOT TO SCALE)

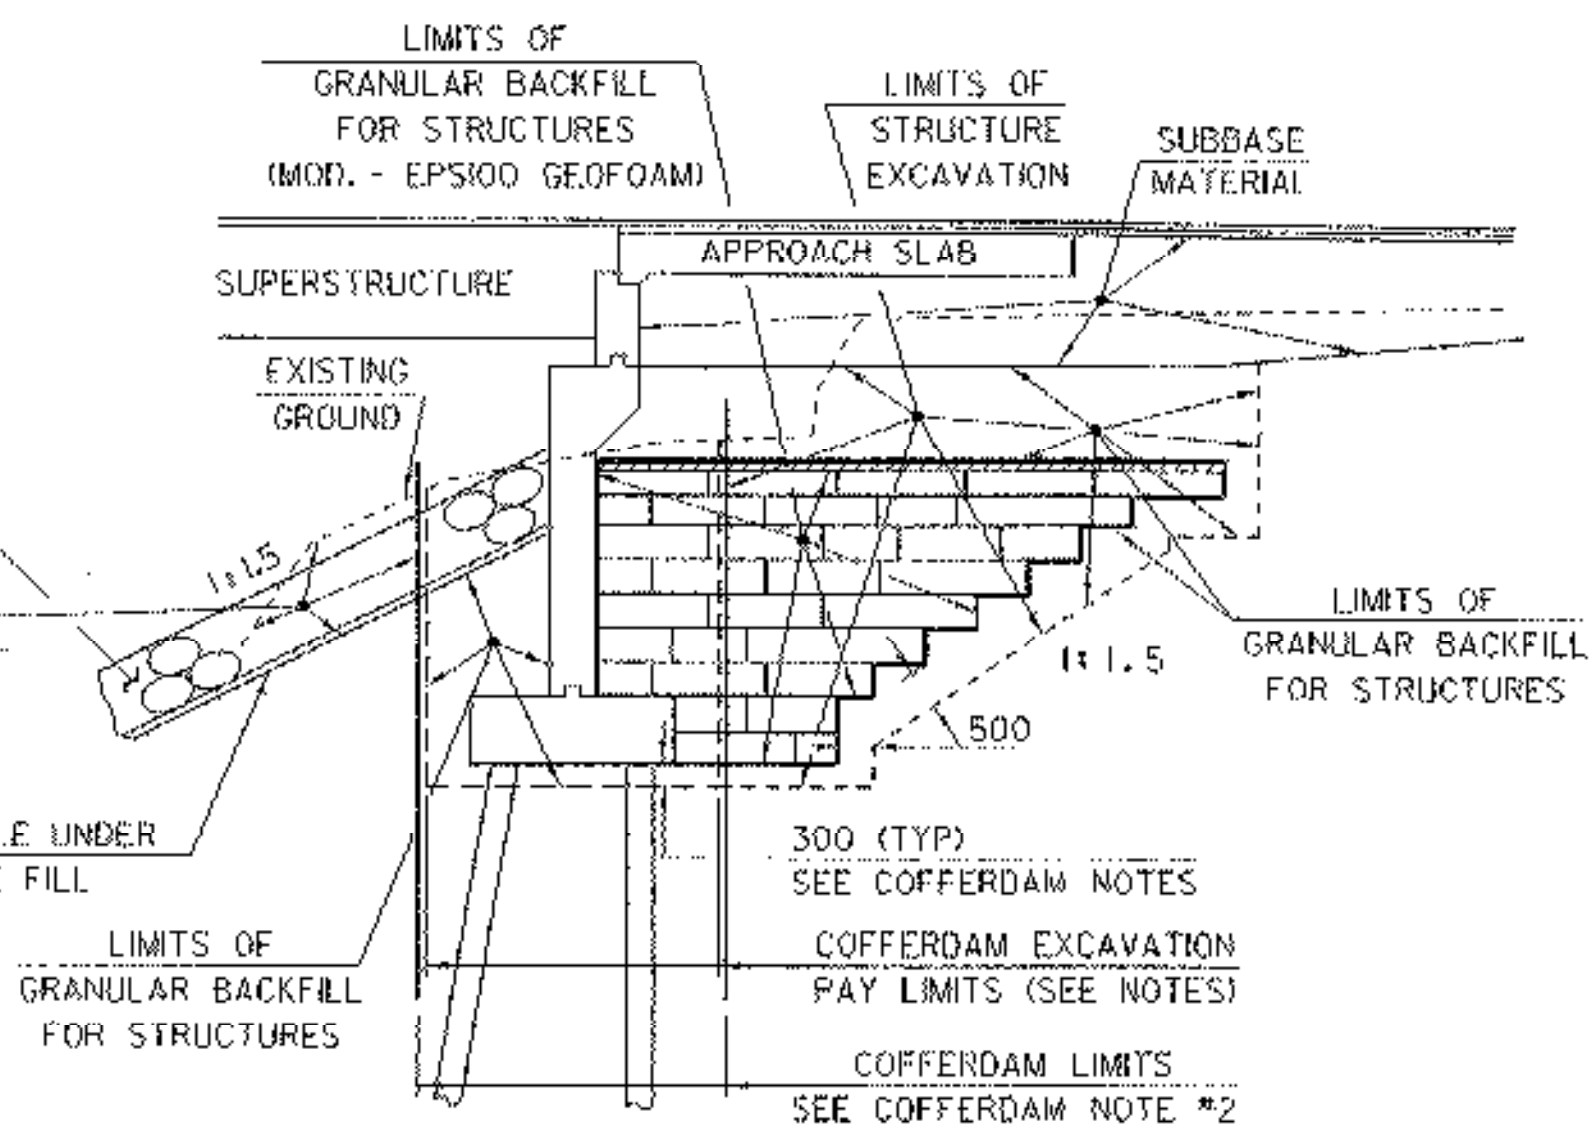


TYPICAL ABUTMENT #2 SECTION

(NOT TO SCALE)

COFFERDAM NOTES

1. COFFERDAM LIMITS TO BE DETERMINED BY THE CONTRACTOR.
2. THE PAY LIMITS OF COFFERDAM EXCAVATION, EARTH AND "COFFERDAM EXCAVATION, ROCK" SHALL BE 600 OUTSIDE THE PERIMETER OF THE FOOTING, UP TO EXISTING GROUND OR BOTTOM OF SUBBASE, WHICHEVER IS LOWER.
3. 300 UNDERCUT AS DETERMINED NECESSARY BY THE RESIDENT ENGINEER.
4. IF A COFFERDAM IS CONSTRUCTED WHICH IS LARGER THAN THE INDICATED COFFERDAM EXCAVATION PAY LIMITS, PAYMENT FOR ALL UNCLASSIFIED CHANNEL EXCAVATION AND STRUCTURE EXCAVATION, INCLUDING THAT PORTION WHICH IS INSIDE THE COFFERDAM BUT OUTSIDE THE COFFERDAM EXCAVATION PAY LIMITS, WILL BE MADE AT THE CONTRACT UNIT PRICE FOR UNCLASSIFIED CHANNEL EXCAVATION AND STRUCTURE EXCAVATION.

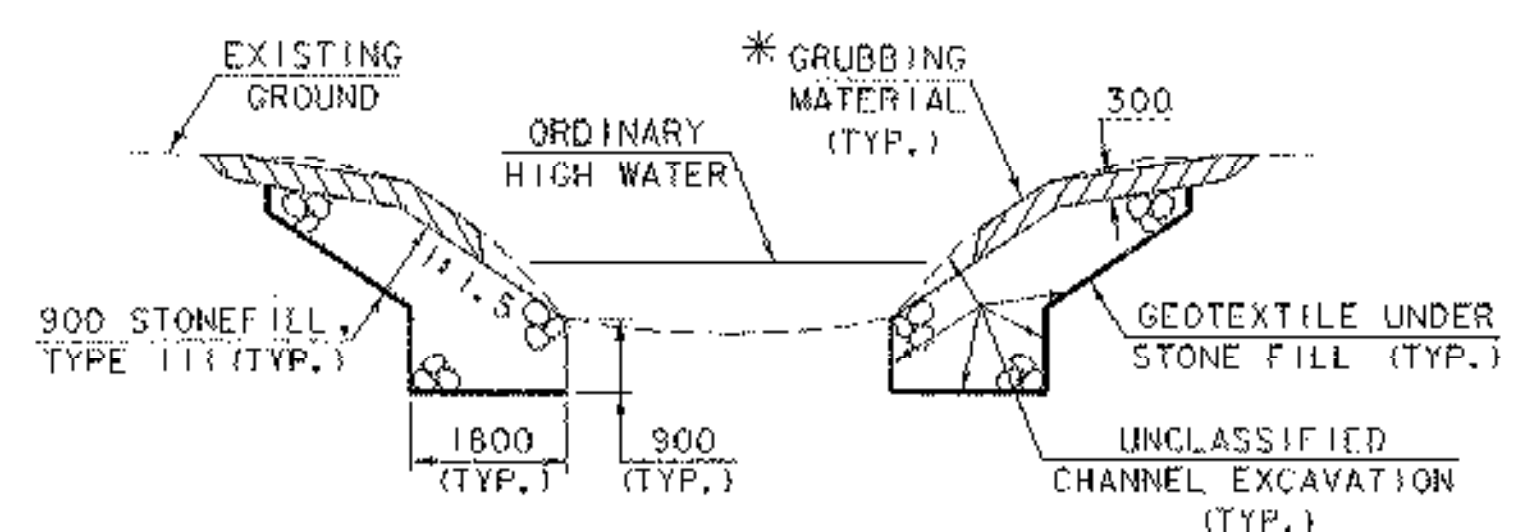

TYPICAL CHANNEL SECTION

(NOT TO SCALE)

* GRUBBING MATERIAL SHALL NOT BE PLACED ON THE STONE FILL IN THE AREA UNDER THE BRIDGE. WHENEVER CHANNEL SLOPE INTERSECTS ROADWAY SUBBASE, GRUBBING MATERIAL SHALL BEGIN AT THE BOTTOM OF SUBBASE.

SHEET NAME: TYPICAL SECTIONS		
PROJECT NAME: LEICESTER	HIGHWAY NO.: FAS 0160	
PROJECT NUMBER: BRF 0160(3)S	BRIDGE NO.: 6	OVER: OTTER CREEK
FILE NAME: /PW/951288/sj288pl.dgn	PLT DATE: 17-AUG-2005	
PROJECT MANAGER: R. R. WHITCOMB	DRAWN BY: J. GILMORE	
DESIGNED BY: C. CARLSON	IPARM NAME: sj2881yp.1	
BRIDGE SHEET NUMBER:	SHEET 3 OF 90	

QUANTITY SHEET



SUMMARY OF ESTIMATED QUANTITIES														TOTALS			DESCRIPTIONS		DETAILED SUMMARY OF QUANTITIES		
ROADWAY	CHANNEL	SUPER-STRUCTURE	ABUT 1	ABUT 2	APPR SLAB 1	APPR SLAB 2	TRAINING	EROSION CONTROL	FULL E&C	BRIDGE QUANTITY	ROUND	GRAND TOTAL	FINAL	UNIT	ITEMS	ITEM NUMBER	QUANTITIES	UNIT	ITEMS		
1												1		LS	CLEARING AND GRUBBING (INCL. INDV. TREES & STUMPS)	201.10					
950												950		CM	COMMON EXCAVATION	203.15					
450	510									510		960		CM	UNCLASSIFIED CHANNEL EXCAVATION	203.27					
470			20	20						40		510		CM	SAND BORROW	203.31					
10												10		CM	GRANULAR BORROW	203.32					
2700												2700		SM	FINE GRADING-SUBGRADE	203.40					
100								10				110		CM	TRENCH EXCAVATION OF EARTH	204.20					
			330	330								660		CM	STRUCTURE EXCAVATION	204.25					
			450	430								880		CM	GRANULAR BACKFILL FOR STRUCTURES	204.30					
			245	205								450		CM	GRANULAR BACKFILL FOR STRUCTURES (MOD. - EPS100 GEOFOAM)	204.30					
			230	220								450		CM	COFFERDAM EXCAVATION, EARTH	208.30					
			120	110								230		CM	COFFERDAM EXCAVATION, ROCK	208.35					
			1									1		LS	COFFERDAM (ABUTMENT NO. 1)	208.40					
				1								1		LS	COFFERDAM (ABUTMENT NO. 2)	208.40					
140												140		SM	COLD PLANING-BITUMINOUS PAVEMENT	210.10					
2330								10				2340		CM	SUBBASE OF DENSE GRADED CRUSHED STONE	301.35					
15												15		CM	AGGREGATE SURFACE COURSE	401.10					
460		30			10	10						50		KG	EMULSIFIED ASPHALT	404.65					
870		54			10	10						74		T	BITUMINOUS CONCRETE PAVEMENT (PG 58-28)	406.25					
		88	1									89		CM	CONCRETE, HIGH PERFORMANCE CLASS A	501.33					
			121	111	19	20						271		CM	CONCRETE, HIGH PERFORMANCE CLASS B	501.34					
		1										1		LS	FURNISHING EQUIPMENT FOR DRIVING PILING	504.10					
			880	590								1470		M	STEEL PILING (HP 360 X 108)	505.17					
		61330										61330		KG	STRUCTURAL STEEL(PLATE GIRDER)	506.55					
			8815	8190								17005		KG	REINFORCING STEEL	507.15					
		12210	65	65	1355	1445						15140		KG	EPOXY COATED REINFORCING STEEL	507.17					
		1										1		LS	SHEAR CONNECTORS (1030 ~ 22 x 180)	508.15					
		1										1		LS	STRUCTURAL PAINTING,SHOP APPLIED (6 METRIC TONS)	513.25					
		1										1		LS	SURFACE PREPARATION,SHOP (6 METRIC TONS)	513.40					
		25	6	6								37		L	WATER REPELLENT (MOD. - SILANE)	514.10					
		10										10		M	BRIDGE EXPANSION JOINT (VERMONT)	516.10					
		10										10		M	BRIDGE EXPANSION JOINT (ASPHALTIC PLUG)	516.10					
		290										290		SM	SHEET MEMBRANE WATERPROOFING (MOD. - TORCH APPLIED)	519.20					
		81										81		M	BRIDGE RAILING - NETC 2 RAIL	525.33					
1												1		LS	TWO-WAY TEMPORARY BRIDGE (240 SM) (MOD.)	528.11					
		240										240		SM	REMOVAL OF BRIDGE PAVEMENT	529.10					
		1										1		EACH	PARTIAL REMOVAL OF STRUCTURE	529.20					
		10										10		EACH	BEARING DEVICE ASSEMBLY (FABRIC)	531.10					
															BEGIN PIPE OPTION						
26												26		M	600 mm CAAP 1.91 mm (68 mm X 12 mm)	601.0226					
26												26		M	600 mm PCCSP 2.01 mm (68 mm X 12 mm)	601.0426					
26												26		M	600 mm CPEP	601.0920					
															END PIPE OPTION						
36												36		M	150 mm UNDERDRAIN	605.10					
14												14		M	150 mm UNDERDRAIN CARRIER PIPE	605.20					

PROJECT NAME: **LEICESTER**
PROJECT NUMBER: **BRF 0160 (3) S**
FILE NAME: 195\288\Structures\sj288qnt.xls PLOT DATE: 08/01/2005
PROJECT MANAGER: R. R. WHITCOMB DRAWN BY: G. ROY
DESIGNED BY: C. CARLSON CHECKED BY: C. CARLSON
QUANTITY SHEET #1 SHEET 4 OF 90

QUANTITY SHEET



SUMMARY OF ESTIMATED QUANTITIES														TOTALS			DESCRIPTIONS			DETAILED SUMMARY OF QUANTITIES		
ROADWAY	CHANNEL	SUPER-STRUCTURE	ABUT 1	ABUT 2	APPR SLAB 1	APPR SLAB 2	TRAINING	EROSION CONTROL	FULL E&C	BRIDGE QUANTITY	ROUND	GRAND TOTAL	FINAL	UNIT	ITEMS	ITEM NUMBER	QUANTITIES	UNIT	ITEMS			
5								10				15		CM	STONE FILL, TYPE I	613.10						
								10				10		CM	STONE FILL, TYPE I (MOD. 1 - CHECK DAMS)	613.10						
								10				10		CM	STONE FILL, TYPE I (MOD. 2 - STABILIZED CONSTRUCTION ENTRANCE)	613.10						
730	480									480		1210		CM	STONE FILL, TYPE III	613.12						
1												1		EACH	RELOCATE MAIL BOX, SINGLE SUPPORT	617.10						
110												110		M	SNOW FENCE (MOD. - ARCH.)	620.70						
								430				430		M	SNOW FENCE (MOD. - PDF)	620.70						
182												182		M	HEAVY DUTY STEEL BEAM GUARD RAIL (GALVANIZED)	621.21						
4												4		EACH	ANCHOR FOR STEEL BEAM RAIL	621.60						
4												4		EACH	GUARD RAIL APPR. SECTION, NETC 2 RAIL	621.72						
102												102		M	TEMPORARY TRAFFIC BARRIER	621.90						
			6	6							12	12		EACH	EARTH PRESSURE CELL	623.60						
50												50		HR	FLAGGERS	630.15						
100												100		HR	FLAGGERS (MOD. - RAILROAD)	630.15						
												1		LS	FIELD OFFICE-ENGINEERS	631.10						
												1		LS	TESTING EQUIPMENT - CONCRETE	631.16			N.A.B.I. = NOT A BID ITEM			
												1		LS	TESTING EQUIPMENT - BITUMINOUS	631.17						
												1		LU	FIELD OFFICE - TELEPHONE (N.A.B.I.)	631.25						
											520	520		HR	EMPLOYEE TRAINEESHIP	634.10						
1												1		LS	MOBILIZATION / DEMOBILIZATION	635.11						
1												1		LS	TRAFFIC CONTROL	641.10						
630												630		M	100 mm YELLOW LINE	646.21						
25												25		M	600 mm STOP BAR	646.26						
4												4		EACH	LETTER OR SYMBOL	646.30						
2												2		EACH	RAILROAD CROSSING SYMBOL	646.32						
			170	150							320	320		SM	GEOTEXTILE FOR ROADBED SUBGRADE SEPARATOR (MOD.)	649.11						
1310	530		250	240							1020	2330		SM	GEOTEXTILE UNDER STONE FILL	649.31						
130												130		SM	GEOTEXTILE FOR UNDERDRAIN TRENCH LINING	649.41						
			80	80							160	160		SM	GEOTEXTILE FOR UNDERDRAIN TRENCH LINING (MOD.)	649.41						
								545				545		SM	GEOTEXTILE FOR SILT FENCE	649.51						
								110				110		SM	GEOTEXTILE FOR FILTER CURTAIN	649.61						
								20				20		KG	SEED	651.15						
								5				5		KG	SEED-WINTER RYE	651.17						
								130				130		KG	FERTILIZER	651.18						
								1.5				1.5		T	AGRICULTURAL LIMESTONE	651.20						
								1.5				1.5		T	HAYMULCH	651.25						
								140				140		CM	TOPSOIL	651.35						
680	460									460		1140		SM	GRUBBING MATERIAL	651.40						
								1				1		LS	EROSION PREVENTION & SEDIMENT CONTROL PLAN	652.10						
								50				50		HR	MONITORING EROSION PREVENTION & SEDIMENT CONTROL PLAN	652.20						
								1				1		LU	MAINTENANCE OF EROSION PREVENTION & SEDIMENT CONTROL PLAN	652.30						
															(N.A.B.I.)							
								140				140		SM	EROSION MATTING	654.10						
2.7												2.7		SM	TRAFFIC SIGNS, TYPE A	675.20						
15												15		M	FLANGED CHANNEL SIGN POST	675.301						
15												15		M	SQUARE TUBE SIGN POSTS AND ANCHOR	675.341						
6												6		EACH	REMOVING SIGNS	675.50						
2												2		EACH	ERECTING SALVAGED SIGNS	675.60						

PROJECT NAME: **LEICESTER**
 PROJECT NUMBER: **BRF 0160 (3) S**
 FILE NAME: 05j288\Structures\sj288qnt.xls PLOT DATE: 04/07/2005
 PROJECT MANAGER: R. R. WHITCOMB DRAWN BY: G. ROY
 DESIGNED BY: C. CARLSON CHECKED BY: C. CARLSON
 QUANTITY SHEET #2 SHEET 5 OF 90

RIGHT - OF - WAY DETAIL SHEET




TABLE OF PROPERTY ACQUISITION

PARCEL NO.	PROPERTY OWNER	SHEET NO.	BEGINNING STATION	ENDING STATION	TAKE AREA ±	REMAINDER AREA ±	RIGHT			RECORDING DATA				REMARKS	
							TYPE	(T)/(P)	AREA ±	TITLE	DATE	TOWN / CITY	BOOK		PAGE
1A	STATE OF VERMONT JOINED BY VERMONT RAILWAY, INC.	11	0+959.7 LT. 0+993.7 LT.	1+001.2 LT.			DRIVE CONST.	(T) (T)	9 S.M. ±			LEICESTER			PAVED 42.4' INCL. PDF, 97 S.F. ±
1B			0+976.57 RT.	0+991.7 RT.			SLOPE	(T)	10 S.M. ±						108 S.F. ±
2	LAMOUREUX, LEO J. & ARLENE J.	12	1+000.3 LT. 1+004.7 LT. 1+015.0 LT. 1+012.1 LT. 1+028.0 LT. 1+021.3 LT. 1+028.3 LT. 1+035.4 LT.	1+018.2 LT. 1+111.3 LT. 1+023.5 LT. 1+035.4 LT. 1+080.0 LT. 1+111.5 LT.			CONST. UTILITY EASEMENT INSTALL & MAINTAIN SLOPE DRIVE CONST. SLOPE DETOUR	(T) (P) (P) (T) (T) (T) (T) (T)	49 S.M. ± 696 S.M. ± 11 S.M. ± 153 S.M. ± 0.11 HA ±			LEICESTER			INCL. PDF & EROSION CONTROL, 527 SF ± 7492 S.F. ± 2-GUYWIRES 118 S.F. ± GRAVEL, 16.4 ± INCL. PDF & EROSION CONTROL, 775 SF ± 1647 SF ±
3	FOX, CATLIN J. & CLAGHORN, ANNE W.; JOINED BY VERMONT LAND TRUST INC.	12	1+109.59 LT.	1+137.32 LT.	739.32SM ±							LEICESTER			7958.23 SF ±
4	LAJEUNESSE, KENNETH A. & BOBBI J. DICKSON & LAJEUNESSE, AGNES L., LIFE ESTATE	12,13	1+152.5 LT. 1+153.0 LT. 1+153.1 LT. 1+153.1 LT. 1+153.1 LT.	1+161.5 LT. 1+184.0 LT. 1+259.2 LT. 1+252.9 LT. 1+259.2 LT.			CUL., DIT. & DR. DETOUR UTILITY EASEMENT SLOPE CONST.	(P) (T) (P) (T) (T)	43 S.M. ± 56 SM ± 601 S.M. ± 390 S.M. ± 661 S.M. ±			LEICESTER			463 S.F. ± 603 SF ±; TWO WAY DETOUR 6469 S.F. ± 4198 S.F. ± INCL. ARCHEOLOGICAL FENCE & PDF & EROSION CONTROL, 7115 S.F. ± GUYWIRE
5	STONE, THOMAS P., CRAM, DWIGHT A. & BETTYA.	12,13	1+105.0 RT. 1+113.2 RT. 1+144.2 RT. 1+162.0 RT. 1+162.7 RT. 1+228.9 RT.	1+160.0 RT. 1+128.8 RT. 1+211.7 RT. 1+251.9 RT.			CONST. CHANNEL SLOPE INSTALL & MAINTAIN INSTALL & MAINTAIN SLOPE	(T) (P) (P) (P) (P) (T)	482 S.M. ± 39 S.M. ± 81 S.M. ± 15 S.M. ±			LEICESTER			INCL. EROSION CONTROL & PDF; 5188 SF ± 420 S.F. ± 872 SF ±; INCL. TEMP. EROSION CONTROL & PDF POLE GUYWIRE 161 SF ±; INCL. TEMP. EROSION CONTROL & PDF
6	DIKE, STEPHEN & DEBORAH	12	1+029.2 RT. 1+046.5 RT. 1+044.2 RT. 1+052.5 RT. 1+054.2 RT. 1+074.5 RT.	1+041.9 RT. 1+074.5 RT. 1+107.5 RT. 1+096.3 RT.			SLOPE DRIVE SLOPE CONST. CHANNEL	(T) (T) (T) (T) (P)	19 S.M. ± 59 S.M. ± 510 S.M. ± 29 S.M. ±			LEICESTER			205 S.F. ± PAVED 28' 635 S.F. ± 5490 S.F. ±; INCLUDES EROSION CONTROL & PDF MONITOR WELL 312 S.F. ±
7	LAROCQUE, WILLIAM J.	11	0+948.5 RT. 0+967.1 RT. 0+957.2 RT.	0+979.6 RT. 0+980.9 RT. 0+977.9 RT.			CONST. UTILITY EASEMENT SLOPE	(T) (P) (T)	80 S.M. ± 90 S.M. ± 34 S.M. ±			LEICESTER			INCL. PDF, 861 S.F. ± 969 S.F. ± 366 S.F. ±
8	CENTRAL VERMONT PUBLIC SERVICE, INC.														UTILITY
9	VERIZON NEW ENGLAND, INC.														UTILITY

TABLE OF REVISIONS

REVISION NO.	SHEET NO.	DESCRIPTION	DATE
1	10,12	PARCEL NO. 2 LAMOUREUX. CHANGE ENDING STA. OF CONST. (T) FROM 1+111.4 LT. TO 1+035.4 LT.; 72 SM ±; 775 SF ±; ADD DETOUR (T) 1+035.4 LT. ~ 1+111.5 LT.; 0.11HA ±; 0.28 A ±; PER C.O. 9425. MADE BY: MR APPROVED BY: RPD	06/09/2005
2	10,12,13	PARCEL NO. 4 LAJEUNESSE. ADD DETOUR (T) AT STA. 1+153.0 LT. ~ 1+164.0 LT.; 56 SM ±; 603 SF ±; PER C.O. 9426. MADE BY: MR APPROVED BY: RPD	06/09/2005
3	10,12,13	PARCEL NO. 5 STONE & CRAM. CHANGE DETOUR (T) TO CONST. (T) WITH AN ENDING STATION OF 1+160.0 RT.; 482 SM ±; 5,188 SF ±; PER C.O. 9427 MADE BY: MR APPROVED BY: RPD	06/09/2005
4	10,12	PARCEL NO. 6 DIKE. CHANGE DETOUR (T) TO CONST. (T) WITH A BEGINNING STA. OF 1+052.5 RT.; 510 SM ±; 5,490 SF ±; PER C.O. 9426 MADE BY: MR APPROVED BY: RPD	06/09/2005
5	10,12,13	PARCEL NO. 4 LAJEUNESSE. ADD BOBBI J. DICKSON AS AN OWNER. PER C.O. 9429. MADE BY: MR APPROVED BY: RPD	06/27/2004
		ELECTRONIC FILES TO STRUCTURES	07/08/2005

PLAN LEGEND

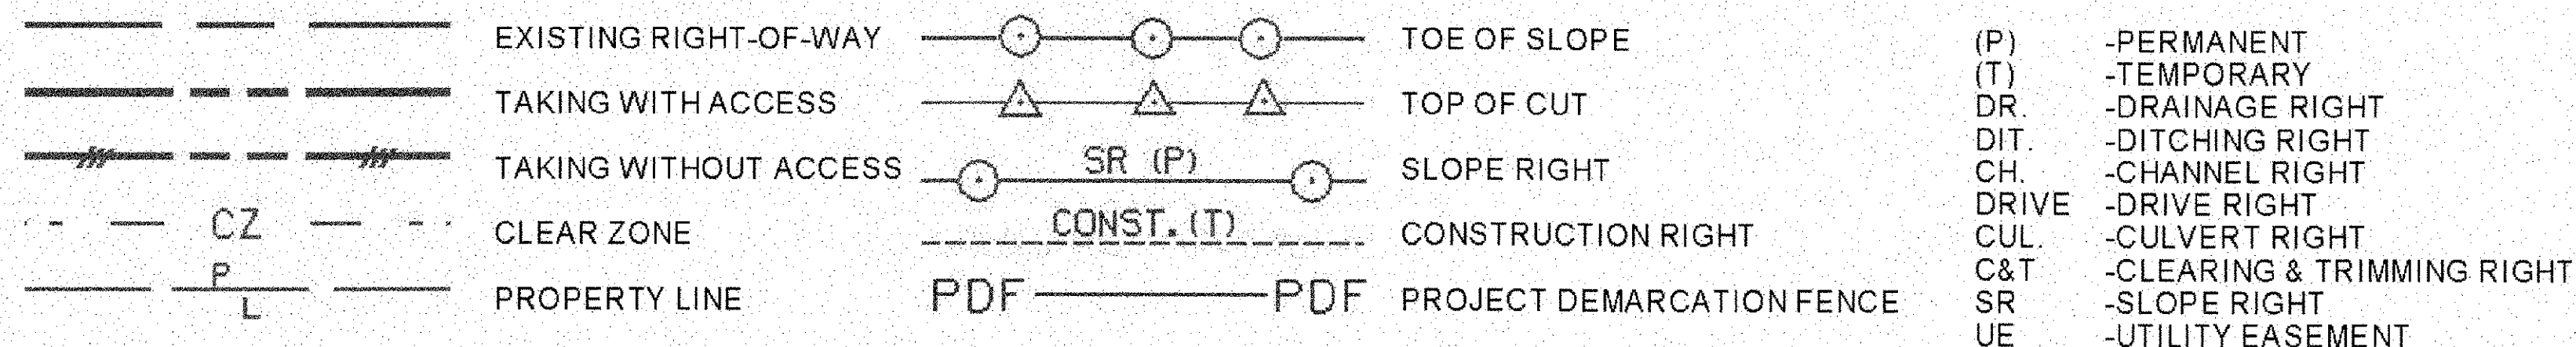

APPROVED: ROGER P. DUMAS DATE: 07-22-03
CHIEF, PLANS & TITLES

PROJECT NAME:	LEICESTER	PLOT DATE:	02/23/05
PROJECT NUMBER:	BRF0160(3) S	DRAWN BY:	G. FUNK
FILE NAME:	rrow/rj088d.xls	CHECKED BY:	B. TERHUNE
PROJECT LEADER:	G.S. ROGERS	R.O.W. SHEET	10 OF 13
DESIGNED BY:	C. MEUNIER	SHEET	6 OF 90

NF
DEPOT FARM SUPPLY, INC.

CONSTRUCT DRIVES

DRIVE LEFT

STA 0+959.740 (PAVED APRON)

150mm UNDERDRAIN

STA 0+994.330 LT - STA 1+015.000 LT
STA 0+999.720 RT - STA 1+015.000 RT

1A
STATE OF VERMONT
JOINED BY
VERMONT RAILWAY, INC.

BEGIN R.O.W. PROJECT
BRF 0160 (3)S STA. 0+948.5
6.9M(22.6') RT.

TH #1 RAILROAD CROSSING
PROJECT STA. 0+994.253 =
RR VALUATION STA. 4029+50.000
(AAR DOT #851-339R, RR MP 77.34)

LAWN

BEGIN APPROACH
Sta 0+950.000

BEGIN PROJECT
END APPROACH
Sta 0+975.000

COMB
#72-1A/1/220

GRAVEL DRIVE

DRIVE(T)

GRAVEL DRIVE

0+920 TO WHITING 0+940

0+960

0+980

1+000

PIPE: SIZE
AND OUTLET
UNKNOWN
(PLUGGED)

#49/72-1

GUY WIRE

SR(T)

GUY WIRE

SR(T)

GUY WIRE

SR(T)

GUY WIRE

SR(T)

GUY WIRE

TEL (NONE)

EL #72

CLASS II WETLANDS

DITCH

GUY WIRE

TEL (NONE)


EL #72

LAWN

7
LAROCQUE,
WILLIAM J.


LINES SHOWN ON THIS PLAN AS EXISTING
PROPERTY LINES P/L ARE BELIEVED TO
BE ACCURATE BUT SHOULD NOT BE RELIED
UPON FOR PURPOSES UNRELATED TO THE
TOWN OF LEICESTER'S ACQUISITION OF LAND
AND RIGHTS FOR THIS PROJECT.

NOTES:
CONTOURS SHOWN INDICATE THE EXISTING SITE.
SEE CROSS SECTION AND CHANNEL SECTION SHEETS
FOR GRADE CHANGES.

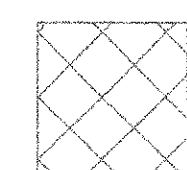

INDICATES APPROXIMATE RAILROAD WORK AREA.
WORK IN THIS AREA TO BE PERFORMED BY VERMONT
RAILWAY. SEE PROJECT NOTE 16 ON SHEET 47 AND
SHEET 38a FOR ADDITIONAL INFORMATION.

SEE LINE STRIPING AND SIGN LAYOUT
ON SHEET 36.

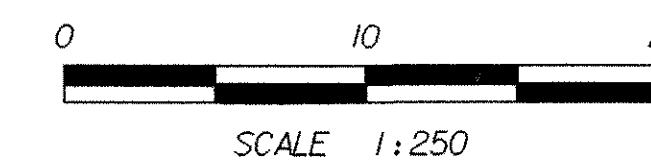

1B
STATE OF VERMONT
JOINED BY
VERMONT RAILWAY, INC.

FOR R.O.W.
USE ONLY

SHEET NAME: PLAN LAYOUT #1	
PROJECT NAME: LEICESTER	HIGHWAY NO.: FAS 0160
PROJECT NUMBER: BRF 0160(3)S	BRIDGE NO.: 6
	OVER: OTTER CREEK
FILE NAME: 95J288\Structures\sj288bdr.dgn	PLOT DATE: 17-AUG-2005
PROJECT MANAGER: R. R. WHITCOMB	DRAWN BY: J. GILMORE
DESIGNED BY: C. CARLSON	IPARM NAME: sj088ps11
R.O.W. SHEET 11 OF 13	SHEET 7 OF 90

CONSTRUCT DRIVES

DRIVE LEFT
STA 1+026.000 (GRAVEL w/4000 PAVED APRON)

DRIVE RIGHT
STA 1+046.500 (PAVED)

GUARD RAIL HEAVY DUTY STEEL BEAM
STA 1+058.203 - STA 1+080.901 RT
STA 1+062.808 - STA 1+081.732 LT
STA 1+136.198 - STA 1+160.000 RT
§ STA 2+007.545 - § STA 2+032.876 LT

ANCHOR FOR STEEL BEAM RAIL
STA 1+060.000 RT
STA 1+065.000 LT
§ STA 2+031.000 LT

BRIDGE RAILING - NETC 2 RAIL
STA 1+088.521 - STA 1+128.734 RT
STA 1+089.350 - STA 1+129.593 LT

BRIDGE APPROACH SECTION - NETC 2 RAIL
STA 1+080.901 - STA 1+088.521 RT
STA 1+081.732 - STA 1+089.350 LT
STA 1+128.734 - STA 1+136.198 RT
STA 1+129.593 - § STA 2+007.545 LT

RELOCATE MAILBOX, SINGLE SUPPORT
STA 1+055 LT

PIPE OPTIONS § STA 2+020 WITH
3000 x 2000 STONE FILL, TYPE I PAD AT INLET & TYPE III AT OUTLET

600 PCCSP x 27.43m
600 CAAP x 27.43m
600 CPEP x 27.43m

§ CURVE DATA
Radius = 300.000
 $\Delta = 6^{\circ}30'03.1''$
Length = 34.038
Tangent = 17.038
Chord = 34.020
External = 0.483
Middle Ordinate = 0.483
Bank = Normal

END SIDELINE APPROACH
Sta 2+070

ARCHAEOLOGICAL FENCING SENSITIVE AREA KEEP OUT

LAJEUNESSE, KENNETH A. & BOBBI J. DICKSON & LAJEUNESSE, AGNES L., LIFE ESTATE

3
FOX, CATLIN J. & CLAGHORN, ANNE W. JOINED BY VERMONT LAND TRUST, INC.

2
LAMOUREUX, LEO J. & ARLENE J.

TH # 12 2+040.04
26.55M (87.11') LT.

TH # 12 2+040.00
7.66M (25.13') LT.

4

APPROXIMATE AERIAL RELOCATION ROUTE BY VERIZON TO BE DONE AFTER TEMPORARY DETOUR IS REMOVED

BENCH MARK NO. 2
R.R.S.I.T.
LARGE WILLOW
ELEV. 106.097

BEGIN SIDELINE APPROACH
Sta 2+004.200

REMOVE EXISTING 460 CGMP (POOR)

TH # 12 2+040.04
6.17M (20.24') LT.

TH # 12 2+040.00
6.28M (20.60') LT.

BEGIN BRIDGE
STA 1+091.320
T.C. = 108.538

END BRIDGE
STA 1+126.102

STONE FILL, TYPE III (TYP)

TEMPORARY DETOUR APPROXIMATE CENTERLINE

CH(P) 27.08M (88.85')

CUL., DIT., & DR. (P)

WILLOWS

WOODS

CLASS III WETLANDS

OTTER CREEK

WETLANDS

WOODS

CLASS III WETLANDS

WOODS

STONE FILL, TYPE III (TYP)

WOODS

CLASS III WETLANDS

WOODS

STONE FILL, TYPE III (TYP)

WOODS

CLASS III WETLANDS

WOODS

STONE FILL, TYPE III (TYP)

WOODS

CLASS III WETLANDS

WOODS

STONE FILL, TYPE III (TYP)

WOODS

CLASS III WETLANDS

5
STONE, THOMAS P. AND CRAM, DWIGHT A. & BETTY A.


FOR R.O.W. USE ONLY

LINES SHOWN ON THIS PLAN AS EXISTING PROPERTY LINES P/L ARE BELIEVED TO BE ACCURATE BUT SHOULD NOT BE RELIED UPON FOR PURPOSES UNRELATED TO THE TOWN OF LEICESTER'S ACQUISITION OF LAND AND RIGHTS FOR THIS PROJECT.

NOTE: CONTOURS SHOWN INDICATE THE EXISTING SITE. SEE CROSS SECTION AND CHANNEL SECTION SHEETS FOR GRADE CHANGES.

SEE LINE STRIPING AND SIGN LAYOUT ON SHEET 37.

FOR R.O.W.

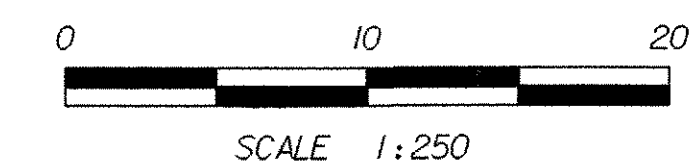

SHEET NAME: PLAN LAYOUT #2	
PROJECT NAME: LEICESTER	HIGHWAY NO.: FAS 0160
PROJECT NUMBER: BRF 0160(3)S	BRIDGE NO.: 6
	OVER: OTTER CREEK
FILE NAME: 95J288\Structures\sj288bdr.dgn	DATE: 17-AUG-2005
PROJECT MANAGER: R. R. WHITCOMB	DRAWN BY: J. GILMORE
DESIGNED BY: C. CARLSON	IPARM NAME: s1088ps2.1
R.O.W. SHEET 12 OF 13	SHEET 8 OF 90



ANCHOR FOR STEEL BEAM RAIL
1+243.900 RT


GUARD RAIL HEAVY DUTY STEEL BEAM
STA 1+160.000 - STA 1+245.420 RT

4

**LAJEUNESSE, KENNETH A.
&
BOBBI J. DICKSON &
LAJEUNESSE, AGNES L.,
LIFE ESTATE**

**END R.O.W. PROJECT
BRF 0160 (3)S STA. 1+259.2
7.2M (23.7')LT.**

BENCH MARK NO. 3
CH. S.O. LE
ELEV. 106.938

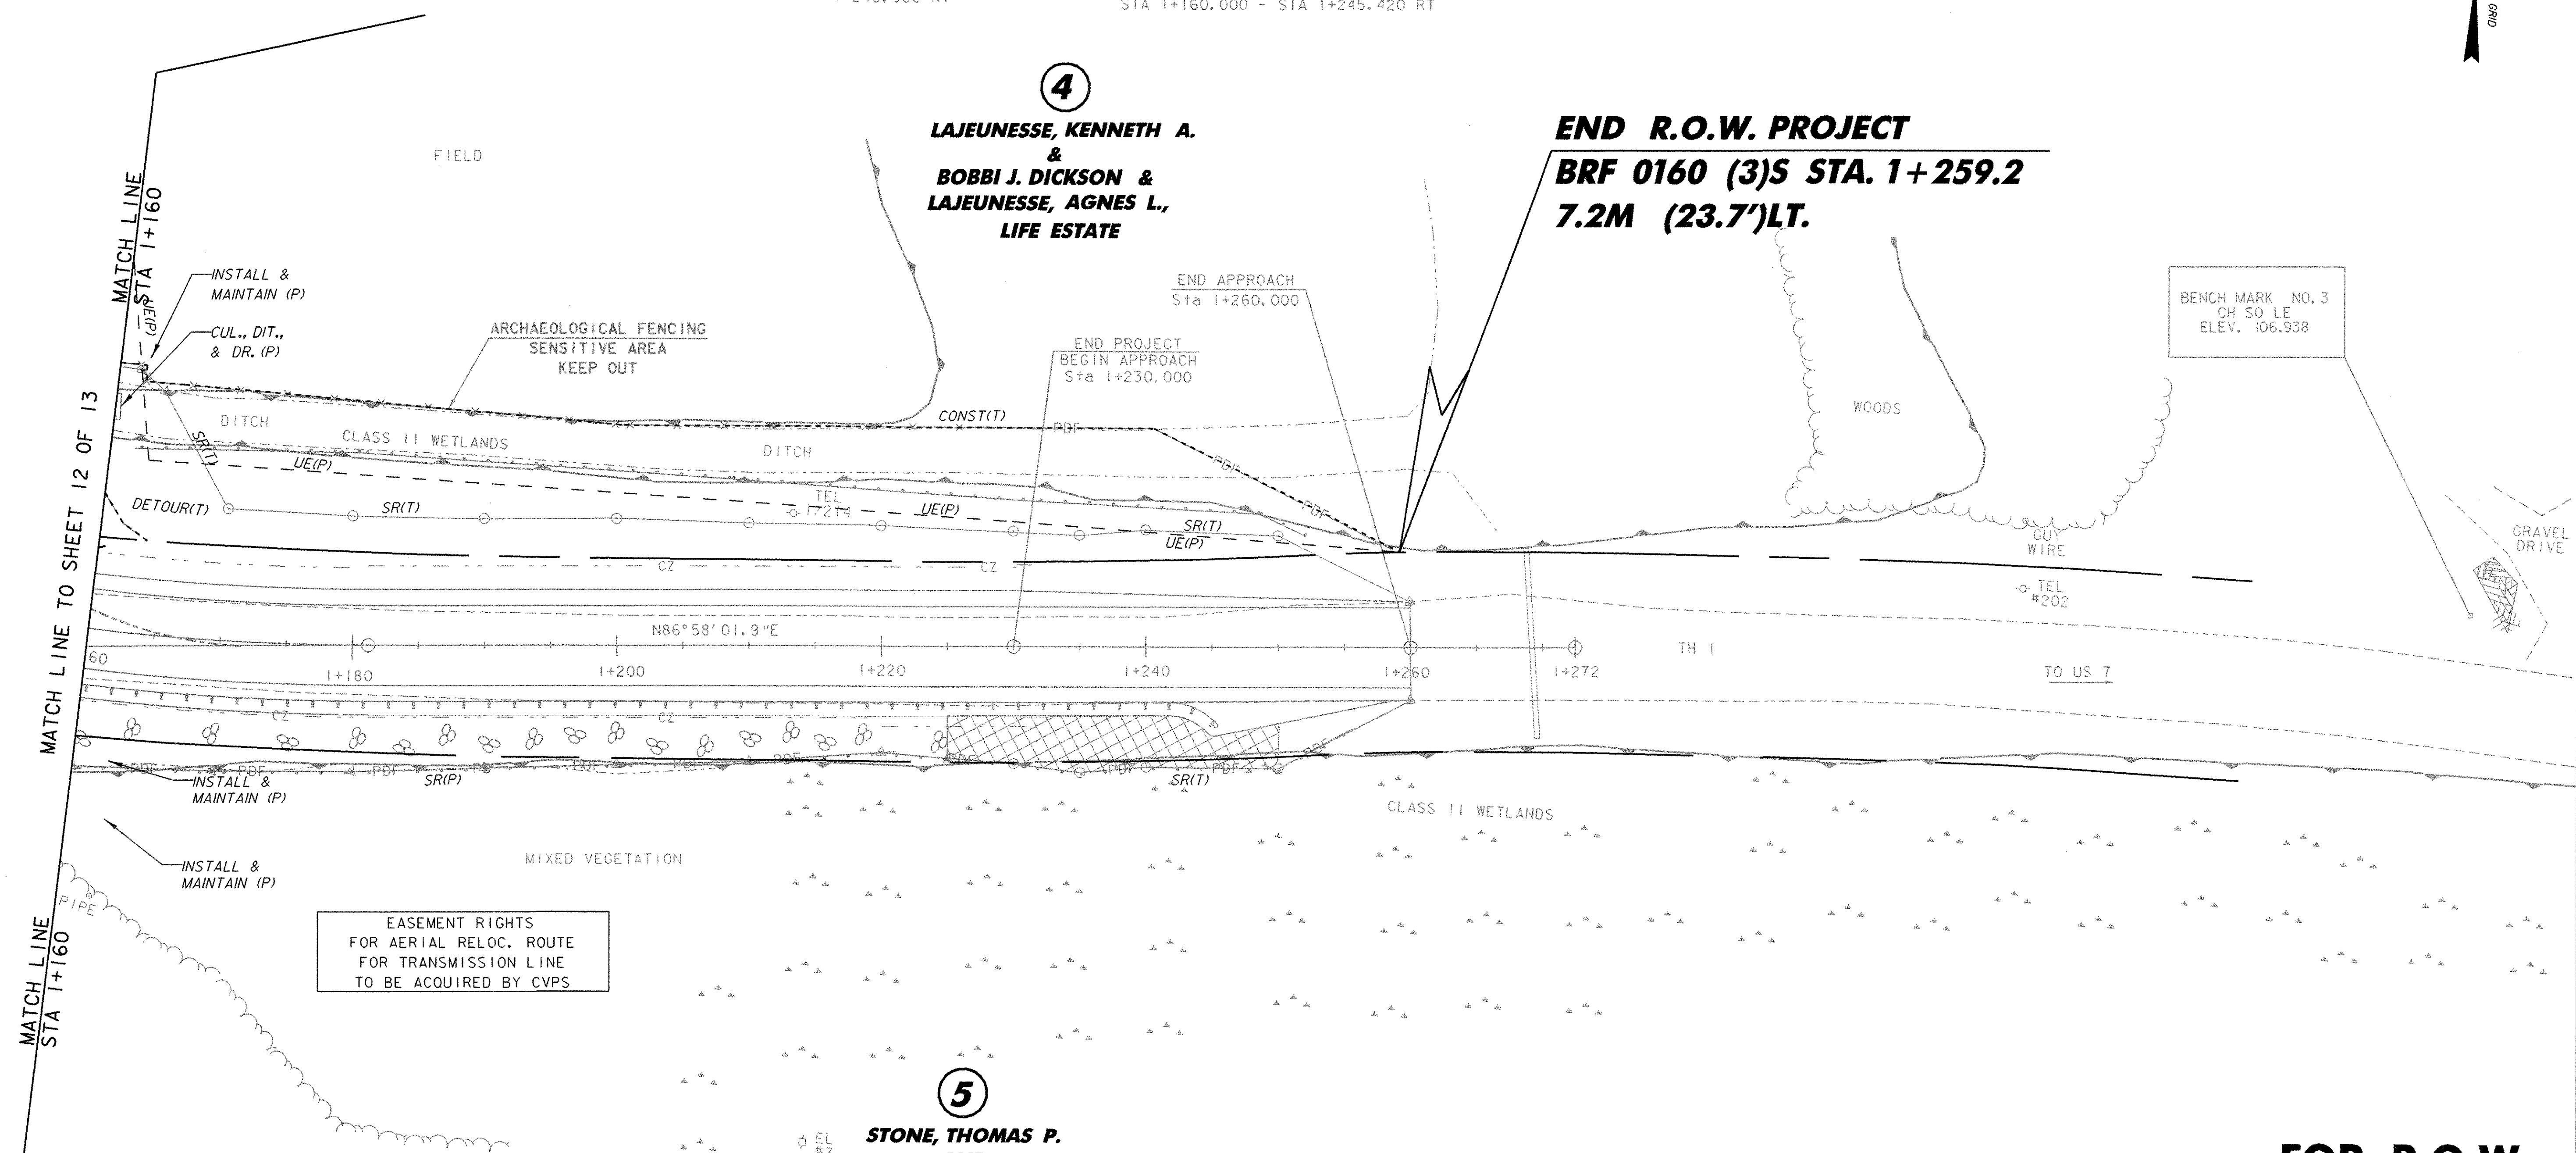

EASEMENT RIGHTS
FOR AERIAL RELOC. ROUTE
FOR TRANSMISSION LINE
TO BE ACQUIRED BY CVPS


5

**STONE, THOMAS P.
AND
CRAM, DWIGHT A.
& BETTY A.**

LINES SHOWN ON THIS PLAN AS EXISTING
PROPERTY LINES P/L ARE BELIEVED TO
BE ACCURATE BUT SHOULD NOT BE RELIED
UPON FOR PURPOSES UNRELATED TO THE
TOWN OF LEICESTER'S ACQUISITION OF LAND
AND RIGHTS FOR THIS PROJECT.

NOTE:
CONTOURS SHOWN INDICATE THE EXISTING SITE.
SEE CROSS SECTION AND CHANNEL SECTION SHEETS
FOR GRADE CHANGES.

**FOR R.O.W.
USE ONLY**

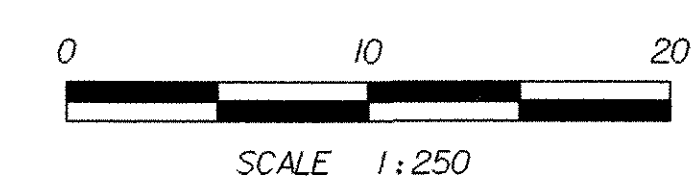

SHEET NAME: PLAN LAYOUT #3	
PROJECT NAME: LEICESTER	HIGHWAY NO.: FAS 0160
PROJECT NUMBER: BRF 0160(3)S	BRIDGE NO.: 6
	OVER: OTTER CREEK
FILE NAME: 95j288\Structures\sj288bdr.dgn	PLOT DATE: 17-AUG-2005
PROJECT MANAGER: R. R. WHITCOMB	DRAWN BY: J. GILMORE
DESIGNED BY: C. CARLSON	IPARM NAME: sj088ps3.1
R.O.W. SHEET 13 OF 13	SHEET 9 OF 90

HVCTRL #1

HVCTRL #2

GPS CONTROL POINTS

C.G.S. SURVEY DISK STAMPED
 "LIECESTER AZ MK"
 N = 150571.9737
 E = 449627.1798
 EL. = 0.000

GENERAL LOCATION, LEICESTER, 4.4 MI (7.1 KM) NORTH NORTHWEST OF BRANDON, 11.2 MI (18.0 KM) SOUTH OF MIDDLEBURY. OWNERSHIP, CHARLES SWININGTON.

TO REACH FROM THE MAIN CROSSROADS IN THE VILLAGE OF LEICESTER (INTERSECTION OF U.S. ROUTE 7, THE LEICESTER-WHITING ROAD, AND FERN LAKE ROAD) AT THE LEICESTER MEETING HOUSE AND CENTRAL SCHOOL GO WEST ALONG THE LEICESTER-WHITING ROAD FOR 1.25 MI (2.01 KM) TO A T-INTERSECTION. TURN LEFT AND GO SOUTH ALONG THE MAIN TRAVELED ROAD FOR 0.3 MI (0.5 KM) TO A T-ROAD RIGHT. CONTINUE STRAIGHT AHEAD (SOUTH) ALONG ARNOLD DISTRICT ROAD FOR 0.2 MI (0.3 KM) TO TELEPHONE POLE NO. 174 AND AZIMUTH MARK ON THE LEFT. IT IS 0.2 MI (0.3 KM) NORTH ALONG ARNOLD DISTRICT ROAD FROM NGS STATION LIECESTER. STATION MARK IS SET IN THE TOP OF A 9 FT (2.7 M) X 6 FT (1.8 M) BOULDER WHICH PROJECTS 4 FT (1.2 M) ABOVE GROUND SURFACE. IT IS 135 FT (41.1 M) EAST OF THE CENTERLINE OF ARNOLD DISTRICT ROAD, 198 FT (60.4 M) SOUTHWEST OF TELEPHONE POLE NO. 174, 165 FT (50.3 M) NORTHEAST OF THE TELEPHONE POLE NO. 173, 195 FT (59.4 M) SOUTH SOUTHWEST OF TRANSMISSION POLE NO. 50, 118 FT (36.0 M) EAST OF A FIBERGLASS WITNESS POST IN A WIRE FENCELINE.
 STATION LAST RECOVERED (1998)

C.G.S. SURVEY DISK STAMPED
 "LIECESTER"
 N = 150242.0070
 E = 449659.5940
 EL. = 141.197'


THE STATION IS LOCATED IN LEICESTER TOWNSHIP ABOUT 4 MI (6.4 KM) NORTH AND 2 MI (3.2 KM) WEST OF BRANDON, AND ABOUT 11 MI (17.7 KM) SOUTH AND 2 MI (3.2 KM) EAST OF MIDDLEBURY. OWNERSHIP--CHARLES SWININGTON, WHO LIVES IN THE FIRST HOUSE SOUTH OF THE STATION.

TO REACH THE STATION FROM THE MAIN CROSSROADS IN THE VILLAGE OF LEICESTER, AT A SCHOOL AND CHURCH, GO WEST ON A PAVED ROAD FOR 1.25 MI (2.01 KM) TO A T-INTERSECTION. TURN LEFT ON MAIN TRAVELED ROAD AND GO SOUTH FOR 0.3 MI (0.5 KM) TO A T-ROAD. CONTINUE STRAIGHT AHEAD FOR 0.4 MI (0.6 KM) TO A DIRT ROAD LEFT AND THE STATION ON THE RIGHT.

THE STATION MARK IS 36 FT (11.0 M) NORTHEAST OF UTILITY POLE NUMBER 53, 14 FT (4.3 M) SOUTH OF A LARGE EXPOSED BOULDER, 13.5 FT (4.1 M) WEST OF WEST EDGE OF PAVEMENT AND 6.6 FT (2.0 M) WEST OF FIBERGLASS WITNESS POST ALONG THE FENCE LINE WEST OF ROAD.
 STATION MARK IS A STANDARD DISK SET TOP OF A 12 INCH SQUARE CONCRETE MONUMENT. OWNERSHIP, SWININGTON WITH CVPS EASEMENT.
 STATION LAST RECOVERED (1995)


* DESCRIPTION PROVIDED BY VERMONT AGENCY OF TRANSPORTATION GEODETIC SURVEY UNIT.

TRAVERSE TIES

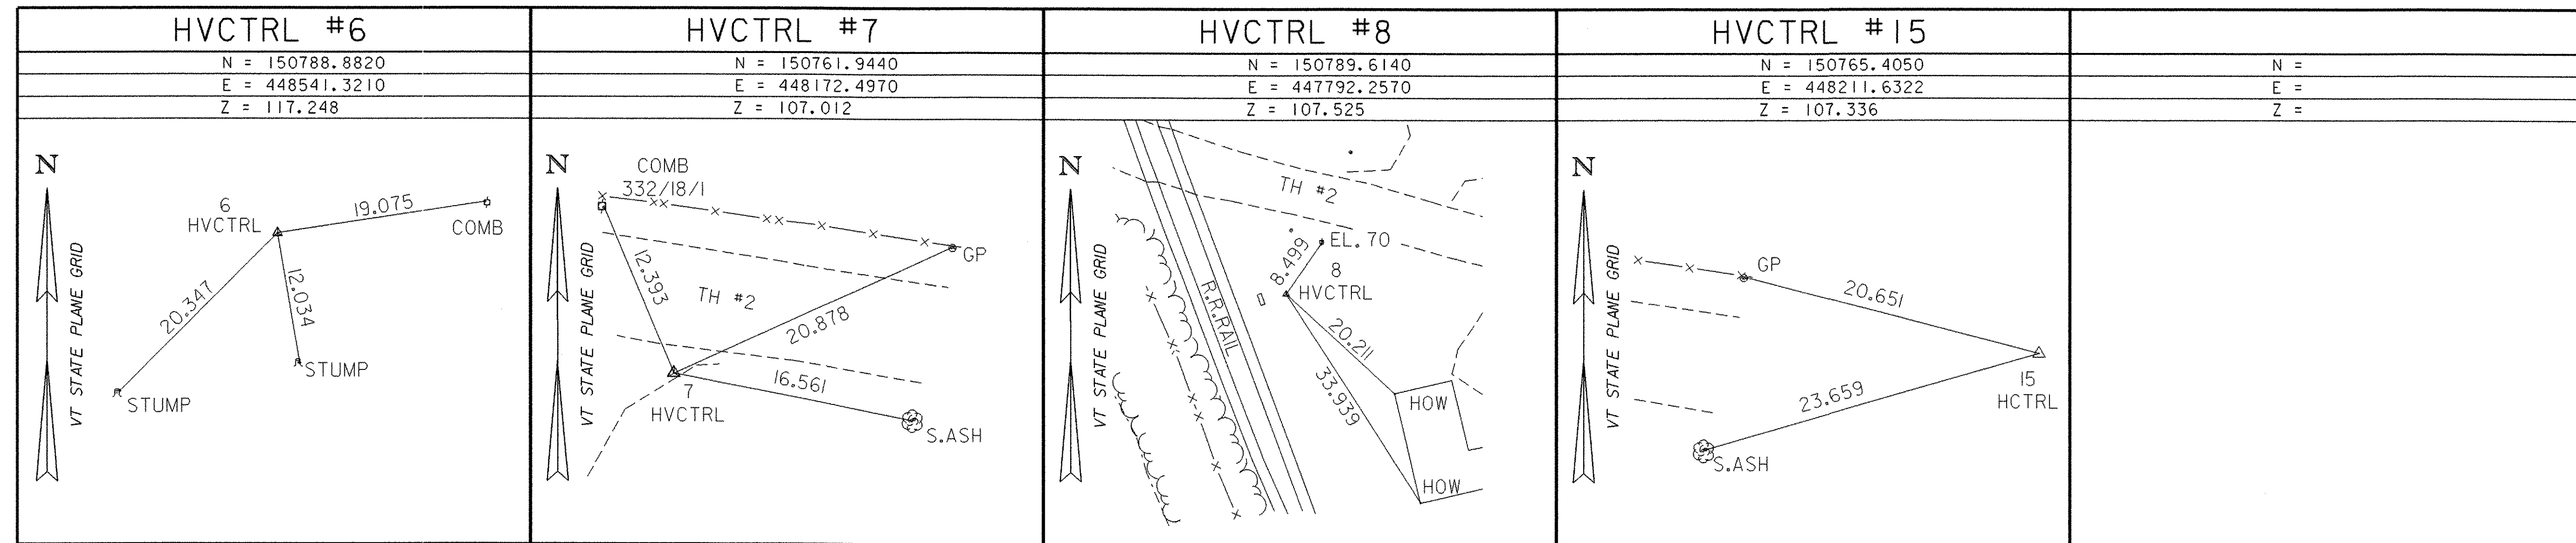

* MAIN TRAVERSE COMPLETED FEB. 08, 1996. SURVEYED BY L.ORVIS & R.BULLOCK

ALIGNMENT TIES

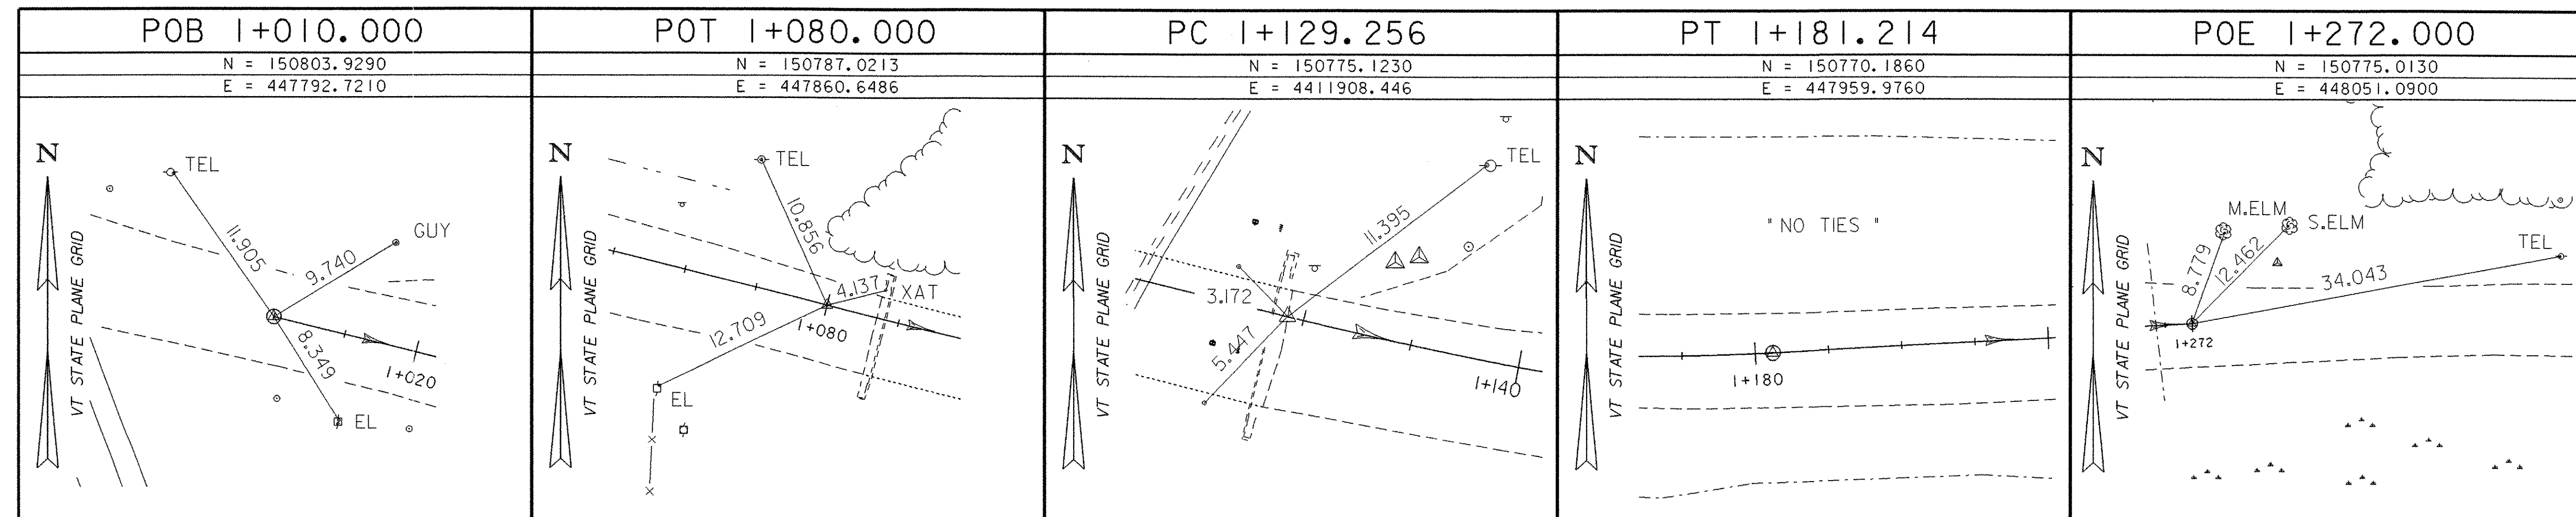

* ALIGNMENT STAKED DEC. 14, 1999. SURVEYED BY L.ORVIS & J.HULETT


DATUM	
VERTICAL	NAVD 88
HORIZONTAL	NAD 83/92
ADJUSTED	YES
TYPE	COMPASS

SHEET NAME: TIE SHEET	
PROJECT NAME: LEICESTER	HIGHWAY NO.: FAS 0160
PROJECT NUMBER: BRF 0160(3)S	BRIDGE NO.: 6
	OVER: OTTER CREEK
FILE NAME: /PW/95J288/sj288tie.dgn	PLOT DATE: 17-AUG-2005
PROJECT MANAGER: R. R. WHITCOMB	DRAWN BY: CAH
DESIGNED BY: C. CARLSON	IPARM NAME: sj088tie.1
BRIDGE SHEET NUMBER:	SHEET 10 OF 90

NOTE: TIE DISTANCES ARE IN METERS




CONSTRUCT DRIVES
 DRIVE LEFT
 STA 0+959.740 (PAVED APRON)
 150mm UNDERDRAIN
~~STA 0+994.330 LT - STA 1+015.000 LT~~
~~STA 0+999.720 RT - STA 1+015.000 RT~~
 30.48m INSTALLED PARALLEL TO
 TRACKS BY R&R REPRESENTATIVE

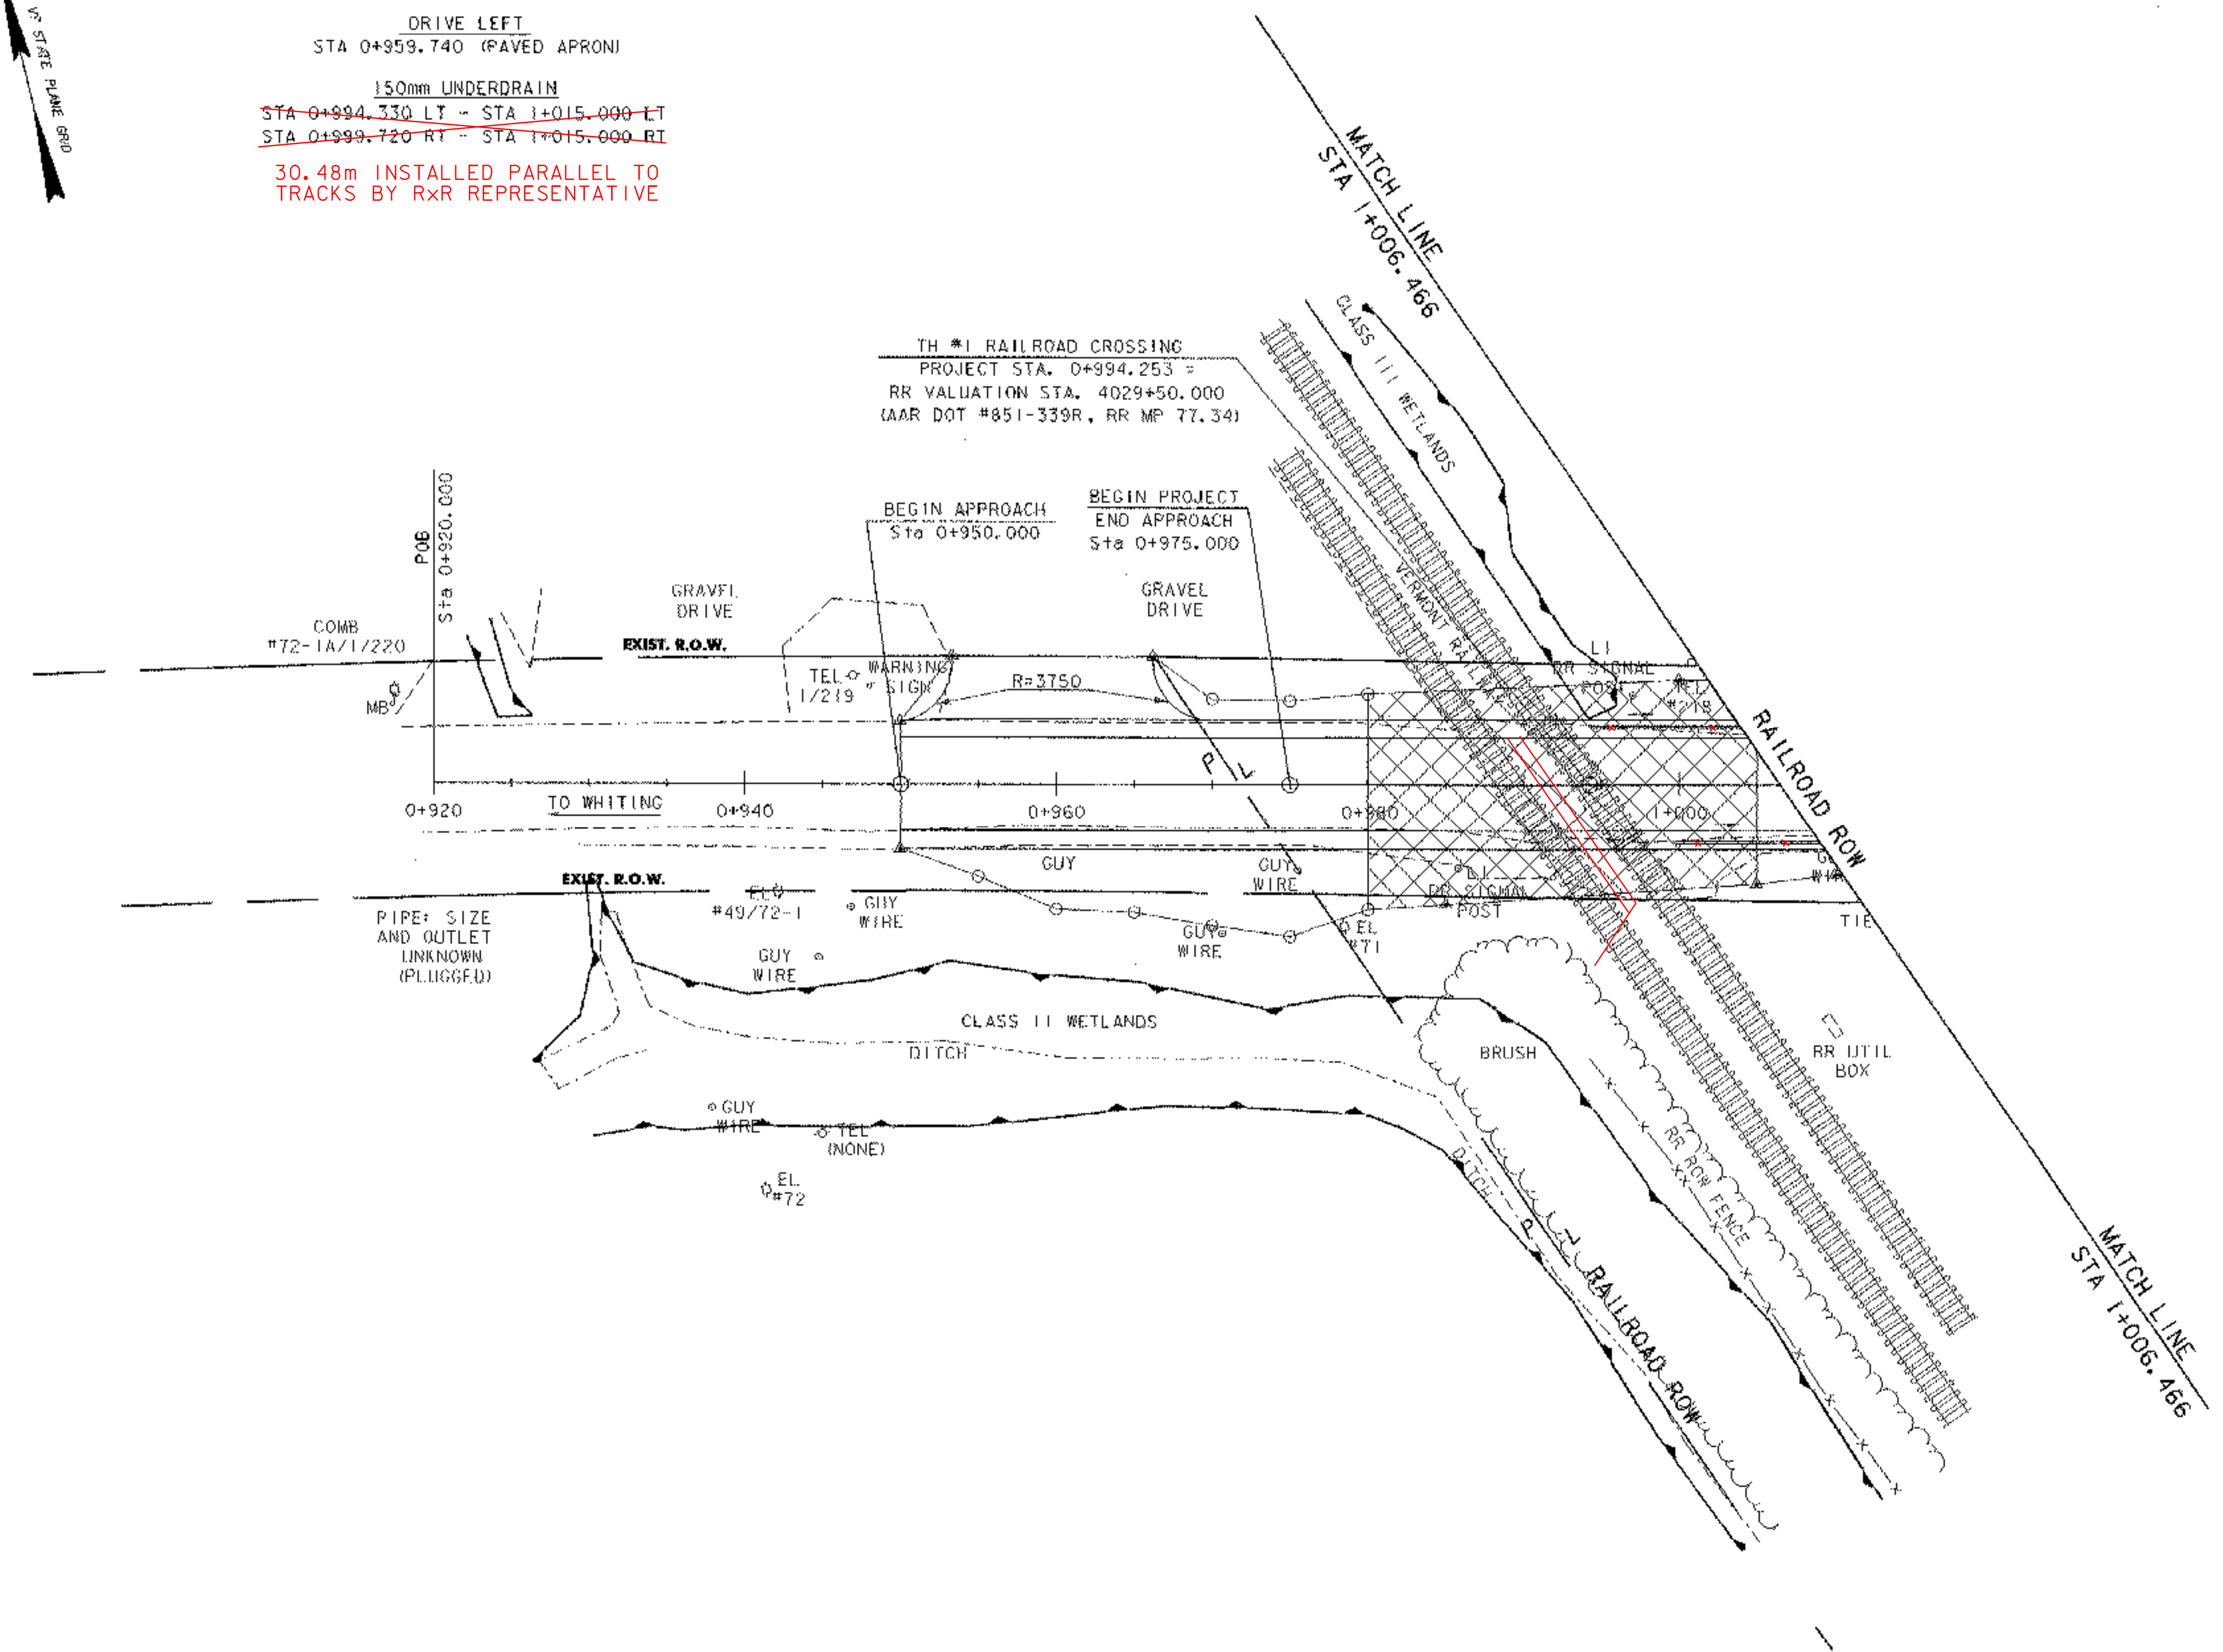

INDICATES APPROXIMATE RAILROAD WORK AREA.
 WORK IN THIS AREA TO BE PERFORMED BY VERMONT
 RAILWAY. SEE PROJECT NOTE 16 ON SHEET 47 AND
 SHEET 38a FOR ADDITIONAL INFORMATION.

SEE LINE STRIPING AND SIGN LAYOUT
 ON SHEET 36.

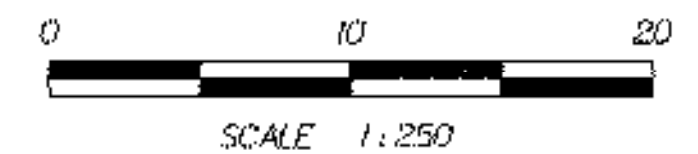

SHEET NAME: PLAN LAYOUT #1	
PROJECT NAME: LEICESTER	HIGHWAY NO.: FAS 0160
PROJECT NUMBER: BRF 0160(3)S	BRIDGE NO.: 6
	OVER: OTTER CREEK
FILE NAME: 95j288\Structures\sj288bdr.dgn	PLOT DATE: 17-AUG-2005
PROJECT MANAGER: R. R. WHITCOMB	DRAWN BY: J. GILMORE
DESIGNED BY: C. CARLSON	IPARM NAME: sj008ps1
BRIDGE SHEET NUMBER:	SHEET 11 OF 90

CONSTRUCT DRIVES

DRIVE LEFT
STA 1+026.000 (GRAVEL w/4000 PAVED APRON)

DRIVE RIGHT
STA 1+046.500 (PAVED)

GUARD RAIL HEAVY DUTY STEEL BEAM
1+057.431 STA 1+058.203 - STA 1+080.901 RT
1+062.072 STA 1+062.808 - STA 1+081.732 LT
STA 1+136.198 - STA 1+160.000 RT
STA 2+007.545 - STA 2+032.876 LT

ANCHOR FOR STEEL BEAM RAIL
STA 1+060.000 RT
STA 1+065.000 LT
STA 2+031.000 LT

BRIDGE RAILING - NETC 2 RAIL
STA 1+088.521 - STA 1+128.734 RT
STA 1+089.350 - STA 1+129.593 LT

BRIDGE APPROACH SECTION - NETC 2 RAIL
STA 1+080.903 - STA 1+088.521 RT
STA 1+081.732 - STA 1+089.350 LT
STA 1+128.734 - STA 1+136.198 RT
STA 1+129.593 - STA 2+007.545 LT

RELOCATE MAILBOX, SINGLE SUPPORT
STA 1+056 LT
1+035 LT

150mm UNDERDRAIN CARRIER PIPE
STA 1+015.000 RT - STA 1+015.000 LT

PIPE OPTIONS @ STA 2+020 WITH 3000 x 2000 STONE FILL, TYPE I PAD AT INLET & TYPE III AT OUTLET

600 PCCSP x 27.43m
600 CAAP x 27.43m
600 CPEP x 27.43m

POE
Sta 2+079.949

CURVE DATA
Radius = 300.000
 $\Delta = 6^{\circ}30'03.1''$
Length = 34.038
Tangent = 17.038
Chord = 34.020
External = 0.483
Middle Ordinate = 0.483
Bank = Normal

PI Sta 2+029.850 BK =
Sta 2+029.812 AH
 $\Delta = 3^{\circ}$ RT
PC
Sta 2+012.813

BEGIN SIDELINE APPROACH
Sta 2+004.200
REMOVE EXISTING 460' COMP (POOR)

END BRIDGE
STA 1+126.102
F.G. = 108.475

BEGIN BRIDGE
STA 1+091.320
F.G. = 108.548
STONE FILL, TYPE III (TYP)

TEMPORARY DETOUR APPROXIMATE CENTERLINE

POC STA 1+143.820 =
STA 2+000
 $\Delta = 90^{\circ}$ LT


CURVE DATA
 $\Delta = 17^{\circ}00'39.6''$
R = 175.00
T = 26.171
L = 51.957
E = 1.946
BANK = 0.060 m/m (MAX)

END SIDELINE APPROACH
Sta 2+070

ARCHAEOLOGICAL FENCING SENSITIVE AREA KEEP OUT


PT
Sta 2+046.851

TEMP. B.M.
#72 R.R.S.I.T.
ELEV. 106.269

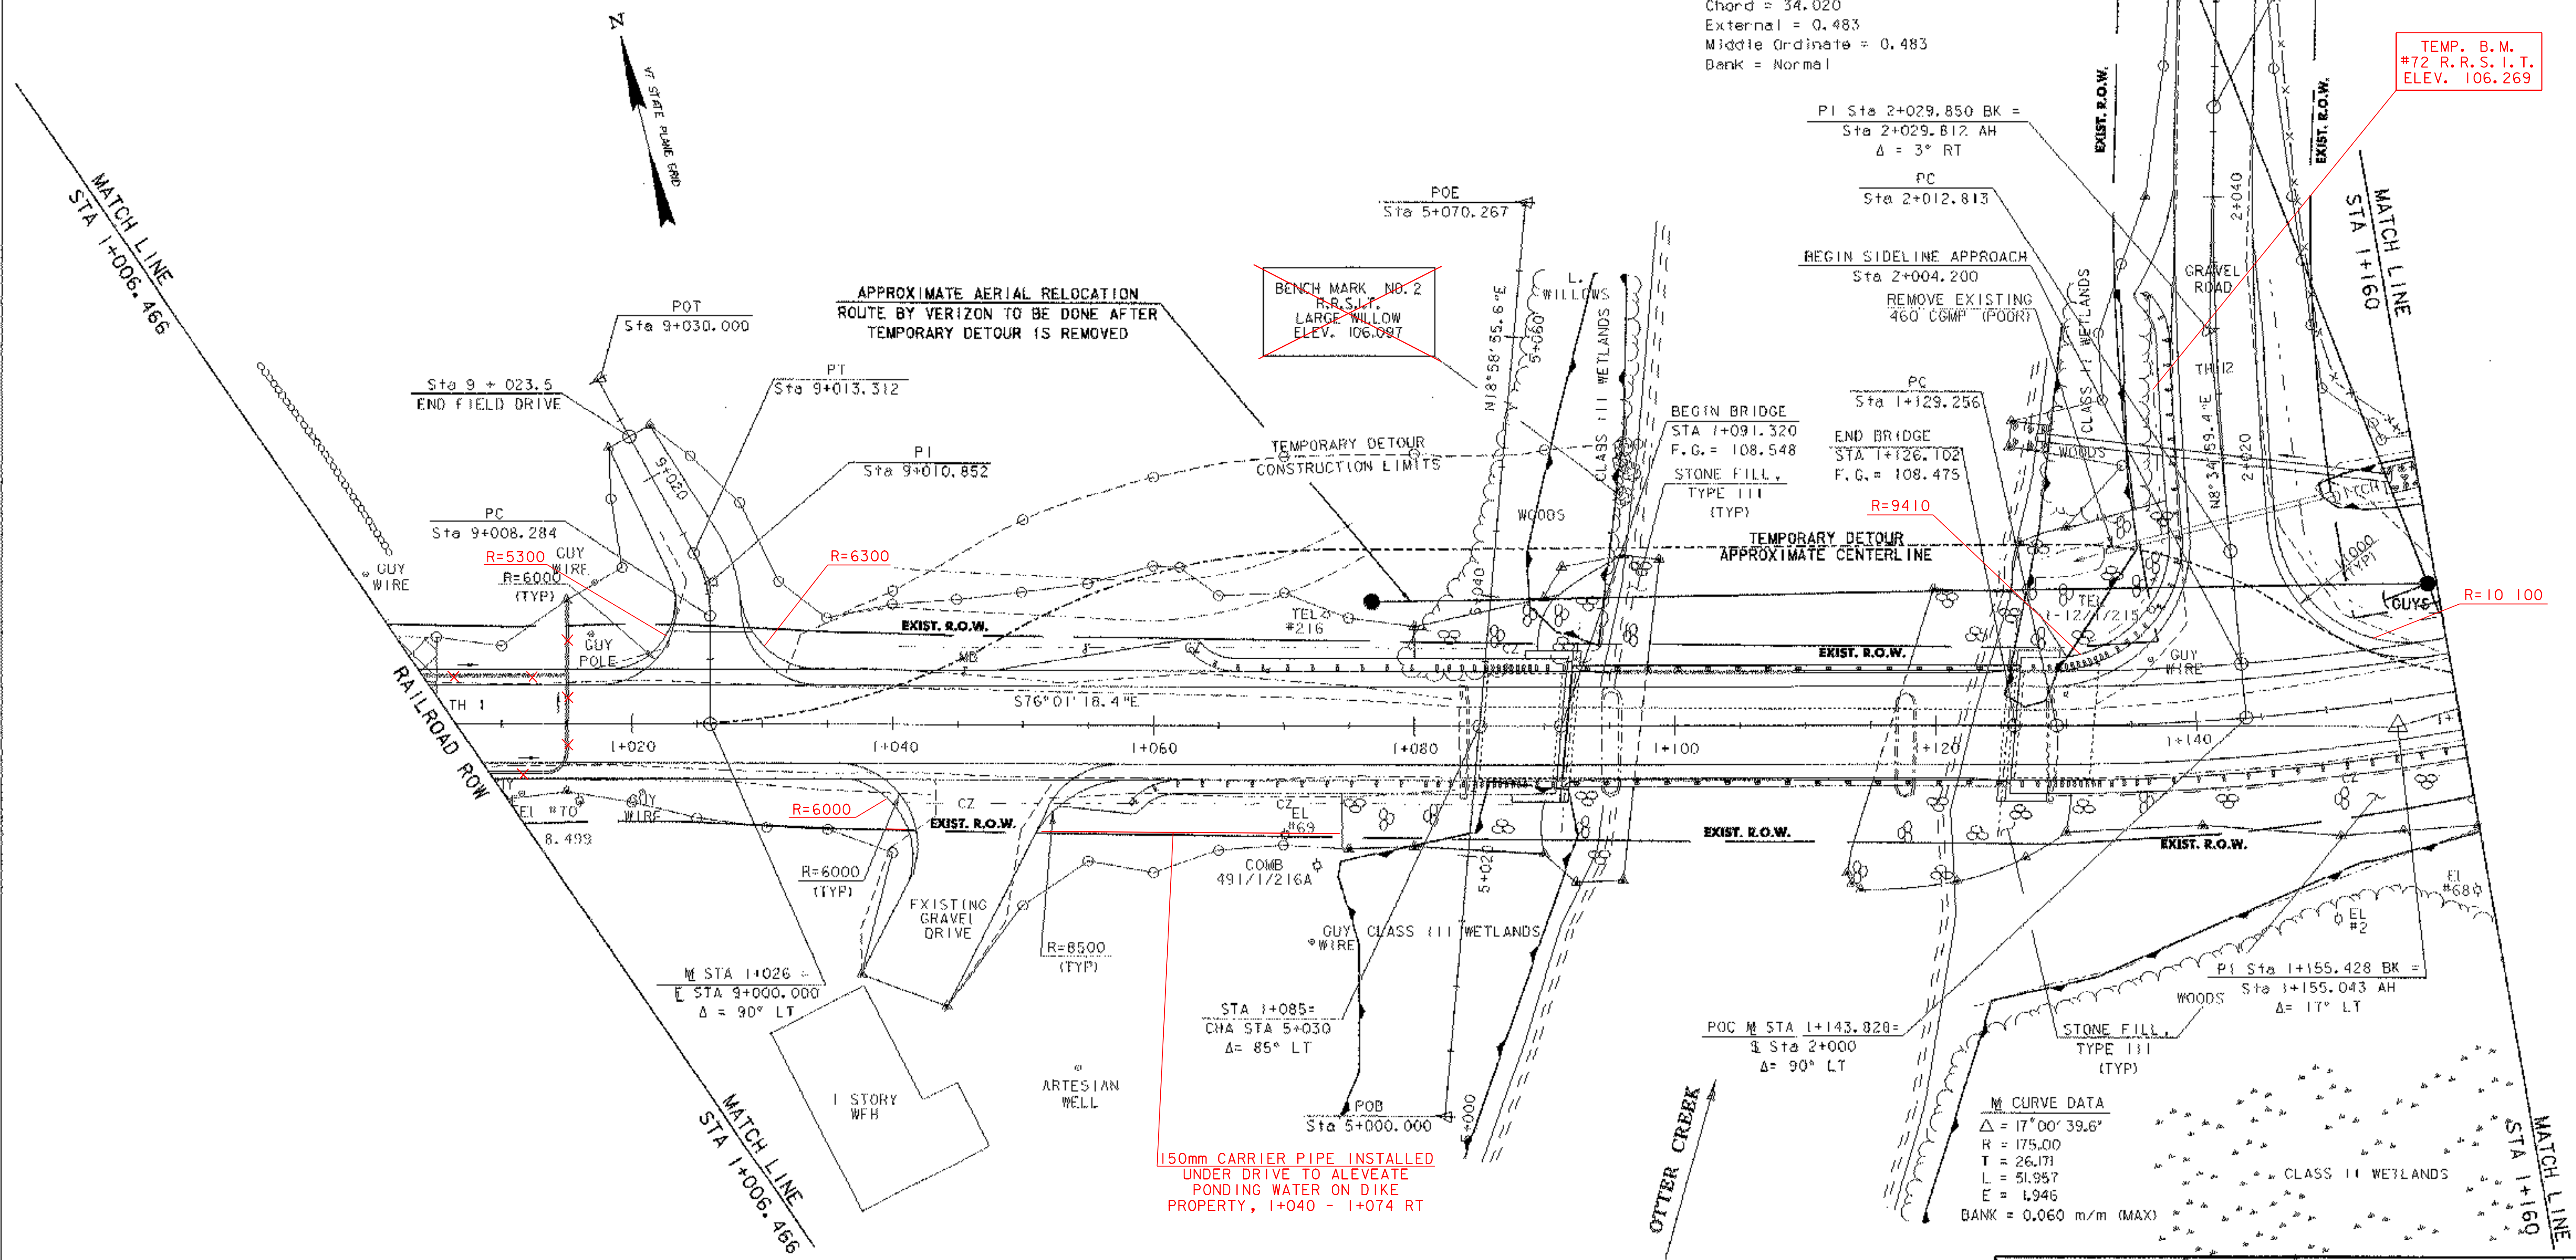

150mm CARRIER PIPE INSTALLED UNDER DRIVE TO ALEVATE PONDING WATER ON DIKE PROPERTY, 1+040 - 1+074 RT

SEE LINE STRIPING AND SIGN LAYOUT ON SHEET 37.


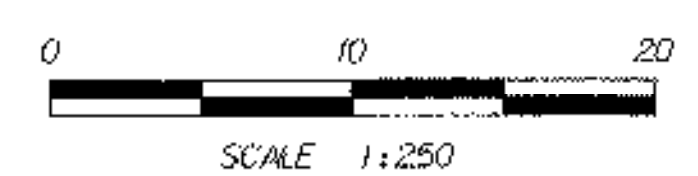


SHEET NAME: PLAN LAYOUT #2	
PROJECT NAME: LEICESTER	HIGHWAY NO.: FAS 0160
PROJECT NUMBER: BRF 0160(3)S	BRIDGE NO.: 6
	OVER: OTTER CREEK
FILE NAME: 95\288\Structures\288bdr.dgn	PLOT DATE: 17-AUG-2005
PROJECT MANAGER: R. R. WHITCOMB	DRAWN BY: J. GILMORE
DESIGNED BY: C. CARLSON	IPARM NAME: sj088ps2.1
BRIDGE SHEET NUMBER:	SHEET 12 OF 90




ANCHOR FOR STEEL BEAM RAIL
 ++243.900 RT
 ++245.168

GUARD RAIL HEAVY DUTY STEEL BEAM
 STA 1+160.000 - STA 1+245.420 RT
 1+247.298

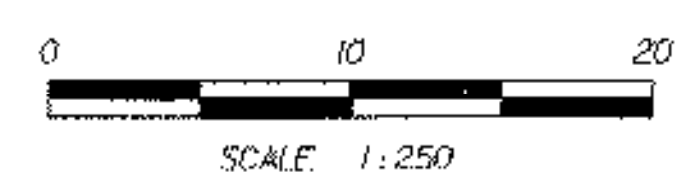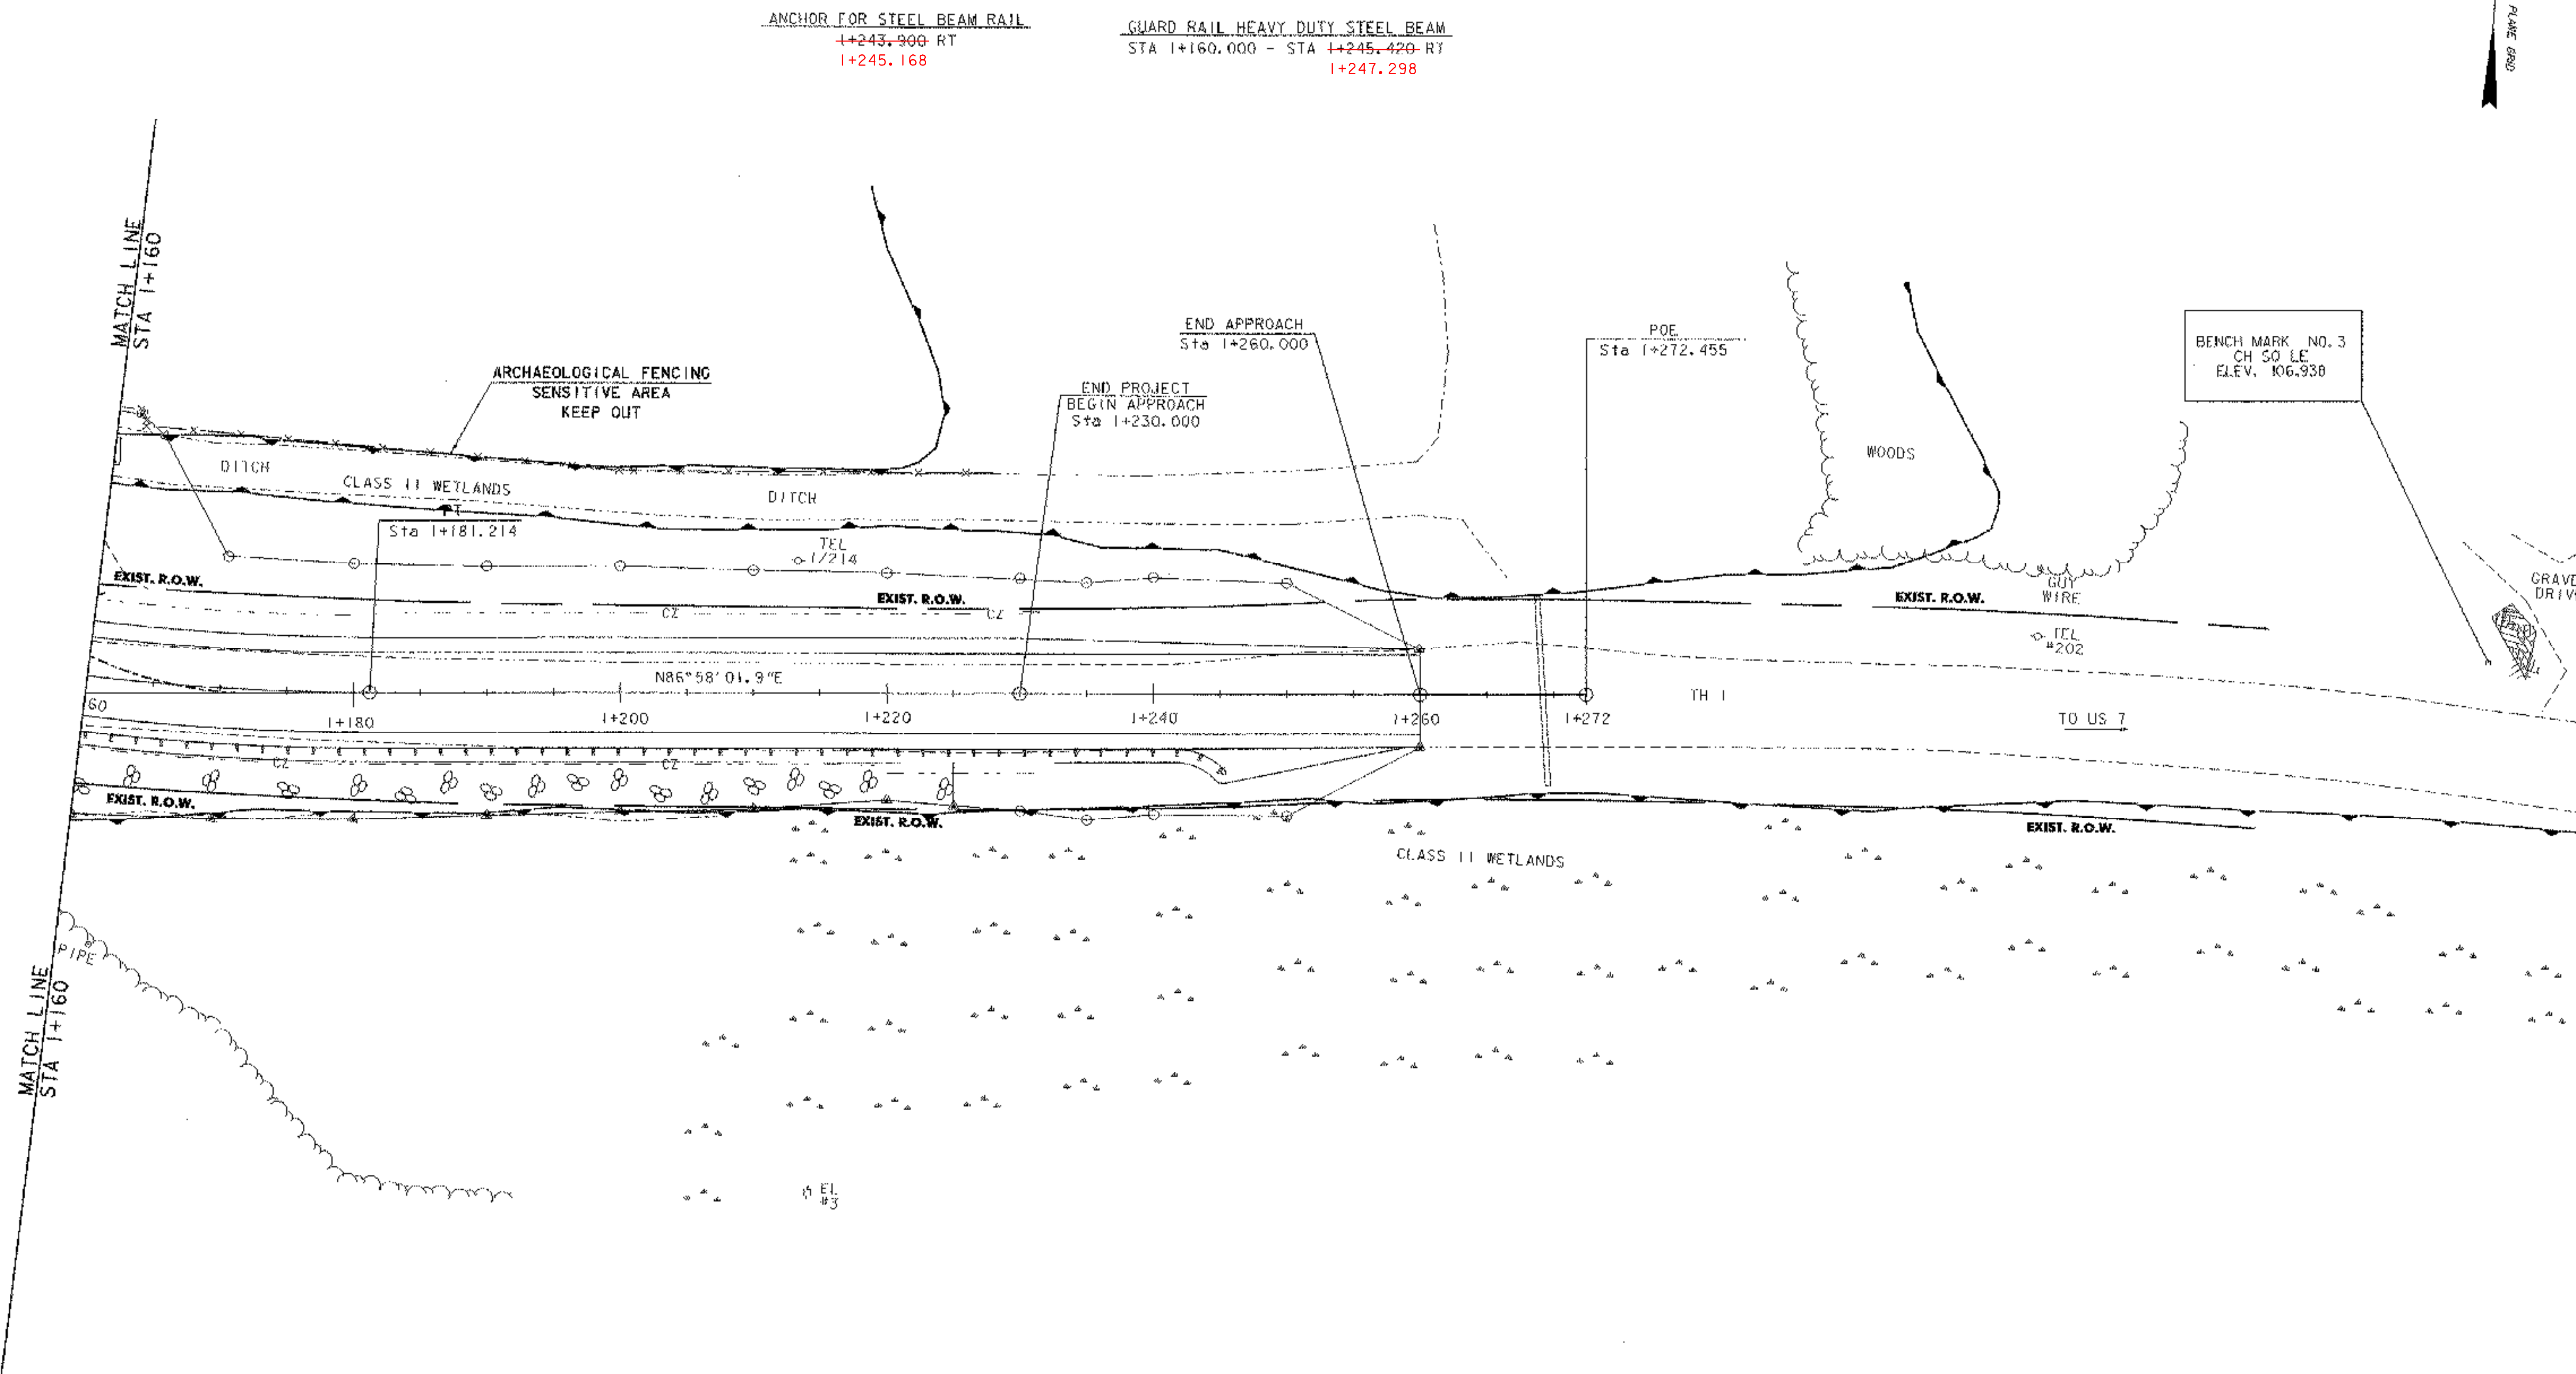


SHEET NAME: PLAN LAYOUT #3	
PROJECT NAME: LEICESTER	HIGHWAY NO.: FAS 0160
PROJECT NUMBER: BRF 0160(3)S	BRIDGE NO.: 6
	OVER: OTTER CREEK
FILE NAME: 95j288\Structures\sj288bdr.dgn	PLOT DATE: 17-AUG-2005
PROJECT MANAGER: R. R. WHITCOMB	DRAWN BY: J. GILMORE
DESIGNED BY: C. CARLSON	IPARM NAME: sj088ps3.1
BRIDGE SHEET NUMBER:	SHEET 13 OF 90

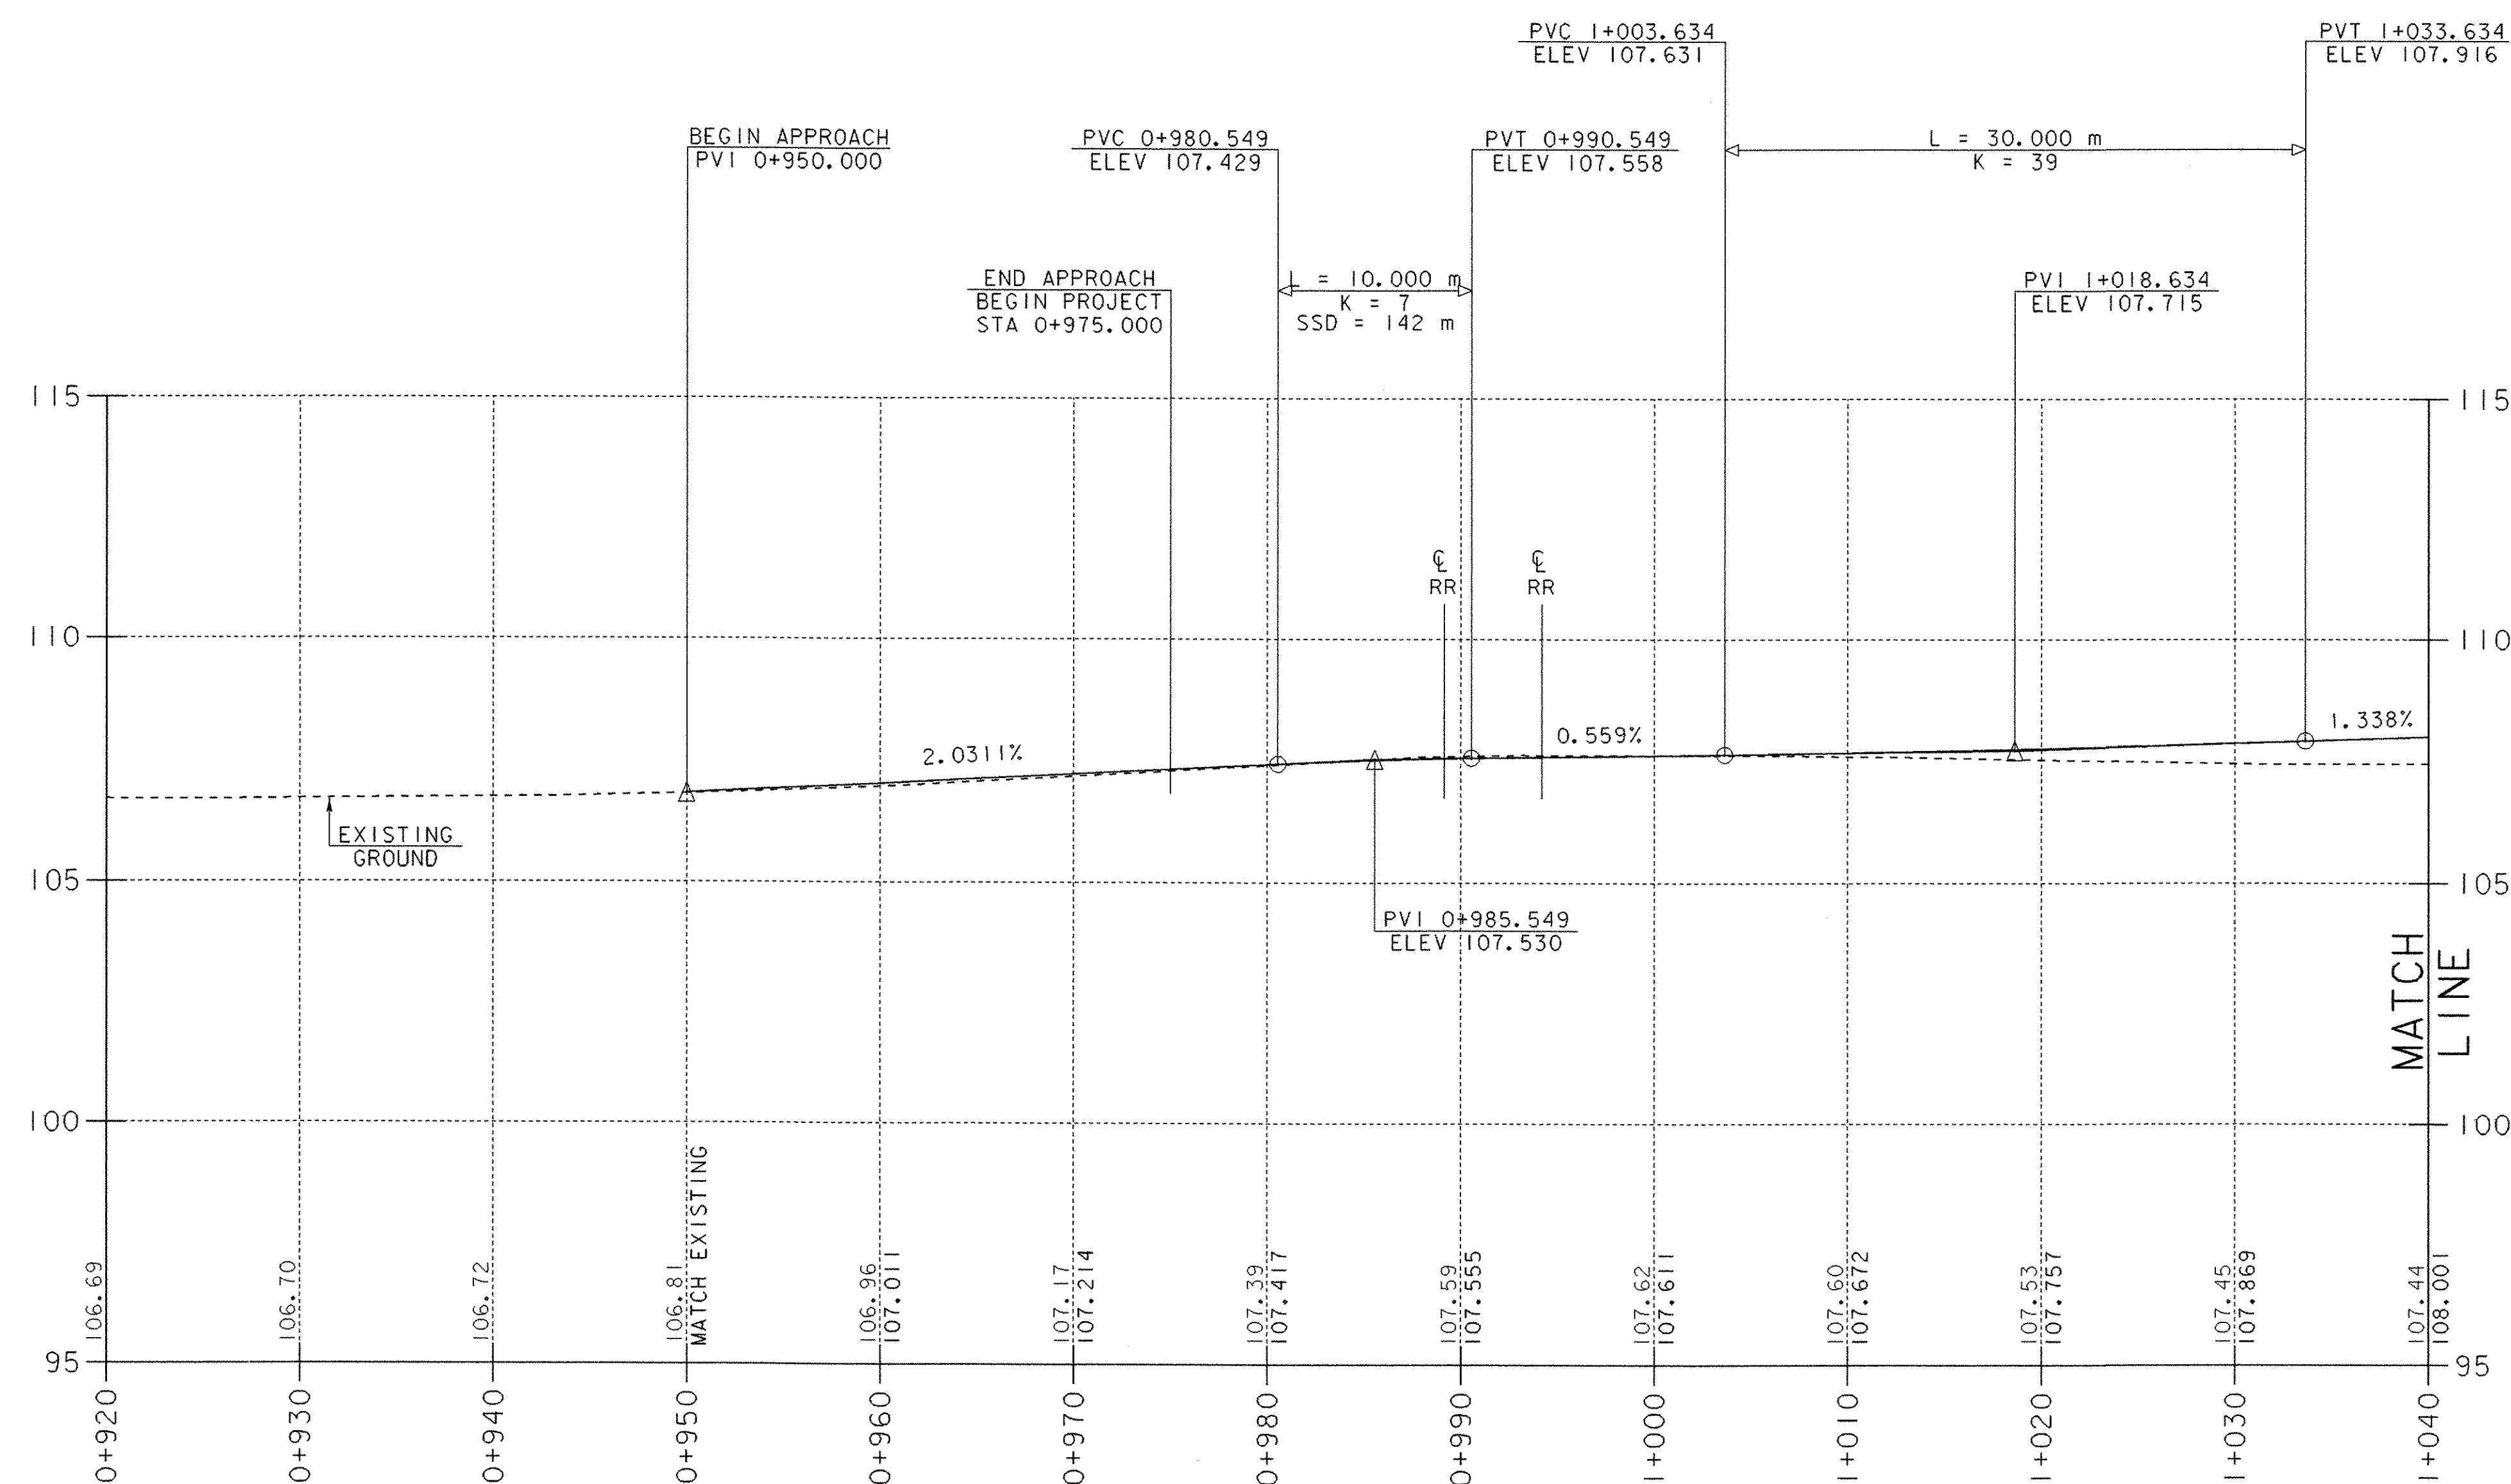


Profile TH 1

NOTES:

- GRADES SHOWN TO THE NEAREST HUNDREDTH ARE THE EXISTING GROUND ALONG THE CENTERLINE.
- GRADES SHOWN TO THE NEAREST THOUSANDTH ARE THE PROPOSED FINISHED GRADE ALONG THE CENTERLINE.
- RAILROAD RAILS AT CROSSING MAY BE RAISED 150mm[±] WHEN CROSSING WORK IS DONE. GRADES WILL BE ADJUSTED ACCORDINGLY.

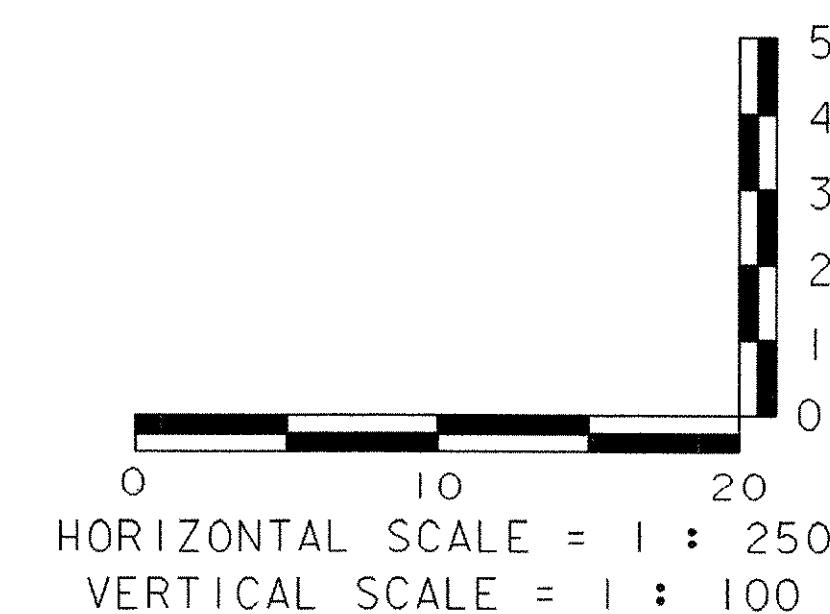


SHEET NAME: MAINLINE PROFILE SHEET 1	
PROJECT NAME: LEICESTER	HIGHWAY NO.: FAS 0160
PROJECT NUMBER: BRF 0160(3)S	BRIDGE NO.: 6
	OVER: OTTER CREEK
FILE NAME: 95J288\Structures\sj288xsl.dgn	PLOT DATE: 17-AUG-2005
PROJECT MANAGER: R. R. WHITCOMB	DRAWN BY: J. GILMORE
DESIGNED BY: C. CARLSON	IPARM NAME: sj088pr1.i
	SHEET 14 OF 90

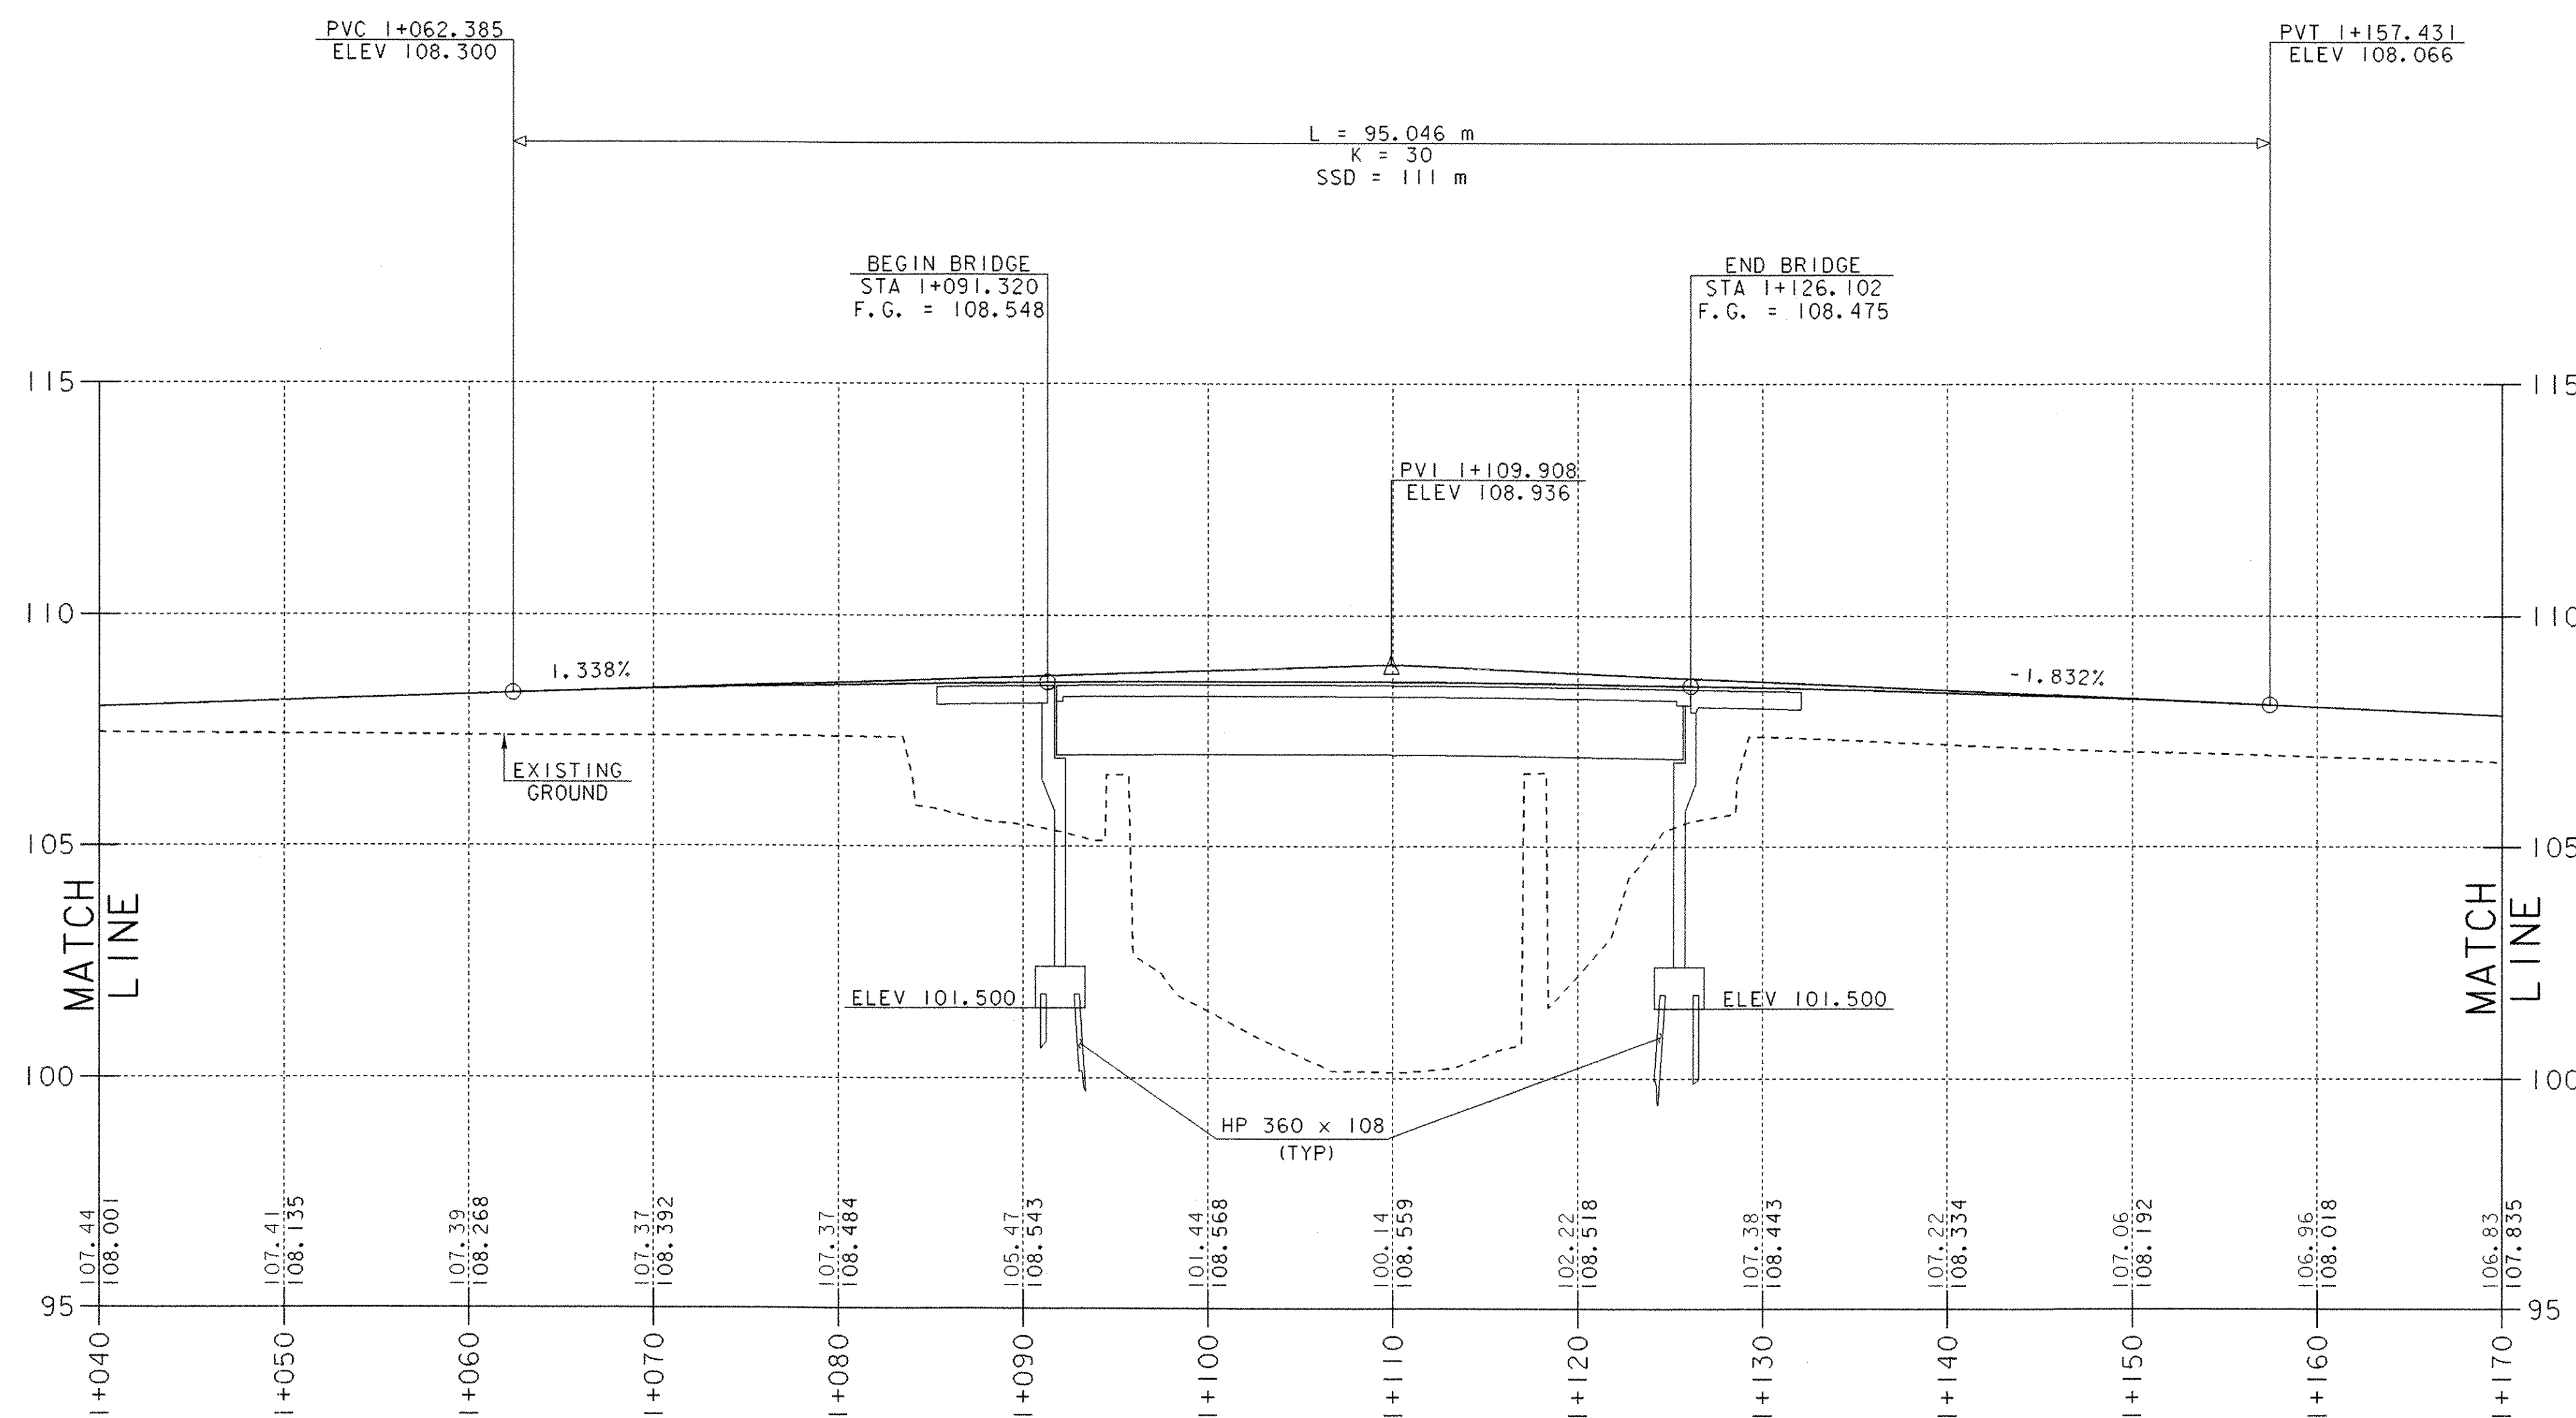


Profile TH 1

NOTE:

GRADES SHOWN TO THE NEAREST HUNDREDTH ARE THE EXISTING GROUND ALONG THE CENTERLINE. GRADES SHOWN TO THE NEAREST THOUSANDTH ARE THE PROPOSED FINISHED GRADE ALONG THE CENTERLINE.

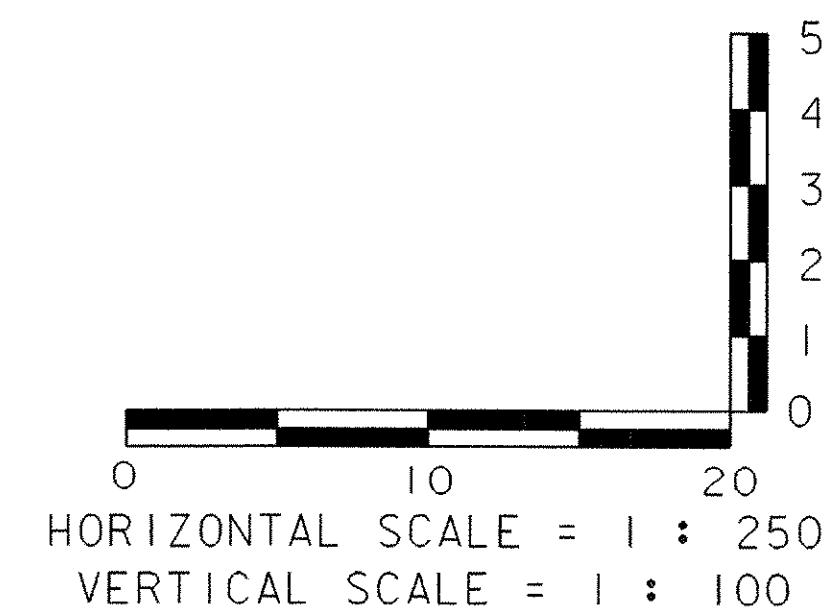


SHEET NAME: MAINLINE PROFILE SHEET 2	
PROJECT NAME: LEICESTER	HIGHWAY NO.: FAS 0160
PROJECT NUMBER: BRF 0160(3)S	BRIDGE NO.: 6
	OVER: OTTER CREEK
FILE NAME: 95j288\Structures\sj288xsl.dgn	PLOT DATE: 17-AUG-2005
PROJECT MANAGER: R. R. WHITCOMB	DRAWN BY: J. GILMORE
DESIGNED BY: C. CARLSON	IPARM NAME: sj088pr2.1
	SHEET 15 OF 90

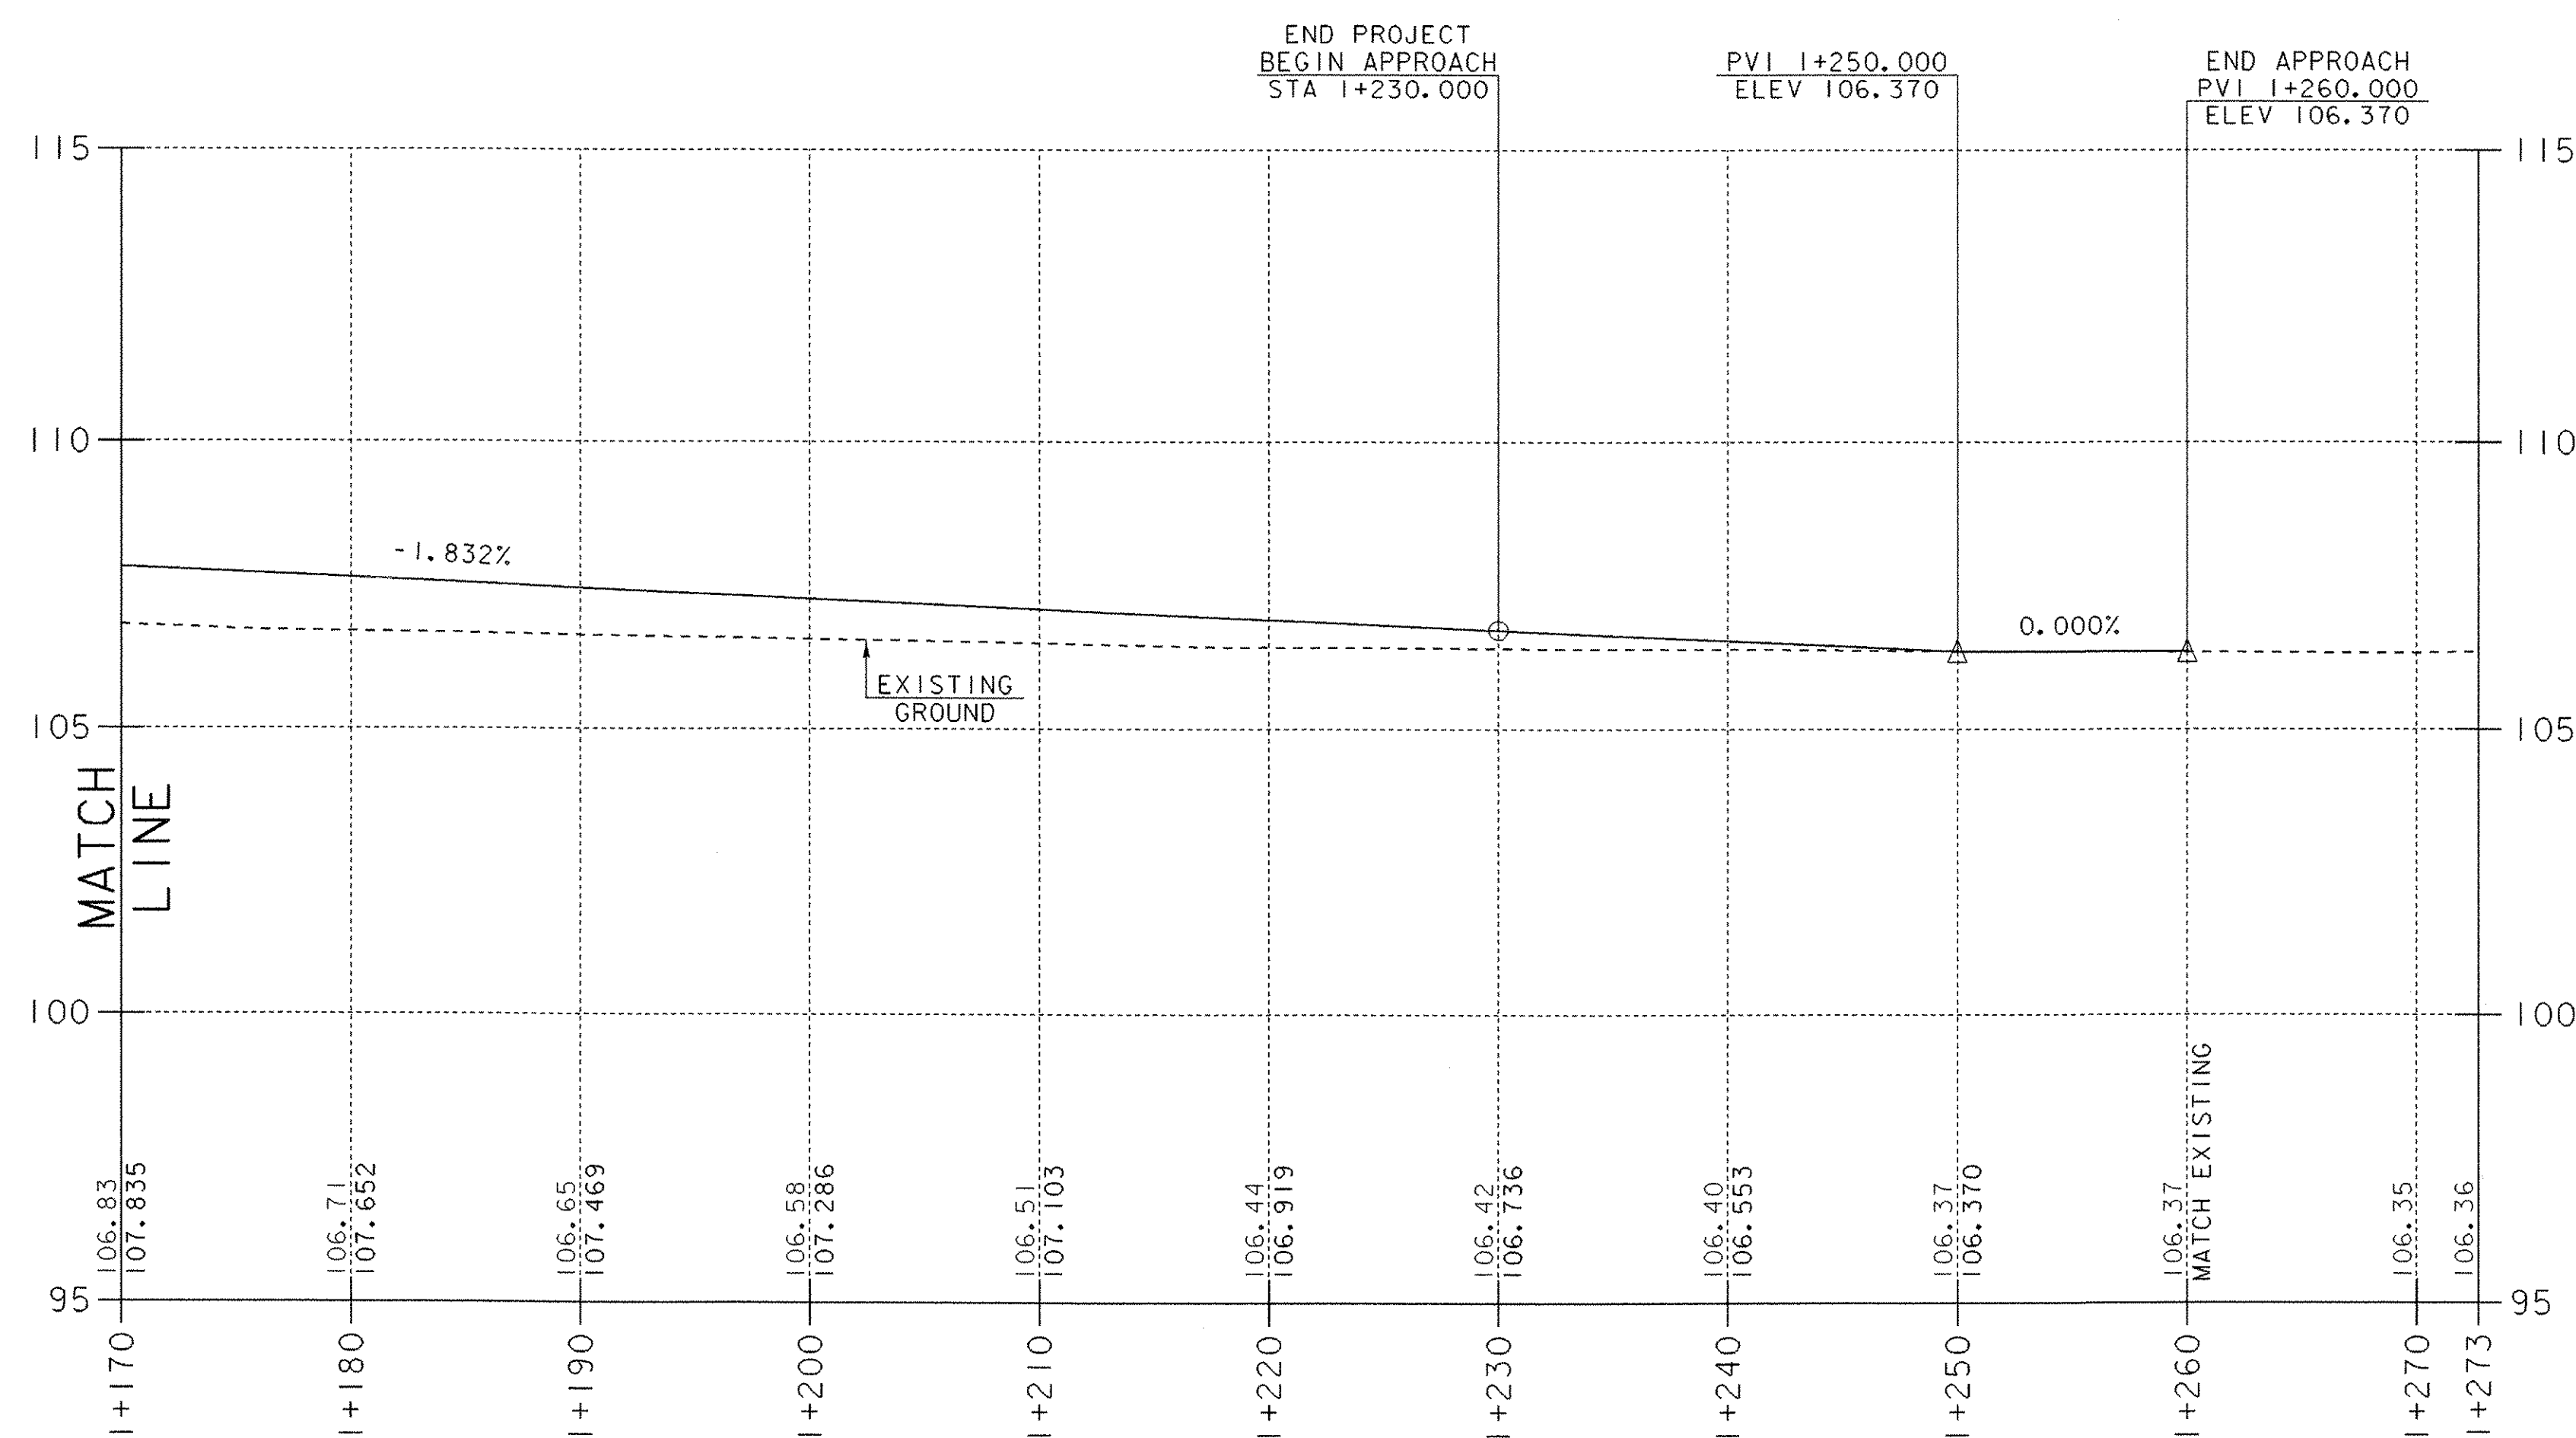


Profile TH 1

NOTE:



GRADES SHOWN TO THE NEAREST HUNDREDTH ARE THE EXISTING GROUND ALONG THE CENTERLINE. GRADES SHOWN TO THE NEAREST THOUSANDTH ARE THE PROPOSED FINISHED GRADE ALONG THE CENTERLINE.

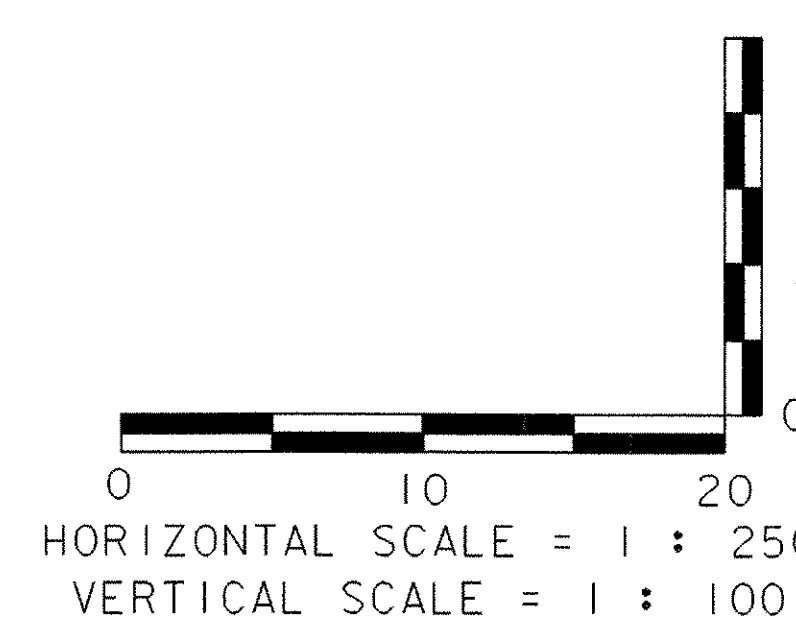

SHEET NAME: MAINLINE PROFILE SHEET 3	
PROJECT NAME: LEICESTER	HIGHWAY NO.: FAS 0160
PROJECT NUMBER: BRF 0160(3)S	BRIDGE NO.: 6
	OVER: OTTER CREEK
FILE NAME: 95j288\Structures\sj288xsl.dgn	PLOT DATE: 17-AUG-2005
PROJECT MANAGER: R. R. WHITCOMB	DRAWN BY: J. GILMORE
DESIGNED BY: C. CARLSON	IPARM NAME: sj088pr5.1
	SHEET 16 OF 90

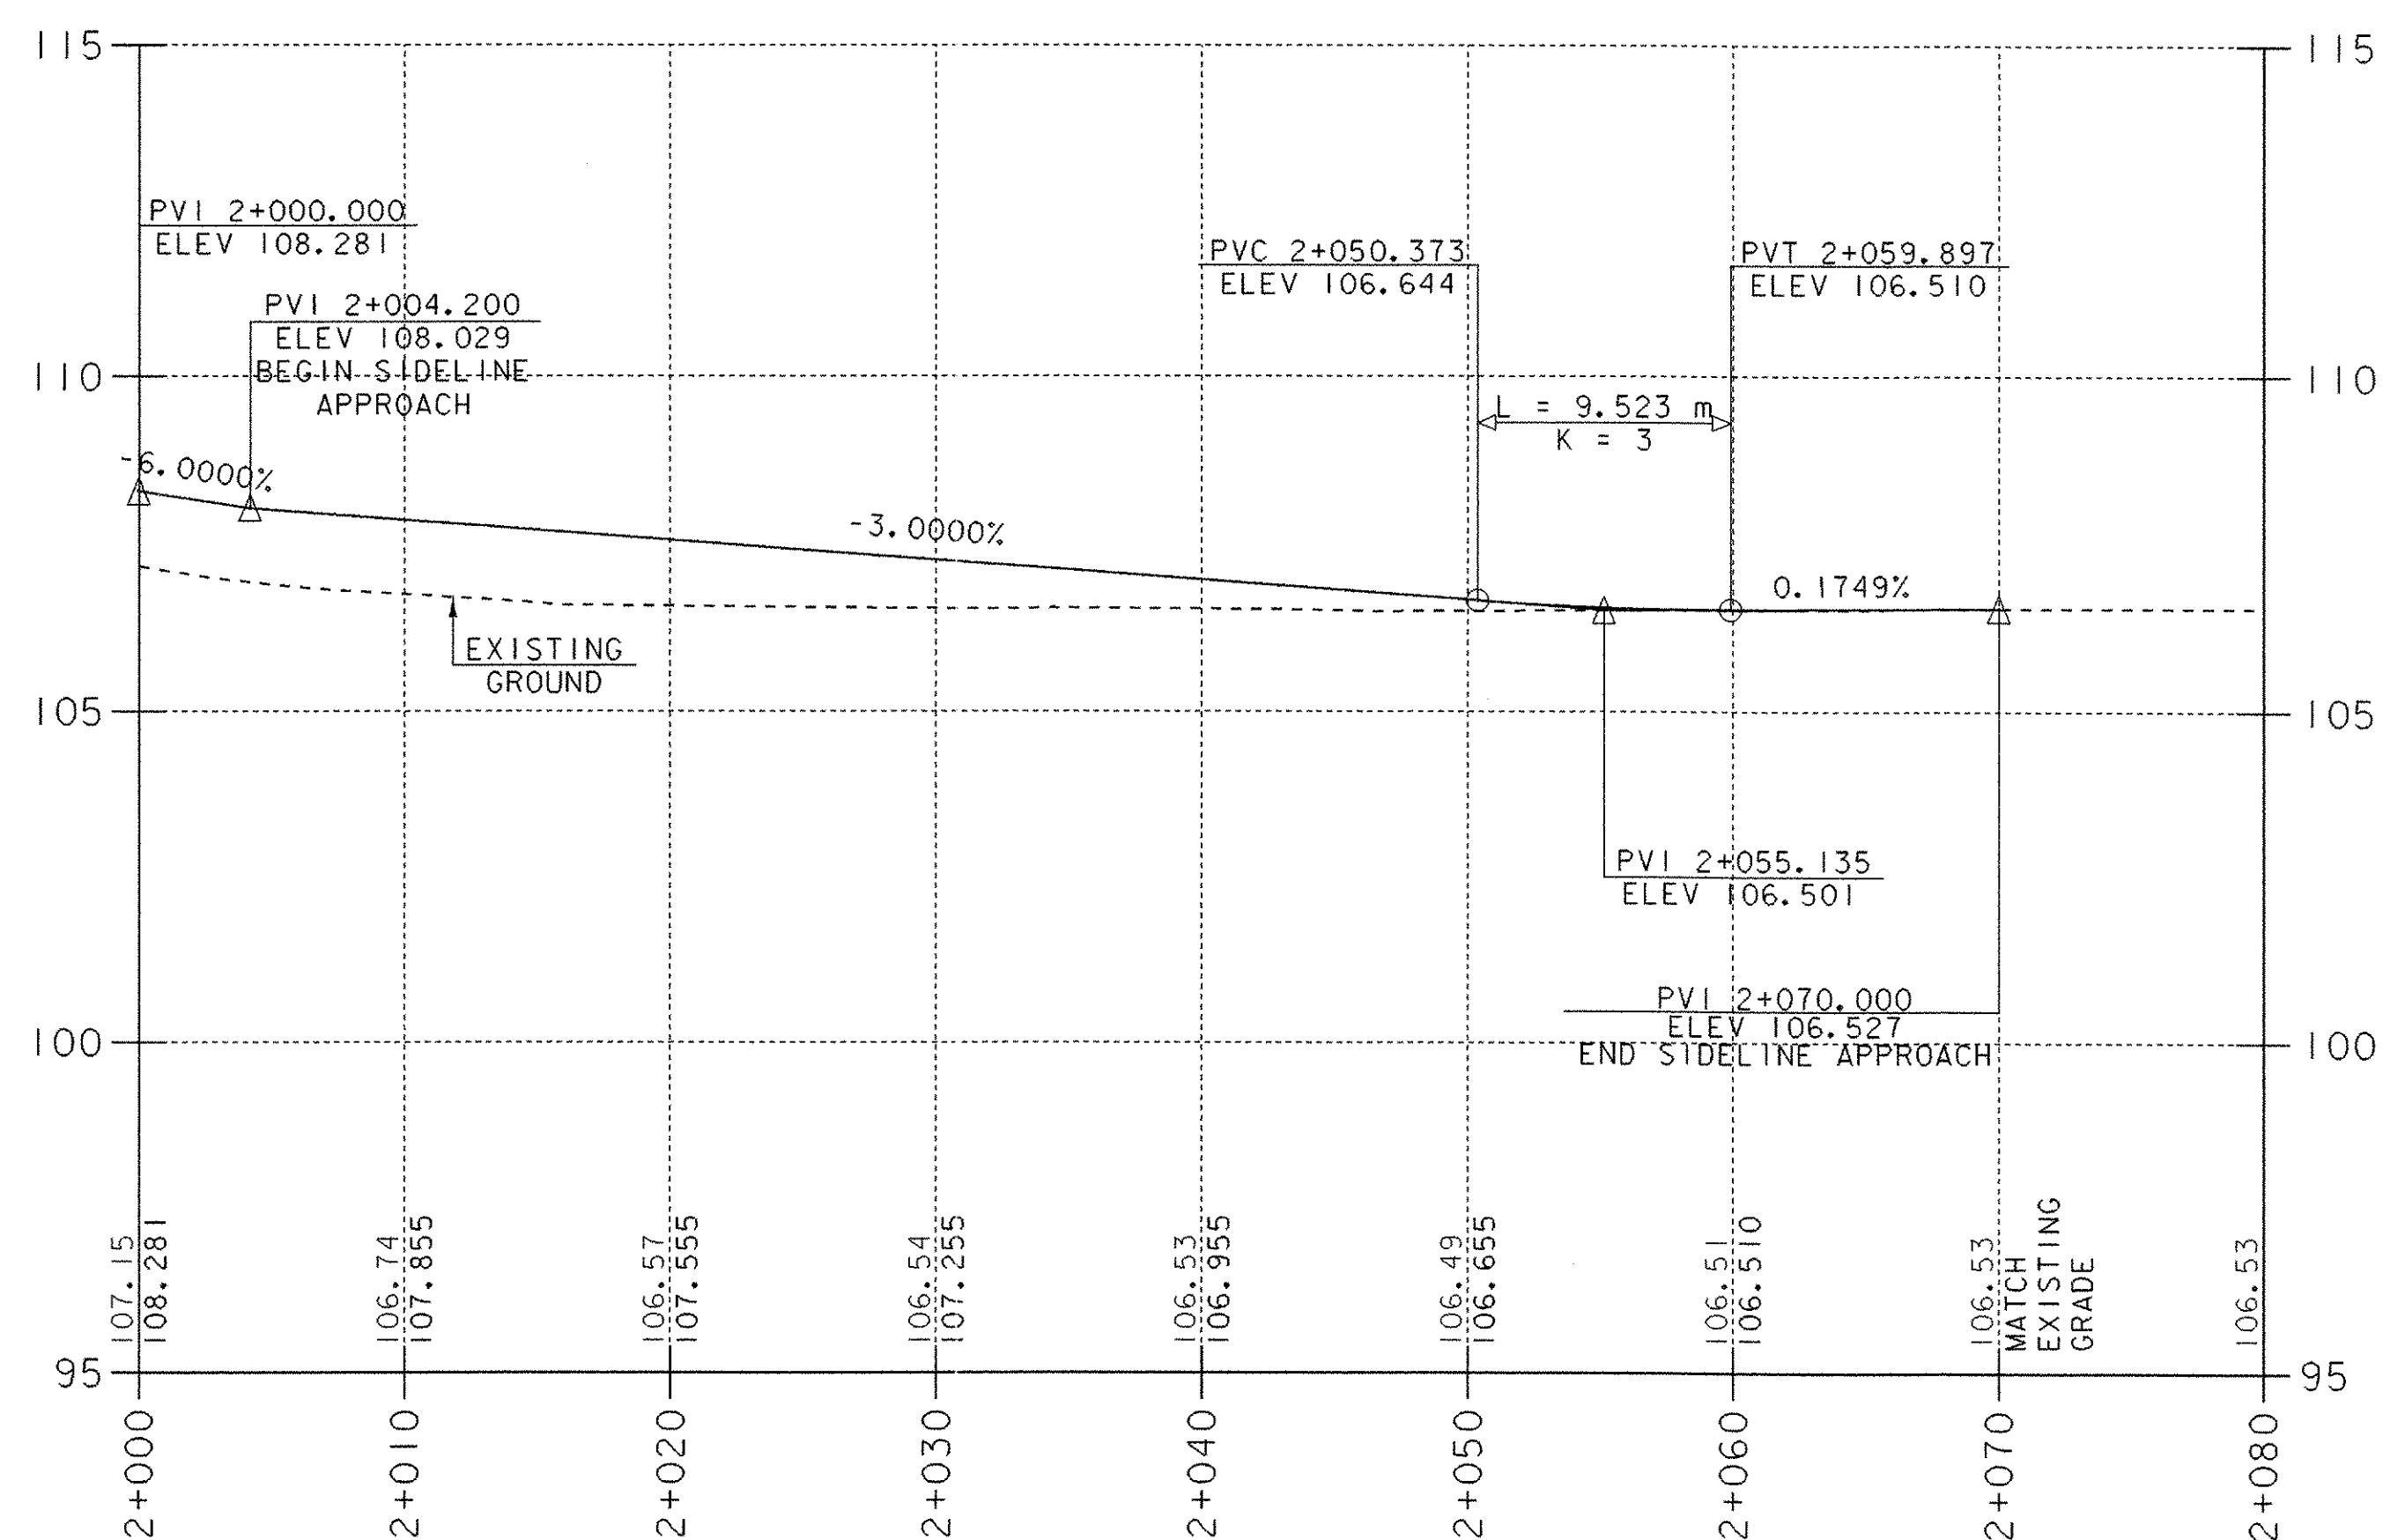


**Profile
TH 12**

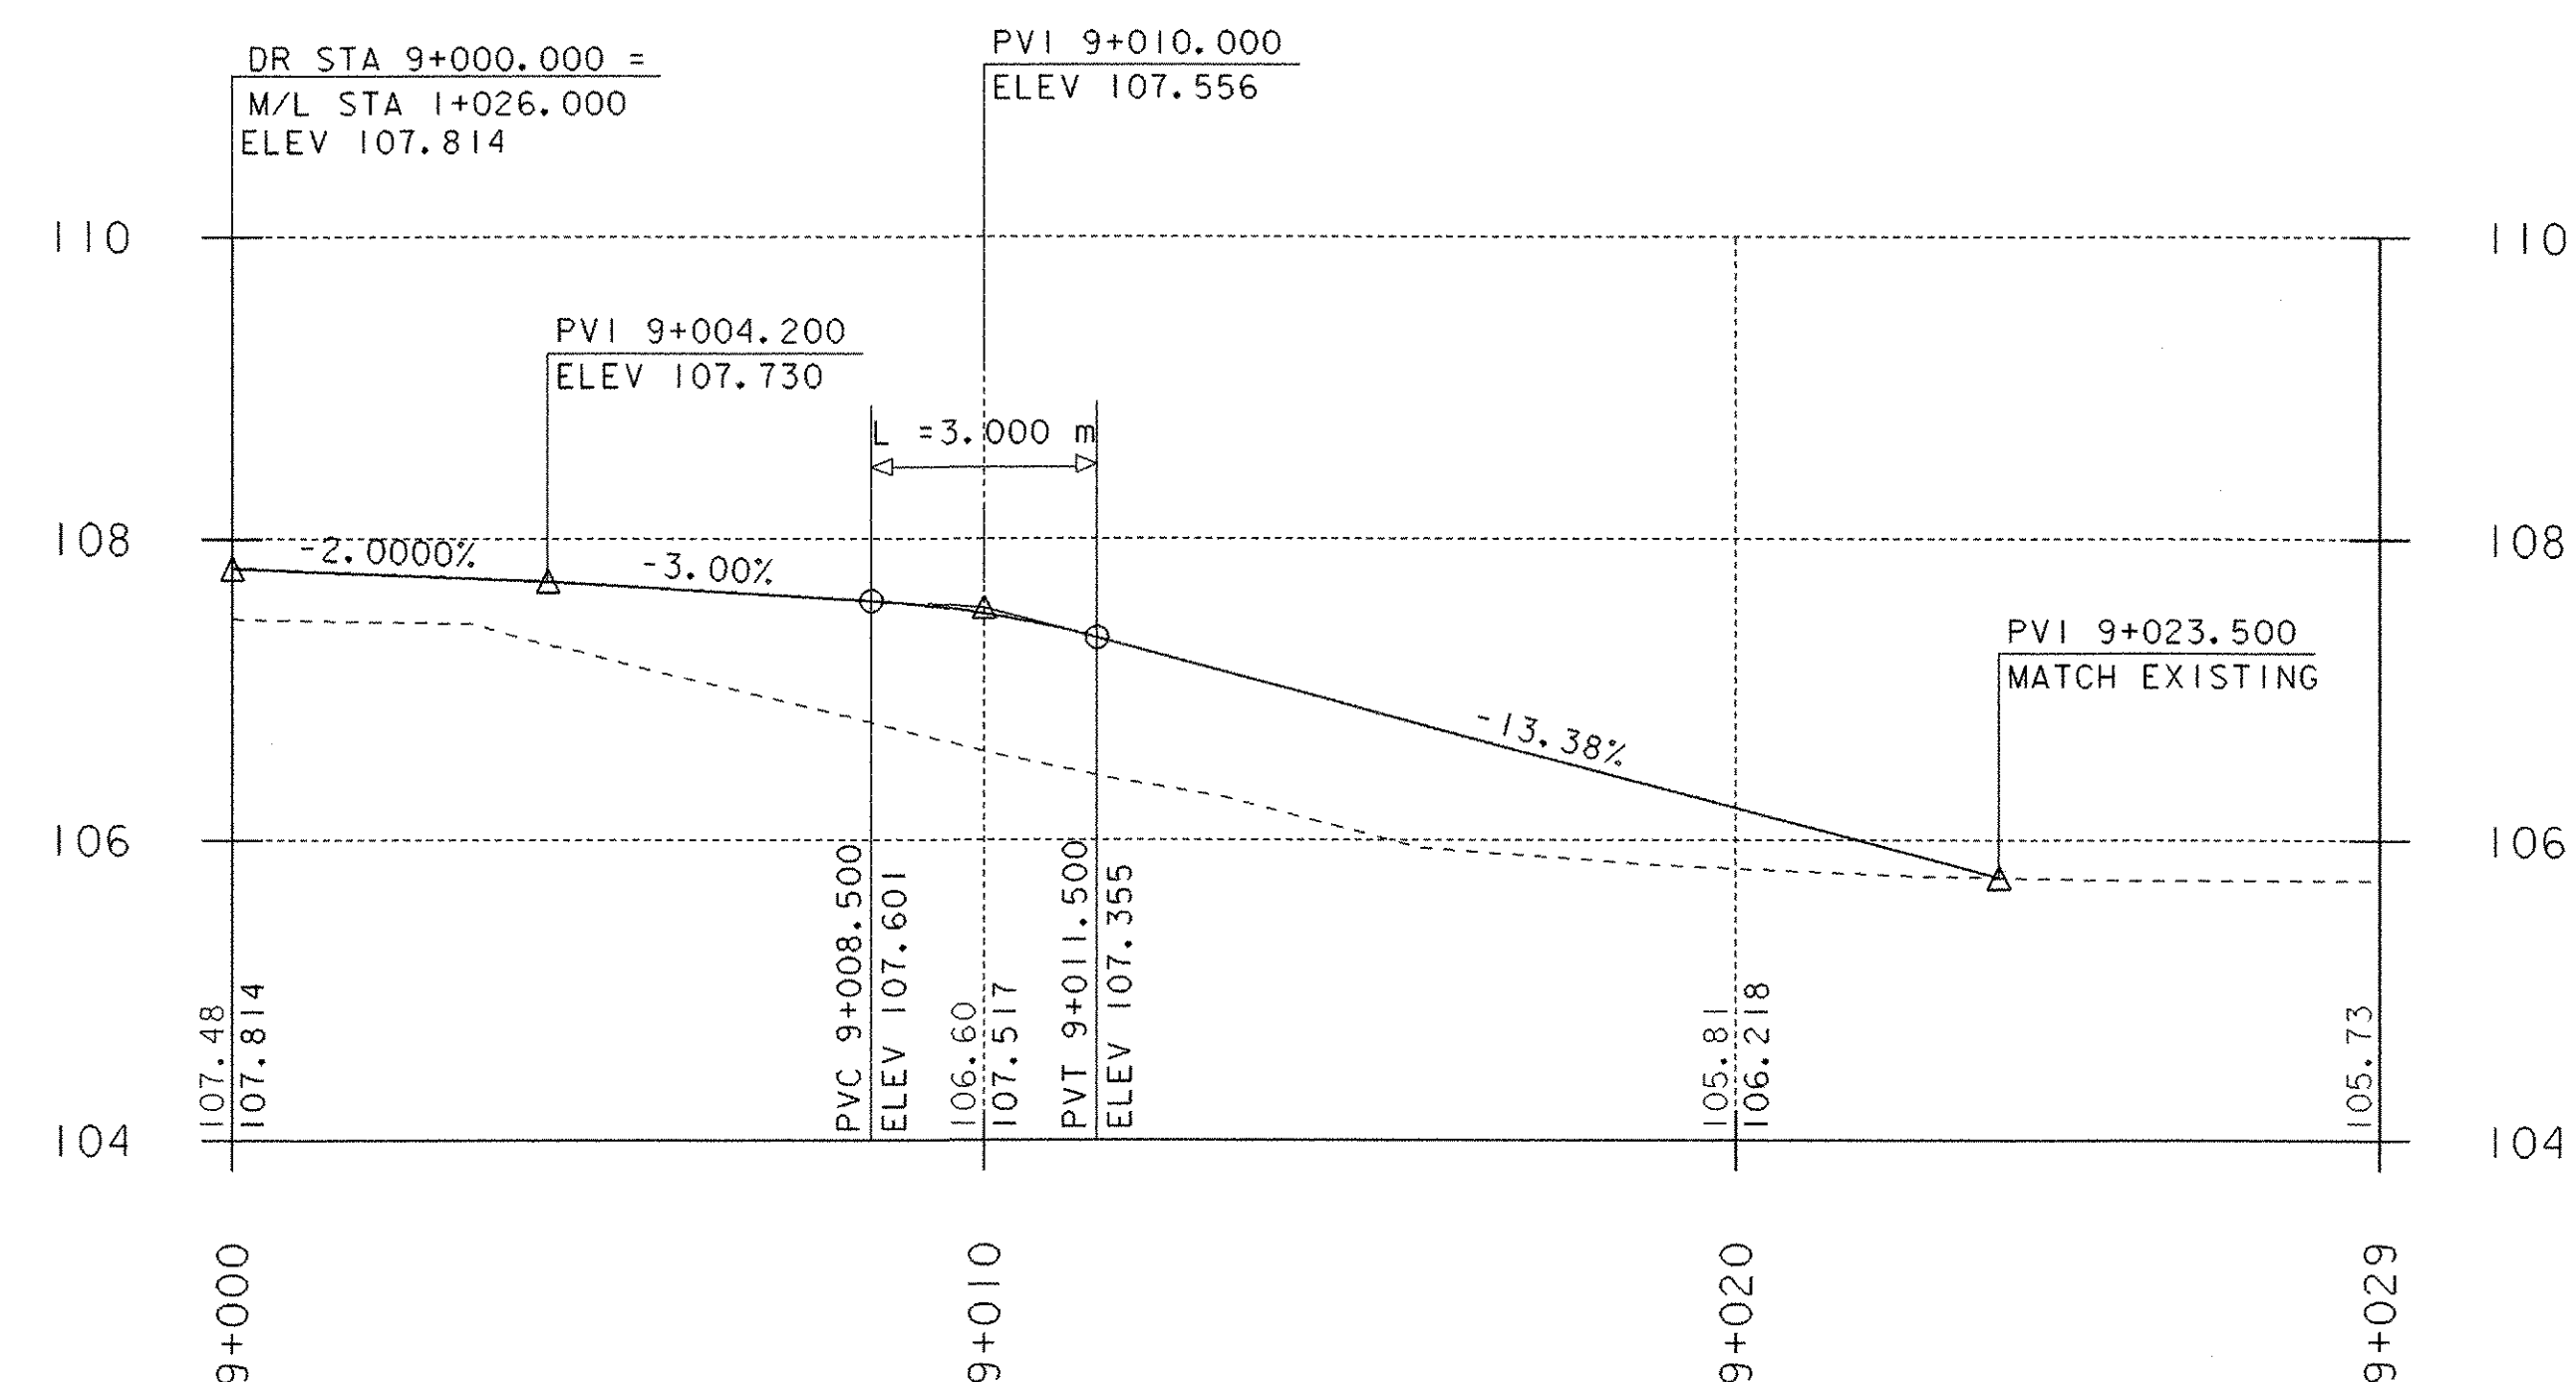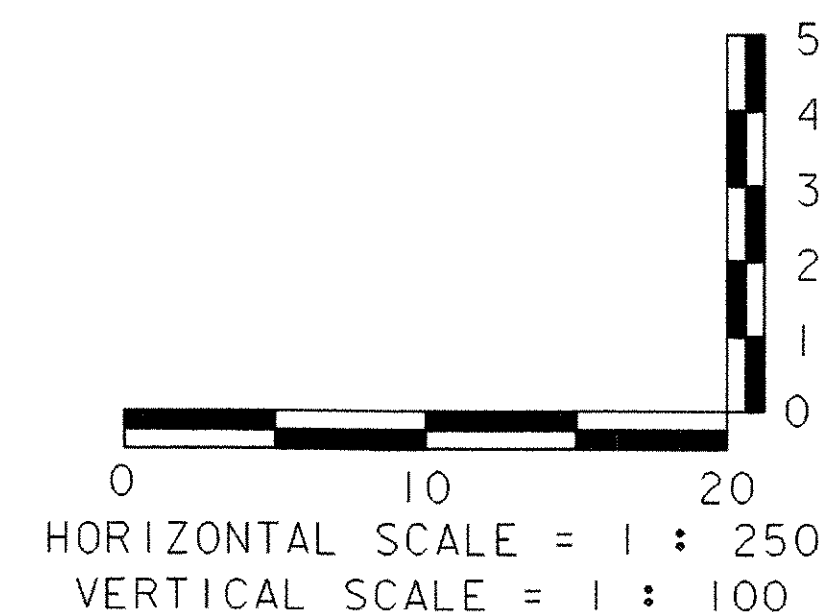

Field Drive Profile

M STA 1+026 LT = FIELD DRIVE STA 9+000

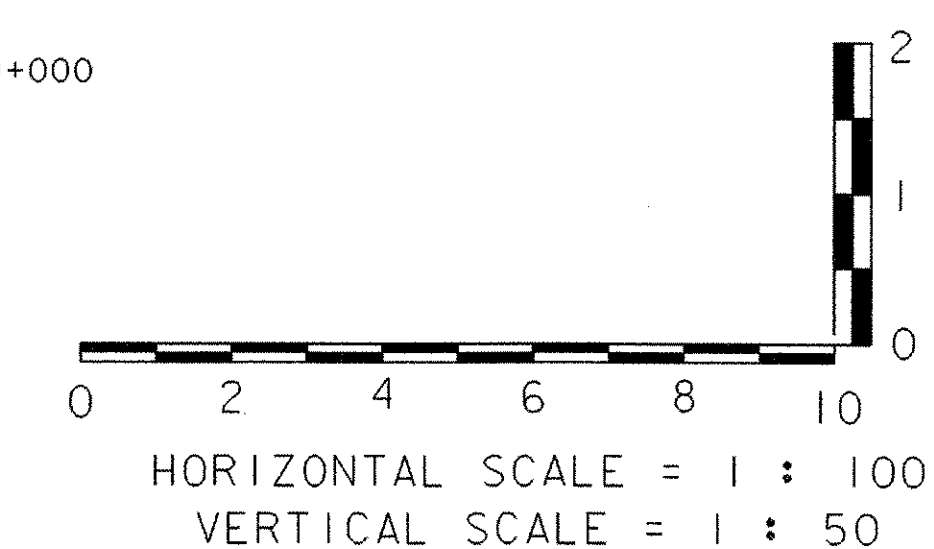

NOTE:

GRADES SHOWN TO THE NEAREST HUNDRETH ARE THE EXISTING GROUND ALONG THE CENTERLINE. GRADES SHOWN TO THE NEAREST THOUSANDTH ARE THE PROPOSED FINISHED GRADE ALONG THE CENTERLINE.

SHEET NAME: SIDELINE PROFILE SHEET	
PROJECT NAME: LEICESTER	HIGHWAY NO.: FAS 0160
PROJECT NUMBER: BRF 0160(3)S	BRIDGE NO.: 6
	OVER: OTTER CREEK
FILE NAME: 95j288\Structures\sj288xsl.dgn	PLOT DATE: 17-AUG-2005
PROJECT MANAGER: R. R. WHITCOMB	DRAWN BY: J. GILMORE
DESIGNED BY: C. CARLSON	IPARM NAME: sj088pr3.1
	SHEET 17 OF 90

POE
Sta 2+079.949

END SIDELINE APPROACH
Sta 2+070

ARCHAEOLOGICAL FENCING
SENSITIVE AREA
KEEP OUT

PT
Sta 2+046.851

MATCH LINE
STA 1+160

PI Sta 2+029.850 BK =
Sta 2+029.812 AH
 $\Delta = 3^\circ$ RT

PC
Sta 2+012.813

BEGIN SIDELINE APPROACH
Sta 2+004.200
REMOVE EXISTING
460 CGMP (POOR)

PC
Sta 1+129.256



END BRIDGE
Sta 1+126.102
F.G. = 108.475

BEGIN BRIDGE
Sta 1+091.320
F.G. = 108.548
STONE FILL,
TYPE III
(TYP)


TEMPORARY DETOUR
APPROXIMATE CENTERLINE



BENCH MARK NO. 2
R.R.S.T.
LARGE WILLOW
ELEV. 106.097

POE
Sta 5+070.267

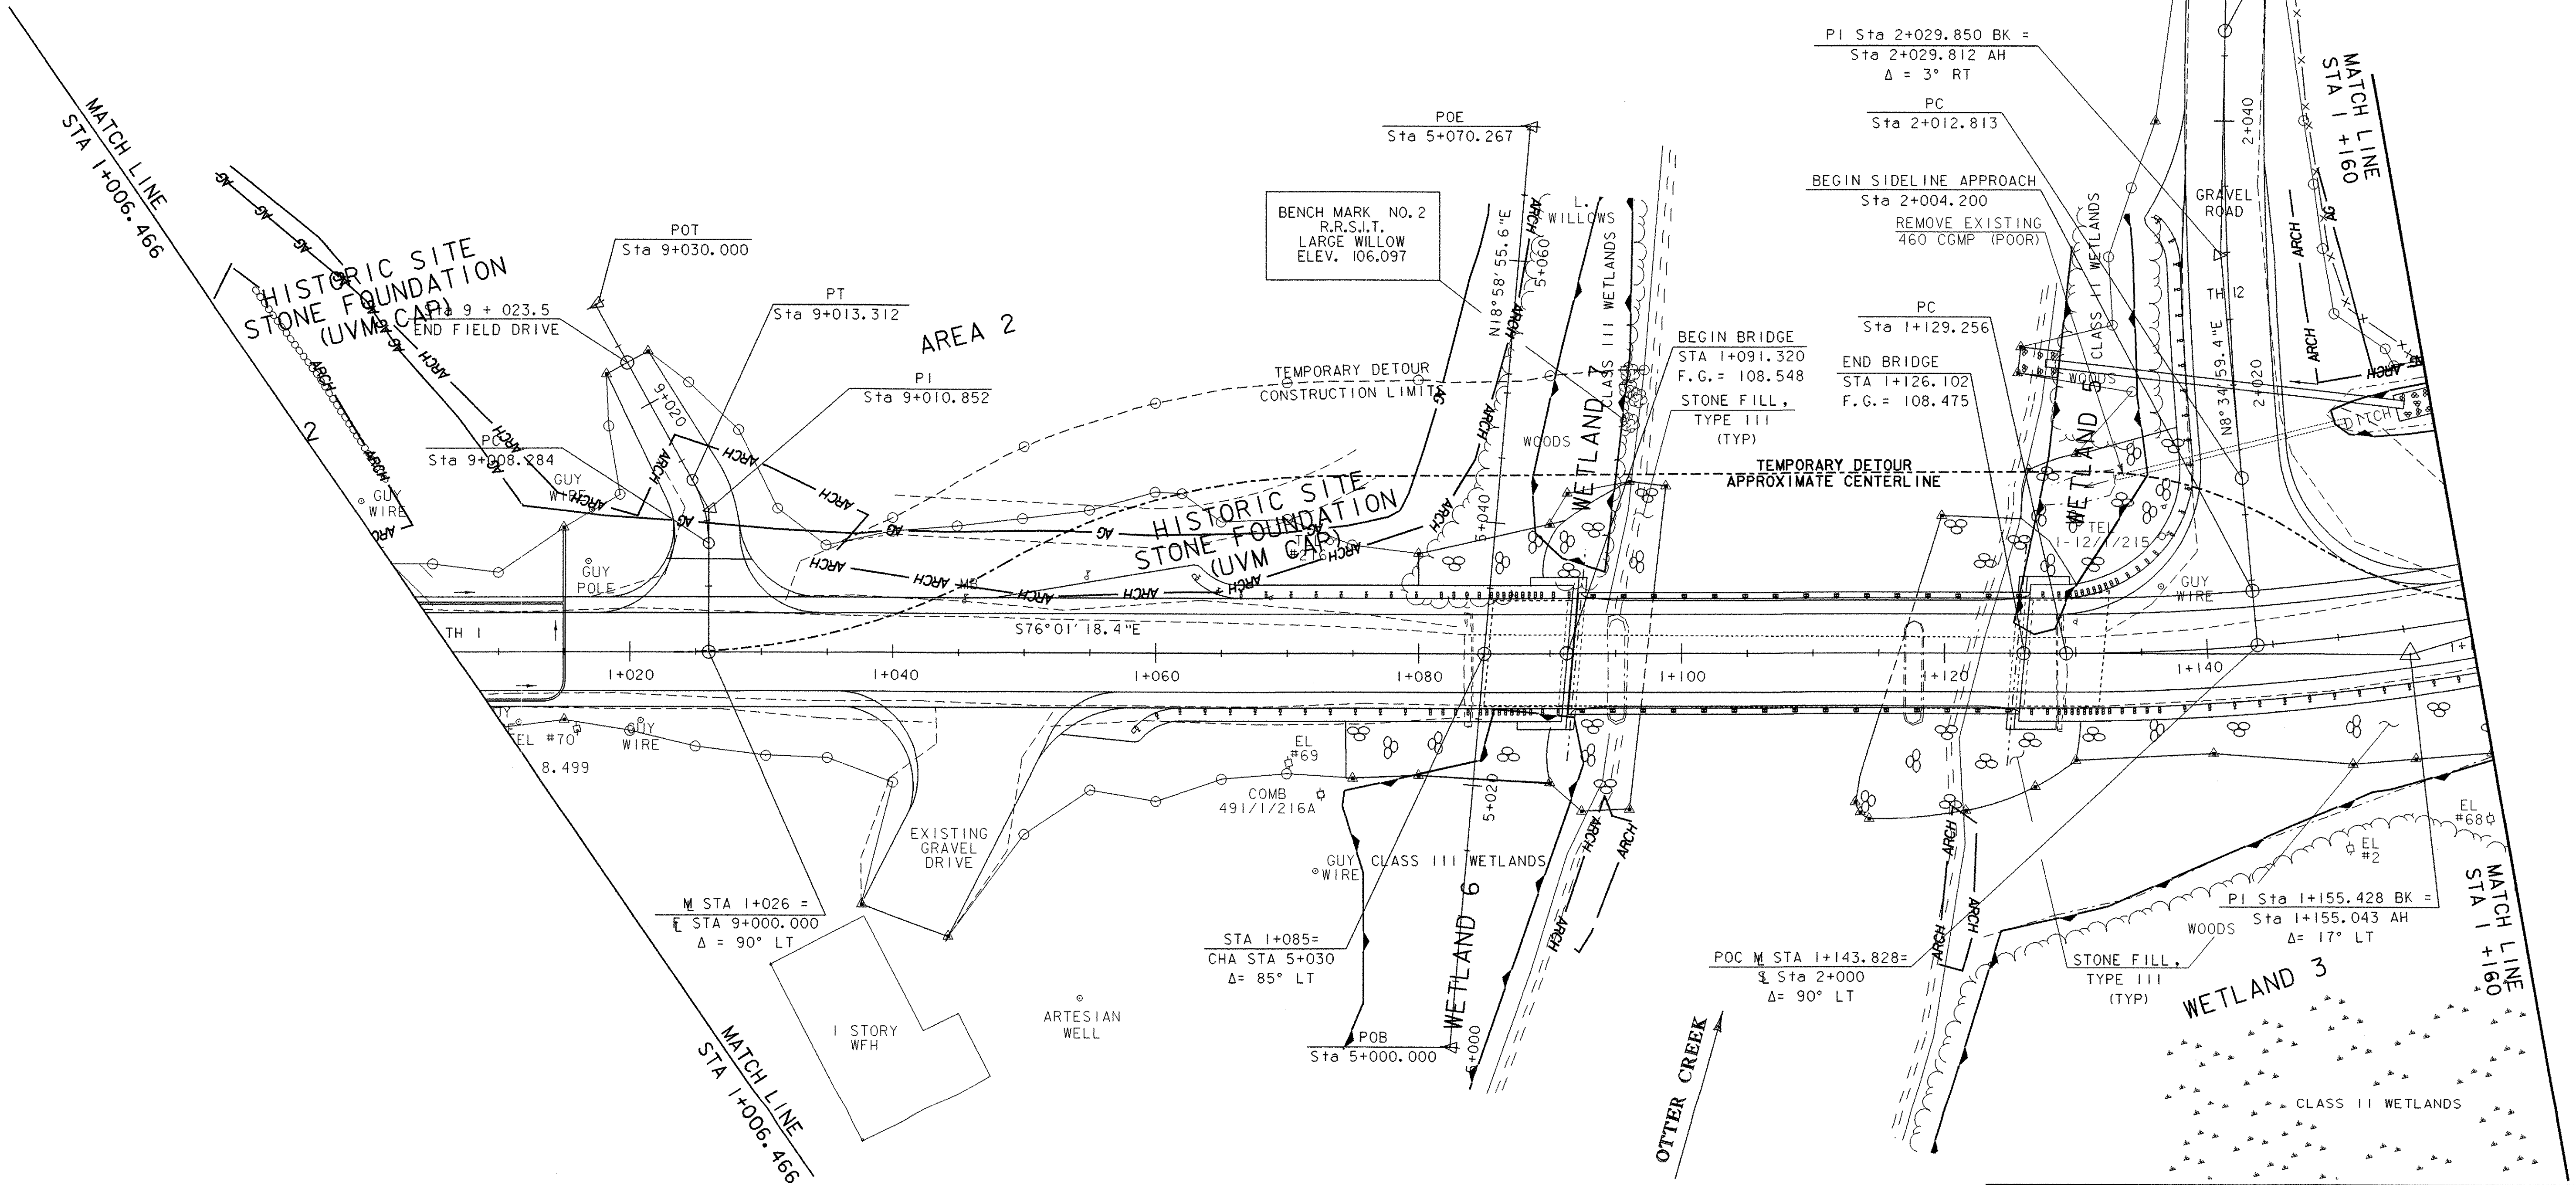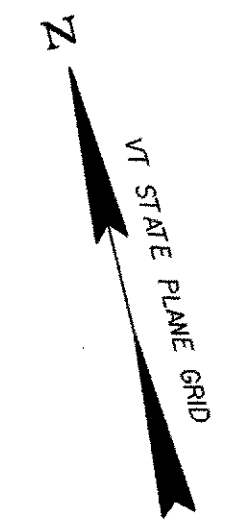

SHEET NAME: RESOURCE LAYOUT #2	
PROJECT NAME: LEICESTER	HIGHWAY NO.: FAS 0160
PROJECT NUMBER: BRF 0160(3S)	BRIDGE NO.: 6
	OVER: OTTER CREEK
FILE NAME: 95J288\structures\sj288bdr.dgn PLOT DATE: 17-AUG-2005	PROJECT MANAGER: R. R. WHITCOMB
DESIGNED BY: C. CARLSON	DRAWN BY: J. GILMORE
BRIDGE SHEET NUMBER:	IPARM NAME: sj088rs2.1
	SHEET 19 OF 90

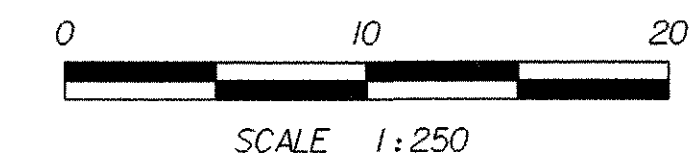

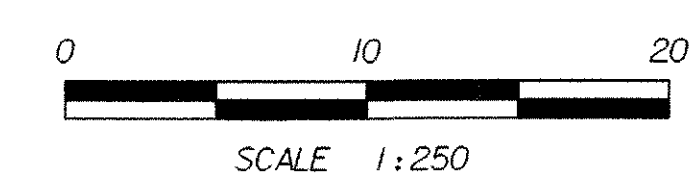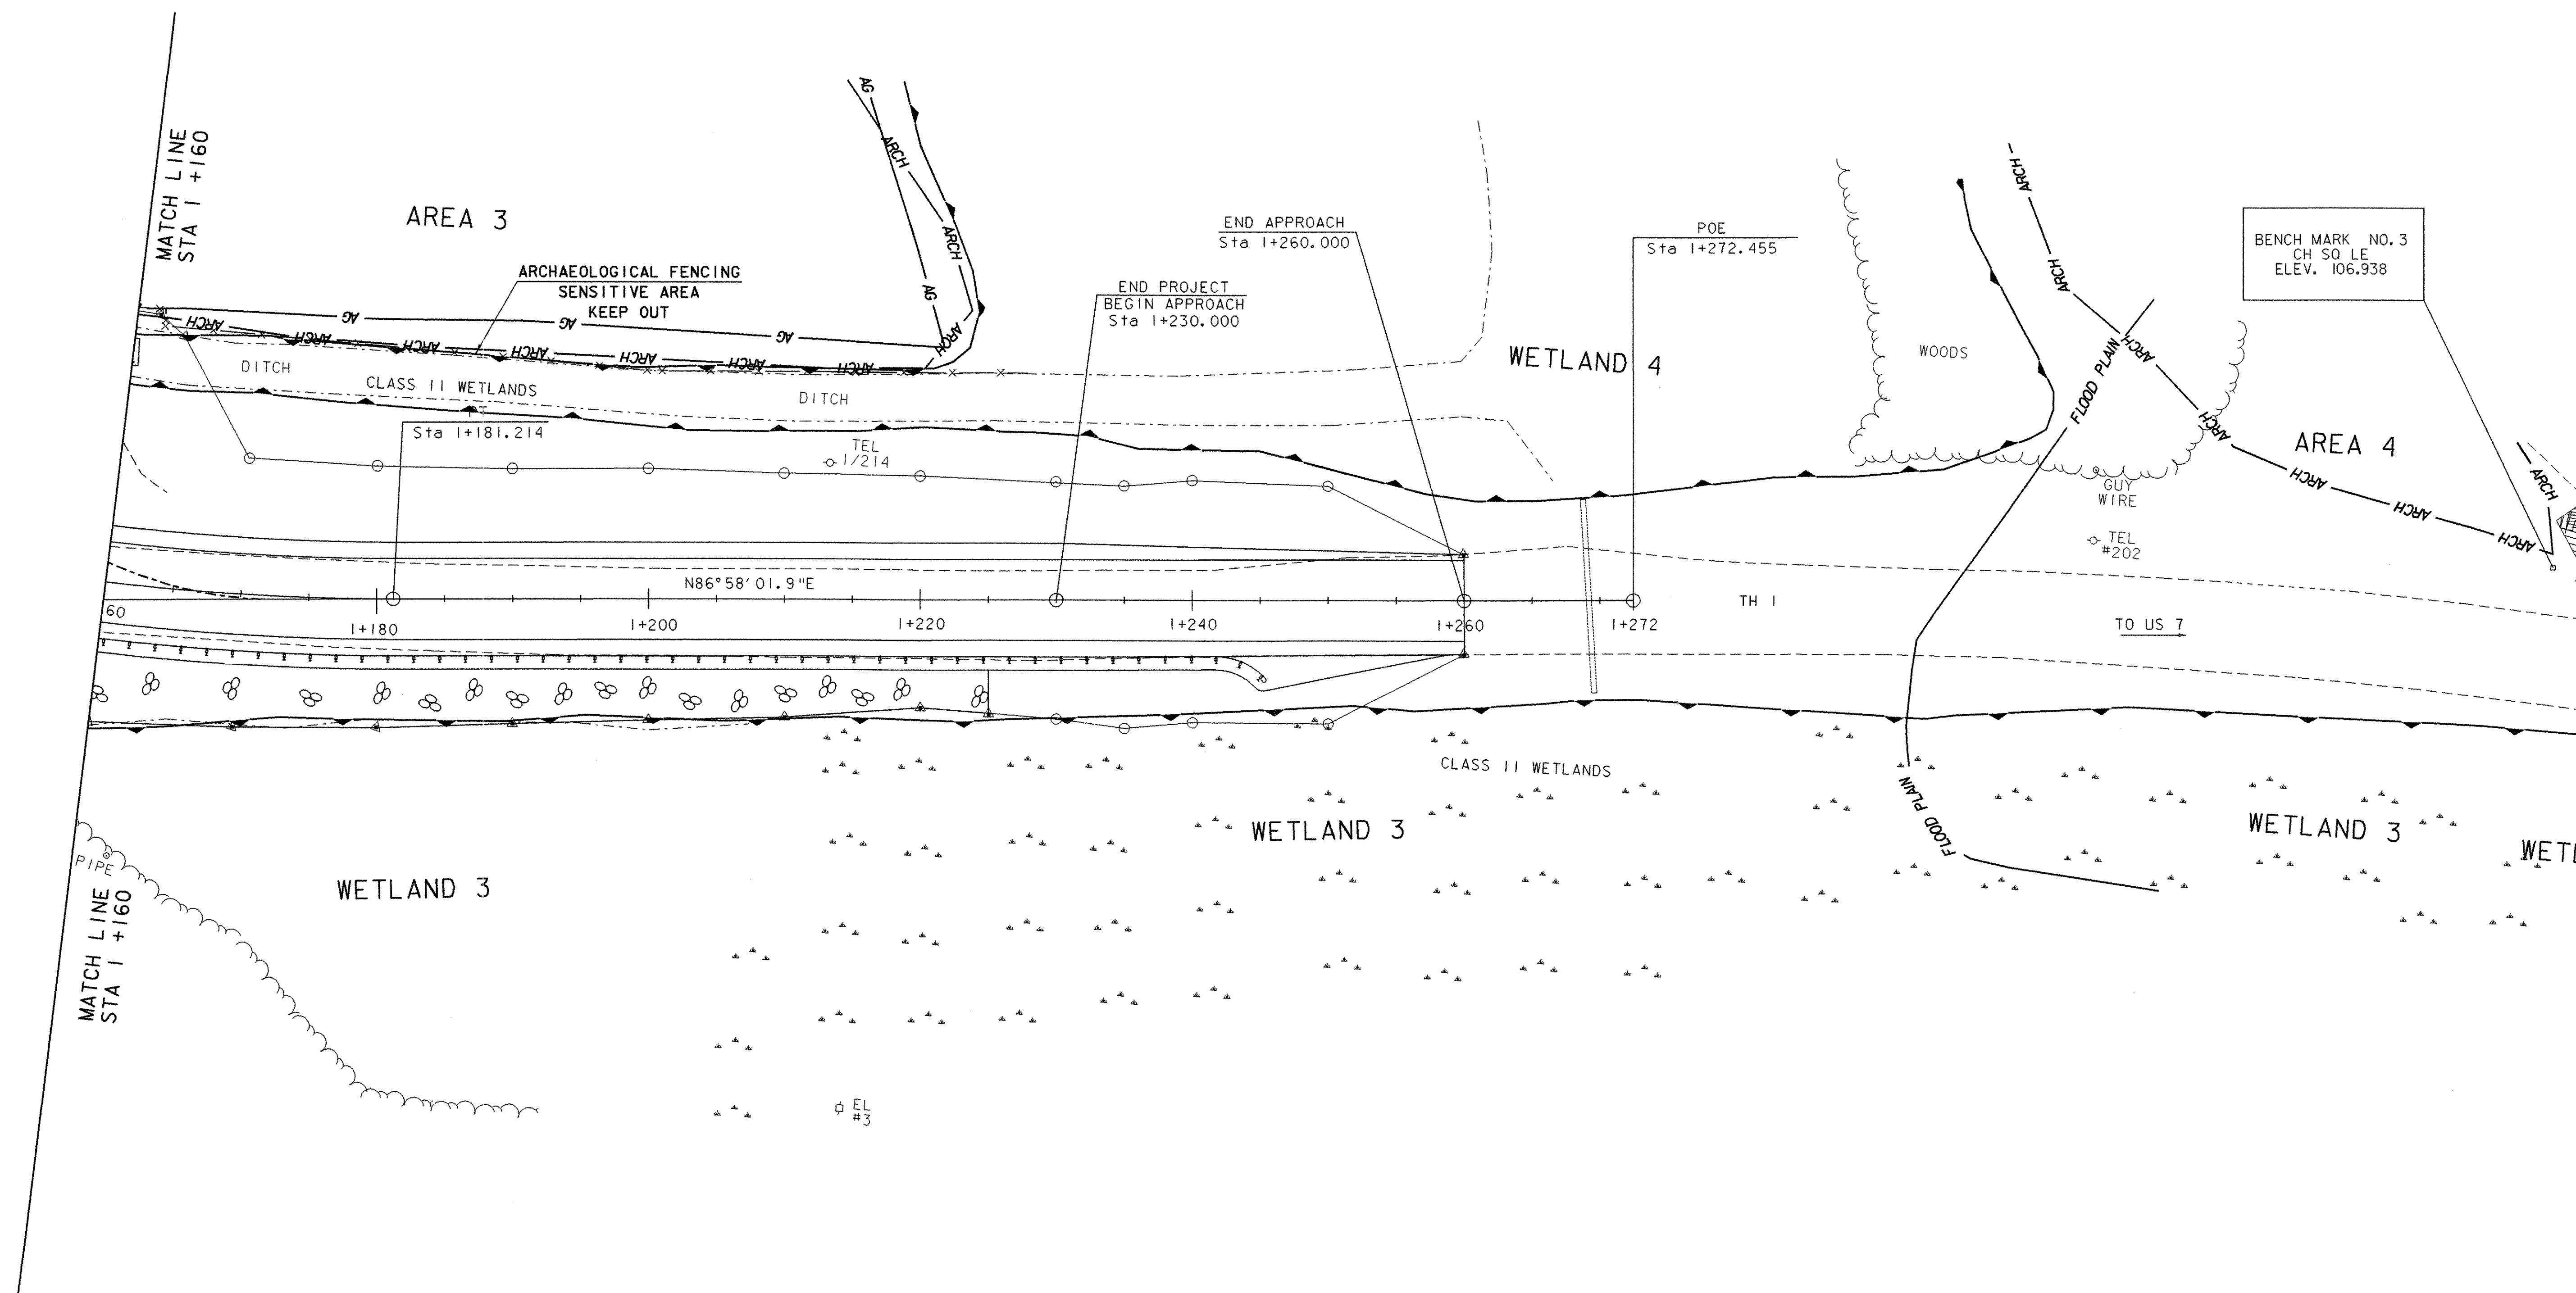

SHEET NAME: RESOURCE LAYOUT #3	
PROJECT NAME: LEICESTER	HIGHWAY NO.: FAS 0160
PROJECT NUMBER: BRF 0160(3)S	BRIDGE NO.: 6
	OVER: OTTER CREEK
FILE NAME: 95j288\Structures\sj288bdr.dgn	PLOT DATE: 17-AUG-2005
PROJECT MANAGER: R. R. WHITCOMB	DRAWN BY: J. GILMORE
DESIGNED BY: C. CARLSON	IPARM NAME: sj088rs3.1
BRIDGE SHEET NUMBER:	SHEET 20 OF 90

PROJECT DESCRIPTION

The project is located on Town Highway 1 over the Otter Creek in the town of Leicester, Vermont. The project area is located approximately 1.61 kilometers (1.0 miles) westerly of the junction of Town Highway 3 and Town Highway 1. The project extends in an east-west direction at this location or approximately 0.19 kilometers (0.12 miles) along Town Highway 1.

Construction will involve the replacement of Bridge #6 on a revised alignment approximately 1.22 meters (4 feet) downstream of the existing alignment. Work will include: construction of a new single span steel girder bridge structure with concrete deck and asphalt overlay that completely spans Otter Creek, new concrete abutments (on piles) and improved roadway approaches and channel work. Town Highway 1 will not be closed during construction work. Traffic will be maintained on an adjacent temporary two-way bridge located downstream during construction.

The vertical clearance of the bridge above streambed will be increased slightly from 6.5 meters (21.3 feet) to 6.7 meters (21.9 feet). There will be a decrease in the waterway full opening by 7 square meters (75 square feet) but the waterway flow characteristics with the location of the new bridge will be greatly improved by the elimination of the poorly aligned existing piers located within the creek channel. In addition, flow characteristic improvements will be realized by realignment of the creek channel subsequent to necessary excavation work during the new abutment installations.

The total disturbed area, excluding waste, borrow and staging areas, is 0.716 hectares.

SITE INVENTORY AND ANALYSIS

OFF SITE DRAINAGE CHARACTERISTICS

The project site is predominantly level. There are some preexisting unlined ditches along both sides of Town Highway 1 at STA 0+940 – STA 0+980 RT, STA 1+150 – STA 1+260 LT. In general, the road surfaces are the high point of the local terrain. Therefore, surface water runoff will flow off the roadway, along the side of the road and toward the Otter Creek. There seems to be little vegetation to impede this flow and particulate transport is probably high.

DRAINAGE, WATERWAYS, BODIES OF WATER

The project site includes Otter Creek, which is characterized as sinuous and alluvial. Otter Creek has a wide flood plain with a relatively flat slope and a drainage area of 1270 square kilometers. The entire project site is within the flood plain and is surrounded by defined wetland areas.

TOPOGRAPHY, EXISTING ROADS, BUILDINGS, UTILITIES

The terrain is flat at the construction site but changes to hilly and mountainous upstream. Town Highway 1 is a paved Class 2 road. Town Highway 12 is a gravel Class 3 road. The Vermont Railway crosses Town Highway 1 at STA 0+992. There is a one story wood frame house at STA 1+037 RT. The aerial utility lines span both sides of Town Highway 1, but they will be relocated by Central Vermont Power Supply to eliminate any interference with the construction site.

VEGETATION

There is little vegetation within the project site. There is a thin strip of trees on both banks of the Otter Creek. There is some brush on the west side of the railroad tracks. There are some residential type grasses growing along both sides of Town Highway 1.

No vegetation is specifically marked for removal and the impacts to the vegetation will be limited to that which is necessary for the construction of the new bridge.

SOILS

There are two soil types listed in the project area. From west to east, they are Limerick silt loam (Le) and Winooski very fine sandy loam (Wo).

The Limerick series consists of very deep, poorly drained soils on flood plains. They formed in loamy alluvium. Permeability is moderate. Slope ranges from 0 to 3 percent. Mean annual precipitation is about 34 inches and mean annual temperature is about 45 degrees F.

The Winooski series consists of very deep, moderately well drained soils formed in alluvial material. These soils are on nearly level floodplains. Slope ranges from 0 to 3 percent. Permeability is moderate or moderately rapid. Mean annual precipitation is about 45 inches and the mean annual temperature is about 49 degrees F.

The listed soil erodibility coefficient (K-Value) for both of these soils is 0.49. This value is in the range of soil that is classified as not highly erodable. (USDA Soil Conservation Service, 1967)

SEDIMENT SETTLING BASIN SIZING CRITERIA

PUMP FLOW RATE	REQUIRED SURFACE AREA		LENGTH / WIDTH = 2:1				
	Q(gpm)	Q(m ³ /s)	(ft ²)	(m ²)	L (ft)	W (ft)	L (m)
50	0.0032	595	55	35.0	17.0	10.6	5.3
100	0.0063	1200	111	49.0	24.5	15.0	7.5
150	0.0095	1776	165	59.6	29.8	18.2	9.1
200	0.0126	2368	220	68.8	34.4	21.0	10.5
250	0.0158	2970	276	77.0	38.5	23.4	11.7
300	0.0189	3560	330	84.4	42.2	25.8	12.9
350	0.0221	4155	386	91.2	45.6	27.8	13.9

SENSITIVE RESOURCE AREAS

There are nine wetland areas and four archeologically sensitive areas defined around the project site.

The drive at STA 1+026 LT is just outside an archeologically sensitive area. In this area, only fill is to be added. There will be no cuts made or removal of topsoil. All work done for adding the fill will be done within the drive limits.

All work on Town Highway 12 will be conducted from the roadway, also.

Protective fencing will be placed between the project site and all archeologically sensitive lands to avoid accidental impacts. Because precautions will be taken to avoid impacts to all identified archeological sensitive areas, this project qualifies for the category of "No Historic Properties Affected" because no buildings, structures, districts or archeological resources listed on or eligible for the National Register of Historic Places are located in the area of potential effect.

The well at STA 1+060 RT should be monitored for quantity and quality before, during and after construction.

It is important to note that the wetlands on the southern side of the Leicester-Whiting Road are unique to Vermont in that they are dominated by Buttonbush (*Cephalanthus occidentalis*). This plant is at the northern fringe of its natural range and is an important food supply for wildlife.

PROXIMITY TO NATURAL OR MAN-MADE WATER FEATURES

The removal of the existing structure and the construction of the new structure will take place on the banks and over the Otter Creek.

TEMPORARY EROSION PREVENTION AND SEDIMENT CONTROL

SEEDING AND MULCHING

Mulch should be applied to exposed soil at the end of each work day. This will require careful planning of the phasing of earth moving. Seed and mulch should be applied as soon as no more soil disturbance is expected to occur. Seed and mulch should be applied to topsoil stockpiles as well as to areas of disturbed soil.

PROJECT DEMARCATION FENCE

Install PDF along the perimeters of areas of disturbed soils. This fencing prevents construction equipment from pushing debris into areas of undisturbed vegetation, and minimizes the area of disturbed soil.

SURFACE ROUGHENING

If surfaces of slopes are left rough, this can help to reduce water velocity and increase infiltration rates. Rough slopes hold water, seed, and mulch better than smooth slopes. Slope surfaces can be roughened by running wheeled construction equipment across the slope or driving tracked equipment up and down the slope. The grooves created by the construction equipment should run across the slope horizontally and not up and down the slope. Slopes can also be scarified to produce the desired surface roughness.

COFFERDAM

Cofferdams are provided to ensure that the excavation of the existing abutments and construction of the new abutments adjacent to the Otter Creek are done in the dry. This may involve the design, construction, maintenance, and removal of a watertight structure or may involve alternate methods of dewatering and stabilizing the site.

CHECK DAM

A check dam is a small dam made of concrete, masonry, rock, metal, wood, sandbags, or other erosion-resistant materials placed in small erosion control waterways or around storm drain inlets. The purpose of a check dam is to reduce or prevent erosion and sedimentation by reducing velocities, by promoting deposition of sediment, and by stabilizing channel grades. Check dams can be damaged by heavy runoff or high water velocities, so be sure to inspect them often and repair or replace them when necessary.

SILT FENCE

A silt fence is a temporary sediment barrier installed at the toe of a slope, or adjacent waterway. The purpose of the silt fence is to intercept and detain small amounts of sediment from unprotected areas of limited extent, and to reduce water velocity on the construction site. A silt fence is constructed of synthetic sedimentation control fabric fastened to a support structure such as a lightweight stock fence. The fence is built parallel to contours where possible. The lower edge of the filter fabric must be buried about 6 inches below ground surface to prevent underflow, and the ends of the fence should be curved uphill to prevent flow around the ends. Silt fence shall also be built around the stabilized construction area.

STABILIZED CONSTRUCTION ENTRANCE

A stabilized pad of crushed stone located at any point where traffic will be entering or leaving a construction site to or from a public right-of-way, street, sidewalk or parking area. The purpose of a stabilized construction entrance is to reduce or eliminate the tracking of sediment onto public rights-of-way.

PERMANENT EROSION CONTROL MEASURES

STONE FILL

Stone fill, Type III, will be placed on the sides and in front of Abutments #1 and #2 at STA 1+075 – STA 1+097 LT & RT and STA 1+113 – STA 1+138 LT & RT. This will prevent runoff from eroding the sides of the banks leading down to the Otter Creek. This will also act as a buffer to prevent the Otter Creek from scouring the soil around the abutments.

DRAINAGE DITCH AND PIPES

A pipe will be installed at STA 2+020 to allow the uninterrupted flow of surface runoff from the drainage ditch on the east of Town Highway 12 to the Otter Creek. Stone fill Type III will be placed at STA 1+130 – STA 1+225 RT and will serve a dual purpose. The stone will help support the edge of the road better than compacted fill and will help keep the roadway edge from being eroded by runoff flow along the south side of Town Highway 1 at this location.

SEED AND MULCH

Seeding and mulching is one of the most effective means of controlling erosion. Therefore, all exposed surfaces outside of the roadway limits, which are not specified to be covered by stones or some other suitable cover, will be seeded and mulched.

GENERAL EROSION & SEDIMENT CONTROL GUIDELINES

The Erosion Control Plans are meant as a guideline for preventing erosion and controlling sediment transport. The work outlined in this narrative consists of applying measures throughout the life of the project to control erosion and minimize the sedimentation of receiving waters. The measures include stabilization and structural practices, storm water controls and other pollution prevention controls.

Coordinate the installation, use, and removal of erosion and sediment control measures with construction activities to ensure economical, effective and continuous erosion and sediment control. Employ temporary stabilization practices in incremental stages as construction proceeds. The contractor will use additional erosion control measures as necessitated by the sequence of construction and as directed by the Engineer and On-Site Coordinator. See section 105.23 of the Vermont AOT Standard Specifications for Construction, dated 2001.


Install all erosion and sediment control measures as shown in the Erosion Control Plan or as directed by the Engineer and On-Site Coordinator. Do not modify the type, size or location of any control or practice without approval of the Engineer. Any changes shall be noted on the plans, in the weekly inspection report, and reported to the appropriate authority in a timely manner. Inspect all control measures weekly and after each rainfall event. Repair or replace any damaged measures.

Preventing initial soil erosion is much more effective than treating eroded sediment. Therefore, stabilize all disturbed areas promptly after construction activity has temporarily or permanently ceased. Temporary vegetation shall be established if the area is to be without construction activity for a period of 14 days. Perimeter control measures shall be installed following clearing, but prior to the start of any grubbing or grading activity, install other temporary controls in incremental stages as construction proceeds.

Maintaining vegetated buffers along stream banks, wetlands or other sensitive areas is a crucial erosion and sediment control measure that should be established wherever possible.

Control only sediment-laden runoff generated by the project site. Collect and route clean offsite runoff around or through the project site using diversion berms, diversion channels, culverts and/or temporary pipes.

Do not allow construction equipment to operate on the down slope side of perimeter control measures.

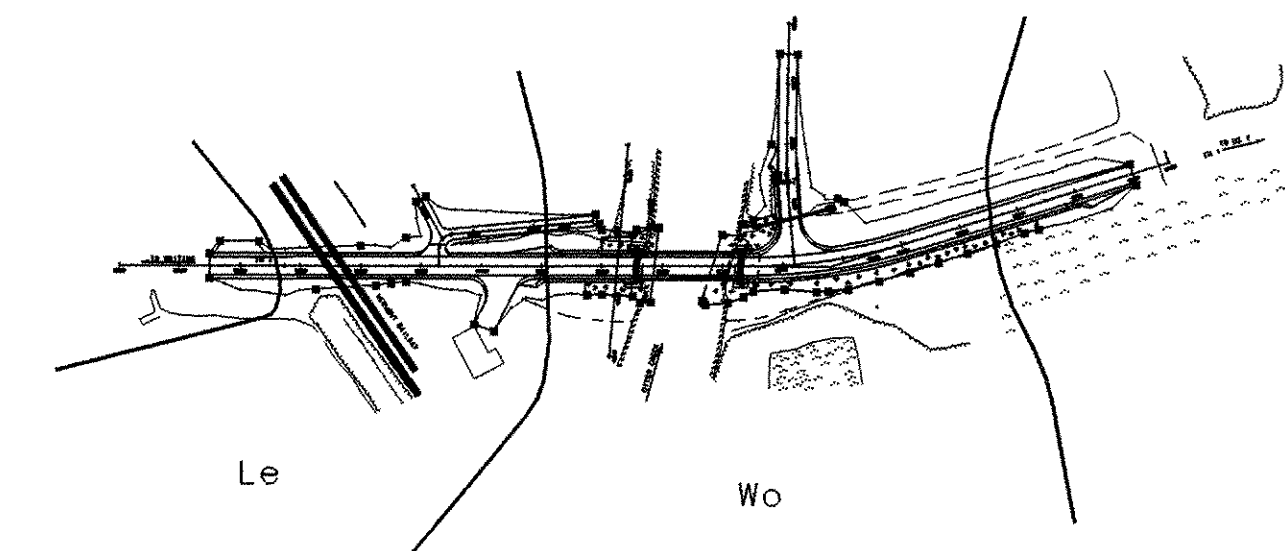


DELINEATION OF DIFFERENT SOIL TYPES


SHEET NAME: EROSION CONTROL NARRATIVE	
PROJECT NAME: LEICESTER	HIGHWAY NO.: FAS 0160
PROJECT NUMBER: BRF 0160(3)S	BRIDGE NO.: TH 6
	OVER: OTTER CREEK
FILE NAME: 95J288\Structures\sj288ecd.dgn	PLOT DATE: 17-AUG-2005
PROJECT MANAGER: R. R. WHITCOMB	DRAWN BY: VAOT
DESIGNED BY: C. CARLSON	IPARM NAME: sj288ecn.1
BRIDGE SHEET NUMBER:	SHEET 21 OF 90

NF
DEPOT FARM SUPPLY, INC.

1A
STATE OF VERMONT
JOINED BY
VERMONT RAILWAY, INC.

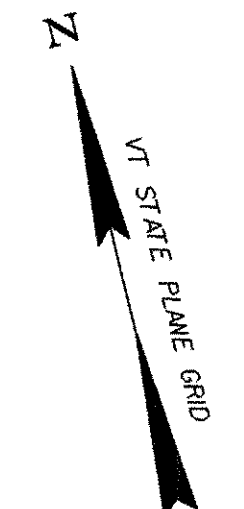

P
L

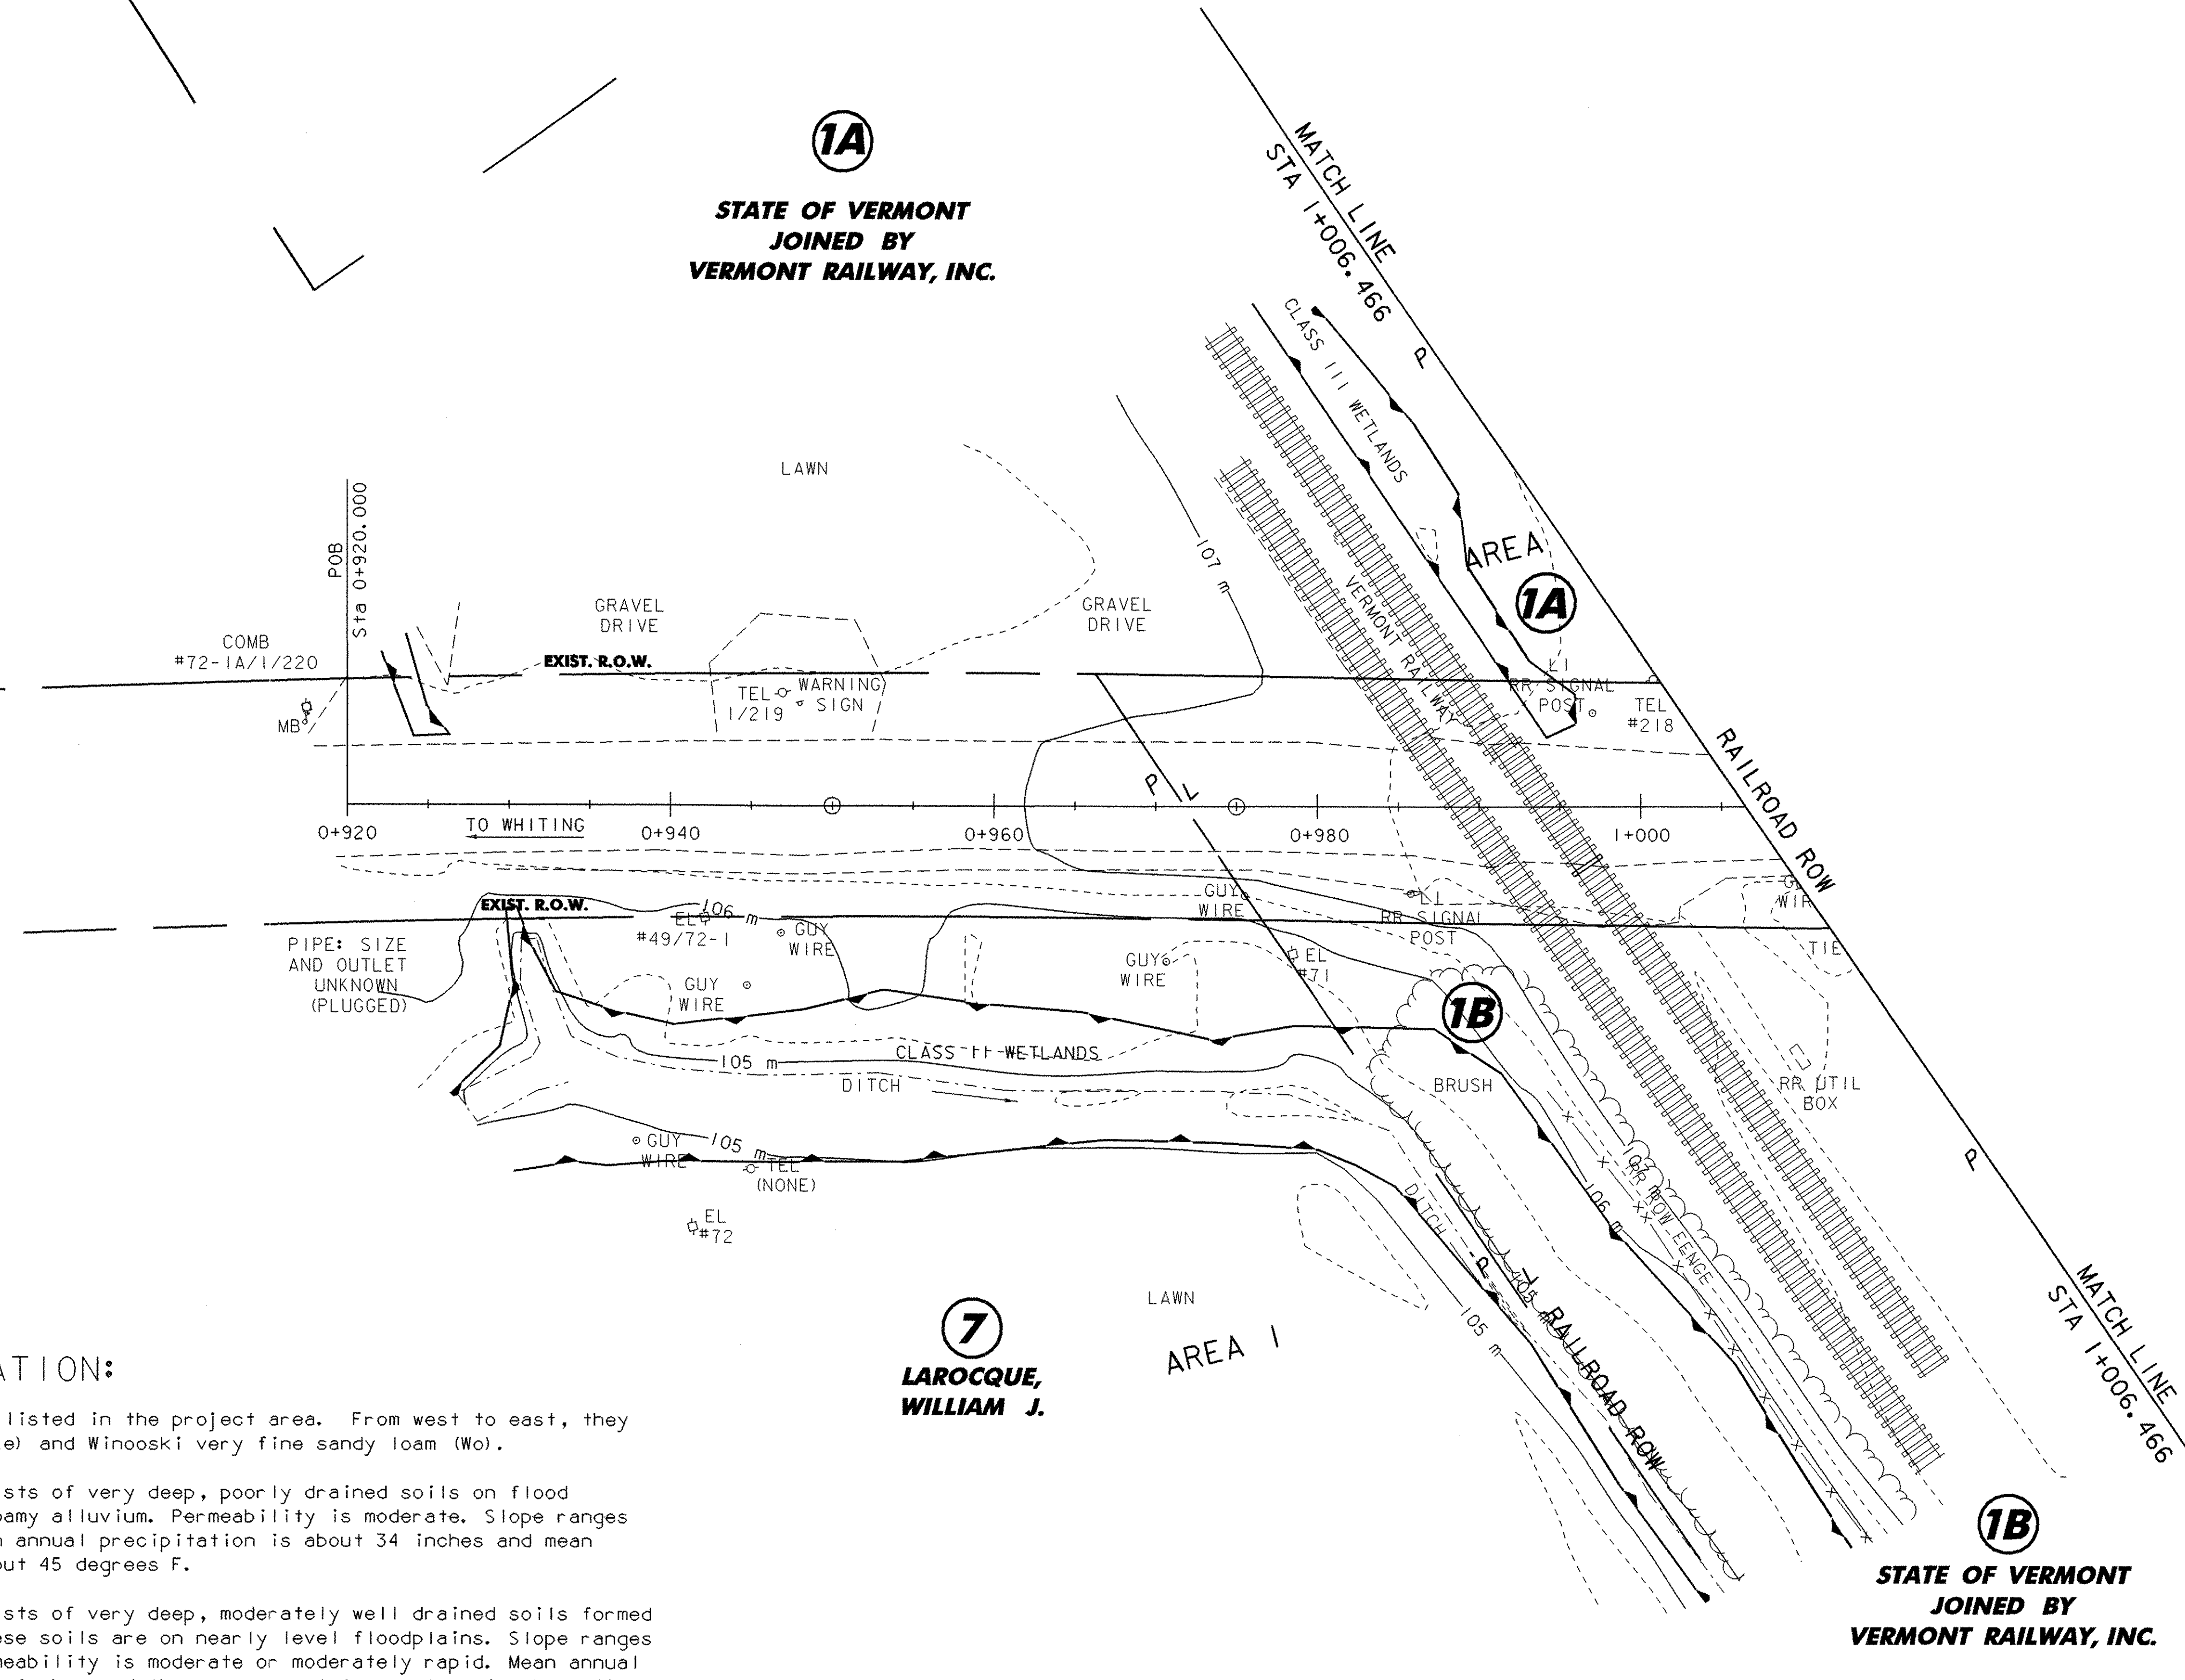

7
LAROCQUE,
WILLIAM J.

1B
STATE OF VERMONT
JOINED BY
VERMONT RAILWAY, INC.


SOILS INFORMATION:

There are two soil types listed in the project area. From west to east, they are Limerick silt loam (Le) and Winooski very fine sandy loam (Wo).


The Limerick series consists of very deep, poorly drained soils on flood plains. They formed in loamy alluvium. Permeability is moderate. Slope ranges from 0 to 3 percent. Mean annual precipitation is about 34 inches and mean annual temperature is about 45 degrees F.

The Winooski series consists of very deep, moderately well drained soils formed in alluvial material. These soils are on nearly level floodplains. Slope ranges from 0 to 3 percent. Permeability is moderate or moderately rapid. Mean annual precipitation is about 45 inches and the mean annual temperature is about 49 degrees F.


DATUM	
VERTICAL	NAVD 88
HORIZONTAL	NAD 83/92
ADJUSTED	YES
TYPE	COMPASS

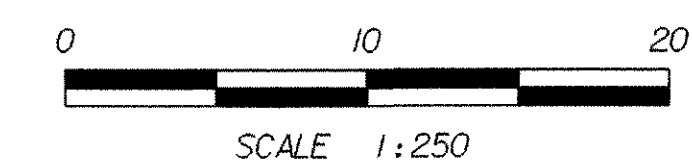

SHEET NAME:	EXISTING CONDITIONS SITE PLAN #1	
PROJECT NAME:	LEICESTER	HIGHWAY NO.: FAS 0160
PROJECT NUMBER:	BRF 0160(3)S	BRIDGE NO.: 6
		OVER: OTTER CREEK
FILE NAME:	95J288\Structures\sj288bdr.dgn	
PROJECT MANAGER:	R. R. WHITCOMB	PLOT DATE: 17-AUG-2005
DESIGNED BY:	C. CARLSON	DRAWN BY: STRI
BRIDGE SHEET NUMBER:		IPARM NAME: sj288erol1
		SHEET 22 OF 90

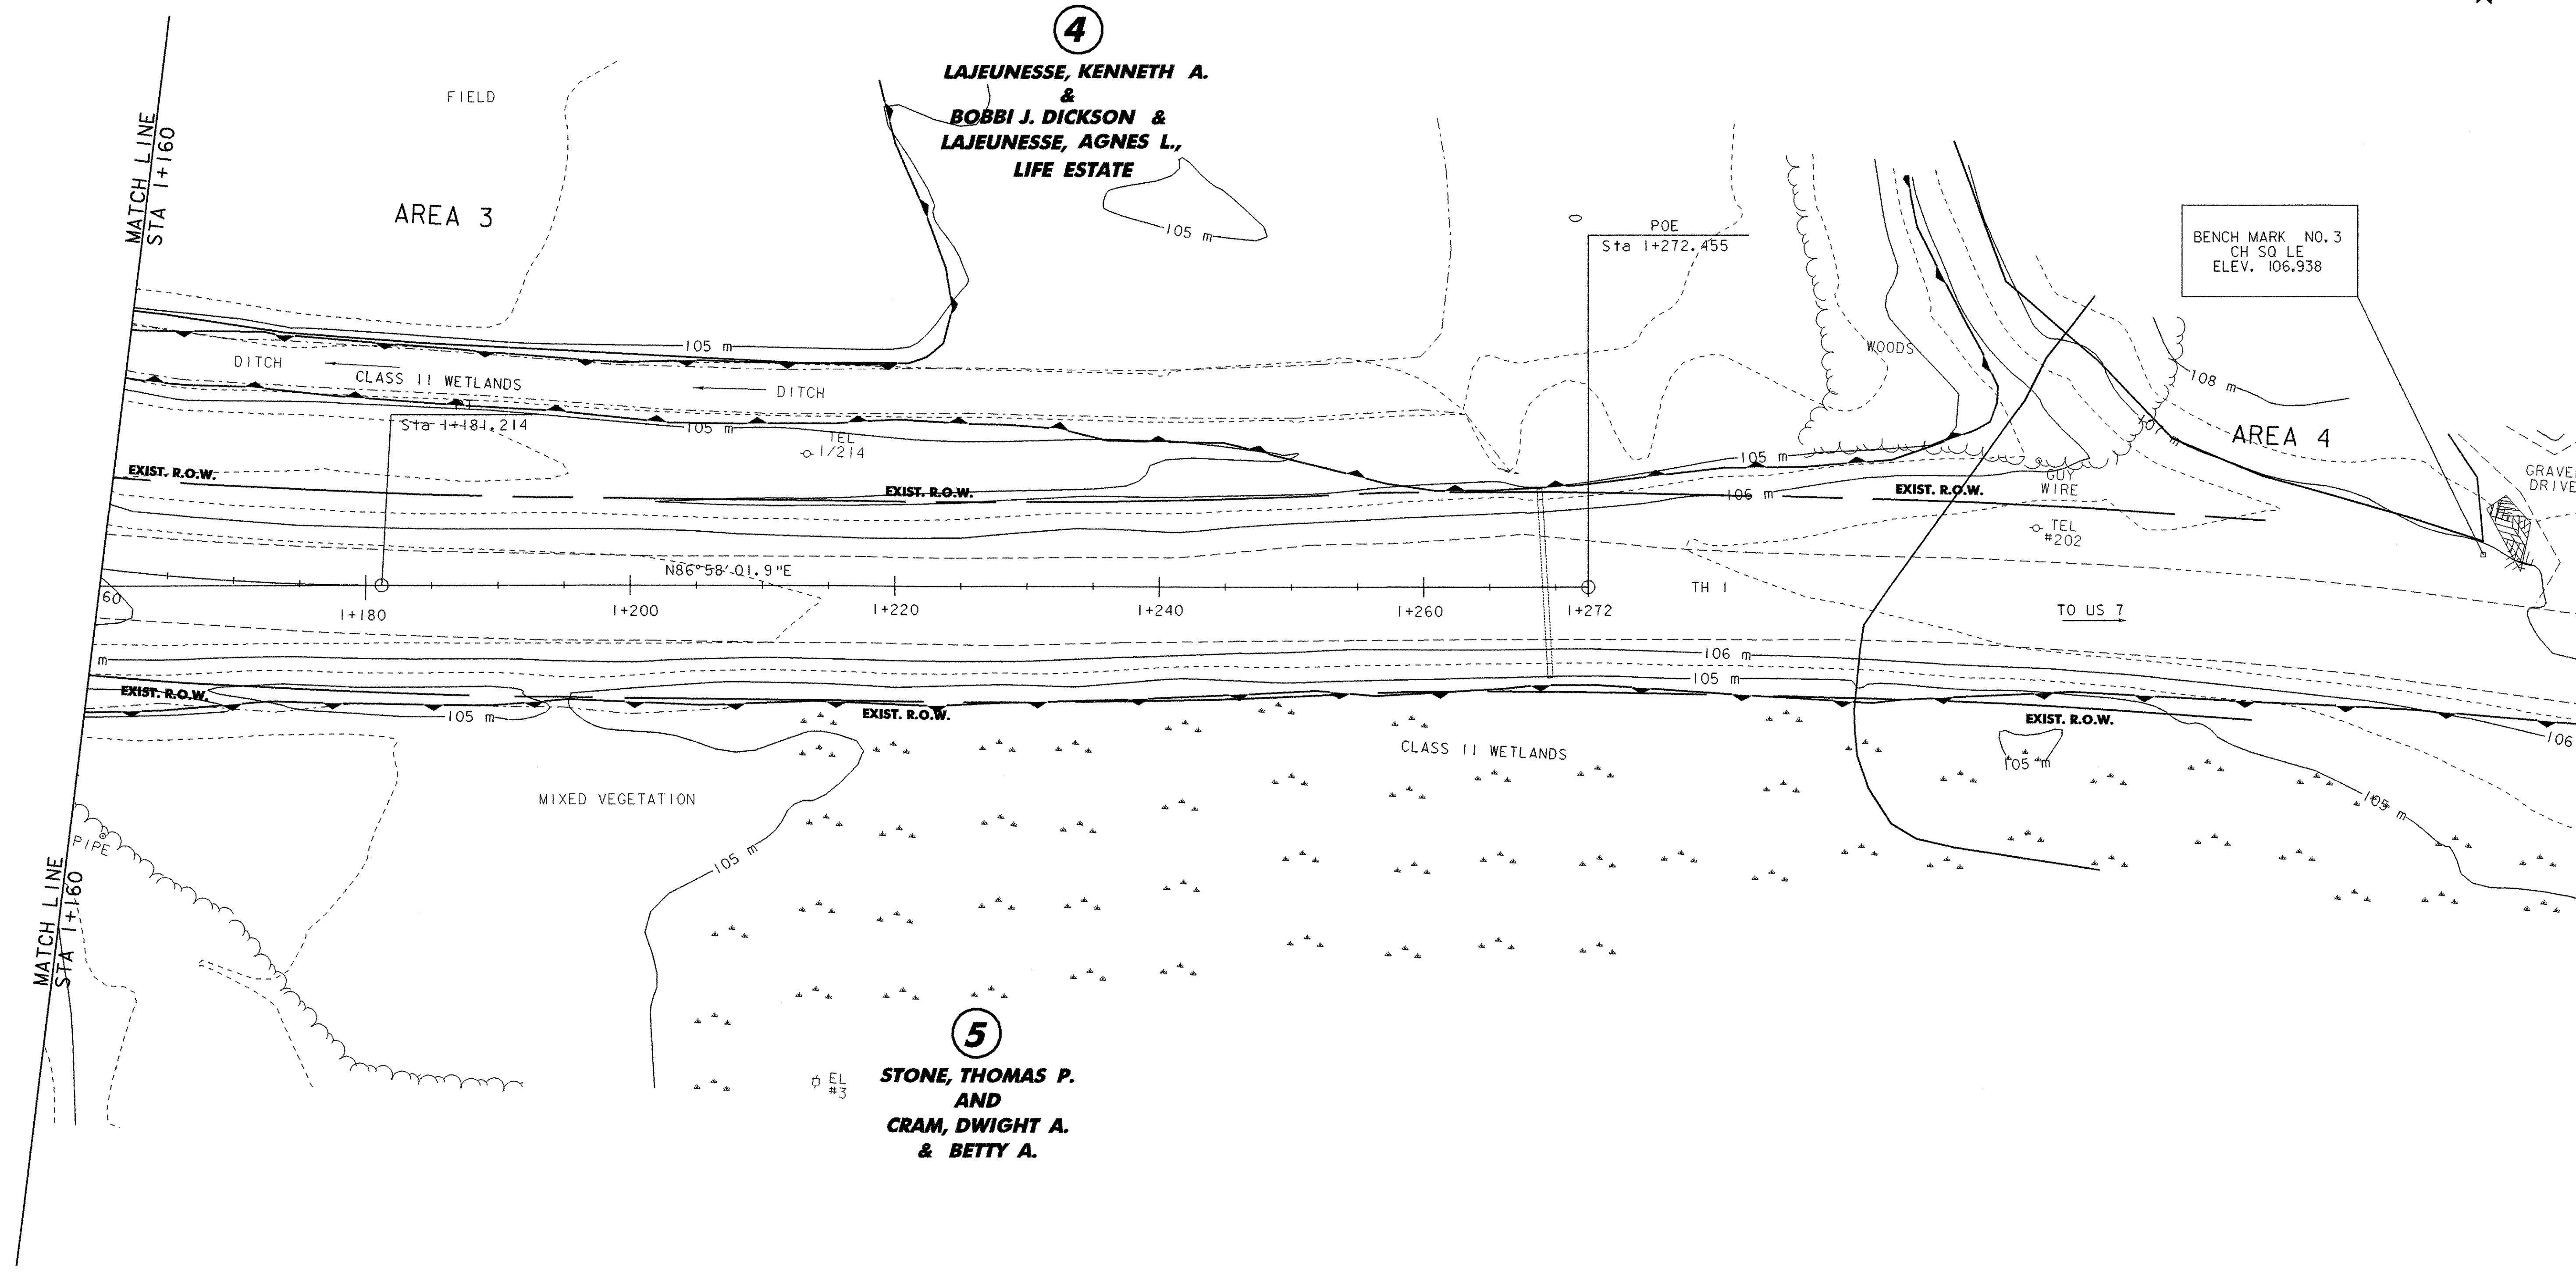


DATUM	
VERTICAL	NAVD 88
HORIZONTAL	NAD 83/92
ADJUSTED	YES
TYPE	COMPASS

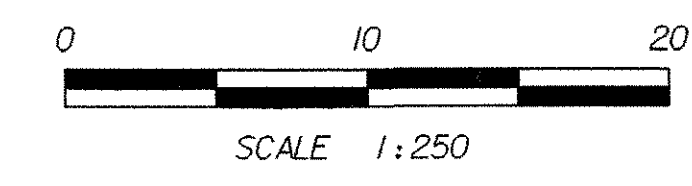


SHEET NAME: EXISTING CONDITIONS SITE PLAN #3	
PROJECT NAME: LEICESTER	HIGHWAY NO.: FAS 0160
PROJECT NUMBER: BRF 0160(3)S	BRIDGE NO.: 6
	OVER: OTTER CREEK
FILE NAME: 95J288\Structures\sj288bdr.dgn	PLOT DATE: 17-AUG-2005
PROJECT MANAGER: R. R. WHITCOMB	DRAWN BY: STRI
DESIGNED BY: C. CARLSON	IPARM NAME: sj288ero3.1
BRIDGE SHEET NUMBER:	SHEET 24 OF 90

NF
DEPOT FARM SUPPLY, INC.

1A
STATE OF VERMONT
JOINED BY
VERMONT RAILWAY, INC.

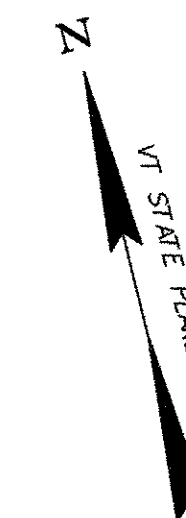

P
L

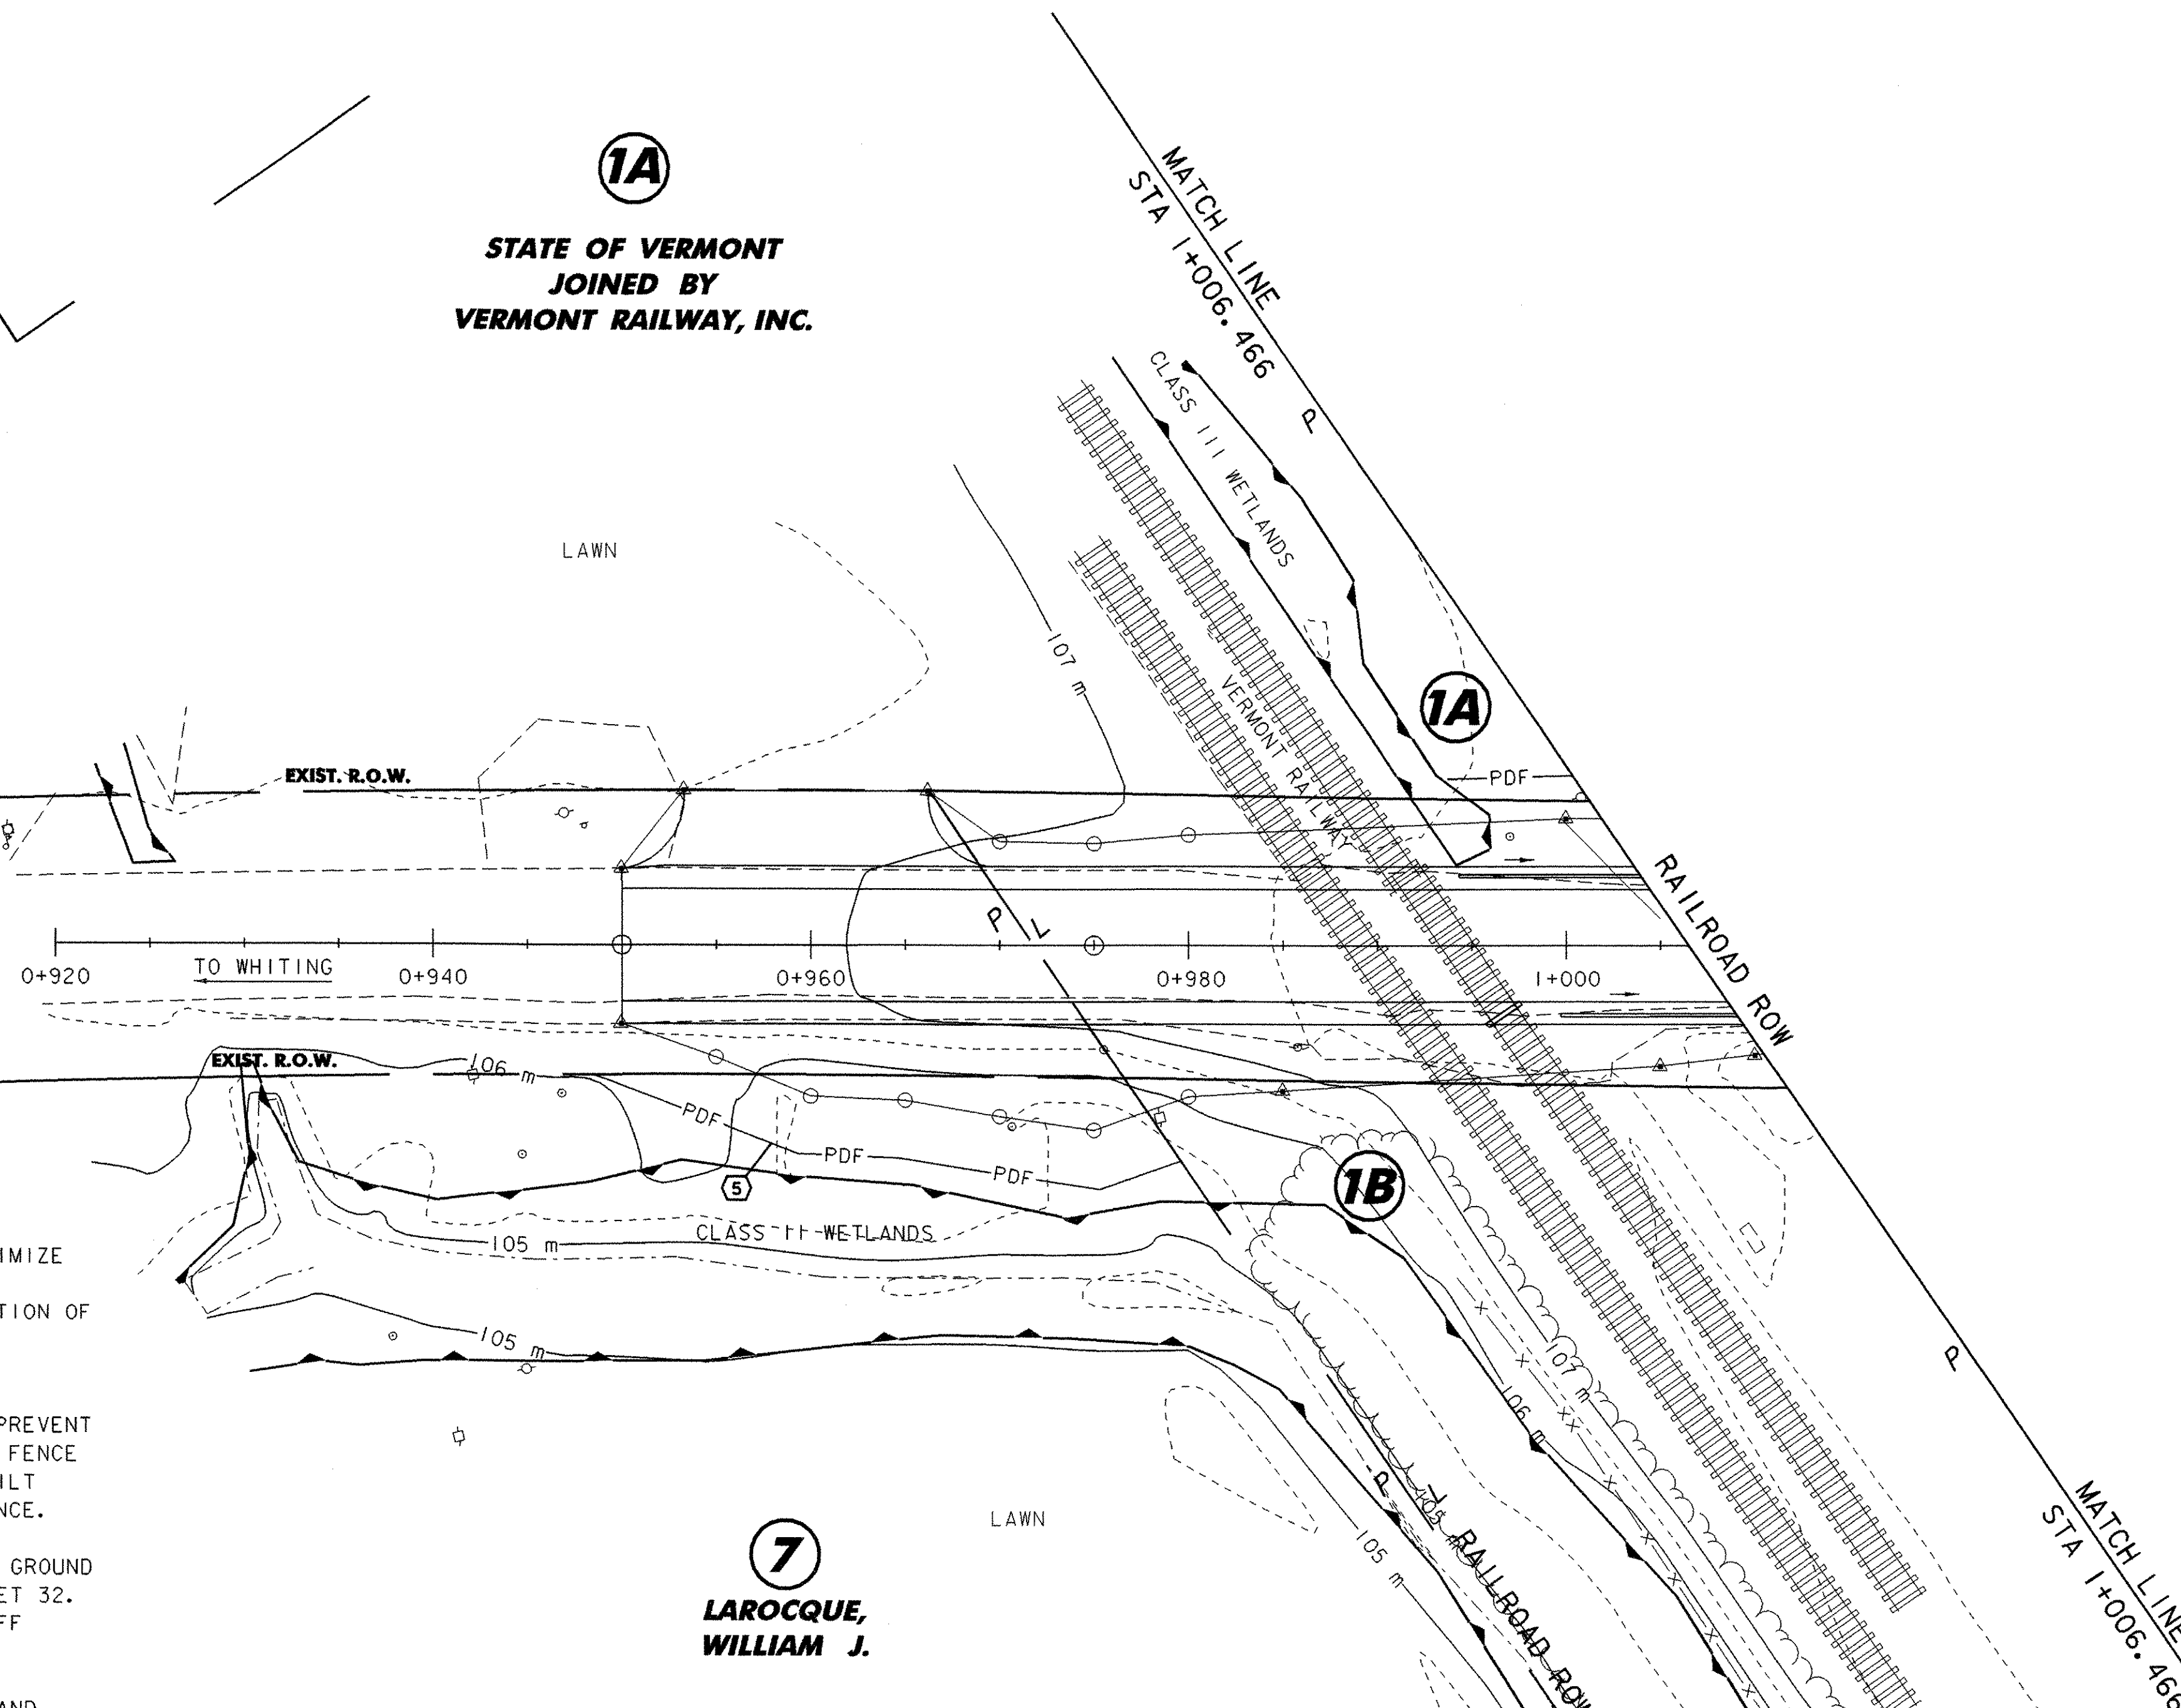

NOTES:

1. SILT FENCE INSTALLATION MAY REQUIRE PHASING TO MAXIMIZE EFFECTIVENESS. INSTALL AND/OR MOVE SILT FENCE AS CONSTRUCTION PROGRESSES TO OBTAIN THE GREATEST PREVENTION OF SEDIMENT TRANSPORT. ALL SILT FENCE INSTALLATION SHALL BE PROPERLY KEYED INTO THE GROUND AND SUPPORTED AS DETAILED ON THE EROSION CONTROL DETAIL SHEET 31. SILT FENCE SHOULD BE INSTALLED ALONG THE CONTOURS TO PREVENT CONCENTRATION OF RUNOFF. THE ENDS OF EACH RUN OF SILT FENCE SHOULD BE TURNED UPHILL TO PROVIDE A SMALL POOL FOR SILT SHOULD WATER TRY TO RUN AROUND THE END OF THE SILT FENCE.

2. TEMPORARY STONE CHECK DAMS SHALL BE KEYED INTO THE GROUND AND CONSTRUCTED AS PER THE EROSION CONTROL DETAIL SHEET 32. THE PURPOSE OF TEMPORARY CHECK DAMS IS TO REDUCE RUNOFF VELOCITIES THUS PREVENTING EROSION.

3. SURFACE ROUGHENING HELPS REDUCE RUNOFF VELOCITIES AND INCREASES INFILTRATION RATES. ROUGHENING MAY BE ACCOMPLISHED BY A NUMBER OF METHODS SUCH AS TRACKING UP AND DOWN THE SLOPE WITH A BULLDOZER, TRACKING ACROSS THE SLOPE WITH A WHEELED VEHICLE OR ANY METHOD OF SCARIFYING THE SLOPE SUCH THAT THE GROOVES CREATED RUN PERPENDICULAR TO THE DIRECTION OF WATER RUNOFF.

4. SEE SHEET 35 FOR SEEDING DETAILS.

7
LAROCQUE,
WILLIAM J.


LEGEND

- WETLANDS
- FILTER CURTAIN
- SILT FENCE
- STONE FILL, TYPE III
- STONE FILL, TYPE I (MOD. I - CHECK DAMS)
- PROJECT DEMARCATION FENCING

EROSION AND SEDIMENT CONTROL INDEX	
NO.	DESCRIPTION
①	INSTALL ARCH. FENCE ALONG ARCHEOLOGICALLY SENSITIVE AREA
②	INSTALL SILT FENCE AT DOWNSLOPE SIDE OF DISTURBANCE LIMITS
③	ENDS OF FENCE TURNED UPHILL TO CREATE PONDING
④	INSTALL ROCK CHECK DAMS IN DITCHES
⑤	PROJECT LIMIT DEMARCATION FENCE (SNOW FENCE (MOD-PDF))
⑥	EROSION CONTROL MATTING

NOTE: ALL DISTURBED AREAS WITH SLOPES GREATER THAN 1:3 WILL REQUIRE TEMPORARY EROSION MATTING (SEE EROSION CONTROL DETAIL SHEET 35)

DATUM	
VERTICAL	NAVD 88
HORIZONTAL	NAD 83/92
ADJUSTED	YES
TYPE	COMPASS

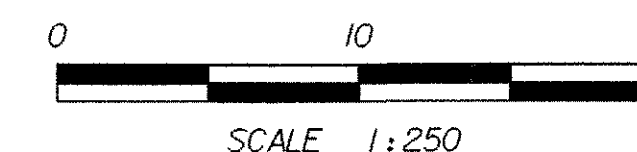


1B
STATE OF VERMONT
JOINED BY
VERMONT RAILWAY, INC.

SHEET NAME: EROSION PREVENTION & SEDIMENT CONTROL PLAN #1	
PROJECT NAME: LEICESTER	HIGHWAY NO.: FAS 0160
PROJECT NUMBER: BRF 0160(3)S	BRIDGE NO.: 6
	OVER: OTTER CREEK
FILE NAME: 95J288\Structures\sj288bdr.dgn	PLOT DATE: 17-AUG-2005
PROJECT MANAGER: R. R. WHITCOMB	DRAWN BY: STRI
DESIGNED BY: C. CARLSON	IPARM NAME: sj288ero4.1
BRIDGE SHEET NUMBER:	SHEET 25 OF 90

EROSION AND SEDIMENT CONTROL INDEX	
NO.	DESCRIPTION
1	INSTALL ARCH. FENCE ALONG ARCHEOLOGICALLY SENSITIVE AREA
2	INSTALL SILT FENCE AT DOWNSLOPE SIDE OF DISTURBANCE LIMITS
3	ENDS OF FENCE TURNED UPHILL TO CREATE PONDING
4	INSTALL ROCK CHECK DAMS IN DITCHES
5	PROJECT LIMIT DEMARCATION FENCE (SNOW FENCE (MOD-PDF))
6	EROSION CONTROL MATTING
7	INSTALL FILTER CURTAIN

NOTE: ALL DISTURBED AREAS WITH SLOPES GREATER THAN 1:3 WILL REQUIRE TEMPORARY EROSION MATTING (SEE EROSION CONTROL DETAIL SHEET 35)

LEGEND	
	WETLANDS
	FILTER CURTAIN
	SILT FENCE
	STONE FILL, TYPE III
	STONE FILL, TYPE I (MOD. I - CHECK DAMS)
	PROJECT DEMARCATION FENCING

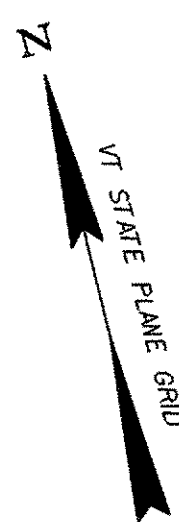

MATCH LINE
STA 1+06.466

MATCH LINE
STA 1+160

2
**LAMOUREUX,
LEO J. & ARLENE J.**


3
**FOX, CATLIN J. &
CLAGHORN, ANNE W.
JOINED BY VERMONT
LAND TRUST, INC.**

4
**LAJEUNESSE,
KENNETH A. &
BOBBI J. DICKSON &
LAJEUNESSE,
AGNES L.,
LIFE ESTATE**

5
**STONE THOMAS P.
AND
CRAM, DWIGHT A.
& BETTY A.**

6
**DIKE,
STEPHEN & DEBORAH**

BENCH MARK NO. 2
R.R.S.L.T.
LARGE WILLOW
ELEV. 106.097

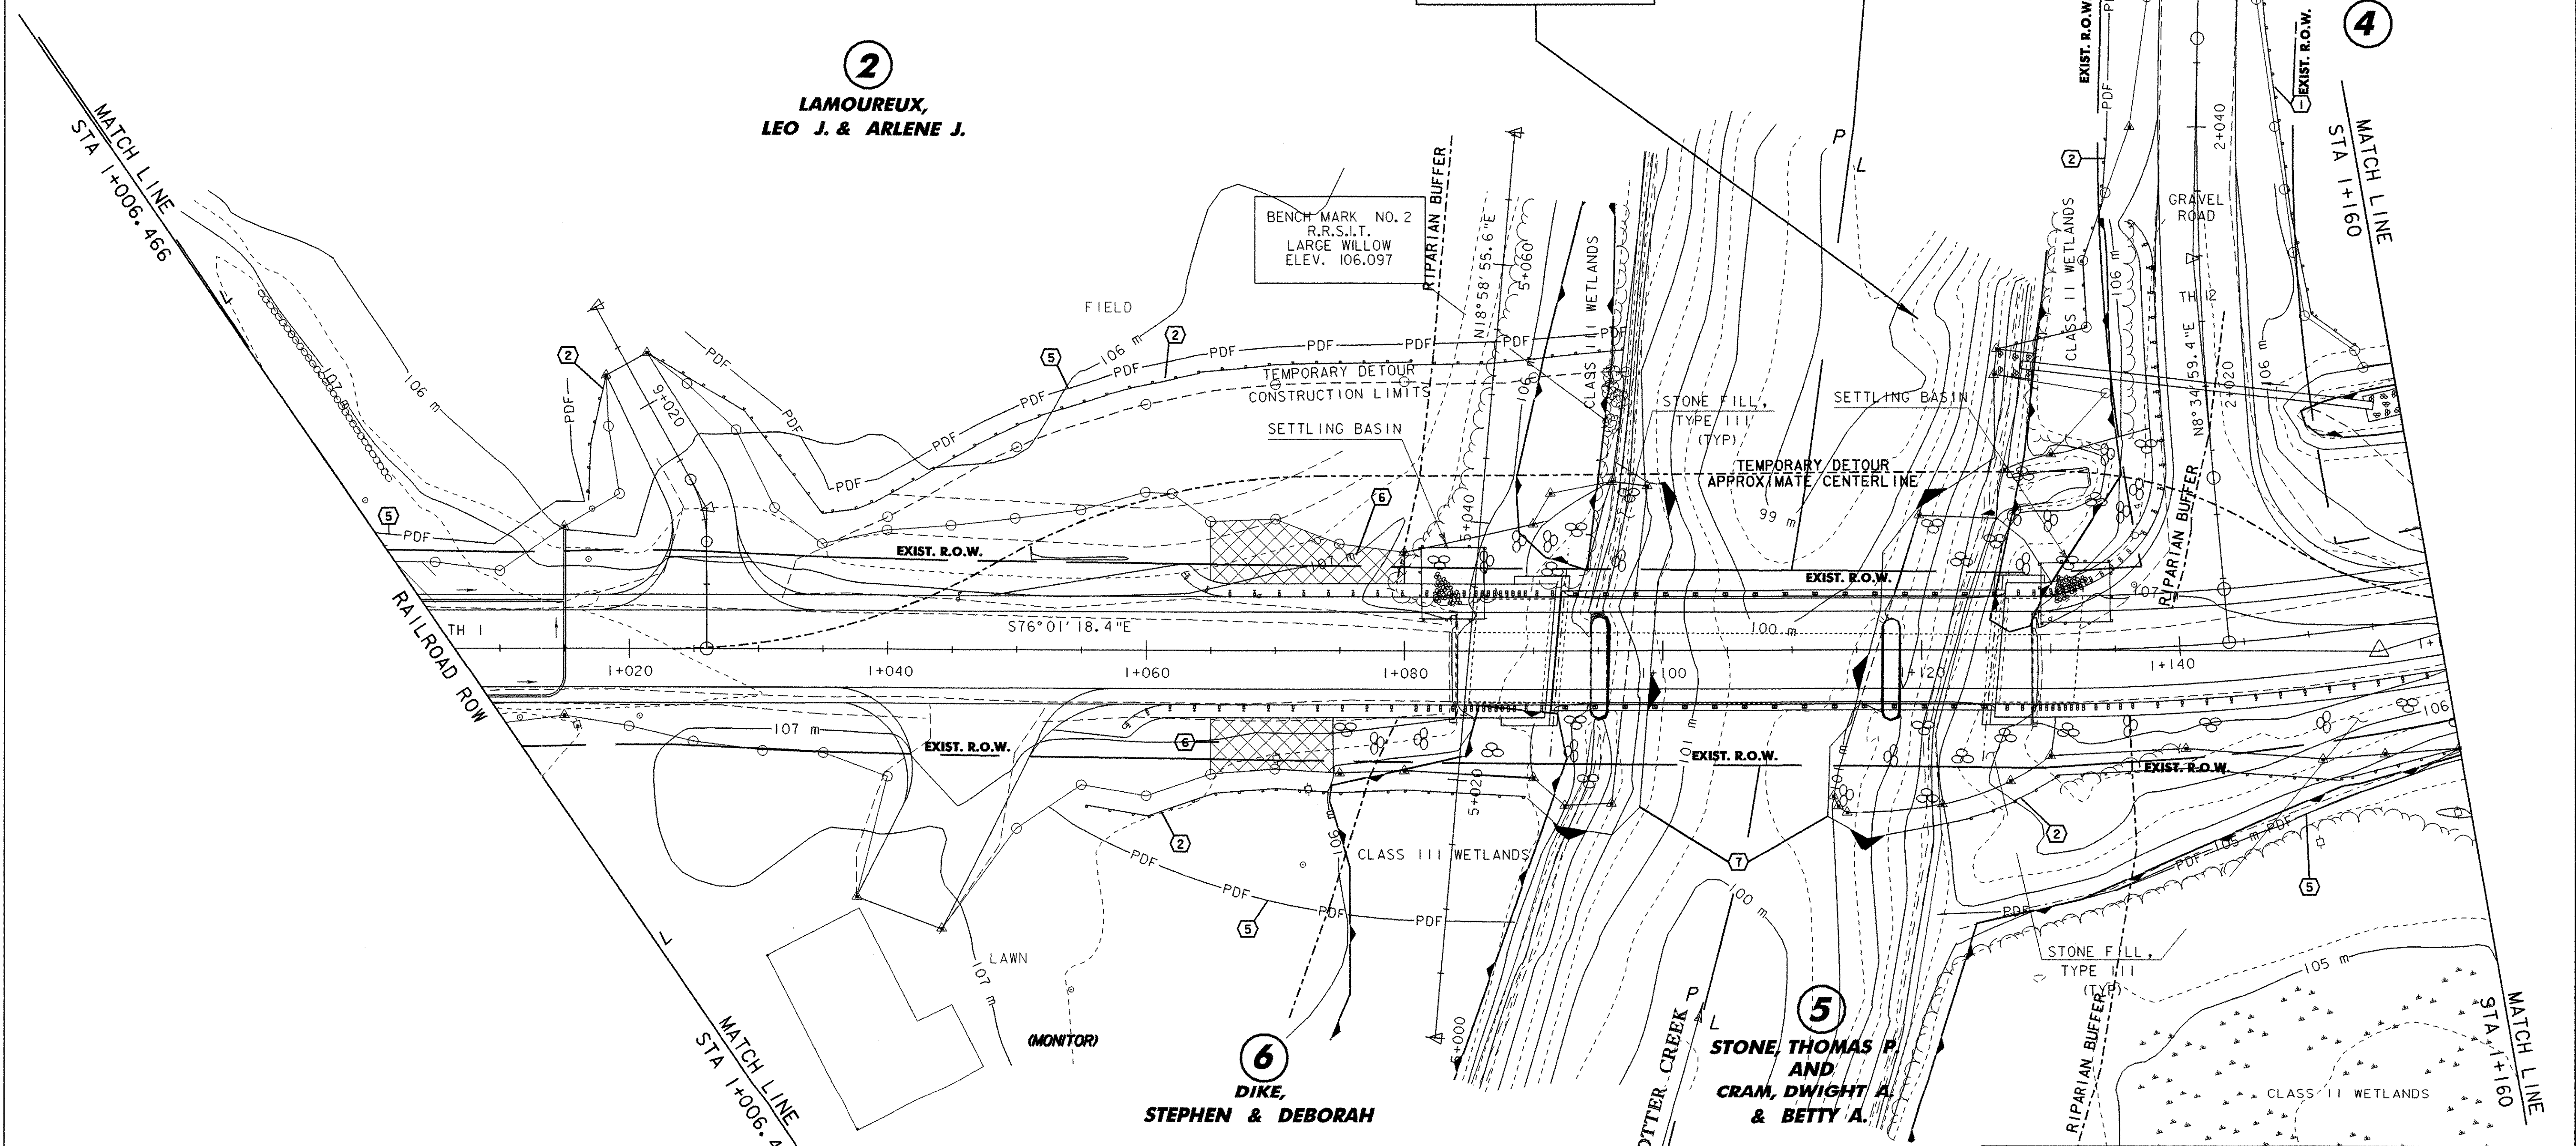


DATUM	
VERTICAL	NAVD 88
HORIZONTAL	NAD 83/92
ADJUSTED	YES
TYPE	COMPASS

EROSION PREVENTION & SEDIMENT CONTROL PLAN #2	
SHEET NAME:	EROSION PREVENTION & SEDIMENT CONTROL PLAN #2
PROJECT NAME:	LEICESTER
PROJECT NUMBER:	BRF 0160(3)S
FILE NAME:	95j288\structures\sj288bdr.dgn
PROJECT MANAGER:	R. R. WHITCOMB
DESIGNED BY:	C. CARLSON
BRIDGE SHEET NUMBER:	
HIGHWAY NO.:	FAS 0160
BRIDGE NO.:	6
OVER:	OTTER CREEK
PLOT DATE:	17-AUG-2005
DRAWN BY:	STRI
IPARM NAME:	sj288ero5.1
SHEET	26 OF 90



LEGEND	
	WETLANDS
	FILTER CURTAIN
	SILT FENCE
	STONE FILL, TYPE III
	PROJECT DEMARCATION FENCE
	EROSION CONTROL MATTING

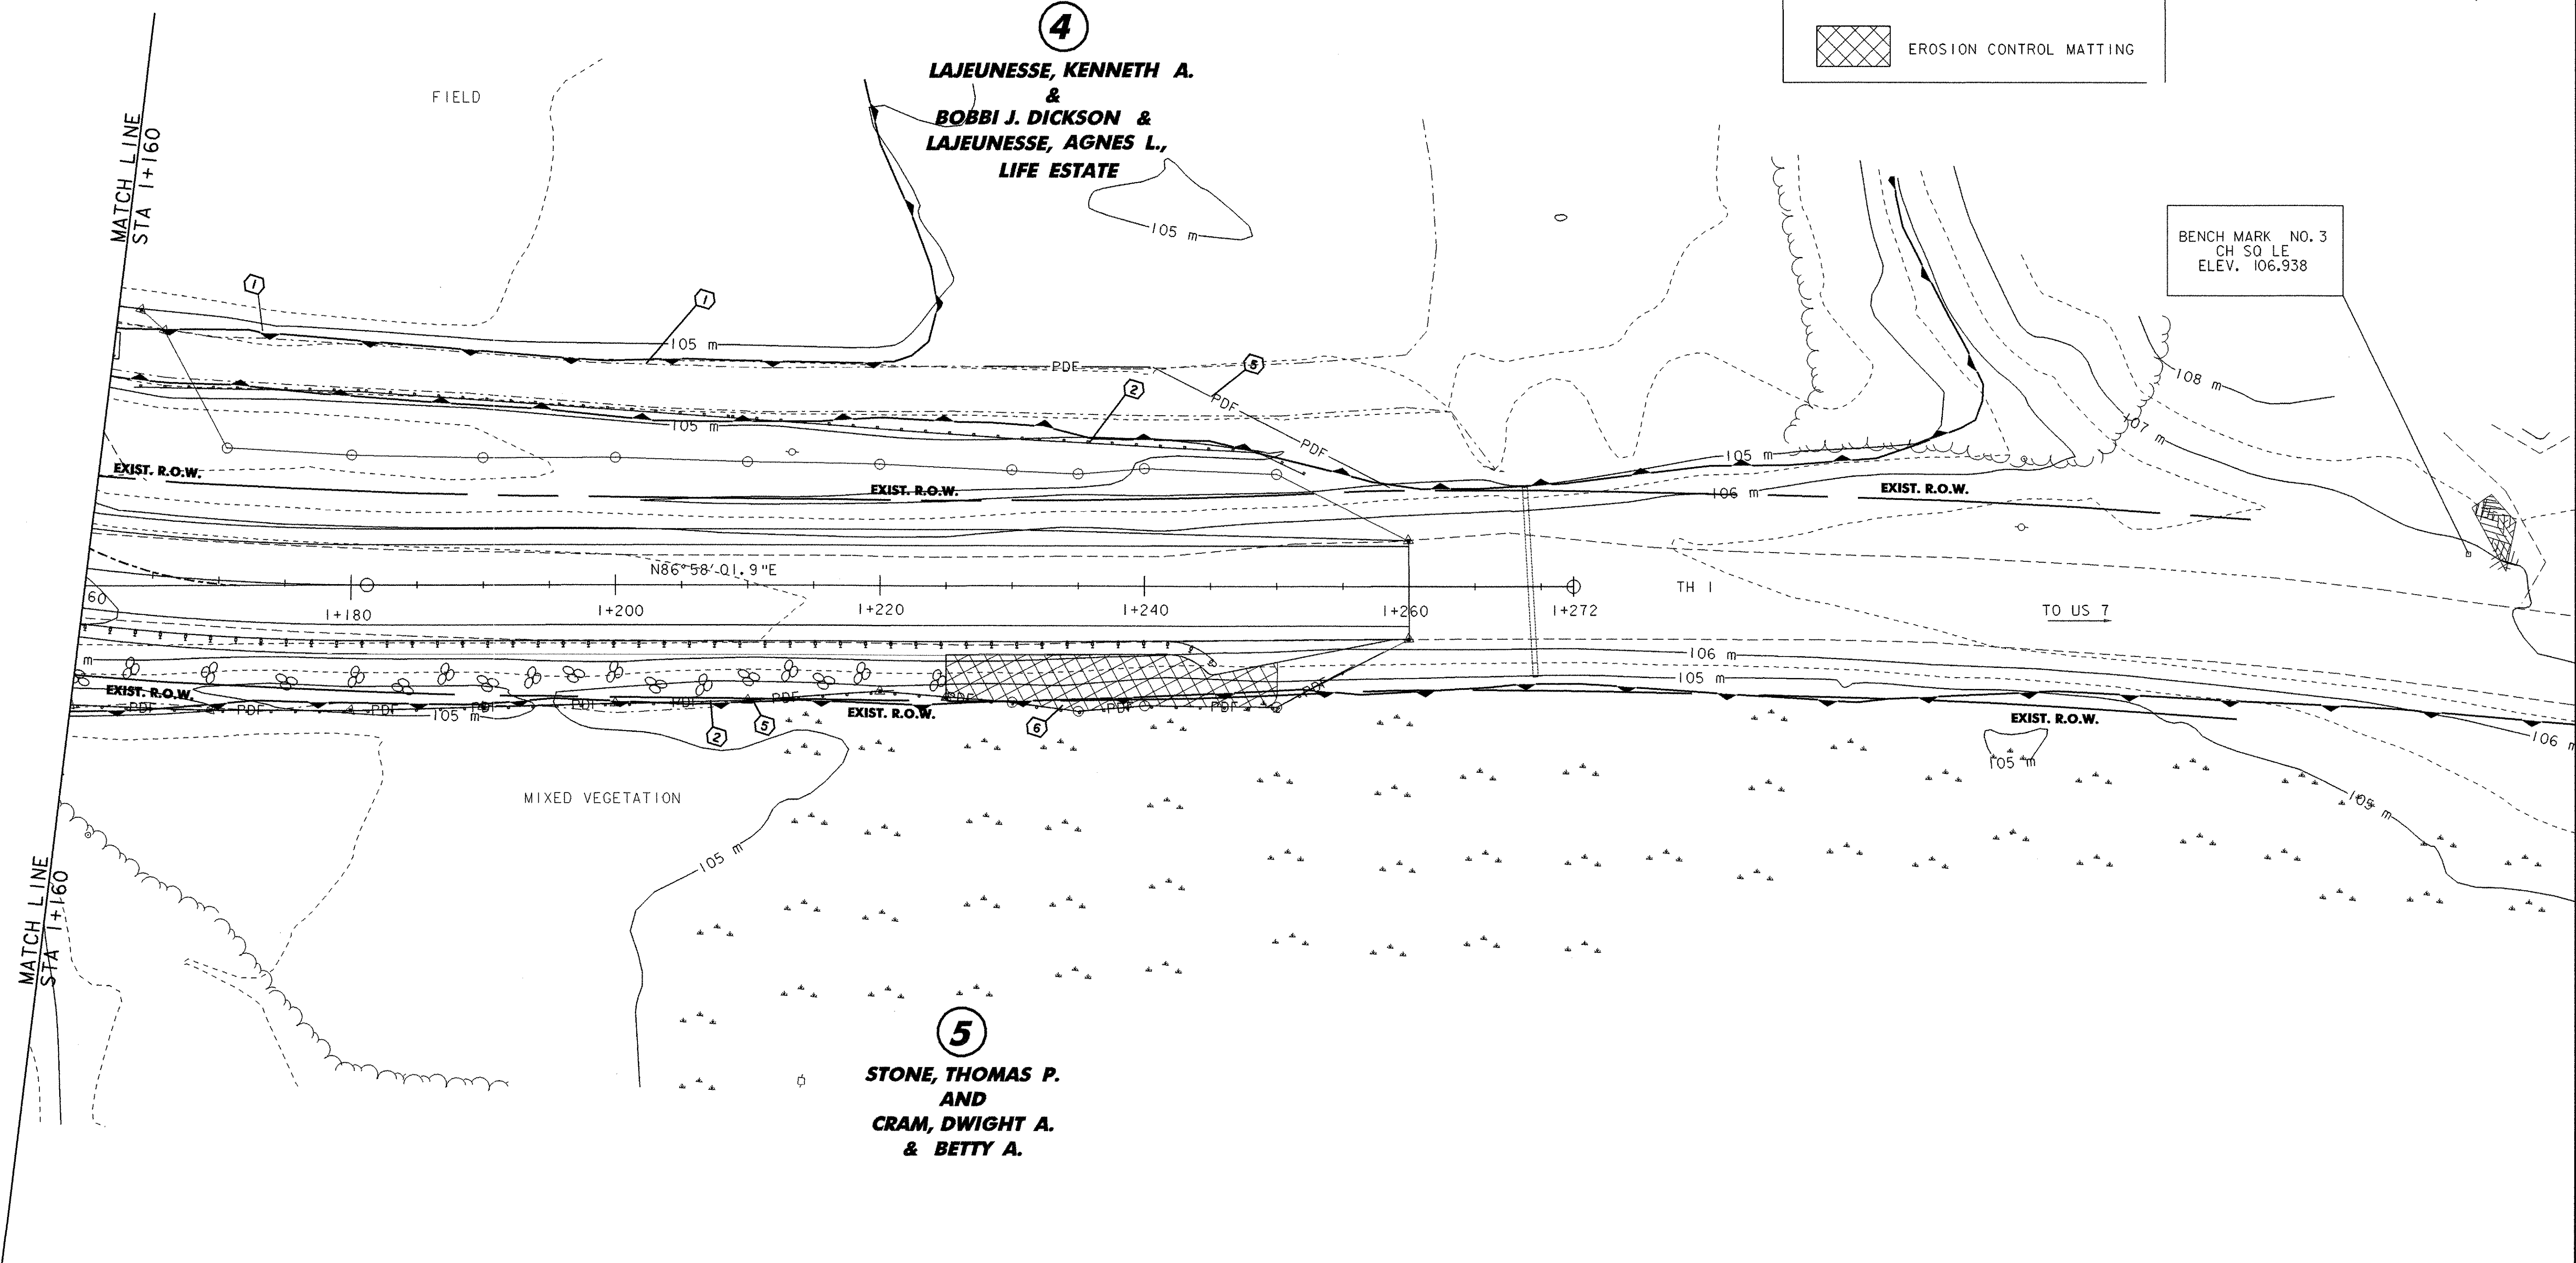


4
LAJEUNESSE, KENNETH A.
&
BOBBI J. DICKSON &
LAJEUNESSE, AGNES L.,
LIFE ESTATE

5
STONE, THOMAS P.
AND
CRAM, DWIGHT A.
& BETTY A.

BENCH MARK NO. 3
 CH SO LE
 ELEV. 106.938

DATUM	
VERTICAL	NAVD 88
HORIZONTAL	NAD 83/92
ADJUSTED	YES
TYPE	COMPASS

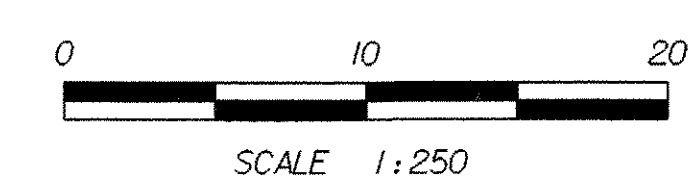


SHEET NAME: EROSION PREVENTION & SEDIMENT CONTROL PLAN #3		
PROJECT NAME: LEICESTER	HIGHWAY NO.: FAS 0160	
PROJECT NUMBER: BRF 0160(3)S	BRIDGE NO.: 6	
	OVER: OTTER CREEK	
FILE NAME: 95j288\structures\sj288bdr.dgn	PLOT DATE: 17-AUG-2005	
PROJECT MANAGER: R. R. WHITCOMB	DRAWN BY: STRI	
DESIGNED BY: C. CARLSON	IPARM NAME: sj288ero6.1	
BRIDGE SHEET NUMBER:	SHEET 27 OF 90	

NF
DEPOT FARM SUPPLY, INC.

1A
STATE OF VERMONT
JOINED BY
VERMONT RAILWAY, INC.



P/L

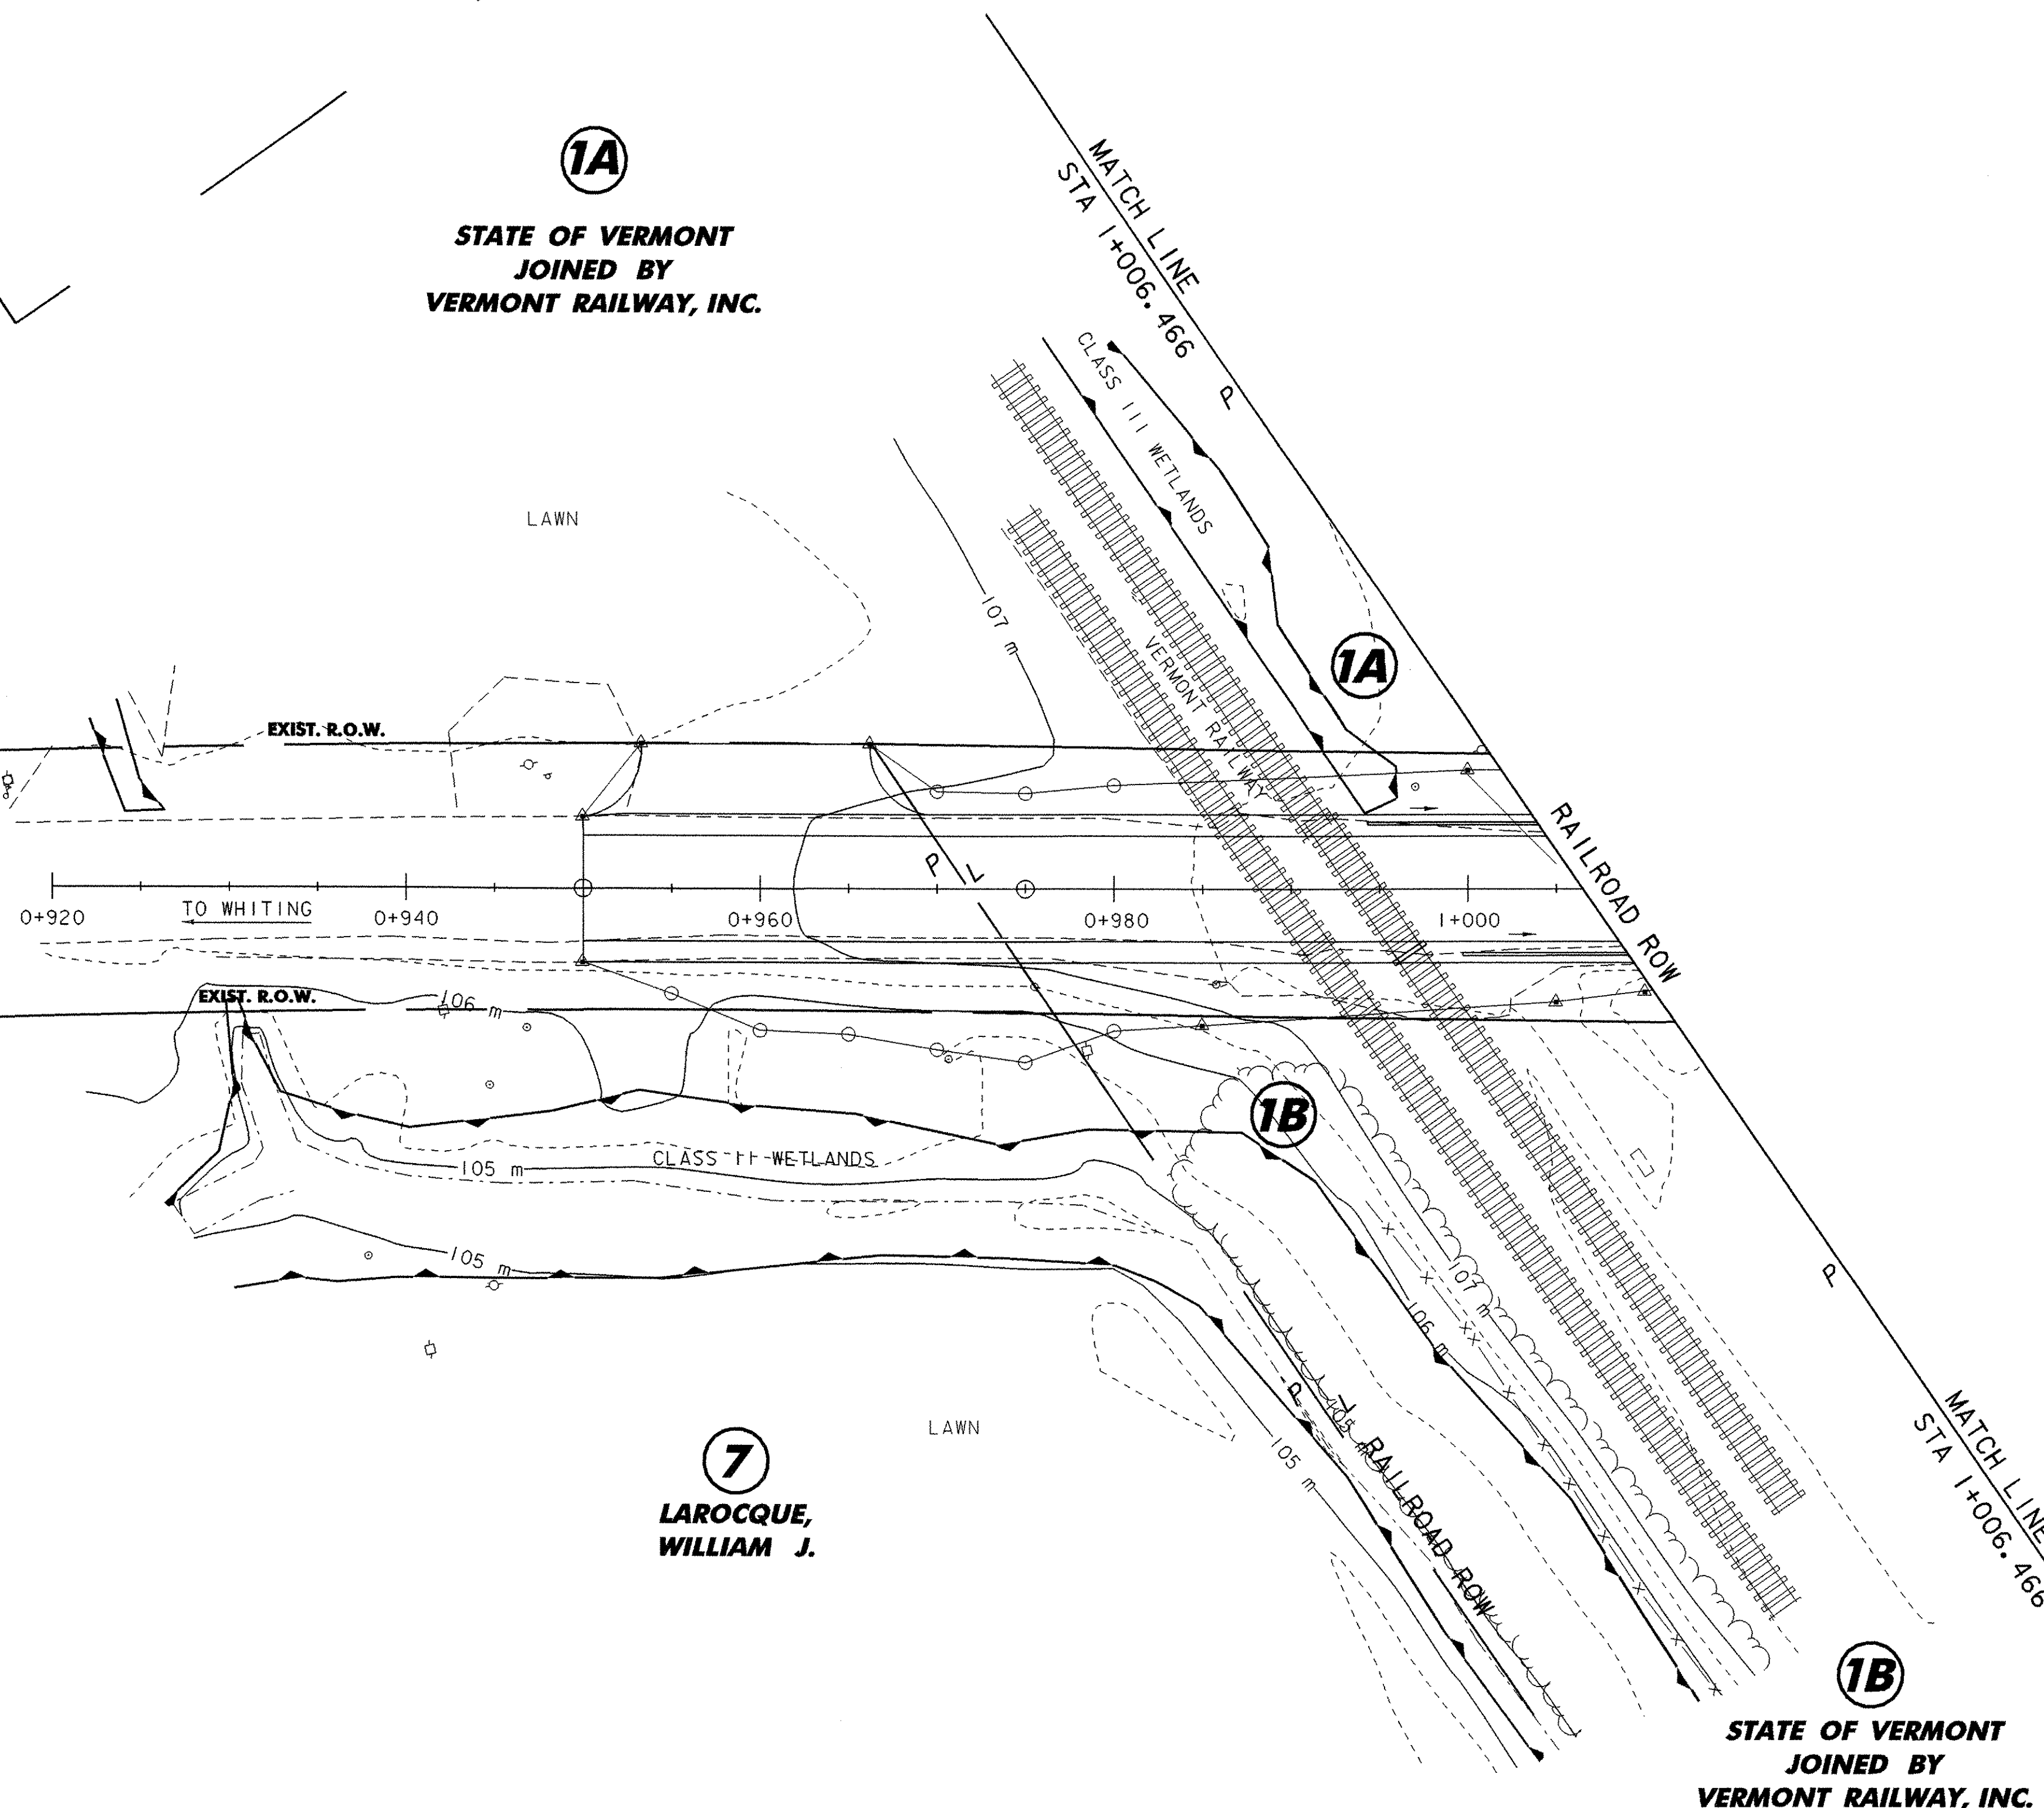


7
LAROCQUE,
WILLIAM J.


1B
STATE OF VERMONT
JOINED BY
VERMONT RAILWAY, INC.

NOTE:
CONTOURS SHOWN INDICATE THE EXISTING SITE.
SEE CROSS SECTION AND CHANNEL SECTION SHEETS
FOR GRADE CHANGES.

DATUM	
VERTICAL	NAVD 88
HORIZONTAL	NAD 83/92
ADJUSTED	YES
TYPE	COMPASS

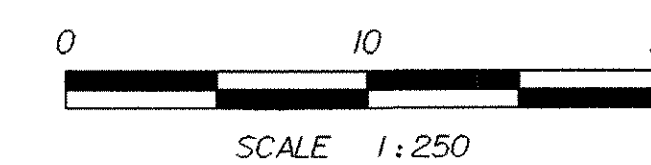

SHEET NAME: FINAL CONDITIONS SITE PLAN #1	
PROJECT NAME: LEICESTER	HIGHWAY NO.: FAS 0160
PROJECT NUMBER: BRF 0160(3)S	BRIDGE NO.: 6
	OVER: OTTER CREEK
FILE NAME: 95J288\Structures\sj288bdr.dgn	PLOT DATE: 17-AUG-2005
PROJECT MANAGER: R. R. WHITCOMB	DRAWN BY: STR1
DESIGNED BY: C. CARLSON	IPARM NAME: sj288ero7.i
BRIDGE SHEET NUMBER:	SHEET 28 OF 90

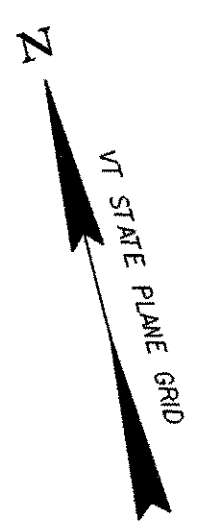


3
**FOX, CATLIN J. &
 CLAGHORN, ANNE W.
 JOINED BY VERMONT
 LAND TRUST, INC.**

2
**LAMOUREUX,
 LEO J. & ARLENE J.**

**LAJEUNESSE,
 KENNETH A. &
 BOBBI J. DICKSON &
 LAJEUNESSE,
 AGNES L.,
 LIFE ESTATE**

4

BENCH MARK NO. 2
 R.R. S.I.T.
 LARGE WILLOW
 ELEV. 106.097

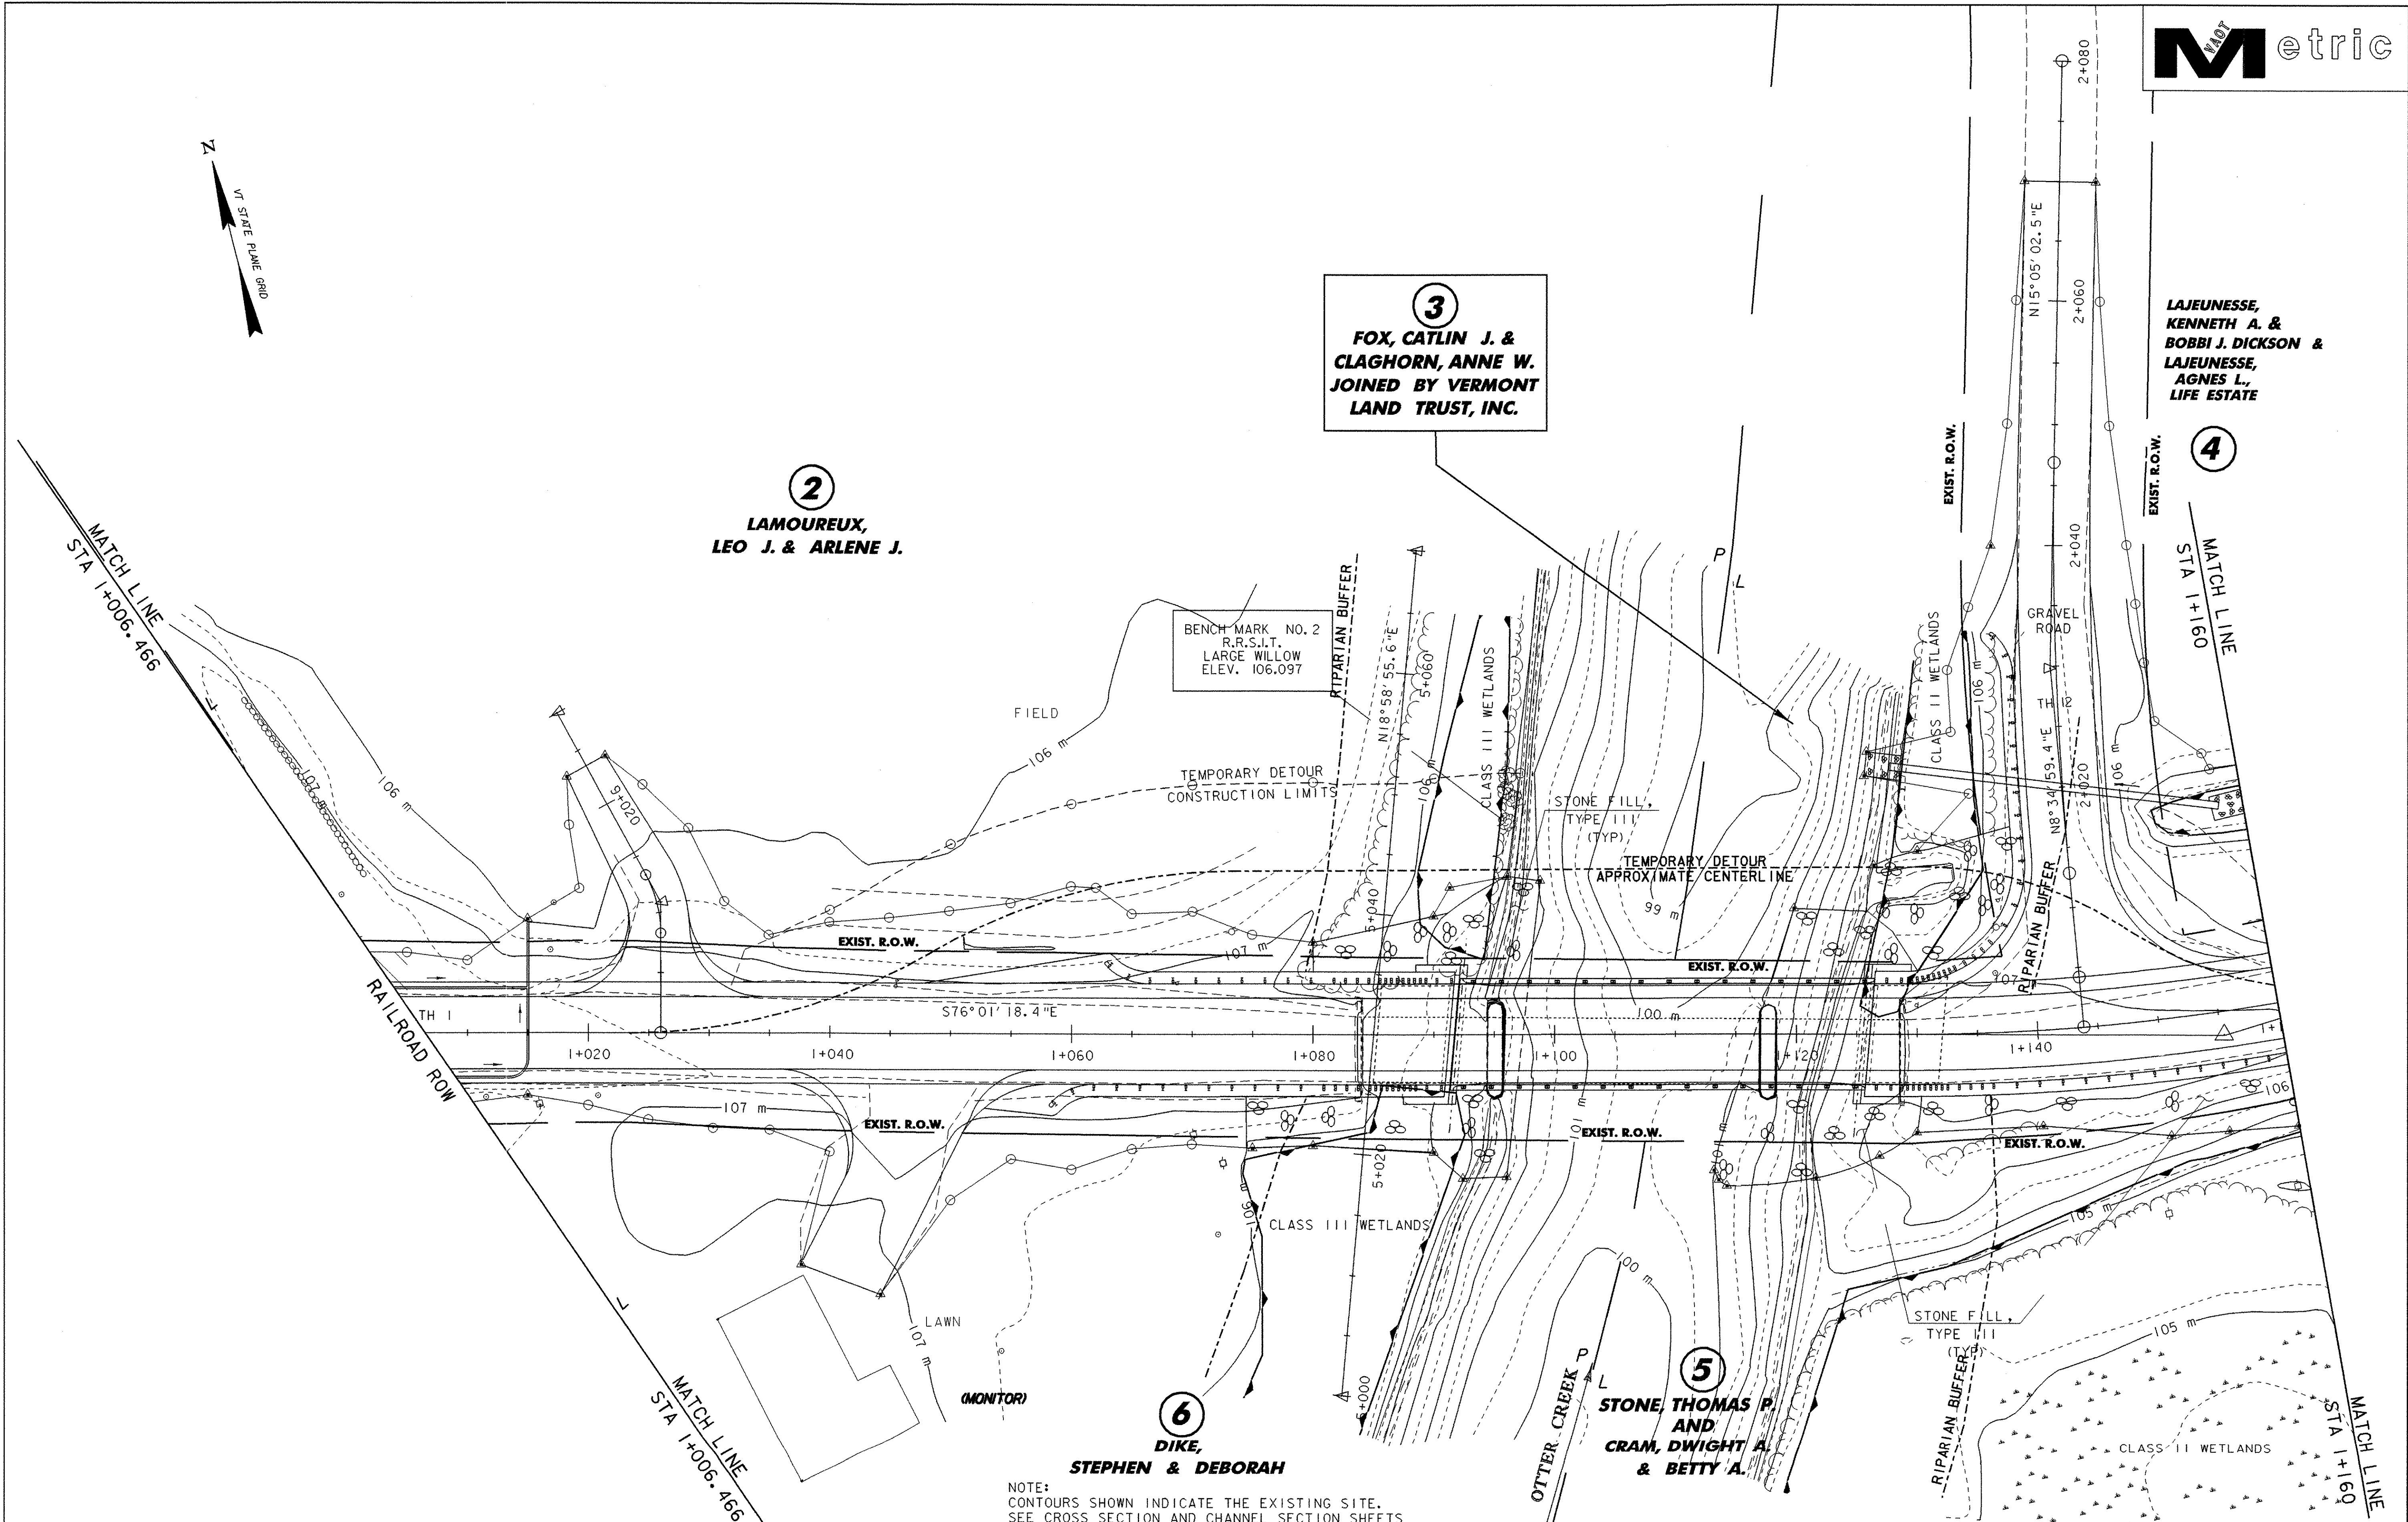


6
**DIKE,
 STEPHEN & DEBORAH**


5
**STONE, THOMAS P.
 AND
 CRAM, DWIGHT A.
 & BETTY A.**

NOTE:
 CONTOURS SHOWN INDICATE THE EXISTING SITE.
 SEE CROSS SECTION AND CHANNEL SECTION SHEETS
 FOR GRADE CHANGES.

DATUM	
VERTICAL	NAVD 88
HORIZONTAL	NAD 83/92
ADJUSTED	YES
TYPE	COMPASS

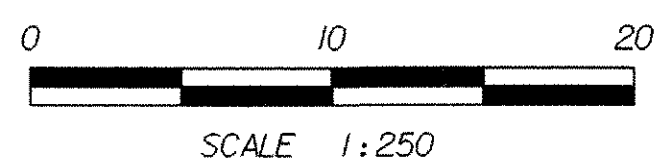


SHEET NAME: FINAL CONDITIONS SITE PLAN #2	
PROJECT NAME: LEICESTER	HIGHWAY NO.: FAS 0160
PROJECT NUMBER: BRF 0160(3)S	BRIDGE NO.: 6
	OVER: OTTER CREEK
FILE NAME: 95j288\Structures\sj288bdr.dgn	DATE: 17-AUG-2005
PROJECT MANAGER: R. R. WHITCOMB	DRAWN BY: STRI
DESIGNED BY: C. CARLSON	IPARM NAME: sj288ero8.1
BRIDGE SHEET NUMBER:	SHEET 29 OF 90

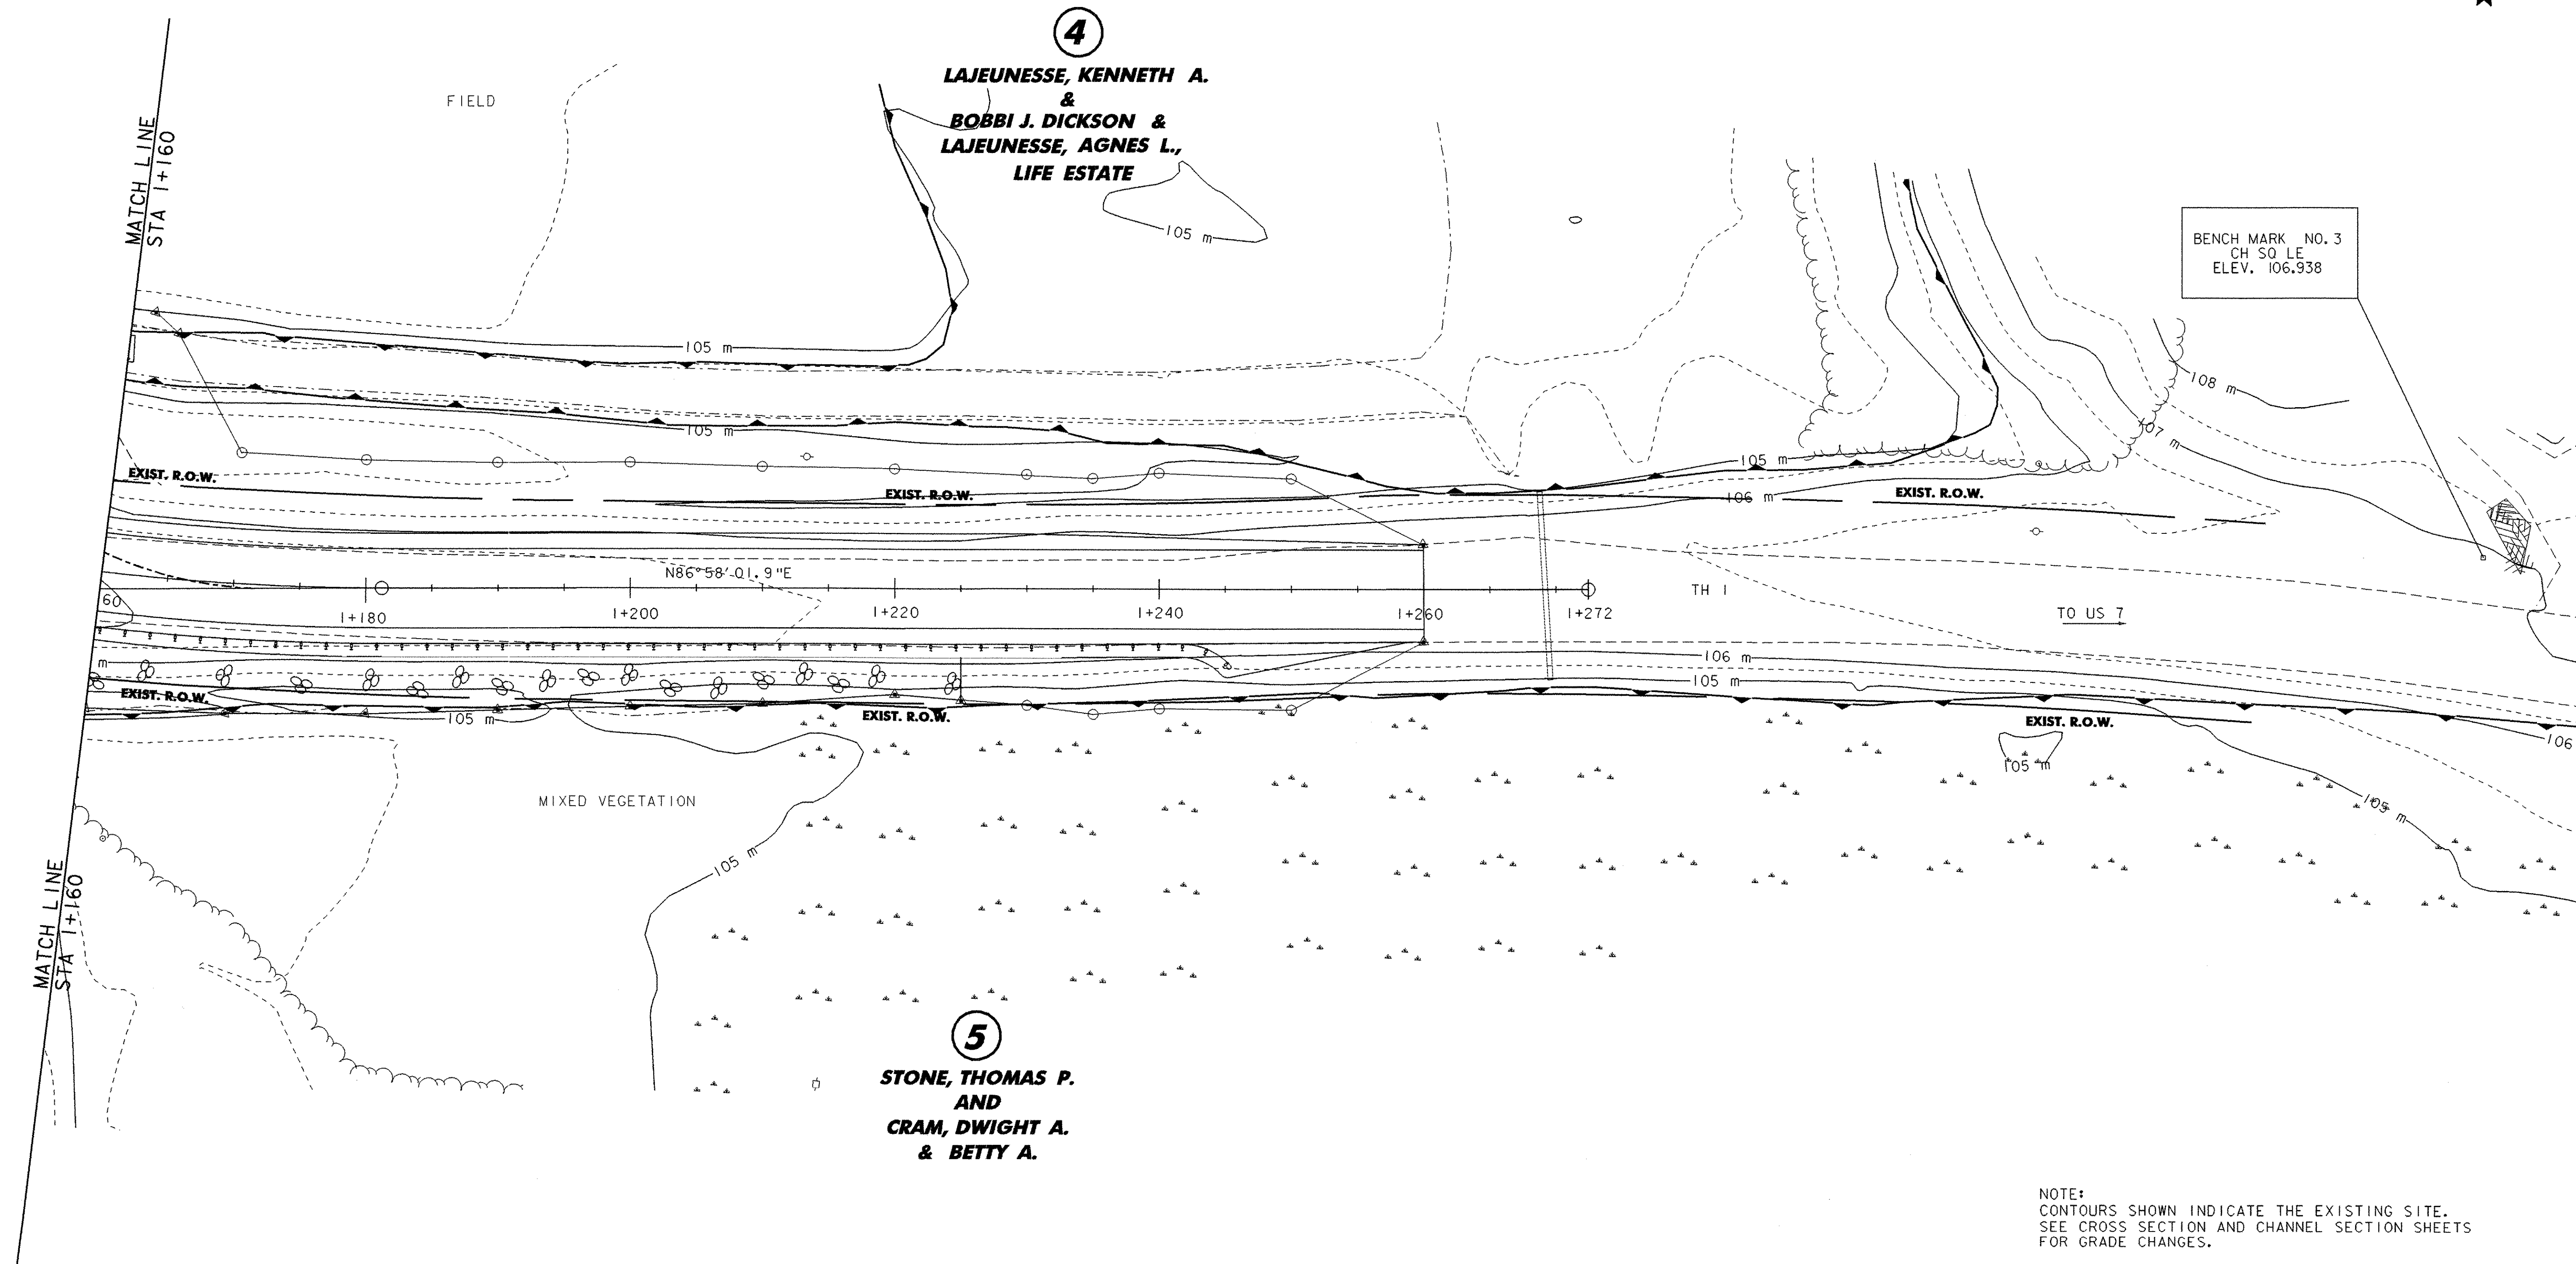

NOTE:
 CONTOURS SHOWN INDICATE THE EXISTING SITE.
 SEE CROSS SECTION AND CHANNEL SECTION SHEETS
 FOR GRADE CHANGES.

DATUM	
VERTICAL	NAVD 88
HORIZONTAL	NAD 83/92
ADJUSTED	YES
TYPE	COMPASS

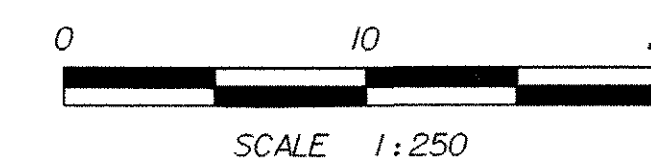

SHEET NAME: FINAL CONDITIONS SITE PLAN #3	
PROJECT NAME: LEICESTER	HIGHWAY NO.: FAS 0160
PROJECT NUMBER: BRF 0160(3)S	BRIDGE NO.: 6
	OVER: OTTER CREEK
FILE NAME: 95J288\Structures\sj288bdr.dgn	PLOT DATE: 17-AUG-2005
PROJECT MANAGER: R. R. WHITCOMB	DRAWN BY: STRI
DESIGNED BY: C. CARLSON	IPARM NAME: sj288ero9.1
BRIDGE SHEET NUMBER:	SHEET 30 OF 90

SILT FENCE

APPLICATION NOTES:


- A. THE PRIMARY PURPOSE OF SILT FENCE IS TO REDUCE RUNOFF VELOCITY AND TRAP SEDIMENT. VELOCITY IS REDUCED, WATER IS IMPOUNDED BEHIND THE MEASURE, AND SEDIMENT FALLS OUT OF SUSPENSION.
- B. SILT FENCE SHALL BE INSTALLED ON A LINE OF EQUAL ELEVATION (CONTOUR). IT MAY BE INSTALLED AT INTERMEDIATE POINTS UP SLOPES AS WELL AS AT THE BOTTOM, AS SHOWN IN THE DETAIL.
- C. SILT FENCE SHALL NOT BE USED ACROSS CONCENTRATED FLOW.

GENERAL NOTES:

1. SILT FENCE SHALL GENERALLY BE PLACED A MINIMUM OF 1.5 m BEYOND TOE OF SLOPE, 3 m PREFERRED, TO PROVIDE ADEQUATE AREA FOR SEDIMENT STORAGE AND FACILITATE MAINTENANCE OF SEDIMENT CONTAINMENT AREA.
2. ALL ENDS SHALL BE "J" HOOKED TO TRAP SEDIMENT.
3. IN AREAS WITH TWO SLOPES, SILT FENCE SHALL BE USED TO ERECT A DAM AND TRAP SEDIMENT AT THE BASE OF THE STEEPER SLOPE.
4. THE BOTTOM EDGE OF SILT FENCE SHALL BE BURIED A MINIMUM OF 150 mm BELOW GROUND, AND KEYED IN 100 mm. THE FENCE SHALL BE INSTALLED WITH THE POSTS ON THE DOWNSTREAM SIDE OF THE FABRIC.
5. MAXIMUM DRAINAGE AREA TRIBUTARY TO 30 m OF SILT FENCE SHALL BE 0.1 Ha.
6. THE FOLLOWING ARE MAXIMUM SLOPE LENGTHS FOR THESE MEASURES:


CONSTRUCTED SLOPE	SLOPE LENGTH (LS) m	HORIZONTAL LENGTH (LH) m
3 : 1	25	24
4 : 1	40	39
5 : 1	60	60
> 5 : 1	80	80

7. MEASURES SHALL BE INSPECTED EVERY SEVEN (7) CALENDAR DAYS AND WITHIN 24 HOURS OF A STORM EVENT GREAT ENOUGH TO CAUSE WATER TO LEAVE THE CONSTRUCTION SITE.
8. MEASURES SHALL BE CLEANED AND REPAIRED AS NEEDED. SEDIMENT SHALL BE REMOVED WHEN ACCUMULATION REACHES ONE-HALF OF THE MEASURE HEIGHT. SEDIMENT SHALL BE DISPOSED OF AS UNSUITABLE MATERIAL.
9. SILT FENCE SHALL BE REMOVED WHEN THE AREA HAS BEEN STABILIZED. AT TIME OF REMOVAL OF THE SILT FENCE, THE DISTURBED AREA SHALL BE REPAIRED AND STABILIZED.
10. PAYMENT FOR INSTALLATION AND REMOVAL OF SILT FENCE SHALL BE MADE UNDER THE GEOTEXTILE FOR SILT FENCE ITEM.
11. PAYMENT FOR MONITORING SILT FENCE SHALL BE MADE UNDER THE MONITORING EROSION PREVENTION & SEDIMENT CONTROL PLAN ITEM.
12. PAYMENT FOR MAINTAINING SILT FENCE SHALL BE MADE UNDER THE MAINTENANCE OF EROSION PREVENTION & SEDIMENT CONTROL PLAN ITEM, UNLESS MAINTENANCE IS REQUIRED DUE TO POOR INSTALLATION PRACTICES.

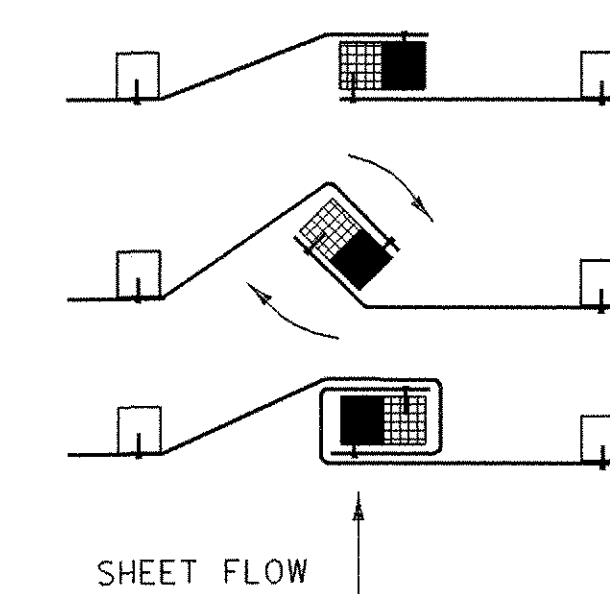


1. PLACE THE END POST OF ONE FENCE INSIDE THE END POST OF THE OTHER FENCE.
2. ROTATE BOTH POSTS AT LEAST 180 DEGREES IN A CLOCKWISE DIRECTION TO CREATE A TIGHT SEAL WITH THE FABRIC MATERIAL.
3. DRIVE BOTH POSTS 18 INCHES INTO THE GROUND AND BURY THE FLAP IN THE TRENCH.

SPLICING DETAIL

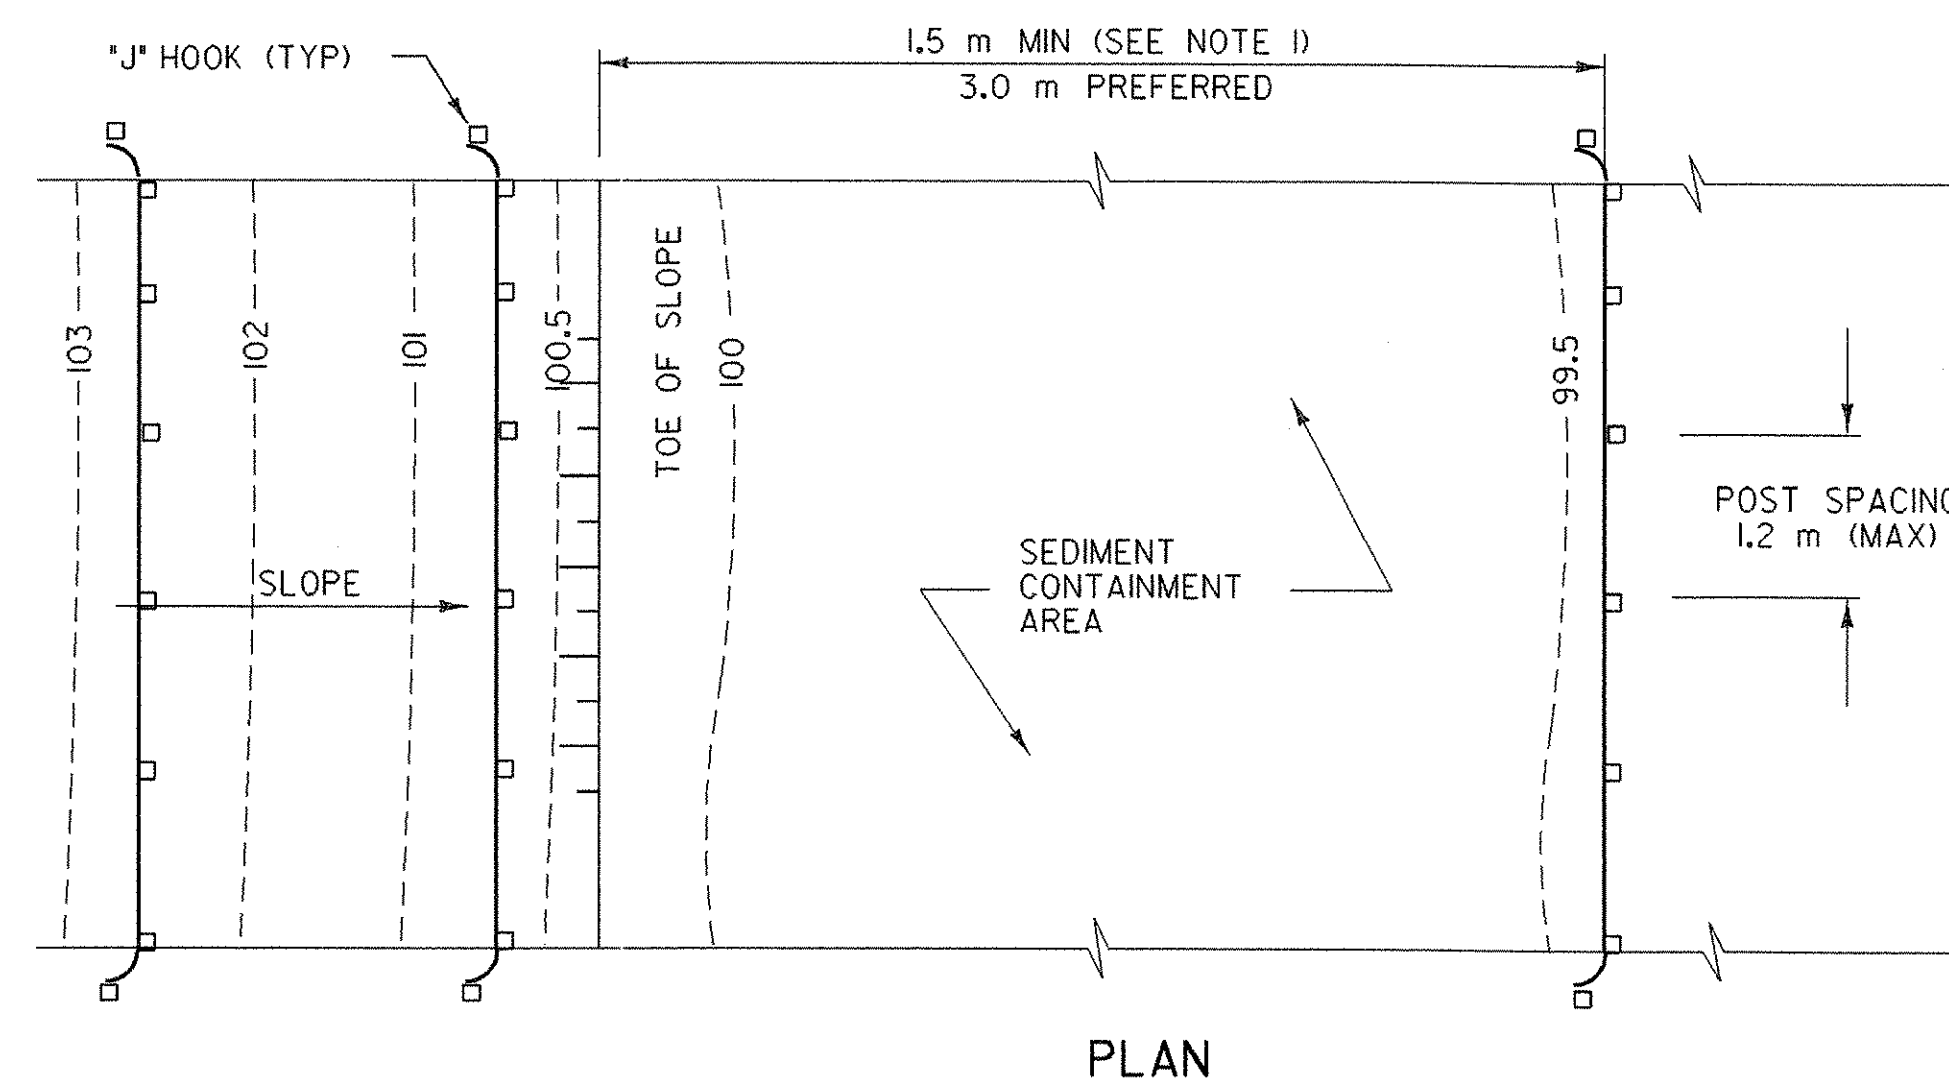

PLAN

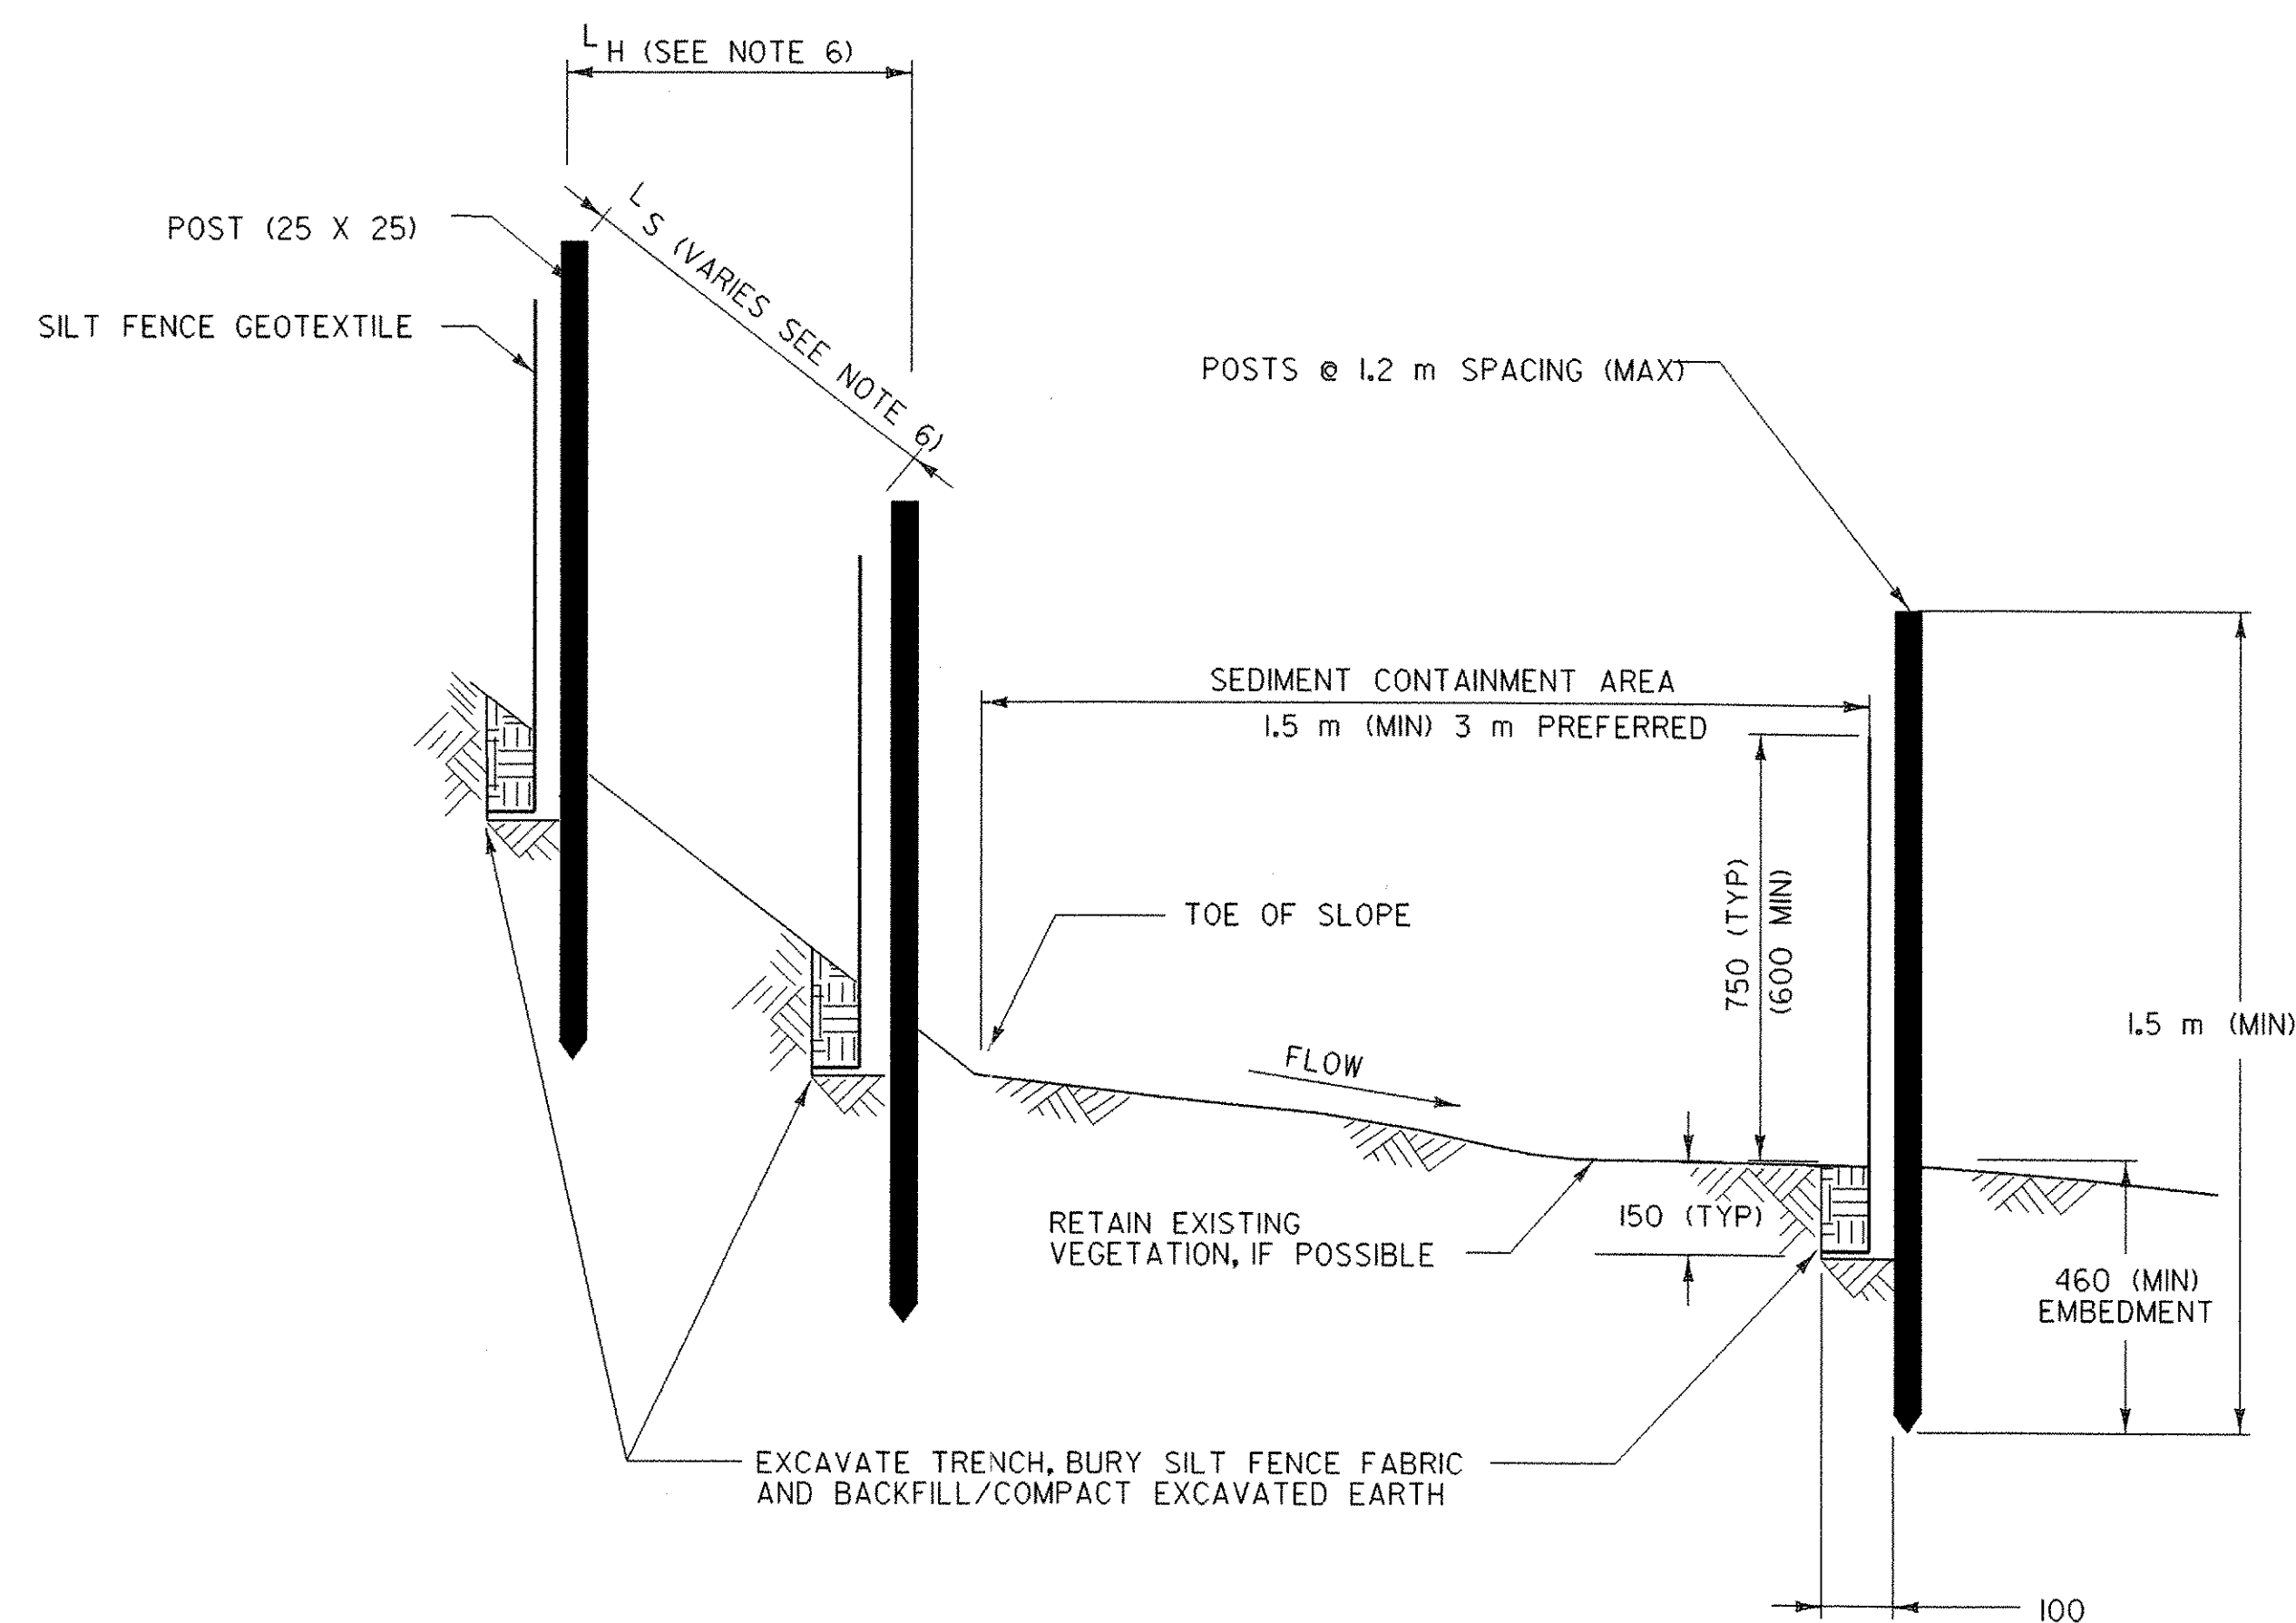

SECTION
SILT FENCE - TEMPORARY

EROSION CONTROL DETAILS SILT FENCE		
SHEET NAME:		
PROJECT NAME:	LEICESTER	HIGHWAY NO.: FAS 0160
PROJECT NUMBER:	BRF 0160(3)S	BRIDGE NO.: 6
		OVER: OTTER CREEK
FILE NAME:	95j288\structures\sj288ecd.dgn	
PROJECT MANAGER:	R. R. WHITCOMB	PLOT DATE: 17-AUG-2005
DESIGNED BY:	C. CARLSON	DRAWN BY: VAOT
BRIDGE SHEET NUMBER:		IPARM NAME: sj288ecd.1
		SHEET 31 OF 90




CHECK DAMS

APPLICATION NOTES:

- THE PRIMARY PURPOSE OF A CHECK DAM IS TO REDUCE EROSION IN A CHANNEL BY REDUCING FLOW VELOCITY.
- CHECK DAMS WILL CAPTURE SEDIMENT THAT FALLS OUT OF SUSPENSION BEHIND THE CHECK DAM DUE TO DECREASED VELOCITY.
- CHECK DAMS ARE NOT INTENDED TO FILTER SEDIMENT FROM TURBID WATER.
- DETAILS SHOWN SHALL BE USED FOR TEMPORARY INSTALLATION ONLY.
- PREFABRICATED DAMS ARE NOT TO BE USED ON SLOPES GREATER THAN 5% OR PER MANUFACTURER'S SPECIFICATIONS.
- PREFABRICATED DAM SPECIFICATIONS SHALL BE PROVIDED TO THE ENGINEER FOR APPROVAL PRIOR TO USE.

GENERAL NOTES:





- GEOTEXTILE SHALL BE INSTALLED UNDER STONE FILL. IT SHALL BE KEYED IN ON THE UP HILL END AND SHALL EXTEND 0.6 m BEYOND THE STONE ON THE DOWN HILL END.
- CORE MATERIAL FOR THE STONE CHECK DAM SHALL MEET THE GRADATION REQUIREMENTS OF STONE FILL TYPE I (MIN.). STONE SIZE SHOULD BE INCREASED WITH INCREASED SLOPE AND VELOCITY.
- THE UPHILL END OF THE APRON FOR THE PREFABRICATED CHECK DAM SHALL BE STAPLED AND BURIED AS SHOWN IN DETAIL "A" OR AS RECOMMENDED BY THE MANUFACTURER'S LITERATURE.
- MEASURES SHALL BE INSPECTED EVERY SEVEN (7) CALENDAR DAYS AND WITHIN 24 HOURS OF A STORM EVENT GREAT ENOUGH TO CAUSE WATER TO LEAVE THE CONSTRUCTION SITE.
- MEASURES SHALL BE CLEANED AND REPAIRED AS NEEDED. SEDIMENT SHALL BE REMOVED WHEN ACCUMULATION REACHES ONE-HALF OF THE MEASURE HEIGHT. SEDIMENT SHALL BE DISPOSED OF AS UNSUITABLE MATERIAL.
- AT TIME OF REMOVAL OF THE CHECK DAMS, THE DISTURBED AREA SHALL BE REPAIRED AND STABILIZED.
- PAYMENT FOR INSTALLATION AND REMOVAL OF CHECK DAMS SHALL BE MADE UNDER APPLICABLE ITEMS INCLUDED IN THE CONTRACT PLANS OR UNDER THE MAINTENANCE OF EROSION PREVENTION & SEDIMENT CONTROL PLAN ITEM.
- PAYMENT FOR MONITORING CHECK DAMS SHALL BE MADE UNDER THE MONITORING EROSION PREVENTION & SEDIMENT CONTROL PLAN ITEM.
- PAYMENT FOR MAINTAINING CHECK DAMS SHALL BE MADE UNDER THE MAINTENANCE OF EROSION PREVENTION & SEDIMENT CONTROL PLAN ITEM, UNLESS MAINTENANCE IS REQUIRED DUE TO POOR INSTALLATION PRACTICES.

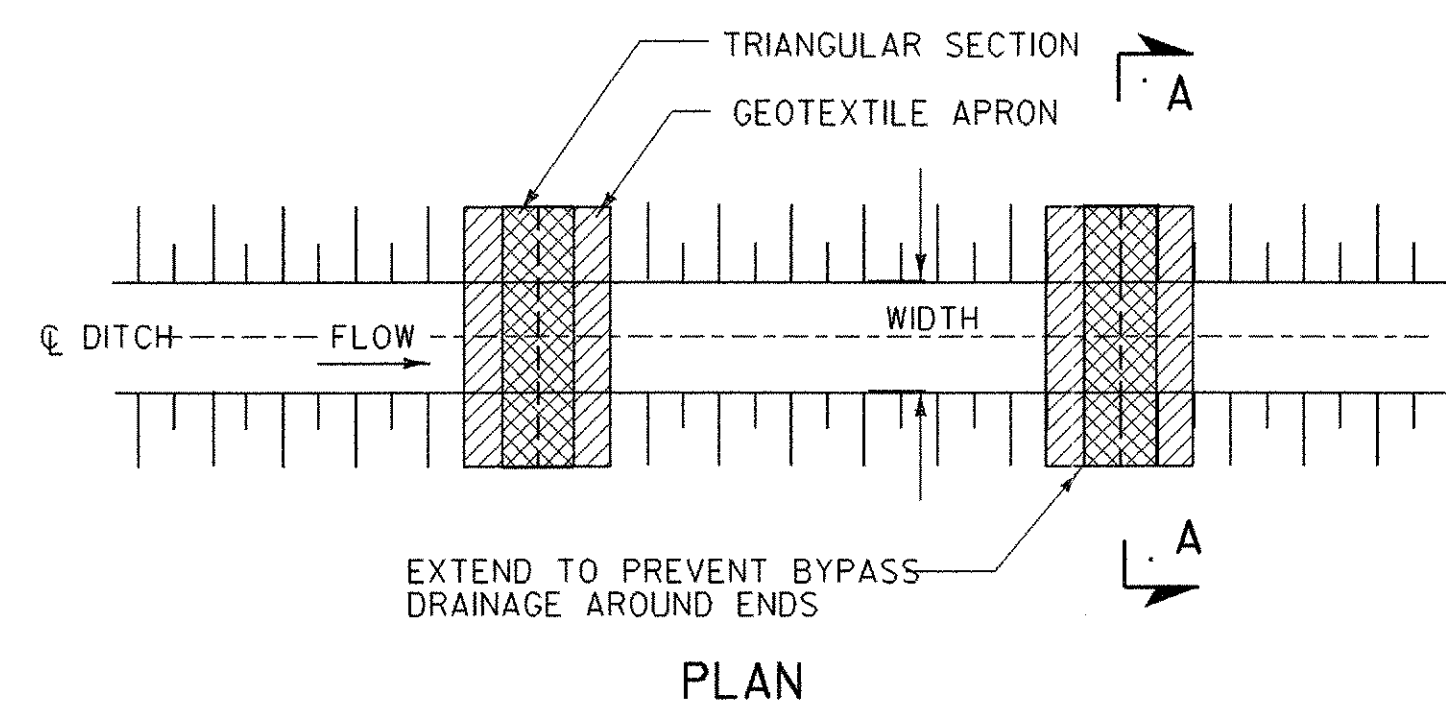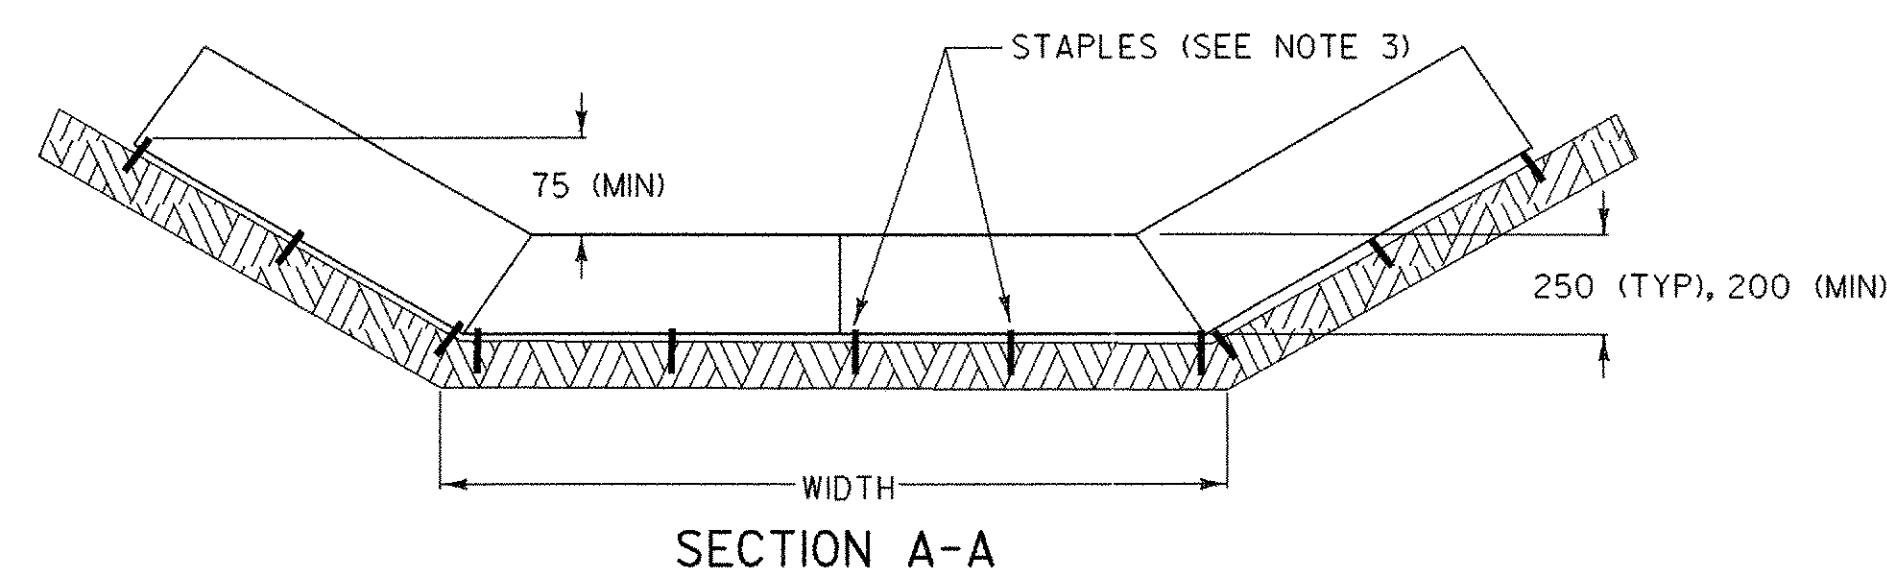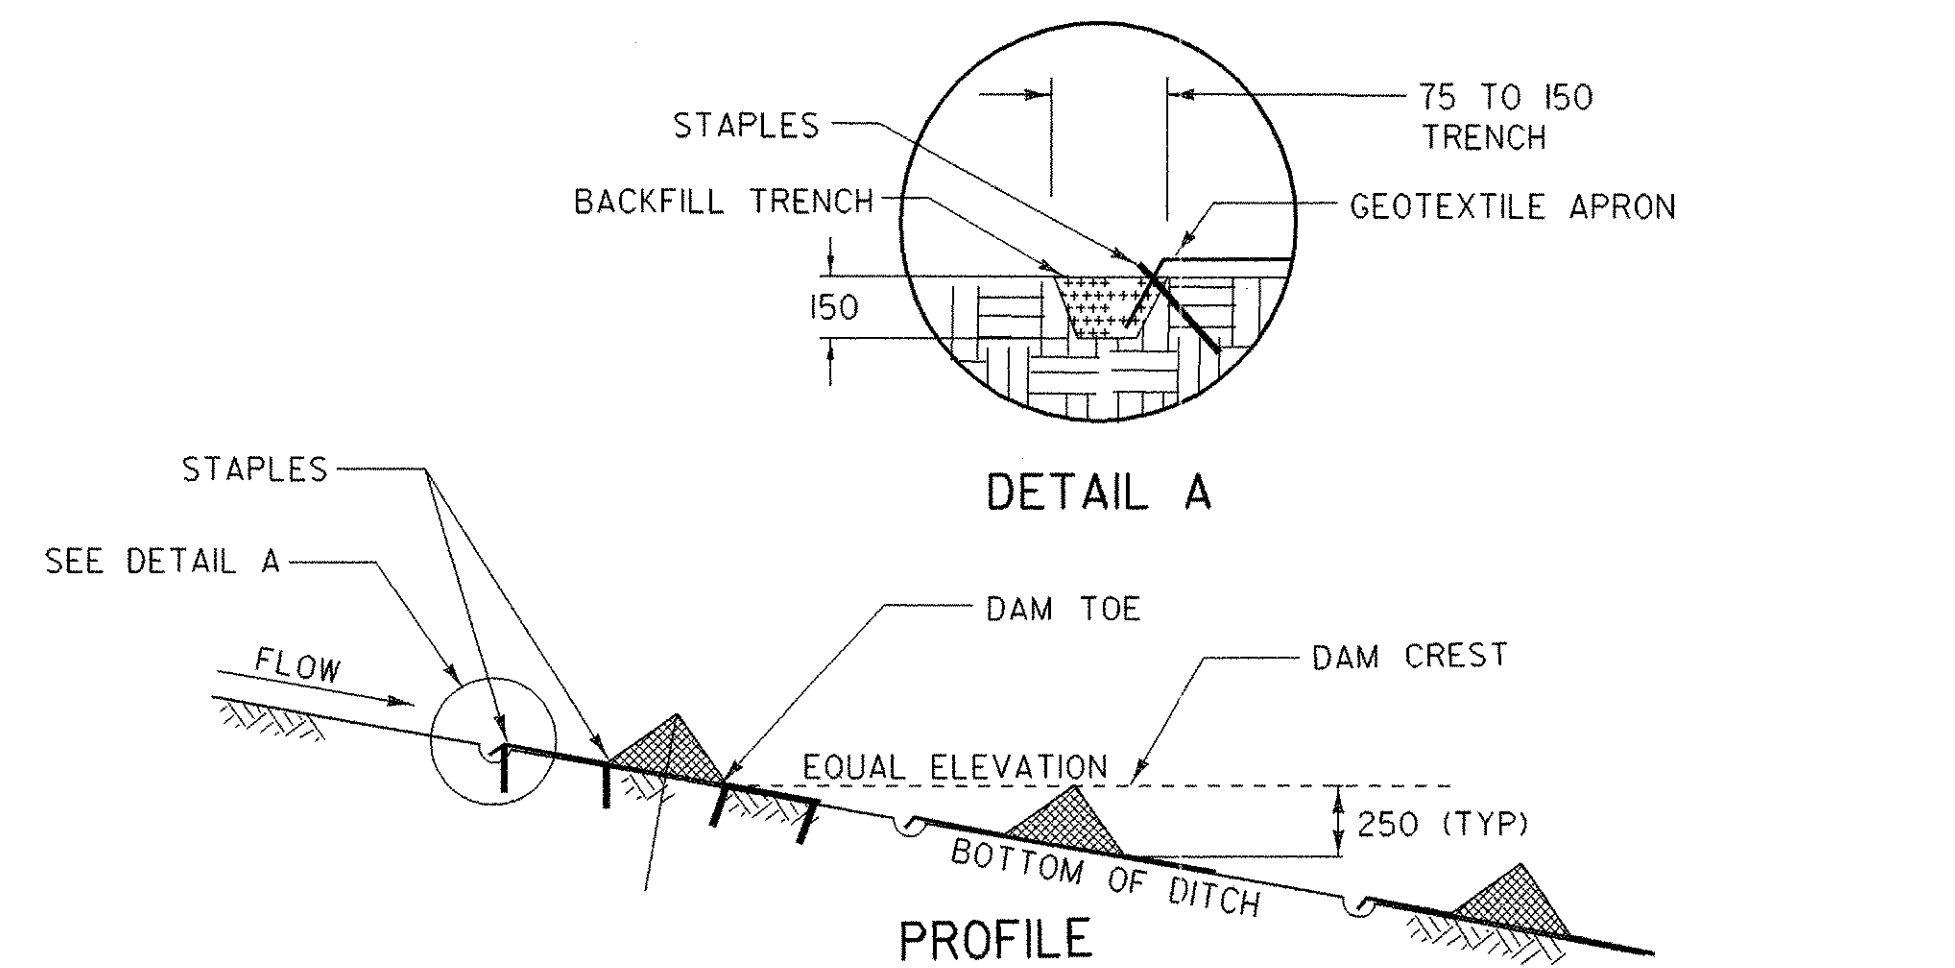

CHECK DAM - TEMPORARY (PREFABRICATED)

PREFABRICATED CHECK DAM PLACEMENT INTERVAL	
DITCH SLOPE	PLACEMENT INTERVAL **
1 ½	15 m
2 ½	12 m
3 ½	8 m
4 ½	6 m
5 ½	5 m

** BASED ON 0.25 m TYPICAL HEIGHT

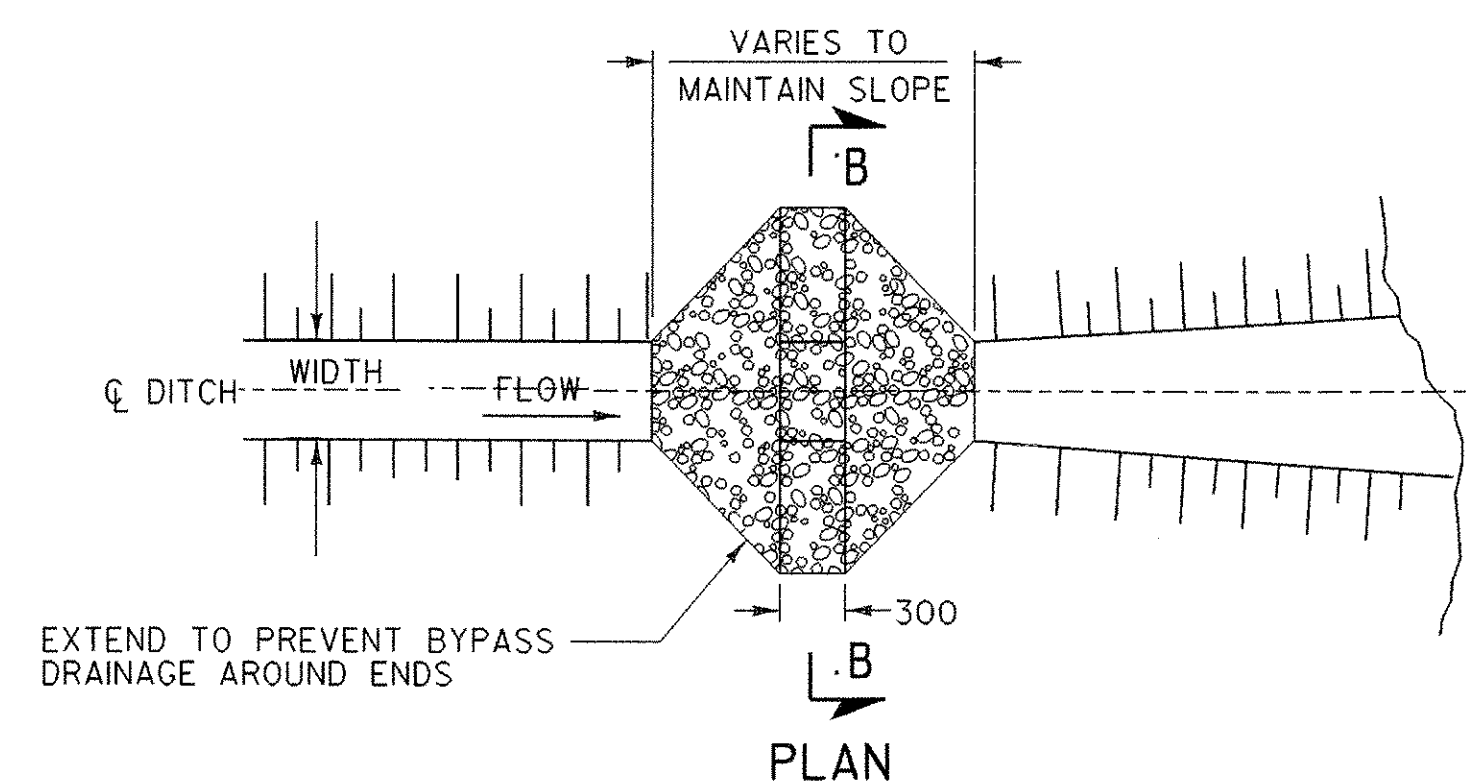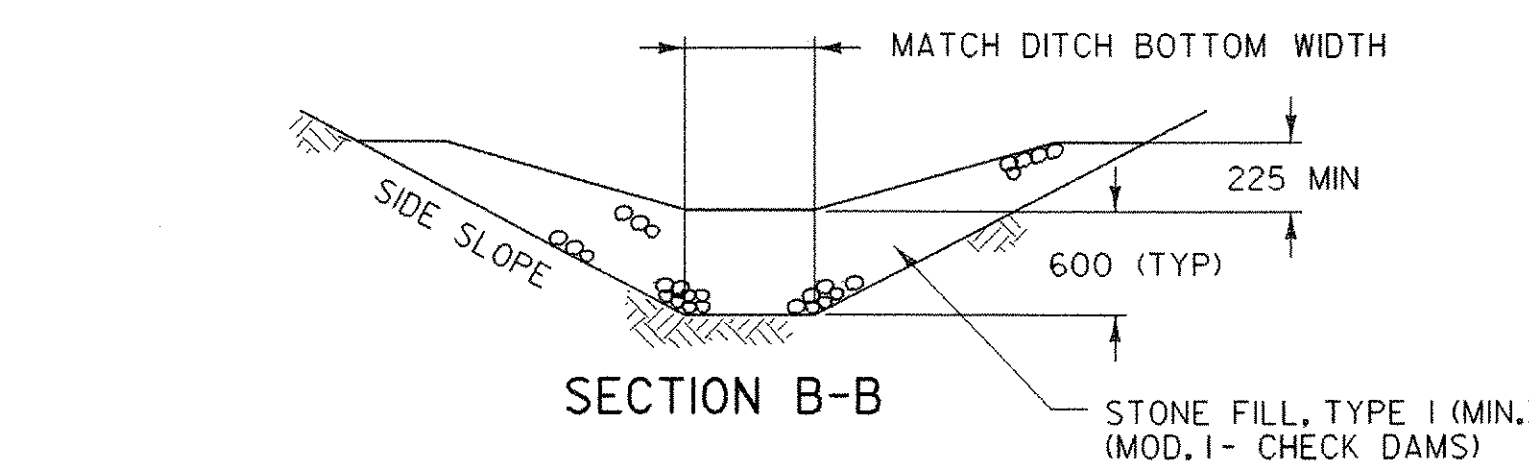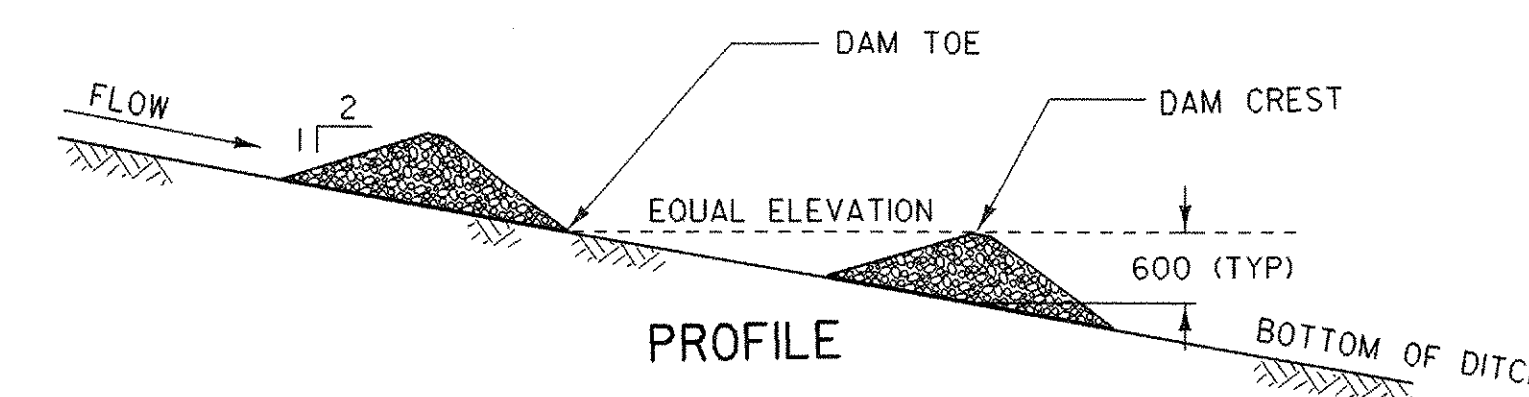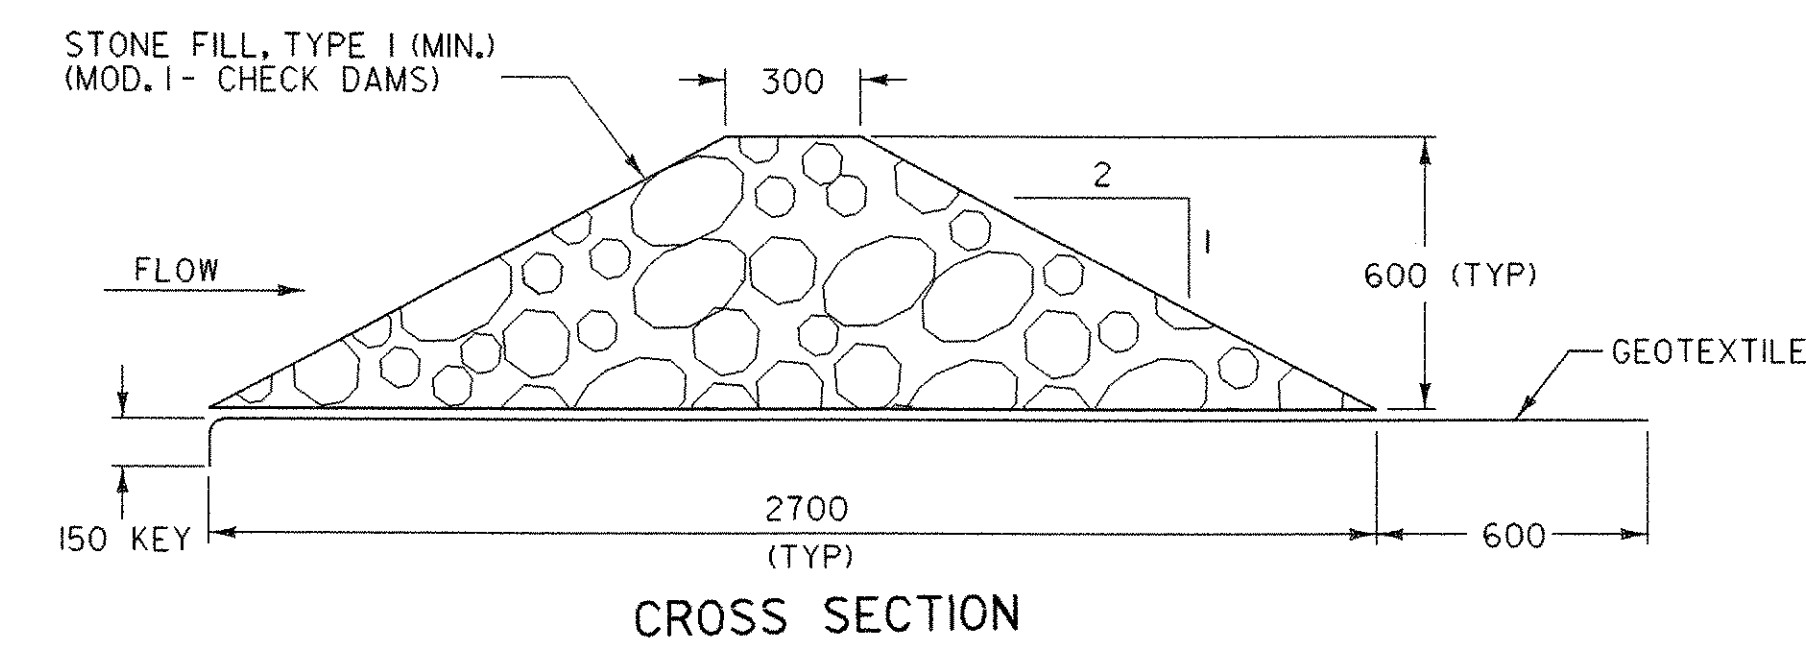


CHECK DAM - TEMPORARY (STONE)

STONE CHECK DAM PLACEMENT INTERVAL	
DITCH SLOPE	PLACEMENT INTERVAL **
1 ½	60 m
2 ½	30 m
3 ½	20 m
4 ½	15 m
5 ½	12 m
6 ½	10 m
8 ½	7.5 m
10 ½	6 m


** BASED ON 0.6 m TYPICAL HEIGHT

EROSION CONTROL DETAILS CHECK DAMS		
SHEET NAME:		
PROJECT NAME:	LEICESTER	HIGHWAY NO.: FAS 0160
PROJECT NUMBER:	BRF 0160(3)S	BRIDGE NO.: 6
		OVER: OTTER CREEK
FILE NAME:	95j288\Structures\sj288ecd.dgn	PLOT DATE: 17-AUG-2005
PROJECT MANAGER:	R. R. WHITCOMB	DRAWN BY: VAOT
DESIGNED BY:	C. CARLSON	IPARM NAME: sj288ecd.1
BRIDGE SHEET NUMBER:		SHEET 32 OF 90

STABILIZED CONSTRUCTION ENTRANCE

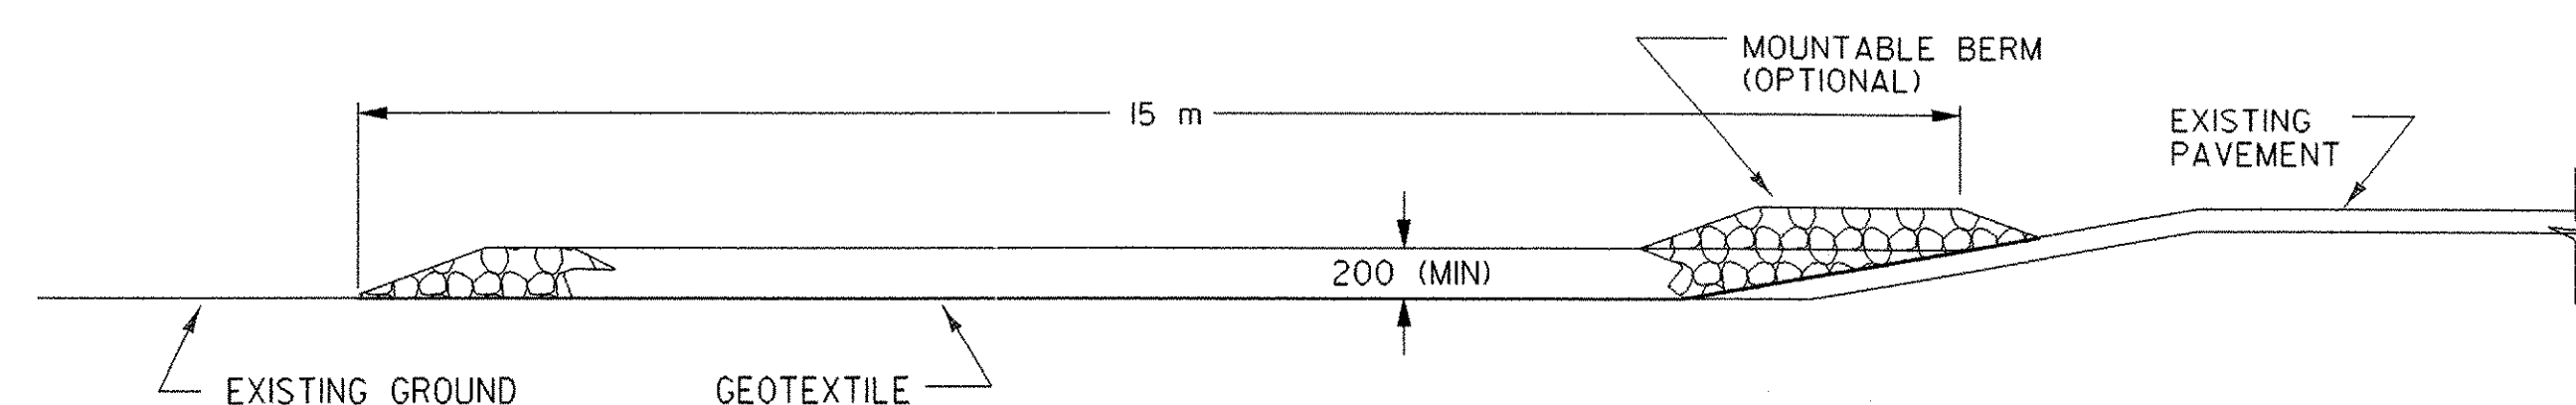

TYPICAL CONSTRUCTION ENTRANCE PROFILE
(CUT AND DITCH SECTIONS)

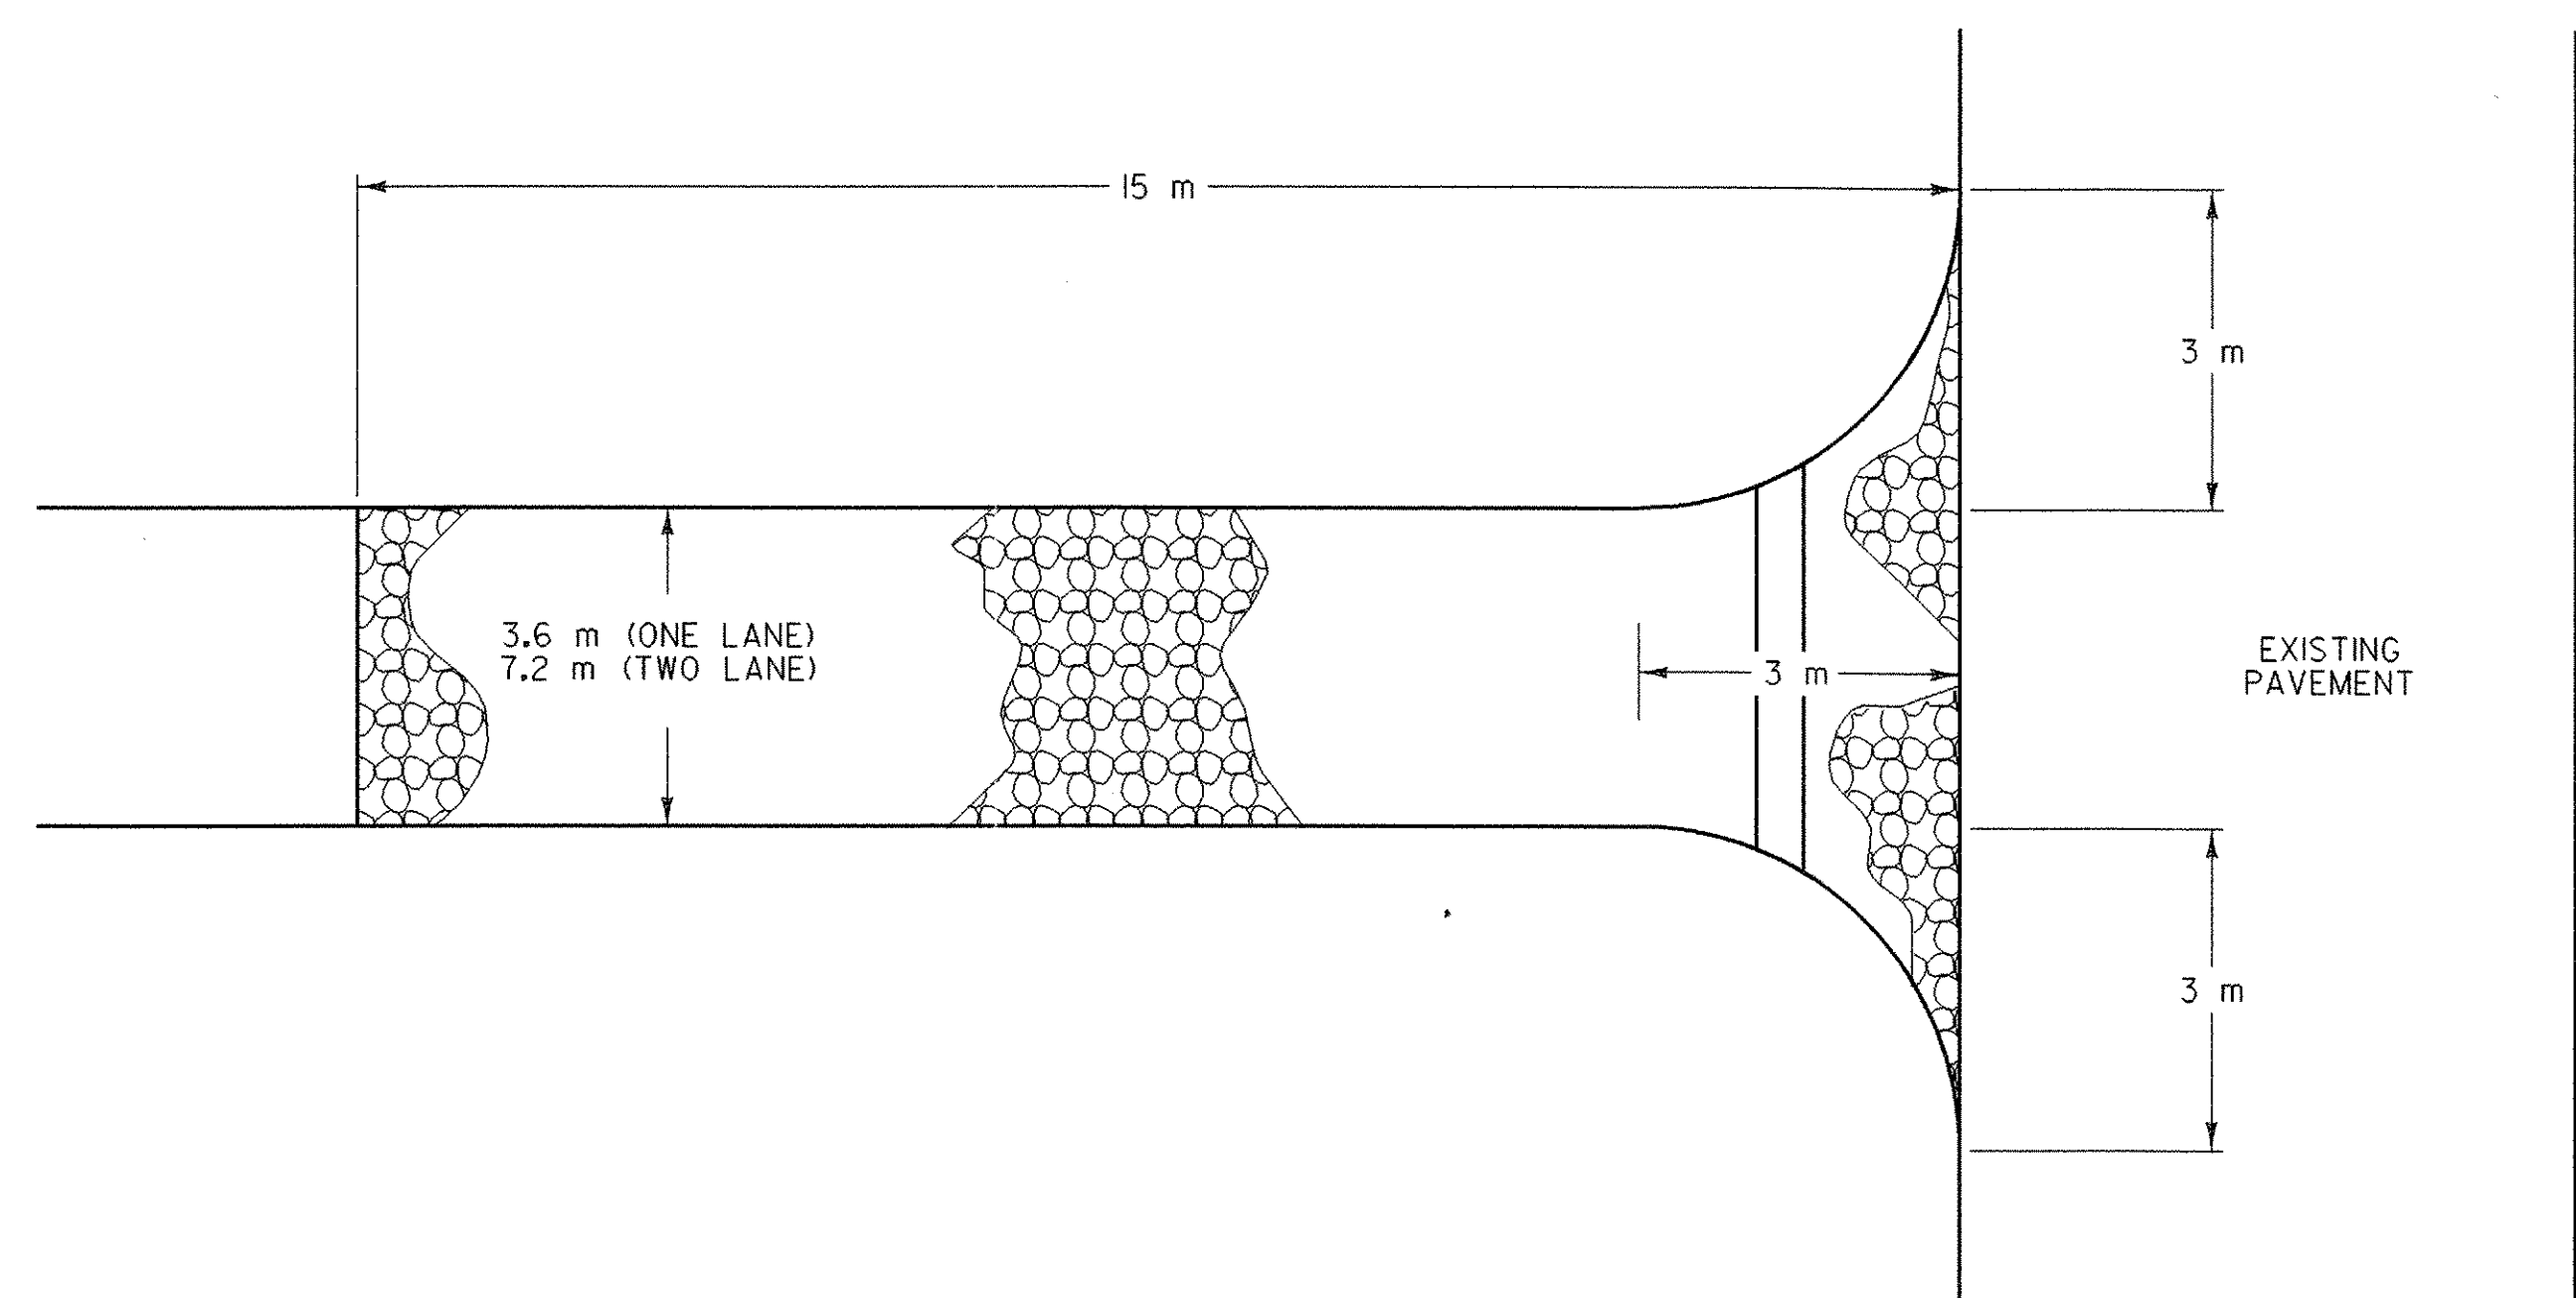


TYPICAL CONSTRUCTION ENTRANCE PLAN
(CUT/DITCH AND FILL SECTIONS)

APPLICATION NOTES:

A. THE PURPOSE OF A STABILIZED CONSTRUCTION ENTRANCE IS TO REDUCE OR ELIMINATE THE TRACKING OF SEDIMENT ONTO PUBLIC RIGHTS OF WAY OR STREETS.



GENERAL NOTES:

1. STONE SIZE - USE CLEAN STONE WITH GRADATION BETWEEN 50 mm AND 100 mm.
2. LENGTH - 15 m (MIN)
3. THICKNESS - 200 mm (MIN)
4. WIDTH - 3.6 m (MIN)
5. GEOTEXTILE UNDER STONE WILL BE PLACED OVER THE ENTIRE AREA PRIOR TO PLACING OF STONE.
6. SURFACE WATER - ALL SURFACE WATER FLOWING OR DIVERTED TOWARD CONSTRUCTION ENTRANCES SHALL BE PIPED ACROSS THE ENTRANCE AS DIRECTED BY THE ENGINEER. IF PIPING IS IMPRACTICAL, A MOUNTABLE BERM WITH 5:1 SLOPES WILL BE PERMITTED.
7. PROPOSED DRAINAGE PIPES SHALL BE SIZED WITH SUFFICIENT CAPACITY TO CARRY DITCH FLOWS. ALTERNATIVE WAYS OF TRANSPORTING DITCH DRAINAGE ACROSS CONSTRUCTION ENTRANCES MAY BE PROPOSED BY THE CONTRACTOR FOR APPROVAL BY THE ENGINEER.
8. WHEN WASHING OF VEHICLE IS NECESSARY, IT SHALL BE DONE ON AN AREA STABILIZED WITH STONE WHICH DRAINS INTO AN APPROVED SEDIMENT TRAPPING DEVICE.
9. MEASURES SHALL BE INSPECTED EVERY SEVEN (7) CALENDAR DAYS AND WITHIN 24 HOURS OF A STORM EVENT GREAT ENOUGH TO CAUSE WATER TO LEAVE THE CONSTRUCTION SITE.
10. MAINTENANCE- THE ENTRANCE SHALL BE MAINTAINED IN A CONDITION WHICH WILL PREVENT TRACKING OR FLOWING OF SEDIMENT ONTO PUBLIC RIGHTS-OF-WAY. ALL SEDIMENT SPILLED, DROPPED, WASHED, OR TRACKED ONTO PUBLIC RIGHTS-OF-WAY MUST BE REMOVED IMMEDIATELY.
11. AT THE TIME OF REMOVAL OF THE STABILIZED CONSTRUCTION ENTRANCE THE DISTURBED AREA SHALL BE REPAIRED AND STABILIZED.
12. PAYMENT OF THE STABILIZED CONSTRUCTION ENTRANCE SHALL BE MADE UNDER APPLICABLE ITEMS INCLUDED IN THE CONTRACT PLANS OR UNDER THE MAINTENANCE OF EROSION PREVENTION & SEDIMENT CONTROL PLAN ITEM.
13. PAYMENT FOR MONITORING STABILIZED CONSTRUCTION ENTRANCES SHALL BE MADE UNDER THE MONITORING EROSION PREVENTION & SEDIMENT CONTROL PLAN ITEM.
14. PAYMENT FOR MAINTAINING STABILIZED CONSTRUCTION ENTRANCES SHALL BE MADE UNDER THE MAINTENANCE OF EROSION PREVENTION & SEDIMENT CONTROL PLAN ITEM, UNLESS MAINTENANCE IS REQUIRED DUE TO POOR INSTALLATION PRACTICES.
15. STONE FOR CONSTRUCTION ENTRANCE SHALL BE PAID FOR AS ITEM 613.10, "STONE FILL, TYPE 1 (MOD. 2 - STABILIZED CONSTRUCTION ENTRANCE)".

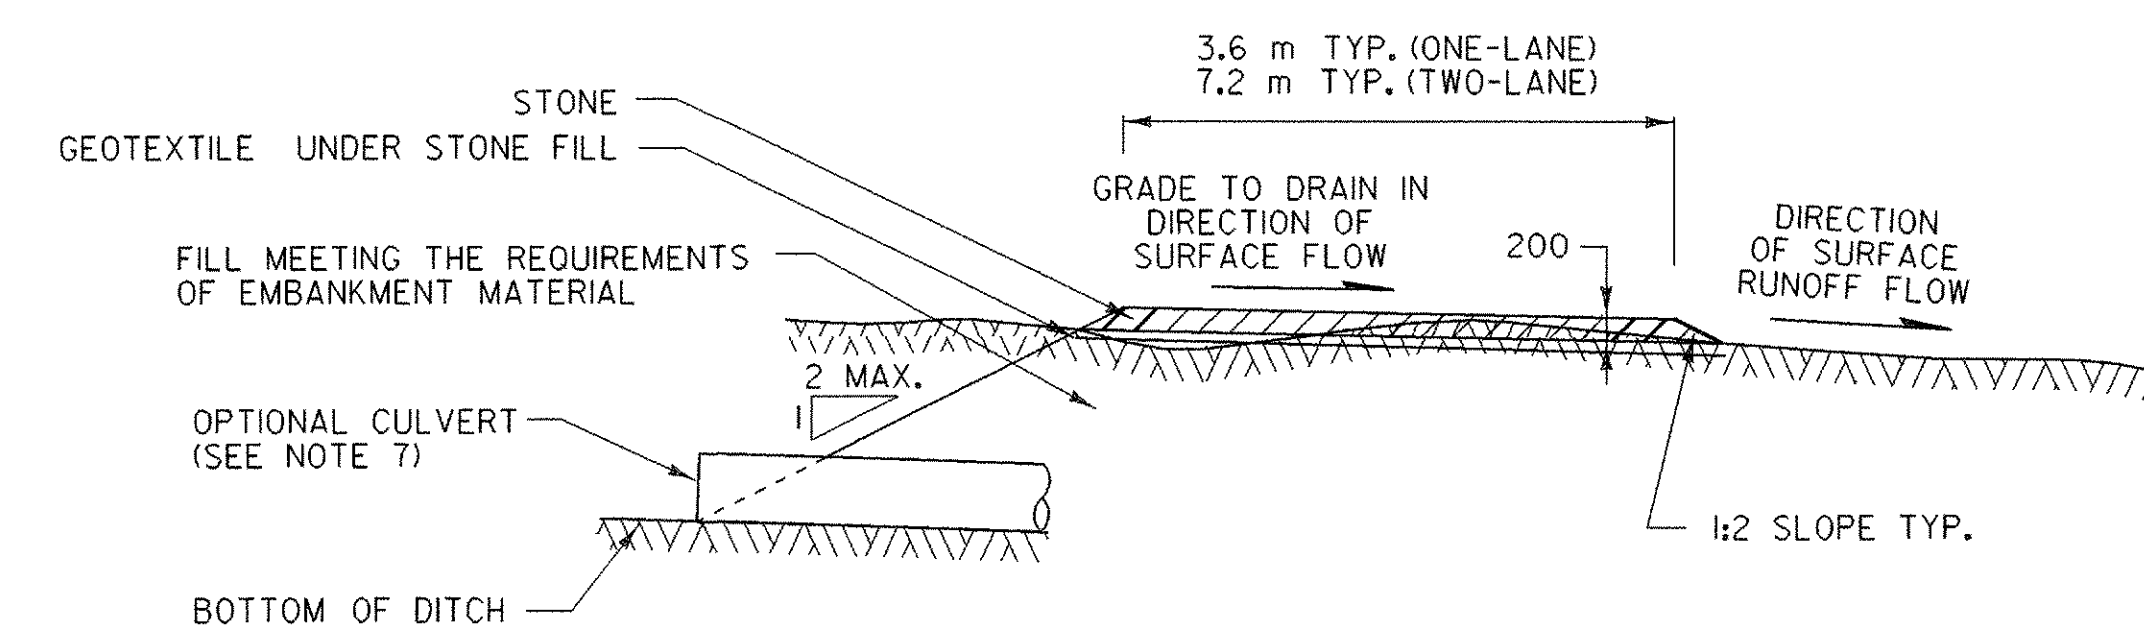

TYPICAL CONSTRUCTION ENTRANCE SECTION

SHEET NAME: EROSION CONTROL DETAILS	
STABILIZED CONSTRUCTION ENTRANCE	
PROJECT NAME: LEICESTER	HIGHWAY NO.: FAS 0160
PROJECT NUMBER: BRF 0160(3)S	BRIDGE NO.: 6
	OVER: OTTER CREEK
FILE NAME: 95j288\Structures\sj288ecd.dgn	PLOT DATE: 17-AUG-2005
PROJECT MANAGER: R. R. WHITCOMB	DRAWN BY: VAOT
DESIGNED BY: C. CARLSON	IPARM NAME: sj288ecd3.i
BRIDGE SHEET NUMBER:	SHEET 33 OF 90

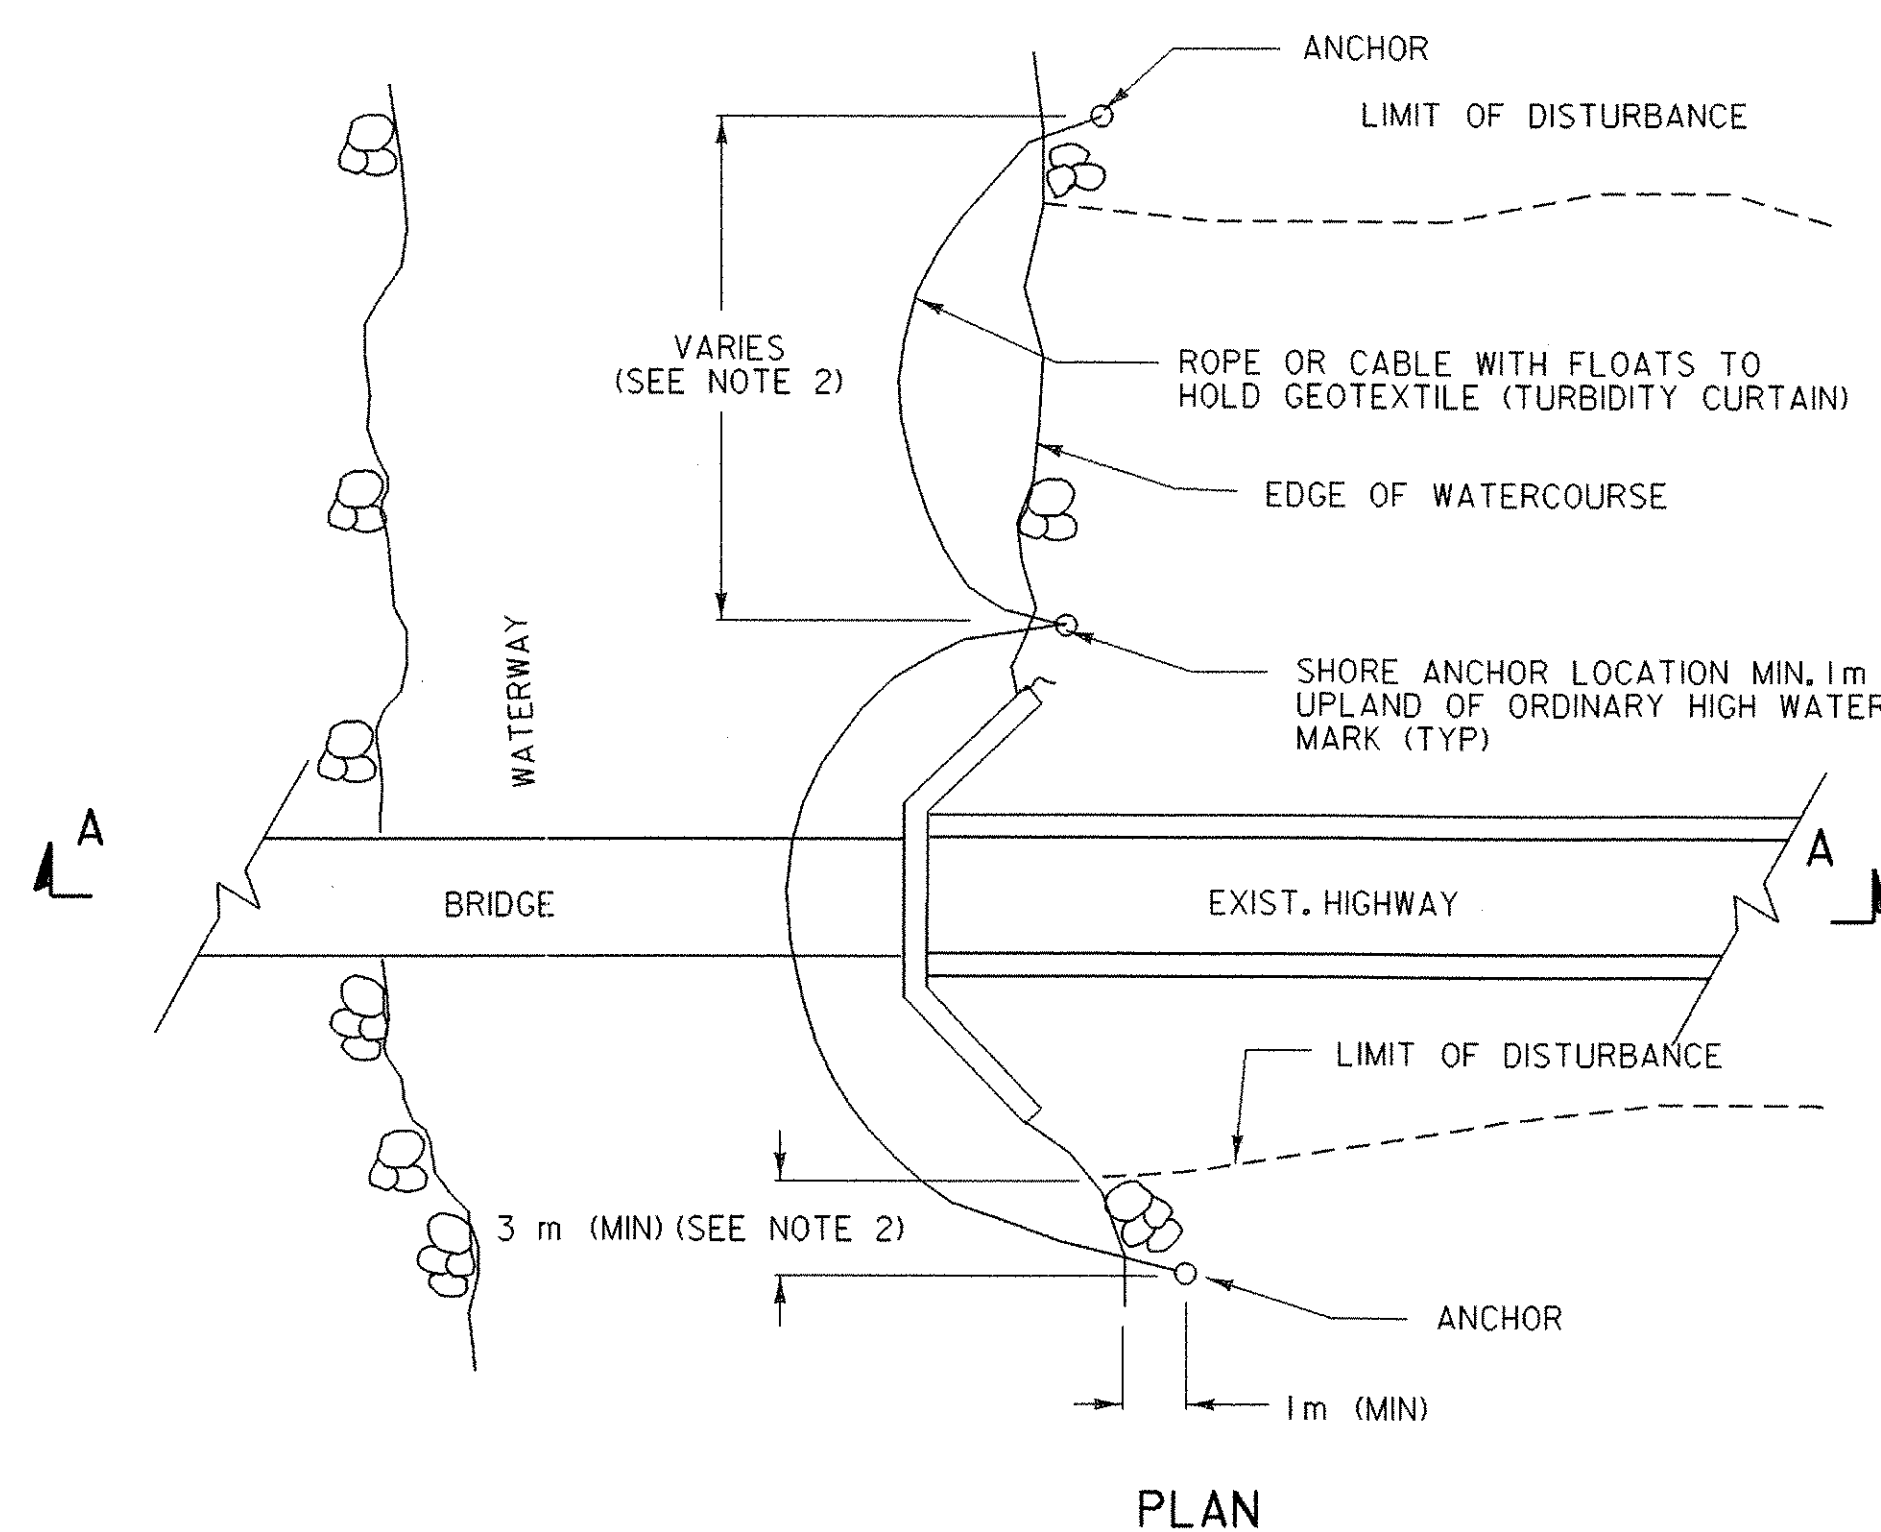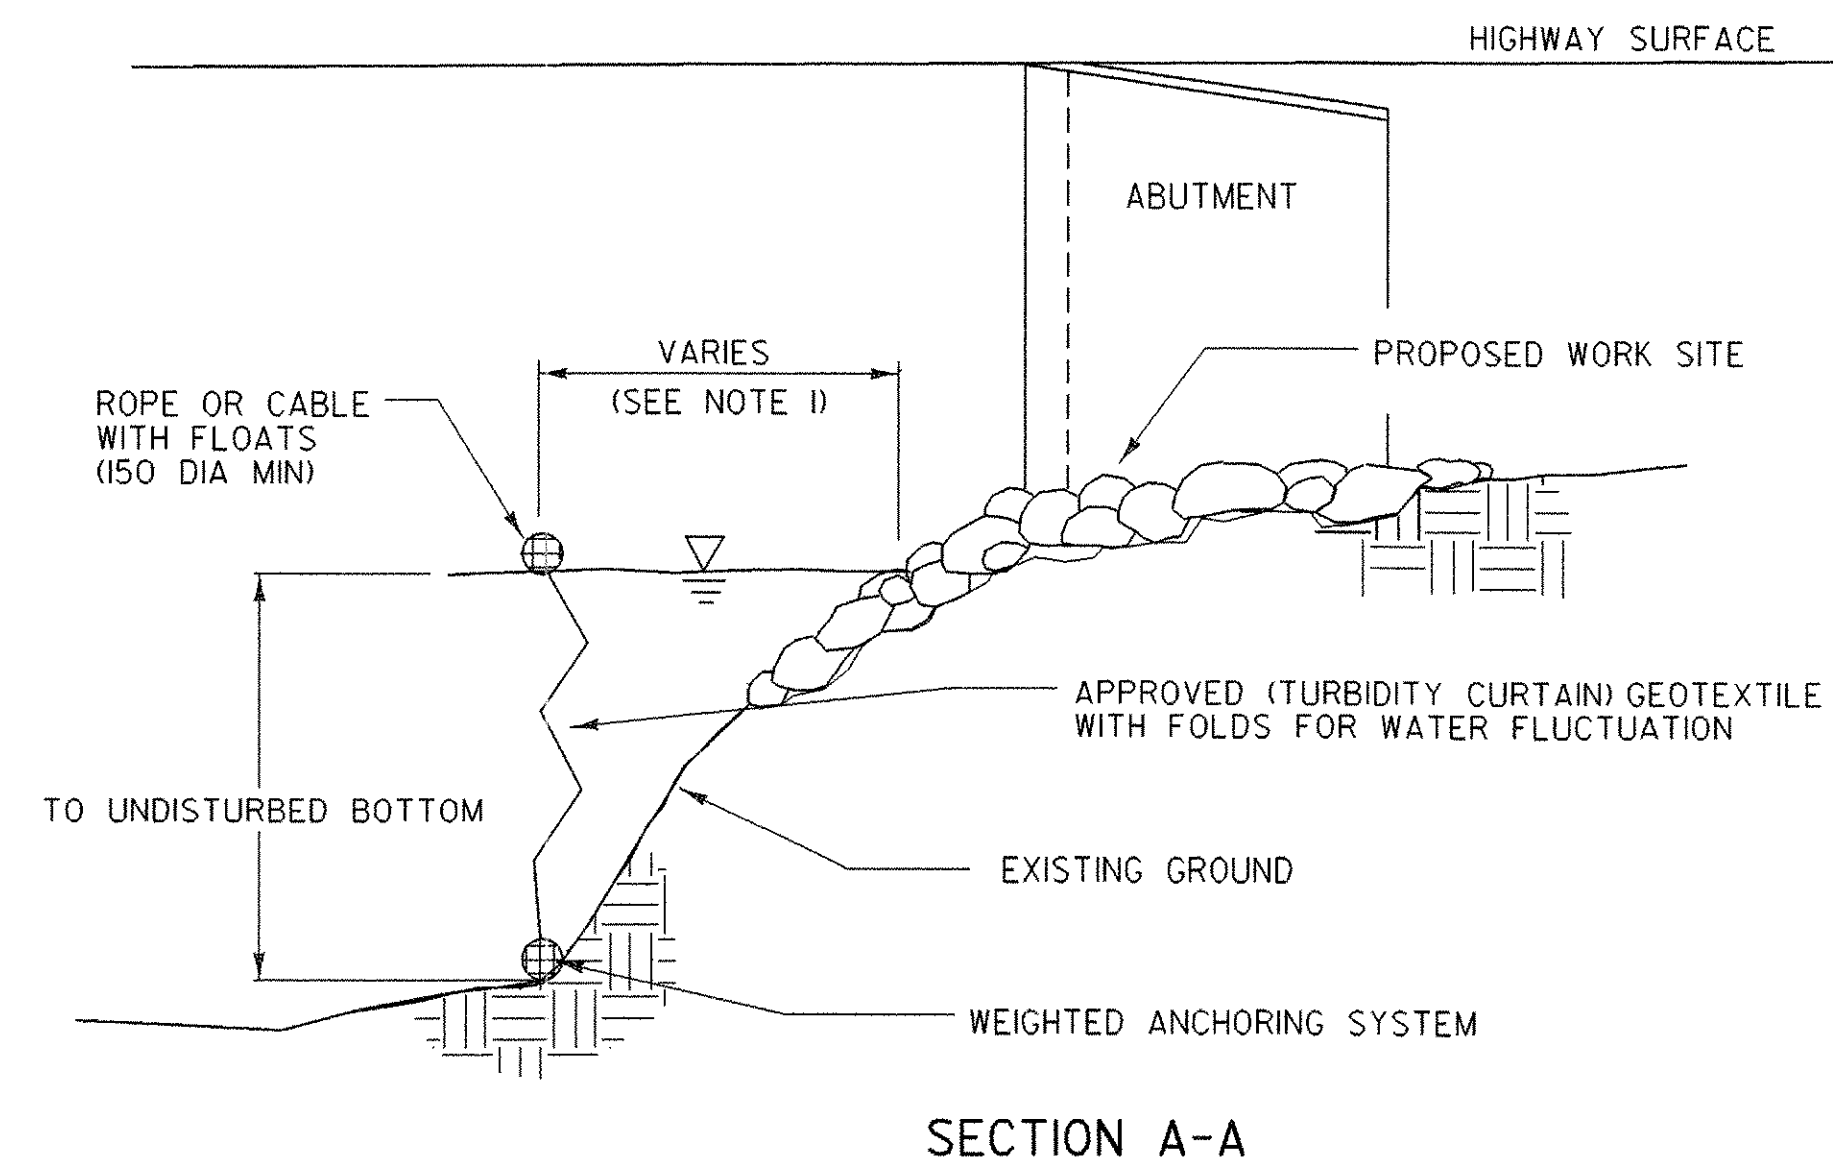

TURBIDITY CURTAIN - TEMPORARY

TURBIDITY CURTAIN


APPLICATION NOTES:

- A. THE PURPOSE OF A TURBIDITY CURTAIN IS TO SEPARATE WORK AREAS IN OR ADJACENT TO WATERS, TO PREVENT SEDIMENT FROM ENTERING THE WATERS.
- B. TURBIDITY CURTAIN SHALL NOT BE PLACED ACROSS A FLOWING WATERWAY, OR IN A WATERWAY WITH STREAM VELOCITIES GREATER THAN 0.5m/SEC.
- C. TURBIDITY CURTAIN SHALL NOT BE PLACED AT THE OUTLET OF A CULVERT OR DITCH UNLESS THE VELOCITY DOES NOT EXCEED 0.5 m/SEC.
- D. THE DETAIL DEPICTS WORK AT A BRIDGE LOCATION, BUT TURBIDITY CURTAIN MAY BE APPLIED AT OTHER LOCATIONS.

GENERAL NOTES:

1. THE TURBIDITY CURTAIN SHALL BE PLACED AS CLOSE TO THE WORK AS POSSIBLE WITHOUT INTERFERING WITH CONSTRUCTION OPERATIONS.
2. THE TURBIDITY CURTAIN SHALL BE A MAXIMUM OF 30 m LONG BETWEEN ANCHORS. LAST SECTION SHALL TERMINATE A MINIMUM OF 3 m BEYOND THE LIMIT OF DISTURBANCE.
3. THE CONTRACTOR SHALL MONITOR THE TURBIDITY CURTAIN, TAKING INTO ACCOUNT WEATHER PATTERNS AND PREVAILING WIND DIRECTIONS THAT MAY AFFECT WATER LEVELS, VELOCITY AND MOVEMENT OF THE TURBIDITY CURTAIN.
4. THE TURBIDITY CURTAIN SHALL BE REMOVED BY SLOWLY PULLING TOWARD THE SHORE TO MINIMIZE ESCAPE OF SEDIMENTS INTO THE WATERWAY.
5. THE WEIGHTED ANCHOR SYSTEM SHALL BE A TYPE THAT ALLOWS THE CURTAIN TO CONFORM TO THE CONTOUR ON THE BOTTOM OF THE WATERWAY.
6. PAYMENT FOR INSTALLATION AND REMOVAL OF THE TURBIDITY CURTAIN SHALL BE MADE UNDER THE GEOTEXTILE FOR FILTER CURTAIN ITEM.
7. PAYMENT FOR MONITORING TURBIDITY CURTAIN SHALL BE MADE UNDER THE MONITORING EROSION PREVENTION & SEDIMENT CONTROL PLAN ITEM.
8. PAYMENT FOR MAINTAINING TURBIDITY CURTAIN SHALL BE MADE UNDER THE MAINTENANCE OF EROSION PREVENTION & SEDIMENT CONTROL PLAN ITEM, UNLESS MINTENANCE IS REQUIRED DUE TO POOR INSTALLATION PRACTICES.

SHEET NAME: EROSION CONTROL DETAILS TURBIDITY CURTAIN	
PROJECT NAME: LEICESTER	HIGHWAY NO.: FAS 0160
PROJECT NUMBER: BRF 0160(3)S	BRIDGE NO.: 6
	OVER: OTTER CREEK
FILE NAME: 95j288\Structures\sj288ecd.dgn	PLOT DATE: 17-AUG-2005
PROJECT MANAGER: R. R. WHITCOMB	DRAWN BY: VAOT
DESIGNED BY: C. CARLSON	IPARM NAME: sj288ecd4.1
BRIDGE SHEET NUMBER:	SHEET 34 OF 90

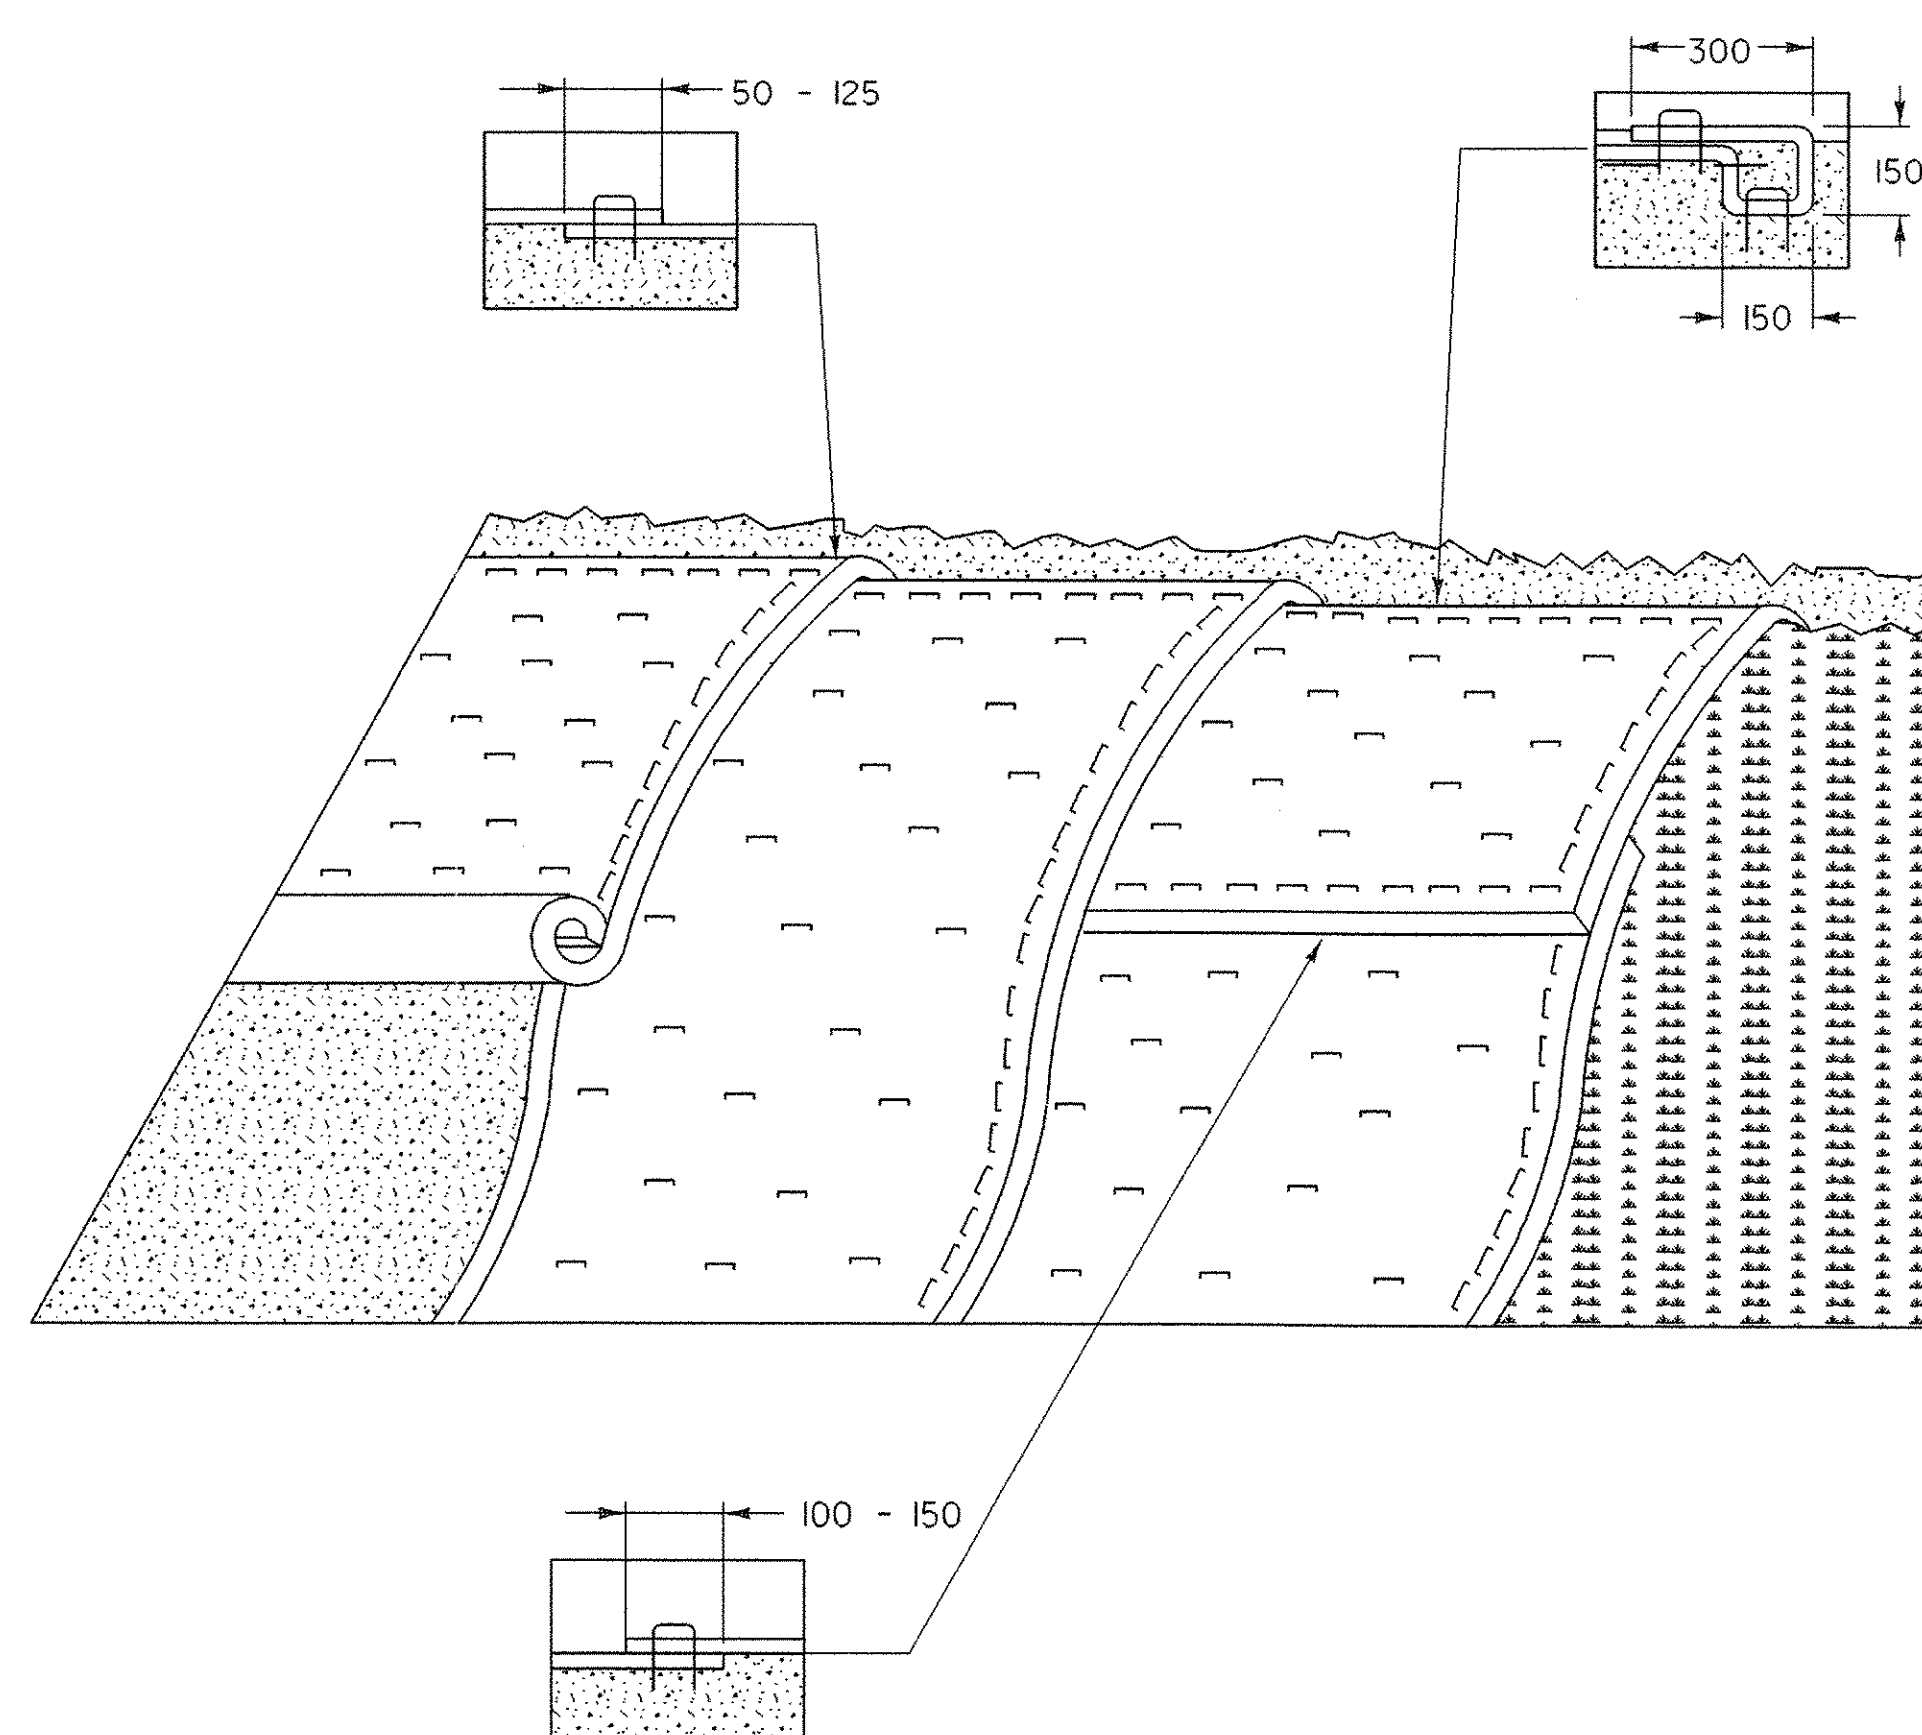

EROSION PREVENTION FOR SIDE SLOPES

APPLICATION NOTES:

- A. THE PURPOSE OF MATTING ON SIDE SLOPES IS TO REDUCE EROSION AND AID THE ESTABLISHMENT OF VEGETATION
- B. EROSION CONTROL MATTING SHALL BE USED FOR THE FOLLOWING REASONS:
 - SIDE SLOPES STEEPER THAN 3:1 (H:V)
 - AREAS WHERE SEED AND MULCH WILL NOT STAY IN PLACE ALONE
 - WHERE SEEDING IS OUTSIDE THE GROWING SEASON.

GENERAL NOTES:

1. GRADE AND SMOOTH THE SLOPE TO PROVIDE GOOD MATTING TO SOIL SURFACE CONTACT.
2. APPLY FERTILIZER, LIME, AND SEED PRIOR TO PLACING MATTING.
3. ANCHOR MATTING AS SHOWN, UTILIZING ANCHOR STAPLES. STAPLE PLACEMENT SHALL BE DETERMINED BY THE MANUFACTURER'S INSTALLATION INSTRUCTIONS.
4. UNROLL MATTING VERTICALLY DOWN SLOPE IN THE DIRECTION OF WATER FLOW.
5. OVERLAP UPPER MATTING OVER LOWER MATTING AS SHOWN.
6. OVERLAP ADJACENT MATTING AS SHOWN.
7. CUT EXCESS MATTING AT END OF SLOPE AND ANCHOR THE END.
8. MATTING SHALL BE INSPECTED EVERY SEVEN (7) CALENDAR DAYS AND WITHIN 24 HOURS OF A STORM EVENT GREAT ENOUGH TO CAUSE WATER TO LEAVE THE CONSTRUCTION SITE.
9. MATTING SHALL BE REPAIRED AND RESTAPLED AS NECESSARY TO ENSURE PROPER FUNCTION.
10. PAYMENT FOR INSTALLATION OF MATTING SHALL BE MADE UNDER THE EROSION CONTROL WITH MATTING ITEM.
11. PAYMENT FOR MONITORING EROSION CONTROL MATTING SHALL BE MADE UNDER THE MONITORING EROSION PREVENTION & SEDIMENT CONTROL PLAN ITEM.
12. PAYMENT FOR MAINTAINING EROSION CONTROL MATTING SHALL BE MADE UNDER THE MAINTENANCE OF EROSION PREVENTION & SEDIMENT CONTROL PLAN ITEM, UNLESS MAINTENANCE IS REQUIRED DUE TO POOR INSTALLATION PRACTICES.

SEEDING FORMULA RURAL AREAS

% WT.	kg/ha	NAME	PUR %	GERM %
37.5	26.0	CREeping RED FESCUE	98	85
37.5	26.0	TALL FESCUE	95	90
5.0	4.0	RED TOP	95	90
15.0	10.0	BIRDSFOOT TREFoil	98	85
5.0	4.0	ANNUAL RYE GRASS	95	85
100.0	70.0			

GENERAL NOTES

SEED MIXTURE: SHALL NOT HAVE A WEED CONTENT EXCEEDING 0.40% BY WEIGHT AND SHALL BE FREE OF ALL NOXIOUS SEED.

SEED: TO BE APPLIED PER SEEDING FORMULAS OR AS DIRECTED BY THE ENGINEER.


FERTILIZER: FORMULA 10-20-10, TO BE USED WITH SEED, APPLIED AT THE RATE OF 560 kg/ha. (HYDRO SEEDERS MAY USE 19-19-19 FORMULA).

AGRICULTURAL LIMESTONE: TO BE APPLIED AT THE RATE OF 4500 kg/ha, OR AS DIRECTED BY THE ENGINEER.

HAY MULCH: TO BE PLACED ON EARTH SLOPES AT THE RATE OF 4500 kg/ha, OR AS DIRECTED BY THE ENGINEER.

TOPSOIL: TO BE USED WITH SEED AS INDICATED ON THE PLANS, OR AS DIRECTED BY THE ENGINEER.

SHEET NAME: EROSION CONTROL DETAILS EROSION CONTROL MATTING	
PROJECT NAME: LEICESTER	HIGHWAY NO.: FAS 0160
PROJECT NUMBER: BRF 0160(3)S	BRIDGE NO.: 6
	OVER: OTTER CREEK
FILE NAME: 95J288\Structures\sj288ecd.dgn	PLOT DATE: 17-AUG-2005
PROJECT MANAGER: R. R. WHITCOMB	DRAWN BY: VAOT
DESIGNED BY: C. CARLSON	IPARM NAME: sj288ecd5.l
BRIDGE SHEET NUMBER:	SHEET 35 OF 90



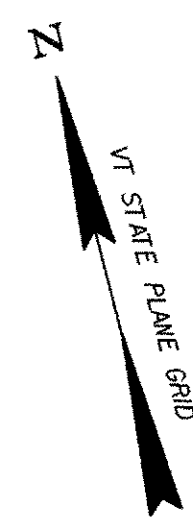


100mm YELLOW LINE (DOUBLE LINE)
STA 0+950 - STA 1+006.466

600mm STOP BAR
STA 0+895.5 RT
STA 0+910.5 RT
STA 0+983.6 RT
STA 0+999.8 LT

RAILROAD CROSSING SYMBOL
STA 0+903.0 RT

TRAFFIC SIGNS, TYPE A
STA 0+903.0 RT - 1 EACH

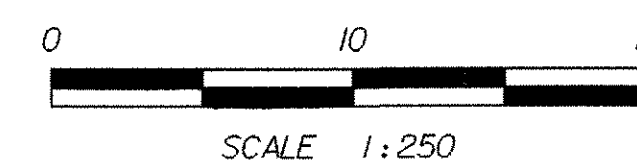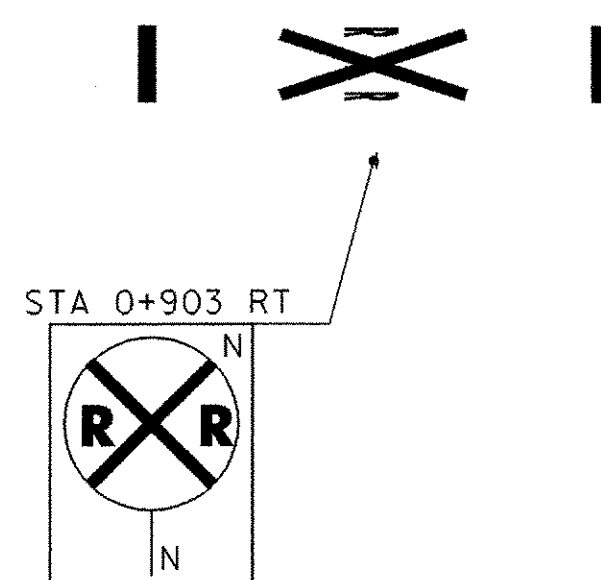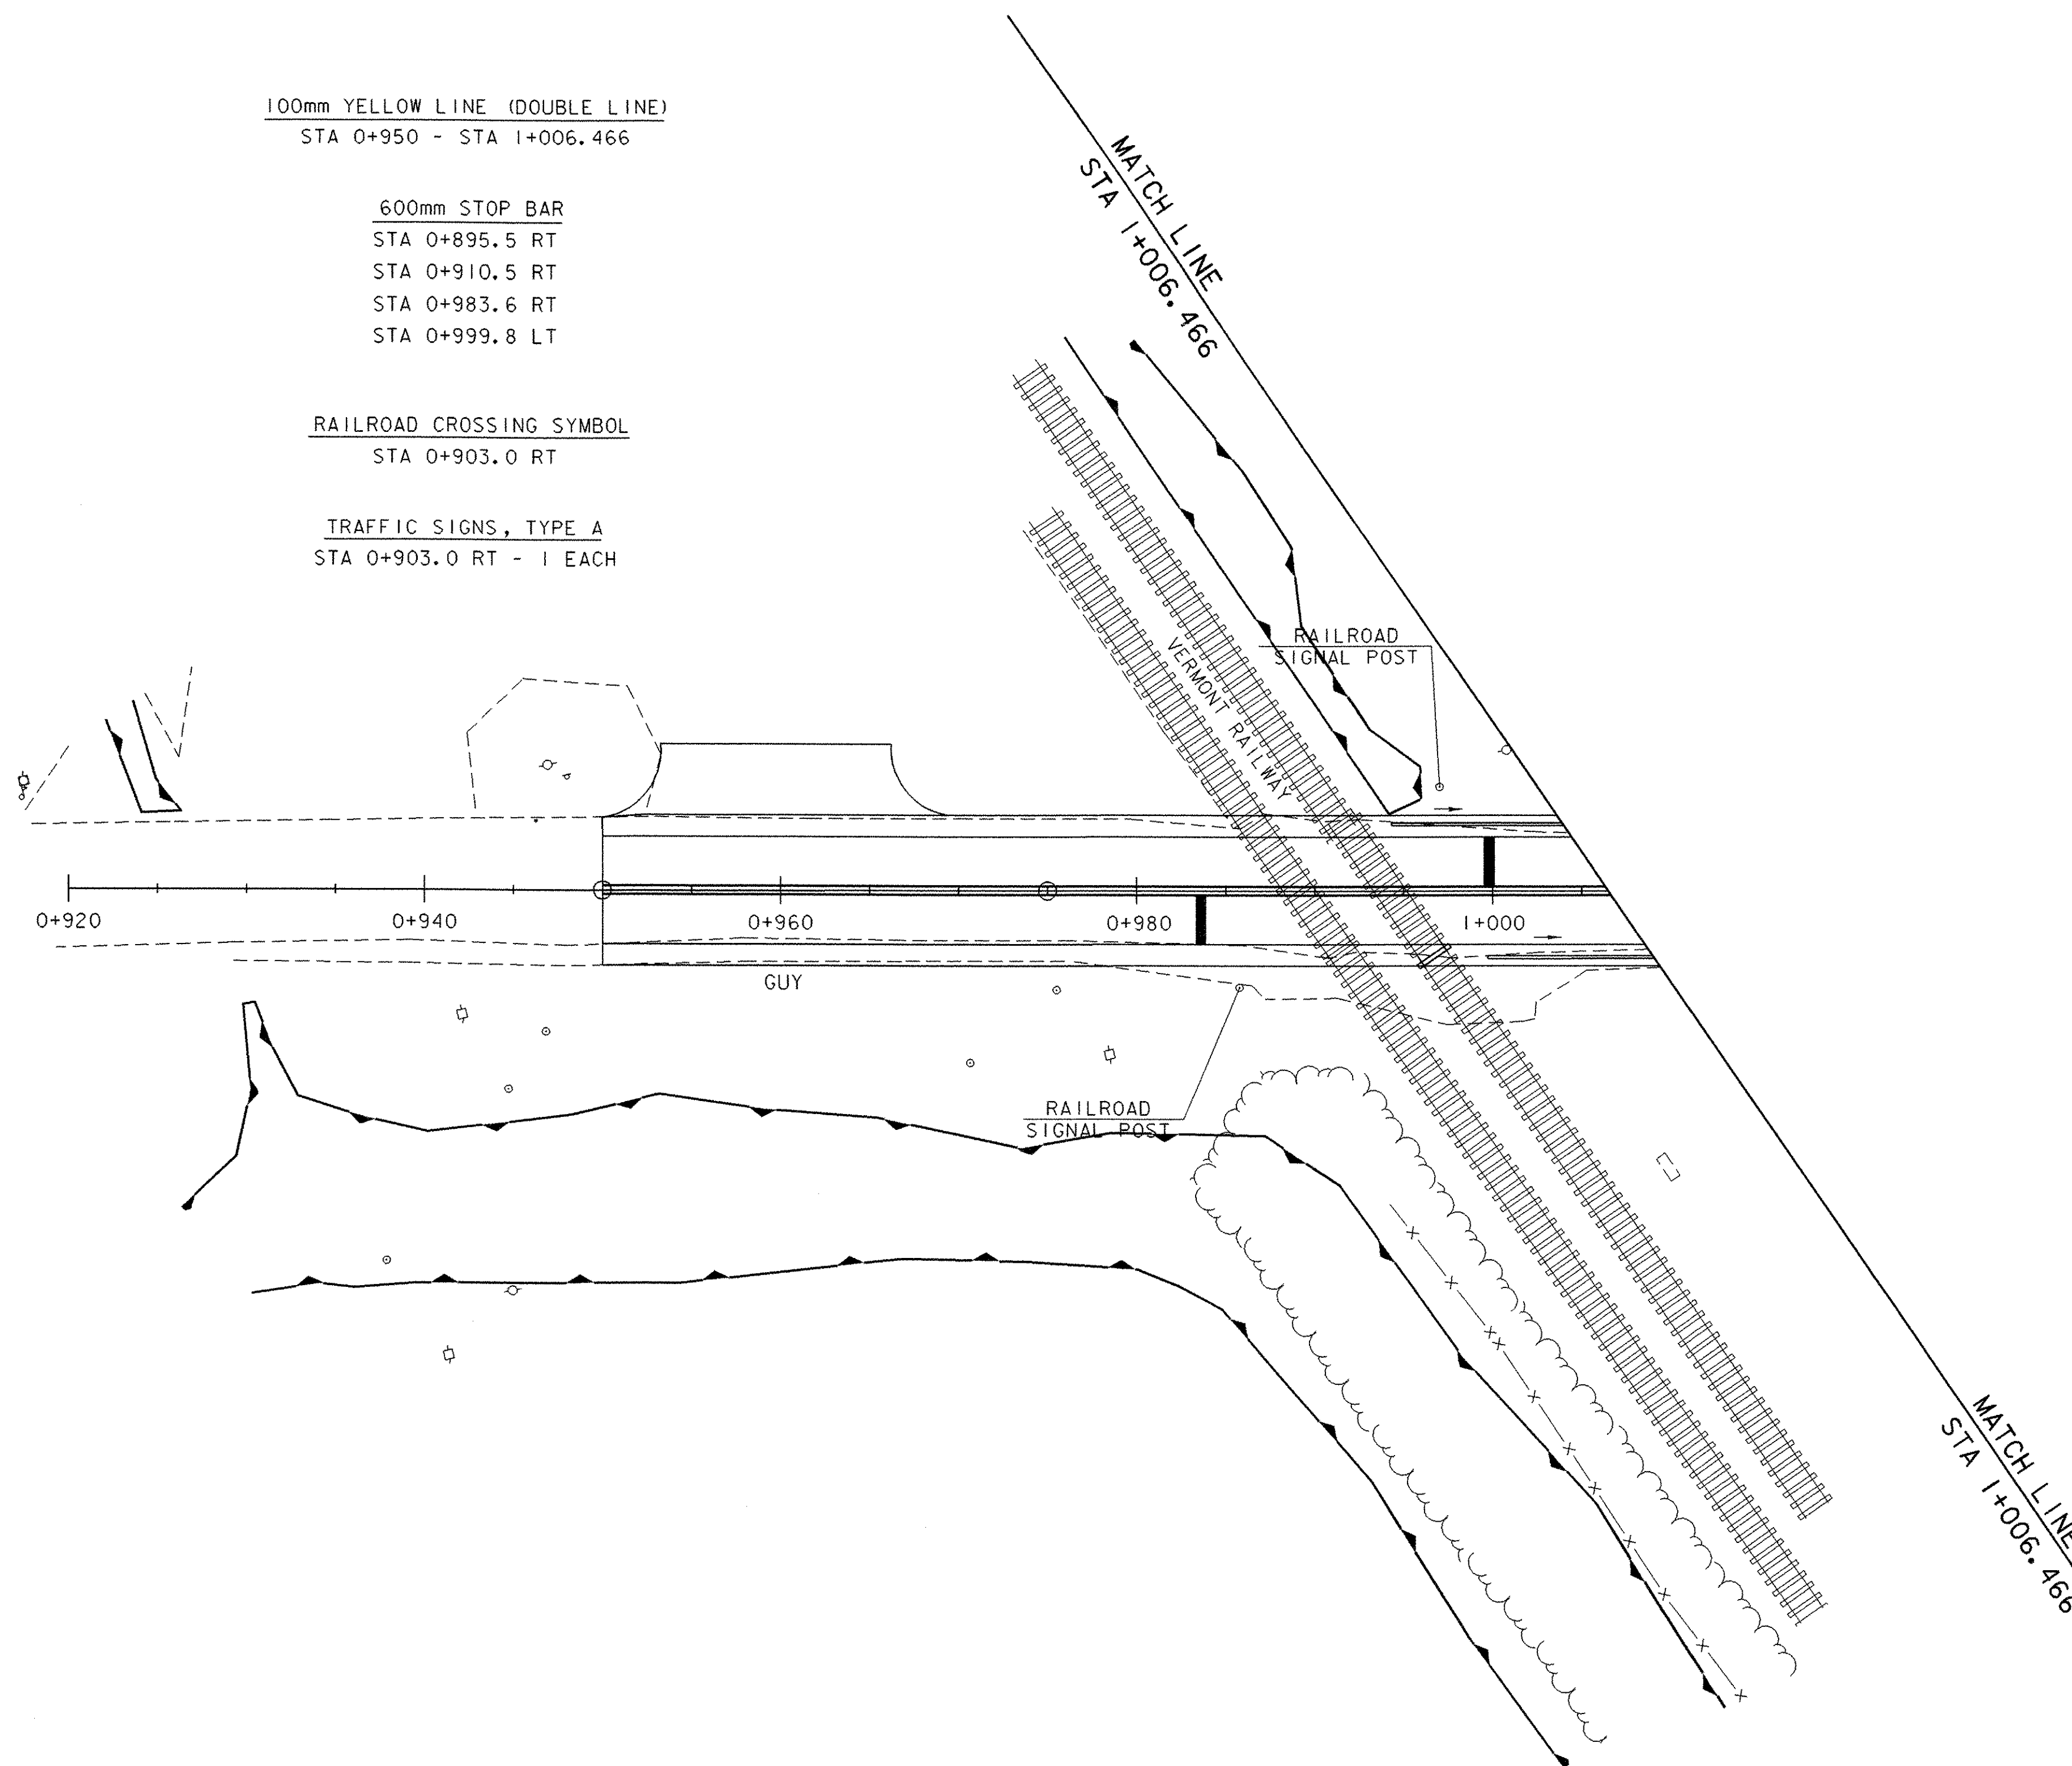


SHEET NAME: LINE STRIPING AND SIGN LAYOUT (I)

PROJECT NAME: LEICESTER	HIGHWAY NO.: FAS 0160
PROJECT NUMBER: BRF 0160(3)S	BRIDGE NO.: 6
	OVER: OTTER CREEK

FILE NAME: 95j288\Structures\sj288bdr.dgn	PLT DATE: 17-AUG-2005
PROJECT MANAGER: R. R. WHITCOMB	DRAWN BY: J. GILMORE
DESIGNED BY: C. CARLSON	IPARM NAME: sj088sgl.l
BRIDGE SHEET NUMBER:	SHEET 36 OF 90

* REUSE SIGNS AND POSTS FOR TEMPORARY TRAFFIC DETOUR. SEE SHEET 40 FOR SIGN LOCATIONS.

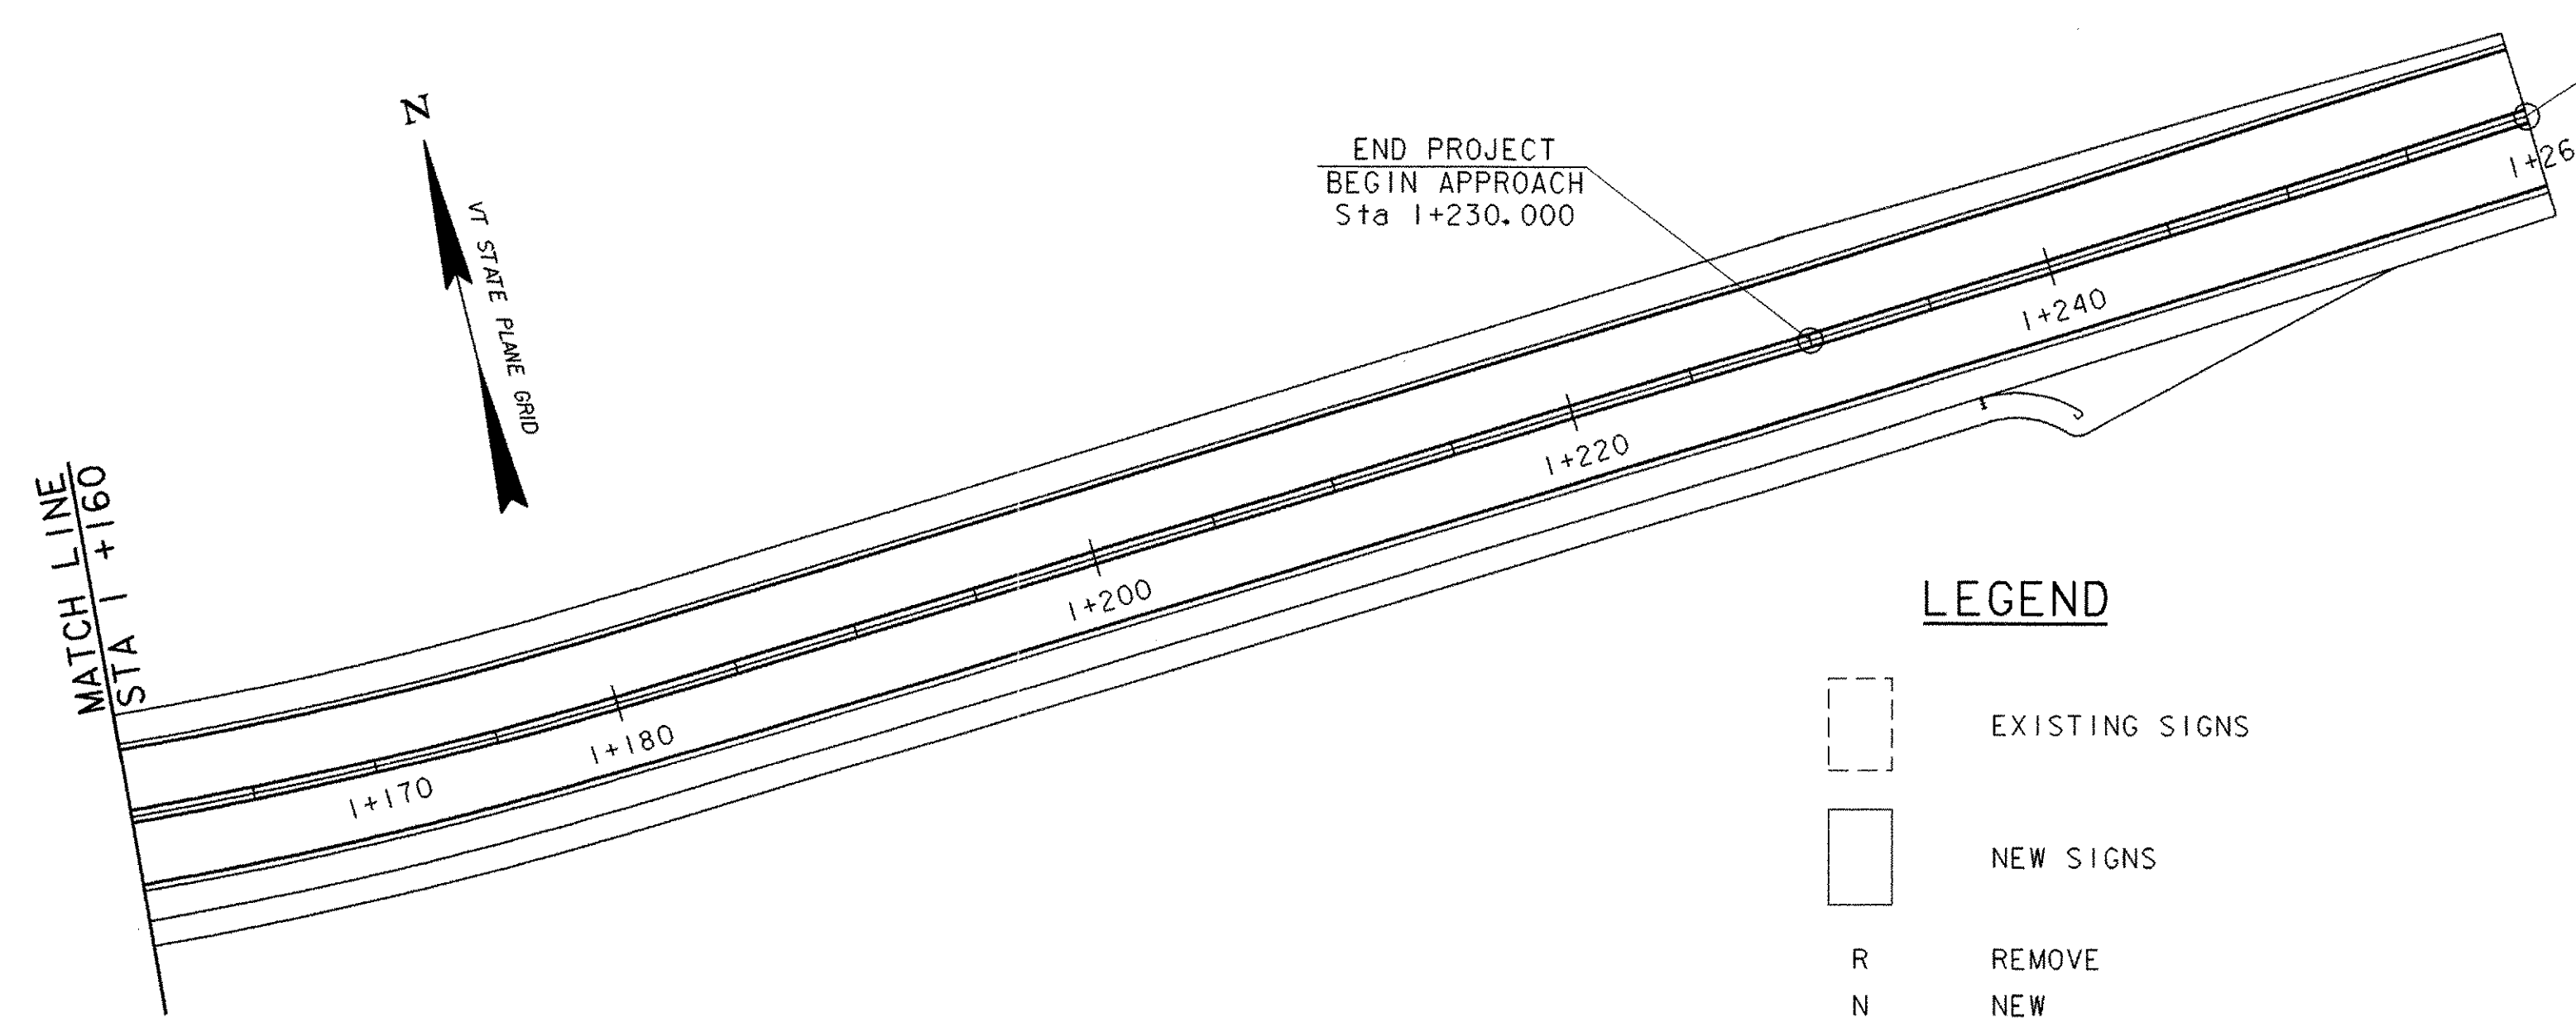

100mm YELLOW LINE (DOUBLE LINE)

STA 1+006.466 - STA 1+138
 STA 1+150 - STA 1+260
 § STA 2+006.1 - § STA 2+020

600mm STOP BAR

STA 1+072.5 LT
 STA 1+087.5 LT
 § STA 2+006.1 LT

LETTERS

STA 2+008 (STOP)

RAILROAD CROSSING SYMBOL

STA 1+080.0 LT

TRAFFIC SIGNS, TYPE A

STA 1+066.7 LT - 1 EACH
 STA 1+080.0 LT - 1 EACH
 § STA 2+010.3 LT - 1 EACH

REMOVING SIGNS

STA 1+068.7 LT - 2 EACH
 * STA 1+130.0 LT - 1 EACH
 * § STA 2+011.1 LT - 3 EACH

ERECTING SALVAGED SIGNS

§ STA 2+010.3 LT - 2 EACH

LEGEND






- EXISTING SIGNS
- NEW SIGNS
- R REMOVE
- N NEW
- R&S REMOVE & SALVAGE
- S SALVAGE

MATCH LINE
STA 1+006.466


MATCH LINE
STA 1+160

MATCH LINE
STA 1+006.466


MATCH LINE
STA 1+160

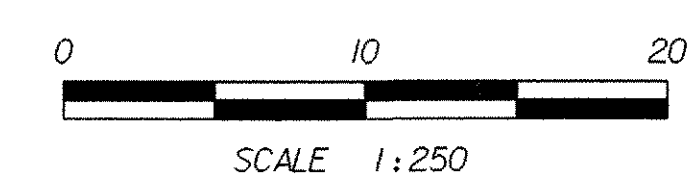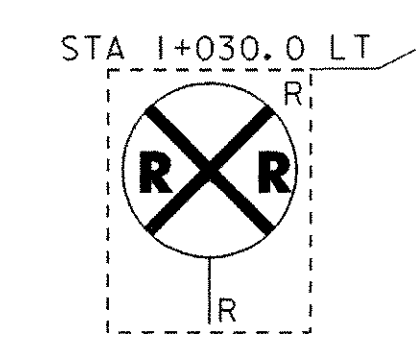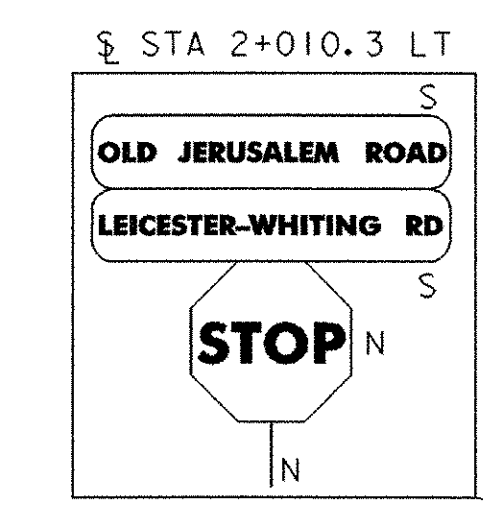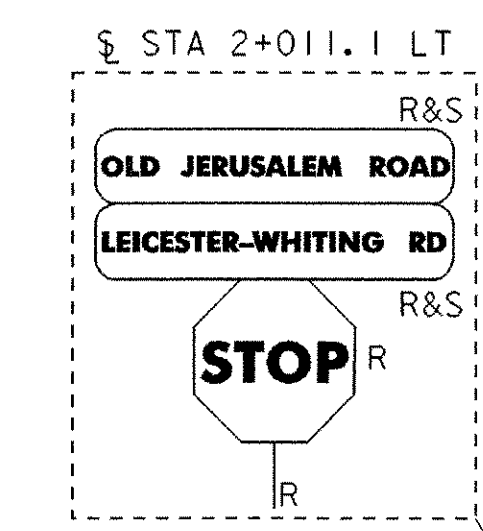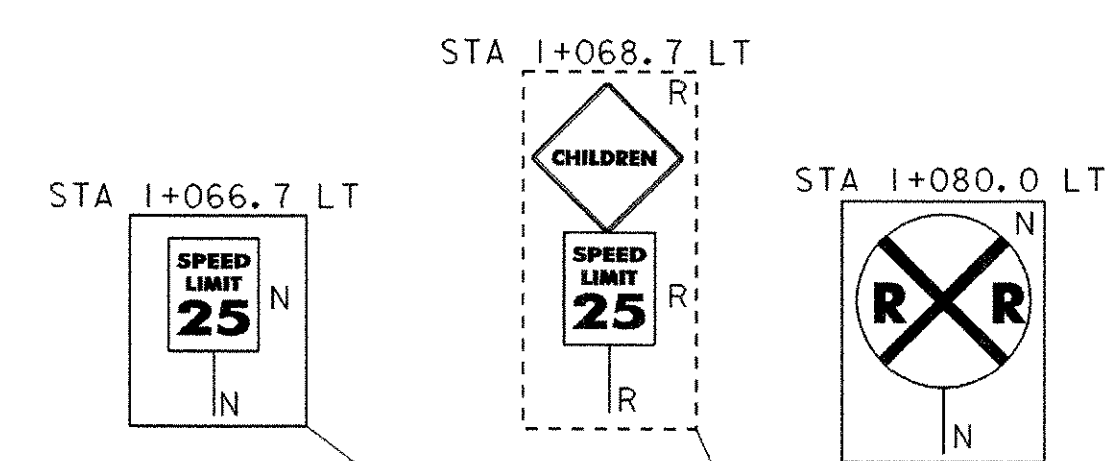


SHEET NAME: LINE STRIPING AND SIGN LAYOUT (2)	
PROJECT NAME: LEICESTER	HIGHWAY NO.: FAS 0160
PROJECT NUMBER: BRF 0160(3)S	BRIDGE NO.: 6
	OVER: OTTER CREEK
FILE NAME: 95j288\Structures\sj288bdr.dgn	PLOT DATE: 17-AUG-2005
PROJECT MANAGER: R. R. WHITCOMB	DRAWN BY: J. GILMORE
DESIGNED BY: C. CARLSON	IPARM NAME: sj088sg2.1
BRIDGE SHEET NUMBER:	SHEET 37 OF 90

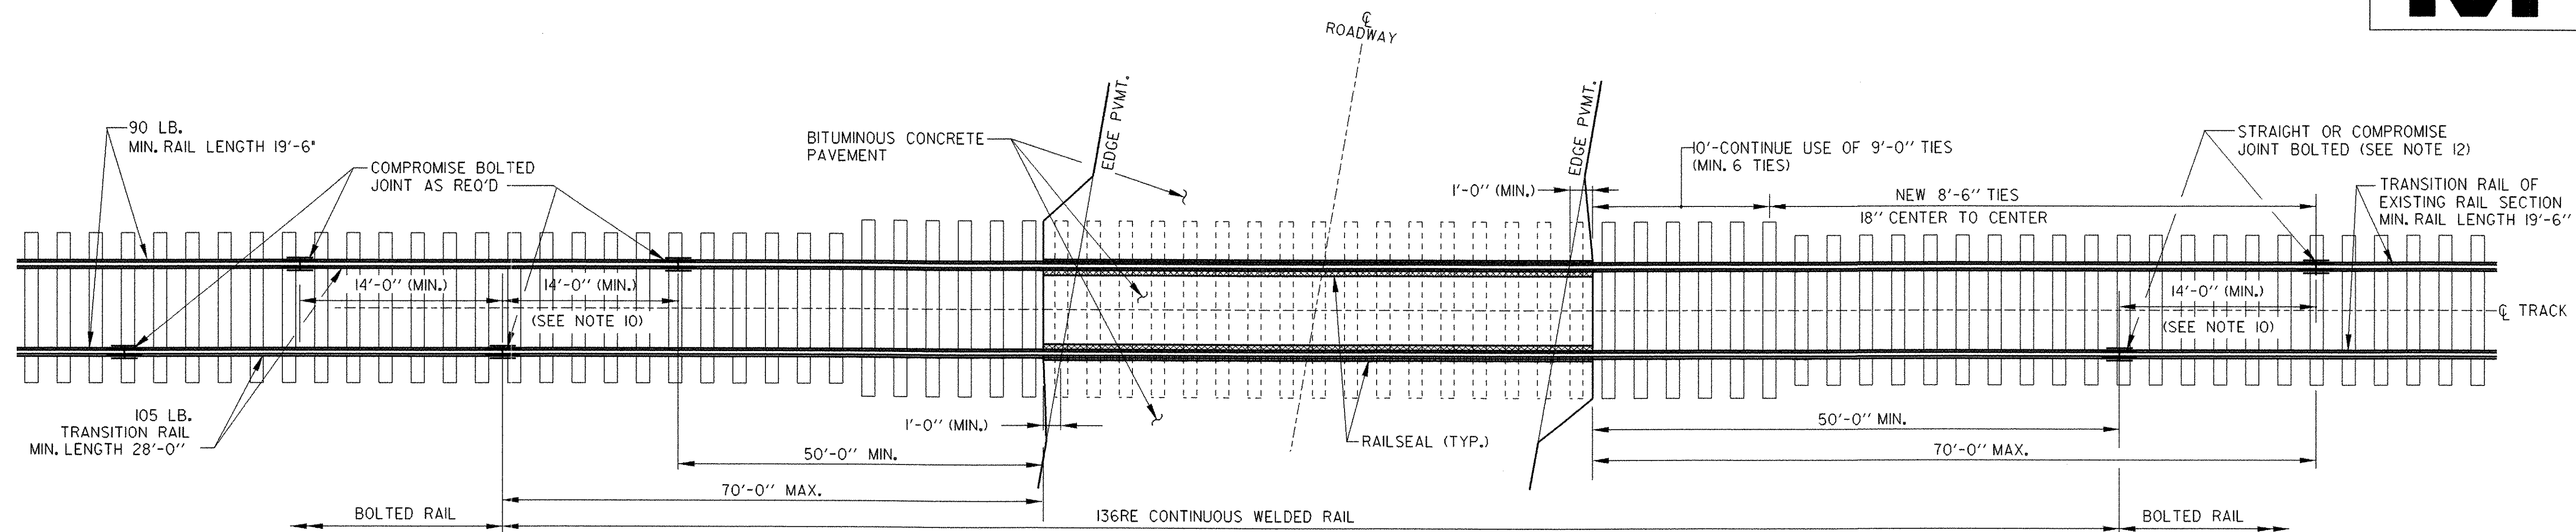


TYPICAL PLAN VIEW

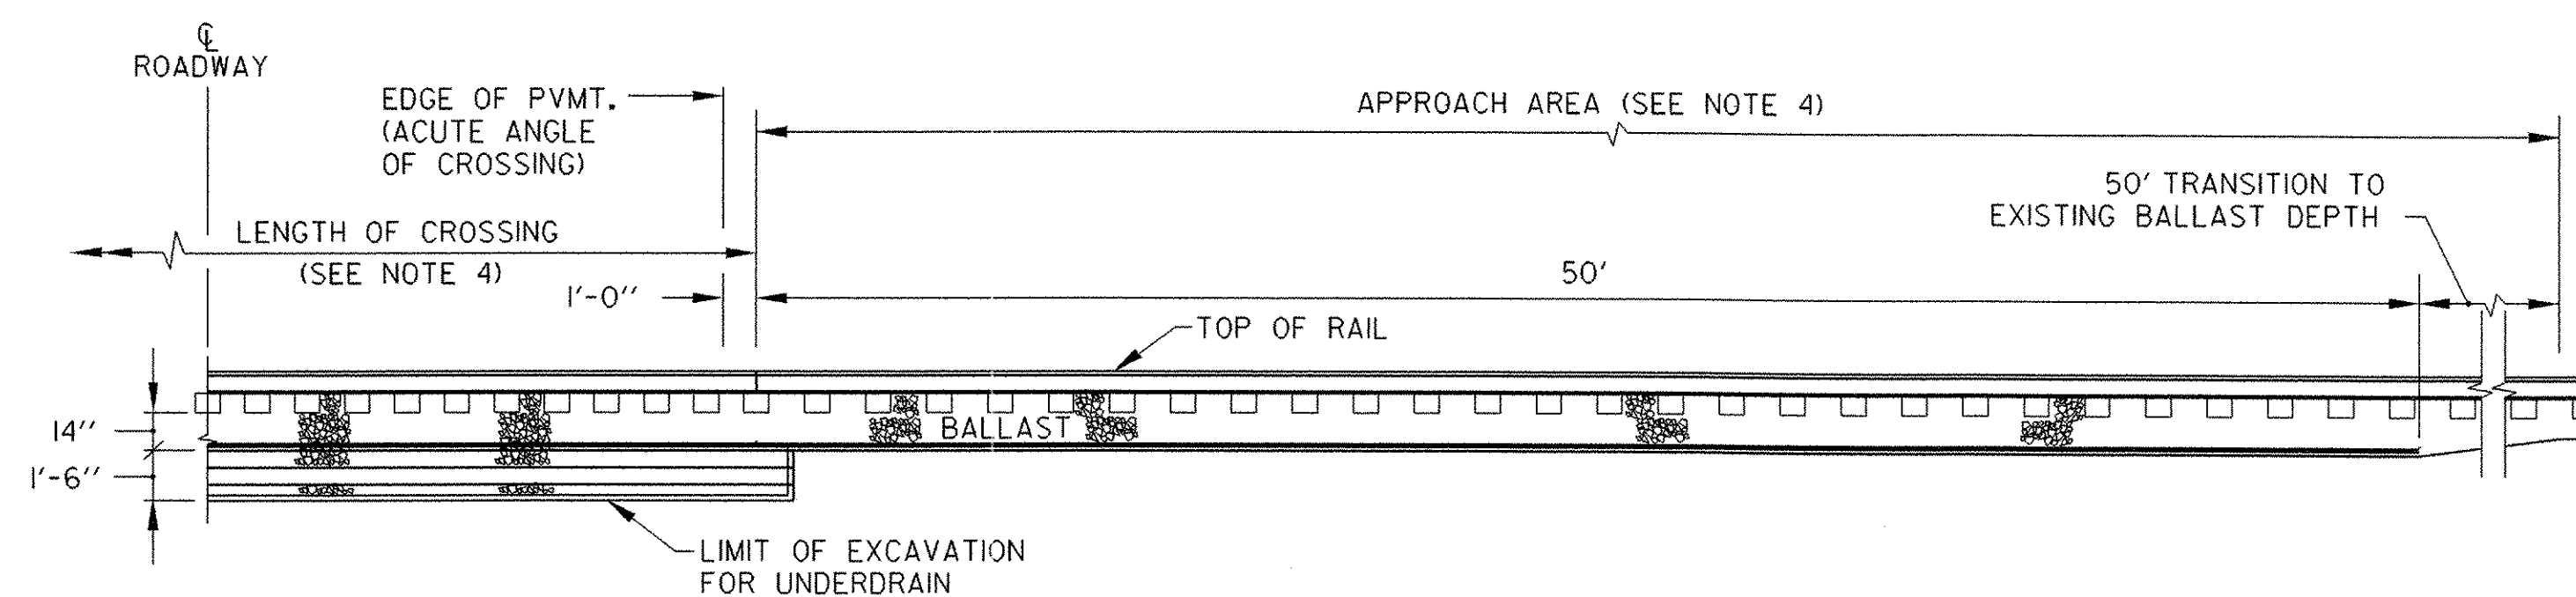

TYPICAL LONGITUDINAL SECTION

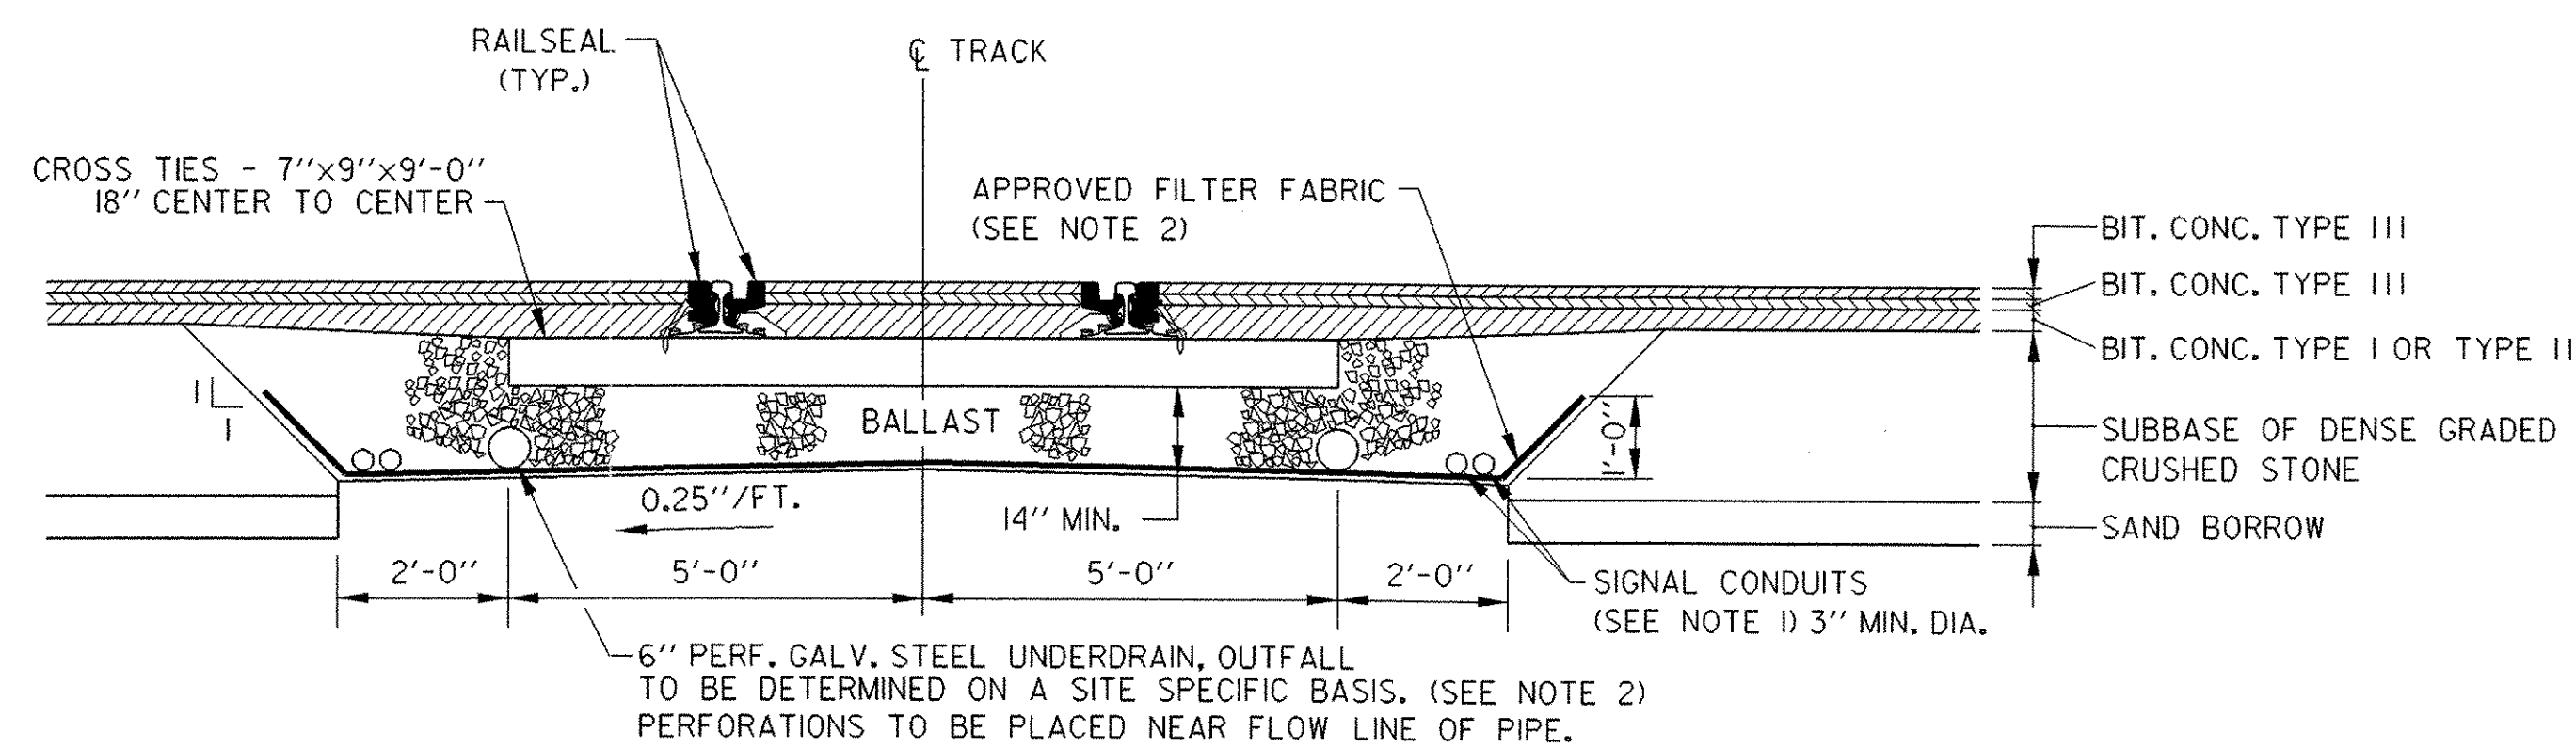

TYPICAL TRANSVERSE SECTION

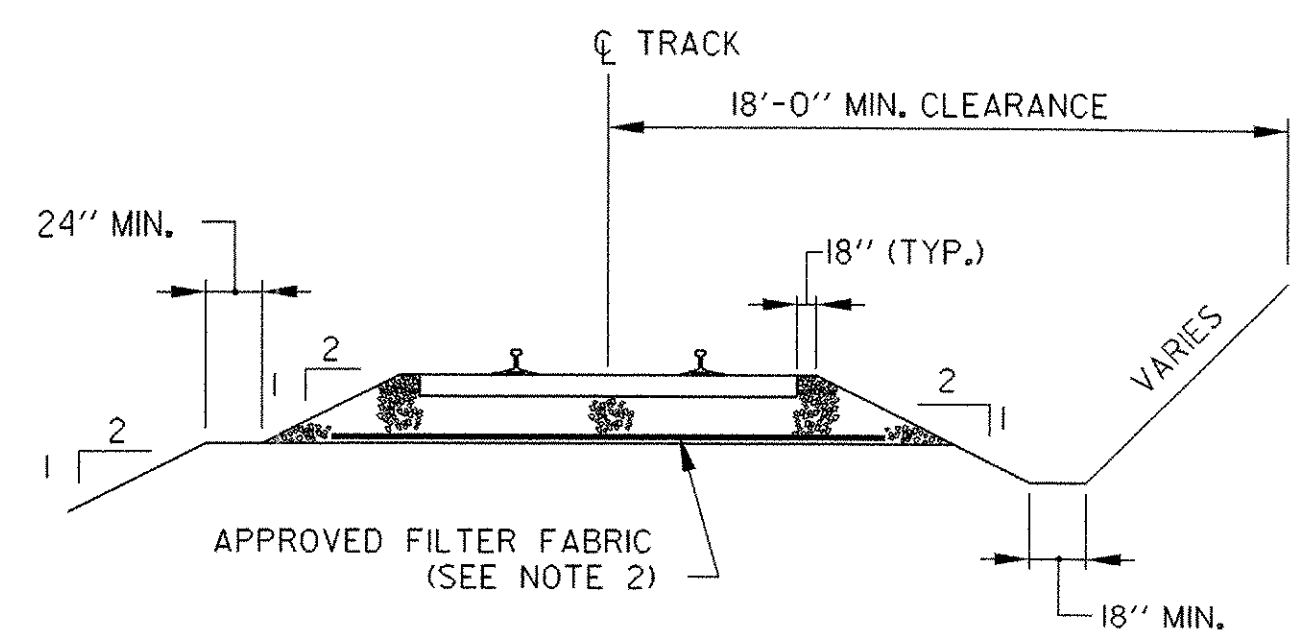

TYPICAL SECTION FOR APPROACH AREAS

GENERAL NOTES

1. SIGNAL CONDUIT (SCHEDULE 80 PVC) TO BE INSTALLED WITH SECURED END CAPS IN LOCATIONS DIRECTED BY THE ENGINEER.
2. THE OUTLET OF UNDERDRAIN AND GEOTEXTILE FABRIC SHALL BE DETERMINED UPON INSPECTION OF FIELD CONDITIONS BY THE ENGINEER.
3. ALL RAIL JOINTS WITHIN THE CROSSING AREA AND 50'-0" BEYOND WILL BE CROPPED AND WELDED IN ACCORDANCE WITH THE LATEST REVISION OF A.R.E.M.A. SPECIFICATIONS AT AN OFF-SITE ELECTRIC WELDING PLANT. WELDING CAN BE DONE IN FIELD UTILIZING THERMITE WELDING WITH ADVANCE APPROVAL FROM THE AGENCY. WELDED JOINTS SHALL BE GROUND TO CONFORM TO THE SHAPE OF THE RAIL ON GAUGE AND FIELD SIDES.
4. NEW 7"x9"x9'-0" AND 7"x9"x8'-6" TIES SHALL BE USED IN CROSSING AREA AS SHOWN. TIES IN APPROACH AREAS SHALL BE REPLACED AS RECOMMENDED BY THE RAILROAD AND APPROVED BY THE ENGINEER.
5. TIE PLATES SHALL BE NEW 14 INCH PLATES MANUFACTURED FOR THE RAIL USED. PLATES SHALL BE INSPECTED AND APPROVED BY THE RAILROAD AND THE ENGINEER. RAIL FASTENERS SHALL BE EITHER CUT TRACK SPIKES OR PANDROL TYPE CLIPS AND LOCK SPIKES. SPECIFIC RAIL FASTENING SYSTEM SHALL BE RECOMMENDED BY THE RAILROAD AND APPROVED BY THE STATE OF VERMONT AGENCY OF TRANSPORTATION DURING FINAL DESIGN.
6. BALLAST IN APPROACH AREAS SHALL EXTEND 18" BEYOND END OF TIES AND SLOPED 1:2 TO THE ROADBED. (SEE DETAIL)
7. RAIL WEIGHT TO BE 115 LB. RE THROUGH CROSSING. DEVIATIONS FROM THIS ARE TO BE APPROVED BY VTRANS RAIL OPERATIONS AND VTRANS GRADE CROSSING ENGINEER.
8. TYPE AND DESIGN OF RAILSEAL SHALL RECEIVE APPROVAL FROM THE VTRANS GRADE CROSSING ENGINEER.
9. MANUFACTURERS SPECIFICATIONS SHALL BE FOLLOWED FOR THE INSTALLATION OF RAILSEAL.
10. INSULATED JOINTS WILL BE REQUIRED FOR TYPE "C" TRACK CIRCUITS (CIRCUITS WITHOUT MOTION DETECTOR OR PREDICTOR SYSTEMS). IF INSULATED JOINTS ARE USED MAXIMUM STAGGER BETWEEN RAIL JOINTS SHALL BE 4'-6", MINIMUM SHALL BE 3'-6". IF INSULATED JOINTS ARE USED, INSTALL ONE ADDITIONAL NEW RAIL UP TO 39'-0" IN LENGTH BEYOND INSULATED JOINT.
11. BITUMINOUS CONCRETE PAVEMENT SHALL BE INSTALLED WITH PAVING MACHINE WITH MAXIMUM 3" LIFTS (UNLESS OTHERWISE DIRECTED BY THE ENGINEER) AND SHALL BE LAID PARALLEL TO CROSSING TO MINIMIZE APPROACH SETTLEMENT.
12. IF EXISTING TRACK IS CONTINUOUS WELDED RAIL, JOINT SHALL BE FIELD WELDED OR BOLTED AS SHOWN ON THE PLANS.
13. REFER TO VTRANS STD. E-190 FOR PLACEMENT OF SIGNS AND PAVEMENT MARKINGS.

DETAILS ARE NOT DRAWN TO SCALE AND DIMENSIONS SHOWN IN ENGLISH UNITS


SHEET NAME: RAILROAD-HIGHWAY CROSSING DETAILS	
PROJECT NAME: LEICESTER	HIGHWAY NO.: TH 1
PROJECT NUMBER: BRF 0160(3)S	BRIDGE NO.: 6
	OVER: OTTER CREEK
FILE NAME: 95J288\Structures\sj288rrx.dgn	PLT DATE: 17-AUG-2005
PROJECT MANAGER: R. R. WHITCOMB	DRAWN BY: G. ROY
DESIGNED BY: C. CARLSON	IPARM NAME: sj288rrx.1
BRIDGE SHEET NUMBER:	SHEET 38a OF 90

TRAFFIC CONTROL NOTES

1. THE TEMPORARY DETOUR LAYOUT SHOWN ON SHEET 40 IS TO BE USED AS AN EXAMPLE OF THE MINIMUM REQUIREMENTS FOR TWO-WAY TRAFFIC CONTROL. MODIFICATION OF, OR ADDITIONS TO, THE TRAFFIC CONTROL DEVICES SHOWN MAY BE REQUIRED BY THE RESIDENT ENGINEER BASED ON FIELD CONDITIONS.
2. THE CONTRACTOR SHALL FURNISH FLAG PERSONS AT THE DIRECTION OF THE ENGINEER AND PROVIDE THE APPROPRIATE SIGNING FOR THEIR PROTECTION. REFER TO STD.E-110 FOR DETAILS. ANY SUCH SIGNING SHALL BE COVERED OR REMOVED WHEN FLAG PEOPLE ARE NO LONGER CONTROLLING TRAFFIC.
3. WHERE EXISTING PAVEMENT MARKINGS ARE NOT APPROPRIATE TO THE MOVEMENT OF TRAFFIC THROUGH THE CONSTRUCTION AREA, THEY SHALL BE REMOVED IN AN APPROVED MANNER. TEMPORARY PAVEMENT MARKINGS SHALL BE APPLIED AS CALLED FOR ON THE PLANS OR AS DIRECTED BY THE ENGINEER.
4. REFLECTIVE PLASTIC DRUMS MAY BE SUBSTITUTED FOR TEMPORARY TRAFFIC BARRIER UNLESS ONE OF THE FOLLOWING CONDITIONS EXIST:
 - A. THE BRIDGE DECK IS REMOVED,
 - B. THE BRIDGE RAIL IS REMOVED, OR
 - C. IN THE JUDGEMENT OF THE RESIDENT ENGINEER, TEMPORARY TRAFFIC BARRIER IS NEEDED.
5. ANY FILL REQUIRED TO EXTEND THE TEMPORARY TRAFFIC BARRIER OUTSIDE THE CLEAR ZONE SHALL BE NEATLY PLACED AND COMPACTED FOR THE SUPPORT OF THE BARRIER AND SHALL BE PROVIDED WITH ADEQUATE COVER TO PREVENT EROSION. THE RESIDENT ENGINEER SHALL APPROVE THE FILL MATERIAL PRIOR TO PLACEMENT. SIDE SLOPES OF THE FILL SHALL BE NO STEEPER THAN 1:4.
6. ANY EXCAVATION REQUIRED TO EXTEND THE TEMPORARY TRAFFIC BARRIER SHALL BE LIMITED TO THE POINT AT WHICH THE END OF BARRIER IS FULLY BURIED OR THE CLEAR ZONE LIMIT, WHICHEVER IS SHORTER. ONCE THE BARRIER HAS BEEN PLACED, IT SHALL BE PROPERLY BACKFILLED TO PROVIDE A SMOOTH CONTINUOUS TRANSITION FROM THE EMBANKMENT TO THE BARRIER.
7. ALL TEMPORARY FILL OR EXCAVATION REQUIRED TO INSTALL TEMPORARY BARRIER SHALL BE REMOVED OR REPLACED TO THE PRE-CONSTRUCTION CONDITION AFTER THE BARRIER IS NO LONGER REQUIRED FOR A PARTICULAR PHASE OF CONSTRUCTION.

ARCHAEOLOGY CONSTRAINT NOTES

1. NO GRUBBING WILL BE ALLOWED IN THE GENERAL AREA OF THE TEMPORARY DETOUR ON THE WEST SIDE OF THE RIVER. THE GRASS AND BRUSHES CAN BE MOWED OR CUT DOWN WITHOUT PULLING UP THE ROOTS.
2. THERE SHALL BE NO TOPSOIL REMOVAL, GRADING, SCRAPING, CUTTING, FILLING, STOCKPILING, LOGGING OR ANY OTHER TYPE OF GROUND DISTURBANCE IN THE ARCHAEOLOGICALLY SENSITIVE AREAS.
3. THE VTRANS ARCHAEOLOGIST SHALL BE PRESENT TO MONITOR AND ASSURE PROPER PROCEDURE TO BURY THE HISTORIC ARCHAEOLOGICAL SITE BEFORE THE START OF CONSTRUCTION OF THE TEMPORARY DETOUR ON THE WEST SIDE OF THE RIVER.
4. AN ADDITIONAL 500 SQUARE METERS OF ITEM 649.31, "GEOTEXTILE UNDER STONE FILL" HAS BEEN PROVIDED TO COVER THE ARCHAEOLOGICALLY SENSITIVE SITE AREA. THIS FABRIC MUST BE DIRECTLY LAID OVER THE SURFACE VEGETATION AND THEN CLEAN FILL MUST BE PLACED ON TOP UNDER THE SUPERVISION OF A VTRANS ARCHAEOLOGIST. THIS MUST BE DONE FIRST BEFORE THE TEMPORARY DETOUR CAN BE CONSTRUCTED OVER THESE LAYERS.
5. WHEN CONSTRUCTION IS COMPLETED THE CONTRACTOR MUST COORDINATE WITH A VTRANS ARCHAEOLOGIST TO MAKE SURE THAT PERSON IS PRESENT WHEN THE FILL IS REMOVED FROM THE TOP OF THE GEOTEXTILE FABRIC AND THE SITE IS RETURNED TO ITS ORIGINAL CONDITION BEFORE CONSTRUCTION WAS STARTED.

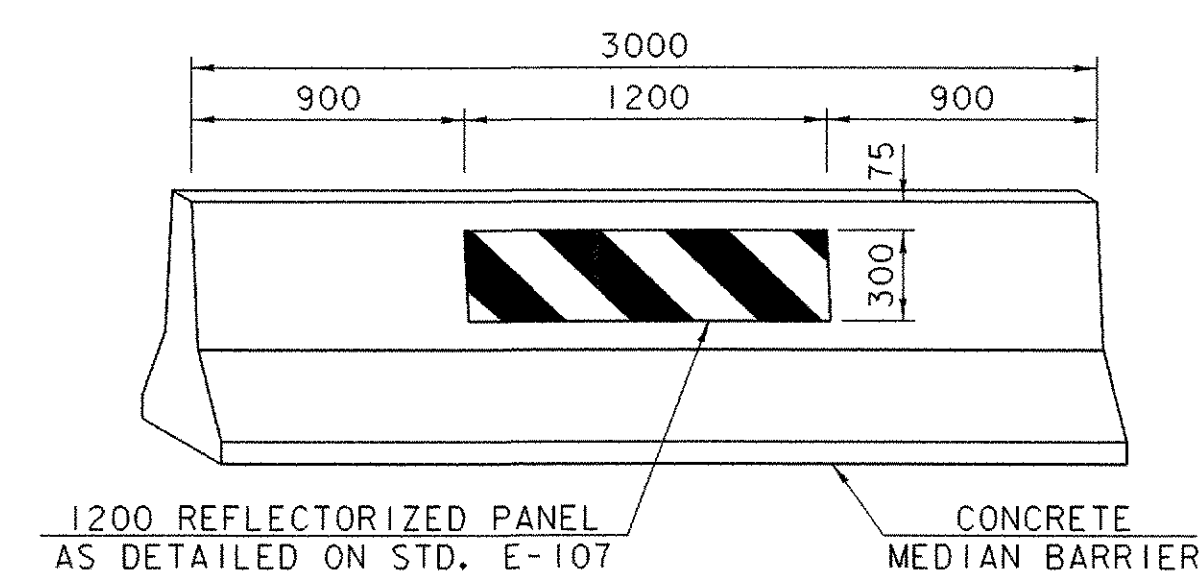

TEMPORARY TRAFFIC BARRIER NOTES

1. THE PANEL SHOWN IS ORIENTATED FOR TRAFFIC PASSING TO THE RIGHT.
2. THE PANEL SHALL BE ATTACHED TO THE CONCRETE MEDIAN BARRIER IN A SECURE FASHION.
3. ALL BARRIER PLACED IN TAPERS SHALL BE PROVIDED WITH A REFLECTORIZED PANEL AS SHOWN. THE PANEL SHALL BE ORIENTATED IN THE PROPER DIRECTION (RIGHT OR LEFT) BASED ON THE APPROACHING TRAFFIC.
4. BARRIER SECTIONS MAY BE MOVED DURING WORKING HOURS TO PROVIDE ACCESS TO THE WORKSITE. HOWEVER, THEY MUST BE REPLACED FOR NON-WORK PERIODS.

SHEET NAME:	TEMPORARY DETOUR DETAILS	
PROJECT NAME:	LEICESTER	HIGHWAY NO.: FAS 0160
PROJECT NUMBER:	BRF 0160(3)S	BRIDGE NO.: 6
		OVER: OTTER CREEK
FILE NAME:	95j288\Structures\sj288trc.dgn	PLOT DATE: 17-AUG-2005
PROJECT MANAGER:	R. R. WHITCOMB	DRAWN BY: G. ROY
DESIGNED BY:	C. CARLSON	IPARM NAME: sj288+dd.1
BRIDGE SHEET NUMBER:		SHEET 39 OF 90

LEGEND


- ◊ REFLECTORIZED PLASTIC DRUM
- ▬ TEMPORARY TRAFFIC BARRIER
- TYPE III BARRICADES (SEE STD.E-107A)
- ⊠ TYPE III BARRICADES (MOD.) (SEE STD.E-107A)
- /// REMOVAL OF EXISTING PAVEMENT MARKINGS
- ▭ USE SALVAGED SIGNS FOR TEMPORARY PLACEMENT

TEMPORARY DETOUR SHALL BE PAVED WITH 50mm BITUMINOUS CONCRETE PAVEMENT WITH COST TO BE INCIDENTAL TO ITEM 528.11, "TWO-WAY TEMPORARY BRIDGE".

TEMPORARY TRAFFIC BARRIER
 (REMAINDER OF BARRIER SHALL BE INCIDENTAL TO ITEM 528.11, "TWO-WAY TEMPORARY BRIDGE")
 STA. I+032.0 LT. - STA. I+084.8 LT.
 STA. I+051.5 RT. - STA. I+084.8 LT.
 STA. I+142.3 LT. - STA. I+149.1 RT.

TEMPORARY RELOCATION OF MAILBOX
 FROM STA. I+045.6 LT. TO STA. I+015.0 LT.

NOTE A:
 THE EXPOSED END OF THE TEMPORARY BARRIER SHALL BE PLACED BEYOND THE "CLEAR ZONE" OR PROTECTED BY AN APPROPRIATE CRASH CUSHION OR IMPACT ATTENUATOR AS OUTLINED IN AASHTO'S "ROAD SIDE DESIGN GUIDE".

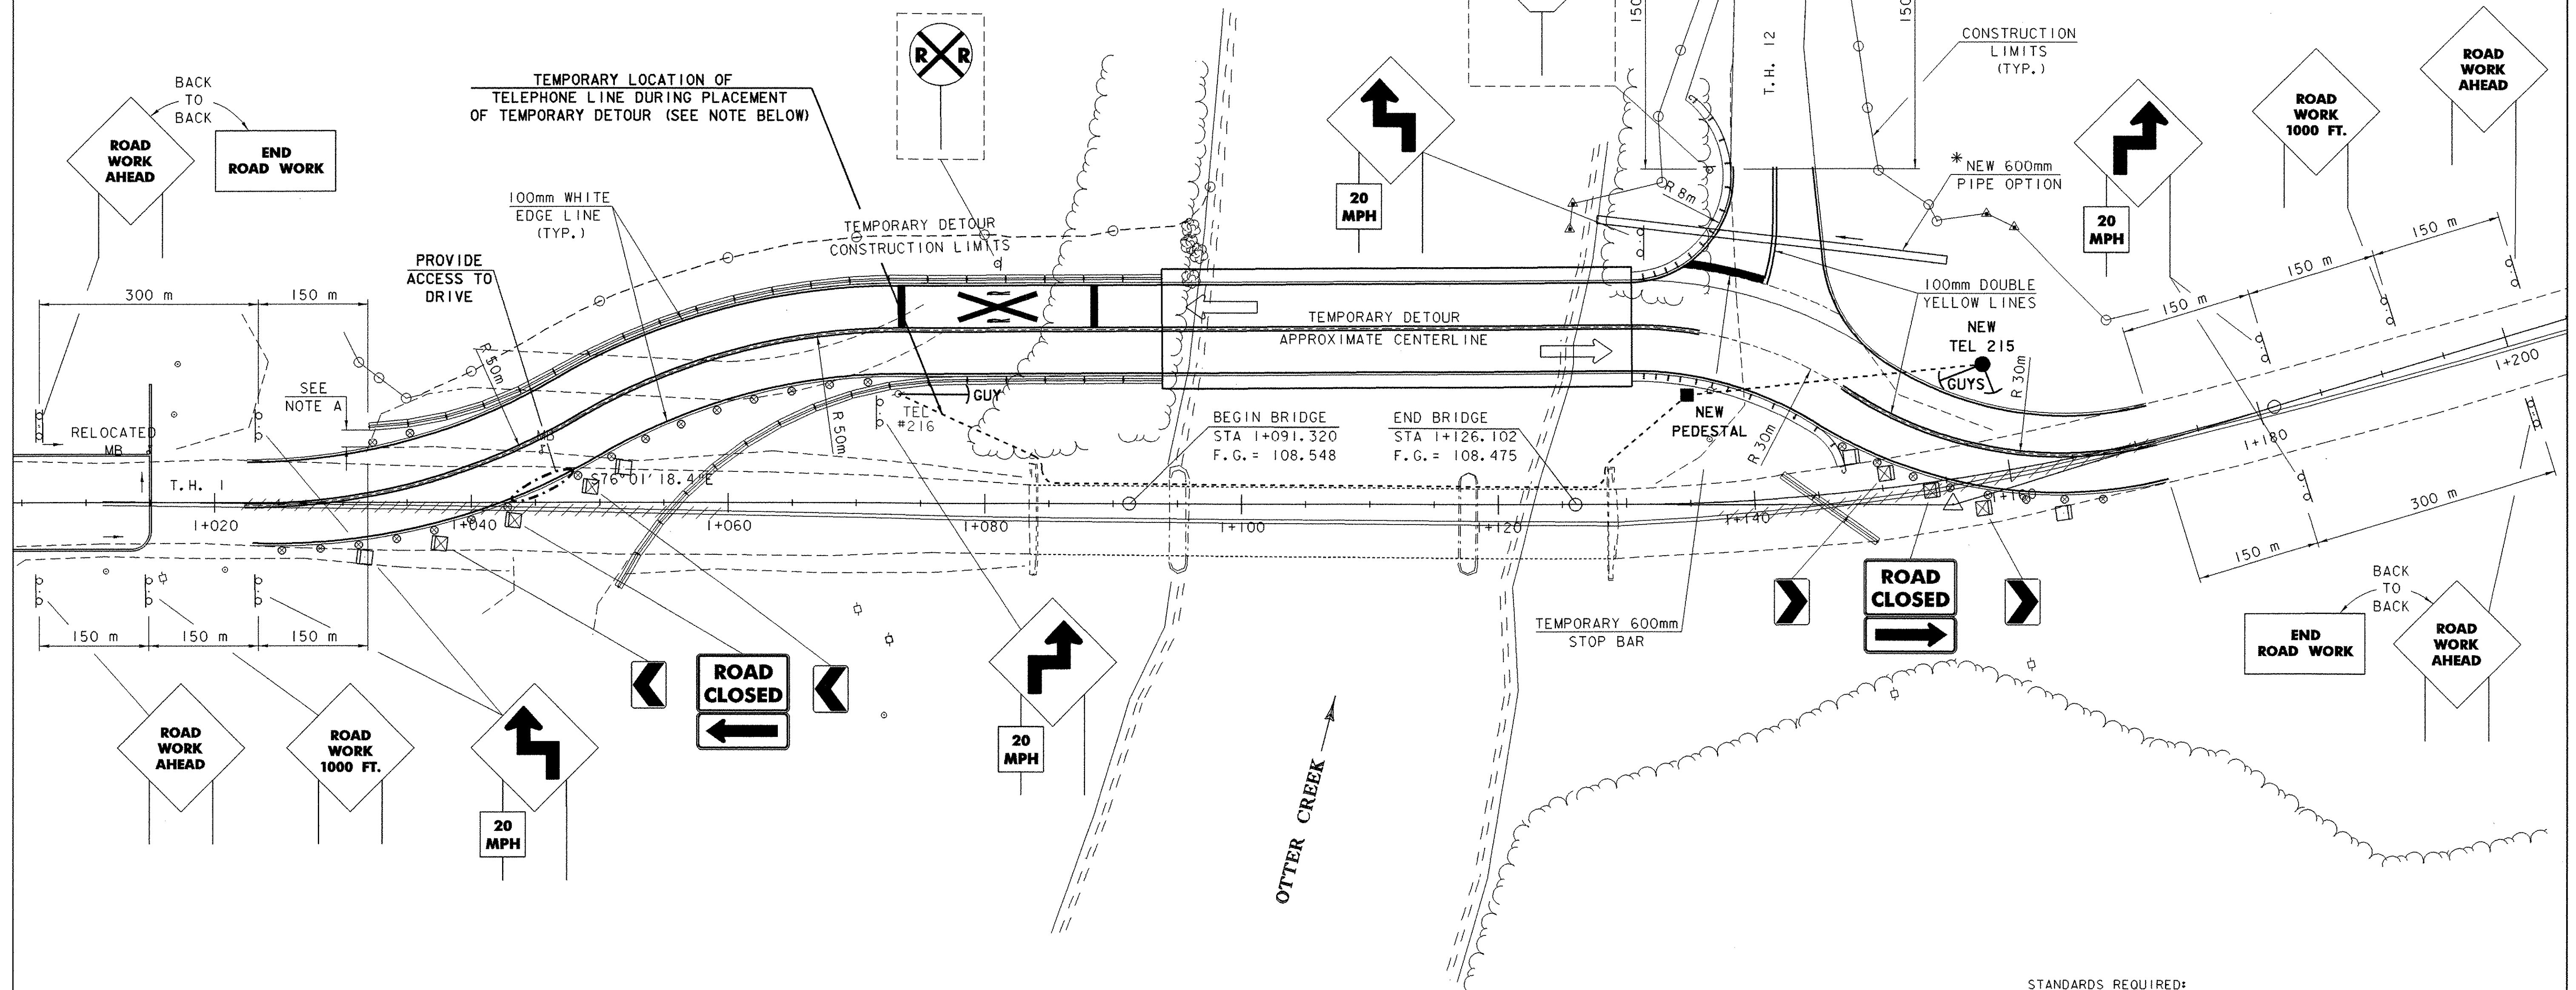

* NEW 600mm PIPE OPTION SHALL BE PLACED BEFORE EAST END OF DETOUR IS CONSTRUCTED.

TEMPORARY LOCATION OF TELEPHONE LINE DURING PLACEMENT OF TEMPORARY DETOUR (SEE NOTE BELOW)


PROVIDE ACCESS TO DRIVE

BEGIN BRIDGE STA I+091.320 F.G. = 108.548
 END BRIDGE STA I+126.102 F.G. = 108.475

TELEPHONE UTILITY NOTE:

PRIOR TO THE INSTALLATION OF THE TEMPORARY BRIDGE, THE TELEPHONE COMPANY WILL PLACE NEW POLE #215 AND A CONDUIT UNDER JERUSALEM ROAD. THE TELEPHONE LINE WILL RUN DOWN POLE #215, THROUGH THE CONDUIT, BE TEMPORARILY ATTACHED TO THE EXISTING BRIDGE AND LAID ON THE GROUND TO EXISTING POLE #216. EXTRA SLACK WILL BE LEFT IN THE LINE SO THAT IT CAN BE ATTACHED TO THE TEMPORARY BRIDGE AND PLACED OUT OF THE WAY DURING NEW CONSTRUCTION ACTIVITIES. THE CONTRACTOR SHALL NOTIFY THE TELEPHONE COMPANY WHEN THE TEMPORARY BRIDGE IS IN PLACE AND THE LINE IS TO BE MOVED FROM THE EXISTING TO THE TEMPORARY BRIDGE. THE CONTRACTOR WILL BE RESPONSIBLE FOR PROTECTING THE LINE DURING CONSTRUCTION AND FOR ANY REPAIR COSTS IF DAMAGE DOES OCCUR.

STANDARDS REQUIRED:
 E-100, E-101, E-102, E-102A, E-106, E-107, E-107A, E-121, E-150, E-152, E-190

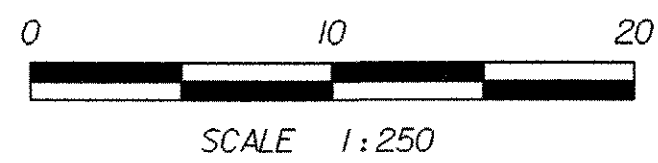

SHEET NAME: TEMPORARY DETOUR LAYOUT	
PROJECT NAME: LEICESTER	HIGHWAY NO.: FAS 0160
PROJECT NUMBER: BRF 0160(3)S	BRIDGE NO.: 6
	OVER: OTTER CREEK
FILE NAME: 95j288\structures\sj288trc.dgn	PLOT DATE: 17-AUG-2005
PROJECT MANAGER: R. R. WHITCOMB	DRAWN BY: G. ROY
DESIGNED BY: C. CARLSON	IPARM NAME: sj288+d.l1
BRIDGE SHEET NUMBER:	SHEET 40 OF 90

SOIL CLASSIFICATION

AASHTO	
A1	Gravel and Sand
A3	Fine Sand
A2	Silty or Clayey Gravel and Sand
A4	Silty Soil - Low Compressibility
A5	Silty Soil - Highly Compressible
A6	Clayey Soil - Low Compressibility
A7	Clayey Soil - Highly Compressible

ROCK QUALITY DESIGNATION

R.O.D. (%)	ROCK DESCRIPTION
<25	Very Poor
25 to 50	Poor
51 to 75	Fair
76 to 90	Good
>90	Excellent

SHEAR STRENGTH

UNDRAINED SHEAR STRENGTH IN kPa	CONSISTENCY
<12	Very Soft
12-24	Soft
24-48	Med. Stiff
48-96	Stiff
96-192	Very Stiff
>192	Hard


CORRELATION GUIDE OF "N" TO DENSITY/CONSISTENCY

DENSITY (GRANULAR SOILS)		CONSISTENCY (COHESIVE SOILS)	
N	DESCRIPTIVE TERM	N	DESCRIPTIVE TERM
<5	Very Loose	<2	Very Soft
5-10	Loose	2-4	Soft
11-24	Med. Dense	5-8	Med. Stiff
25-50	Dense	9-15	Stiff
>50	Very Dense	16-30	Very Stiff
		31-60	Hard
		>60	Very Hard


COMMONLY USED SYMBOLS

▼	Water Elevation
⊕	Standard Penetration Boring
⊕	Auger Boring
⊕	Rod Sounding
S	Sample
N	Standard Penetration Test
	Blow Count Per 300 mm For:
	50.8 mm O.D. Sampler
	35.0 mm I.D. Sampler
	Hammer Weight Of 63.5 kg.
	Hammer Fall Of 762 mm
VS	Field Vane Shear Test
US	Undisturbed Soil Sample
B	Blast
DC	Diamond Core
MD	Mud Drill
WA	Wash Ahead
HSA	Hollow Stem Auger
AX	Core Size 30.1mm
BX	Core Size 42.0 mm
NX	Core Size 54.7 mm
M	Double Tube Core Barrel Used
LL	Liquid Limit
PL	Plastic Limit
PI	Plasticity Index
NP	Non Plastic
w	Moisture Content (Dry Wgt. Basis)
D	Dry
M	Moist
MTW	Moist To Wet
W	Wet
Sat	Saturated
Bo	Boulder
Gr	Gravel
Sa	Sand
Si	Silt
Cl	Clay
HP	Hardpan
Le	Ledge
NLTD	No Ledge To Depth
CNPF	Can Not Penetrate Further
TLOB	To Ledge Or Boulder
NR	No Recovery
Rec.	Recovery
%Rec.	Percent Recovery
ROD	Rock Quality Designation
CBR	California Bearing Ratio
<	Less Than
>	Greater Than
R	Refusal (N > 100)

COLOR			
blk	Black	pnk	Pink
bl	Blue	pu	Purple
brn	Brown	rd	Red
dk	Dark	tn	Tan
gry	Gray	wh	White
gn	Green	yel	Yellow
lt	Light	mtc	Multicolored
or	Orange		

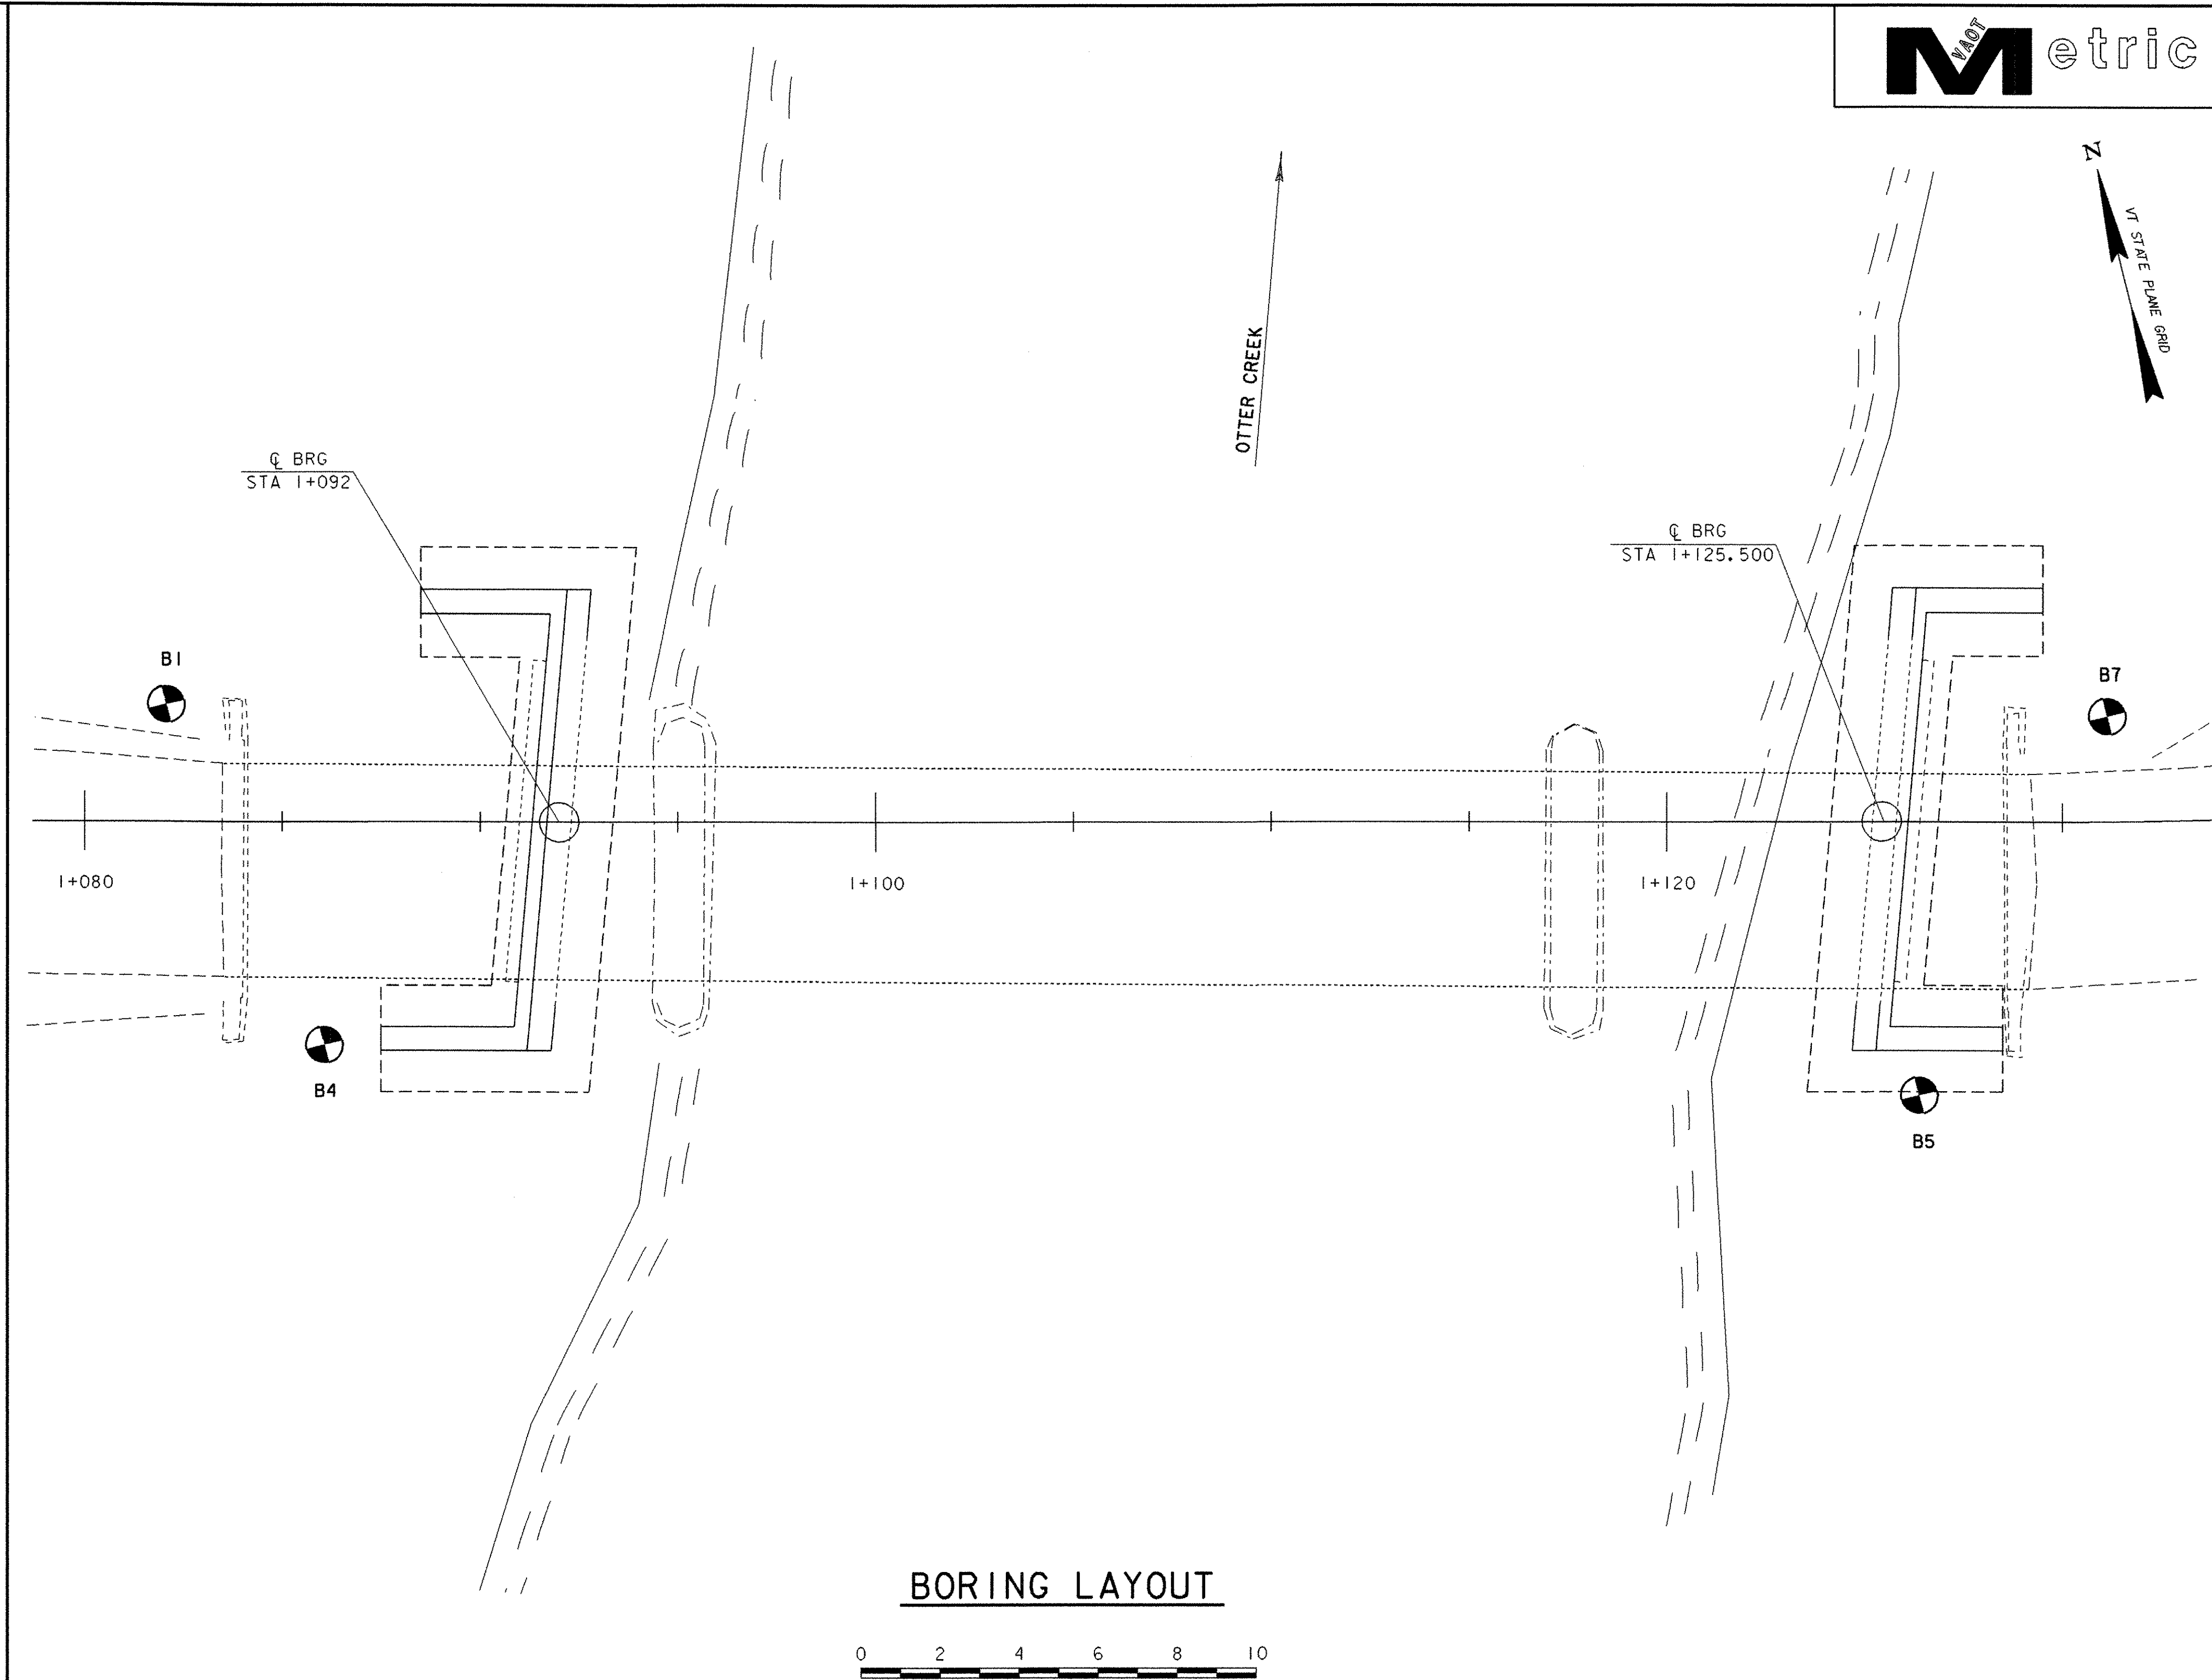

BORING LAYOUT

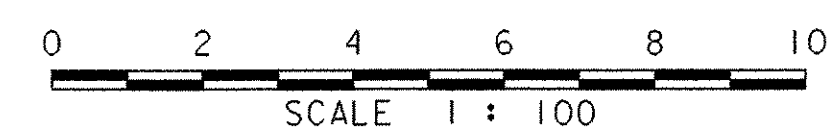

DEFINITIONS (AASHTO)

- BEDROCK (LEDGE)** - Rock in its native location of indefinite thickness.
- BOULDER** - A rock fragment with an average dimension > 304.8 mm.
- COBBLE** - Rock fragments with an average dimension between 76.2 and 304.8 mm.
- GRAVEL** - Rounded particles of rock < 76.2 mm and > 2 mm (#10 sieve).
- SAND** - Particles of rock < 2 mm (#10 sieve) and > 75 μm (#200 sieve).
- SILT** - Soil < 75 μm (#200 sieve), non or slightly plastic and exhibits no strength when air-dried.
- CLAY** - Fine grained soil, exhibits plasticity when moist and considerable strength when air-dried.
- VARVED** - Alternate layers of silt and clay.
- HARDPAN** - Extremely dense soil, cemented layer, not softened when wet.
- MUCK** - Soft organic soil (containing > 10% organic material).
- MOISTURE CONTENT** - Weight of water divided by dry weight of soil.
- FLOWING SAND** - Granular soil so saturated (loose) that it flows into drill casing during extraction of wash rod.
- STRIKE** - Angle from magnetic north to line of intersection of bed with a horizontal plane.
- DIP** - Inclination of bed with a horizontal plane.

GENERAL NOTES

- The subsurface explorations shown herein were made between 07/30/98 and 08/27/98 by the Agency.
- Soil and rock classifications, properties and descriptions are based on engineering interpretation from available subsurface information by the Agency and may not necessarily reflect actual variations in subsurface conditions that may be encountered between individual boring or sample locations.
- Observed water levels and/or conditions indicated are as recorded at the time of exploration and may vary according to the prevailing rainfall, methods of exploration and other factors.
- Engineering judgement was exercised in preparing the subsurface information presented herein. Analysis and interpretation of subsurface data was performed and estimated purposes. Presentation of the information in the Contract is intended to provide the Contractor access to the same data available to the Agency. The subsurface information is presented in good faith and is not intended as a substitute for personal investigation, independent interpretation, independent analysis or judgement by the Contractor.
- Pictorial structure details shown on the boring plan layout or soils profile are for illustrative purposes only and may not accurately portray final contract details.
- Terminology used on boring logs to describe the hardness, degree of weathering, and spacing of fractures, joints and other discontinuities in the bedrock is defined in the AASHTO Manual on Subsurface Investigations, 1988.

BORING CHART

HOLE NO.	STATION	OFFSET (m)	GROUND ELEV.	TLOB ELEV.
B-1	1+082	2.690 LT	105.561	62.561
B-4	1+086	5.639 RT	105.186	59.986
B-5	1+126	6.943 RT	105.671	76.401
B-7	1+131	2.662 LT	106.454	73.754


SHEET NAME: BORING LAYOUT	
PROJECT NAME: LEICESTER	HIGHWAY NO.: FAS 0160
PROJECT NUMBER: BRF 0160(3)S	BRIDGE NO.: 6
	OVER: OTTER CREEK
FILE NAME: 95J288\Structures\sj288bor.dgn	PLOT DATE: 17-AUG-2005
PROJECT MANAGER: R. R. WHITCOMB	DRAWN BY: J. GILMORE
DESIGNED BY: C. CARLSON	IPARM NAME: sj088bor.1
BRIDGE SHEET NUMBER:	SHEET 41 OF 90

STATE OF VERMONT AGENCY OF TRANSPORTATION MATERIALS & RESEARCH DIVISION SUBSURFACE INFORMATION										HOLE NO.: B-1 SHEET 1 OF 3 DATE STARTED: 7/30/98 DATE COMPLETED: 8/27/98	
PROJECT NAME: LEICESTER SITE NAME: BR-6 STATION: I+082.10 GROUND EL.: 105.561			PROJECT NUMBER: BRF 0160 (3) S SITE NO.: TH-1 OFFSET: -2.960 G.W. DEPTH:							BORING RIG: UNI-MOG BORING TYPE: WASH BORE SAMPLE TYPE: SPLIT BARREL	
BORING CREW CREW CHIEF: TALLMAN DRILLER: GAMMELL LOGGER: MCGLYNN ADDITIONAL CREW:			BORING RIG: UNI-MOG BORING TYPE: WASH BORE SAMPLE TYPE: SPLIT BARREL								
DEPTH	SYMBOL	CLASSIFICATION OF MATERIALS (Description)	BLOWS PER 0.3 m	M.C. %	GRAVEL %	SAND %	FINES %	LL	PI		
		No Rec., Rock in end of sampler	4								
		A-4, SaSi, gry, MTW, Rec. = 0.51m	4	48.2	0.3	37.4	62.3				
		Rec. = 0.20m, Wood only, No sample sent to lab.	4								
5		A-2-4, SiSa, gry, MTW, Rec. = 0.42m	6	43	0.2	65.6	34.2				
		A-4, SaSi with Trace of Organics (5.64%), dk/gry, Sat, Rec. = 0.45m	2	73.1	0.2	45.6	54.2				
		A-4, SaSi with Trace of Organics (6.09%), dk/gry, Wet, Rec. = 0.56m	5	70	0.1	42.1	57.8				
10		A-4, SaSi with Little Organics (10.33%), Dk/gry-brn, Sat, Rec. = 0.55m	7	95.6	2.9	43.5	53.6				
		A-4, SaSi with Trace of Organics (8.44%), Dk/gry-brn, Sat, Rec. = 0.57m	8	71.7	12.1	41	46.9				
		13.50m-14.10m VS = 315/50 psf									
	A.7.5	A-4, Si with Wood (visual), dk/brn-gry, Sat, Rec. = 0.15m	5	52.4	0.7	1.4	97.9	56	28		
		A-7-5, Clay, gry, Wet, Rec. = 0.29m	WH	61.8		0.2	99.8				
	A.7.6	A-7-6, Clay (visual), gry, Wet, Rec. = 0.50m									
		14.50m-15.10m VS = 200/110 psf									
GEOLOGISTS REPORT: SEE SHEET 3											

BOTTOM OF FOOTING
ELEV 101.500

STATE OF VERMONT AGENCY OF TRANSPORTATION MATERIALS & RESEARCH DIVISION SUBSURFACE INFORMATION										HOLE NO.: B-1 SHEET 2 OF 3 DATE STARTED: 7/30/98 DATE COMPLETED: 8/27/98	
PROJECT NAME: LEICESTER SITE NAME: BR-6 STATION: I+082.10 GROUND EL.: 105.561			PROJECT NUMBER: BRF 0160 (3) S SITE NO.: TH-1 OFFSET: -2.960 G.W. DEPTH:							BORING RIG: UNI-MOG BORING TYPE: WASH BORE SAMPLE TYPE: SPLIT BARREL	
BORING CREW CREW CHIEF: TALLMAN DRILLER: GAMMELL LOGGER: MCGLYNN ADDITIONAL CREW:			BORING RIG: UNI-MOG BORING TYPE: WASH BORE SAMPLE TYPE: SPLIT BARREL								
DEPTH	SYMBOL	CLASSIFICATION OF MATERIALS (Description)	BLOWS PER 0.3 m	M.C. %	GRAVEL %	SAND %	FINES %	LL	PI		
15		16.00m-16.60m VS = 550/105 psf									
	A.7.6	A-7-6, Clay (visual), gry, Wet, Rec. = 0.37m	WH	62.5		0.2	99.8				
	A.7.6	A-7-6, Clay (visual), gry, Sat, Rec. = 0.42m	WH	75		0.4	99.6				
		17.50m-18.10m VS = 550/25 psf									
	A.7.6	A-7-6, Clay (visual), gry, Sat, Rec. = 0.39m	WH	75.6		0.2	99.8				
		19.50m-20.10m VS = 340/50 psf									
20		A-7-6, Clay, gry, Sat, Rec. = 0.37m	WH	70.7		0.2	99.8	68	39		
		21.50m-22.10m VS = 390/100 psf									
	A.7.6	A-7-6, Clay (visual), gry, Wet, Rec. = 0.20m	WH	69.6		0.3	99.7				
		23.50m-24.10m VS = 340/100 psf									
		No Rec.	WH								
25		25.50m-26.10m VS = 600/85 psf									
	A.7.6	A-7-6, Clay (visual), gry, MTW, Rec. = 0.19m	WH	45.9		0.2	99.8				
		27.50m-28.10m VS = 600/85 psf									
	A.7.6	A-7-6, Clay, gry, Wet, Rec. = 0.42m	WH	66.8		0.3	99.7	54	31		
		29.50m-30.10m VS = 620/150 psf									
GEOLOGISTS REPORT: SEE SHEET 3											

STATE OF VERMONT AGENCY OF TRANSPORTATION MATERIALS & RESEARCH DIVISION SUBSURFACE INFORMATION										HOLE NO.: B-1 SHEET 3 OF 3 DATE STARTED: 7/30/98 DATE COMPLETED: 8/27/98	
PROJECT NAME: LEICESTER SITE NAME: BR-6 STATION: I+082.10 GROUND EL.: 105.561			PROJECT NUMBER: BRF 0160 (3) S SITE NO.: TH-1 OFFSET: -2.960 G.W. DEPTH:							BORING RIG: UNI-MOG BORING TYPE: WASH BORE SAMPLE TYPE: SPLIT BARREL	
BORING CREW CREW CHIEF: TALLMAN DRILLER: GAMMELL LOGGER: MCGLYNN ADDITIONAL CREW:			BORING RIG: UNI-MOG BORING TYPE: WASH BORE SAMPLE TYPE: SPLIT BARREL								
DEPTH	SYMBOL	CLASSIFICATION OF MATERIALS (Description)	BLOWS PER 0.3 m	M.C. %	GRAVEL %	SAND %	FINES %	LL	PI		
30		31.50m-32.10m VS = 540/210 psf									
	A.7.6	A-7-6, Clay, gry, Wet, Rec. = 0.37m	WH	54.9		0.5	99.5	58	33		
	A.7.6	A-7-6, Clay (visual), gry, Wet, Rec. = 0.23m	WH	52.6		0.3	99.7				
		33.50m-34.10m VS = 740/115 psf									
	A.7.5	A-7-5, Clay (visual), gry, Wet, Rec. = 0.37m	WH	52.3		0.5	99.5				
35		35.50-36.50m VS = 1000/200 psf									
		A-4, Cisi, gry, Wet, Rec. = 0.26m	WH	50.6		0.4	99.6	27	8		
		37.50m-38.10m VS = 800/185 psf									
	A.7.5	A-7-5, Clay (visual), gry, Wet, Rec. = 0.60m	WH	59.1		0.6	99.4				
		39.50m-40.10m VS = 540/100 psf									
40		A-4, Cisi (visual), gry, MTW, Rec. = 0.22m		38.1		1.4	98.6				
		A-4, Si, gry, MTW, Rec. = 0.22m		23.7		5.9	94.1				
		A-4, Si, gry, MTW, Rec. = 0.50m	WH	24.9		2.9	97.1				
		Top of bedrock @ 43.0m									
		Run #1: BXMD, 43.0m-44.5m, Rec. = 1.29m, See Geologist's Report.	RUN	RECZ	RODZ	Dip°					
		Run #2: BXMD, 44.5m-46.0m, Rec. = 1.55m, See Geologist's Report.	2	100	96						
45											
Hole stopped @ 46.0m											
GEOLOGISTS REPORT: Run #1: Buff to white marble, Very hard, Unweathered, Competent. Run #2: Same as Run #1.											

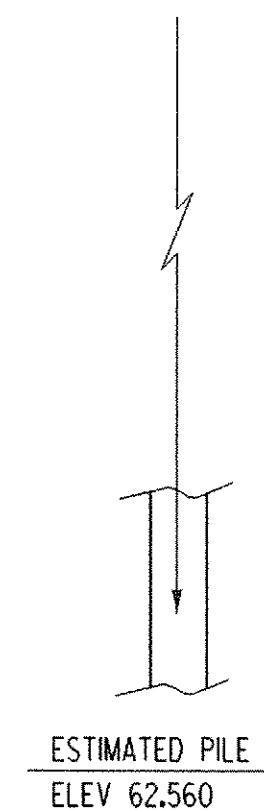

SHEET NAME: BORING LOGS #1	
PROJECT NAME: LEICESTER	HIGHWAY NO.: FAS 0160
PROJECT NUMBER: BRF 0160(3)S	BRIDGE NO.: 6
	OVER: OTTER CREEK
FILE NAME: 95j288\Structures\sj288bor.dgn	PLOT DATE: 17-AUG-2005
PROJECT MANAGER: R. R. WHITCOMB	DRAWN BY: J. TOUCHETTE
DESIGNED BY: C. CARLSON	IPARM NAME: sj088br1.1
BRIDGE SHEET NUMBER:	SHEET 42 OF 90

STATE OF VERMONT AGENCY OF TRANSPORTATION MATERIALS & RESEARCH DIVISION SUBSURFACE INFORMATION		HOLE NO.: B-4 SHEET 1 OF 4 DATE STARTED: 7/15/98 DATE COMPLETED: 7/22/98							
PROJECT NAME: LEICESTER SITE NAME: BR-6 STATION: I+086J0 GROUND EL.: 105.86		PROJECT NUMBER: BRF 0160 (3) S SITE NO.: TH-1 OFFSET: 5.639 G.W. DEPTH:							
BORING CREW CREW CHIEF: TALLMAN DRILLER: GAMMELL LOGGER: HOLT ADDITIONAL CREW:		BORING RIG: UNI-MOG BORING TYPE: WASH BORE SAMPLE TYPE: SPLIT BARREL							
DEPTH	SYMBOL	CLASSIFICATION OF MATERIALS (Description)	BLOWS PER 0.3 m	M.C. %	GRAVEL %	SAND %	FINES %	LL	PI
		A-4, SaSi, brn, MTW, Rec. = 0.38m	3	35.5		28.6	71.4		
		A-4, SaSi, gry/brn, MTW, Rec. = 0.48m	5	41.6		31.2	68.8		
5		A-4, SaSi Trace of Organics (3.97%), gry/brn, Wet, Rec. = 0.43m	3	52.4		42.7	57.3		
		A-2-4, SiSa, gry, MTW, Rec. = 0.36m	8	39.9	0.3	70.3	29.4		
		A-4, SaSi Trace of Organics (6.38%), Dk/brn, Wet, Rec. = 0.60m	6	69.1		25.5	74.5		
		A-4, SaSi Trace of Organics (5.75%), Dk/brn, Sat, Rec. = 0.60m	8	70		26	74		
10		A-4, SaSi Little Organics (11.31%), Dk/brn, Sat, Rec. = 0.60m	10	84.1	0.3	30.1	69.6		
		A-8, Organic Silt (21.11%), Dk/brn, Sat, Rec. = 0.60m	7	151	3	14.8	82.2		
	A.7.6	A-7-6, Clay, gry, MTW, Rec. = 0.60m	2	45.7		0.7	99.3	63	34
GEOLOGISTS REPORT: SEE SHEET 4									

STATE OF VERMONT AGENCY OF TRANSPORTATION MATERIALS & RESEARCH DIVISION SUBSURFACE INFORMATION		HOLE NO.: B-4 SHEET 2 OF 4 DATE STARTED: 7/15/98 DATE COMPLETED: 7/22/98							
PROJECT NAME: LEICESTER SITE NAME: BR-6 STATION: I+086J0 GROUND EL.: 105.86		PROJECT NUMBER: BRF 0160 (3) S SITE NO.: TH-1 OFFSET: 5.639 G.W. DEPTH:							
BORING CREW CREW CHIEF: TALLMAN DRILLER: GAMMELL LOGGER: HOLT ADDITIONAL CREW:		BORING RIG: UNI-MOG BORING TYPE: WASH BORE SAMPLE TYPE: SPLIT BARREL							
DEPTH	SYMBOL	CLASSIFICATION OF MATERIALS (Description)	BLOWS PER 0.3 m	M.C. %	GRAVEL %	SAND %	FINES %	LL	PI
15	A.7.6	A-7-6, Clay (visual), gry, Sat, Rec. = 0.35m	2	77.5					
		A-7-6, Clay (visual), gry, Sat, Rec. = 0.38m	WH	75.5					
	A.7.6	A-7-6, Clay, gry, Sat, Rec. = 0.42m	WH	71.2		0.8	99.2	71	42
	A.7.6	A-7-6, Clay (visual), gry, Wet, Rec. = 0.47m	WH	64.6					
20	A.7.6	A-7-6, Clay (visual), gry, Wet, Rec. = 0.42m	WH	64.4					
	A.7.6	A-7-6, Clay, gry, Wet, Rec. = 0.38m	WH	63.2		0.7	99.3	64	36
	A.7.6	A-7-6, Clay (visual), gry, Wet, Rec. = 0.60m	WH	68.3					
25	A.7.6	A-7-6, Clay (visual), gry, Wet, Rec. = 0.24m	WH	60.3					
	A.7.6	A-7-6, Clay, gry, Wet, Rec. = 0.21m	WH	66.9		1.2	98.8	64	36
	A.7.6	A-7-6, Clay (visual), gry, Wet, Rec. = 0.34m	WH	54.2					
GEOLOGISTS REPORT: SEE SHEET 4									

STATE OF VERMONT AGENCY OF TRANSPORTATION MATERIALS & RESEARCH DIVISION SUBSURFACE INFORMATION		HOLE NO.: B-4 SHEET 3 OF 4 DATE STARTED: 7/15/98 DATE COMPLETED: 7/22/98							
PROJECT NAME: LEICESTER SITE NAME: BR-6 STATION: I+086J0 GROUND EL.: 105.86		PROJECT NUMBER: BRF 0160 (3) S SITE NO.: TH-1 OFFSET: 5.639 G.W. DEPTH:							
BORING CREW CREW CHIEF: TALLMAN DRILLER: GAMMELL LOGGER: HOLT ADDITIONAL CREW:		BORING RIG: UNI-MOG BORING TYPE: WASH BORE SAMPLE TYPE: SPLIT BARREL							
DEPTH	SYMBOL	CLASSIFICATION OF MATERIALS (Description)	BLOWS PER 0.3 m	M.C. %	GRAVEL %	SAND %	FINES %	LL	PI
30	A.7.6	A-7-6, Clay (visual), gry, Wet, Rec. = 0.36m	WH	67.3					
	A.7.6	A-7-6, Clay, gry, Wet, Rec. = 0.14m	WH	53.4		0.8	99.2	62	35
	A.7.6	A-7-6, Clay (visual), gry, MTW, Rec. = 0.60m	WH	49.7					
35	A.7.6	A-7-6, Clay (visual), gry, Wet, Rec. = 0.21m	WH	62.2					
		A-4, SiSa, gry, MTW, Rec. = 0.49m	13	38.9		1.2	98.8	24	9
		A-6, Clay (visual), gry, Wet, Rec. = 0.60m	WH	68.5					
		A-6, SiCl, gry, MTW, Rec. = 0.52m	WH	40.7		0.8	99.2	38	17
40		A-4, Si, gry, MTW, Rec. = 0.50m	WH	24.6		3.8	96.2		
		No Sample, Boulder, Advanced casing to 43.2m							
		BXMDC, 43.2m-43.8m, Boulder, Advanced casing to 45.2m.							
GEOLOGISTS REPORT: SEE SHEET 4									


STATE OF VERMONT AGENCY OF TRANSPORTATION MATERIALS & RESEARCH DIVISION SUBSURFACE INFORMATION		HOLE NO.: B-4 SHEET 4 OF 4 DATE STARTED: 7/15/98 DATE COMPLETED: 7/22/98							
PROJECT NAME: LEICESTER SITE NAME: BR-6 STATION: I+086J0 GROUND EL.: 105.86		PROJECT NUMBER: BRF 0160 (3) S SITE NO.: TH-1 OFFSET: 5.639 G.W. DEPTH:							
BORING CREW CREW CHIEF: TALLMAN DRILLER: GAMMELL LOGGER: HOLT ADDITIONAL CREW:		BORING RIG: UNI-MOG BORING TYPE: WASH BORE SAMPLE TYPE: SPLIT BARREL							
DEPTH	SYMBOL	CLASSIFICATION OF MATERIALS (Description)	BLOWS PER 0.3 m	M.C. %	GRAVEL %	SAND %	FINES %	LL	PI
45		Run #1: BXMDC, 45.2m-46.4m, Rec. = 1.16m, See Geologist's Report.	1	97	25	70			
		Run #2: BXMDC, 46.4m-47.8m, Rec. = 1.30m, See Geologist's Report.	2	93	50	70			
		Hole stopped @ 47.80m							
50									
55									
GEOLOGISTS REPORT: Run #1: Numerous joints, Buff to white marble, Very hard, Poor ROD, Unweathered, Poor competency. Run #2: Numerous joints, Buff to white marble, Very hard, Unweathered, Fair competency.									




SHEET NAME: BORING LOGS #2	
PROJECT NAME: LEICESTER	HIGHWAY NO.: FAS 0160
PROJECT NUMBER: BRF 0160(3)S	BRIDGE NO.: 6
	OVER: OTTER CREEK
FILE NAME: 95J288\Structures\sj288bor.dgn	PLOT DATE: 17-AUG-2005
PROJECT MANAGER: R. R. WHITCOMB	DRAWN BY: J. TOUCHETTE
DESIGNED BY: C. CARLSON	IPARM NAME: sj088br2.1
BRIDGE SHEET NUMBER:	SHEET 43 OF 90

STATE OF VERMONT AGENCY OF TRANSPORTATION MATERIALS & RESEARCH DIVISION SUBSURFACE INFORMATION		HOLE NO.: B-5 SHEET 1 OF 2 DATE STARTED: 7/24/98 DATE COMPLETED: 7/28/98							
PROJECT NAME: LEICESTER SITE NAME: BR-6 STATION: 1426.40 GROUND EL.: 105.671		PROJECT NUMBER: BRF 0160 (3) S SITE NO.: TH-1 OFFSET: 6.943 G.W. DEPTH:							
BORING CREW CREW CHIEF: TALLMAN DRILLER: GAMMELL LOGGER: HOLT ADDITIONAL CREW:		BORING RIG: UNI-MOG BORING TYPE: WASH BORE SAMPLE TYPE: SPLIT BARREL							
DEPTH	SYMBOL	CLASSIFICATION OF MATERIALS (Description)	BLOWS PER 0.3 m	M.C. %	GRAVEL %	SAND %	FINES %	LL	PI
		A-4, SaSi, brn, MTW, Rec. = 0.31m	6	36.3	7.3	22	70.7		
		A-4, Si, brn, MTW, Rec. = 0.52m	6	29.7	0.1	19	80.9		
5		A-4, SiSa with Trace of Organics (3.20%), Lt/gry, Wet, Rec. = 0.56m	5	54.6	1.4	58.6	40		
		A-4, SiSa with Trace of Organics (4.18%), Lt/gry, MTW, Rec. = 0.53m	3	48.5	1.7	54.9	43.4		
		A-2-4, SiSa with Trace of Organics (4.18%), gry, MTW, Rec. = 0.49m	5	41	0.4	67	32.6		
		A-4, Si, Lt/gry, MTW, Rec. = 0.60m	4	27.4		8.3	91.7		
10		A-4, SaSi, Lt/gry, MTW, Rec. = 0.57m	3	31.1	0.1	34	65.9		
		A-4, SaSi, Lt/gry, MTW, Rec. = 0.43m	8	26.9		29.3	70.7		
		A-4, SaSi, Lt/gry, MTW, Rec. = 0.41m	7	29.9		45	55		
GEOLOGISTS REPORT: SEE SHEET 2									

BOTTOM OF FOOTING
ELEV 101.500

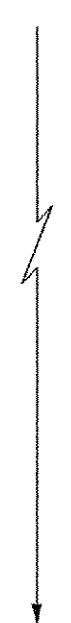

STATE OF VERMONT AGENCY OF TRANSPORTATION MATERIALS & RESEARCH DIVISION SUBSURFACE INFORMATION		HOLE NO.: B-5 SHEET 2 OF 2 DATE STARTED: 7/24/98 DATE COMPLETED: 7/28/98							
PROJECT NAME: LEICESTER SITE NAME: BR-6 STATION: 1426.40 GROUND EL.: 105.671		PROJECT NUMBER: BRF 0160 (3) S SITE NO.: TH-1 OFFSET: 6.943 G.W. DEPTH:							
BORING CREW CREW CHIEF: TALLMAN DRILLER: GAMMELL LOGGER: HOLT ADDITIONAL CREW:		BORING RIG: UNI-MOG BORING TYPE: WASH BORE SAMPLE TYPE: SPLIT BARREL							
DEPTH	SYMBOL	CLASSIFICATION OF MATERIALS (Description)	BLOWS PER 0.3 m	M.C. %	GRAVEL %	SAND %	FINES %	LL	PI
15	A.7.5	A-7-5, Clay, gry, Wet, Rec. = 0.60m	7	64.7			100	76	45
	A.7.5	A-7-5, Clay, gry, Wet, Rec. = 0.60m	WH	63.3			100	69	38
	A.7.6	A-7-6, Clay, gry, Sat, Rec. = 0.60m	WH	76.5			100	49	25
20	A.7.6	A-7-6, Clay (visual), gry, Wet, Rec. = 0.60m	WH	65.6		0.2	99.8		
	A.7.6	A-7-6, Clay (visual), gry, Wet, Rec. = 0.60m	WH	63.9		0.2	99.8		
	A.7.6	A-7-6, Clay, gry, Wet, Rec. = 0.60m	WH	63		0.2	99.8	63	36
	A.7.6	A-7-6, Clay (visual), gry, Wet, Rec. = 0.30m	WH	61		0.2	99.8		
25	A.7.6	A-7-6, Clay (visual), gry, Wet, Rec. = 0.60m	WH	58		0.3	99.7		
	A.7.6	A-7-6, Clay, gry, MTW, Rec. = 0.60m	WH	42.8		0.2	99.8	42	22
	A.7.6	A-7-6, Clay (visual), gry, Wet, Rec. = 0.60m	WH	67.4		0.8	99.2		
		Top of bedrock @ 29.27m							
30		Run #1: BXMDC, 29.27m-30.77m, Rec. = 1.47m, See Geologist's Report.	RUN	98	30	35			
		Run #2: BXMDC, 30.77m-32.27m, Rec. = 1.10m, See Geologist's Report.	RUN	73	40	35			
Hole stopped @ 32.27m									
GEOLOGISTS REPORT: Run #1: 29.27m-29.47m, Dark gray limestone, Hard, Unweathered, Competent. 29.47m-30.77m, Light gray limestone, Hard, Unweathered, Competent. Run #2: 30.77m-31.67m, Light gray limestone, Hard, Unweathered, Competent. 31.67m-32.27m, Pink shaley limestone, Hard, Unweathered, Competent.									

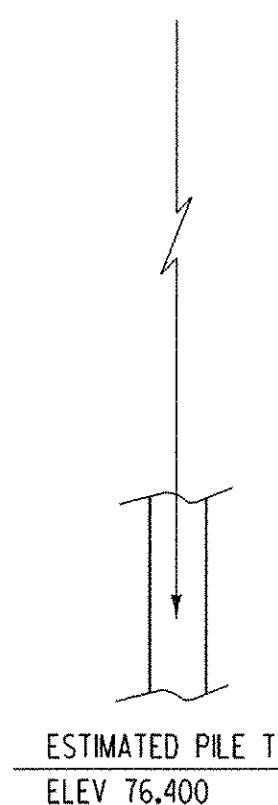

SHEET NAME: BORING LOGS #3	
PROJECT NAME: LEICESTER	HIGHWAY NO.: FAS 0160
PROJECT NUMBER: BRF 0160(3)S	BRIDGE NO.: 6
	OVER: OTTER CREEK
FILE NAME: 95J288\Structures\sj288bor.dgn	PLOT DATE: 17-AUG-2005
PROJECT MANAGER: R. R. WHITCOMB	DRAWN BY: J. TOUCHETTE
DESIGNED BY: C. CARLSON	IPARM NAME: sj088br3.1
BRIDGE SHEET NUMBER:	SHEET 44 OF 90

STATE OF VERMONT AGENCY OF TRANSPORTATION MATERIALS & RESEARCH DIVISION SUBSURFACE INFORMATION		HOLE NO.: B-7 SHEET 1 OF 3 DATE STARTED: 7/10/98 DATE COMPLETED: 7/15/98							
PROJECT NAME: LEICESTER SITE NAME: BR-6 STATION: 141310 GROUND EL.: 106.454		PROJECT NUMBER: BRF 0160 (3) S SITE NO.: TH-1 OFFSET: -2.662 G.W. DEPTH:							
BORING CREW CREW CHIEF: TALLMAN DRILLER: GAMMELL LOGGER: HOLT ADDITIONAL CREW:		BORING RIG: UNI-MOG BORING TYPE: WASH BORE SAMPLE TYPE: SPLIT BARREL							
DEPTH	SYMBOL	CLASSIFICATION OF MATERIALS (Description)	BLOWS PER 0.3 m	M.C. %	GRAVEL %	SAND %	FINES %	LL	PI
		A-2-4, SiSa, brn, Moist, Rec. = 0.26m	7	19.9	16.7	50.2	33.1		
		A-4, SaSi, brn, MTW, Rec. = 0.04m	4	49		29.7	70.3		
		A-4, SaSi, brn, MTW, Rec. = 0.40m	8	29.9	0.3	23.2	76.5		
		A-4, SiSa, gry, MTW, Rec. = 0.27m	7	34.8		51.5	48.5		
5		A-4, SaSi with Chopped Root (visual), blk, Wet, Rec. = 0.43m	4	65.2					
		A-4, SaSi with Chopped Root (visual), blk, Sat, Rec. = 0.45m	6	116					
		No Sample.	6						
		A-4, Si, gry, MTW, Rec. = 0.40m	9	30		2.1	97.9		
		No Sample.	7						
10		A-4, Si, gry, MTW, Rec. = 0.27m	6	29.7		18.6	81.4		
		A-4, SaSi, gry, MTW, Rec. = 0.56m	9	31		21.2	78.8		
		A-4, SaSi, gry, MTW, Rec. = 0.54m	11	26.7		31.1	68.9		
		A-4, SiSa, gry, MTW, Rec. = 0.47m	11	24.8		54.8	45.2		
GEOLOGISTS REPORT: SEE SHEET 3									

BOTTOM OF FOOTING
ELEV 101.500



STATE OF VERMONT AGENCY OF TRANSPORTATION MATERIALS & RESEARCH DIVISION SUBSURFACE INFORMATION		HOLE NO.: B-7 SHEET 2 OF 3 DATE STARTED: 7/10/98 DATE COMPLETED: 7/15/98							
PROJECT NAME: LEICESTER SITE NAME: BR-6 STATION: 141310 GROUND EL.: 106.454		PROJECT NUMBER: BRF 0160 (3) S SITE NO.: TH-1 OFFSET: -2.662 G.W. DEPTH:							
BORING CREW CREW CHIEF: TALLMAN DRILLER: GAMMELL LOGGER: HOLT ADDITIONAL CREW:		BORING RIG: UNI-MOG BORING TYPE: WASH BORE SAMPLE TYPE: SPLIT BARREL							
DEPTH	SYMBOL	CLASSIFICATION OF MATERIALS (Description)	BLOWS PER 0.3 m	M.C. %	GRAVEL %	SAND %	FINES %	LL	PI
15	A.7.5	A-7-5, Clay, gry, Sat, Rec. = 0.60m	6	74.4		0.3	99.7	68	38
	A.7.6	A-7-6, Clay, Lt/gry, Sat, Rec. = 0.60m	1	74.3		0.3	99.7	69	41
	A.7.6	A-7-6, Clay, Lt/gry, MTW, Rec. = 0.60m	WH	42.1		0.3	99.7	68	40
	A.7.6	A-7-6, Clay, Lt/gry, Wet, Rec. = 0.60m	WH	68.6		0.3	99.7	69	41
20		Lost casing, 24.0m-27.0m, No Sample							
	A.7.6	A-7-6, Clay, Lt/gry, Wet, Rec. = 0.60m	WH	63.3		0.3	99.7	68	39
	A.7.6	A-7-6, Clay, Lt/gry, Wet, Rec. = 0.60m	WH	64.3		0.3	99.7	68	40
	A.7.6	A-7-6, Clay, gry, Wet, Rec. = 0.50m	WH	54	11	1.5	90.5	55	28
	A.7.6	A-7-6, Clay, gry, Wet, Rec. = 0.44m	WH	58.3	1.3	1.7	97	55	29
GEOLOGISTS REPORT: SEE SHEET 3									

ESTIMATED PILE TIP
ELEV 73.750


STATE OF VERMONT AGENCY OF TRANSPORTATION MATERIALS & RESEARCH DIVISION SUBSURFACE INFORMATION		HOLE NO.: B-7 SHEET 3 OF 3 DATE STARTED: 7/10/98 DATE COMPLETED: 7/15/98							
PROJECT NAME: LEICESTER SITE NAME: BR-6 STATION: 141310 GROUND EL.: 106.454		PROJECT NUMBER: BRF 0160 (3) S SITE NO.: TH-1 OFFSET: -2.662 G.W. DEPTH:							
BORING CREW CREW CHIEF: TALLMAN DRILLER: GAMMELL LOGGER: HOLT ADDITIONAL CREW:		BORING RIG: UNI-MOG BORING TYPE: WASH BORE SAMPLE TYPE: SPLIT BARREL							
DEPTH	SYMBOL	CLASSIFICATION OF MATERIALS (Description)	BLOWS PER 0.3 m	M.C. %	GRAVEL %	SAND %	FINES %	LL	PI
30	A.7.6	A-7-6, Clay, gry, MTW, Rec. = 0.55m	WH	40.2		0.6	99.4	49	26
		A-2-4, CIGr (visual), gry, Moist, Rec. = 0.17m, Top of bedrock @ 32.70m	24	7.4	52.9	17.8	29.3		
		Run #1: BXMD, 32.7m-34.2m, Rec. = 1.29m, See Geologist's Report.	RUN	REC%	RODZ	Dip°			
			1	86	70	40			
		Run #2: BXGDC, 34.2m-35.45m, No Rec., See Geologist's Report.	2	NA	NA	NA			
		Hole stopped @ 35.45m							
GEOLOGISTS REPORT: Run #1: Gray limestone, Hard, Unweathered, Competent. Run #2: No recovery, Core barrel broken, Drillers report no seams encountered.									



SHEET NAME:	BORING LOGS #4	
PROJECT NAME:	LEICESTER	HIGHWAY NO.: FAS 0160
PROJECT NUMBER:	BRF 0160(3)S	BRIDGE NO.: 6 OVER: OTTER CREEK
FILE NAME:	95J288\Structures\sj288bor.dgn	PLOT DATE: 17-AUG-2005
PROJECT MANAGER:	R. R. WHITCOMB	DRAWN BY: J. TOUCHETTE
DESIGNED BY:	C. CARLSON	IPARM NAME: sj088br4.1
BRIDGE SHEET NUMBER:		SHEET 45 OF 90

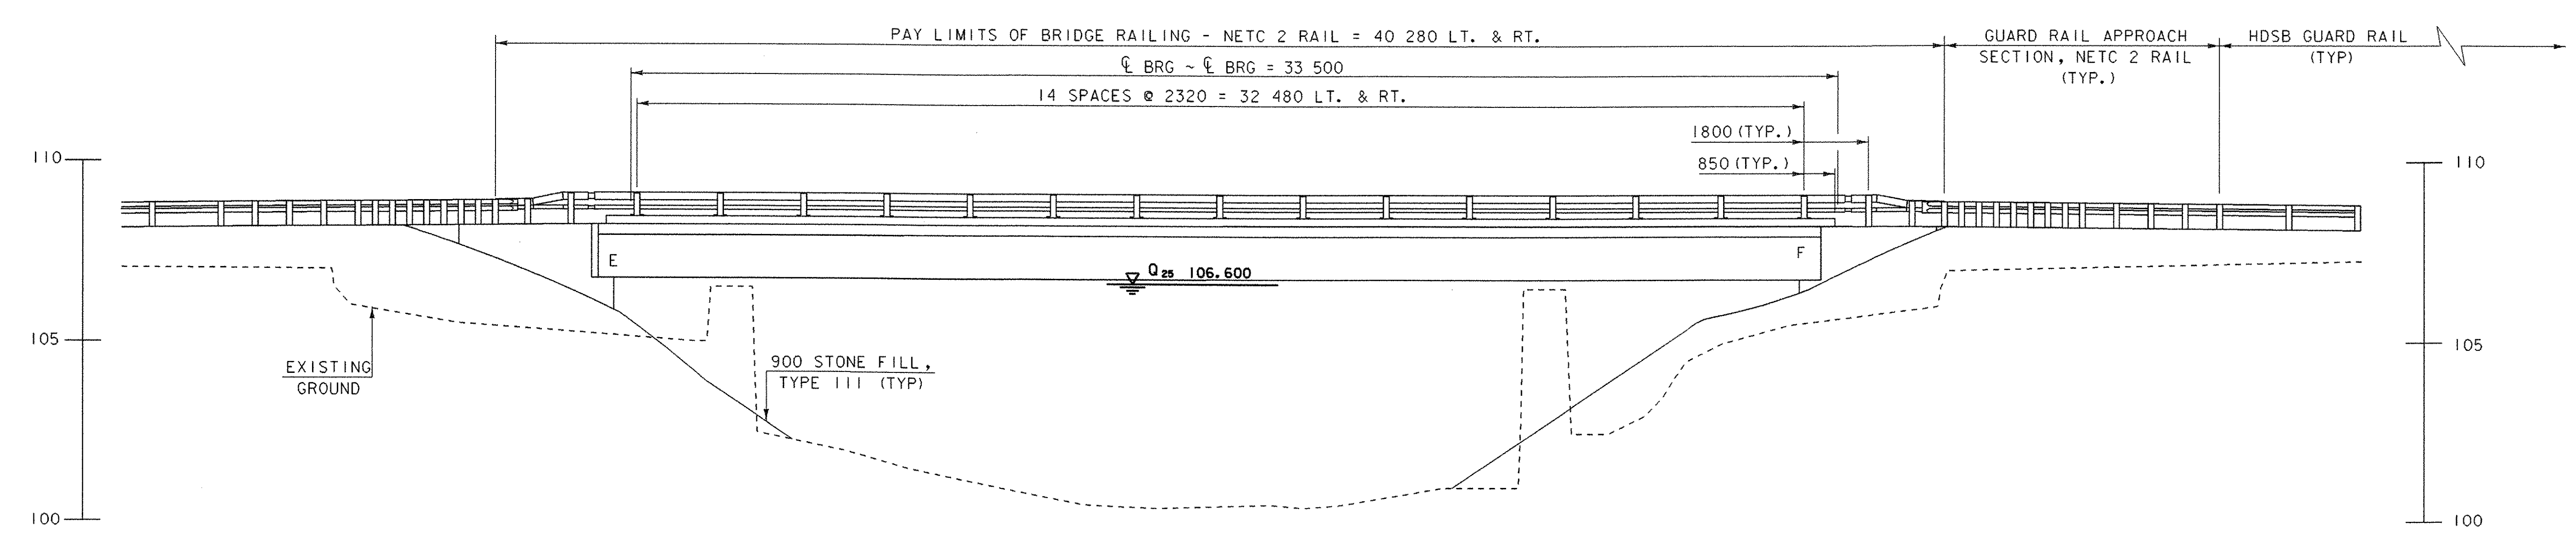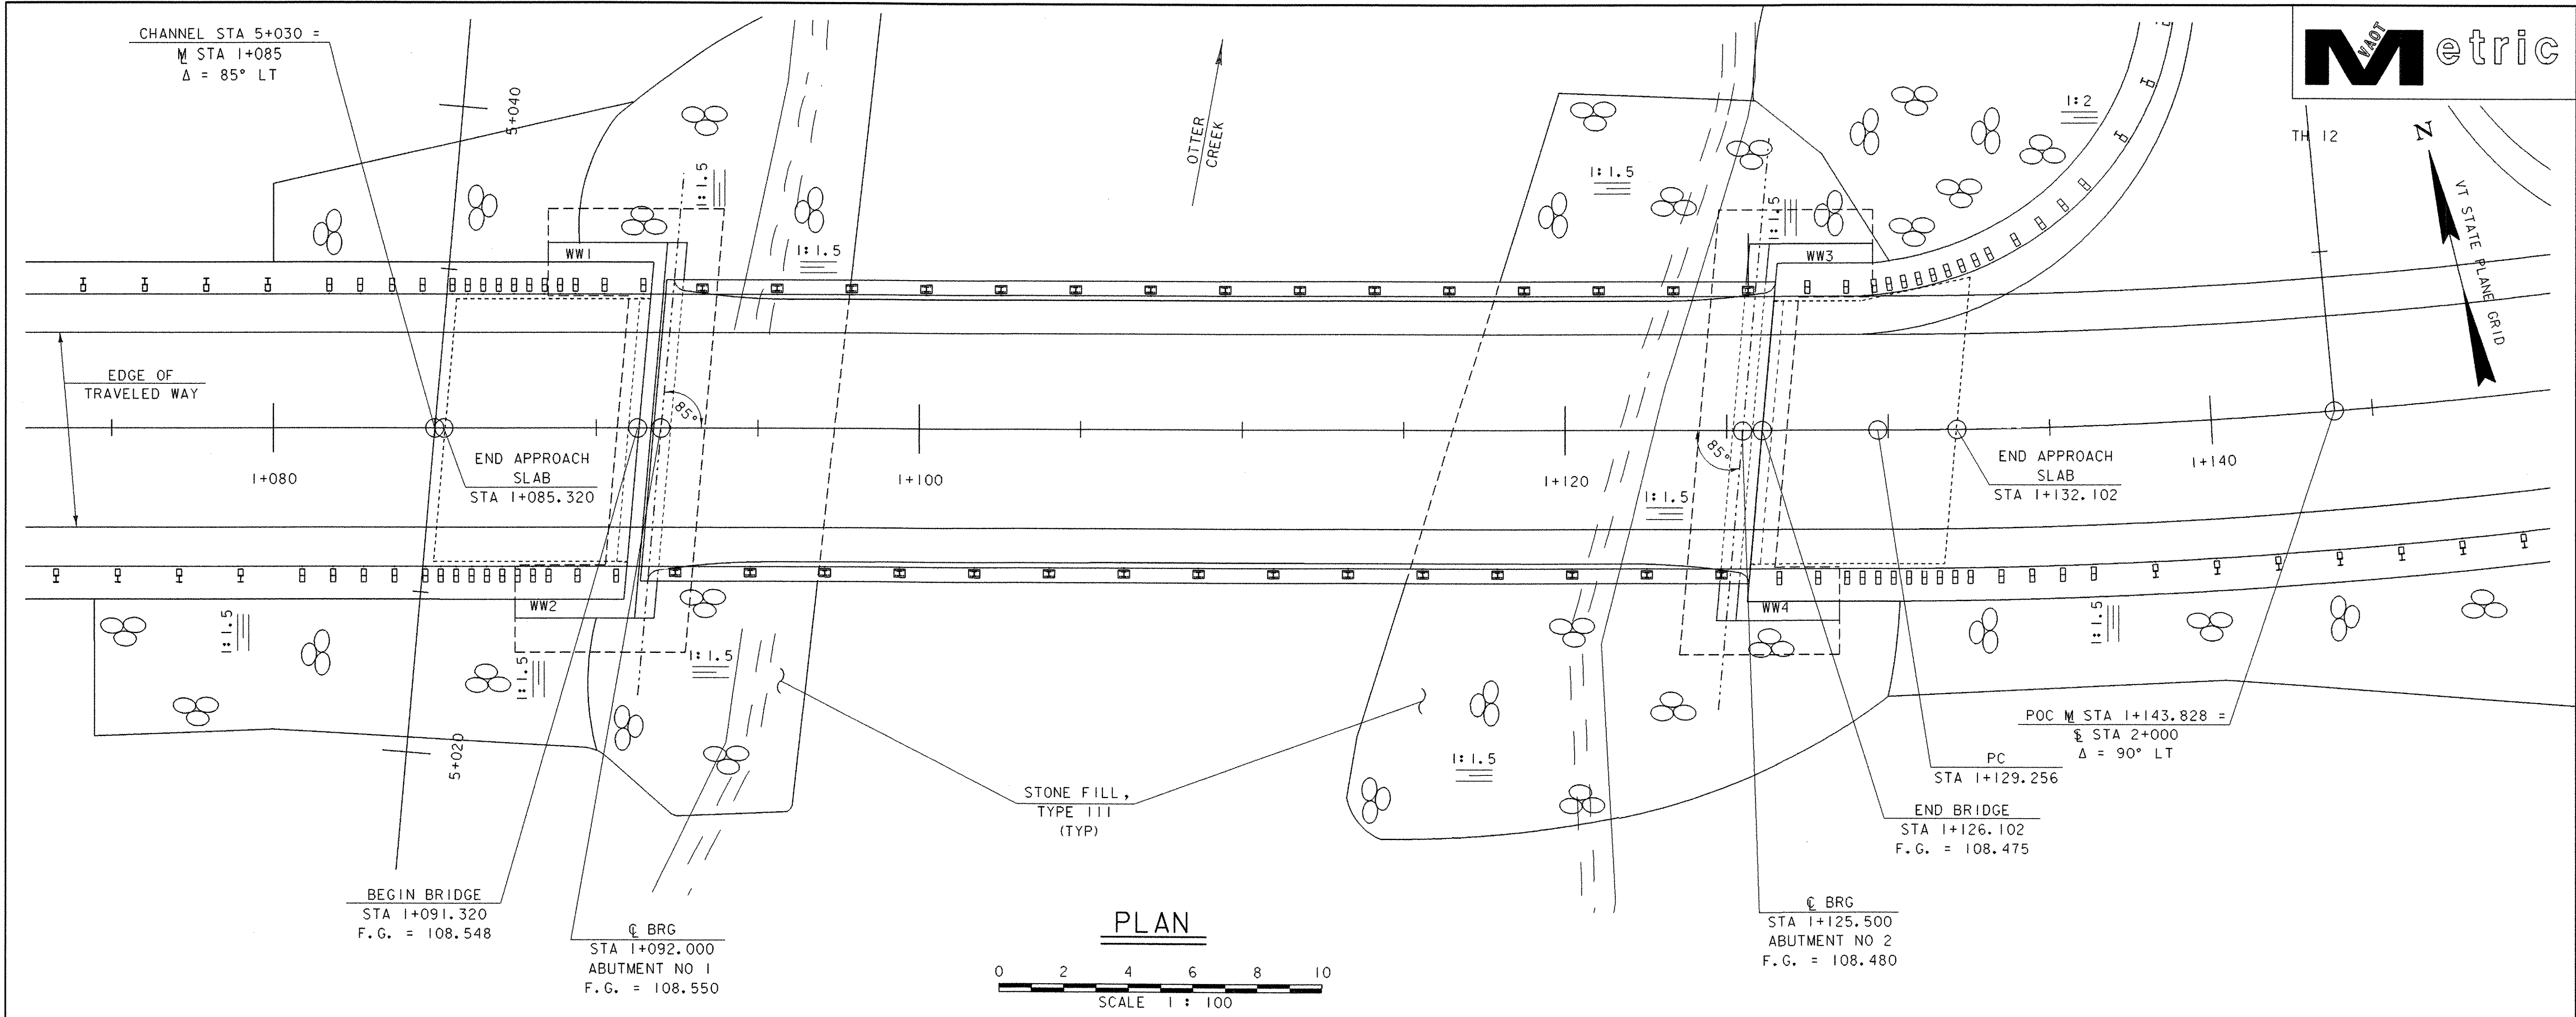

ELEVATION AT UPSTREAM FASCIA

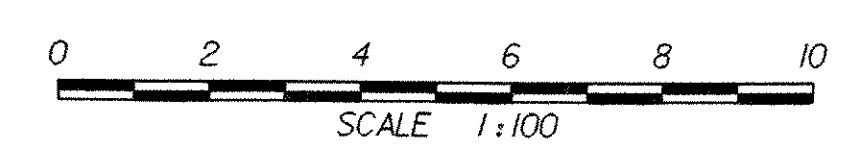

SHEET NAME: PLAN AND ELEVATION	
PROJECT NAME: LEICESTER	HIGHWAY NO.: FAS 0160
PROJECT NUMBER: BRF 0160(3)S	BRIDGE NO.: 6
	OVER: OTTER CREEK
FILE NAME: 95J288\Structures\sj288pe.dgn	PLOT DATE: 17-AUG-2005
PROJECT MANAGER: R. R. WHITCOMB	DRAWN BY: J. GILMORE
DESIGNED BY: C. CARLSON	IPARM NAME: sj088pe.i
BRIDGE SHEET NUMBER:	SHEET 46 OF 90

GENERAL

1. ALL MATERIALS AND CONSTRUCTION SHALL CONFORM TO THE AGENCY OF TRANSPORTATION'S STANDARD SPECIFICATIONS FOR CONSTRUCTION, DATED 2001, AND ITS LATEST REVISIONS, AND THE AASHTO STANDARD SPECIFICATIONS FOR HIGHWAY BRIDGES, SEVENTEENTH EDITION, AND ITS LATEST REVISIONS.
2. BRIDGE IS DESIGNED FOR MS 22.5 LIVE LOAD WITH NO ALLOWANCE FOR FUTURE PAVEMENT.
3. a) IN-STREAM CONSTRUCTION SHALL BE RESTRICTED TO JUNE 1 TO OCTOBER 1, UNLESS THE CONTRACTOR OBTAINS WRITTEN PERMISSION FROM THE AGENCY OF NATURAL RESOURCES TO DO WORK OUTSIDE OF THAT TIME FRAME.
b) THE CONTRACTOR SHALL REVIEW AND UNDERSTAND ALL APPLICABLE ENVIRONMENTAL PERMITS AND INSURE THAT ALL CONDITIONS ARE MET.
4. THE CONTRACTOR SHALL TAKE ALL PRECAUTIONS NECESSARY TO PREVENT SILTATION OR POLLUTION, ESPECIALLY THE DISCHARGE OF RAW CONCRETE INTO THE OTTER CREEK.
5. ALL DIMENSIONS ARE HORIZONTAL OR VERTICAL AND ARE GIVEN AT 20 DEGREES C UNLESS OTHERWISE NOTED.
6. THE EXISTING STRUCTURAL STEEL ON THIS PROJECT WAS PAINTED WITH A MATERIAL WHICH MAY CONTAIN LEAD. THE REMOVED STRUCTURAL STEEL IS THE PROPERTY OF THE CONTRACTOR. THE CONTRACTOR SHALL INDEMNIFY AND HOLD THE STATE, ITS OFFICERS, AND EMPLOYEES HARMLESS CONCERNING THE CONTRACTOR'S USE OR DISPOSITION OF THE STRUCTURAL STEEL.
7. THE EXISTING SUPERSTRUCTURE INCLUDING THE BEAMS, DECK AND RAILING SHALL BE REMOVED DOWN TO THE EXISTING BRIDGE SEATS. THIS WORK SHALL BE PAID FOR UNDER THE ITEM 529.20, "PARTIAL REMOVAL OF STRUCTURE".
8. PAYMENT FOR REMOVAL OF EXISTING BITUMINOUS PAVEMENT ON THE BRIDGE SHALL BE MADE UNDER THE ITEM 529.10, "REMOVAL OF BRIDGE PAVEMENT." THE MATERIAL SHALL BECOME THE PROPERTY OF THE CONTRACTOR AND SHALL BE DISPOSED OF PROPERLY AT AN OFFSITE LOCATION.
9. TEMPORARY FENCING SHALL BE PLACED BETWEEN STATIONS S/L STA 2+022 RT - S/L STA 2+070 RT AND MAIN LINE STATIONS 1+153 LT - 1+230 LT TO RESTRICT ACCESS TO AN AREA THAT IS ARCHAEOLOGICALLY SENSITIVE. THIS WORK WILL BE PAID FOR AS ITEM 620.70, "SNOW FENCE" (MOD.-ARCH).
10. ALL WORK REQUIRED FOR THE CONSTRUCTION OF TOWN HIGHWAY 12 (JERUSALEM ROAD) SHALL BE CONDUCTED FROM THE ROADWAY.
11. THE CONTRACTOR SHALL NOT REMOVE ANY EXISTING TOPSOIL OR OTHER MATERIAL IN THE VICINITY OF THE FIELD DRIVE LOCATED AT STATION 1+026 LT. THE CONTRACTOR SHALL PLACE THE FILL AND SUBBASE MATERIALS FOR THIS DRIVE WITHIN THE DRIVE LIMITS..
12. THE CONTRACTOR SHALL NOT USE ANY OF THE LAND THAT IS IDENTIFIED ON THE PLANS AS AN "ARCHAEOLOGICALLY SENSITIVE AREA" FOR STAGING, WASTE OR BORROW AREA.
13. THE EXISTING CONCRETE ABUTMENTS SHALL BE REMOVED IN THEIR ENTIRETY THIS WORK SHALL BE PAID FOR UNDER ITEM 204.25, "STRUCTURE EXCAVATION".
14. THE EXISTING PIERS SHALL BE REMOVED TO 600mm BELOW THE STREAMBED ELEVATION THOSE PORTIONS OF THE PIERS THAT FALL WITHIN THE COFFERDAM'S PAY LIMITS WILL BE PAID FOR AS "COFFERDAM EXCAVATION, ROCK". THOSE PORTIONS OF THE PIERS THAT FALL OUTSIDE THE COFFERDAMS SHALL BE PAID AS "UNCLASSIFIED CHANNEL EXCAVATION".
15. ALL PILES SHALL BE FURNISHED WITH REINFORCED PILE POINT OF PREFABRICATED CAST STEEL AS PER SUBSECTION 505.04(E) AND 730.01.
16. THE VERMONT RAILWAY OR A CONTRACTOR IN THEIR EMPLOY WILL CONSTRUCT THE NEW RAILROAD CROSSING AND UPGRADE THE FLASHING SIGNAL SYSTEM FOR THE RAILROAD CROSSING LOCATED AT PROJECT STATION 0+994.253. THE CONTRACTOR FOR THE BRIDGE REPLACEMENT PROJECT WILL BE REQUIRED TO COORDINATE THEIR WORK WITH THE RAILROAD AND WILL NOT BE COMPENSATED DIRECTLY FOR THIS COORDINATION OR FOR ANY EXTRA WORK THAT MAY BE REQUIRED TO WORK AROUND OR WITH THE RAILROAD CREWS PERFORMING THE WORK. THE CONTRACTOR IS RESPONSIBLE FOR PAVING THE RAILROAD CROSSING. THIS WORK WILL BE PAID FOR AS ITEM 406.25, "BITUMINOUS CONCRETE PAVEMENT".
17. THE CONTRACTOR SHALL ARRANGE FOR INSPECTION OF THE HOUSE FOUNDATION (STA. 1+040 RT.) PRIOR TO PILE DRIVING AND FOR MONITORING OF THE FOUNDATIONS DURING PILE DRIVING AT EACH ABUTMENT. THIS WORK WILL BE INCIDENTAL TO THE ITEM 504.10, "FURNISHING EQUIPMENT FOR DRIVING PILING". SEE SPECIAL PROVISIONS.
18. EXISTING TRAFFIC SIGNS AND SIGN POSTS SHALL BE REMOVED AND STOCKPILED ON THE PROJECT. THEY WILL REMAIN THE PROPERTY OF THE TOWN. THE CONTRACTOR SHALL BE PREPARED TO LOAD THE SIGNS ON TRUCKS FURNISHED AT THE SITE BY THE TOWN FOR REMOVAL FROM THE SITE BY THE TOWN. NOTIFICATION MUST BE GIVEN ONE WEEK IN ADVANCE TO THE TOWN INDICATING WHEN THE MATERIAL WILL BE AVAILABLE. CONTACT ARLAN PIDGEON, ROAD FOREMAN AT (802) 247-2961. THIS WORK WILL BE PAID FOR UNDER THE ITEM 675.50, "REMOVING SIGNS".
19. A WATER QUALITY AND QUANTITY TEST WILL BE PERFORMED FOR THE WELL LOCATED AT STA 1 + 053(+/-) RT PRIOR TO AND IMMEDIATELY AFTER CONSTRUCTION. THIS WORK WILL BE PERFORMED BY AGENCY STAFF AND/OR DESIGNEES.

STRUCTURAL STEEL

20. ANY CONNECTIONS THAT ARE NOT DETAILED ON THE PLANS SHALL BE DETAILED BY THE FABRICATOR AND SUBMITTED TO THE STRUCTURES ENGINEER FOR APPROVAL.
21. ALL WELDING SHALL CONFORM TO THE PROVISIONS OF VERMONT SPECIFICATION 506.10.
22. ALL MEMBERS MARKED (CVN) MUST MEET THE CHARPY V-NOTCH TESTING REQUIREMENTS AS INDICATED IN SECTION 714 OF THE VERMONT AGENCY OF TRANSPORTATION SPECIFICATIONS FOR CONSTRUCTION.
23. ANY HOLES IN THE WEBS OF THE FASCIA BEAMS/GIRDERS THAT ARE NOT OTHERWISE FILLED SHALL BE FILLED AS DESCRIBED IN NOTE 24 FOR PAINTED AND UNPAINTED AREAS. THE BOLTS SHALL BE TIGHTENED IN ACCORDANCE WITH SUBSECTION 506.19 OF THE STANDARD SPECIFICATION.
24. ALL FIELD CONNECTIONS SHALL BE MADE WITH 22 mm DIAMETER AASHTO DESIGNATION M 164M TYPE III BOLTS IN 24 mm DIAMETER HOLES EXCEPT FOR CONNECTIONS IN PAINTED AREAS AT THE ABUTMENT NO. 1 END WHERE 22 mm DIAMETER BOLTS MEETING AASHTO M164, TYPE I GALVANIZED SHALL BE USED.
25. THE DESIGN OF THE FLEMING BRACKETS SHALL BE LEFT UP TO THE CONTRACTOR BUT SHALL BE LIMITED TO A MAXIMUM OF 1.220 METER SPACING.
26. ALL STRUCTURAL STEEL WITHIN 2.4 METERS OF THE GIRDER ENDS AT ABUTMENT NUMBER ONE SHALL BE PAINTED. THE COLOR OF THE FINAL COAT OF PAINT SHALL BE BROWN AND SHALL CONFORM WITH FEDERAL STANDARD NUMBER 595, COLOR CHIP NUMBER 20059. THIS WORK WILL BE PAID FOR UNDER THE ITEMS 513.25, "STRUCTURAL PAINTING, SHOP APPLIED (6 TONNES)" AND 513.40, "SURFACE PREPARATION, SHOP APPLIED (6 TONNES)".
27. THE ENDS OF THE GIRDERS AT ABUTMENT NO. ONE, THE END DIAPHRAGMS AND BEARING STIFFENERS SHALL BE GREASED AS PER SECTION 513.06(d) OF THE SUPPLEMENTAL SPECIFICATION. THIS WORK WILL BE PAID FOR UNDER "STRUCTURAL PAINTING, SHOP APPLIED (6 TONNES)".

CONCRETE

28. THE KEY IN CONCRETE CONSTRUCTION JOINTS SHALL BE MONOLITHIC AND CONTINUOUS FOR THE FULL LENGTH OF THE JOINT, ANY UPWARD KEY SHALL BE PLACED INTEGRALLY WITH THE CONCRETE BELOW THE JOINT.
29. ALL EXPOSED EDGES OF CONCRETE SHALL BE CHAMFERED 25 mm BY 25 mm.
30. JOINTS AND SCORE MARKS IN CONCRETE SHALL BE CONSTRUCTED AS INDICATED ON THE PLANS OR AS DIRECTED BY THE ENGINEER.
31. ALL REINFORCING STEEL SHALL BE DETAILED AND FABRICATED USING PROCEDURES AND TOLERANCES IN ACCORDANCE WITH APPLICABLE PUBLICATIONS OF THE CONCRETE REINFORCING STEEL INSTITUTE (CRSI).
32. REINFORCING PLACEMENT TOLERANCES SHALL BE:
SPACING + - 25 mm
CLEARANCE + - 5 mm
33. MINIMUM COVER FOR REINFORCING STEEL SHALL BE AS DETAILED IN THE PROJECT PLANS.
34. SURFACES OF BRIDGE SEATS UNDER BEARING DEVICES SHALL BE LEVEL, OTHER BRIDGE SEAT AREAS SHALL BE SLOPED 40mm/m. ABUTMENT SEATS SHALL BE SLOPED FULL WIDTH TOWARD THE CENTER SPAN. THE ENTIRE BRIDGE SEAT SURFACE SHALL BE SMOOTHED WITH A MAGNESIUM FLOAT FINISH.
35. DECK POUR IS TO BE DONE IN ONE POUR WITHIN A MAXIMUM OF EIGHT HOURS. IF CIRCUMSTANCES BEYOND THE CONTRACTOR'S CONTROL PREVENT THIS FROM BEING ACCOMPLISHED, A MINIMUM DELAY OF NINETY-SIX (96) HOURS BETWEEN THE COMPLETION OF ONE DAY'S POUR AND THE BEGINNING OF ANY OTHER POUR WILL BE ADHERED TO. SEE SHEET 51 FOR DETAIL OF TRANSVERSE BRIDGE SLAB CONSTRUCTION
36. WATER REPELLENT (MOD.-SILANE) SHALL BE APPLIED TO ALL EXPOSED CONCRETE SURFACES EXCEPT THE UNDERSIDE OF THE DECK BETWEEN THE DRIP BEADS.
37. NO CONCRETE IN THE ABUTMENTS OR WINGWALLS SHALL BE PLACED ABOVE THE BRIDGE SEAT ELEVATIONS UNTIL THE GIRDERS HAVE BEEN PROFILED AND THE FINISHED GRADE OF THE DECK HAS BEEN DETERMINED.
38. AFTER THE SUPERSTRUCTURE HAS BEEN ERECTED, ELEVATIONS SHALL BE TAKEN ALONG THE TOP OF THE BEAMS/GIRDERS, AS DIRECTED BY THE RESIDENT ENGINEER, FOR USE IN DETERMINING THE FINISHED GRADE.
39. ALL SUBSTRUCTURE CONCRETE AND THE APPROACH SLABS SHALL BE CONCRETE, HIGH PERFORMANCE CLASS B, UNLESS OTHERWISE NOTED.
40. THE DECK AND CURBS SHALL BE CONCRETE, HIGH PERFORMANCE CLASS A.

TEMPORARY BRIDGE/DETOUR


41. TRAFFIC WILL BE MAINTAINED ON A TWO-WAY TEMPORARY BRIDGE LOCATED DOWNSTREAM OF THE EXISTING STRUCTURE.
42. THE ROADWAY APPROACHES TO THE TEMPORARY BRIDGE WILL BE PAVED. THE PAVEMENT WILL BE PAID FOR UNDER ITEM 528.11, "TWO WAY TEMPORARY BRIDGE (MOD.)".
43. THE REMOVAL, COVERING AND/OR RESETTING OF EXISTING TRAFFIC SIGNS, AS DEEMED NECESSARY BY THE RESIDENT ENGINEER, WILL BE CONSIDERED INCIDENTAL TO ITEM 641.10, "TRAFFIC CONTROL".
44. THE COST OF ALL ON-PROJECT CONSTRUCTION SIGNING AND BARRICADES SHALL BE INCIDENTAL TO ITEM 641.10, "TRAFFIC CONTROL".
45. ACCESS TO DRIVES SHALL BE MAINTAINED. WHEN THE CONTRACTOR MUST TEMPORARILY RESTRICT ACCESS TO THE DRIVES, THE CONTRACTOR SHALL NOTIFY THE PROPERTY OWNERS IN ADVANCE. THIS WORK WILL BE PAID FOR UNDER THE ITEM 641.10, "TRAFFIC CONTROL".
46. THE EXISTING BERM PROTECTING THE CORN FIELD IN THE NORTHWEST QUADRANT OF THE PROJECT WILL BE EITHER MAINTAINED OR REPLACED WITH A WATERTIGHT PHYSICAL BARRIER AT OR ABOVE ITS PRESENT ELEVATION AT ALL TIMES DURING CONSTRUCTION. WHEN FINAL GRADING IS DONE THE BERM SHALL BE RETURNED TO ITS ORIGINAL CONDITION AND MEET THE APPROVAL OF THE ENGINEER AND LANDOWNER. ANY COSTS INVOLVED IN MAINTAINING AND RECONSTRUCTING THE BERM WILL BE INCIDENTAL TO OTHER CONTRACT ITEMS.

GEOTECHNICAL INSTRUMENTATION

47. THE CONTRACTOR WILL BE RESPONSIBLE FOR COORDINATING WITH THE VTRANS GEOTECHNICAL ENGINEER CHRIS BENDA AT 828-6910 CONCERNING THE INSTALLATION OF THE EARTH PRESSURE CELLS. THE CONTRACTOR SHALL GIVE ADEQUATE NOTIFICATION SO THAT EACH LOAD CELL CAN BE PLACED IN THE LOCATIONS SHOWN ON THE PLANS BEFORE THE NEXT PHASE OF CONSTRUCTION BEGINS. ALL COSTS ASSOCIATED WITH THIS COORDINATION (INCLUDING ANY DELAYS) AND IN ASSISTING WITH THE INSTALLATION OF THE CELLS SHALL BE INCLUDED IN THE UNIT PRICE BID FOR ITEM 623.60, "EARTH PRESSURE CELL".


PROJECT NAME:	LEICESTER
PROJECT NUMBER:	BRF 0160(3) S
FILE NAME:	95\288\Structures\j288gen.xls
PROJECT LEADER:	R. R. WHITCOMB
DESIGNED BY:	C. CARLSON
GENERAL NOTES SHEET	PLOT DATE: 04/07/2005 DRAWN BY: G. ROY CHECKED BY: C. CARLSON SHEET 47 OF 90

* PAYMENT INCIDENTAL TO ITEM 501.34, "CONCRETE, HIGH PERFORMANCE CLASS B"

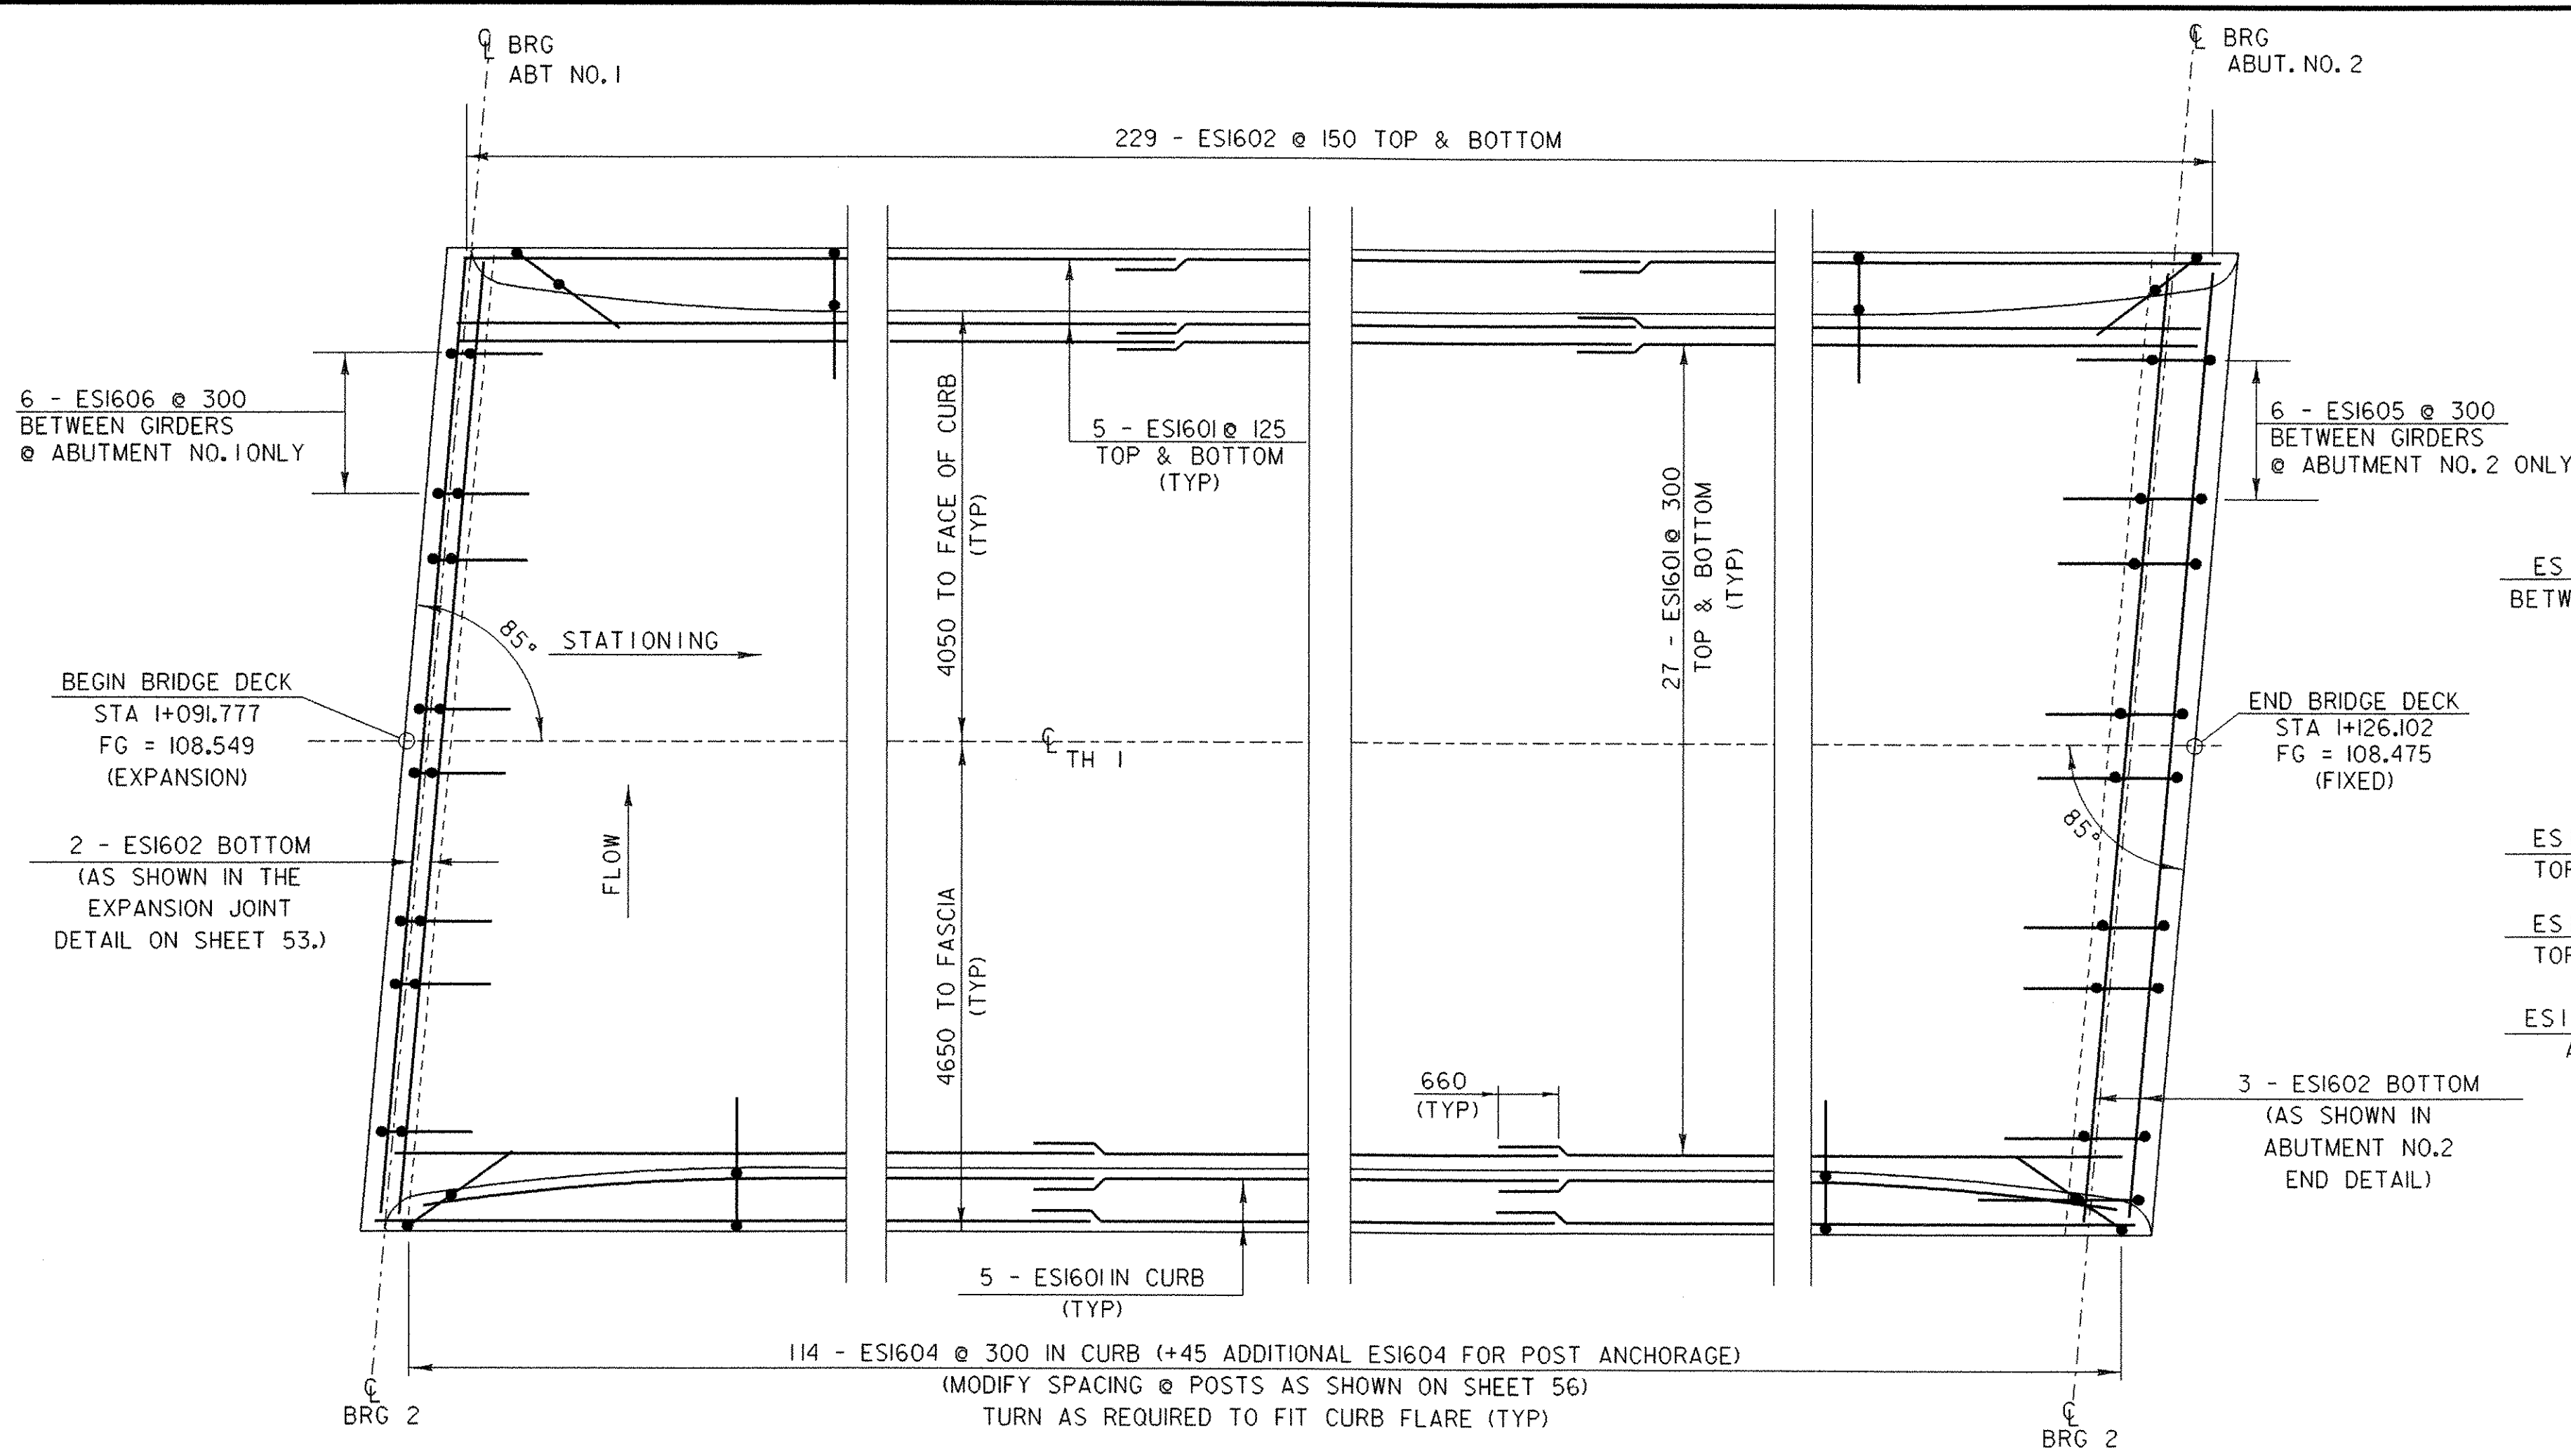


DETAIL REINFORCING PLAN

SCALE 1 : 50

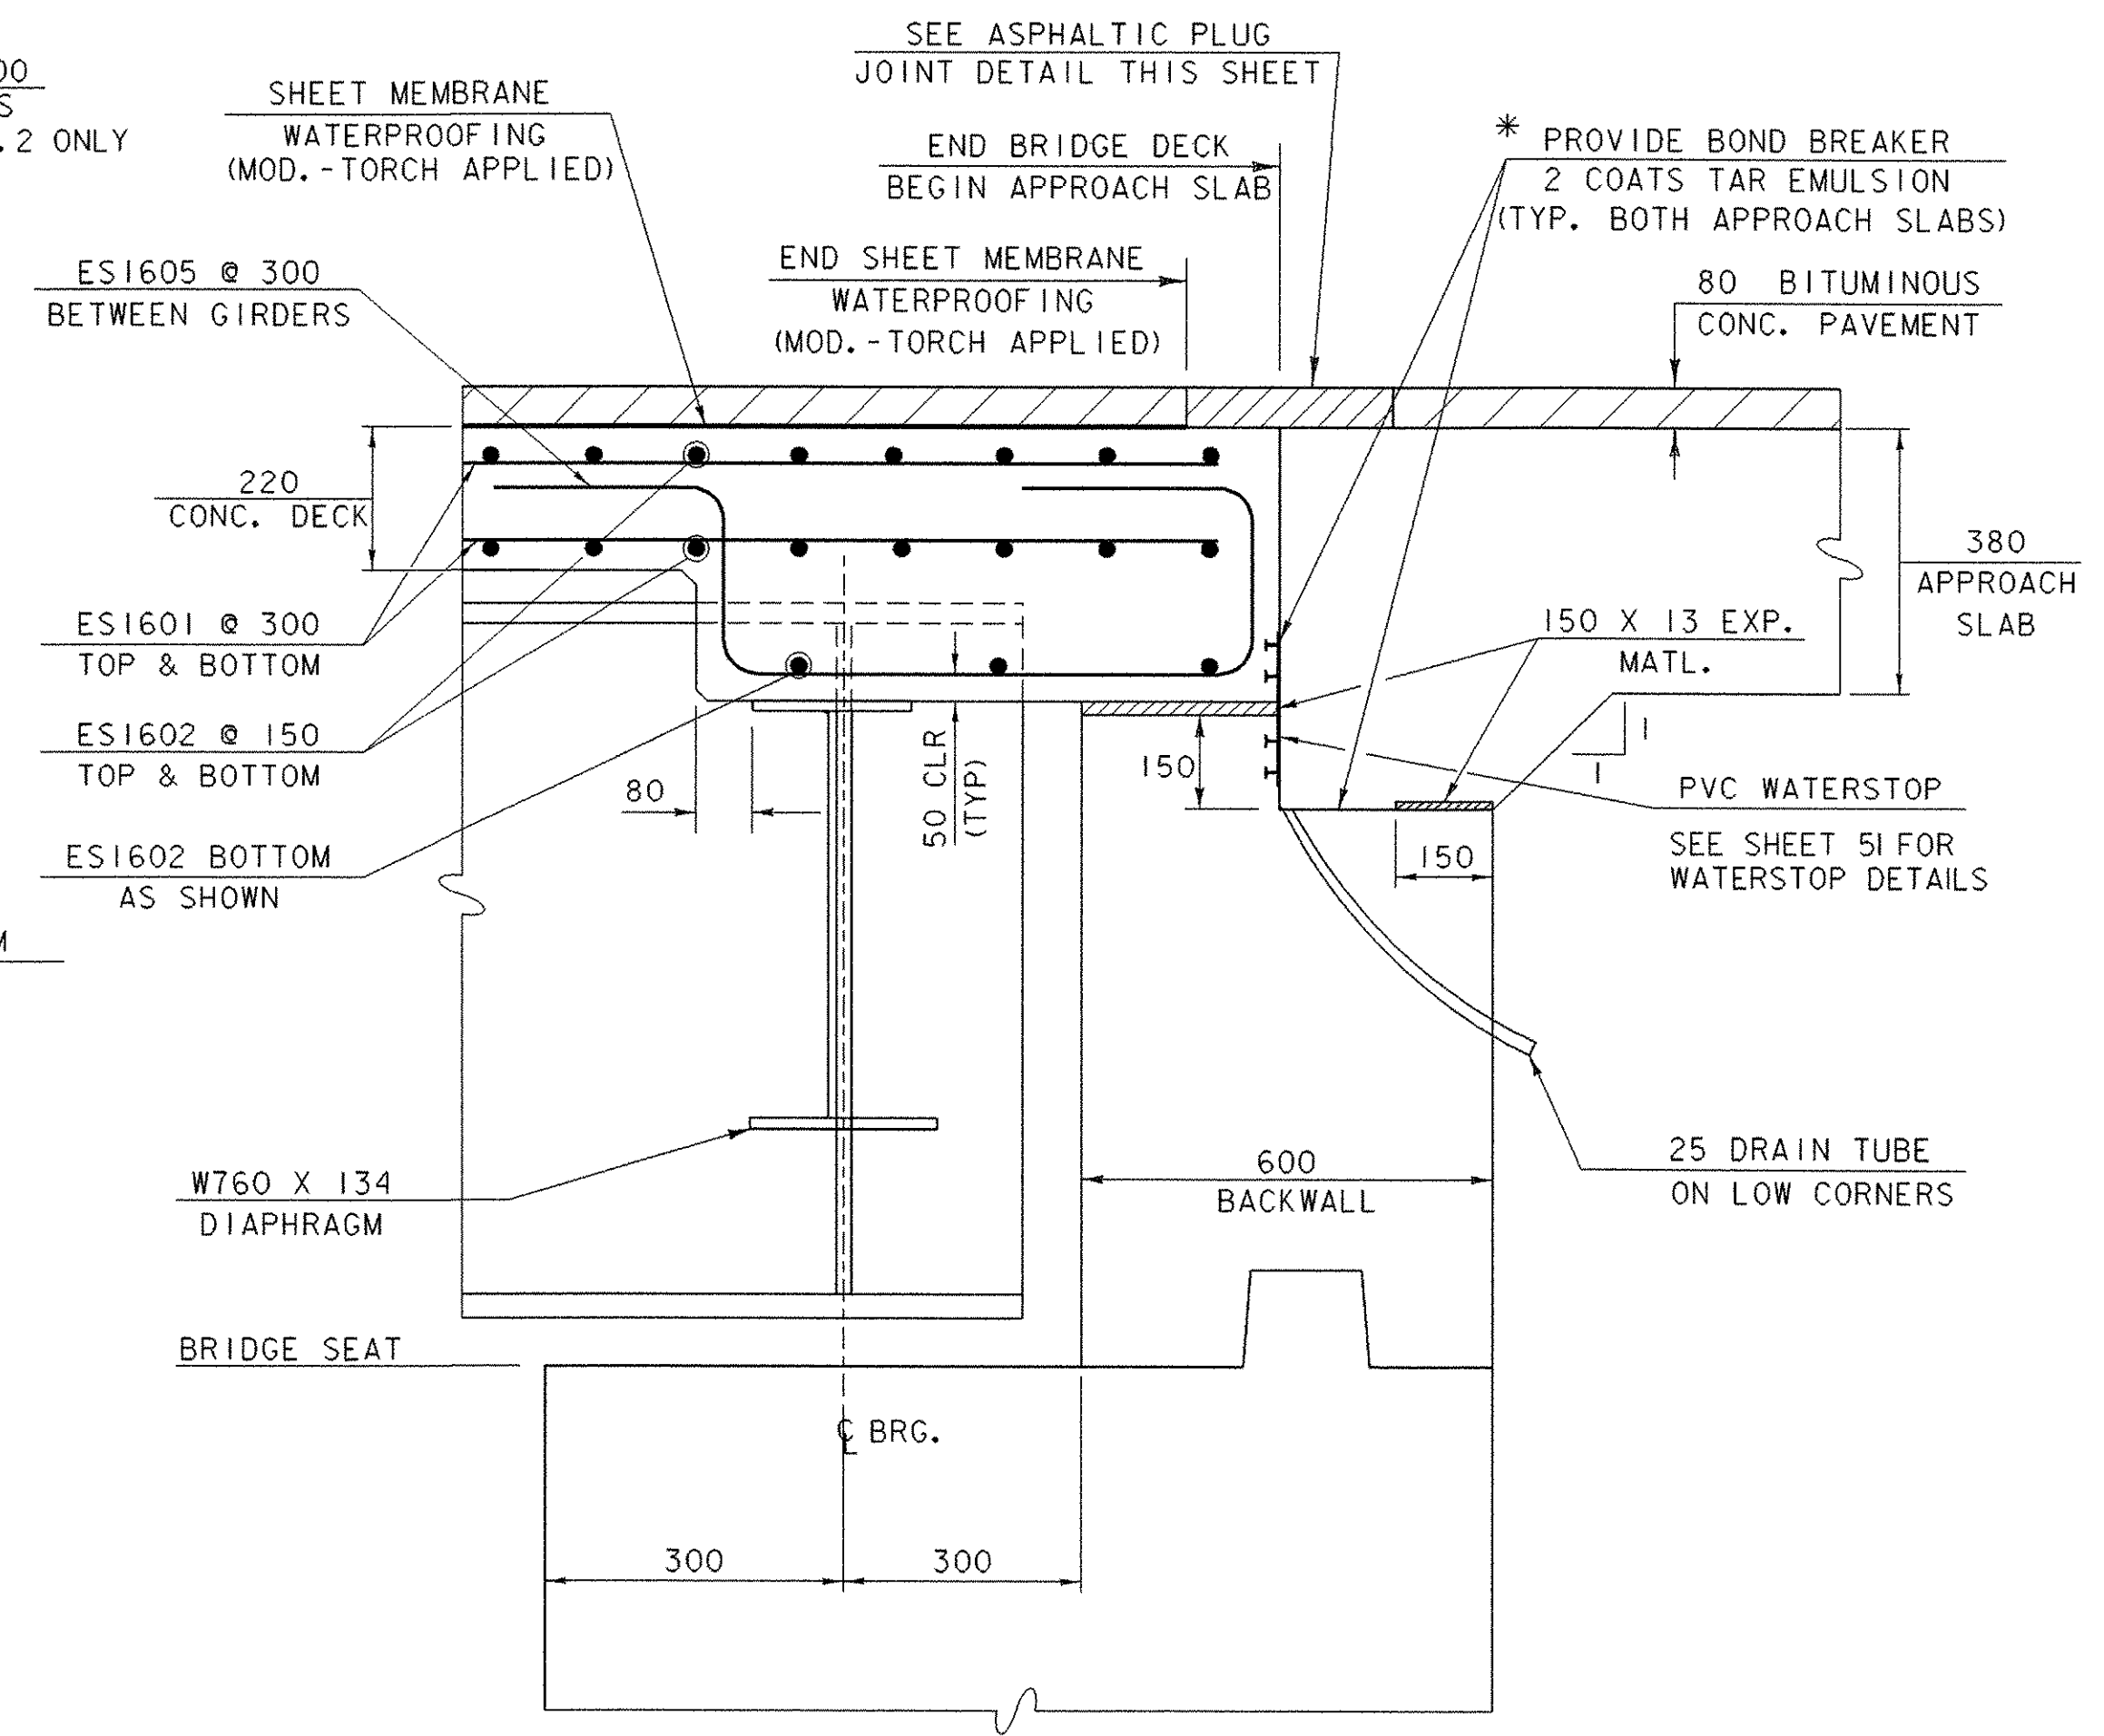

END DETAIL @ ABUTMENT NO. 2


NORMAL TO CENTERLINE OF BEARING NOT TO SCALE

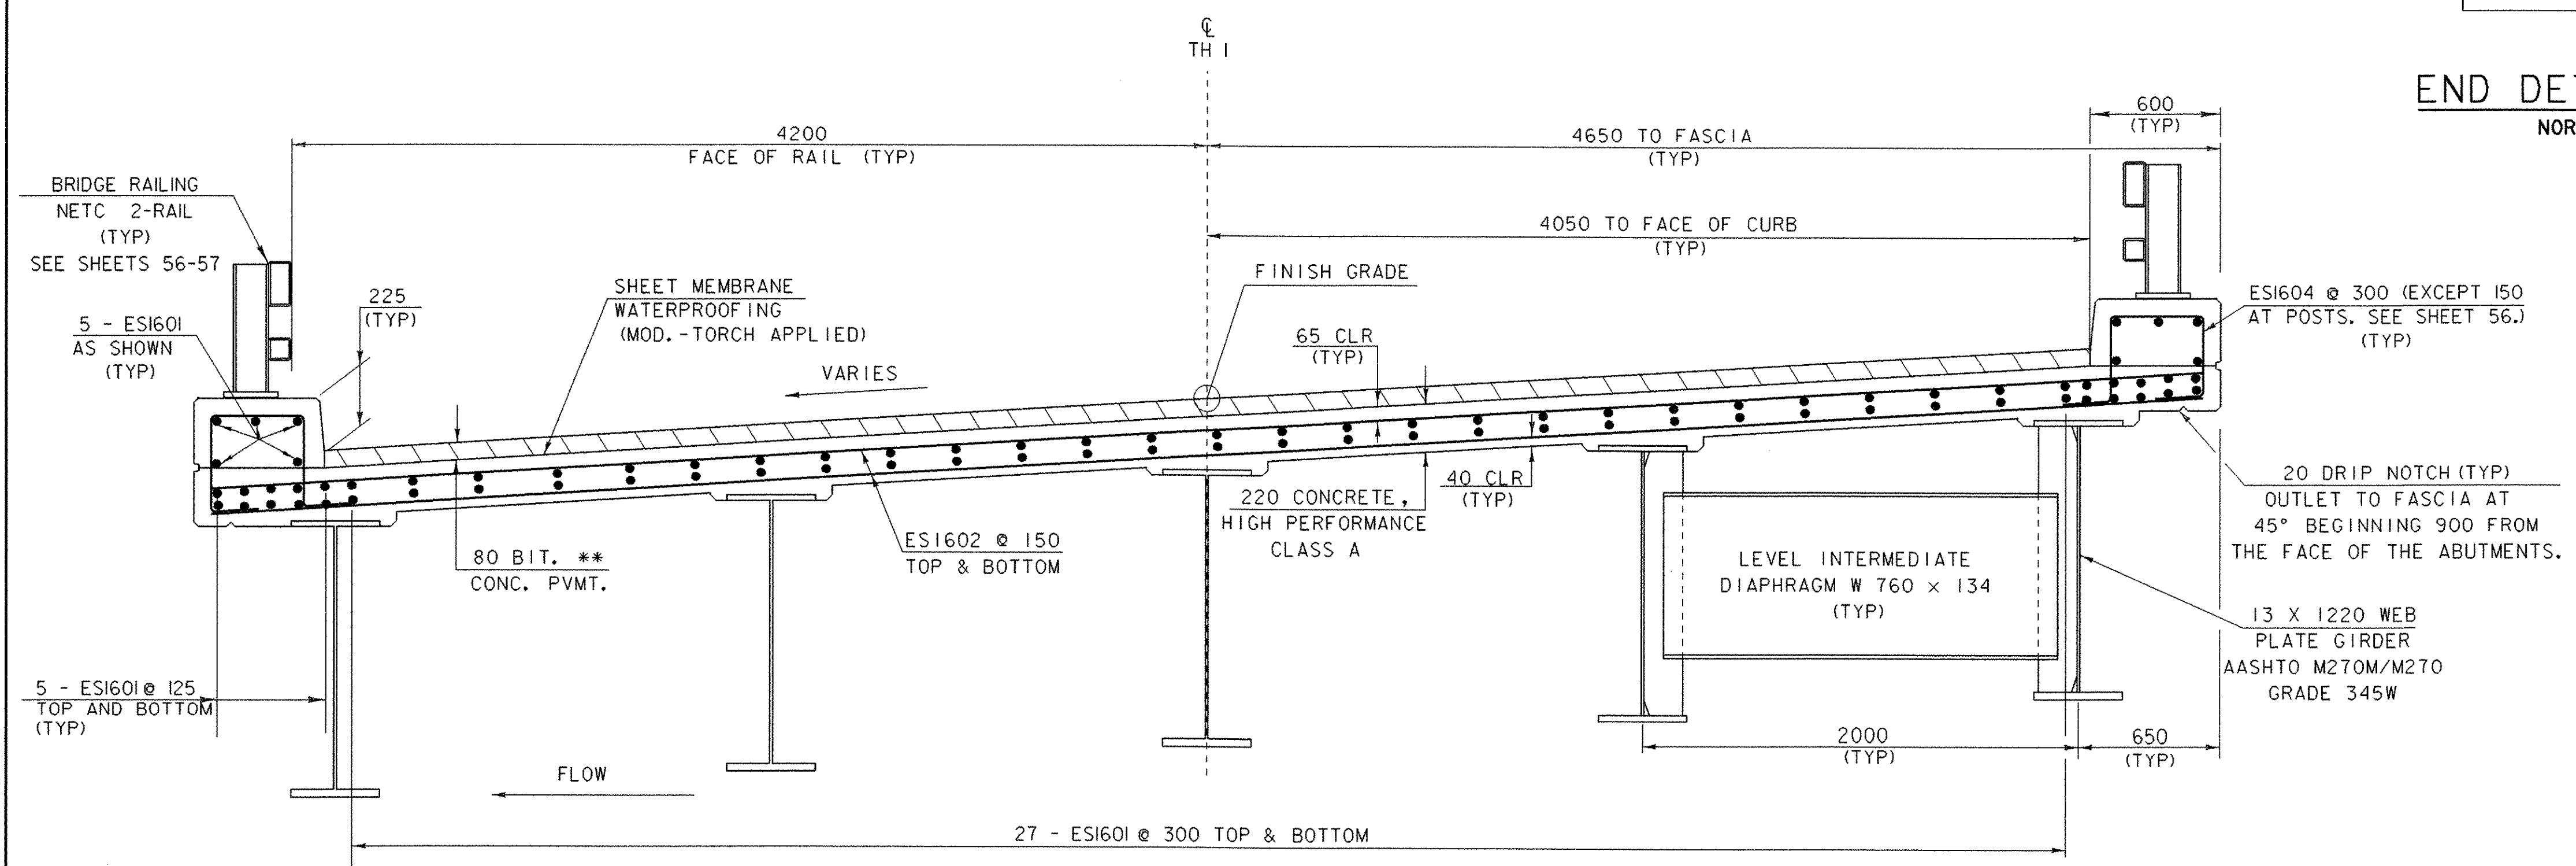

BRIDGE TYPICAL SECTION

SCALE 1 : 20




** 40 BIT. CONC. PVMT. TYPE III OVER 40 BIT. CONC. PVMT. TYPE III

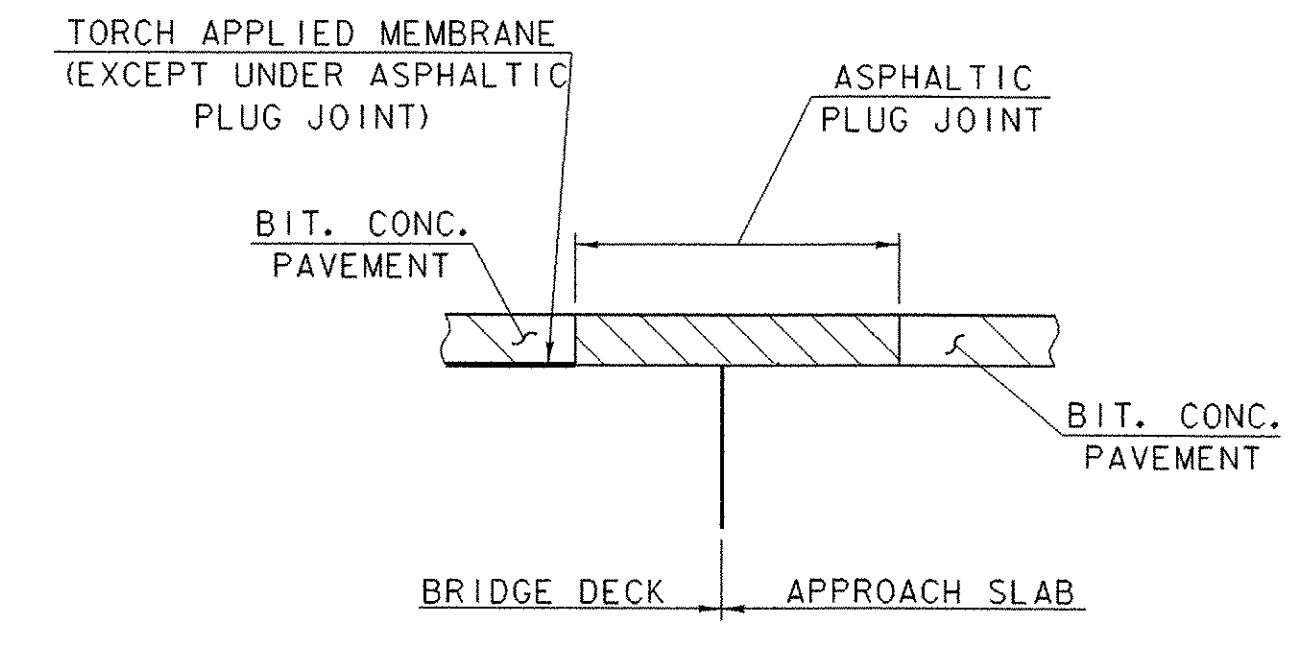

ASPHALTIC PLUG JOINT DETAIL


NOT TO SCALE

SHEET NAME: DECK REINFORCING PLAN	
PROJECT NAME: LEICESTER	HIGHWAY NO.: TH 1
PROJECT NUMBER: BRF 0160(3)S	BRIDGE NO.: 6
	OVER: OTTER CREEK
FILE NAME: 95j288\Structures\sj288sup.dgn	PLOT DATE: 17-AUG-2005
PROJECT MANAGER: R. R. WHITCOMB	DRAWN BY: T. FILLBACH
DESIGNED BY: C. CARLSON	IPARM NAME: sj288dck.I
BRIDGE SHEET NUMBER:	SHEET 48 OF 90

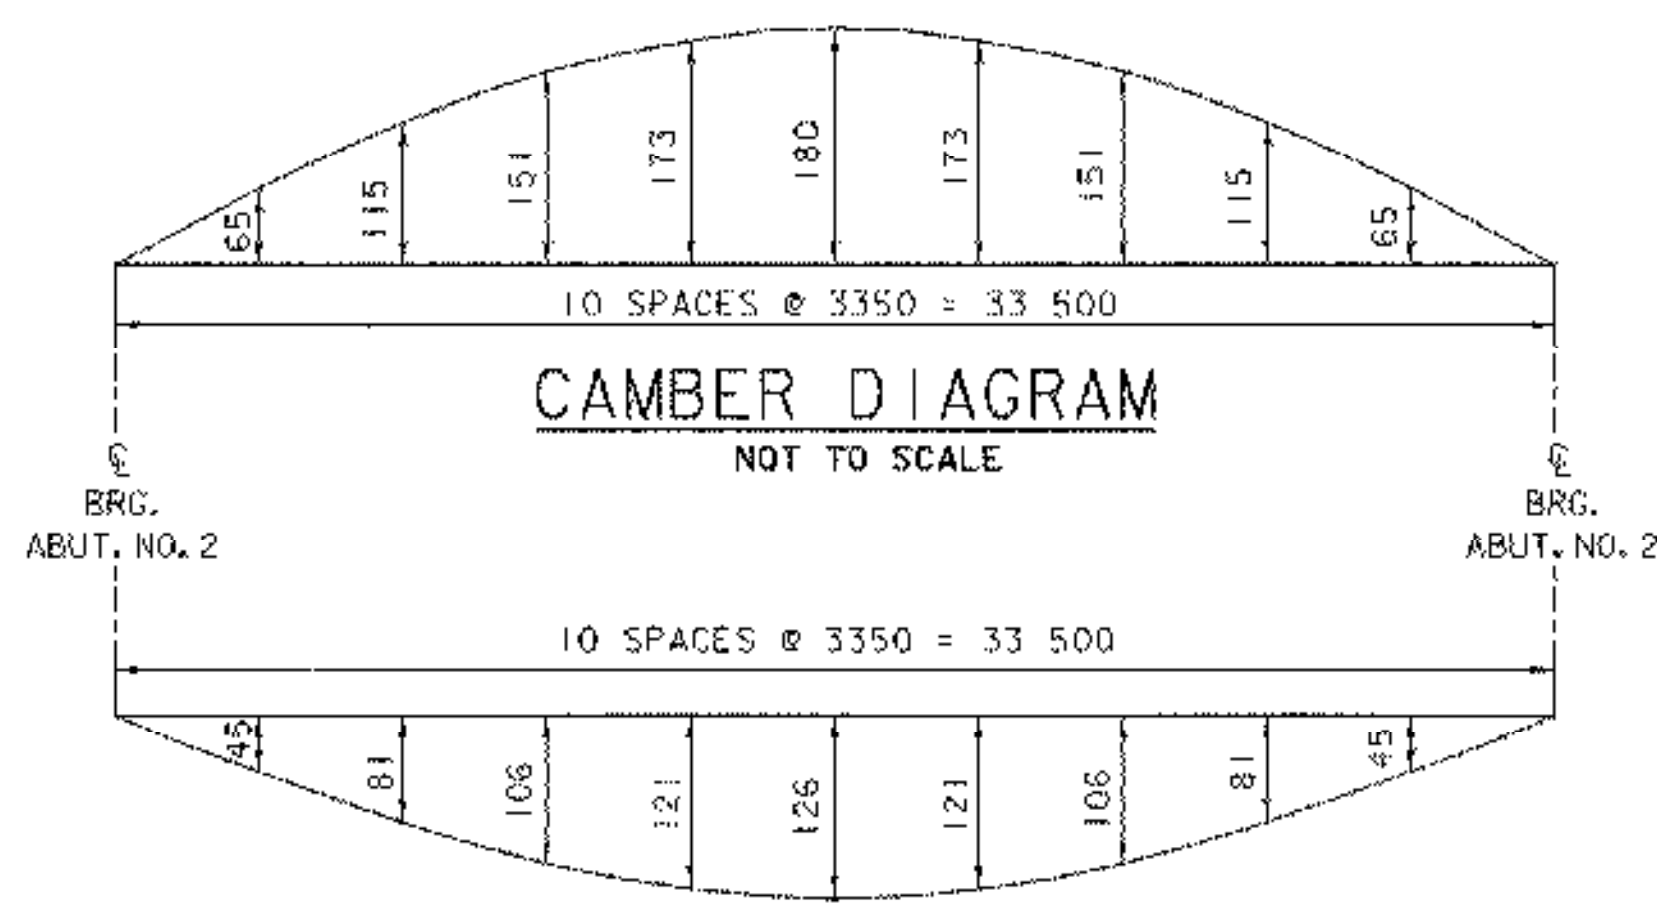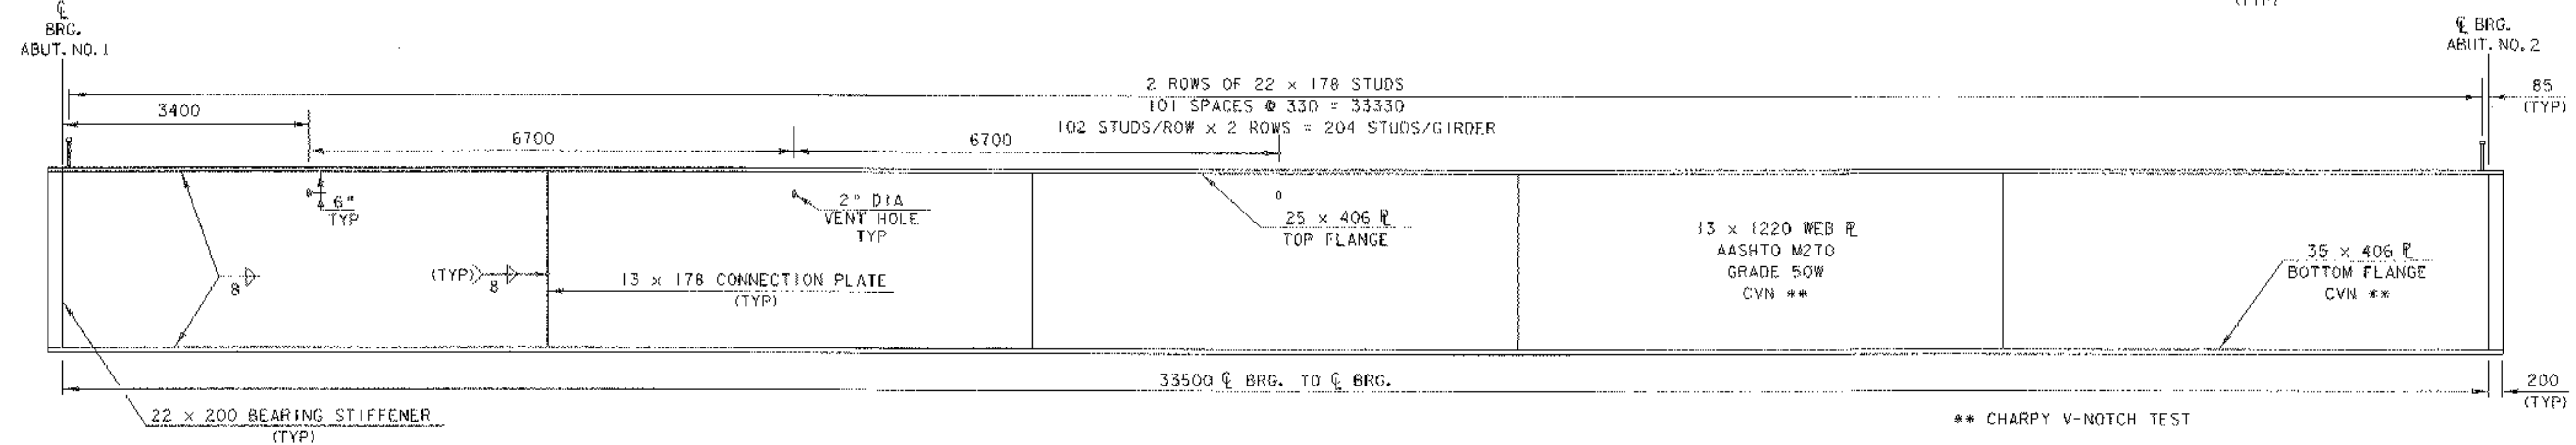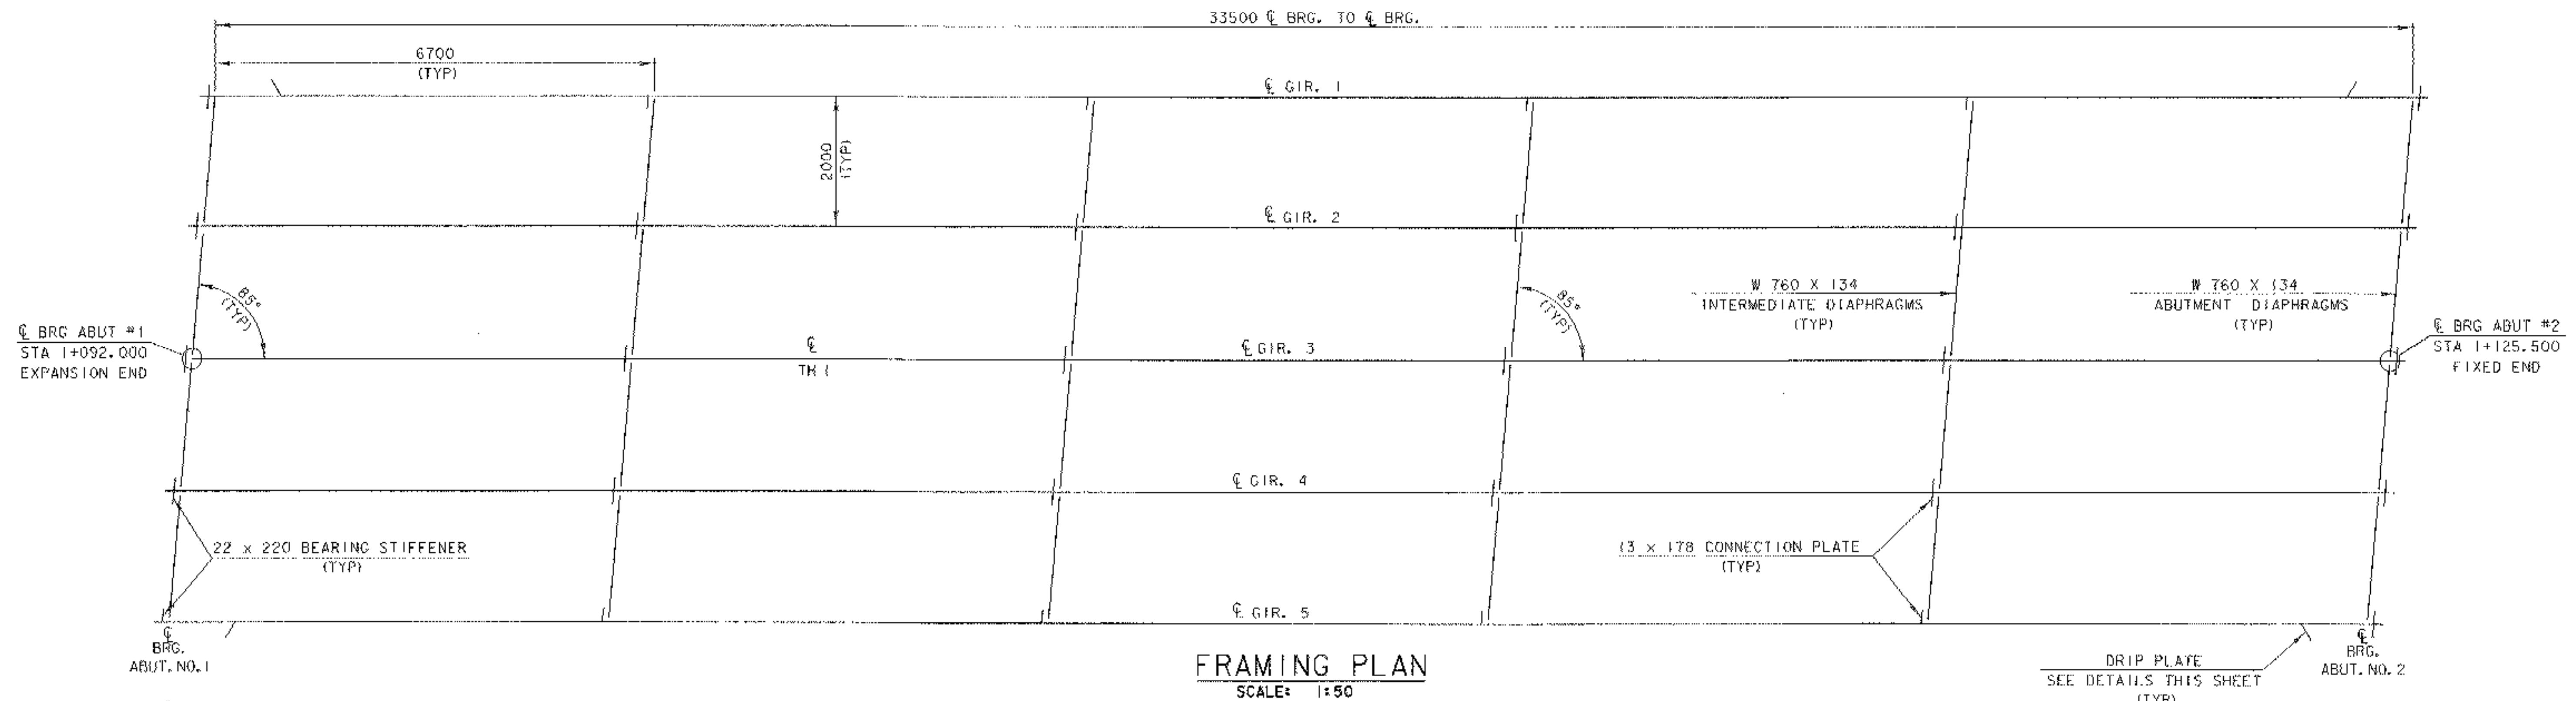


DEAD LOAD DEFLECTION
NOT TO SCALE


NOTE: DEAD LOAD DEFLECTION IS DUE TO GIRDER, DIAPHRAGMS, DECK, CURBS, PAVEMENT AND RAILING.

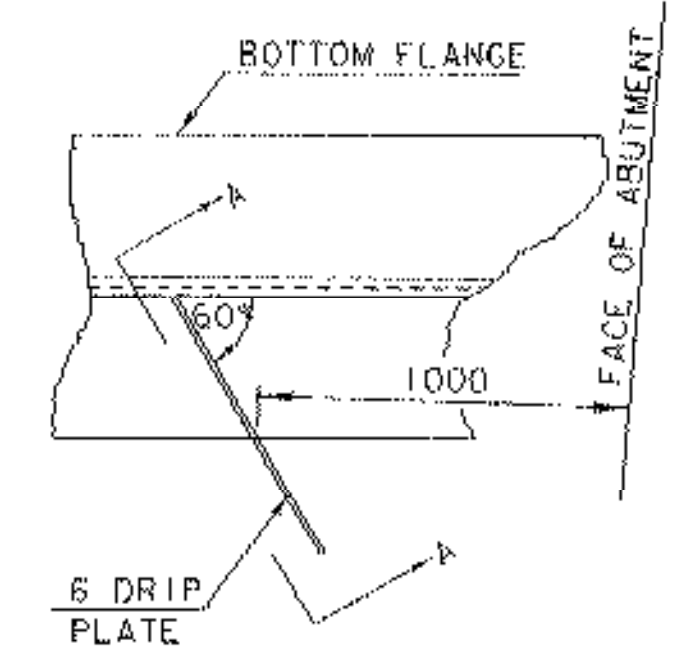

PLAN DRIP PLATE
NOT TO SCALE

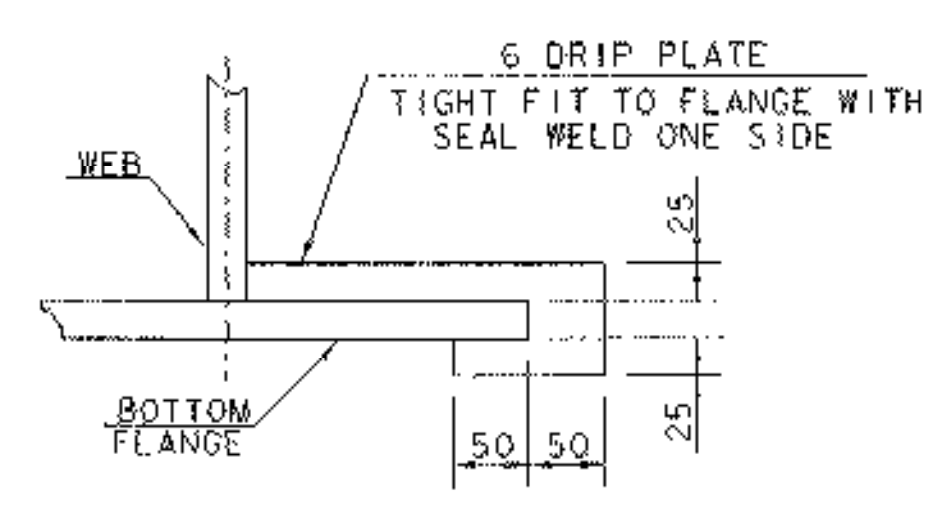


SECTION A - A
NOT TO SCALE

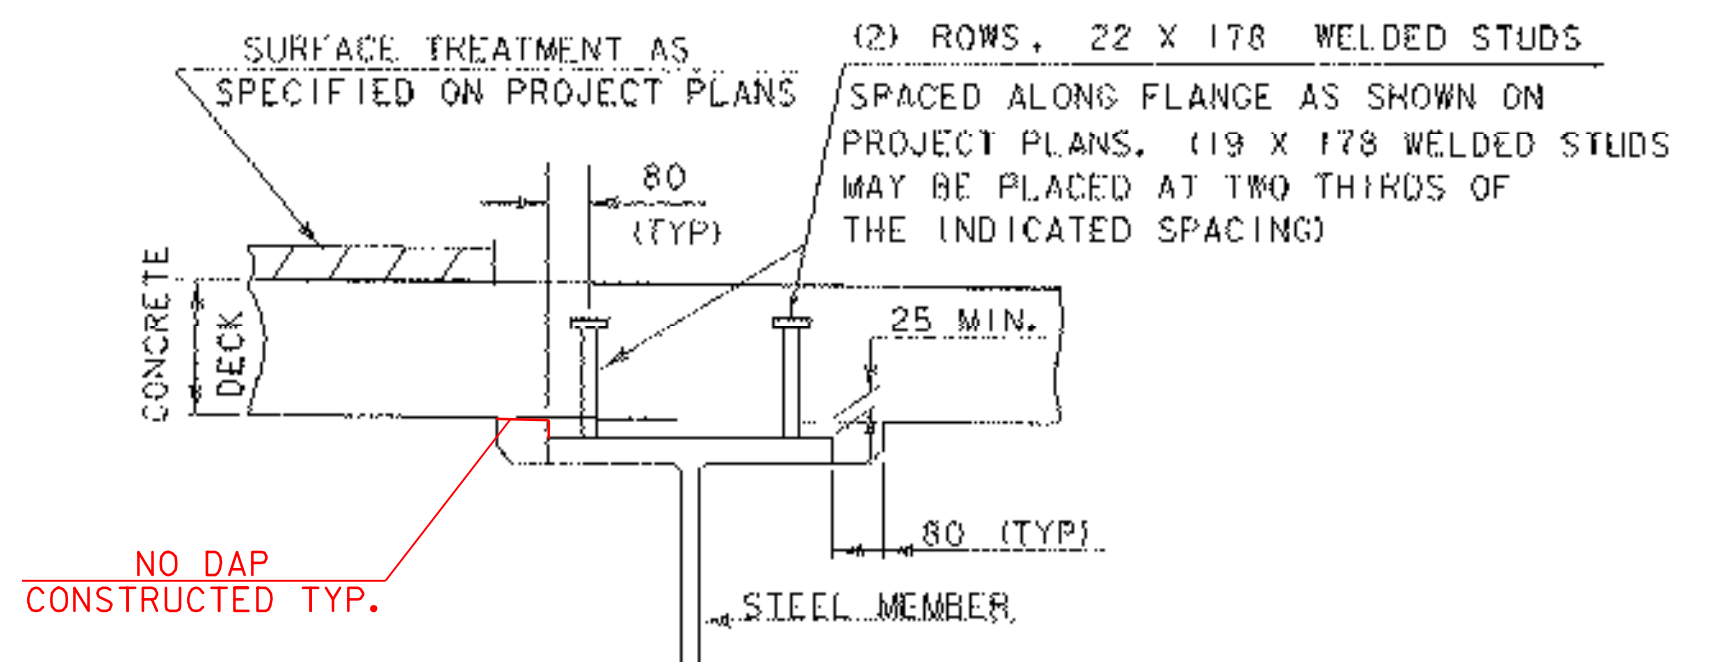


NOTE: THE 80 HORIZONTAL SECTION MAY BE ELIMINATED FOR FORMING SYSTEMS DESIGNED FOR THE CONSTRUCTION OF VERTICAL HAUNCHES IF APPROVED BY THE STRUCTURES ENGINEER

BORG HANGERS APPROVED AND USED.


SHEET NAME: FRAMING PLAN	
PROJECT NAME: LEICESTER	HIGHWAY NO.: TH 1
PROJECT NUMBER: BRF 0160(3)S	BRIDGE NO.: 6
	OVER: OTTER CREEK
FILE NAME: /PW/95J288/sj288sup.dgn	PLOT DATE: 17-AUG-2005
PROJECT MANAGER: R. R. WHITCOMB	DRAWN BY: T. FILLBACH
DESIGNED BY: C. CARLSON	IPARM NAME: sj288frm.i
BRIDGE SHEET NUMBER:	SHEET 49 OF 90

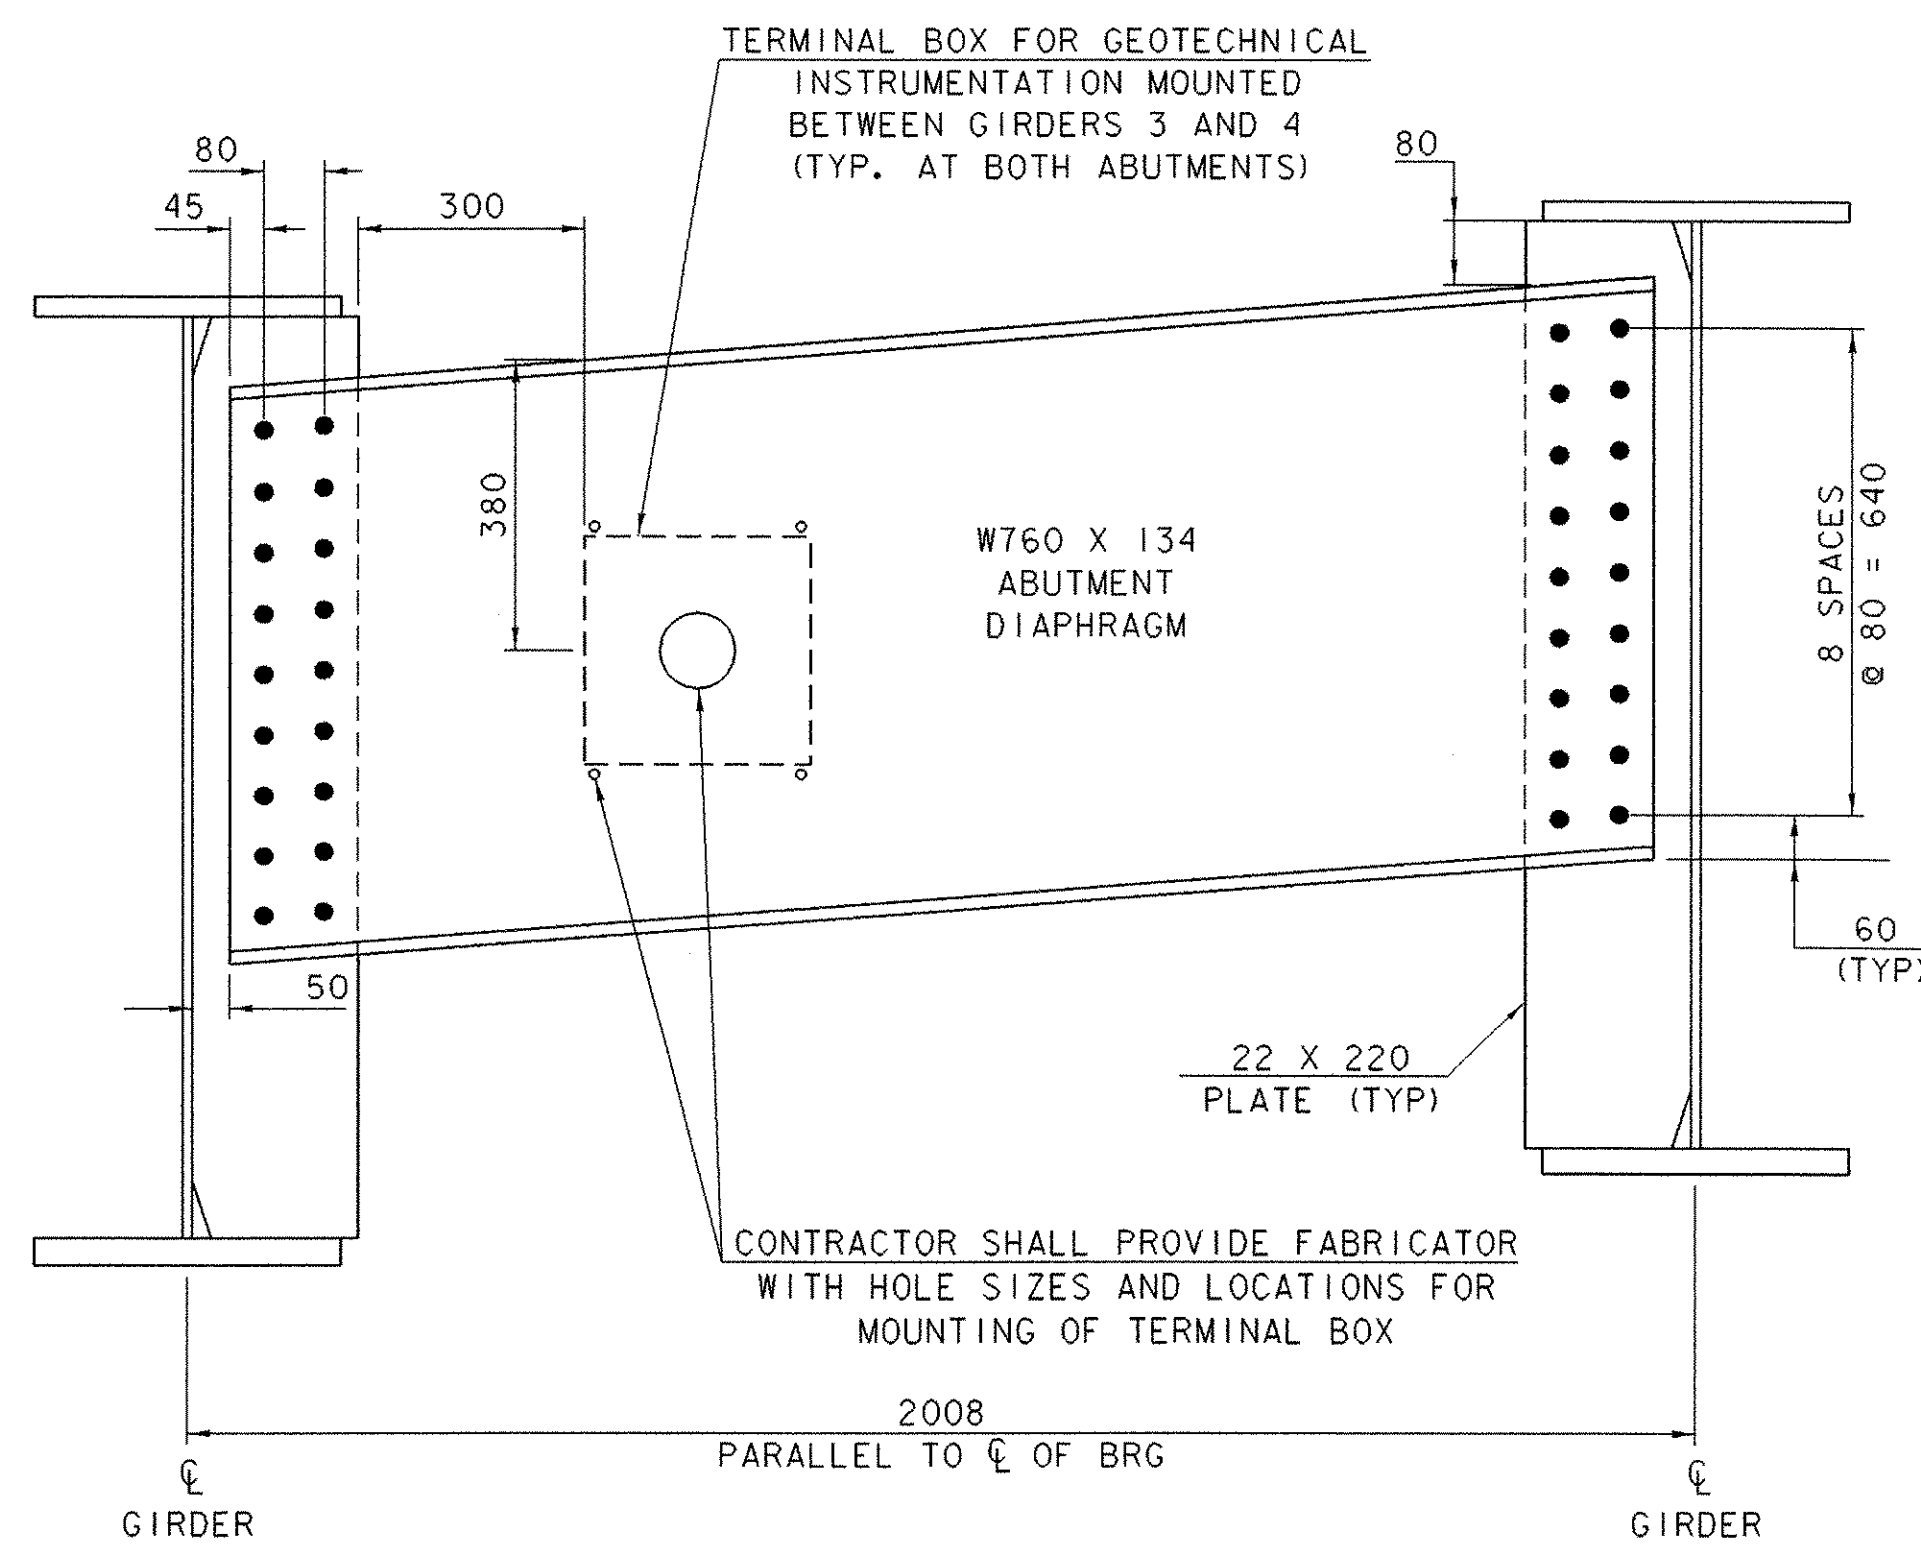

ABUTMENT DIAPHRAGM
SCALE 1 : 10

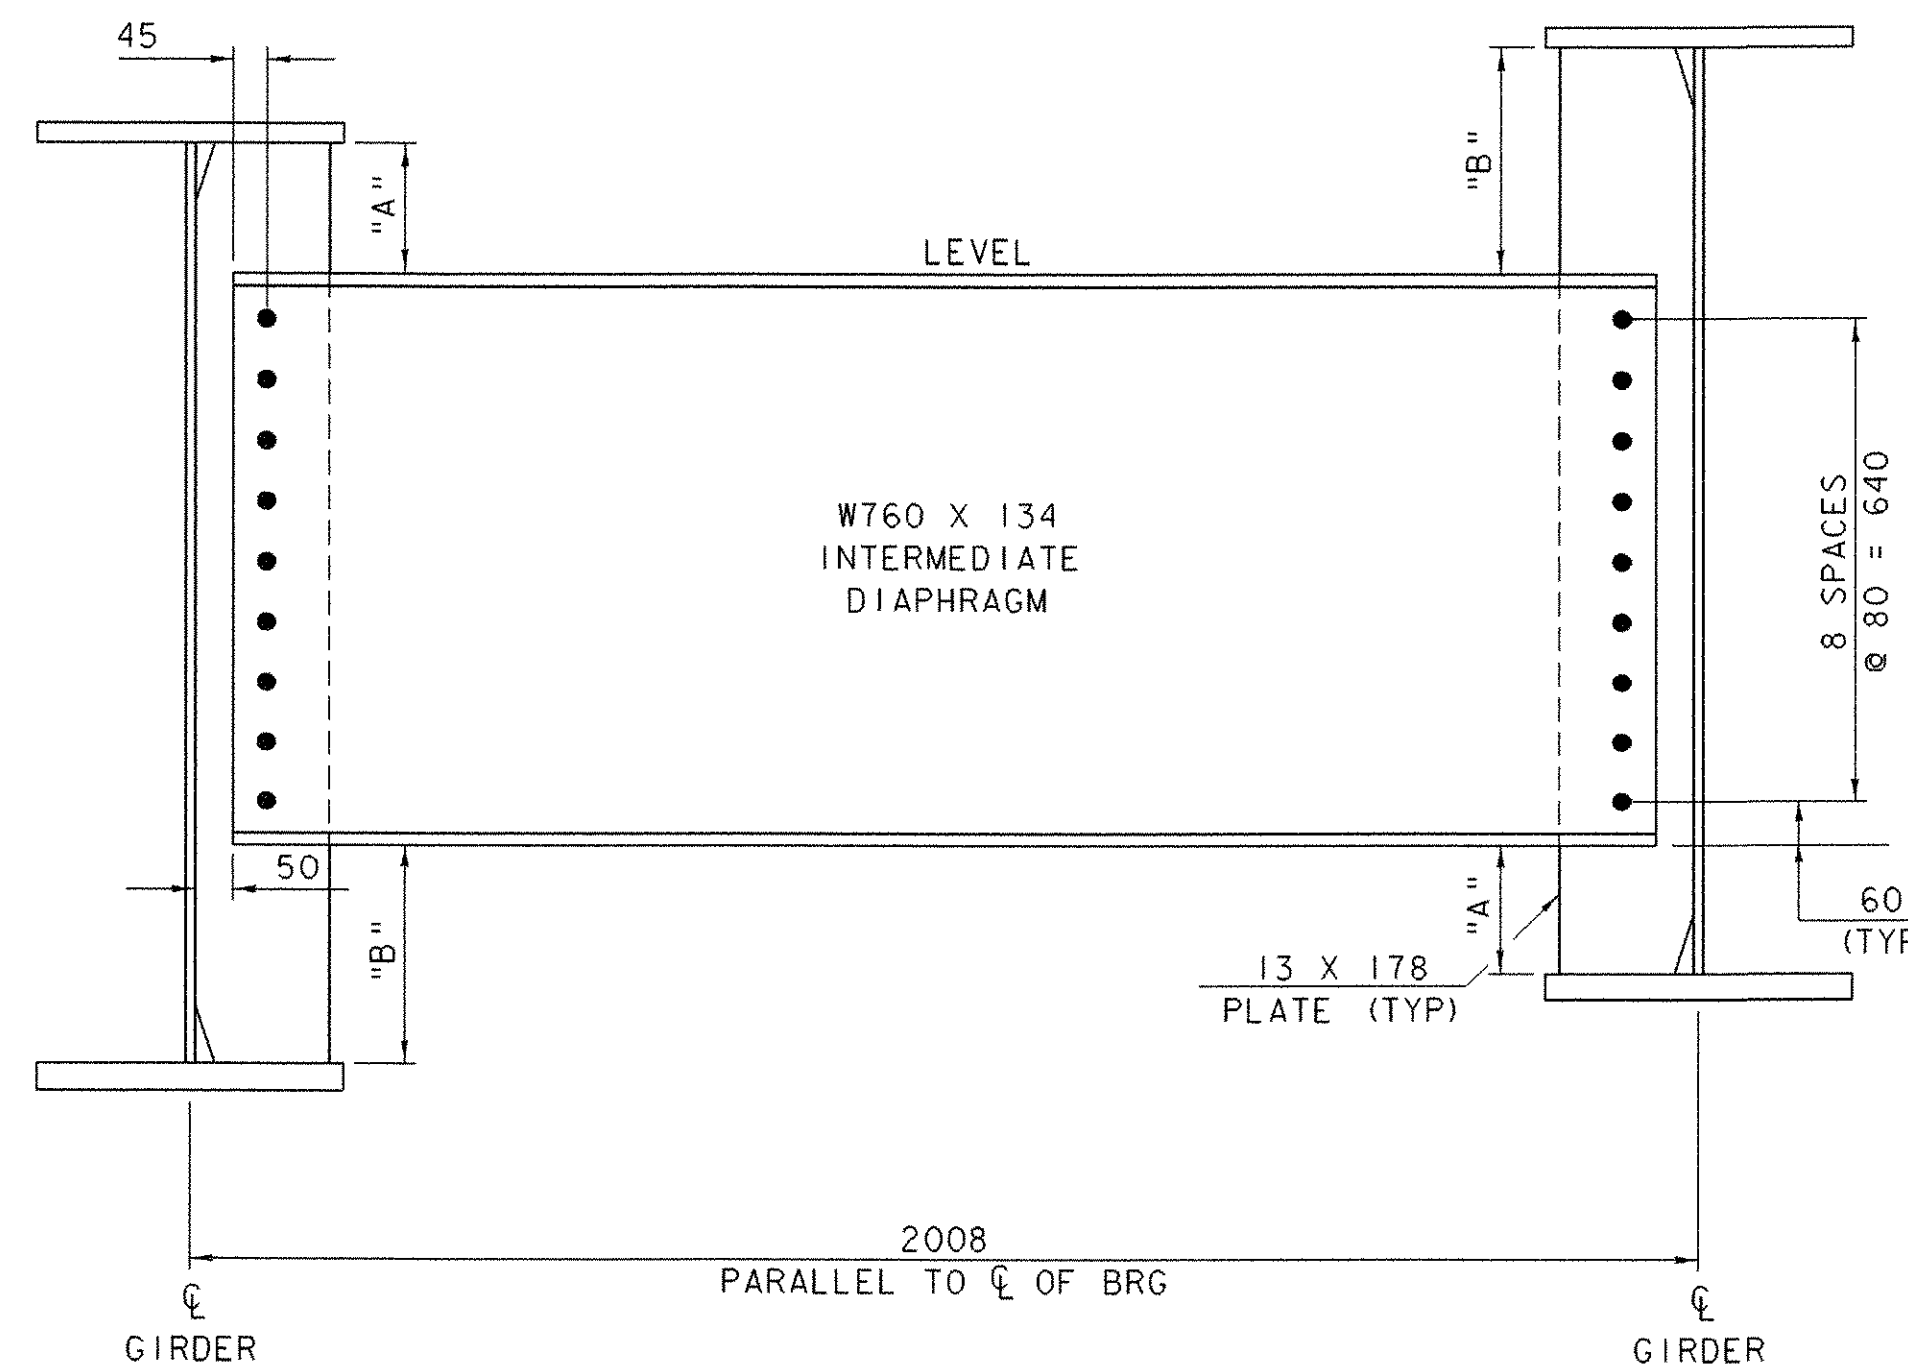


INTERMEDIATE DIAPHRAGM
SCALE 1 : 10

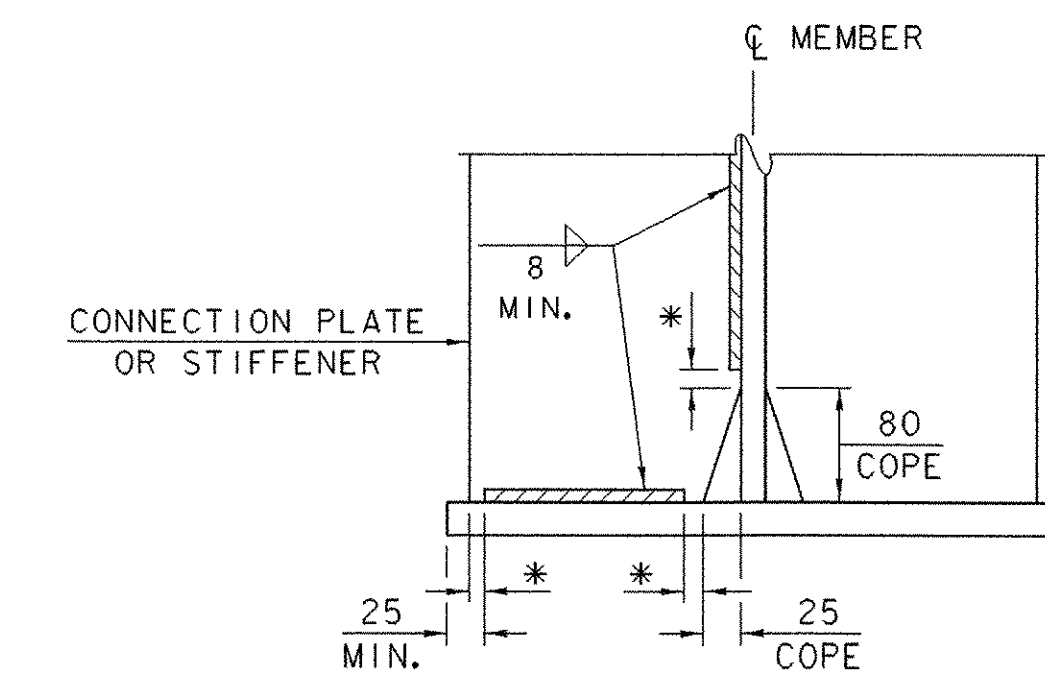


WELD TERMINATION AND COPING DETAIL FOR STEEL MEMBERS

* NO WELD FOR 10 MIN. , 22 MAX. (EXCEPT MUST MAINTAIN 25 MIN. FROM EDGE OF FLANGE)

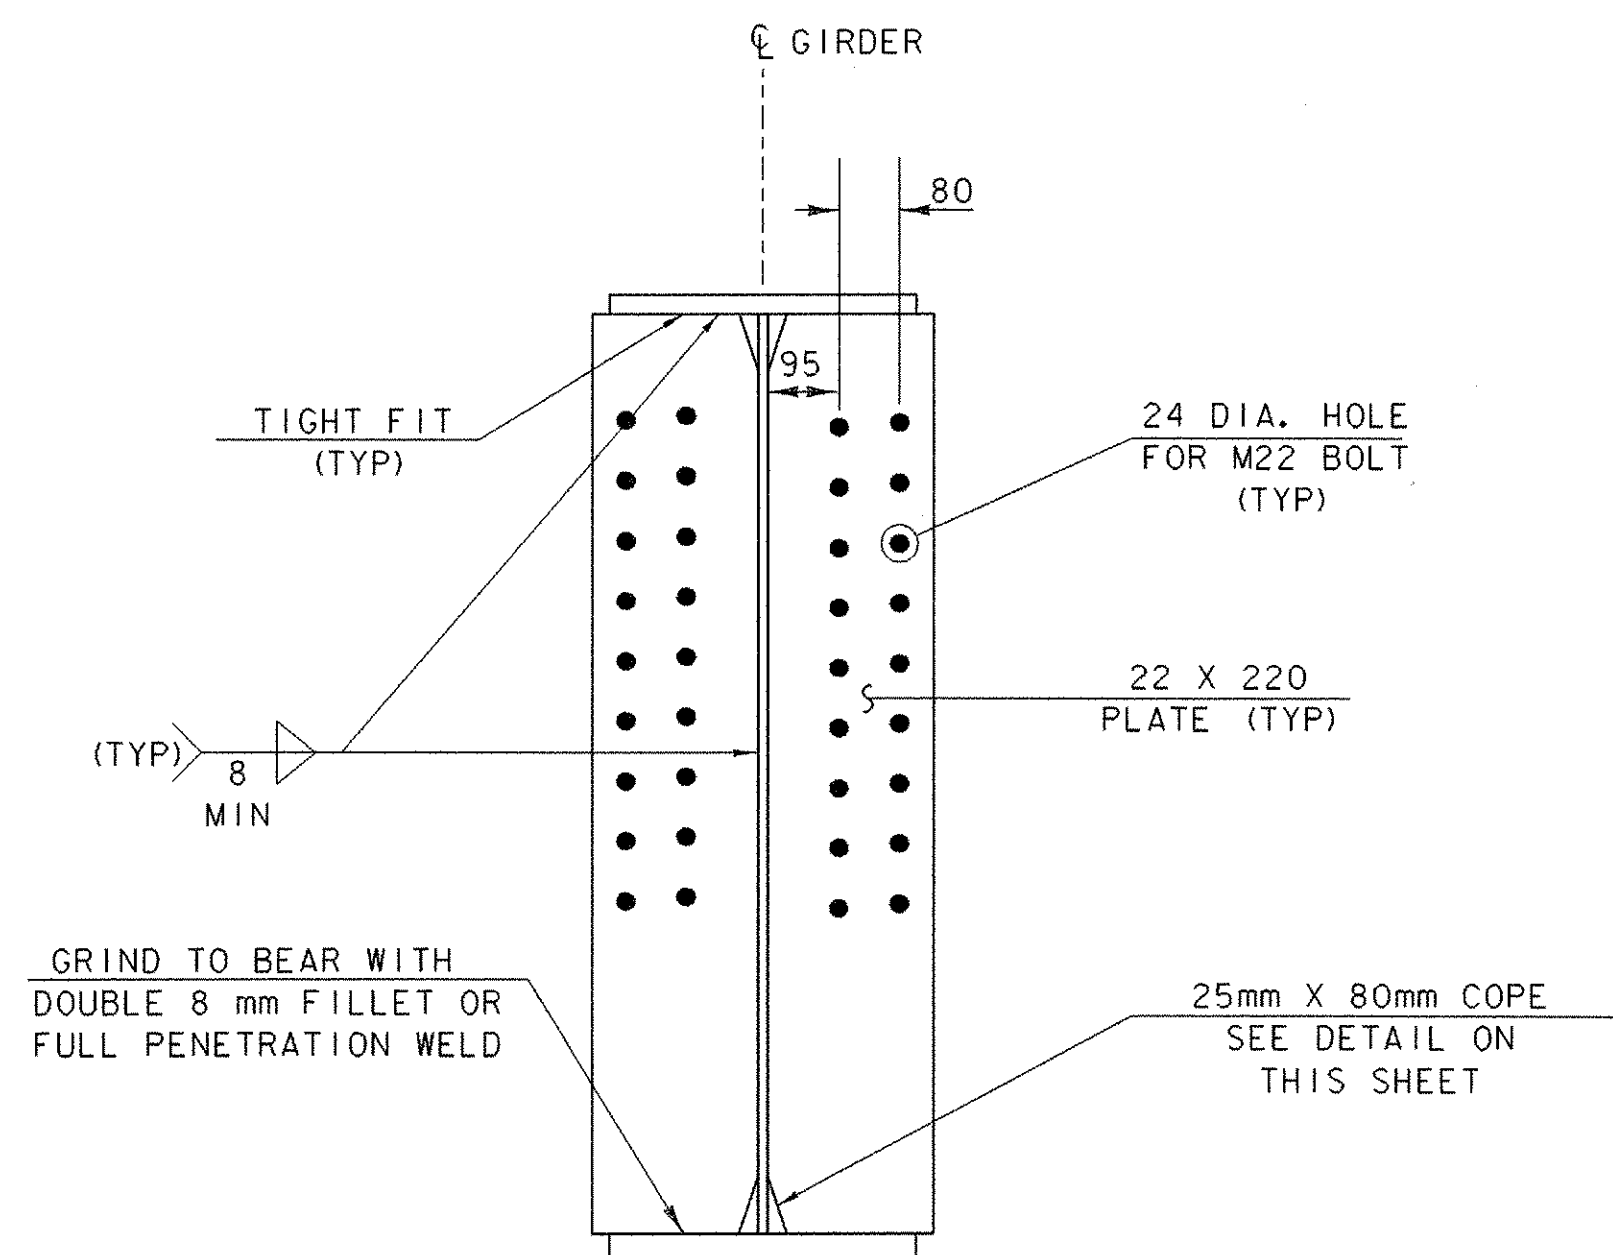


ABUTMENT BEARING STIFFENER DETAIL
SCALE 1 : 10

NOTE: OMIT HOLES IN THE STIFFENERS ON THE OUTSIDE OF THE FASCIA GIRDERS.

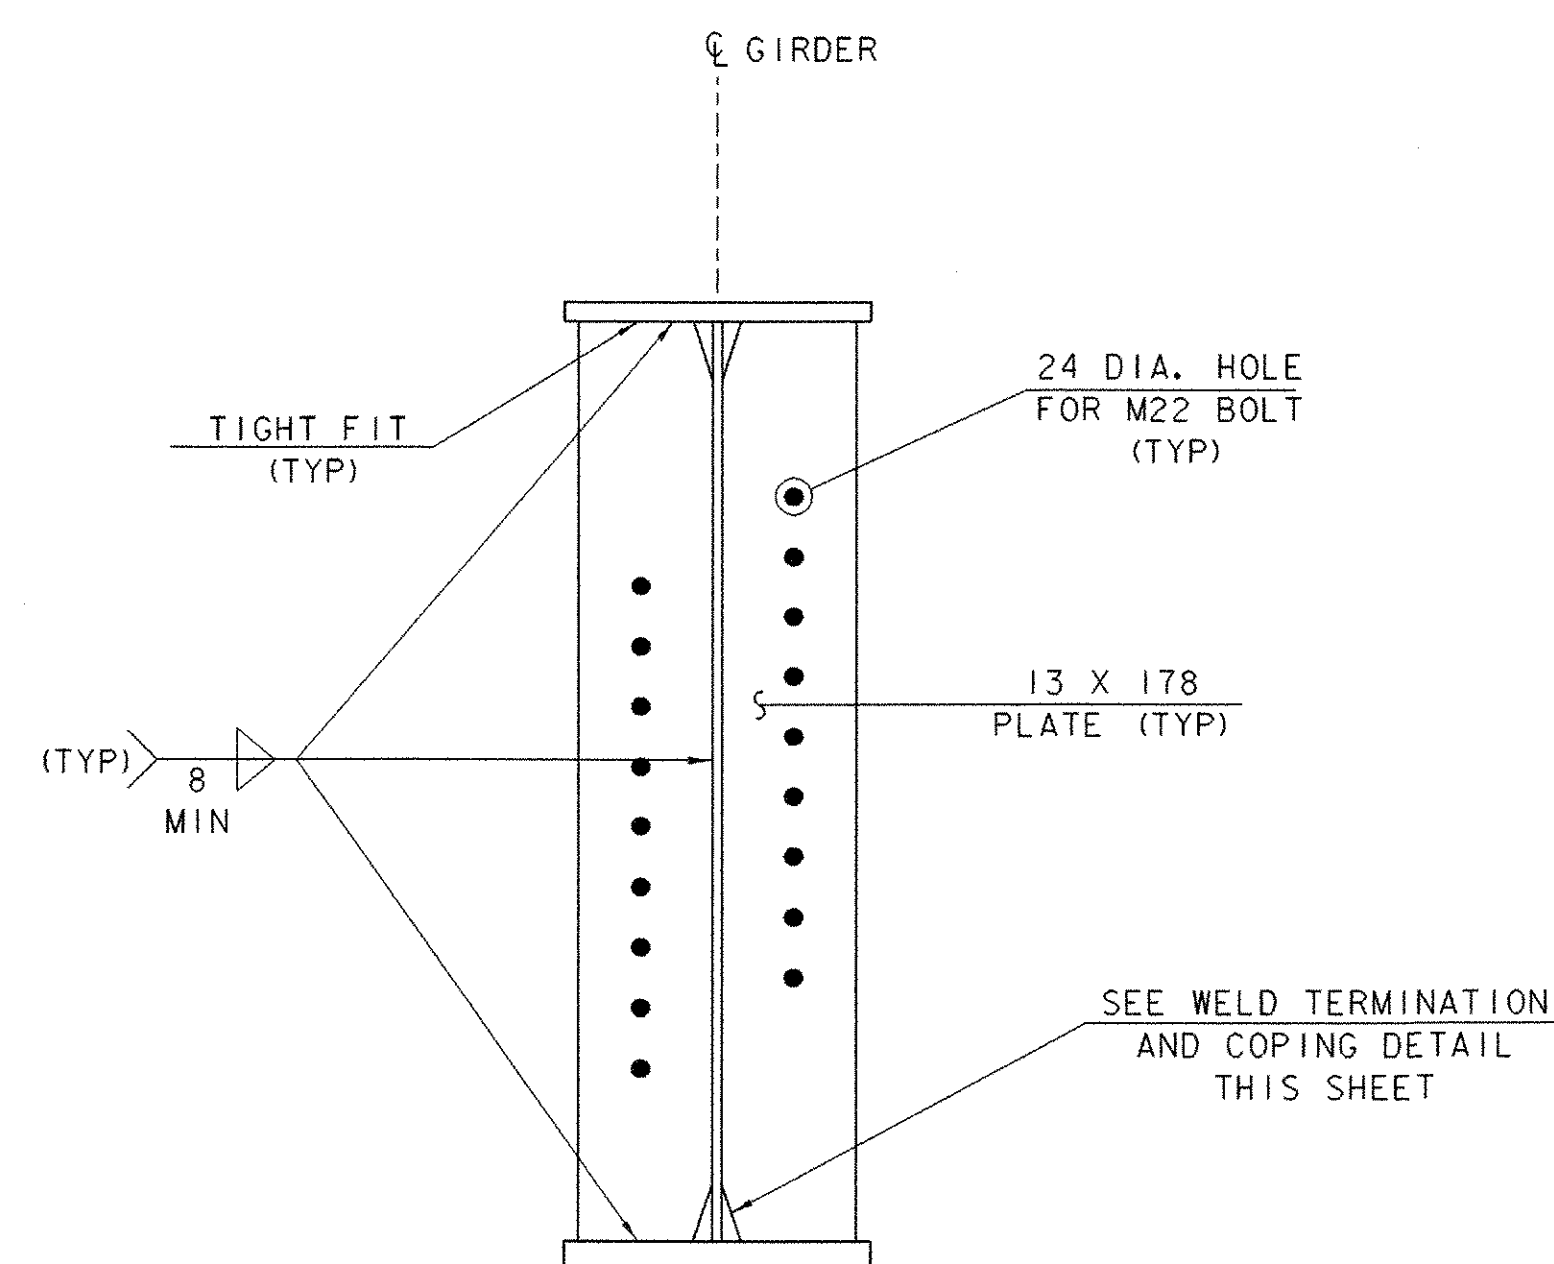


INTERMEDIATE DIAPHRAGM CONNECTION PLATE DETAIL
SCALE 1 : 10

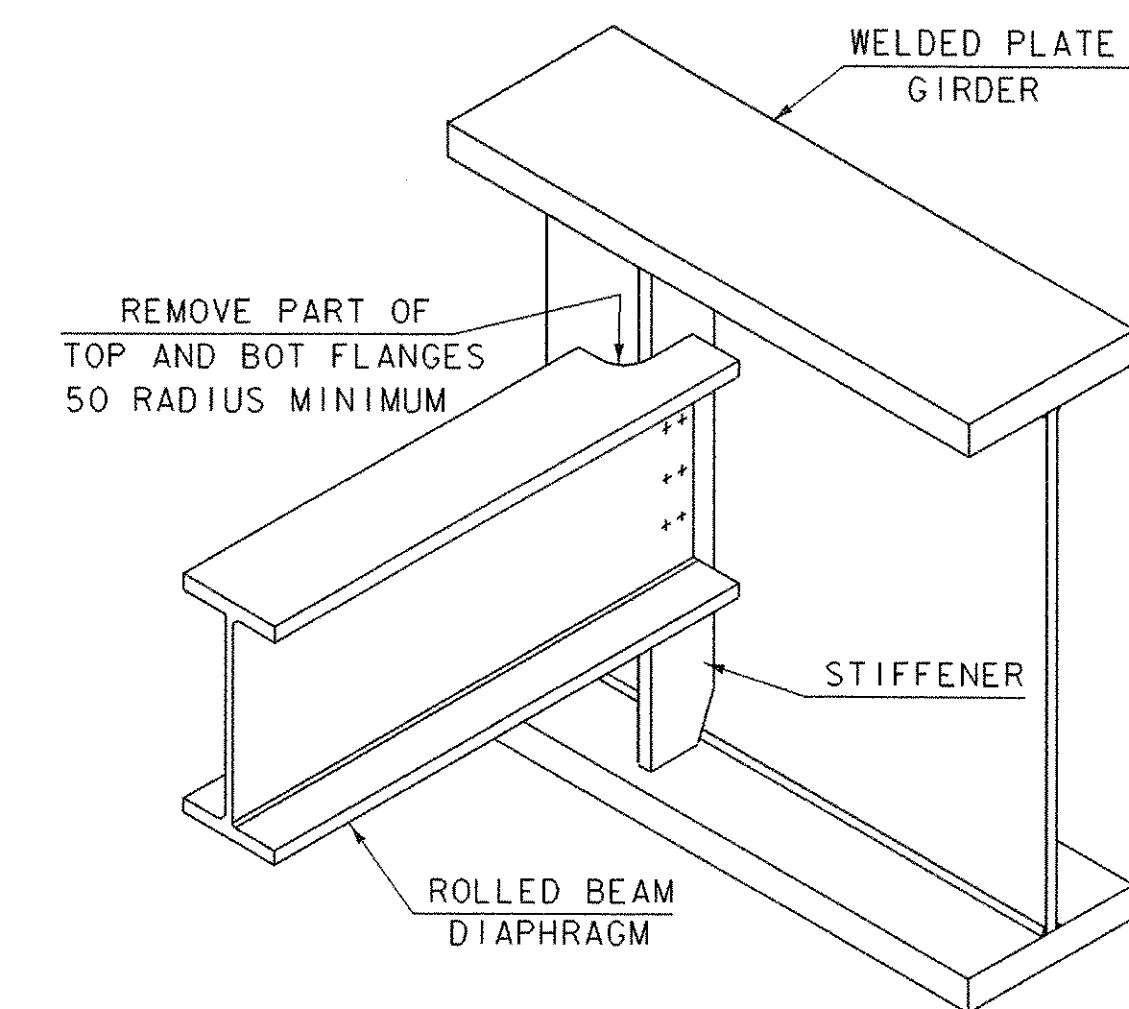

SEE CONTRACT DRAWINGS FOR SIZES OF MEMBERS AND CONNECTION DETAILS

ROLLED BEAM USED AS DIAPHRAGM
NOT TO SCALE


SHEET NAME: STRUCTURAL STEEL DETAILS	
PROJECT NAME: LEICESTER	HIGHWAY NO.: TH 1
PROJECT NUMBER: BRF 0160(3)S	BRIDGE NO.: 6
	OVER: OTTER CREEK
FILE NAME: 95j288\Structures\sj288sup.dgn	PLOT DATE: 17-AUG-2005
PROJECT MANAGER: R. R. WHITCOMB	DRAWN BY: M. HALE
DESIGNED BY: C. CARLSON	IPARM NAME: sj288ssd.1
BRIDGE SHEET NUMBER:	SHEET 50 OF 90

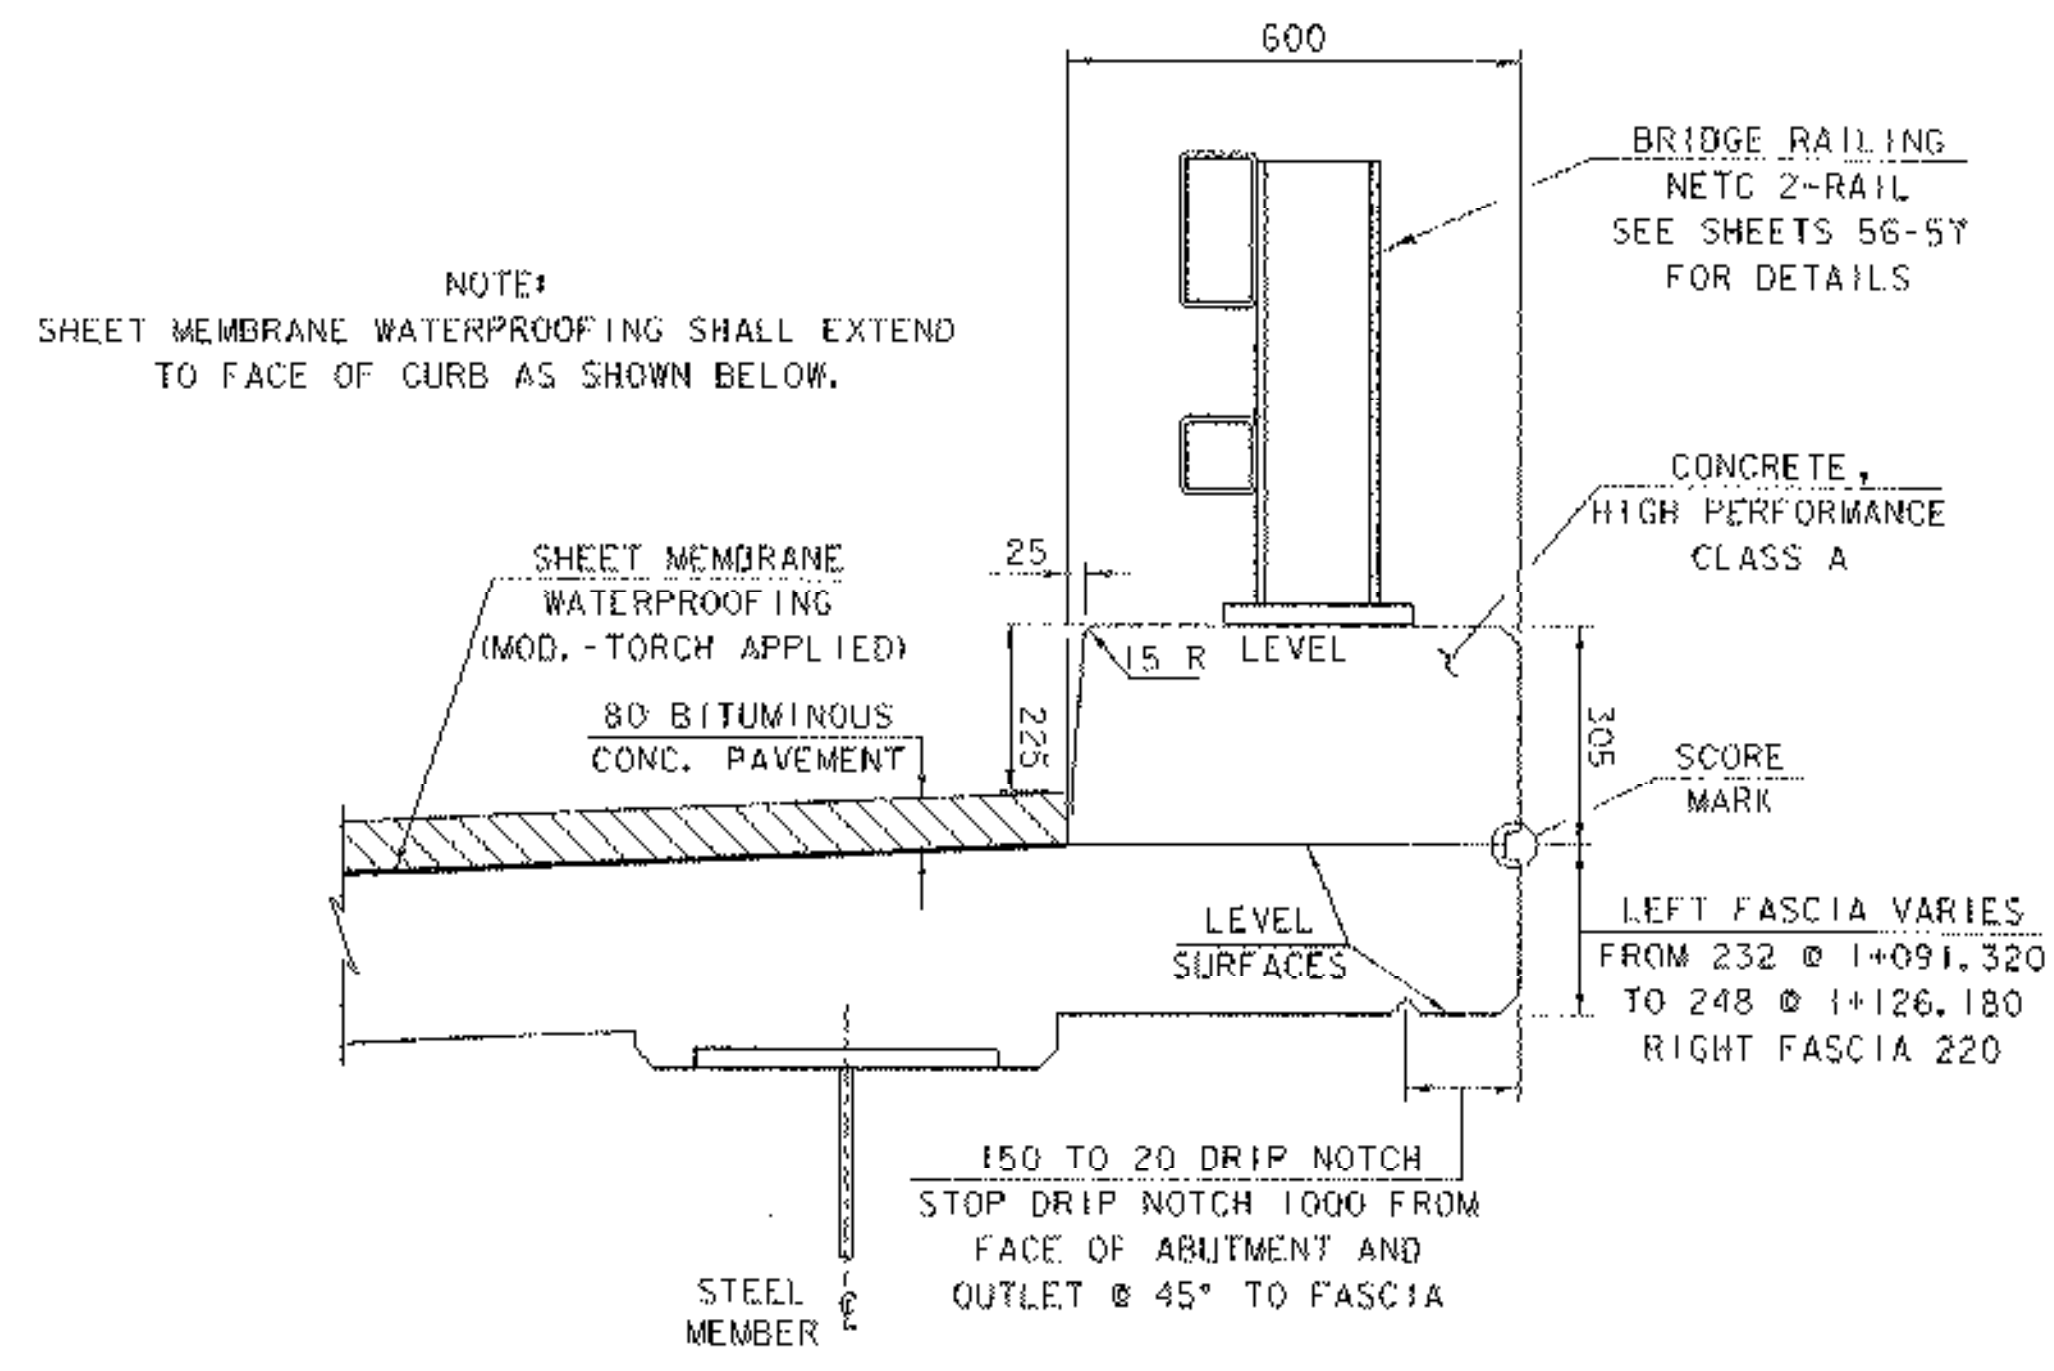


TYPICAL 600 CURB SECTION

P.V.C. WATERSTOP FOR CONSTRUCTION JOINTS


THE COST FOR P.V.C. WATERSTOP SHALL BE INCLUDED IN THE UNIT PRICE BID FOR THE CONCRETE. OTHER CONFIGURATIONS MAY BE USED UPON APPROVAL OF THE STRUCTURES ENGINEER.

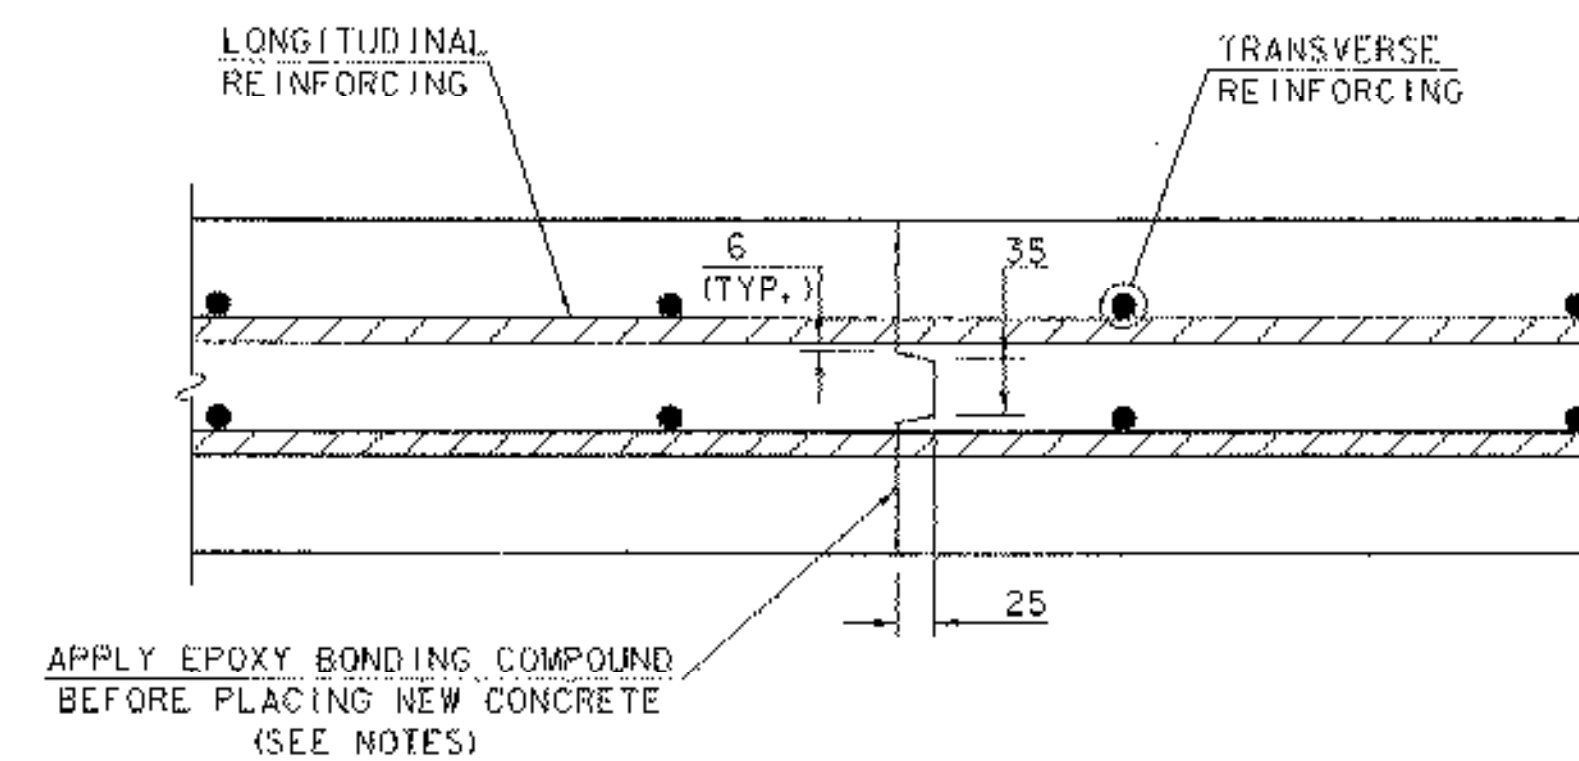

TRANSVERSE BRIDGE DECK CONSTRUCTION JOINT DETAILS

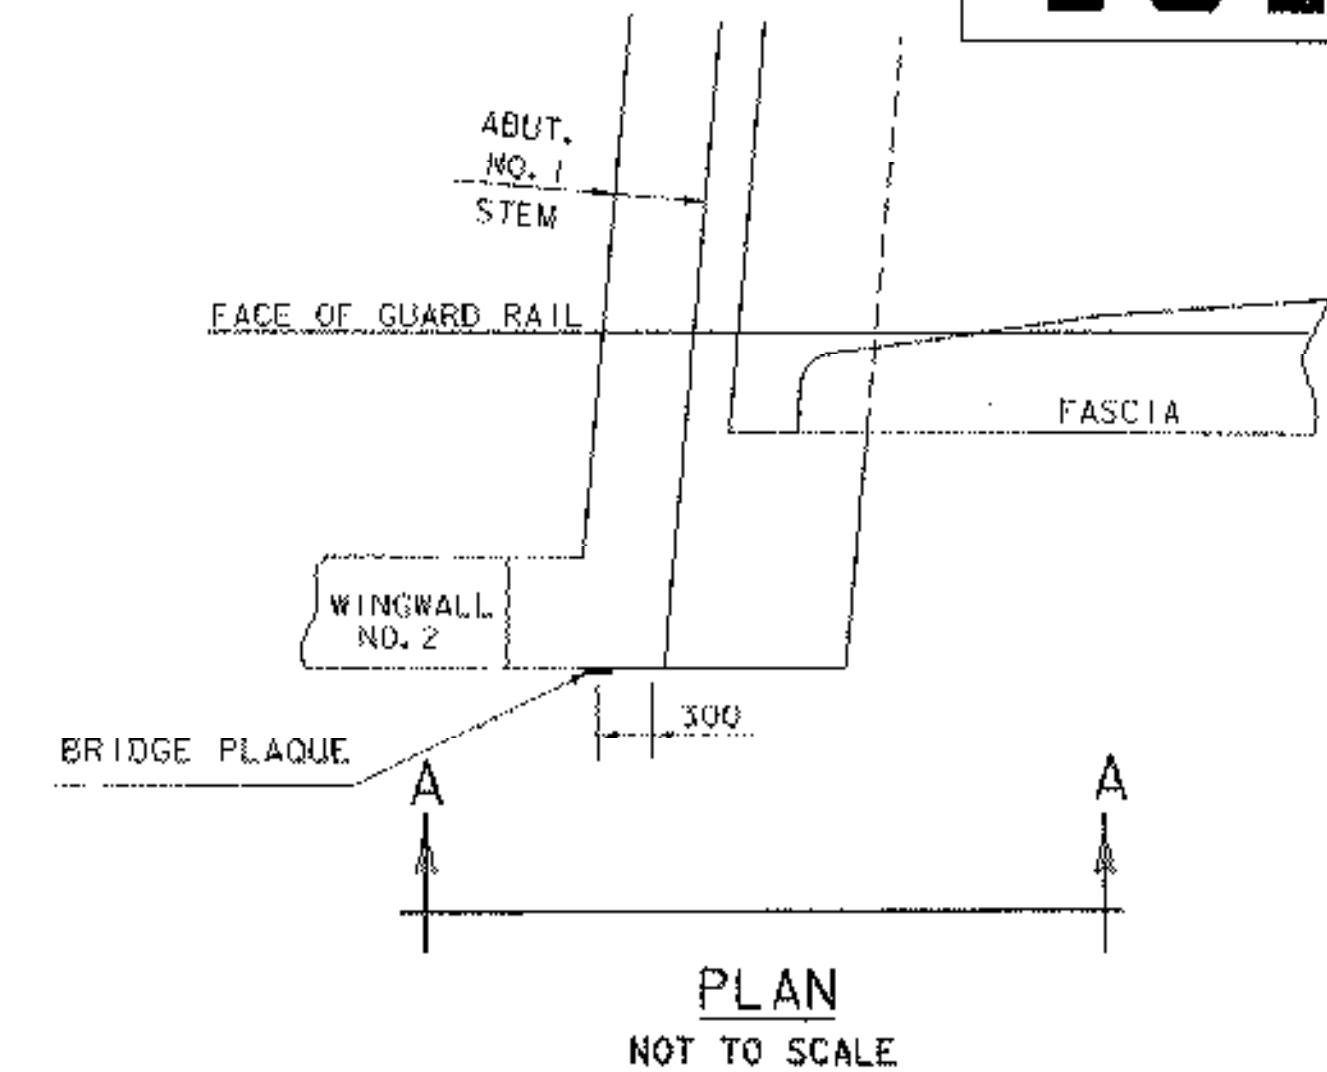


PLAN NOT TO SCALE

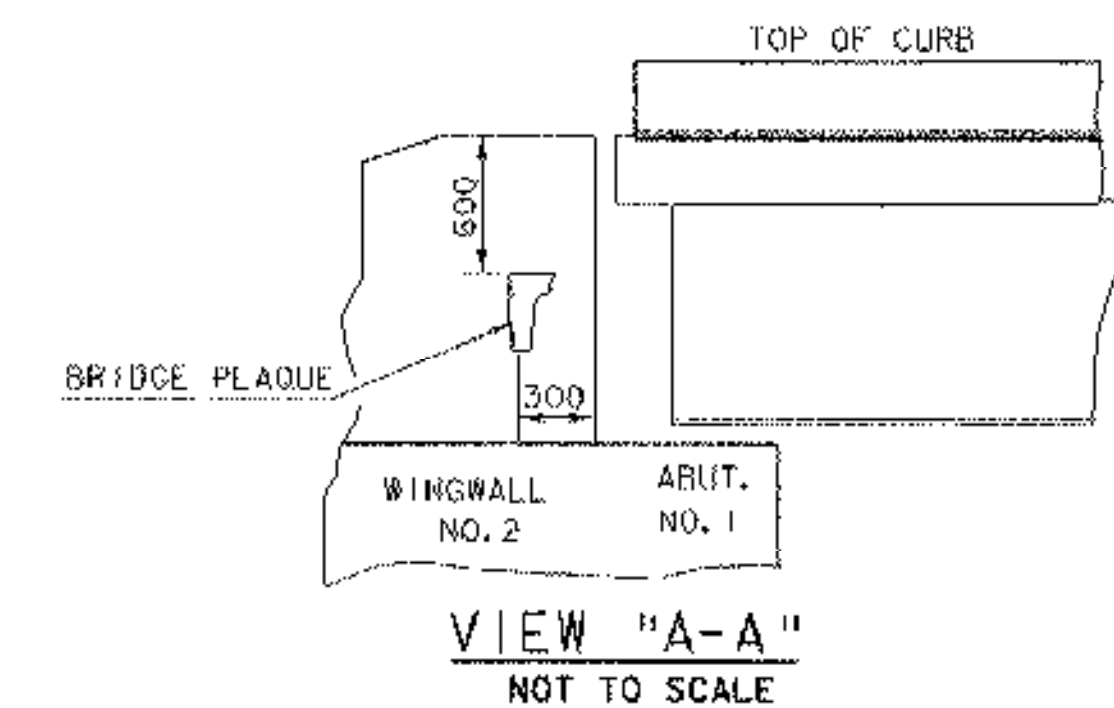


VIEW "A-A" NOT TO SCALE

LOCATE BRIDGE PLAQUE


THE BRIDGE PLAQUE WILL BE SUPPLIED BY THE AGENCY OF TRANSPORTATION AND SHALL BE INSTALLED BY THE CONTRACTOR AS SHOWN OR AS DIRECTED BY THE ENGINEER.

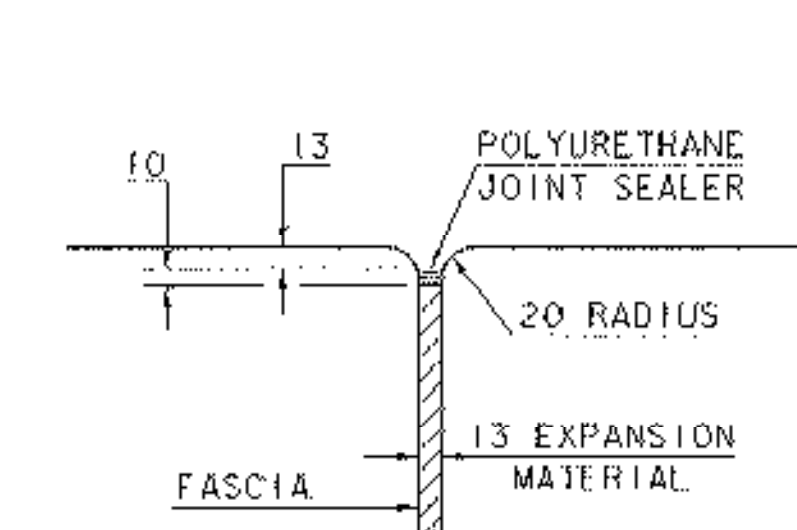


JOINT BETWEEN FASCIA AND WINGWALL NOT TO SCALE

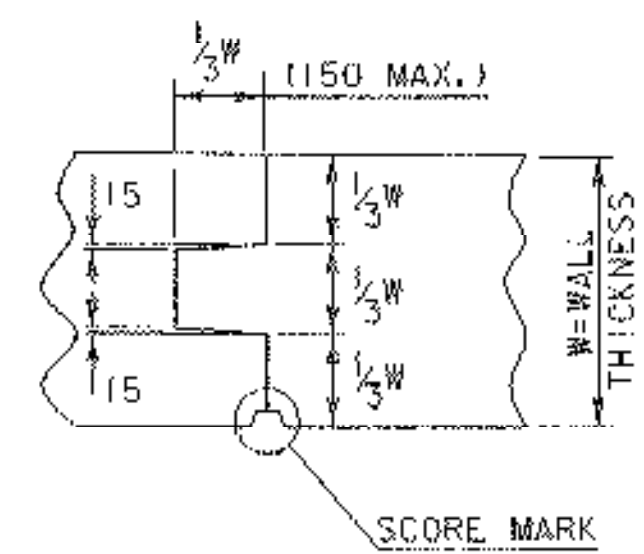


TYPICAL CONCRETE CONSTRUCTION JOINT NOT TO SCALE

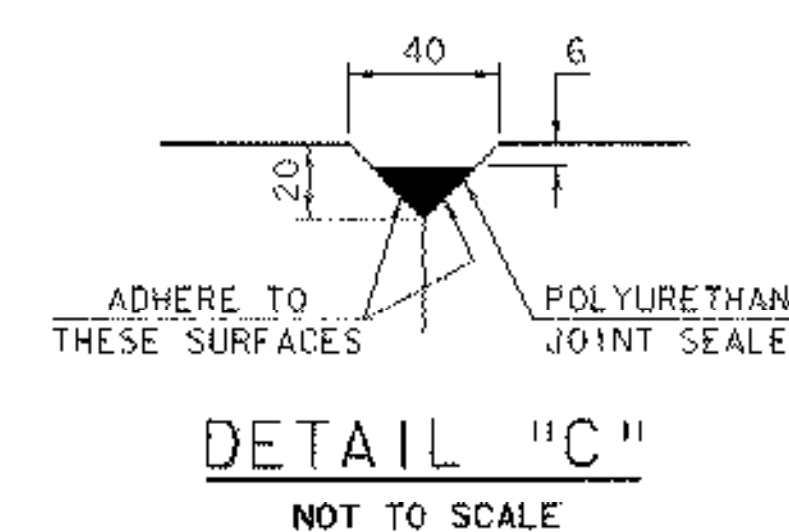


DETAIL "C" NOT TO SCALE

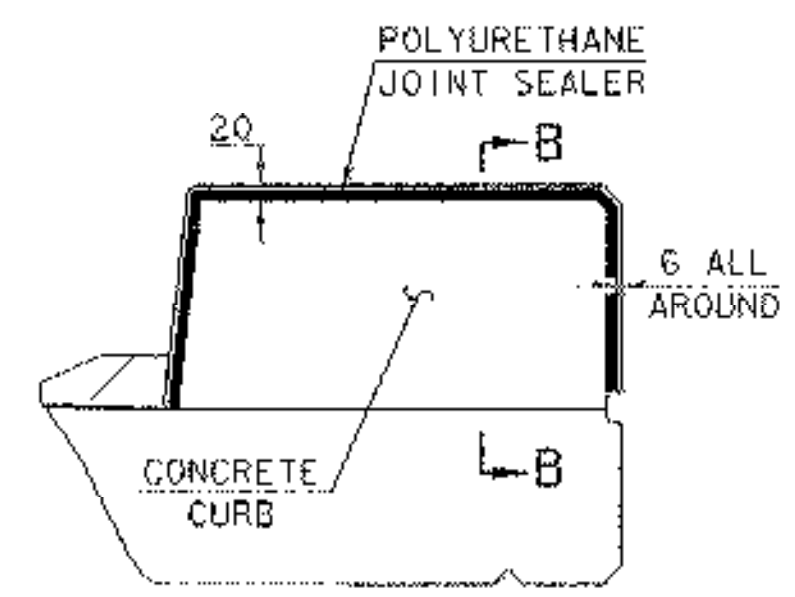

TYPICAL SECTION THROUGH CONCRETE CURB CONSTRUCTION JOINT NOT TO SCALE

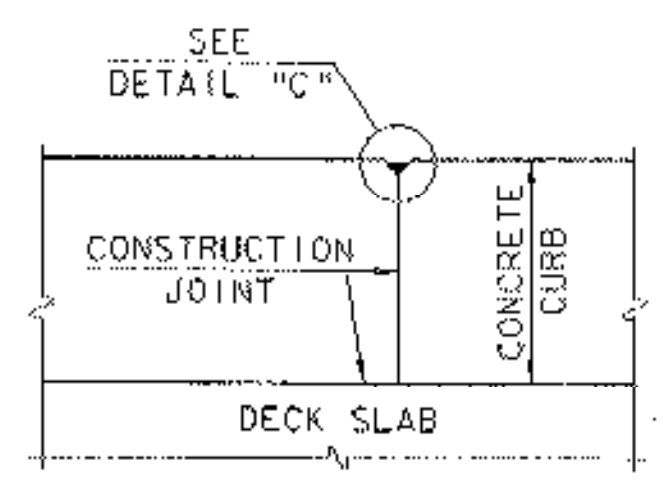

SECTION B-B NOT TO SCALE

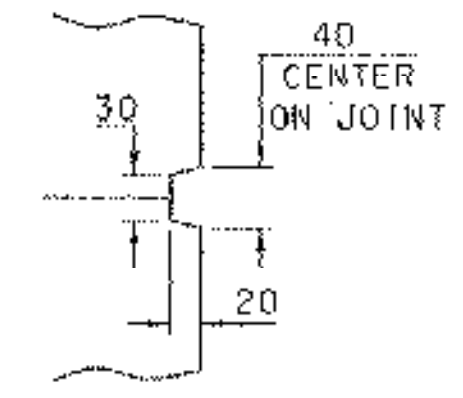


SCORE MARK DETAIL

NOTES


1. TORCH APPLIED MEMBRANE SHALL EXTEND TO FACE OF CURB.
2. CONSTRUCTION JOINTS THROUGH CONCRETE CURBS SHALL BE SPACED A MAXIMUM OF 4500 CENTER TO CENTER AND SHALL BE 550 MINIMUM FROM THE CENTER OF THE NEAREST BRIDGE RAIL POST. CONCRETE SHALL BE PLACED IN ALTERNATE SECTIONS WITH A MINIMUM OF 48 HOURS DELAY BETWEEN ADJACENT POORS.
3. LONGITUDINAL REINFORCING SHALL PASS THROUGH CONCRETE CONSTRUCTION JOINTS. CURB REINFORCING STIRRUP BARS SHALL BE TURNED AS REQUIRED TO FIT FLARED ENDS.
4. MATERIAL AND APPLICATION FOR POLYURETHANE JOINT SEALER SHALL MEET THE REQUIREMENTS OF SUBSECTIONS 707.05 AND 524.06 (d) OF THE STANDARD SPECIFICATIONS. PAYMENT SHALL BE MADE INCIDENTAL TO ITEM 501.33, "CONCRETE, HIGH PERFORMANCE CLASS A".
5. EPOXY BONDING COMPOUND SHALL BE PAID INCIDENTAL TO ITEM 501.33, "CONCRETE, HIGH PERFORMANCE CLASS A".

2. CURBS WERE CONSTRUCTED IN ONE POUR. FOUR CONTROL JOINTS CONSTRUCTED PER SIDE AT EQUAL SPACES.

SHEET NAME: CURB DETAILS	
PROJECT NAME: LEICESTER	HIGHWAY NO.: TH 1
PROJECT NUMBER: BRF 0160(3)S	BRIDGE NO.: 6
	OVER: OTTER CREEK
FILE NAME: 95J288\Structures\sj288sup.dgn	PLOT DATE: 17-AUG-2005
PROJECT MANAGER: R. R. WHITCOMB	DRAWN BY: T. FILLBACH
DESIGNED BY: C. CARLSON	SPARM NAME: sj288crb.f
BRIDGE SHEET NUMBER:	SHEET 51 OF 90

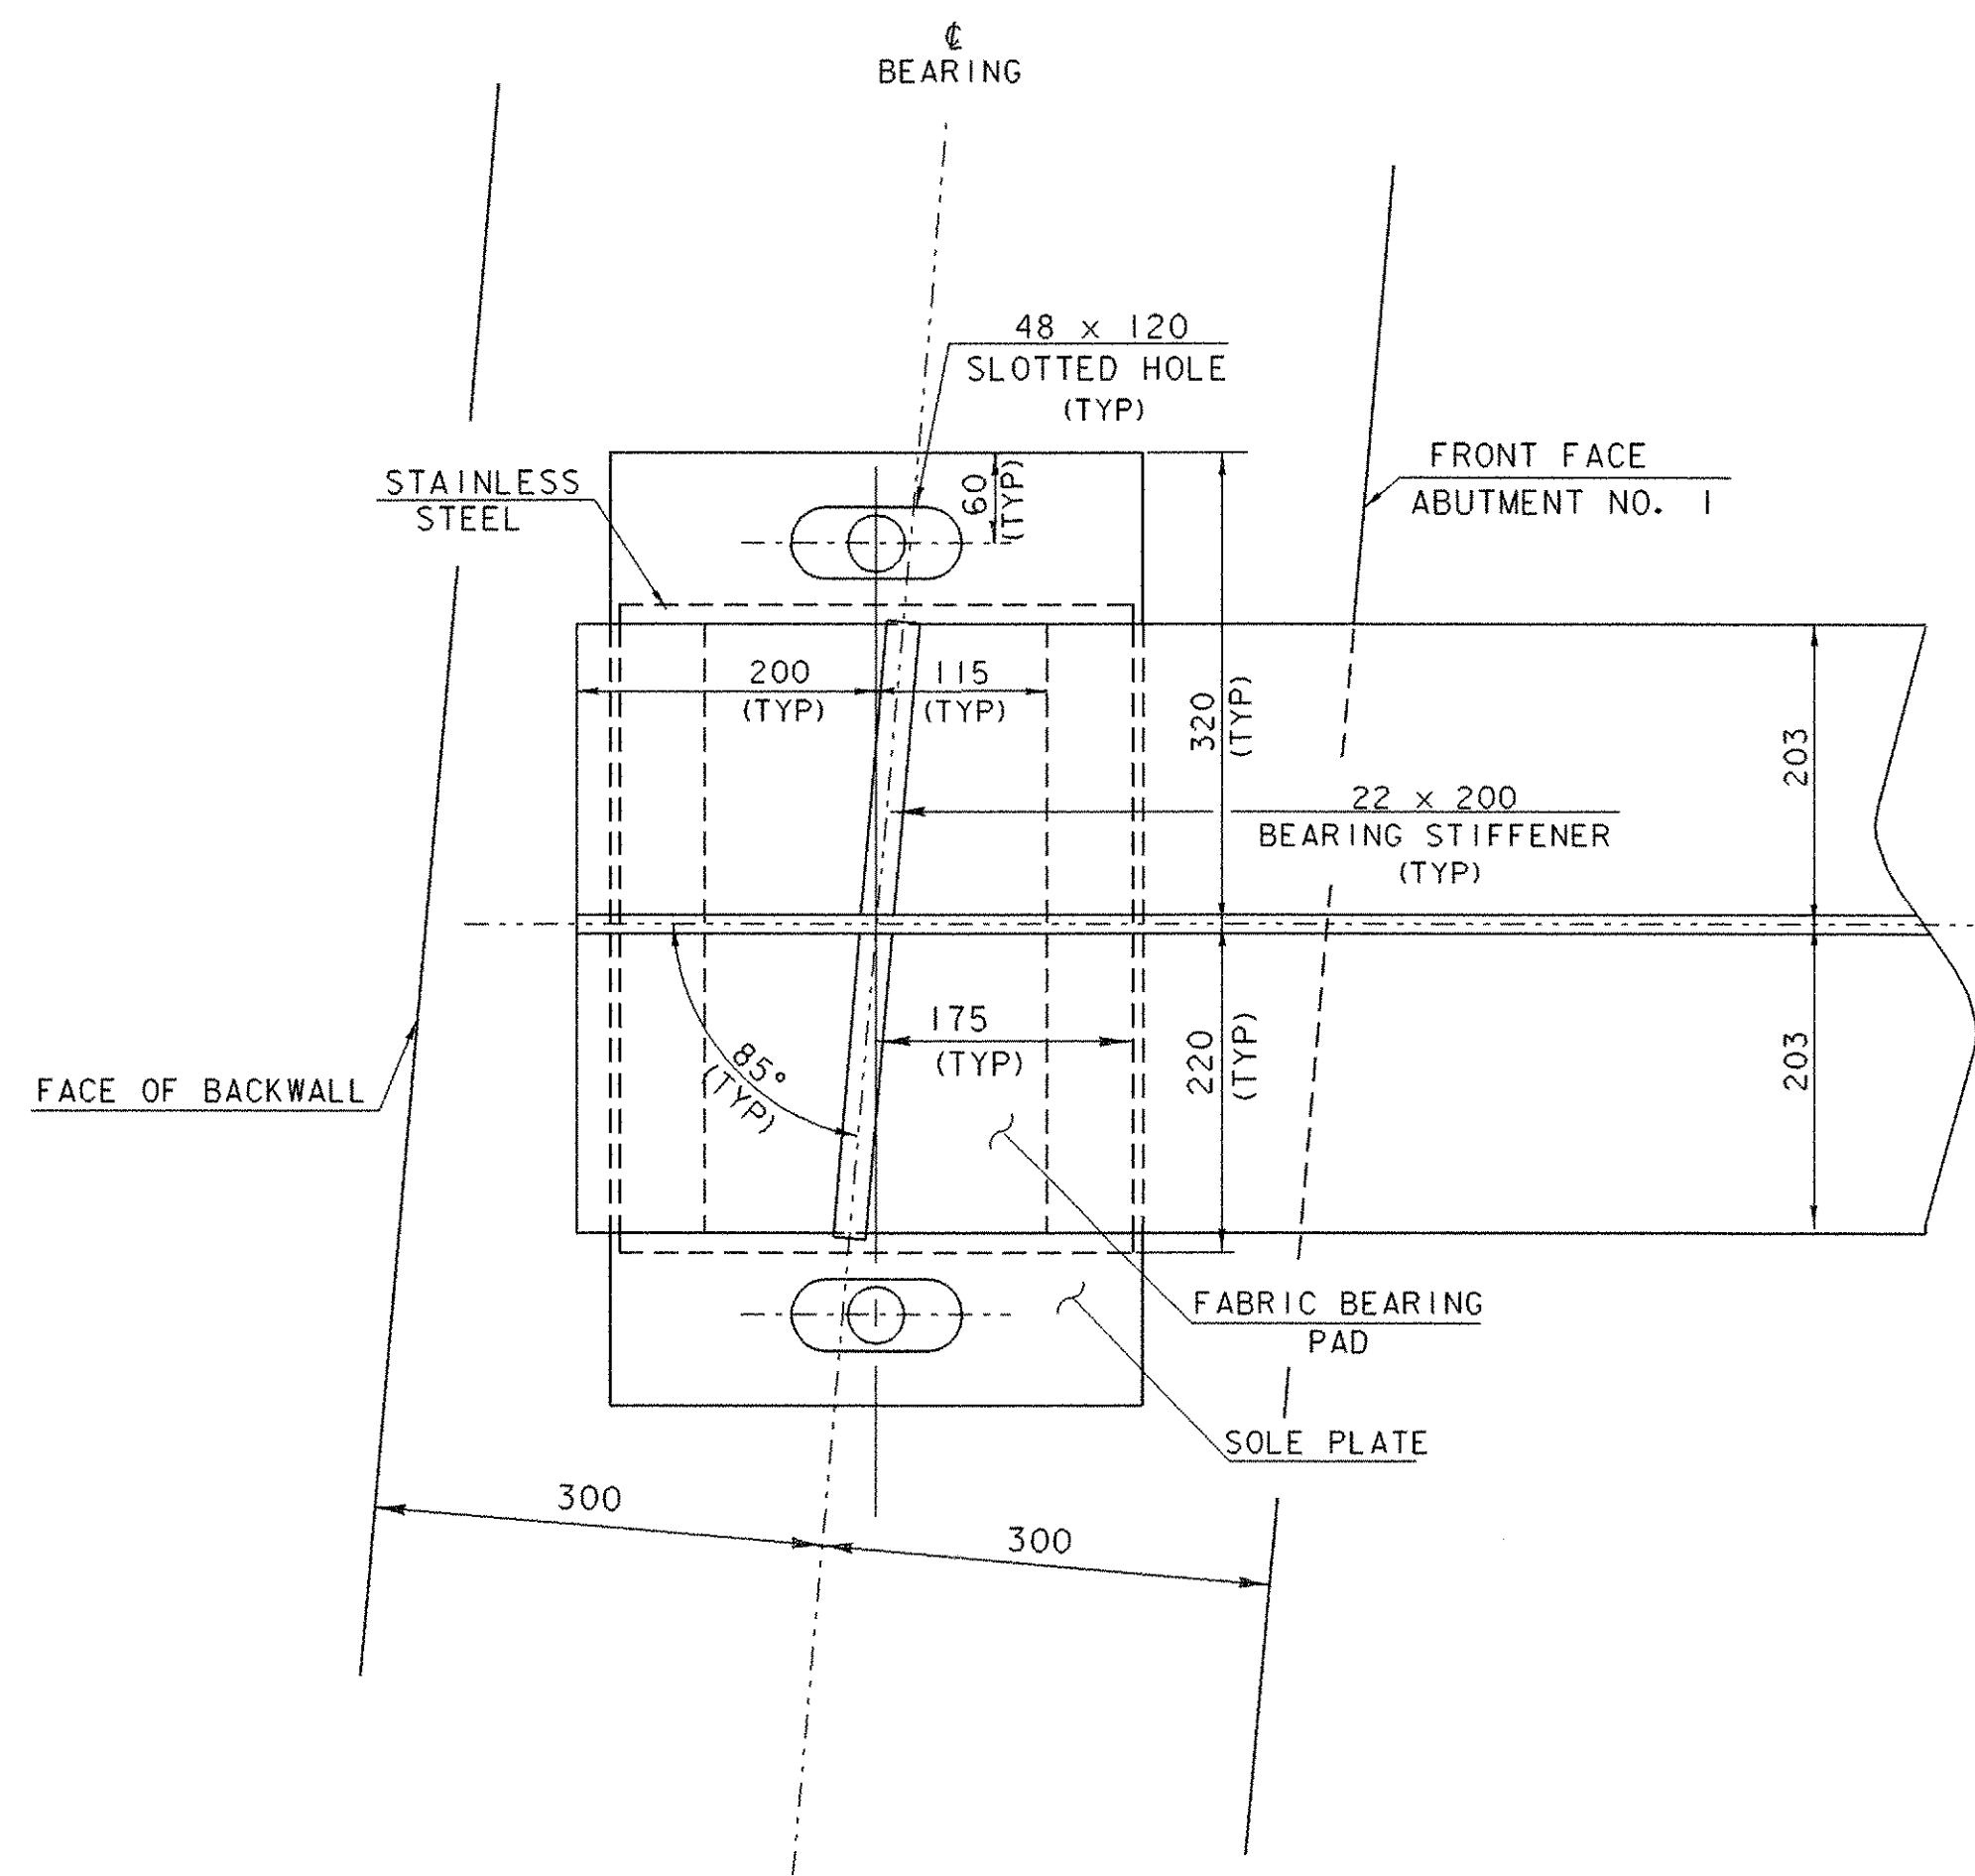


PLAN
SCALE: 1:5

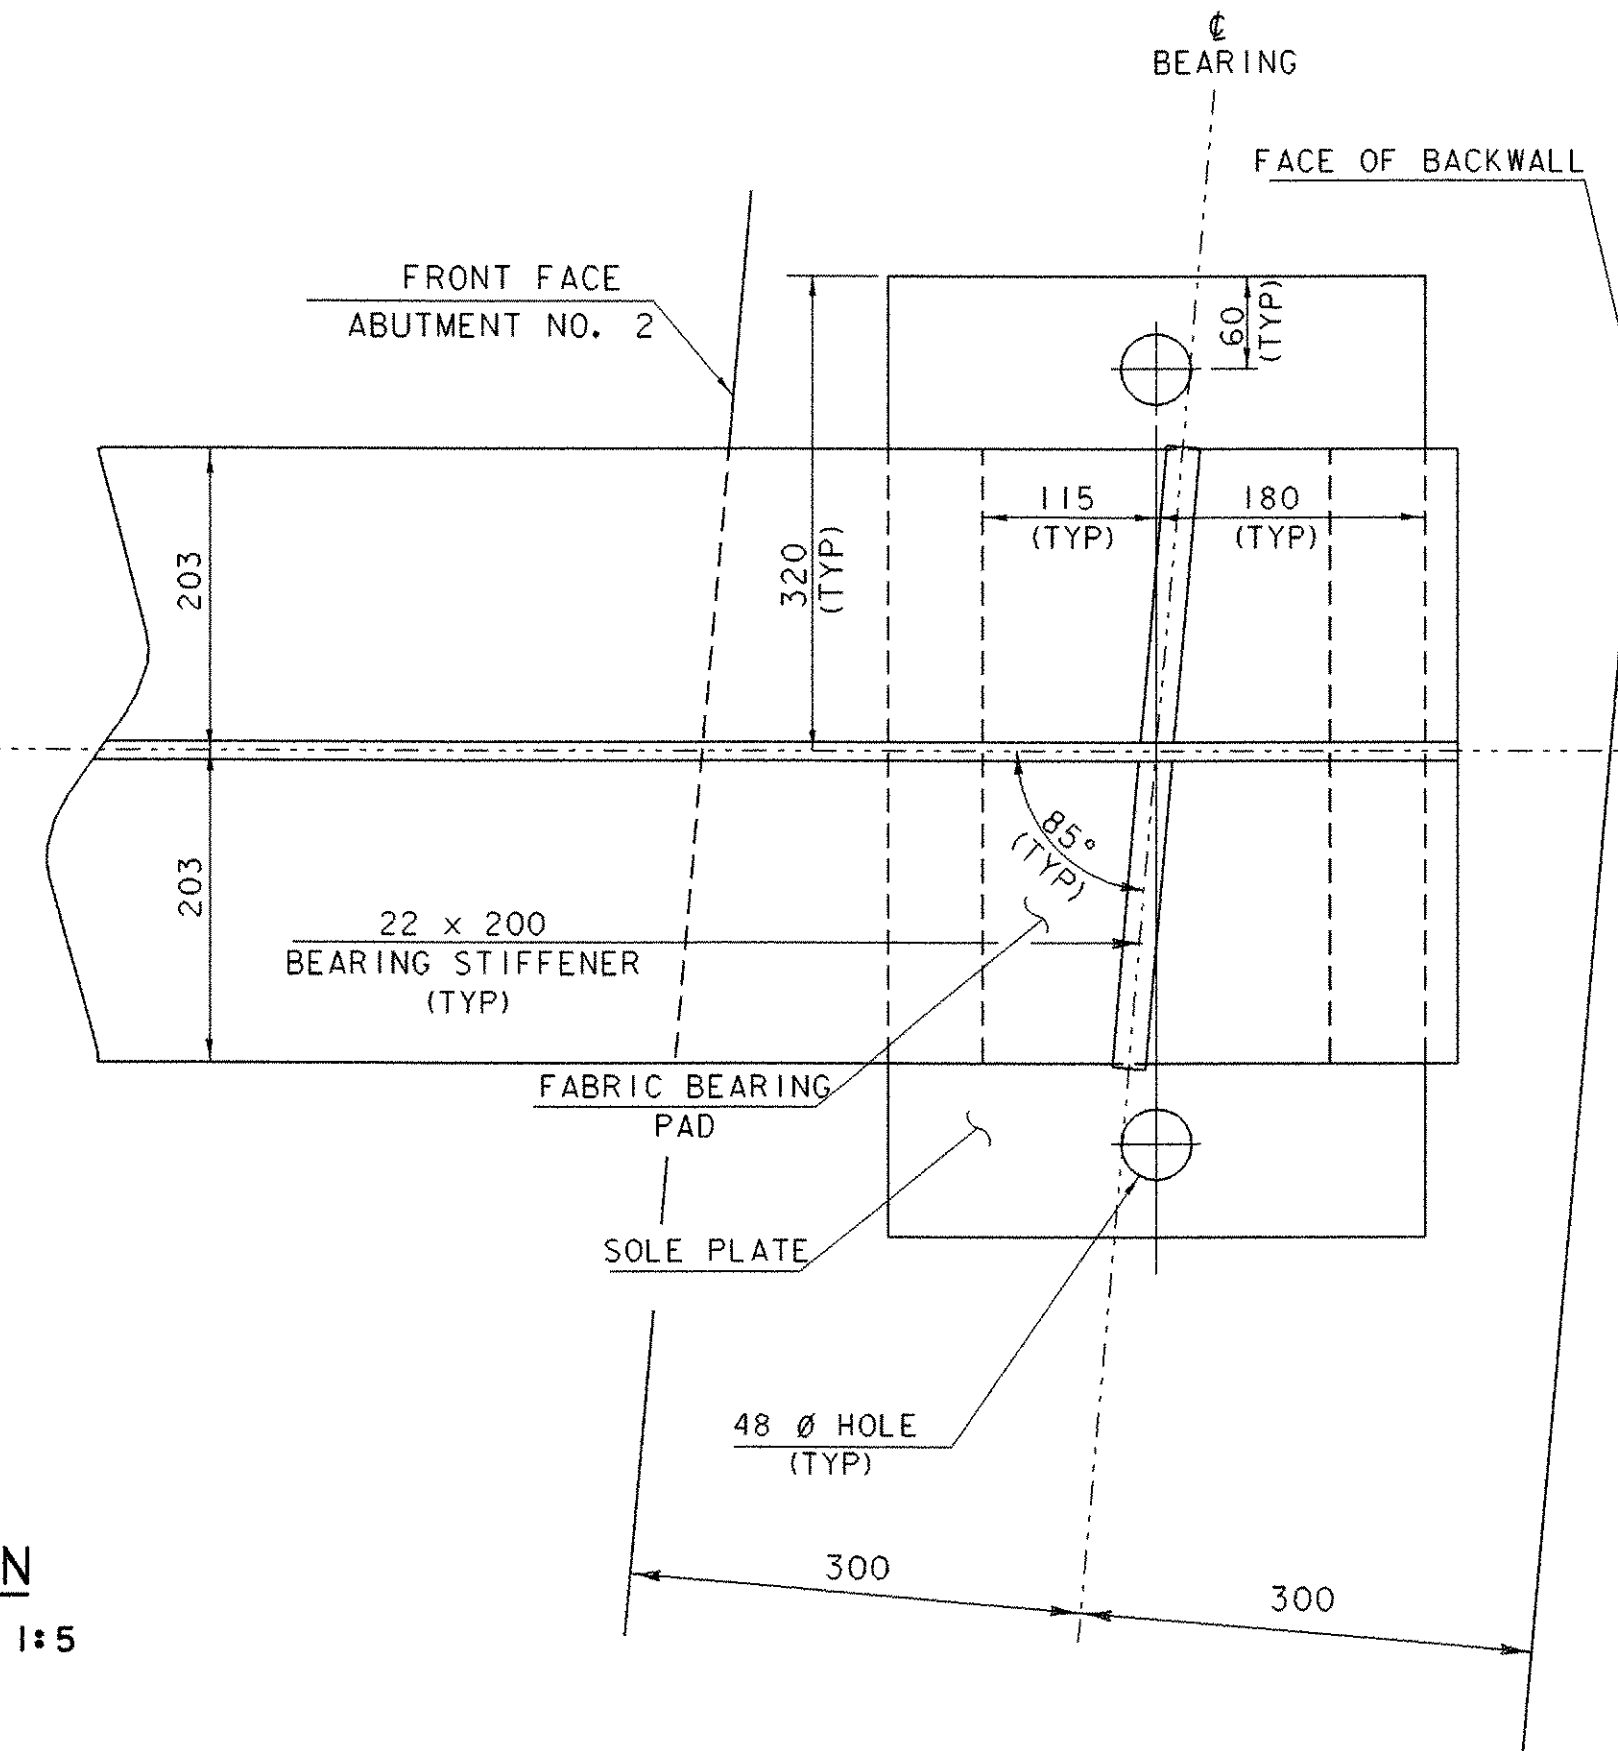


BEARING NOTES


- BEARINGS SHALL BE PAID FOR UNDER ITEM 531.10, "BEARING DEVICE ASSEMBLY (FABRIC)" AND SHALL CONFORM TO SECTIONS 531 AND 731 OF THE STANDARD SPECIFICATIONS.
- SHOP DRAWINGS SHALL BE SUBMITTED AS PER SUBSECTION 531.03 OF THE STANDARD SPECIFICATIONS. THE SUBMITTAL SHALL INCLUDE ASSOCIATED WELDING AND BONDING PROCEDURES.
- DESIGN CRITERIA:
 - MAXIMUM ALLOWABLE BEARING ON CONCRETE OR MASONRY: 7000 kPa
 - MINIMUM ALLOWABLE DESIGN ROTATION: 0.015 RADIAN.
 - DESIGN VERTICAL LOAD: 630 KN
 - DESIGN HORIZONTAL LOAD: MINIMUM 10% OF VERTICAL LOAD.
- THE "B" DISTANCE IS THE FINAL SETTING FOR THE BEARING PAD AFTER THE CONCRETE SLAB, CURB, PAVEMENT, AND BRIDGE RAIL HAVE BEEN PLACED. THE "A" DISTANCE IS FOR SETTING THE BEARING AFTER THE STRUCTURAL STEEL IS ERECTED AND BEFORE THE CONCRETE DECK IS Poured. THE DIFFERENCE IS THE THEORETICAL ELONGATION OF THE BOTTOM FLANGE DUE TO DEAD LOAD DEFLECTION. THE FINAL "B" DISTANCE SHOWN IN THE TABLE MUST BE ATTAINED WITHIN 3 mm.
- THE CONCRETE SURFACE UNDER THE BEARING DEVICE SHALL BE LEVEL.
- ANCHOR BOLTS SHALL HAVE A MINIMUM 380 EMBEDMENT INTO CONCRETE AND SHALL CONFORM TO SUBSECTION 714.08 OF THE STANDARD SPECIFICATIONS.
- ALL STEEL IN BEARING DEVICE ASSEMBLY (EXCEPT STAINLESS) SHALL BE AASHTO M270M/M270, GR 250.
- ALL BEARING DEVICES SHALL BE GALVANIZED OR METALIZED AS PER SUBSECTIONS 531.04 (b) AND 506.15 OF THE STANDARD SPECIFICATIONS. IF THE BEARINGS ARE METALIZED, THEY SHALL BE SEALED WITH AN APPROVED SEALER AS SPECIFIED IN SUBSECTION 506.15 (b) OF THE STANDARD SPECIFICATIONS. AREAS OF GALVANIZING OR METALIZING DAMAGED BY FIELD WELDING OR HANDLING SHALL BE REPAIRED IN CONFORMANCE WITH SUPPLEMENTAL SPECIFICATION 513.
- ALL ANCHOR BOLTS, NUTS, AND WASHERS SHALL BE GALVANIZED. ALL WASHERS SHALL BE 10 PLATE MINIMUM. PAYMENT FOR ANCHOR BOLTS, NUTS, WASHERS AND THEIR INSTALLATION SHALL BE INCLUDED IN THE UNIT BID PRICE FOR ITEM 531.10, "BEARING DEVICE ASSEMBLY (FABRIC)".

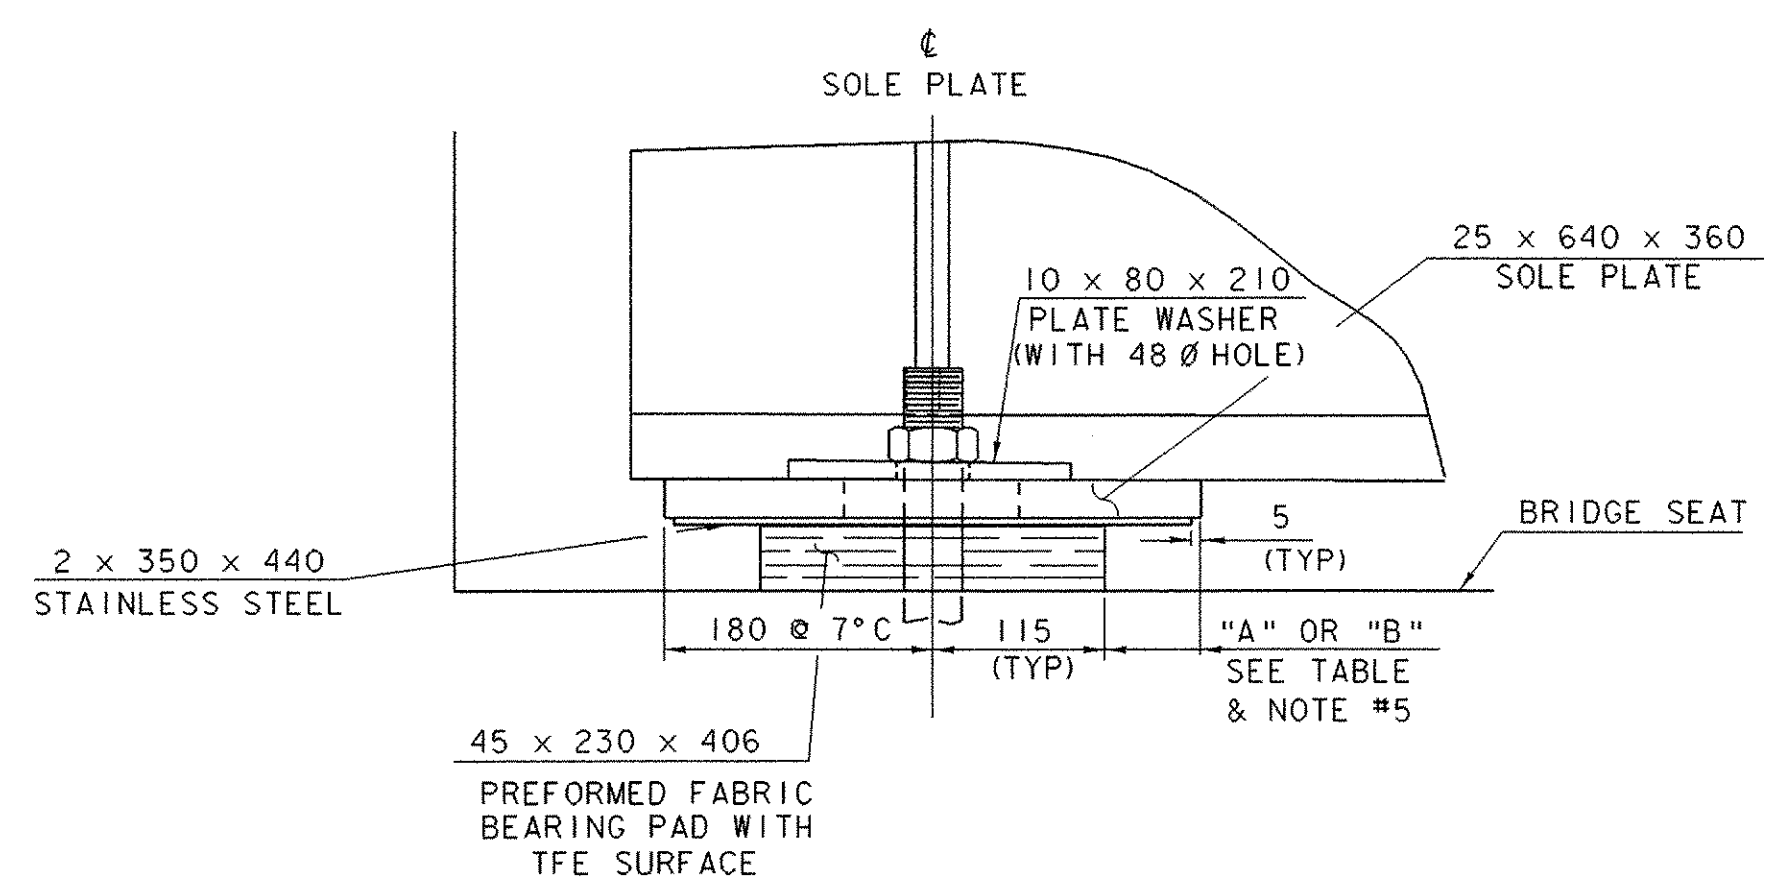

SIDE ELEVATION
SCALE: 1:5

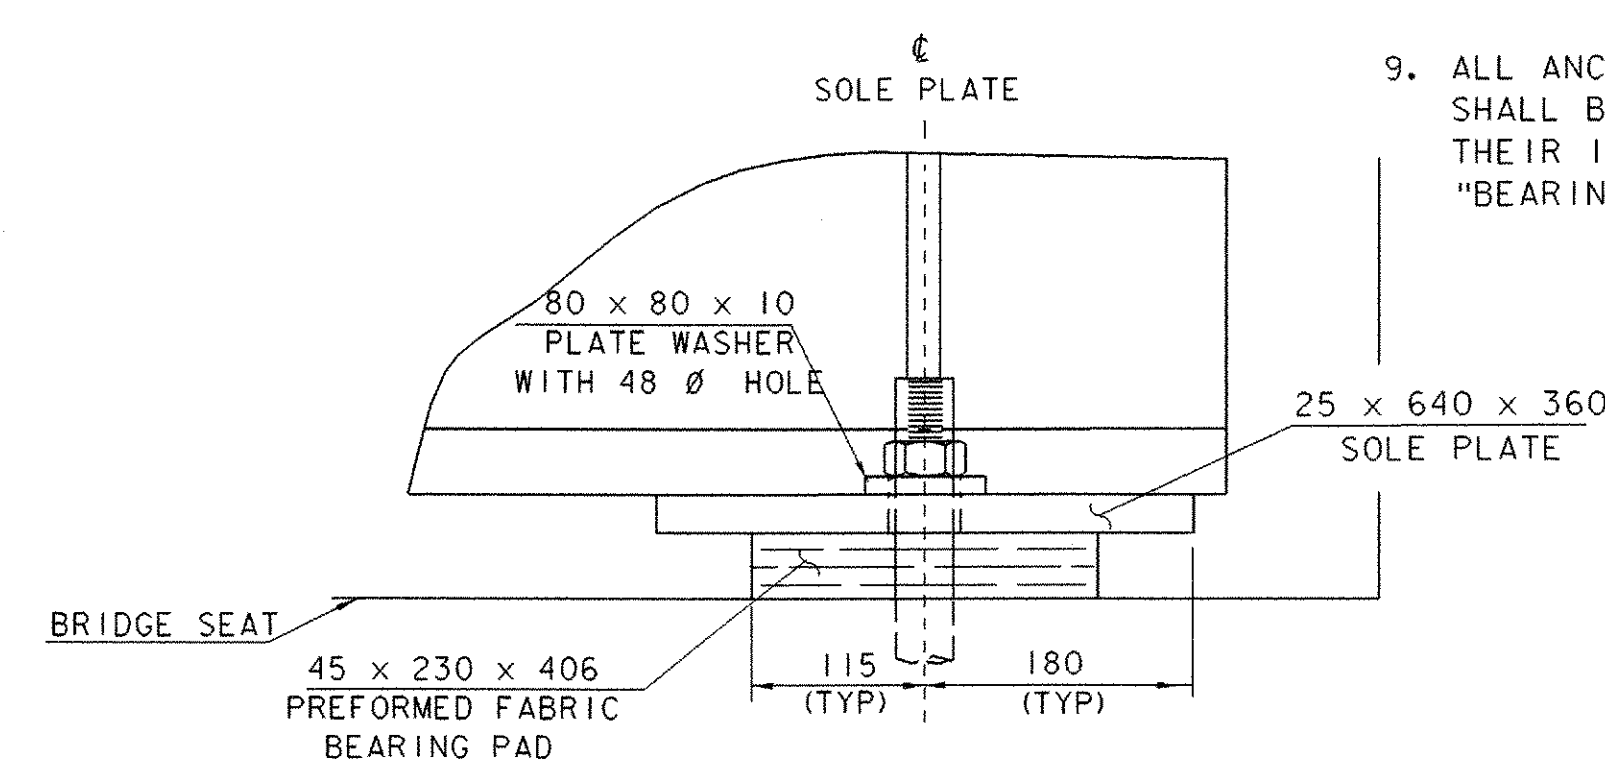


TEMP	"A" DIST	"B" DIST
-34°C	79	95
-26°C	76	92
-18°C	73	89
-9°C	70	86
-1°C	67	83
7°C	64	79
16°C	60	76
24°C	57	73
32°C	54	70
41°C	51	67
49°C	48	64

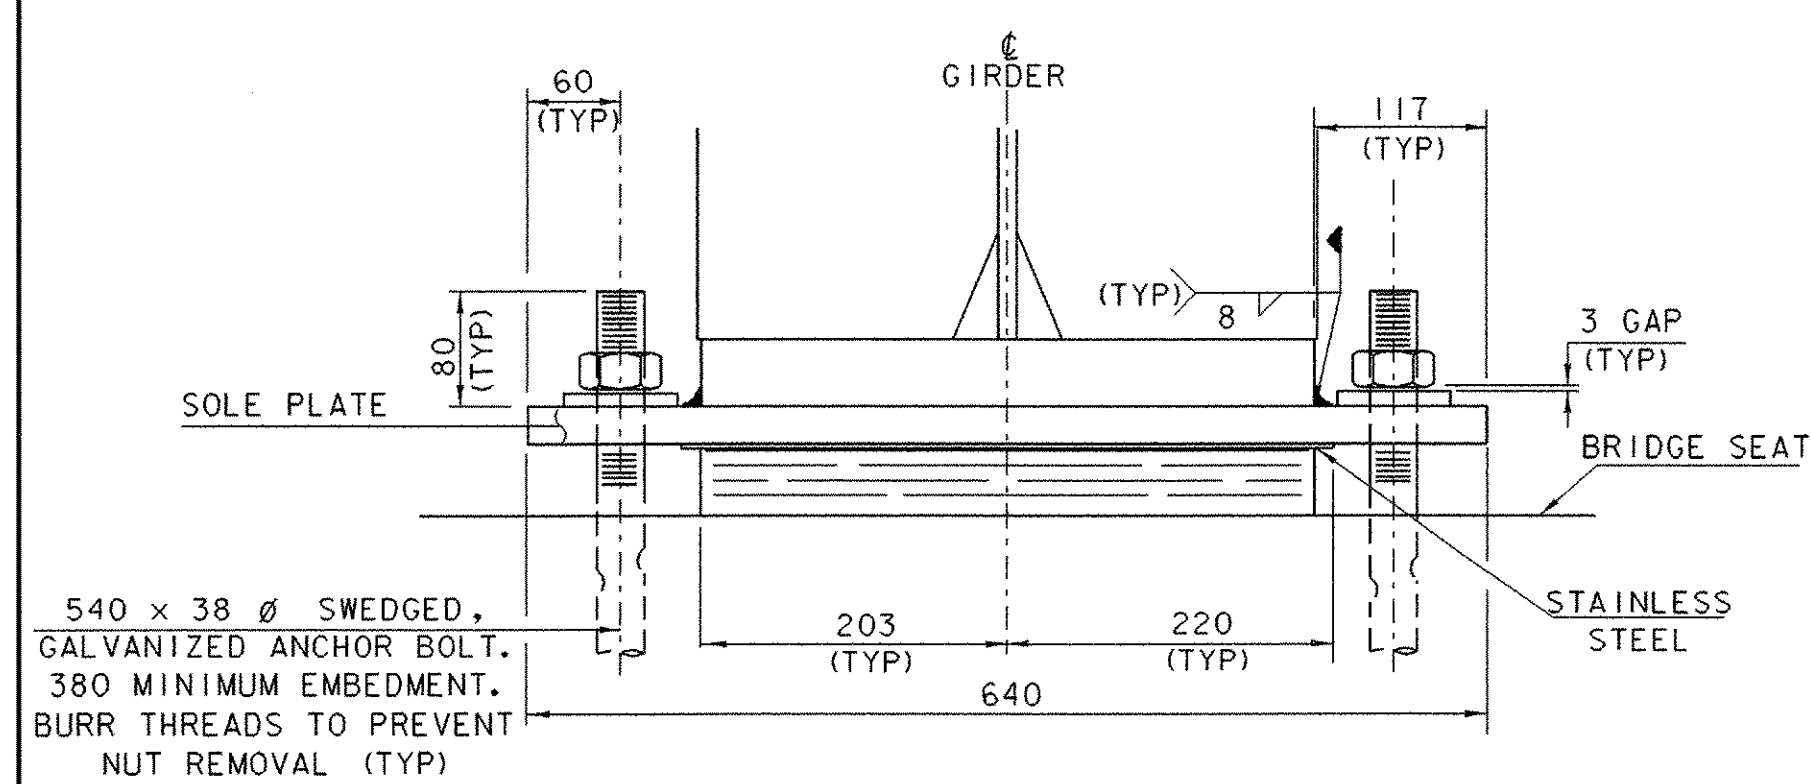



EXPANSION BEARING @ ABUT NO. 1

FRONT VIEW
SCALE: 1:5


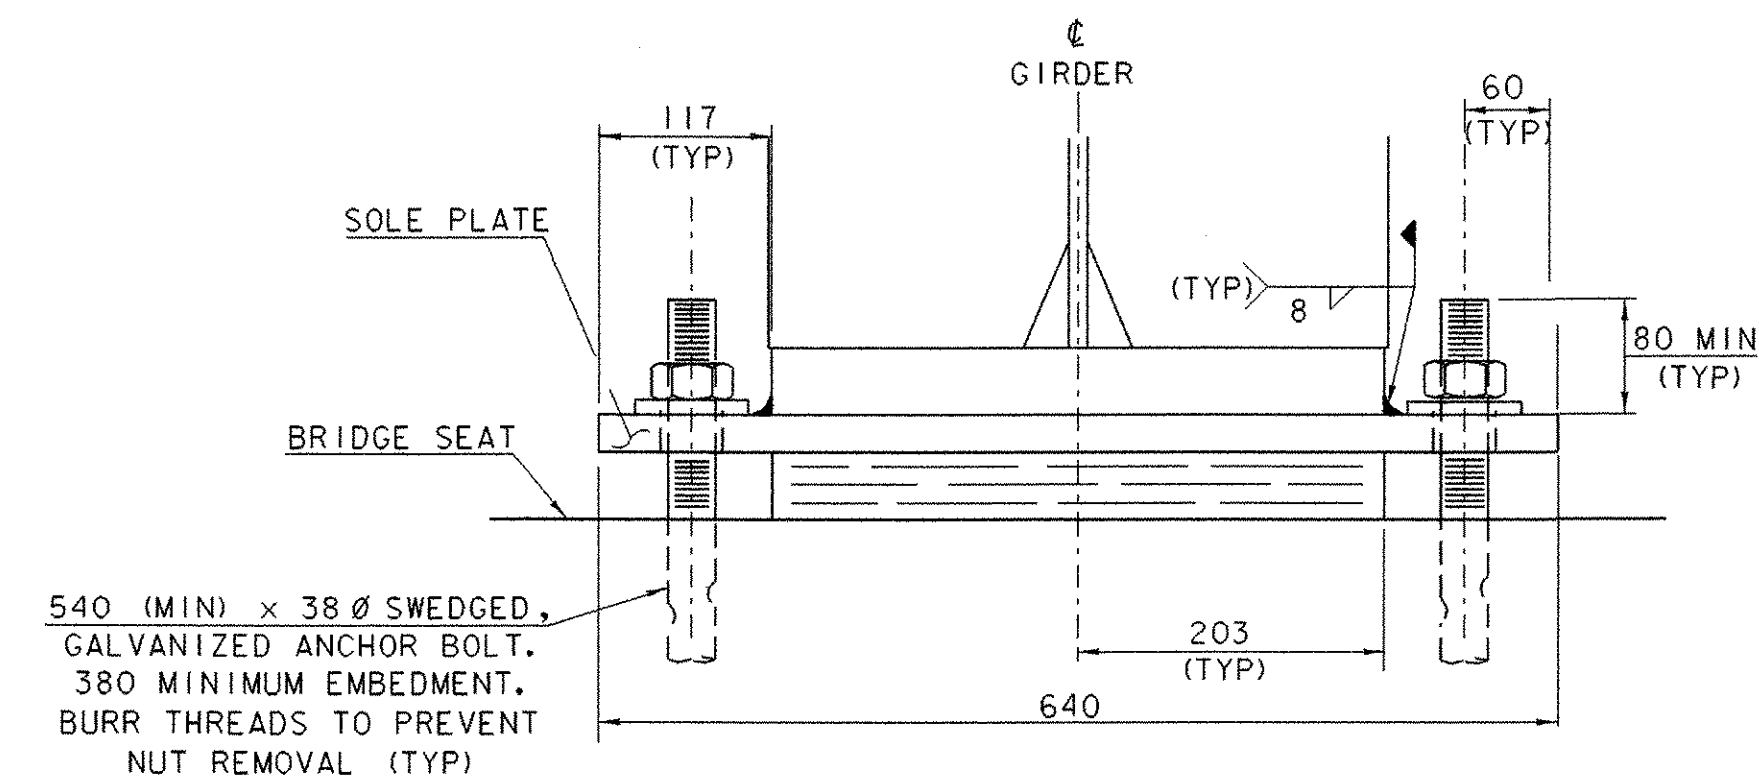


FIXED BEARING @ ABUT NO. 2

SHEET NAME: BEARING DETAILS		
PROJECT NAME: LEICESTER	HIGHWAY NO.: TH 1	
PROJECT NUMBER: BRF 0160(3)S	BRIDGE NO.: 6	
	OVER: OTTER CREEK	
FILE NAME: /PW/95j288/sj288sup.dgn	PLOT DATE: 17-AUG-2005	
PROJECT MANAGER: R. R. WHITCOMB	DRAWN BY: T. FILLBACH	
DESIGNED BY: C. CARLSON	IPARM NAME: sj288brg.1	
BRIDGE SHEET NUMBER:	SHEET 52 OF 90	

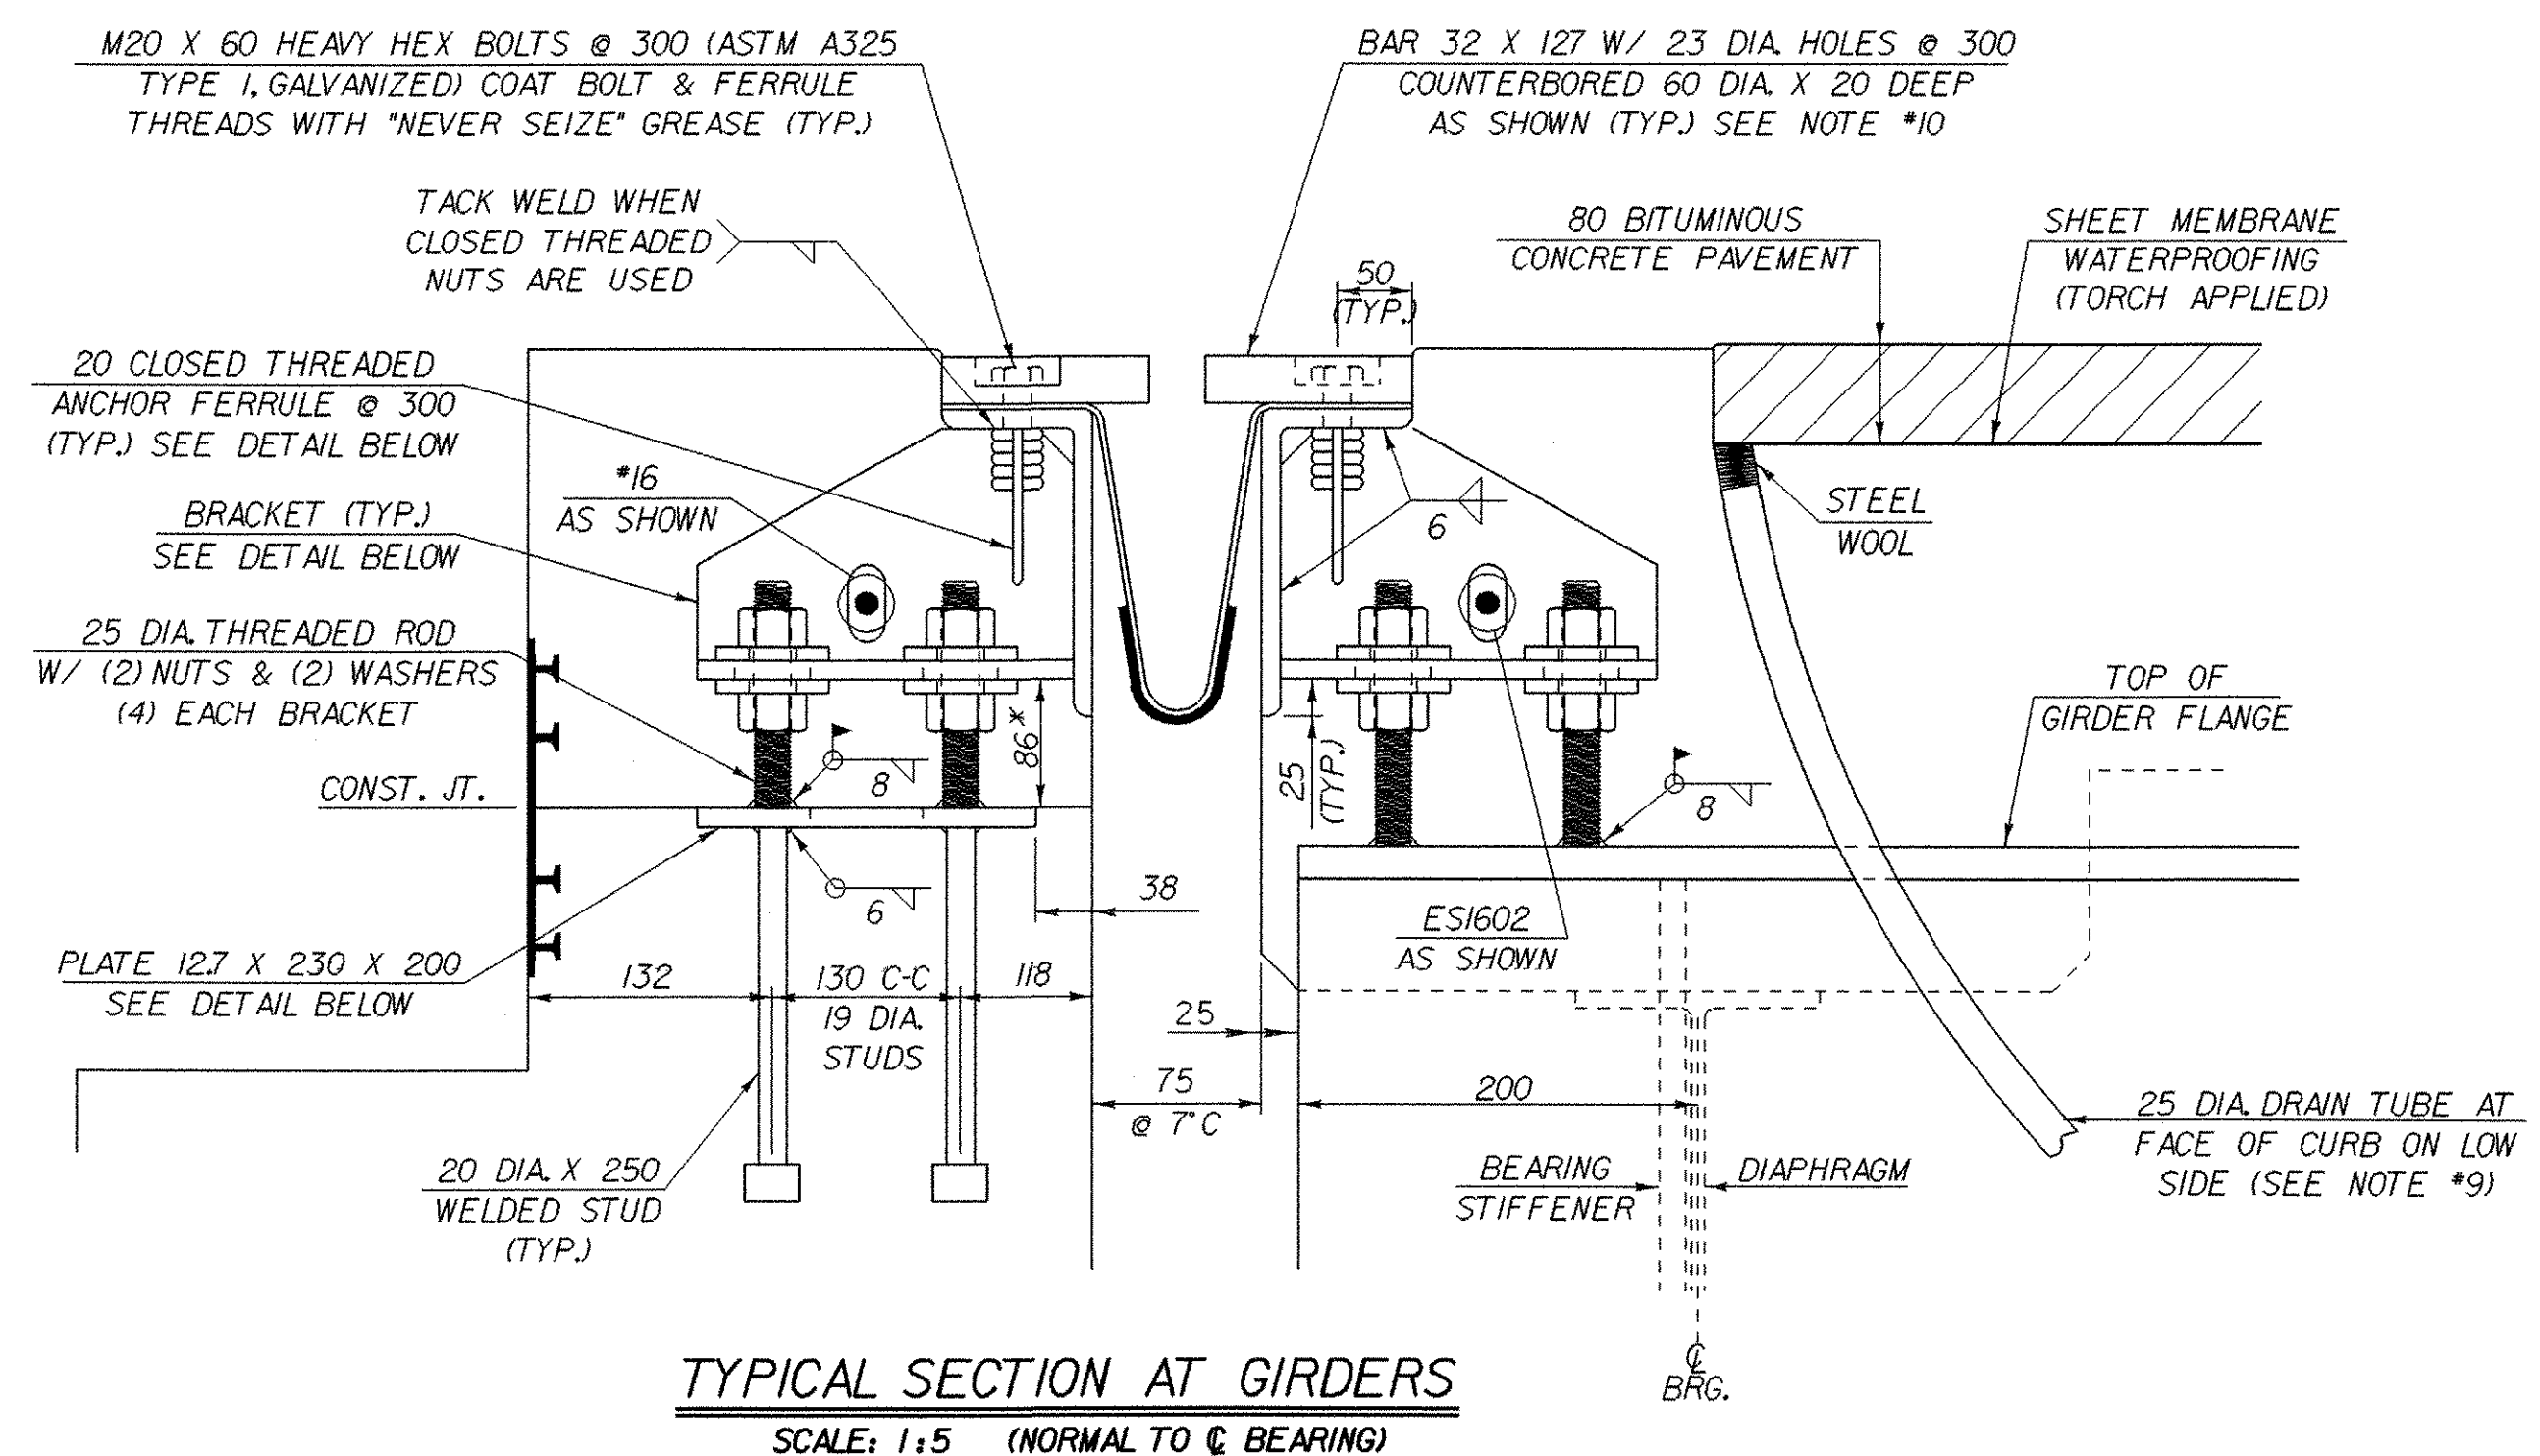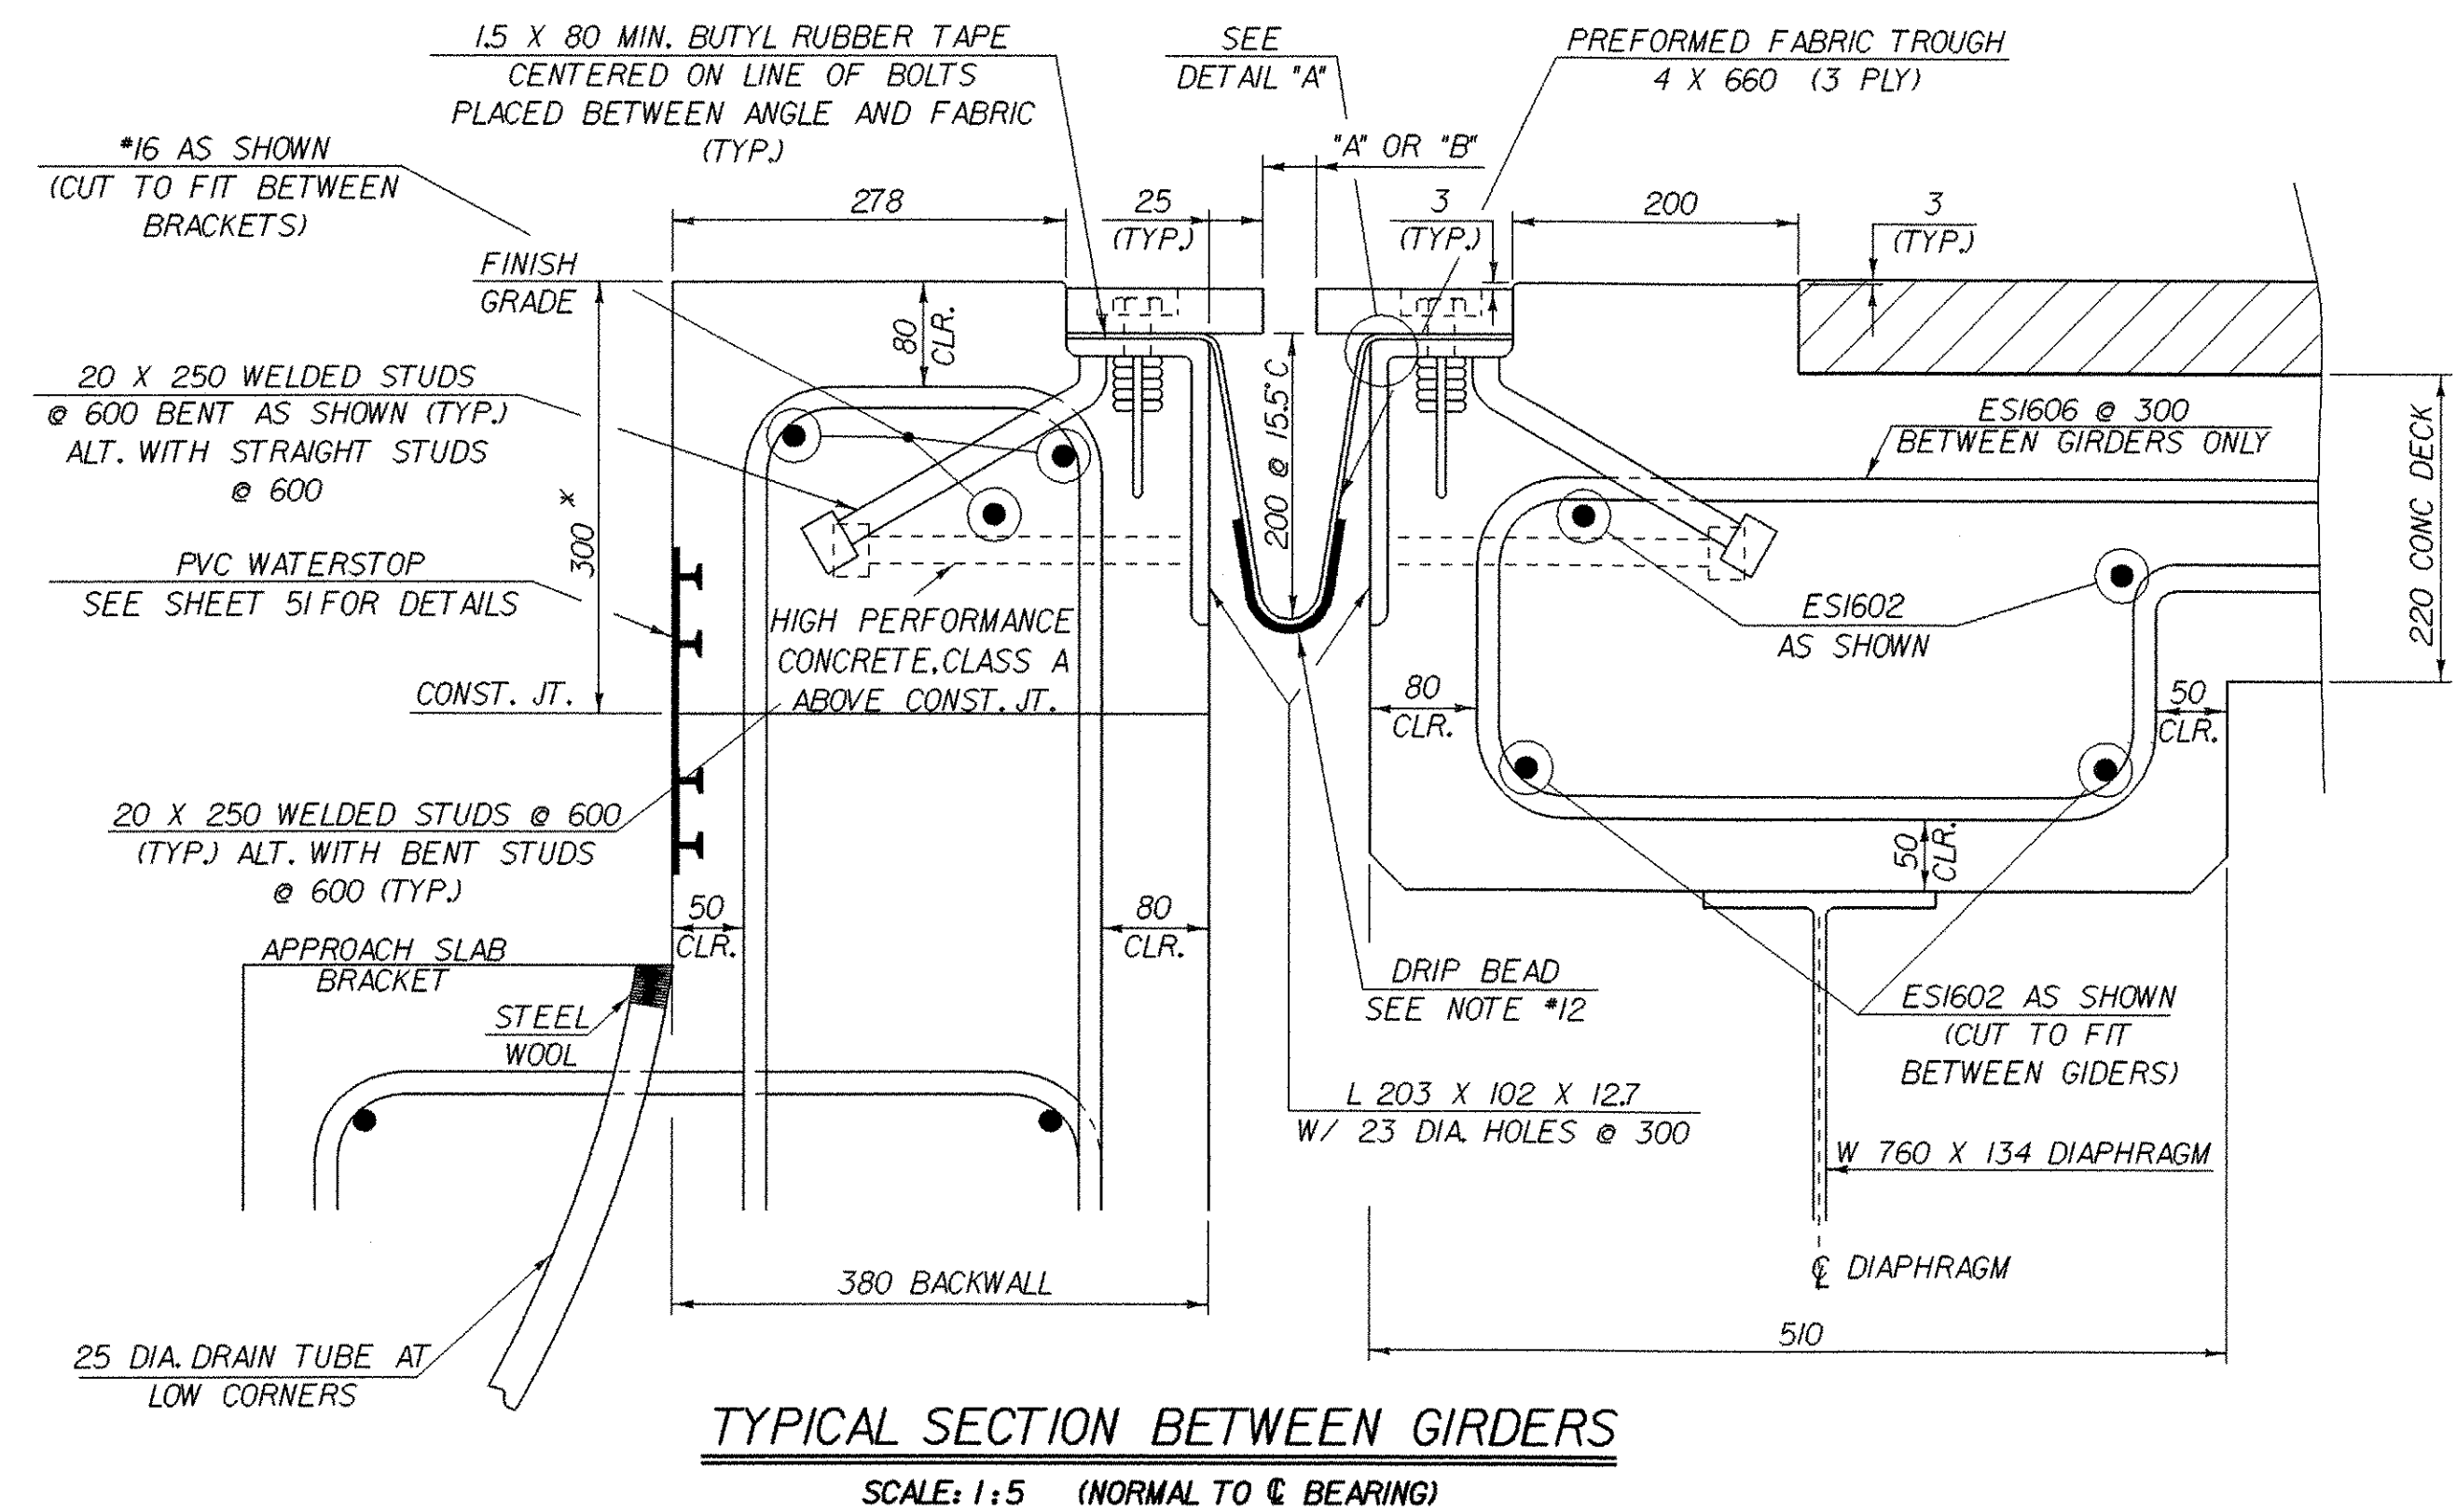





* THESE DIMENSIONS ARE THEORETICAL AND MAY CHANGE DEPENDING UPON THE OUTCOME OF THE BEAM PROFILES.

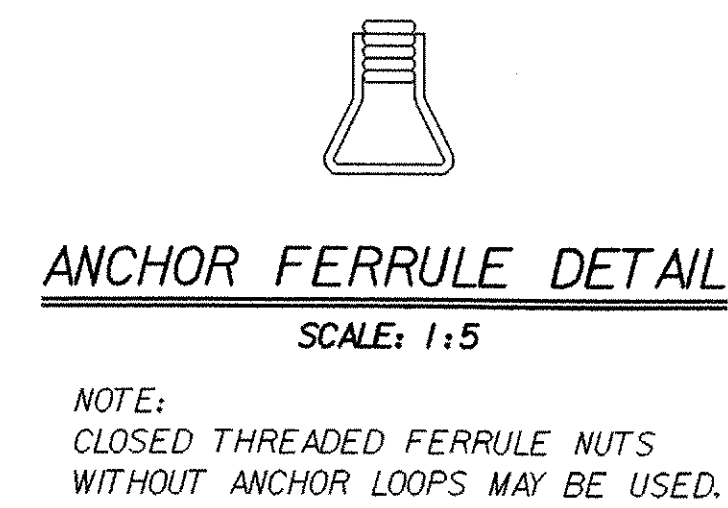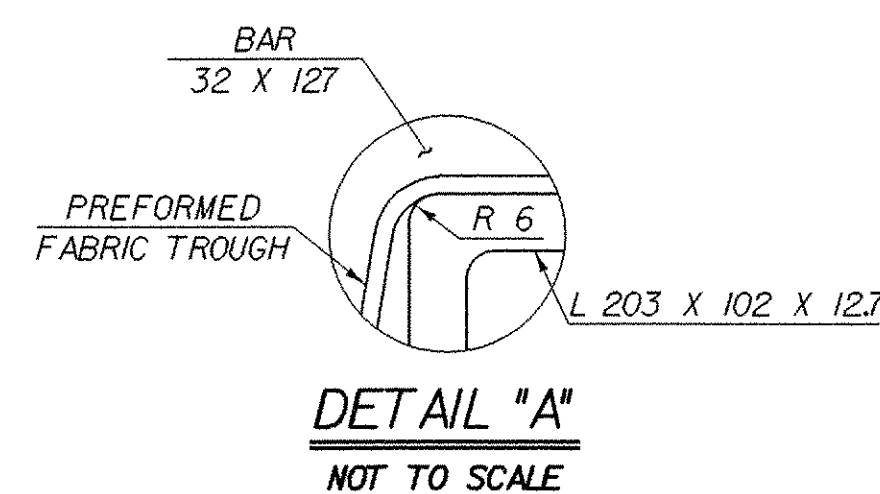

TEMP	"A" DIST	"B" DIST
-18° C	51	35
-9° C	48	32
-1° C	44	29
7° C	41	25
16° C	38	22
24° C	35	19
32° C	32	16
41° C	29	13

*"A" IS THE SETTING BEFORE DEAD LOADS ARE IN PLACE.

*"B" IS THE FINAL SETTING AFTER ALL DEAD LOADS ARE IN PLACE.

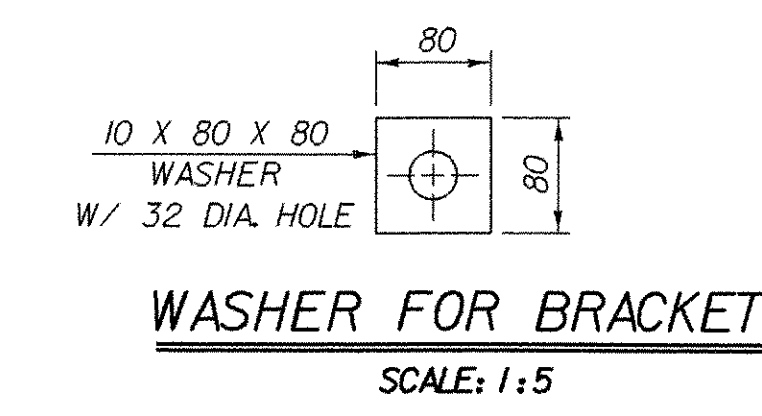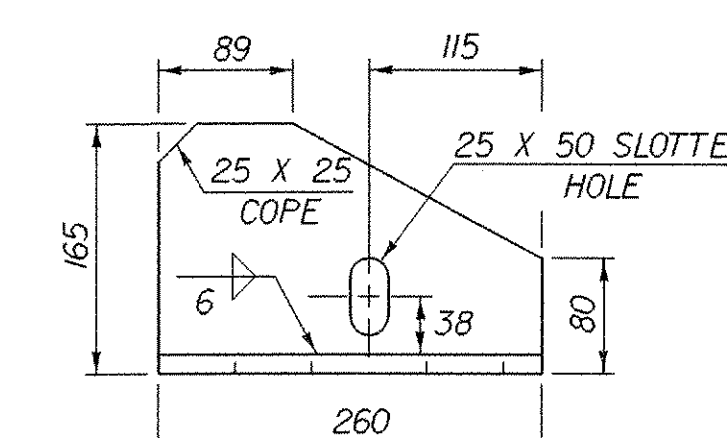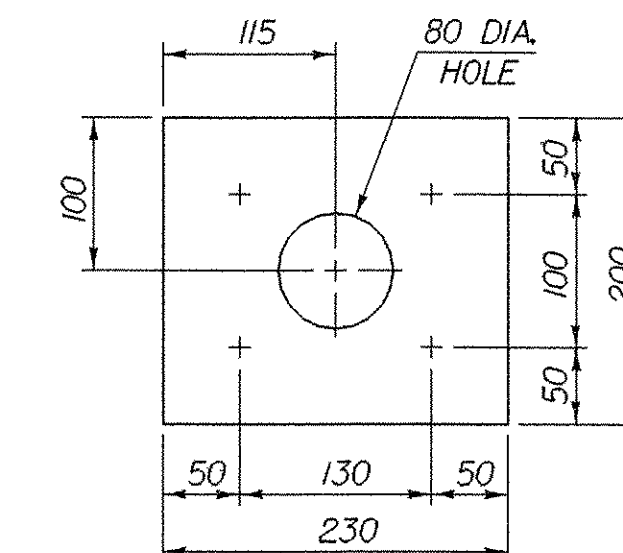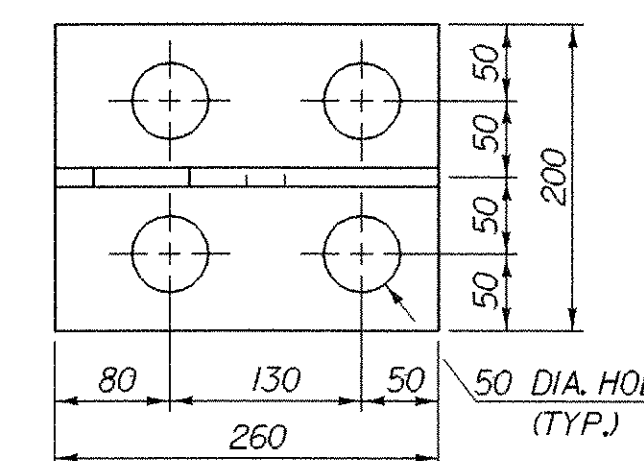


NOTES



- DETAILS ON THIS SHEET ARE FOR ITEM 516.10 "BRIDGE EXPANSION JOINT (VERMONT)".
- PREFORMED FABRIC MATERIAL SHALL BE CONTINUOUS AND SHALL CONFORM TO SUBSECTION 707.07 OF THE STANDARD SPECIFICATION.
- BUTYL RUBBER TAPE SHALL CONFORM TO AASHTO SPECIFICATION M-198, TYPE II.
- THE FINAL FINISH OF THE EXPANSION DEVICE SHALL BE COVERED DURING THE PLACING OF BRIDGE DECK CONCRETE.
- ALL STEEL COMPONENTS SHALL BE AASHTO M270M/M270 GRADE 250 GALVANIZED OR METALIZED AS PER SUBSECTION 506.04 OF THE STANDARD SPECIFICATION AS MODIFIED BY THE GENERAL SPECIAL PROVISIONS UNLESS OTHERWISE SPECIFIED.
- THE ITEM "BRIDGE EXPANSION JOINT (VERMONT)" SHALL INCLUDE THE FABRICATION AND ERECTION OF THE COMPLETE JOINT ASSEMBLY INCLUDING ALL STEEL PLATES, BRACKETS, ANGLES, WELDED STUDS OR RODS, PREFORMED FABRIC DRAIN TROUGH MATERIAL AND PLASTIC DRAIN TUBES, BUTYL RUBBER TAPE AND ANY OTHER MISCELLANEOUS MATERIAL NECESSARY TO INSTALL JOINT.
- THE 203 X 102 X 12.7 ANGLES SHALL BE FURNISHED AS ONE CONTINUOUS PIECE. THE 32 X 127 BARS EACH SIDE OF THE JOINT SHALL BE PROVIDED IN TWO EQUAL LENGTHS.
- COAT CONCRETE CONTACT SURFACES WITH EPOXY BONDING COMPOUND MEETING THE REQUIREMENTS OF SUBSECTION 719.02. PAYMENT SHALL BE INCLUDED IN THE UNIT PRICE BID FOR ITEM 516.10 "BRIDGE EXPANSION JOINT (VERMONT)".
- A 25mm DIAMETER PLASTIC DRAIN TUBE (PER STANDARD SPECIFICATION 740.07) SHALL BE INSTALLED AS SHOWN AT THE FACE OF CURB. THE UPPER END IS TO BE PLUGGED WITH STEEL WOOL AND THE LOWER END IS TO EXTEND BELOW THE BOTTOM OF THE ADJACENT GIRDER. THE DRAIN TUBES SHALL BE FASTENED TO THE GIRDERS USING A METHOD APPROVED BY THE ENGINEER. PAYMENT FOR DRAIN TUBES AND THEIR INSTALLATION SHALL BE MADE INCIDENTAL TO ITEM 501.33, HIGH PERFORMANCE CONCRETE, CLASS A.
- FILL COUNTERBORED HOLES WITH HOT Poured JOINT SEALER (STANDARD SPECIFICATION 707.04 AS MODIFIED BY THE GENERAL SPECIAL PROVISIONS) AFTER BOLT INSTALLATION. PAYMENT FOR THE WORK SHALL BE INCIDENTAL TO ITEM 516.10.
- PAYMENT FOR WATERSTOP SHALL BE SUBSIDIARY TO ITEM 501.33, HIGH PERFORMANCE CONCRETE, CLASS A.
- A DRIP BEAD OF 6 X 178 STRIP OF PREFORMED MATERIAL SHALL BE CEMENTED TO THE BOTTOM OF THE FABRIC TROUGH USING AN ADHESIVE APPROVED BY THE MANUFACTURER. THE DRIP BEAD SHALL BE APPLIED 25 mm FROM THE DOWNSPOUT END OF THE TROUGH.
- FABRIC TROUGH SHALL BE THOROUGHLY CLEANED AND FLUSHED AFTER PAVING OPERATION.
- THE EXPANSION JOINT SHALL BE SHOP ASSEMBLED AND SHIPPED AS ONE UNIT.
- ALL BOLTS, STUDS AND RELATED HARDWARE, EXCEPT AS NOTED SHALL BE ASTM A-307 AND SHALL BE GALVANIZED IN ACCORDANCE WITH ASTM A-153 (AASHTO M232).

SHEET NAME: EXPANSION JOINT DETAILS	
PROJECT NAME: LEICESTER	HIGHWAY NO.: TH 1
PROJECT NUMBER: BRF 0160(3)S	BRIDGE NO.: 6
	OVER: OTTER CREEK
FILE NAME: /PW/95J288/sj288exp.dgn	PLOT DATE: 17-AUG-2005
PROJECT MANAGER: R. R. WHITCOMB	DRAWN BY: T. FILLBACH
DESIGNED BY: C. CARLSON	IPARM NAME: sj288exp.i
BRIDGE SHEET NUMBER:	SHEET 53 OF 90


ALL PLATES 127 THICK

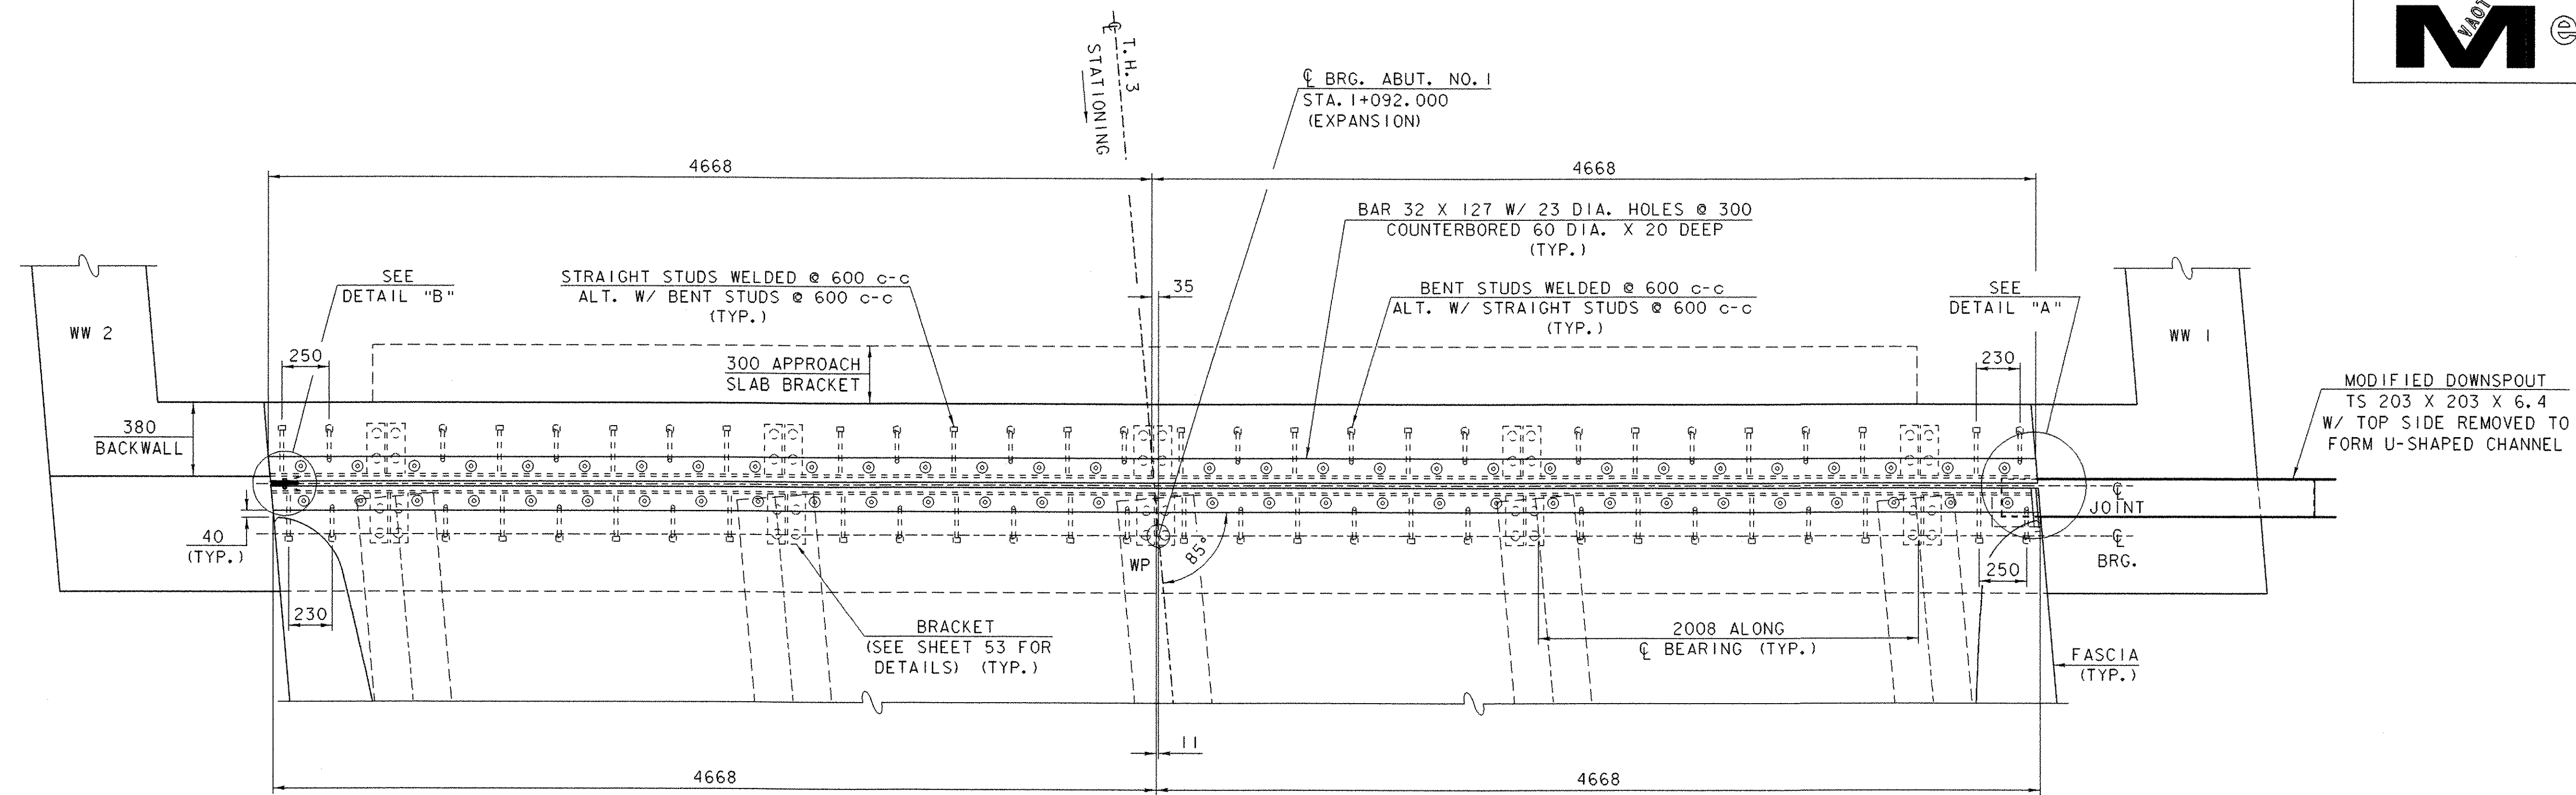


EXPANSION JOINT PLAN AT ABUTMENT NO. 1

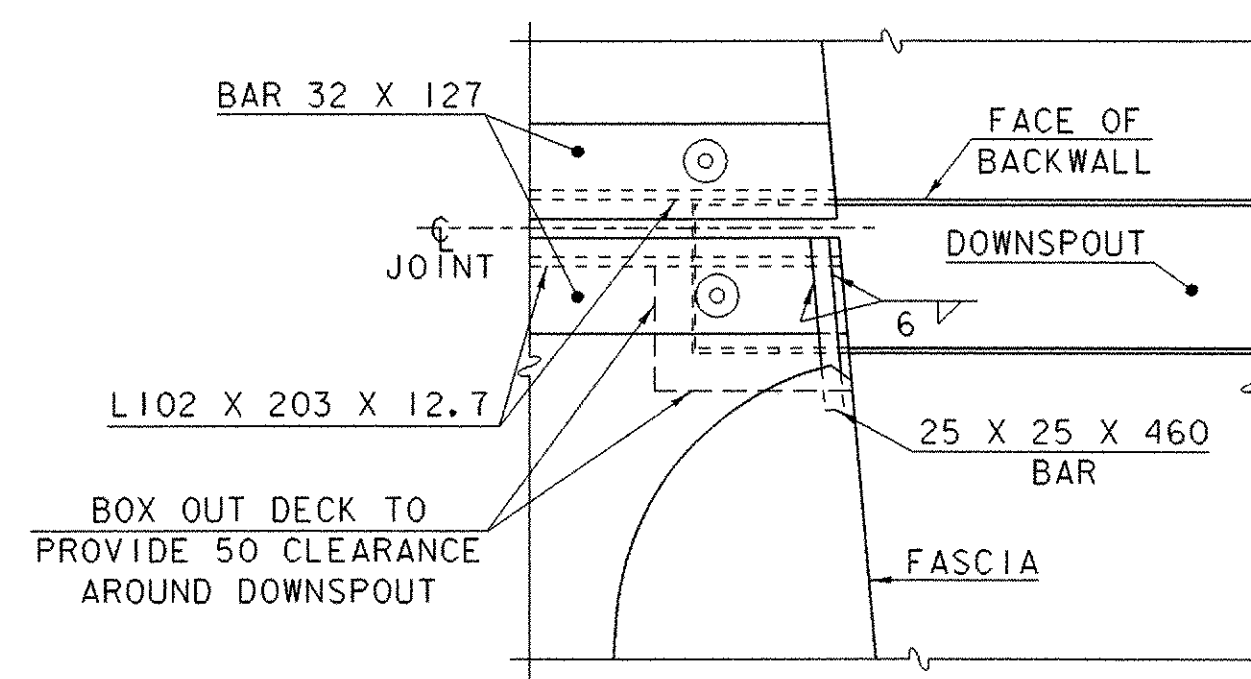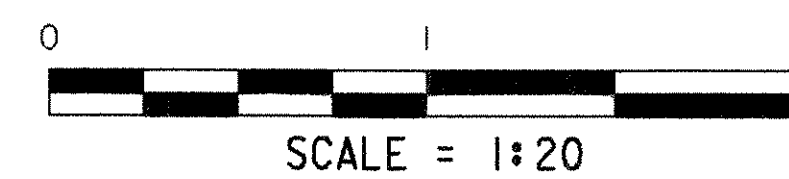

DETAIL "A"

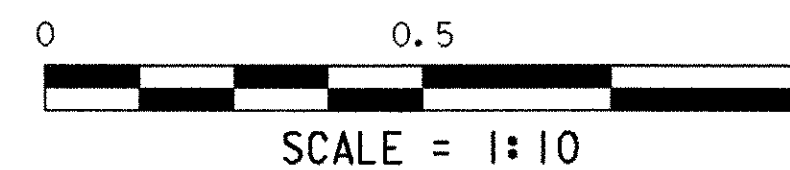


M20 DIA. X 230 LONG
EXPANSION ANCHOR BOLT
WITH 1 NUT AND WASHER
(TYP.)

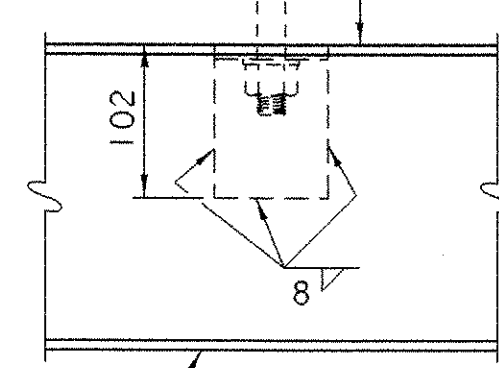

PLAN


MODIFIED DOWNSPOUT
TS 203 X 203 X 6.4

FACE OF
BACKWALL

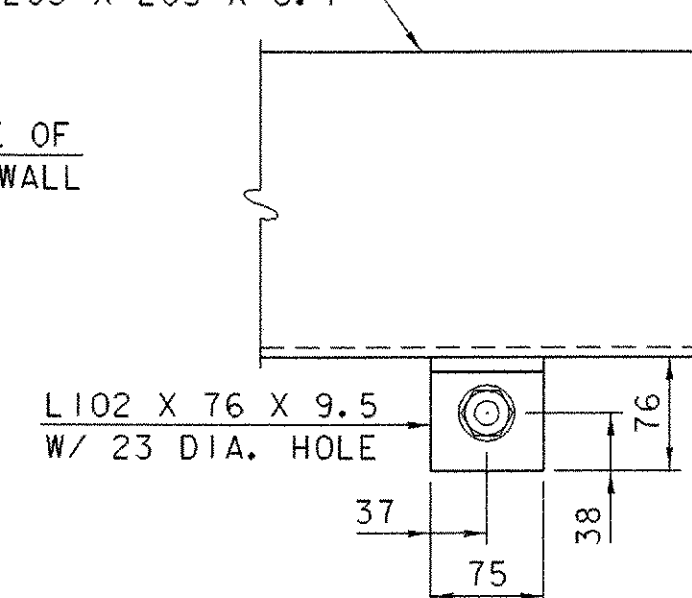


ELEVATION

DOWNSPOUT MOUNTING BRACKET DETAILS


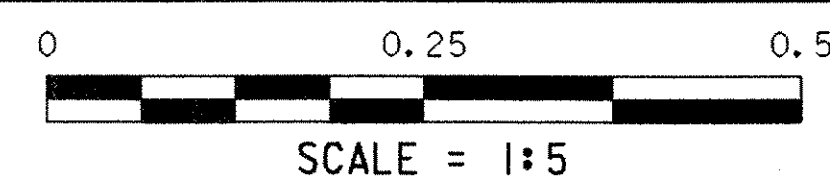


DOWNSPOUT NOTES

- HOLLOW STRUCTURAL STEEL TUBING SHALL CONFORM TO ASTM A500 OR A501.
- ALL PLATES, BARS, AND ANGLES SHALL CONFORM TO AASHTO M270M/M270 GRADE 250.
- THE DOWNSPOUT SHALL BE GALVANIZED IN ACCORDANCE WITH AASHTO M111M/M111 AFTER FABRICATION.
- ALL BOLTS AND RELATED HARDWARE SHALL BE ASTM F568M, CLASS 4.6 AND SHALL BE GALVANIZED IN ACCORDANCE WITH AASHTO M232M/M232.
- ANY PLACE WHERE GALVANIZING HAS BEEN REMOVED FROM THE DOWNSPOUT EITHER BY CUTTING, BURNING, WELDING, PLACING, OR ANY OTHER MEANS, REPAIRS SHALL BE MADE IN ACCORDANCE WITH AASHTO M36.
- THE DOWNSPOUT, MOUNTING BRACKETS, ALL ANCHOR BOLTS WITH RELATED HARDWARE, AND INSTALLATION SHALL BE PAID FOR UNDER ITEM 506.55, "STRUCTURAL STEEL (PLATE GIRDER)".

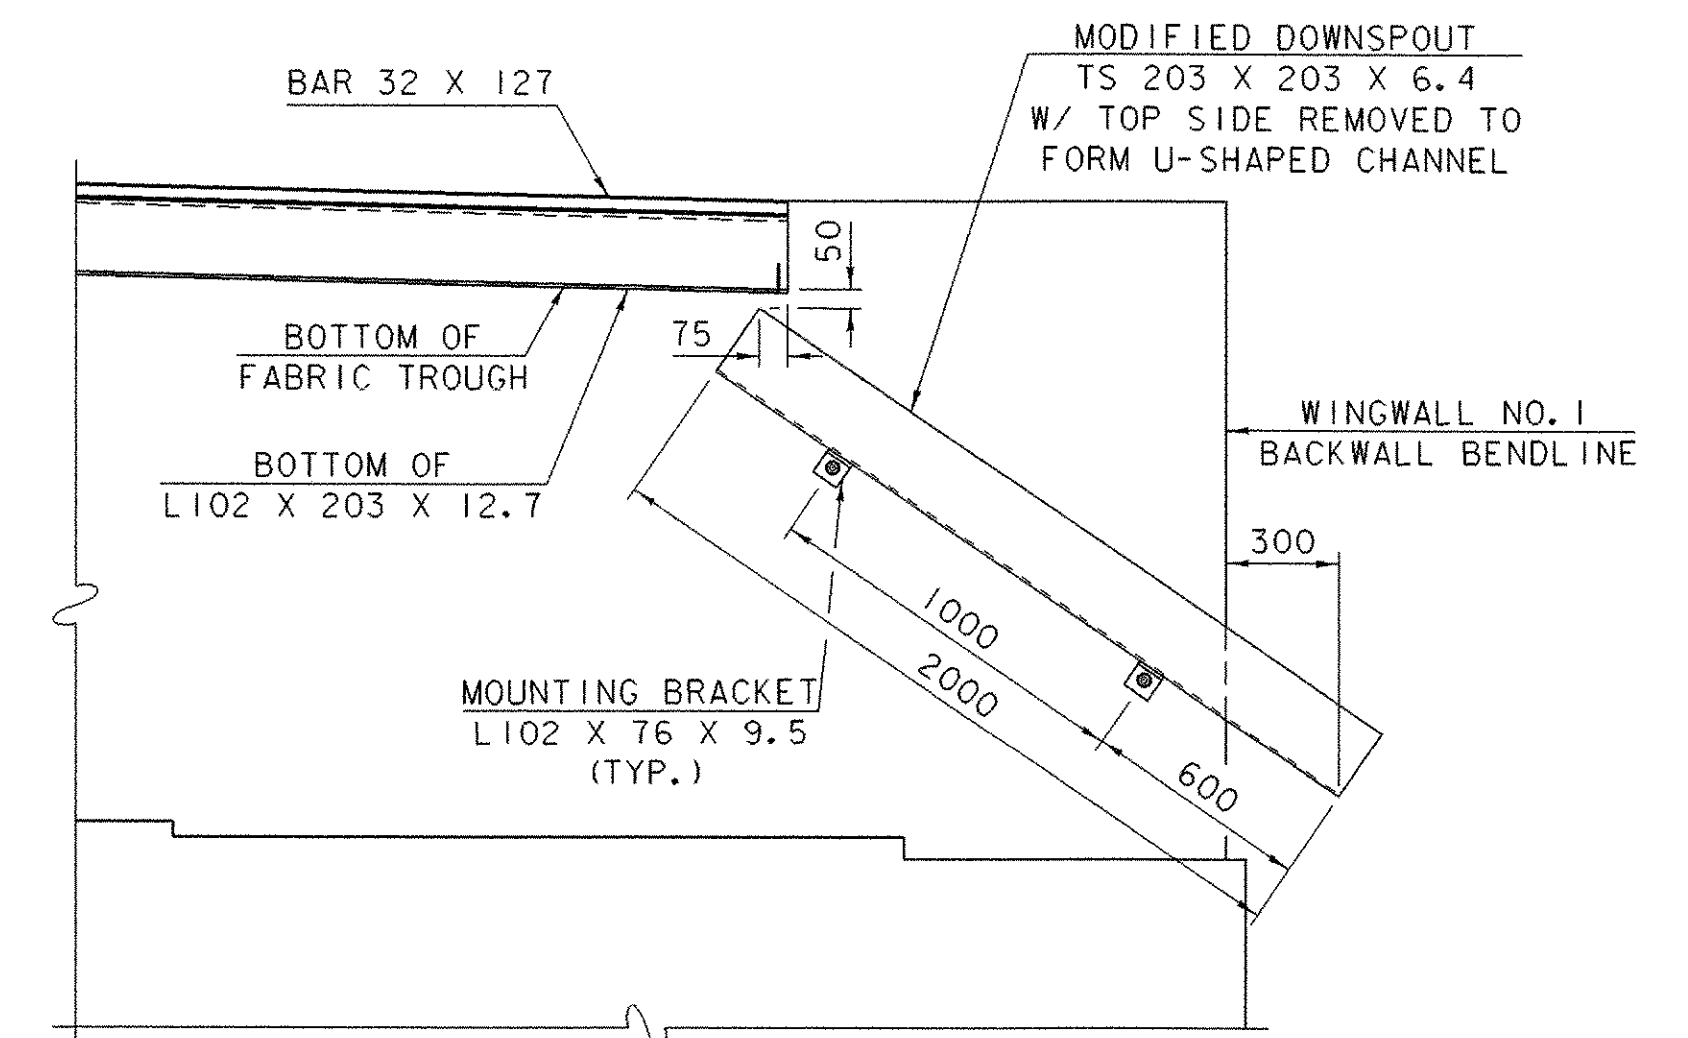


DOWNSPOUT ELEVATION

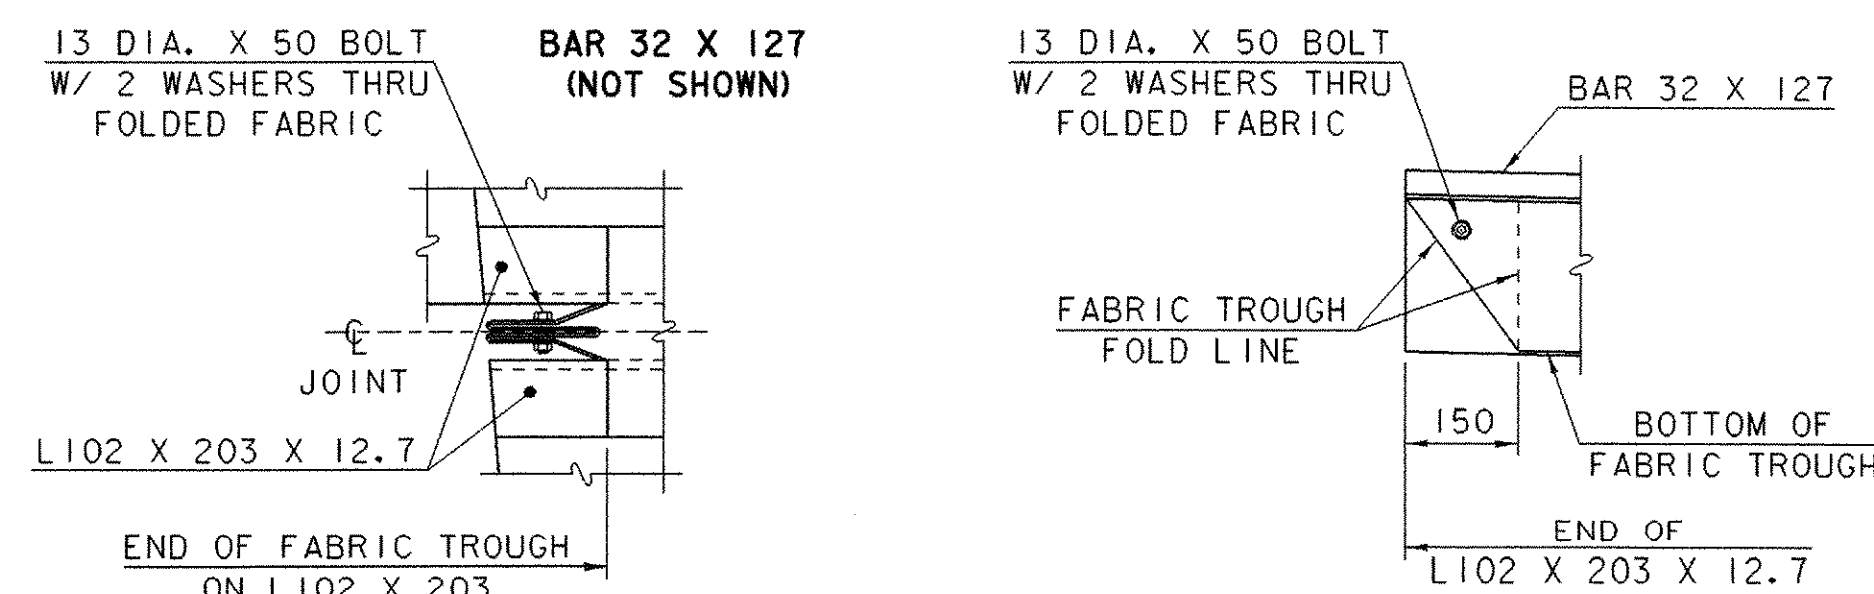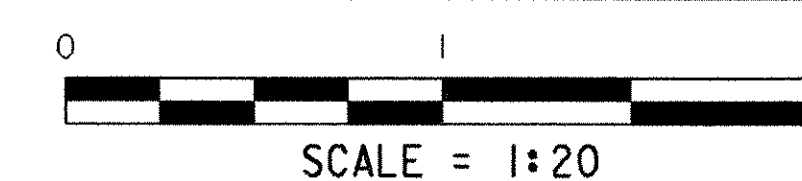


PLAN

ELEVATION

DETAIL "B"

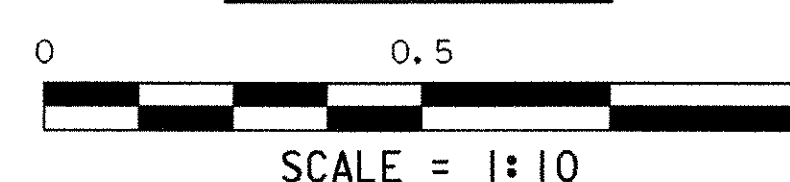

EXPANSION JOINT PLAN AND DOWNSPOUT DETAILS			
SHEET NAME:			
PROJECT NAME: LEICESTER	HIGHWAY NO.: TH 1		
PROJECT NUMBER: BRF 0160(3)S	BRIDGE NO.: 6		
	OVER: OTTER CREEK		
FILE NAME: /PW/95J288/sj288exp.dgn	PLOT DATE: 17-AUG-2005		
PROJECT MANAGER: R. R. WHITCOMB	DRAWN BY: G. ROY		
DESIGNED BY: C. CARLSON	IPARM NAME: sj288exh.1		
BRIDGE SHEET NUMBER:	SHEET 54 OF 90		

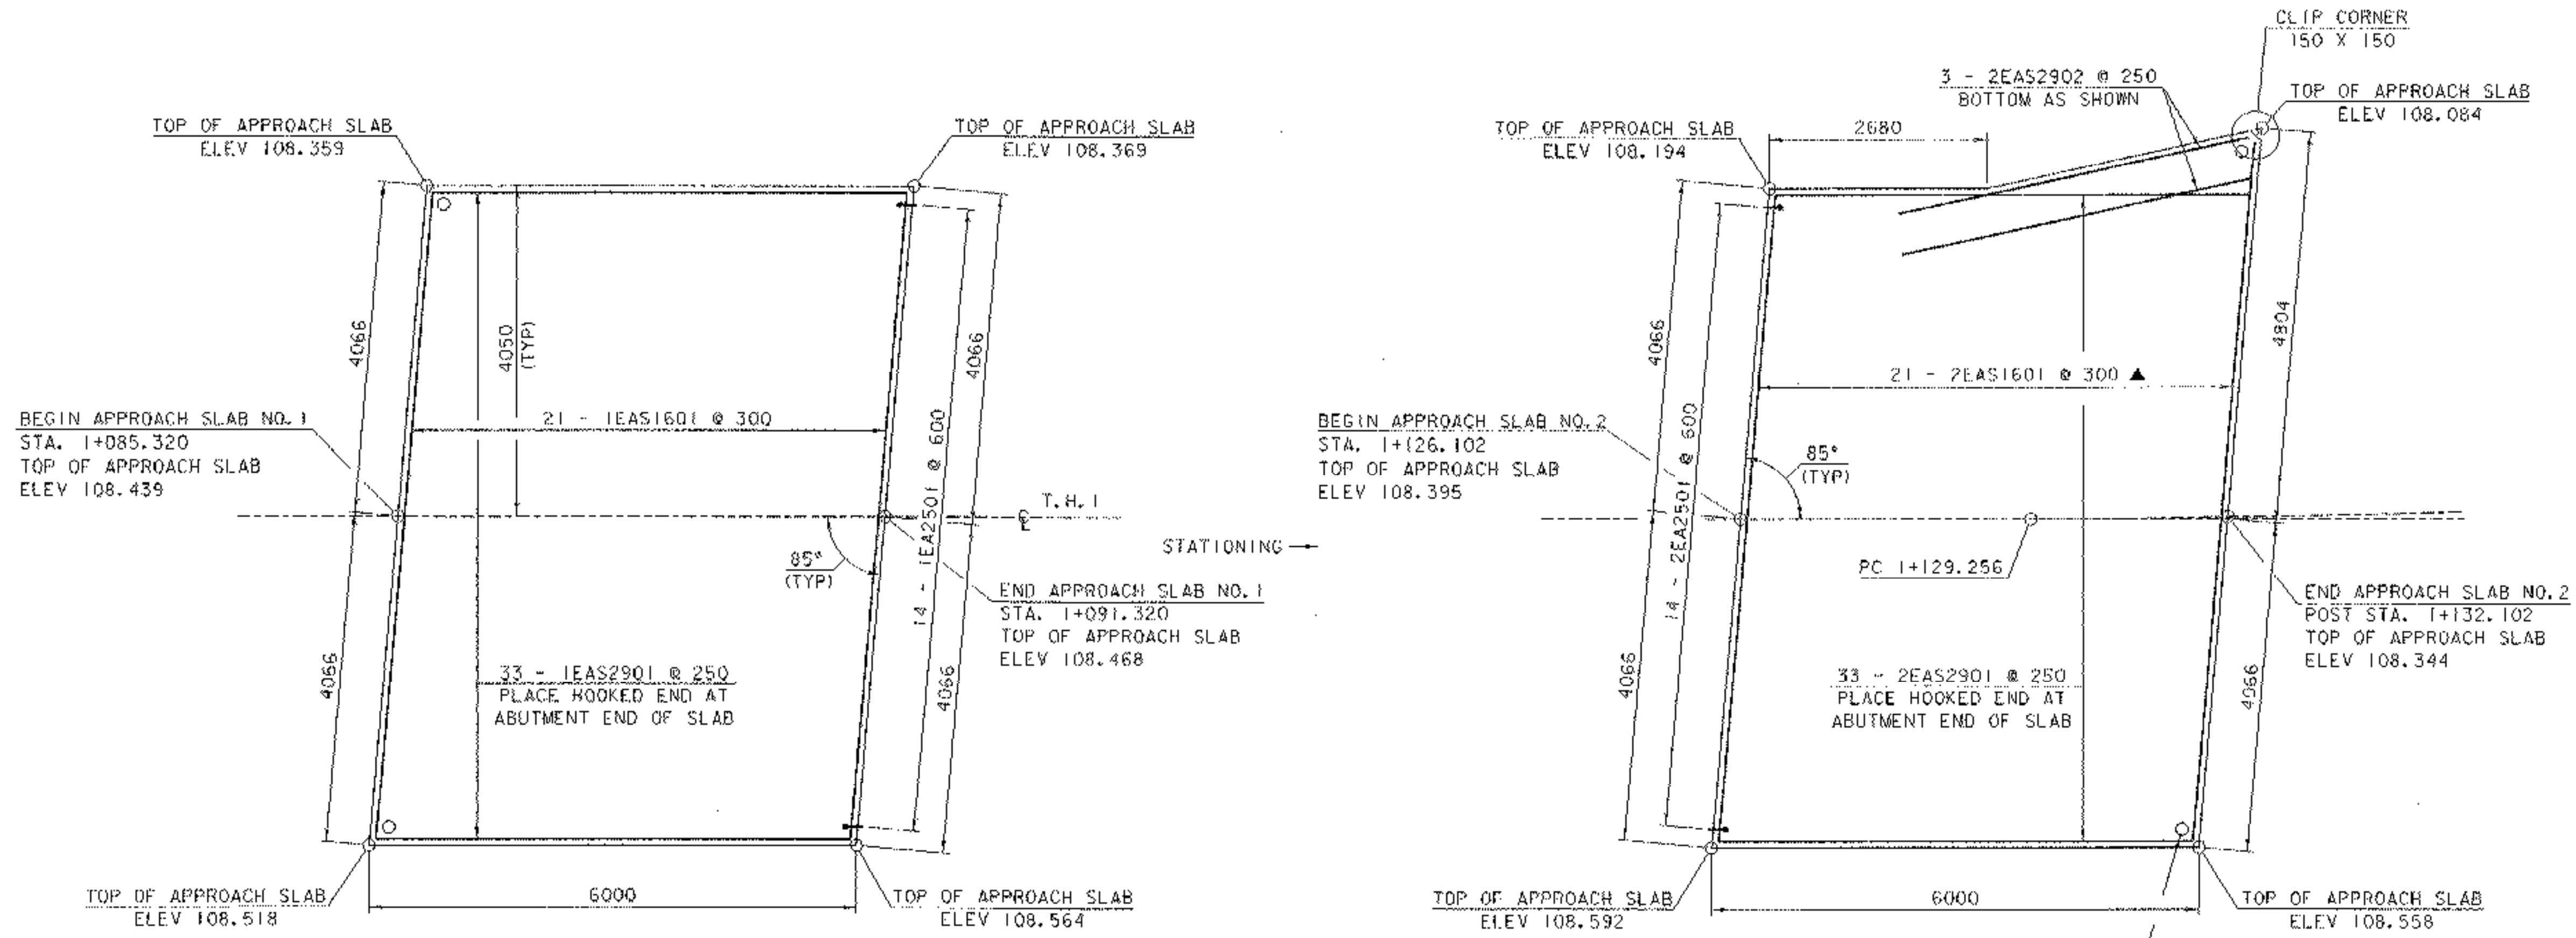


APPROACH SLAB PLAN

SCALE 1 : 50

~~*INSTALL BENCH MARK DISC FLUSH WITH TOP OF PAVEMENT AND 150 CLEAR FROM EDGES OF APPROACH SLAB. TYPICAL ALL FOUR OUTSIDE CORNERS OF APPROACH SLABS AS SHOWN. VAQT SHALL SUPPLY DISCS. COST FOR INSTALLATION SHALL BE INCIDENTAL TO ITEM 501.34, "CONCRETE, HIGH PERFORMANCE CLASS B".~~

~~*THIS WORK ELIMINATED.~~

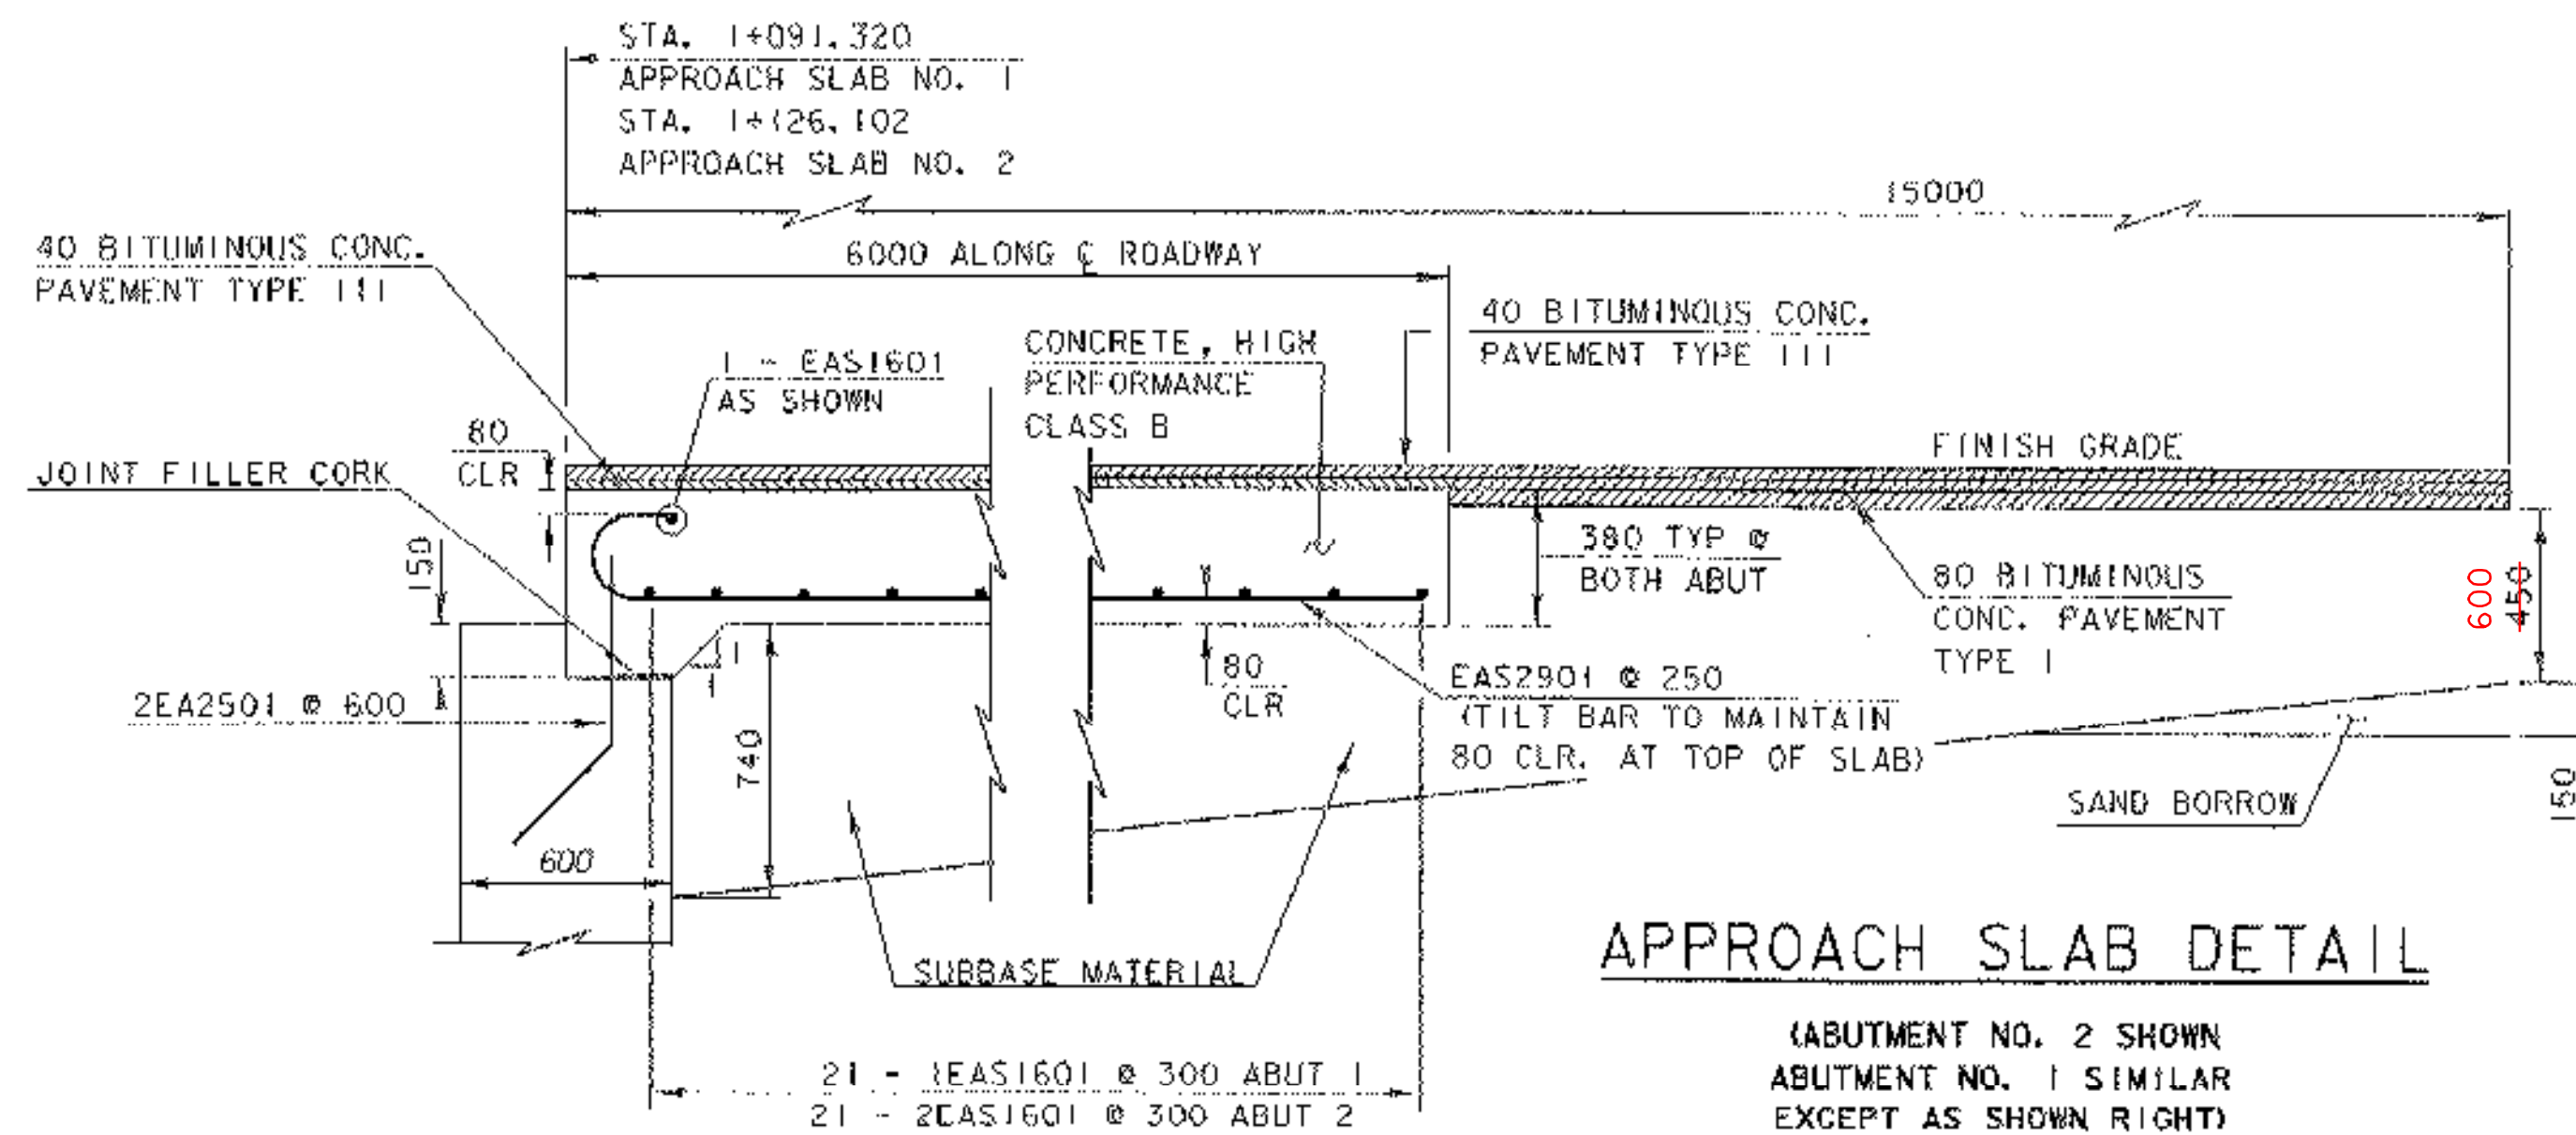


APPROACH SLAB DETAIL

(ABUTMENT NO. 2 SHOWN
ABUTMENT NO. 1 SIMILAR
EXCEPT AS SHOWN RIGHT)

SCALE 1 : 20


*SEE SHEET 75 OF 90
FOR PROPER SUBBASE
DETAIL AT ABUTMENTS

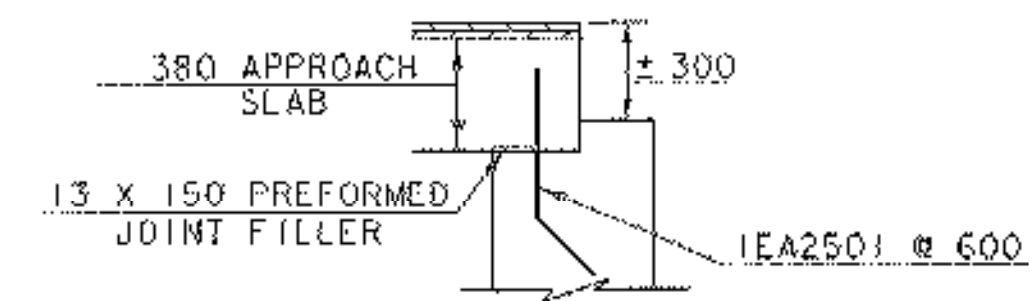


ABUTMENT NO. 1 DETAIL

NOT TO SCALE


SHEET NAME: APPROACH SLAB DETAILS	
PROJECT NAME: LEICESTER	HIGHWAY NO.: TH 1
PROJECT NUMBER: BRF 0160(3)S	BRIDGE NO.: 6
	OVER: OTTER CREEK
FILE NAME: 95J288\Structures\sJ288sup.dgn	PLOT DATE: 17-AUG-2005
PROJECT MANAGER: R. R. WHITCOMB	DRAWN BY: T. FILLBACH
DESIGNED BY: C. CARLSON	(PARM NAME: sJ288asd.i)
BRIDGE SHEET NUMBER:	SHEET 55 OF 90

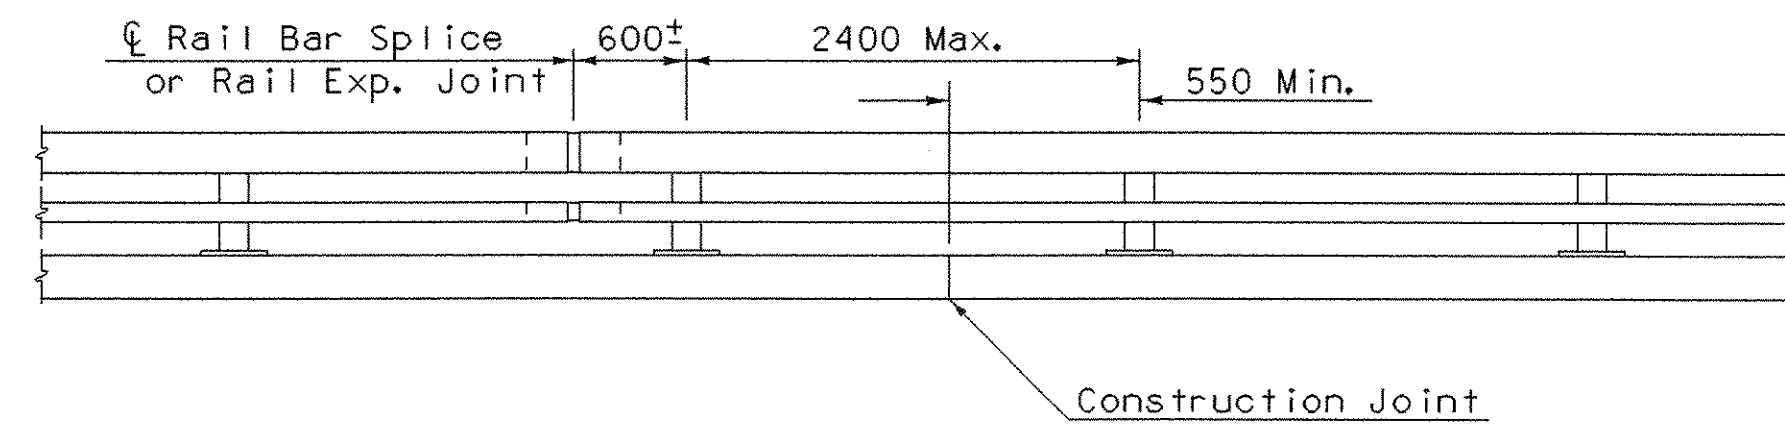


BRIDGE RAILING ELEVATION

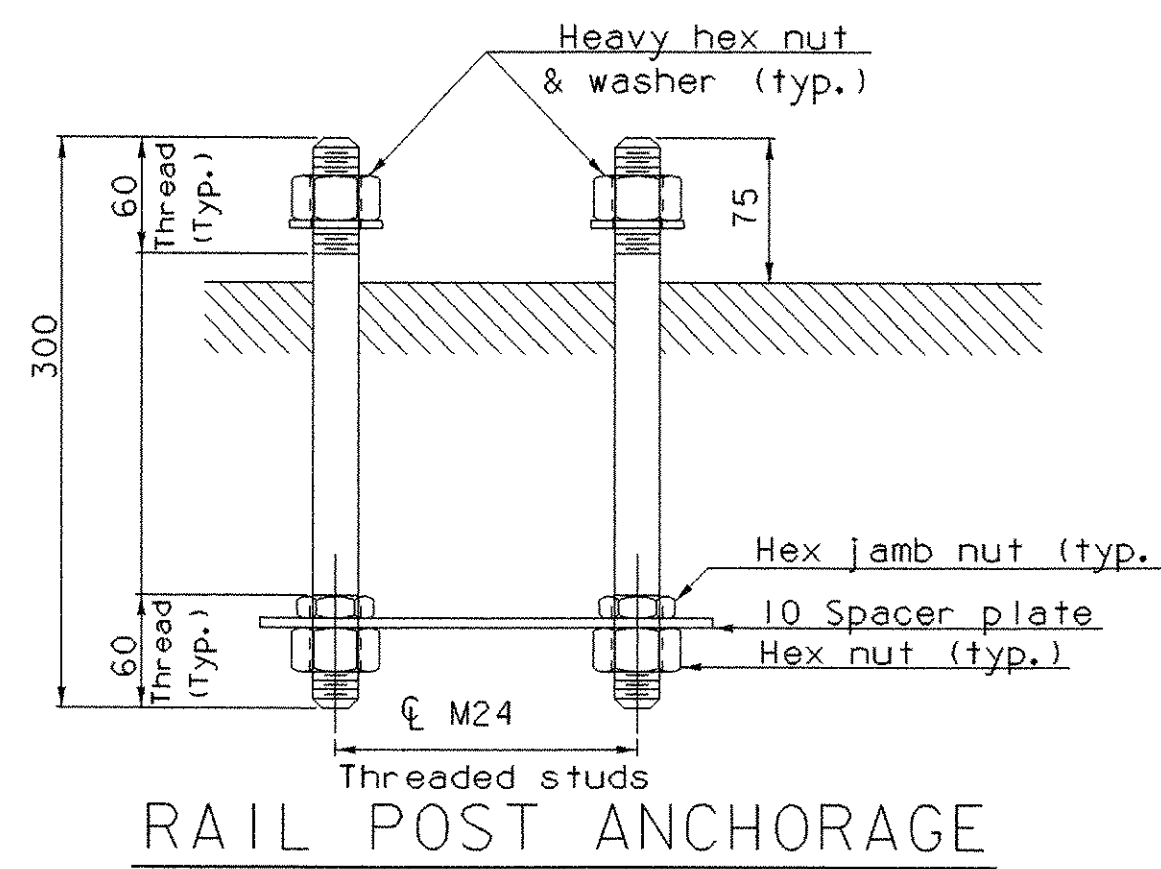


RAIL POST ANCHORAGE

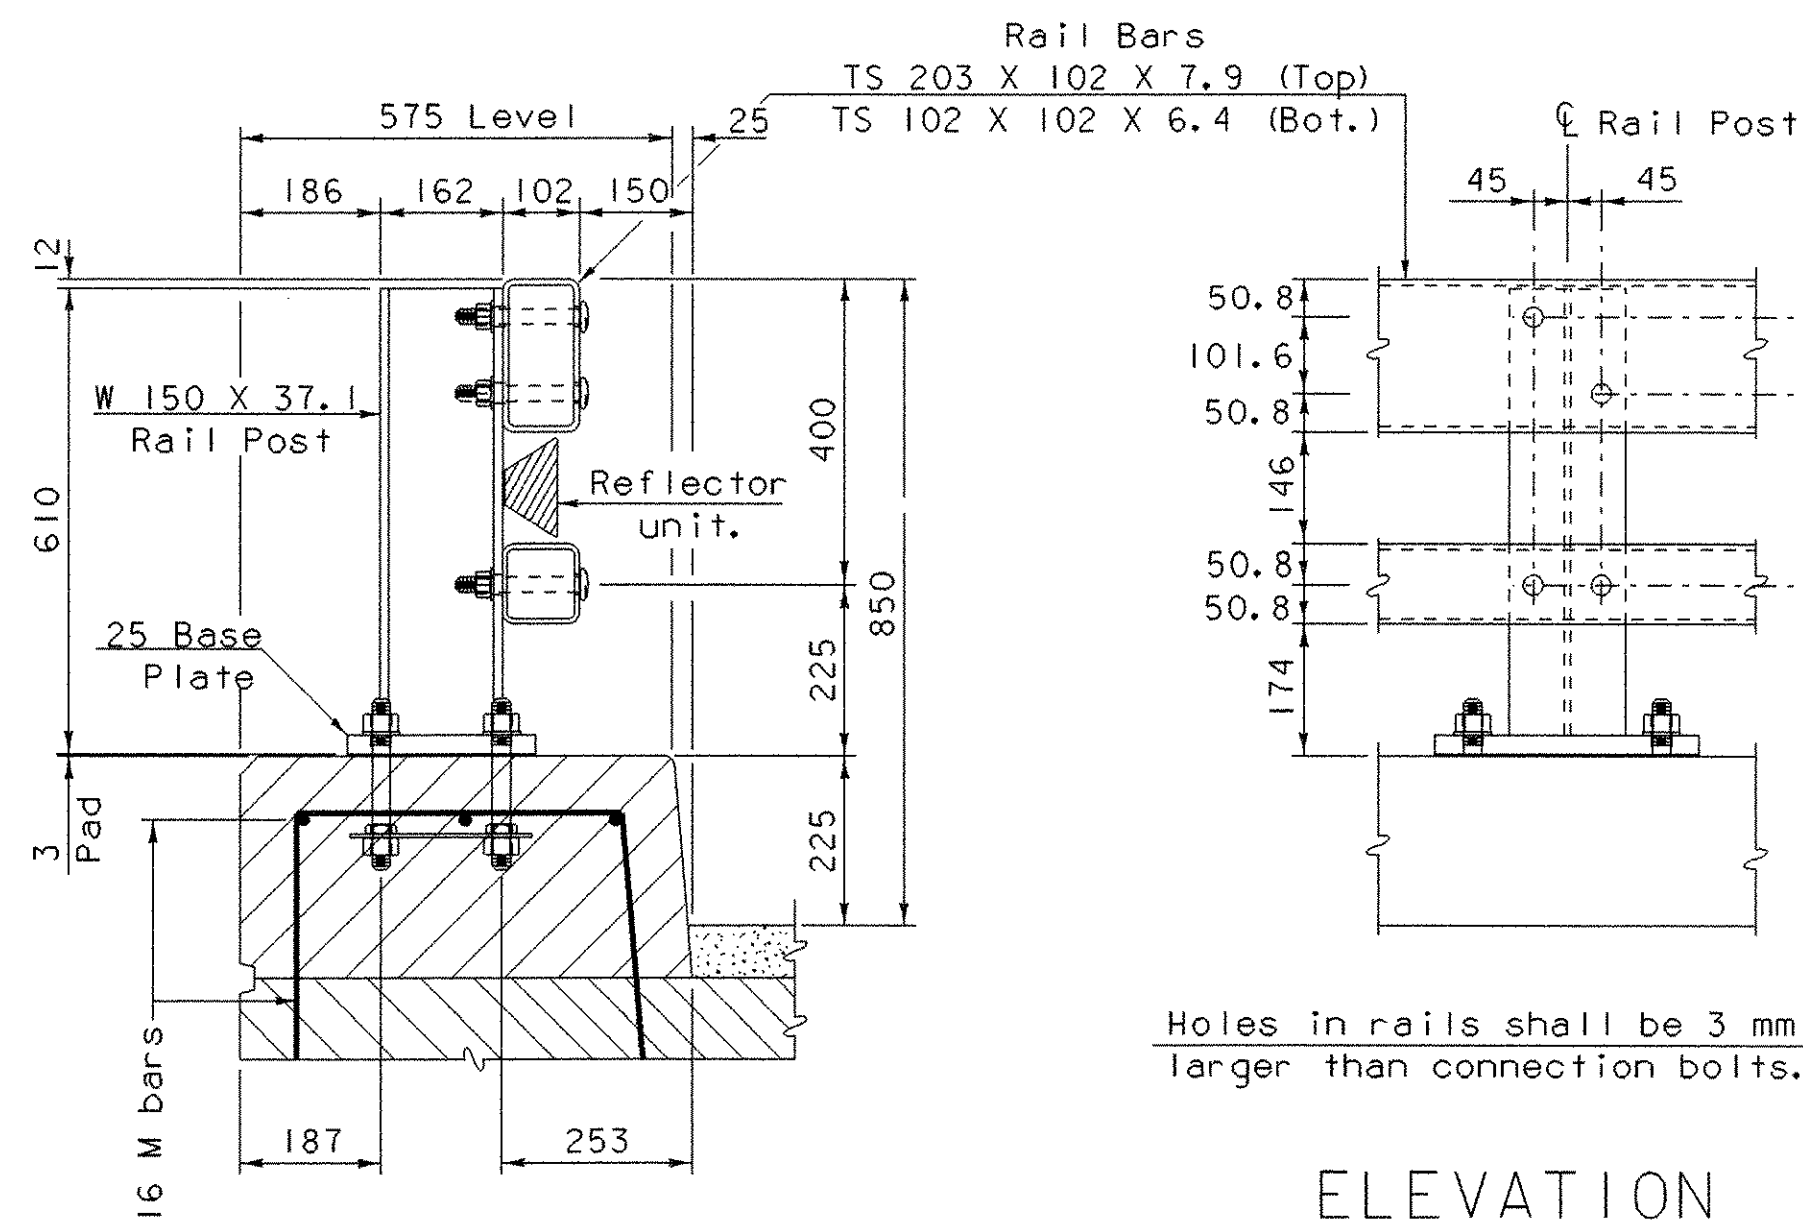

TYPICAL SECTION

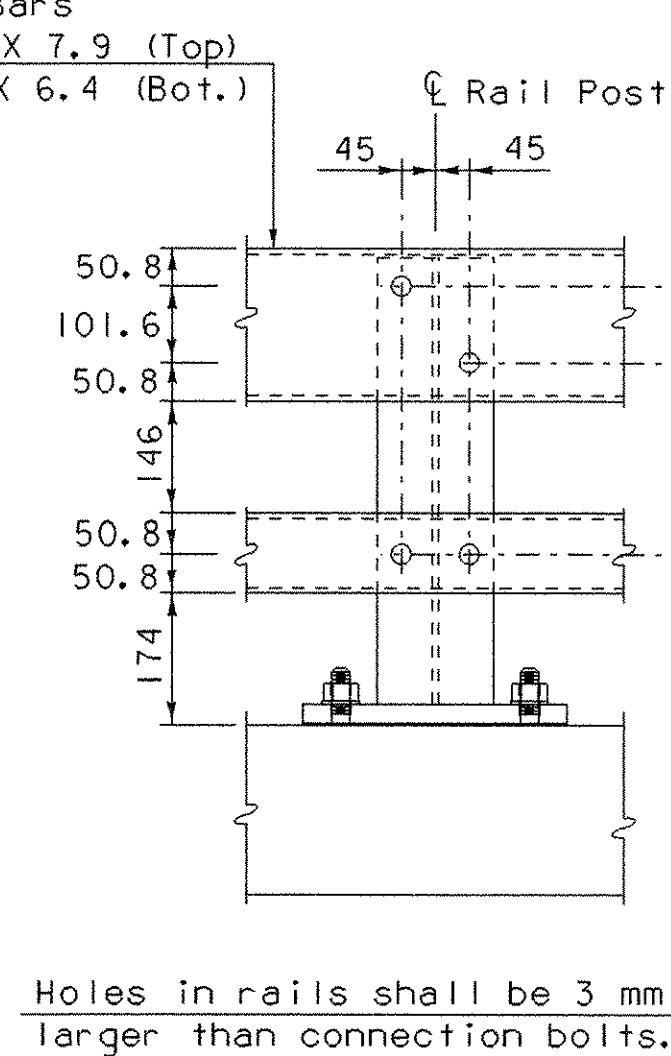


ELEVATION

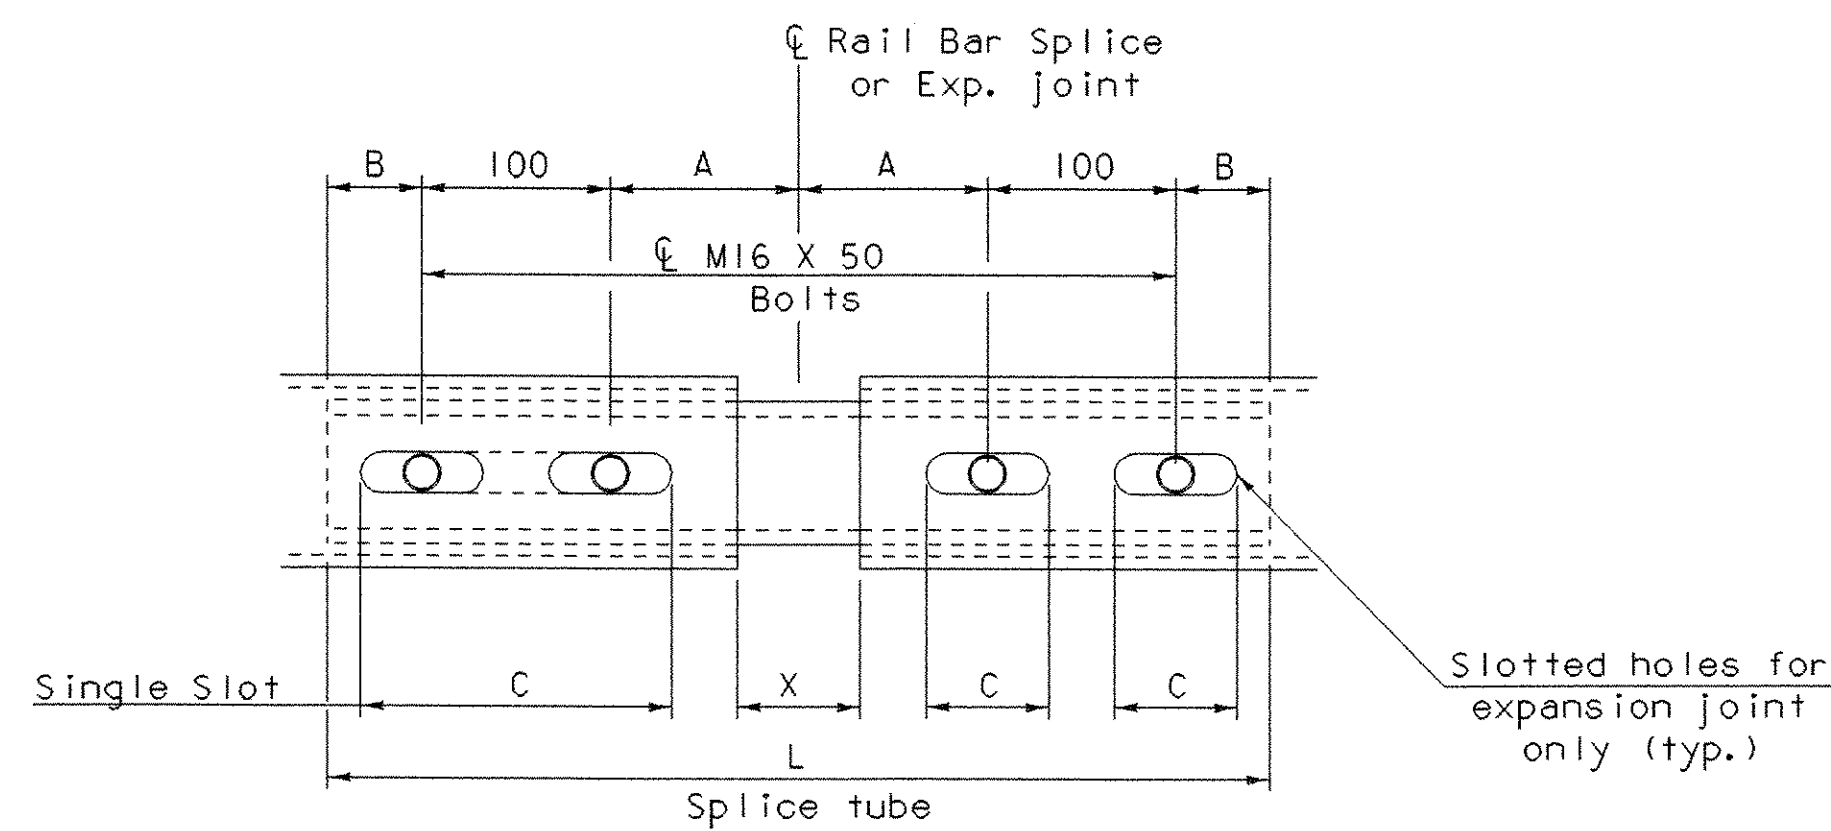


RAIL BAR SPLICE & RAIL EXP. JOINT DETAIL


[Bottom View]

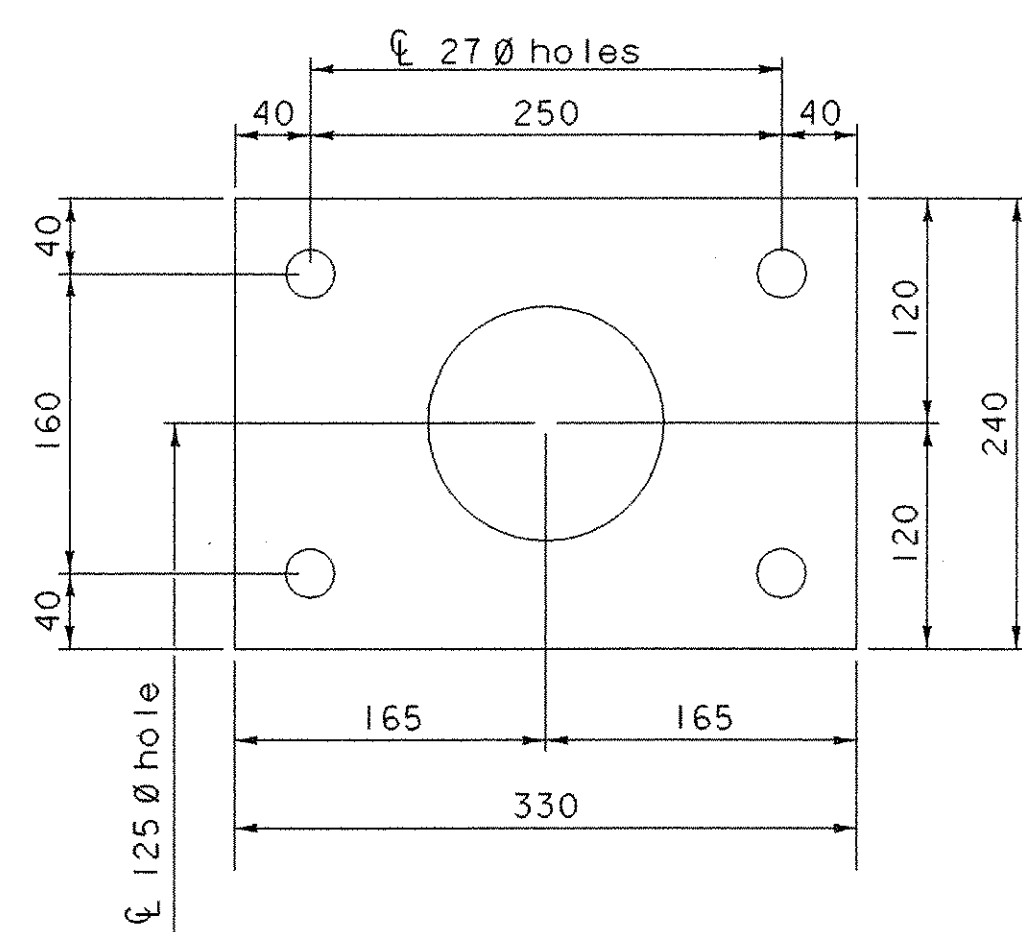


SPACER PLATE

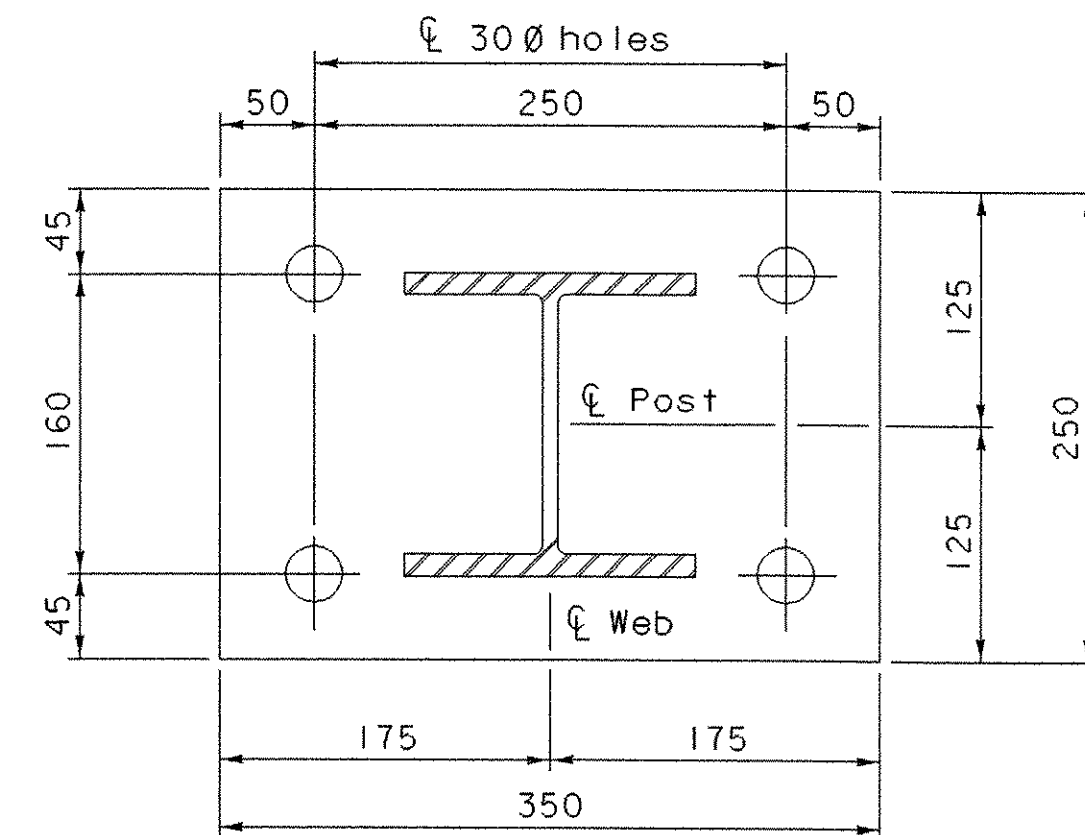


POST & BASE PLATE

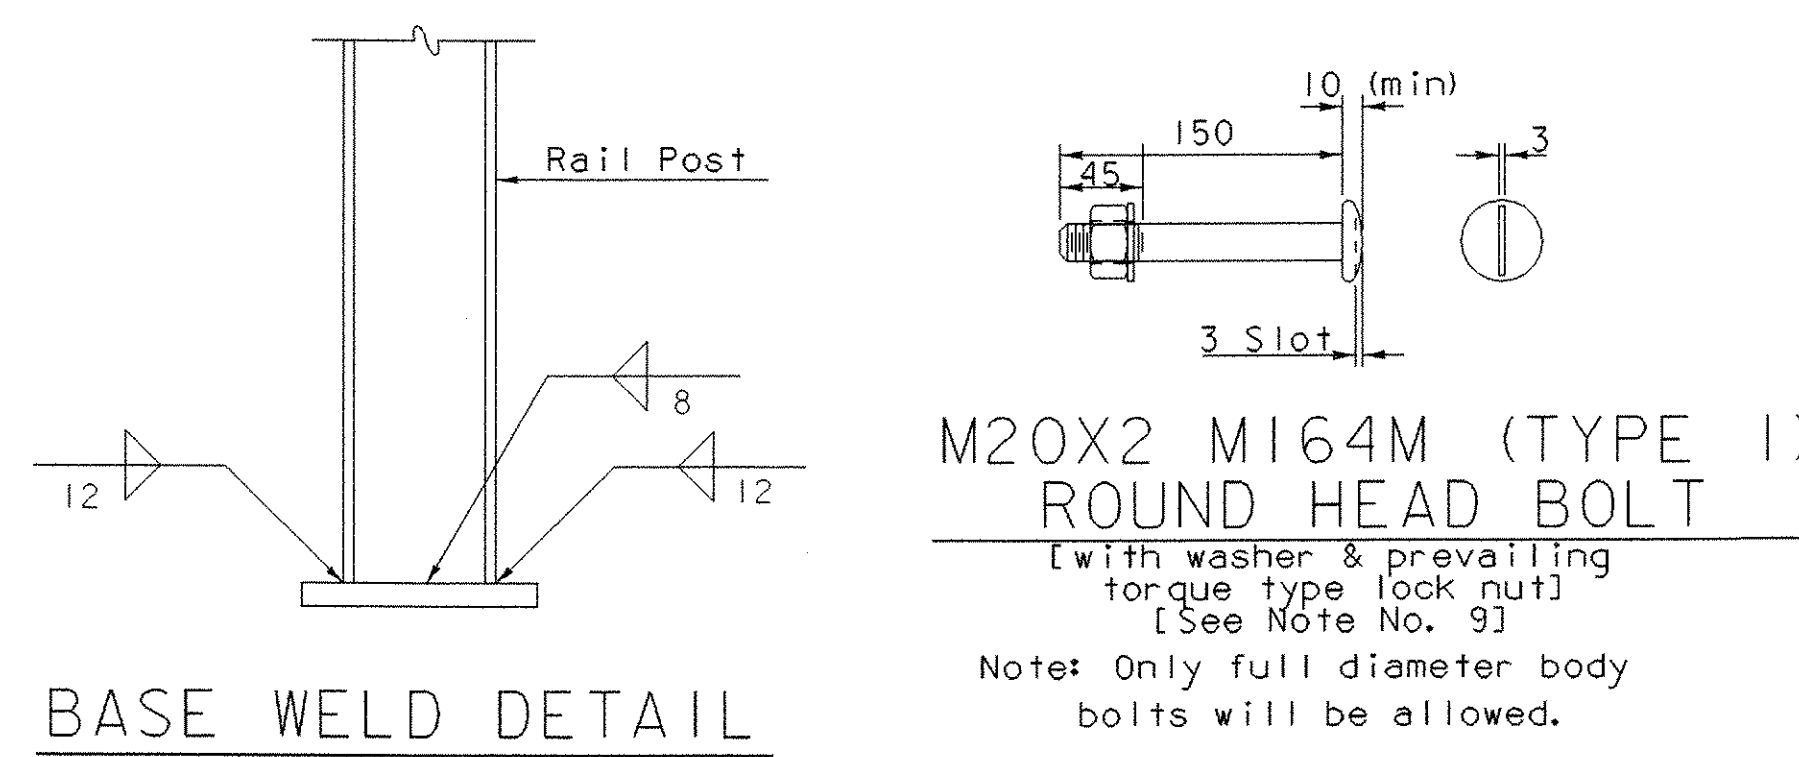


BASE WELD DETAIL

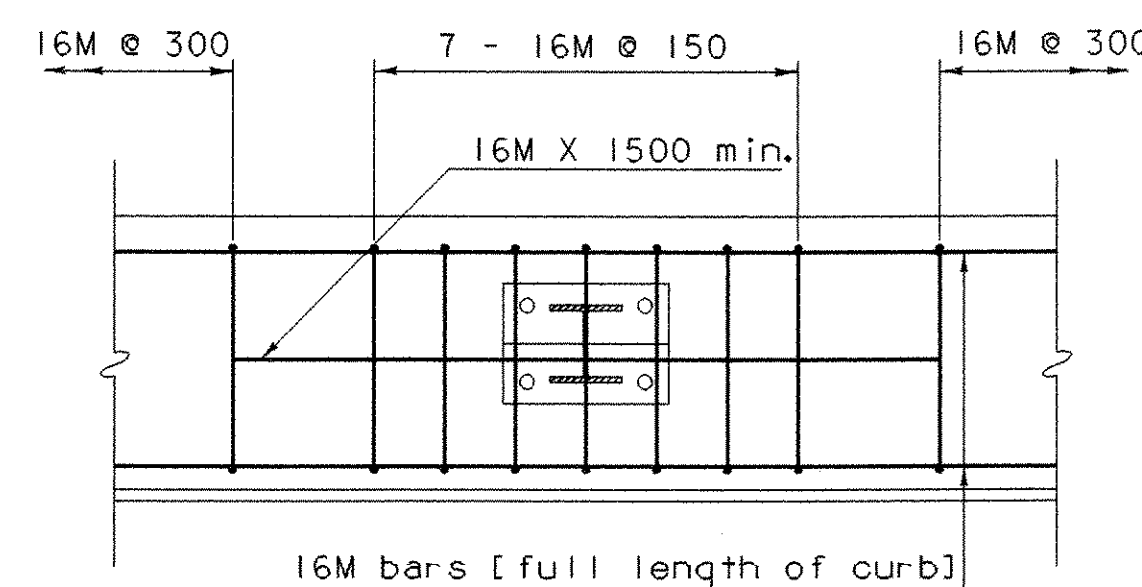

CURB REINFORCING PLAN

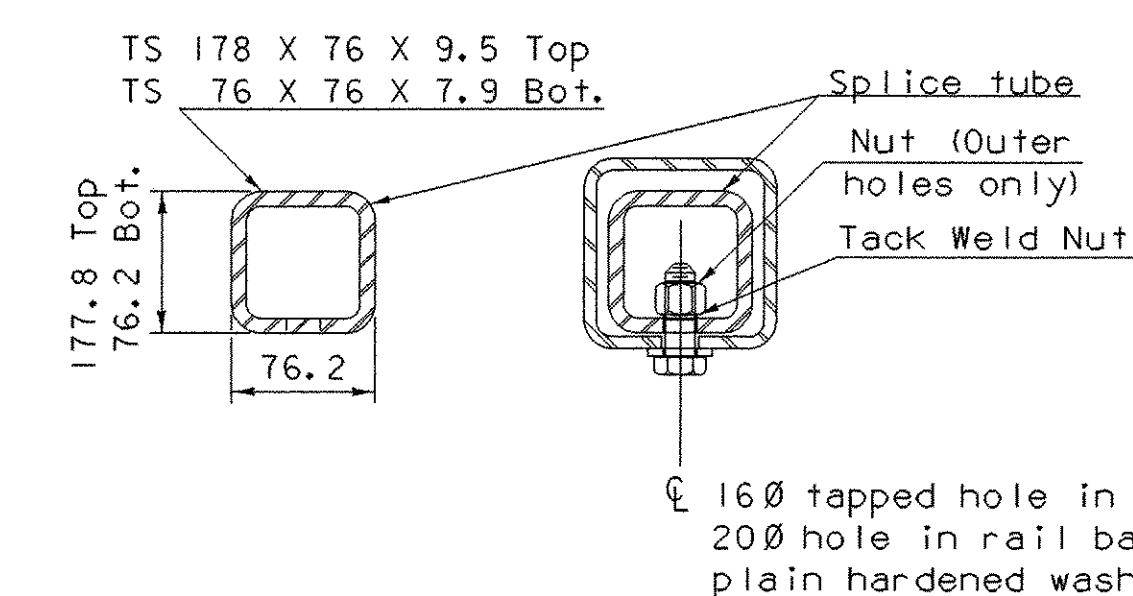

RAIL BAR SPLICE SECTION

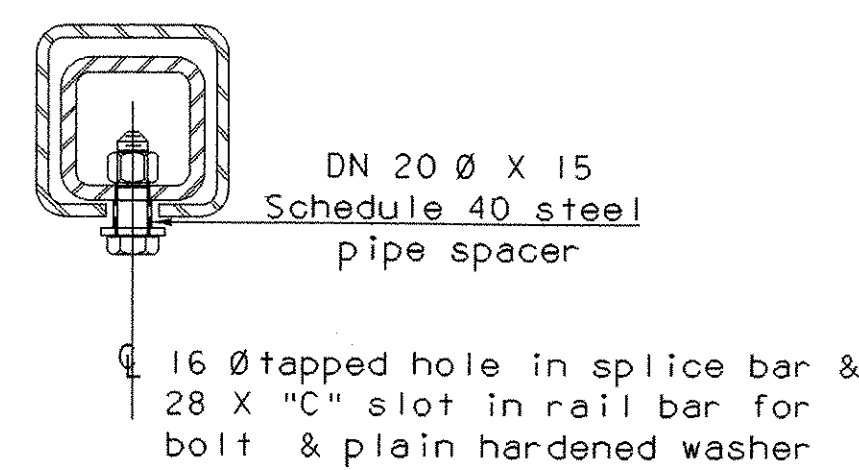

EXPANSION JOINT SECTION

For details not shown, see "Rail Bar Splice Section"

SPLICE & EXPANSION JOINT TABLE					
T	A	B	C	L	X
Splice	100	50	--	500	20
≤ 100	100	50	65	500	65
>100 ≤165	140	60	90	600	100
>165 ≤225	165	85	225*	700	125
>225 ≤330	215	110	275*	850	175

T = Total Movement * = Single Slot

NOTES

- All work and materials shall conform to the provisions of Section 525 - Railings of the Standard Specifications for Construction.
- Tubing and posts shall meet the requirements of Section 732 - Railing materials of the Standard Specifications for Construction.
- All exposed cut or sheared edges shall be rounded to a 1.6 mm radius and be free of burrs.
- Rail posts shall be set normal to grade.
- Sections of rail bar shall be attached to a minimum of two rail posts and preferably to at least four posts.
- Rail bar expansion joints shall be provided in any rail bay spanning a superstructure expansion joint. Expansion joint width shall be "X" at 7 °C and will be adjusted in the field by the Engineer.
- All parts shall be galvanized after fabrication in accordance with AASHTO M111, except that hardware shall meet the requirements of AASHTO M232.
- Rail posts anchoring nuts shall be tightened to a snug fit and given an additional 45 degree turn.
- Rail bars shall be attached using M20 full diameter body AASHTO M164M (Type 1) round head bolts inserted through the face of the bar. Holes in posts shall be 2 mm larger than the bolt size.
- Holes in rails for rail bar attachment may be field - drilled. Holes shall be coated with an approved zinc - rich paint prior to erection.
- If there is a conflict between these Standard Details and the Design Drawings, the requirements of the Design drawings shall be followed.
- Any bending of rail shall be by shop procedure only.
- The fabricator shall submit shop drawings including welding procedures to the structures section for approval in accordance with the provision of 506.04, shop drawings. All welding shall conform with section 506.10.
- The drop-weight tear test in section 732 shall not apply to the structural tubing on this standard.

MATERIALS

Rail bars.....ASTM A500, Grade B or ASTM A501
 Rail posts.....ASTM A709/A709M, Grade 345
 All other shapes & plates.....ASTM A709/A709M, Grade 250
 Anchor studs.....ASTM F568M, Class 8.8
 All other bolts [unless noted].....AASHTO M164M, Type 1

Nuts for AASHTO M164M bolts shall comply with AASHTO M291M. Nuts for anchor studs shall comply with ASTM A563.
 Washers shall comply with AASHTO M293M (ASTM F436M) specification.


3 mm pad shall comply with standard specification subsection 731.01 or 731.02.

Set screws for delineation devices shall conform to ASTM F880M, Class A1-70, Condition CW, Alloy Type 304.


SHEET NAME: **NETC BRIDGE RAILING DETAILS (I)**

PROJECT NAME: **LEICESTER** HIGHWAY NO.: TH 1
 PROJECT NUMBER: **BRF 0160(3)S** BRIDGE NO.: 6
 OVER: OTTER CREEK

FILE NAME: 95j288\Structures\sj288rd.dgn PLOT DATE: 17-AUG-2005
 PROJECT MANAGER: R. R. WHITCOMB DRAWN BY: G. ROY
 DESIGNED BY: C. CARLSON IPARM NAME: sj288brd.I
 BRIDGE SHEET NUMBER: SHEET 56 OF 90

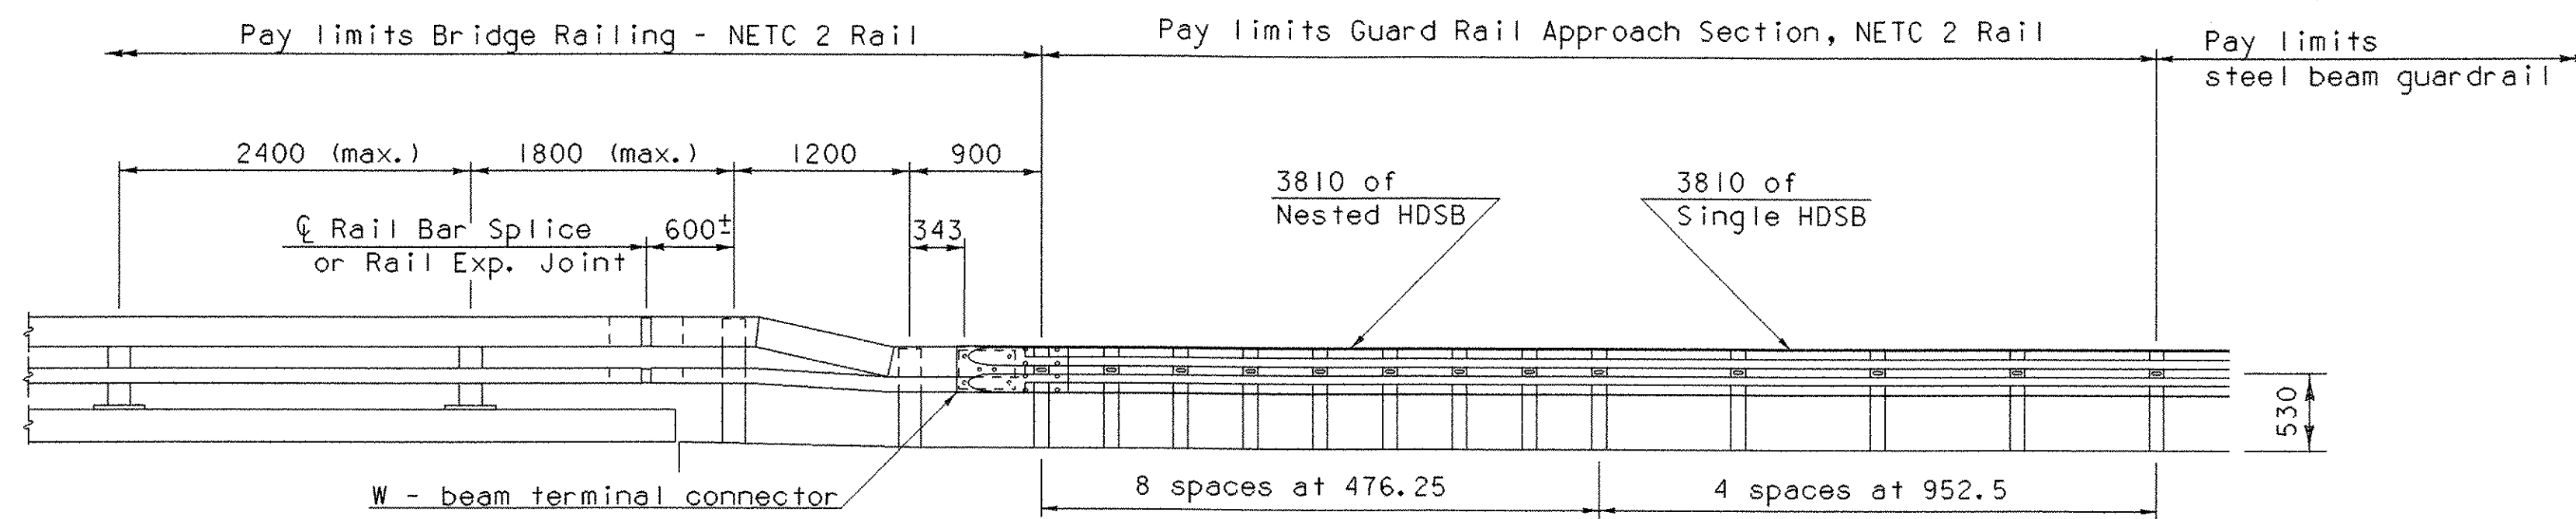


RAILING TRANSITION ELEVATION

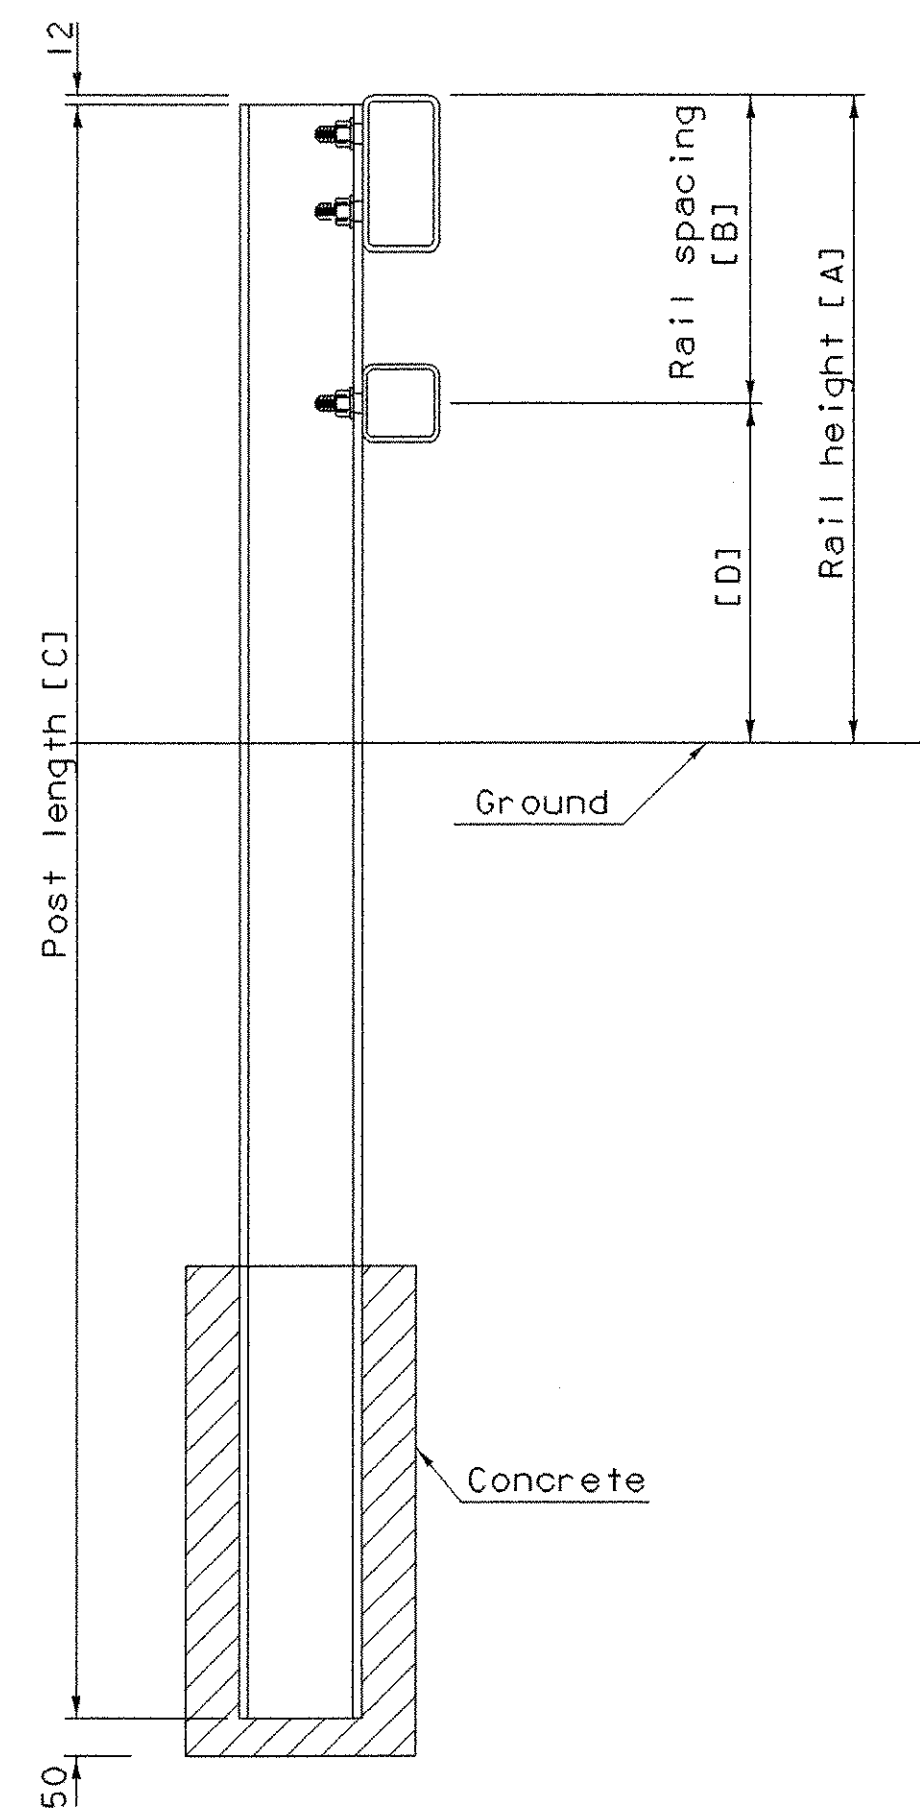

TYPICAL SECTION


TABLE OF DIMENSIONS				
Post Number	Rail Height [A]	Rail Spacing [B]	Post Length [C]	Rail Height [D]
1	850	400	2135	450
2	704	254	1990	450

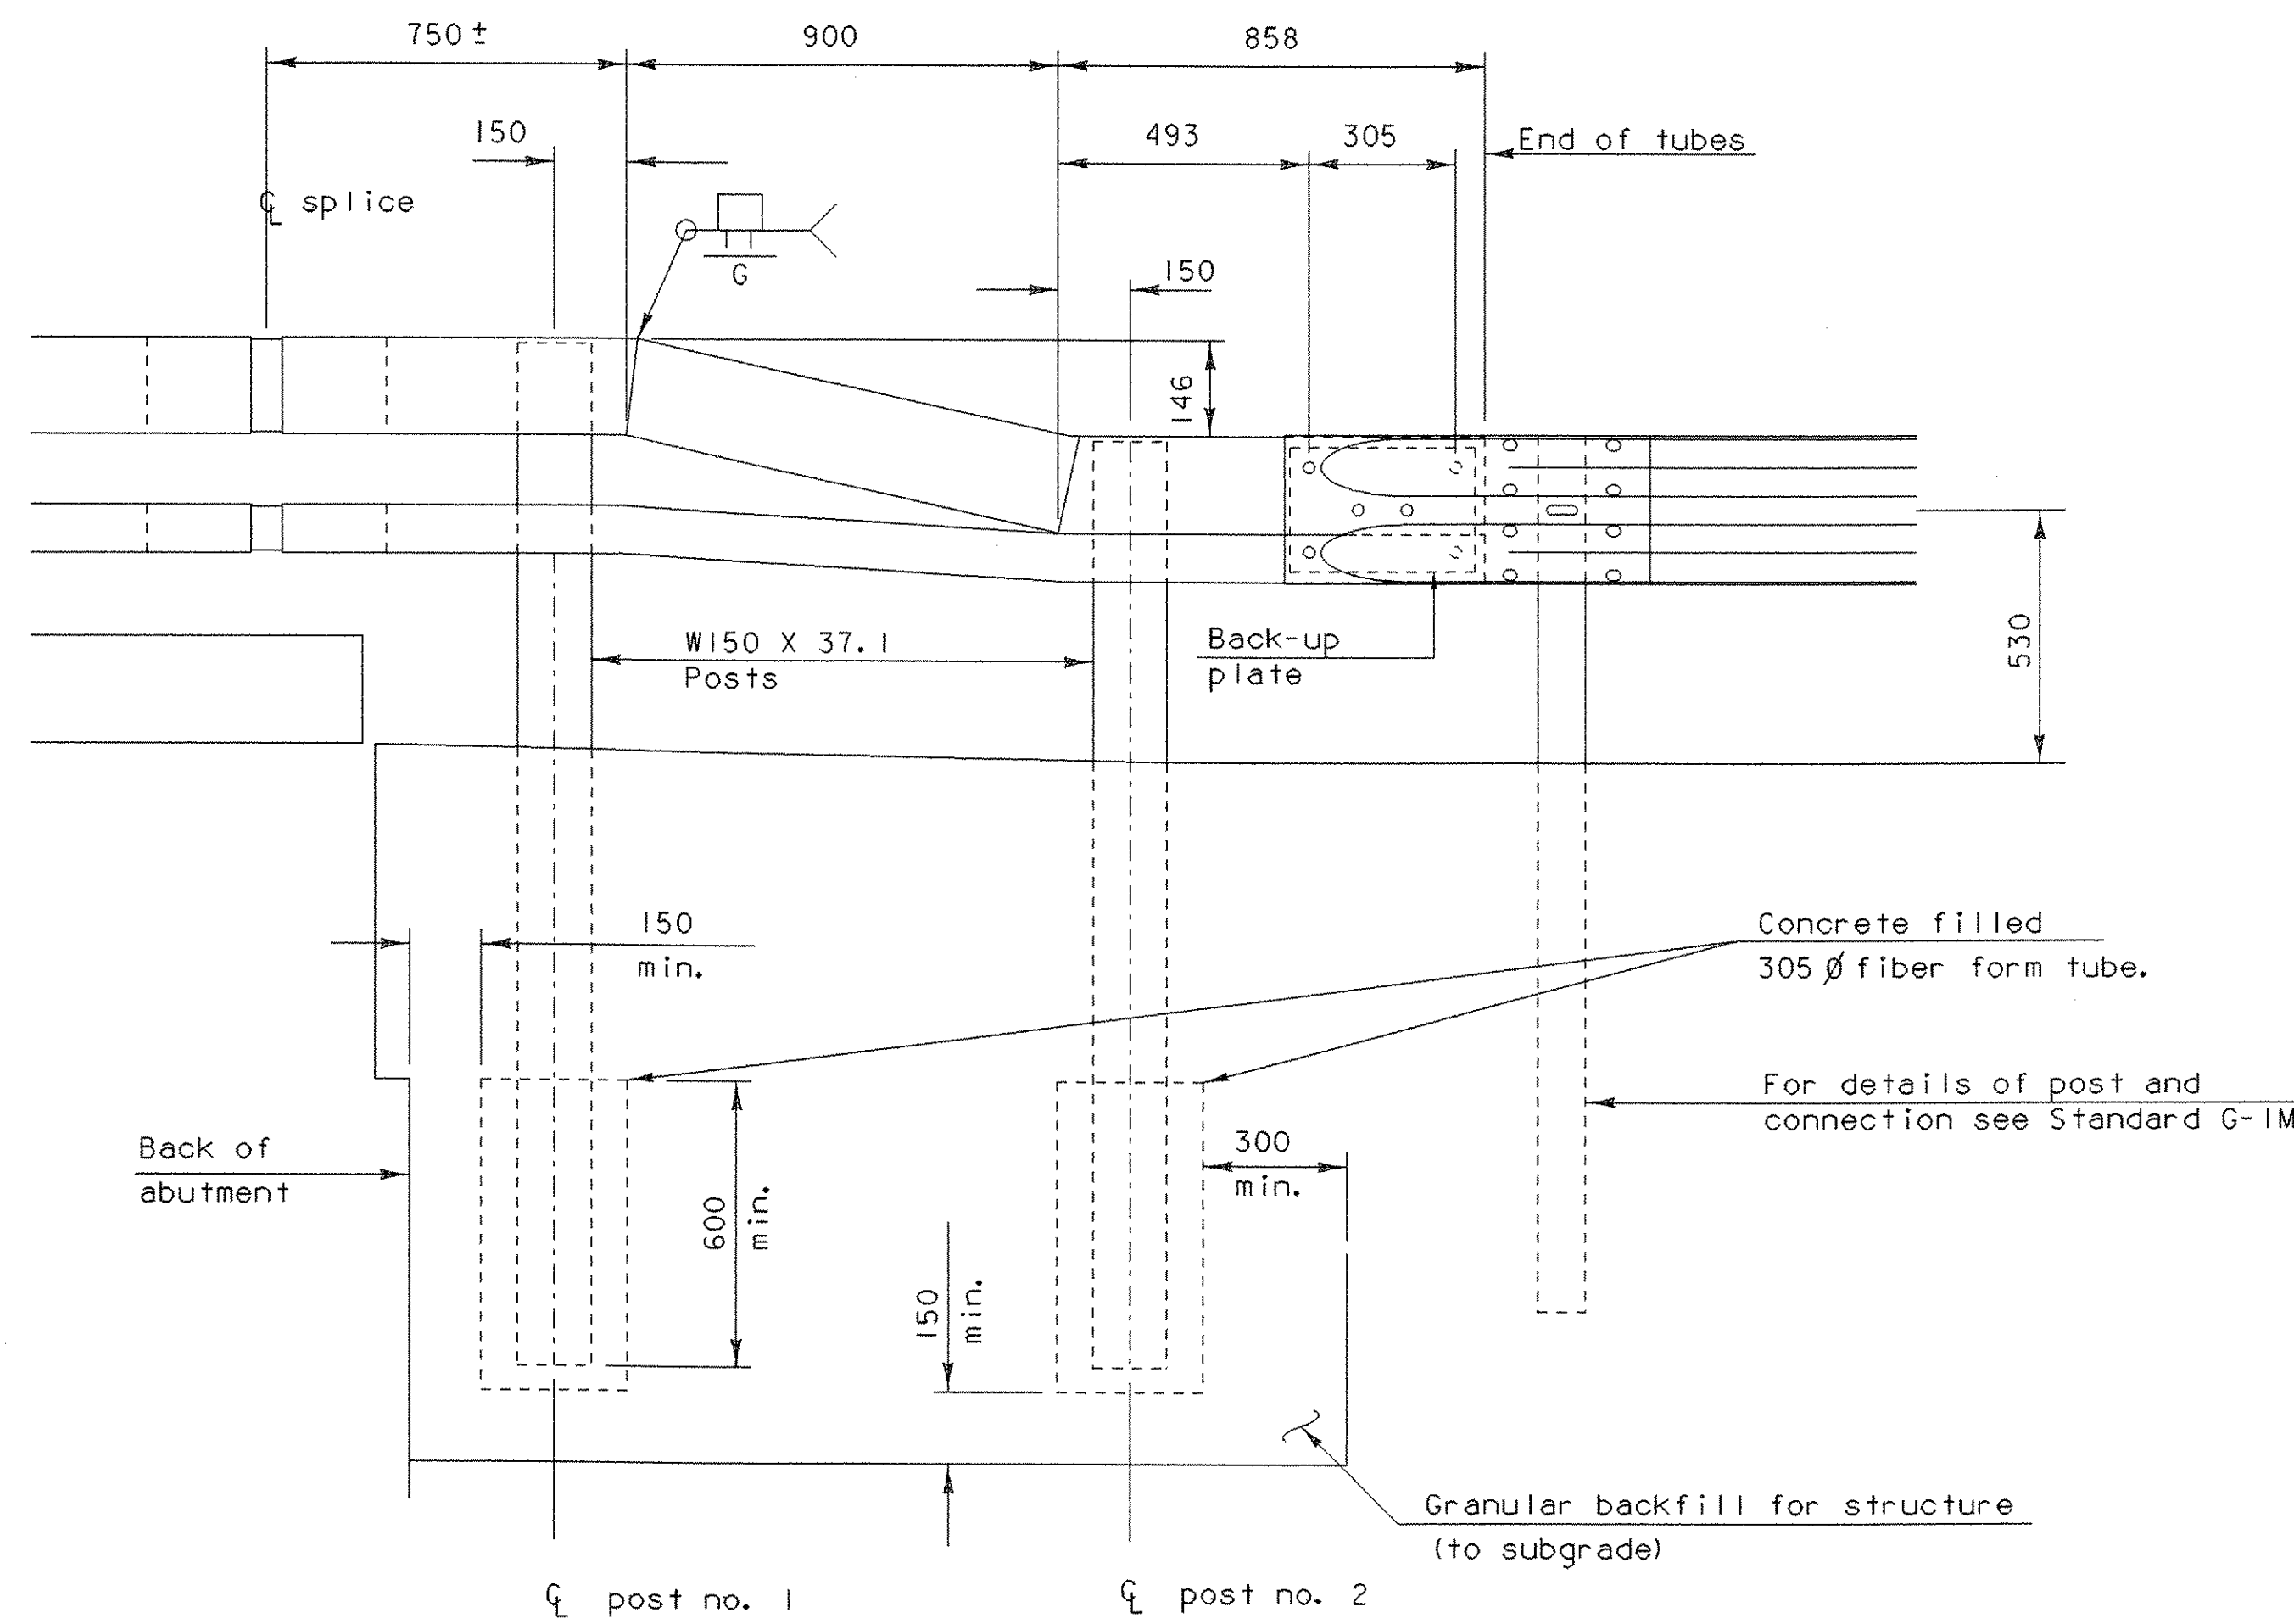


ELEVATION

Notes:


1. Refer to sheet 56 for additional details, notes and materials specifications.
2. To facilitate field fit-up, the transition railing posts shall be set loosely into fiber form tubes while transition parts are being assembled. Post holes shall be backfilled with a concrete mix approved by the Engineer. Payment for components, including backup plate and end terminal connector for guard rail, augering, fiber-form & concrete, and installation shall be considered incidental to Bridge Railing - NETC 2 Rail.
3. The reflectorized aluminum delineation is to be erected every 9 m (or closet post) with two M4 X 0.7 X 20 set screws. Delineators shall meet specification requirements for ASTM B 209M alloy 5052-H32.
4. Reflective material shall meet requirements of subsection 750.08 and ASTM type III and shall be of encapsulated lens silver or amber. Amber is to be installed on the driver's left and silver on their right.
5. On bridges with a sidewalk, delineators are not to be installed on the sidewalk side of the bridge (i.e. delineators installed only on the curb side and on the approach on the curb side). Payment shall be incidental to all other items.
6. All approach rail splices shall be lapped in the direction of traffic flow.

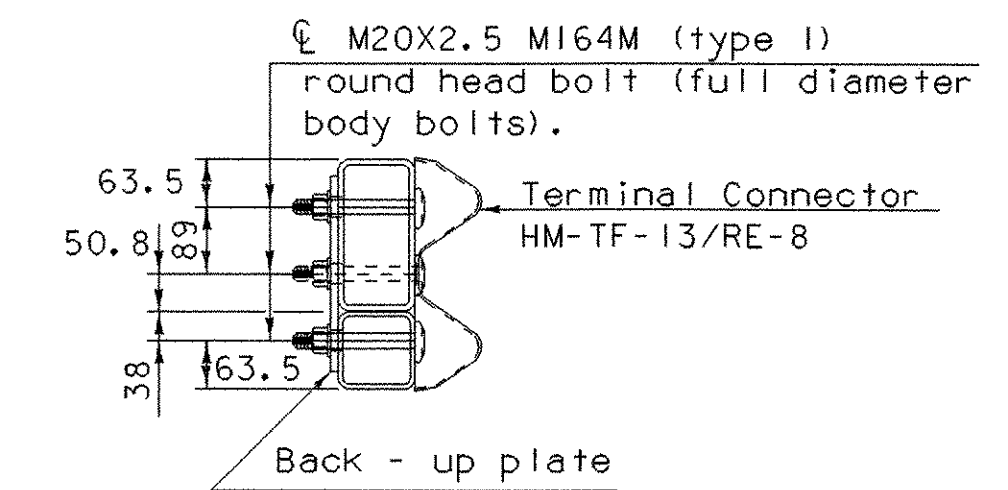


SECTION THROUGH GUARD RAIL CONNECTION AT TERMINAL CONNECTOR

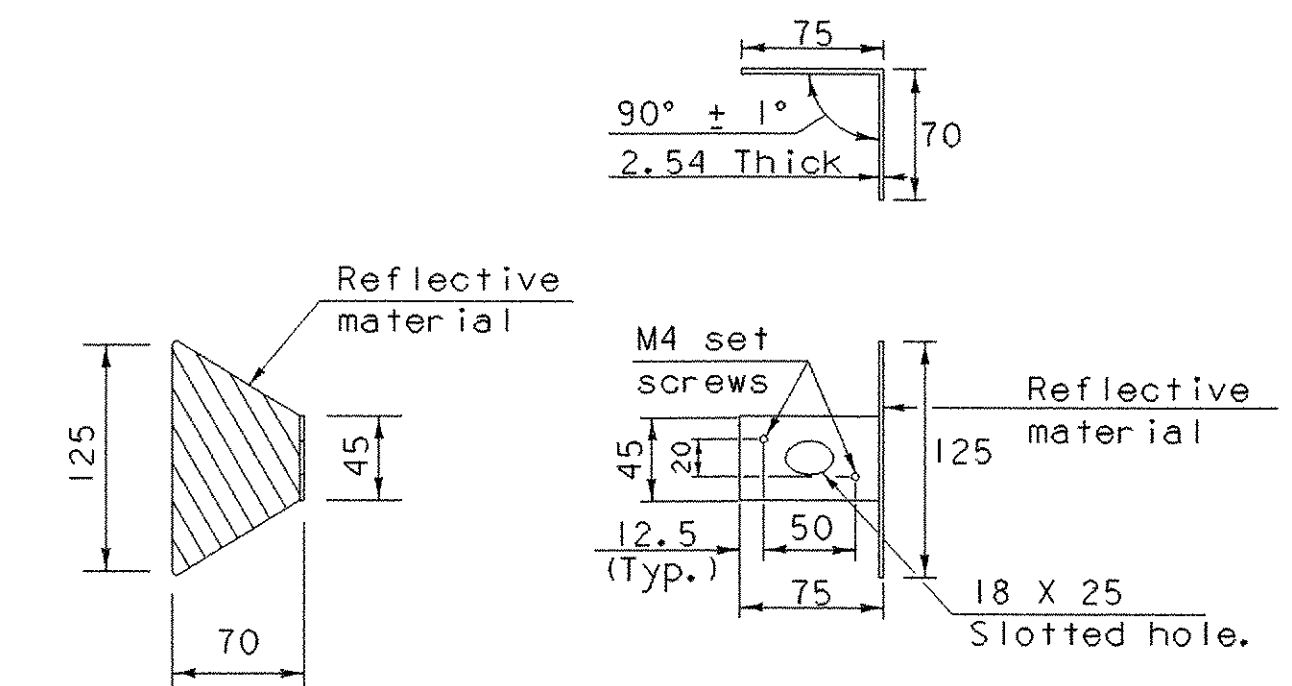

DELINEATION DEVICE DETAILS

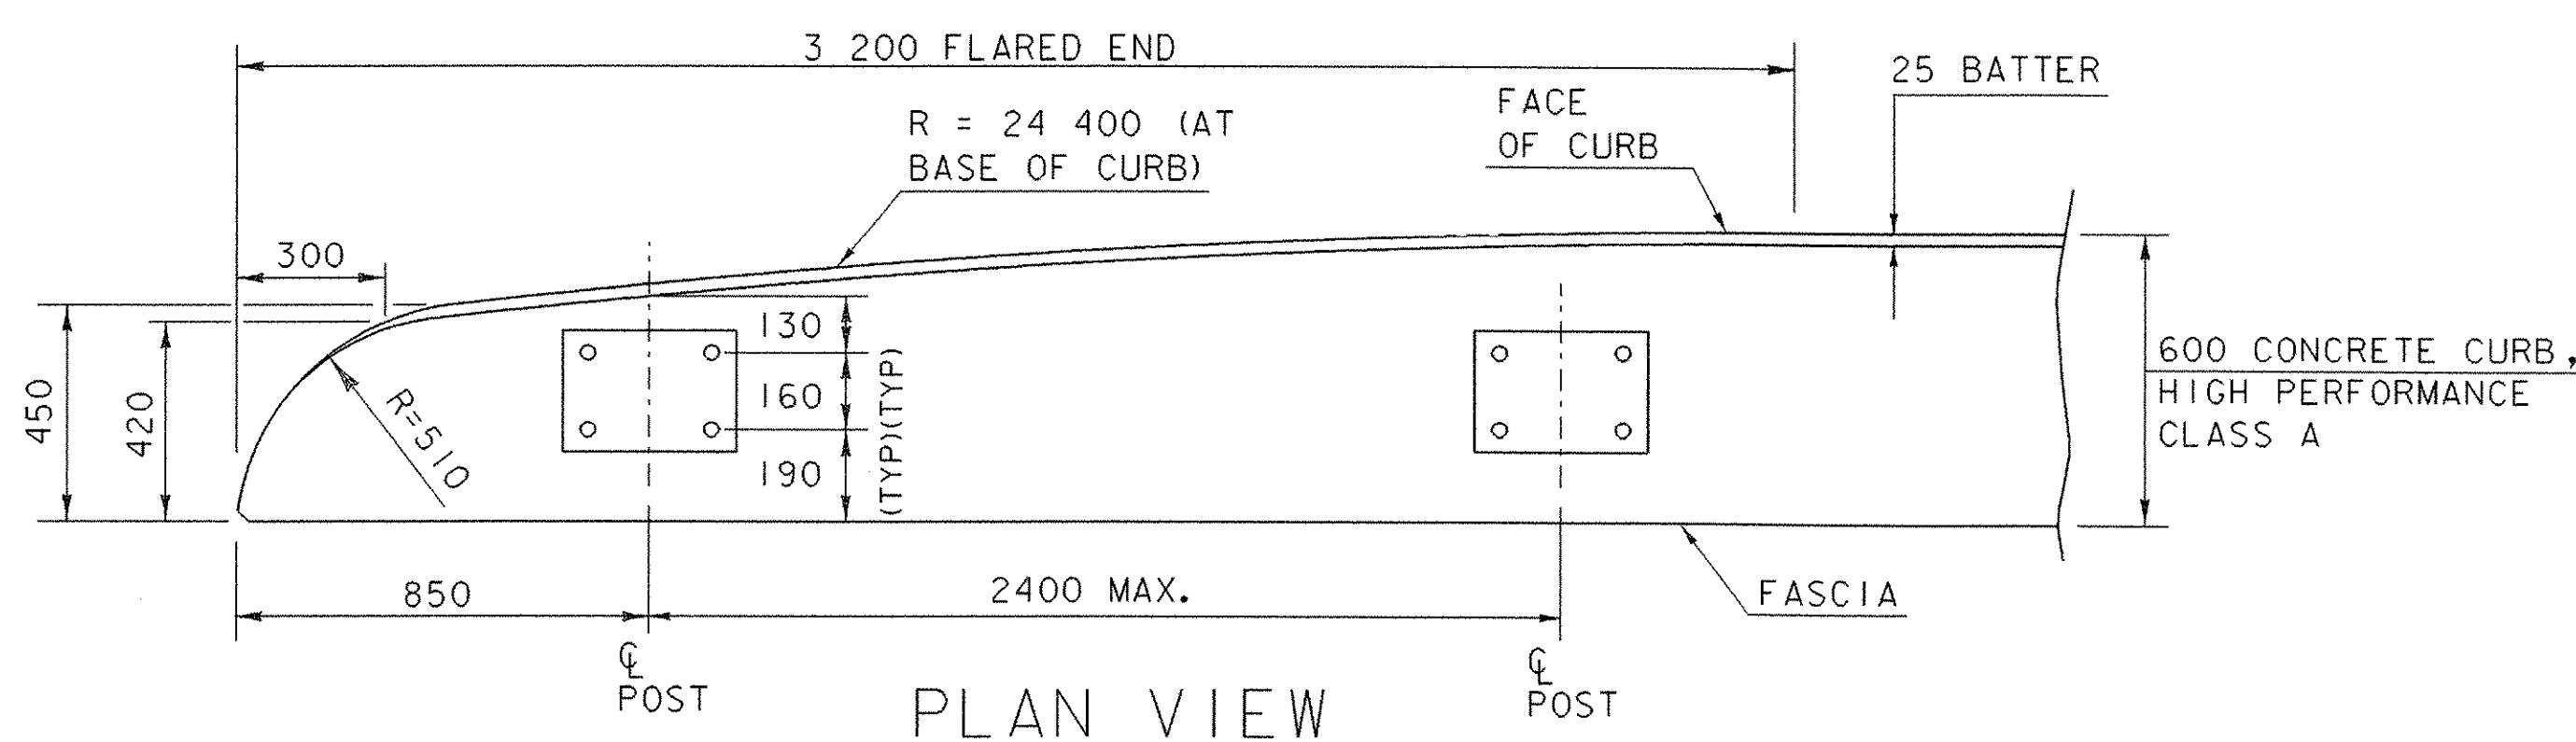


PLAN VIEW

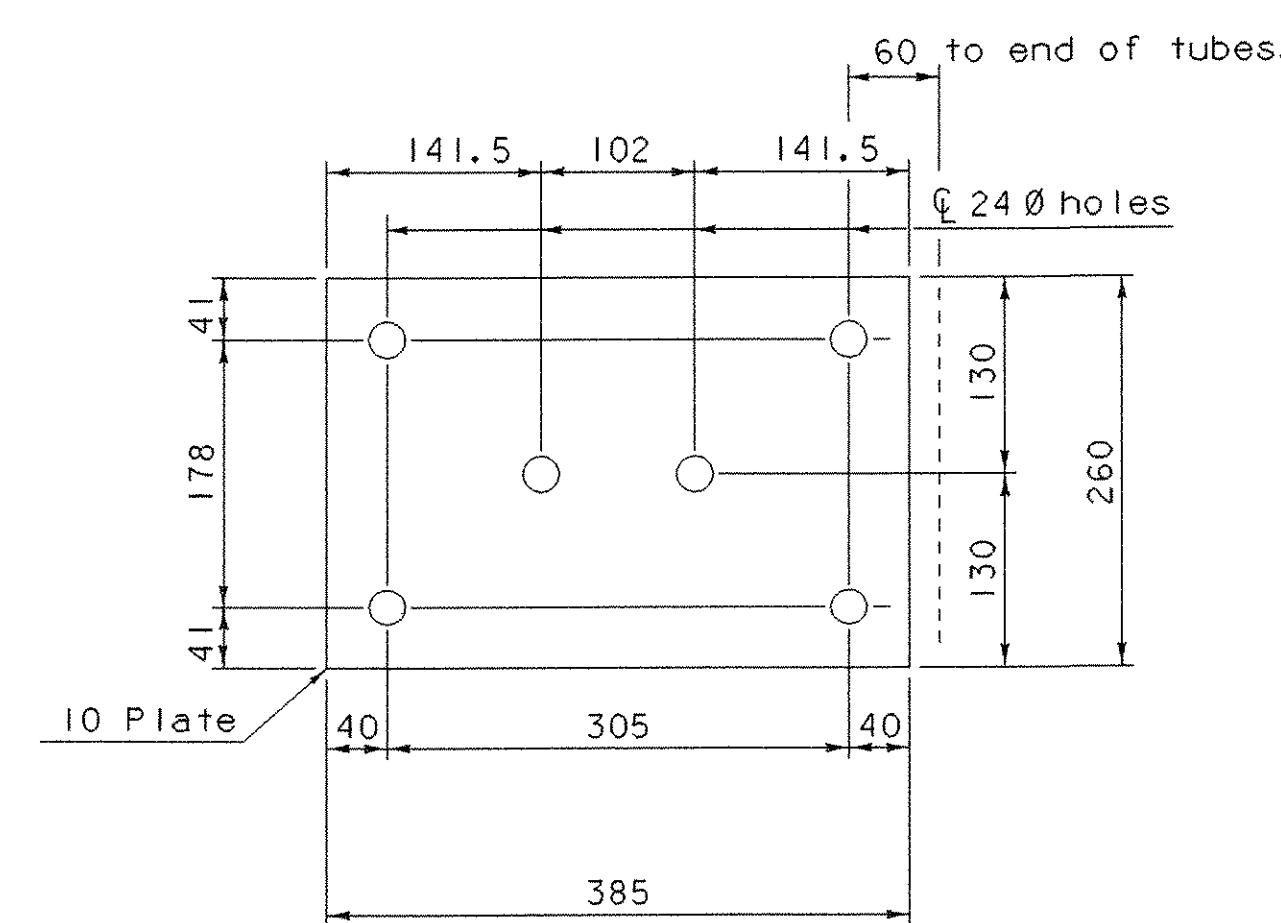



BACK - UP PLATE

SHEET NAME: NETC BRIDGE RAILING DETAILS (2)		
PROJECT NAME: LEICESTER	HIGHWAY NO.: TH 1	
PROJECT NUMBER: BRF 0160(3)S	BRIDGE NO.: 6	
	OVER: OTTER CREEK	
FILE NAME: 95j288\structures\sj288ra1.dgn	PLOT DATE: 17-AUG-2005	
PROJECT MANAGER: R. R. WHITCOMB	DRAWN BY: C. ROY	
DESIGNED BY: C. CARLSON	IPARM NAME: sj288brd2.1	
BRIDGE SHEET NUMBER:	SHEET 57 OF 90	


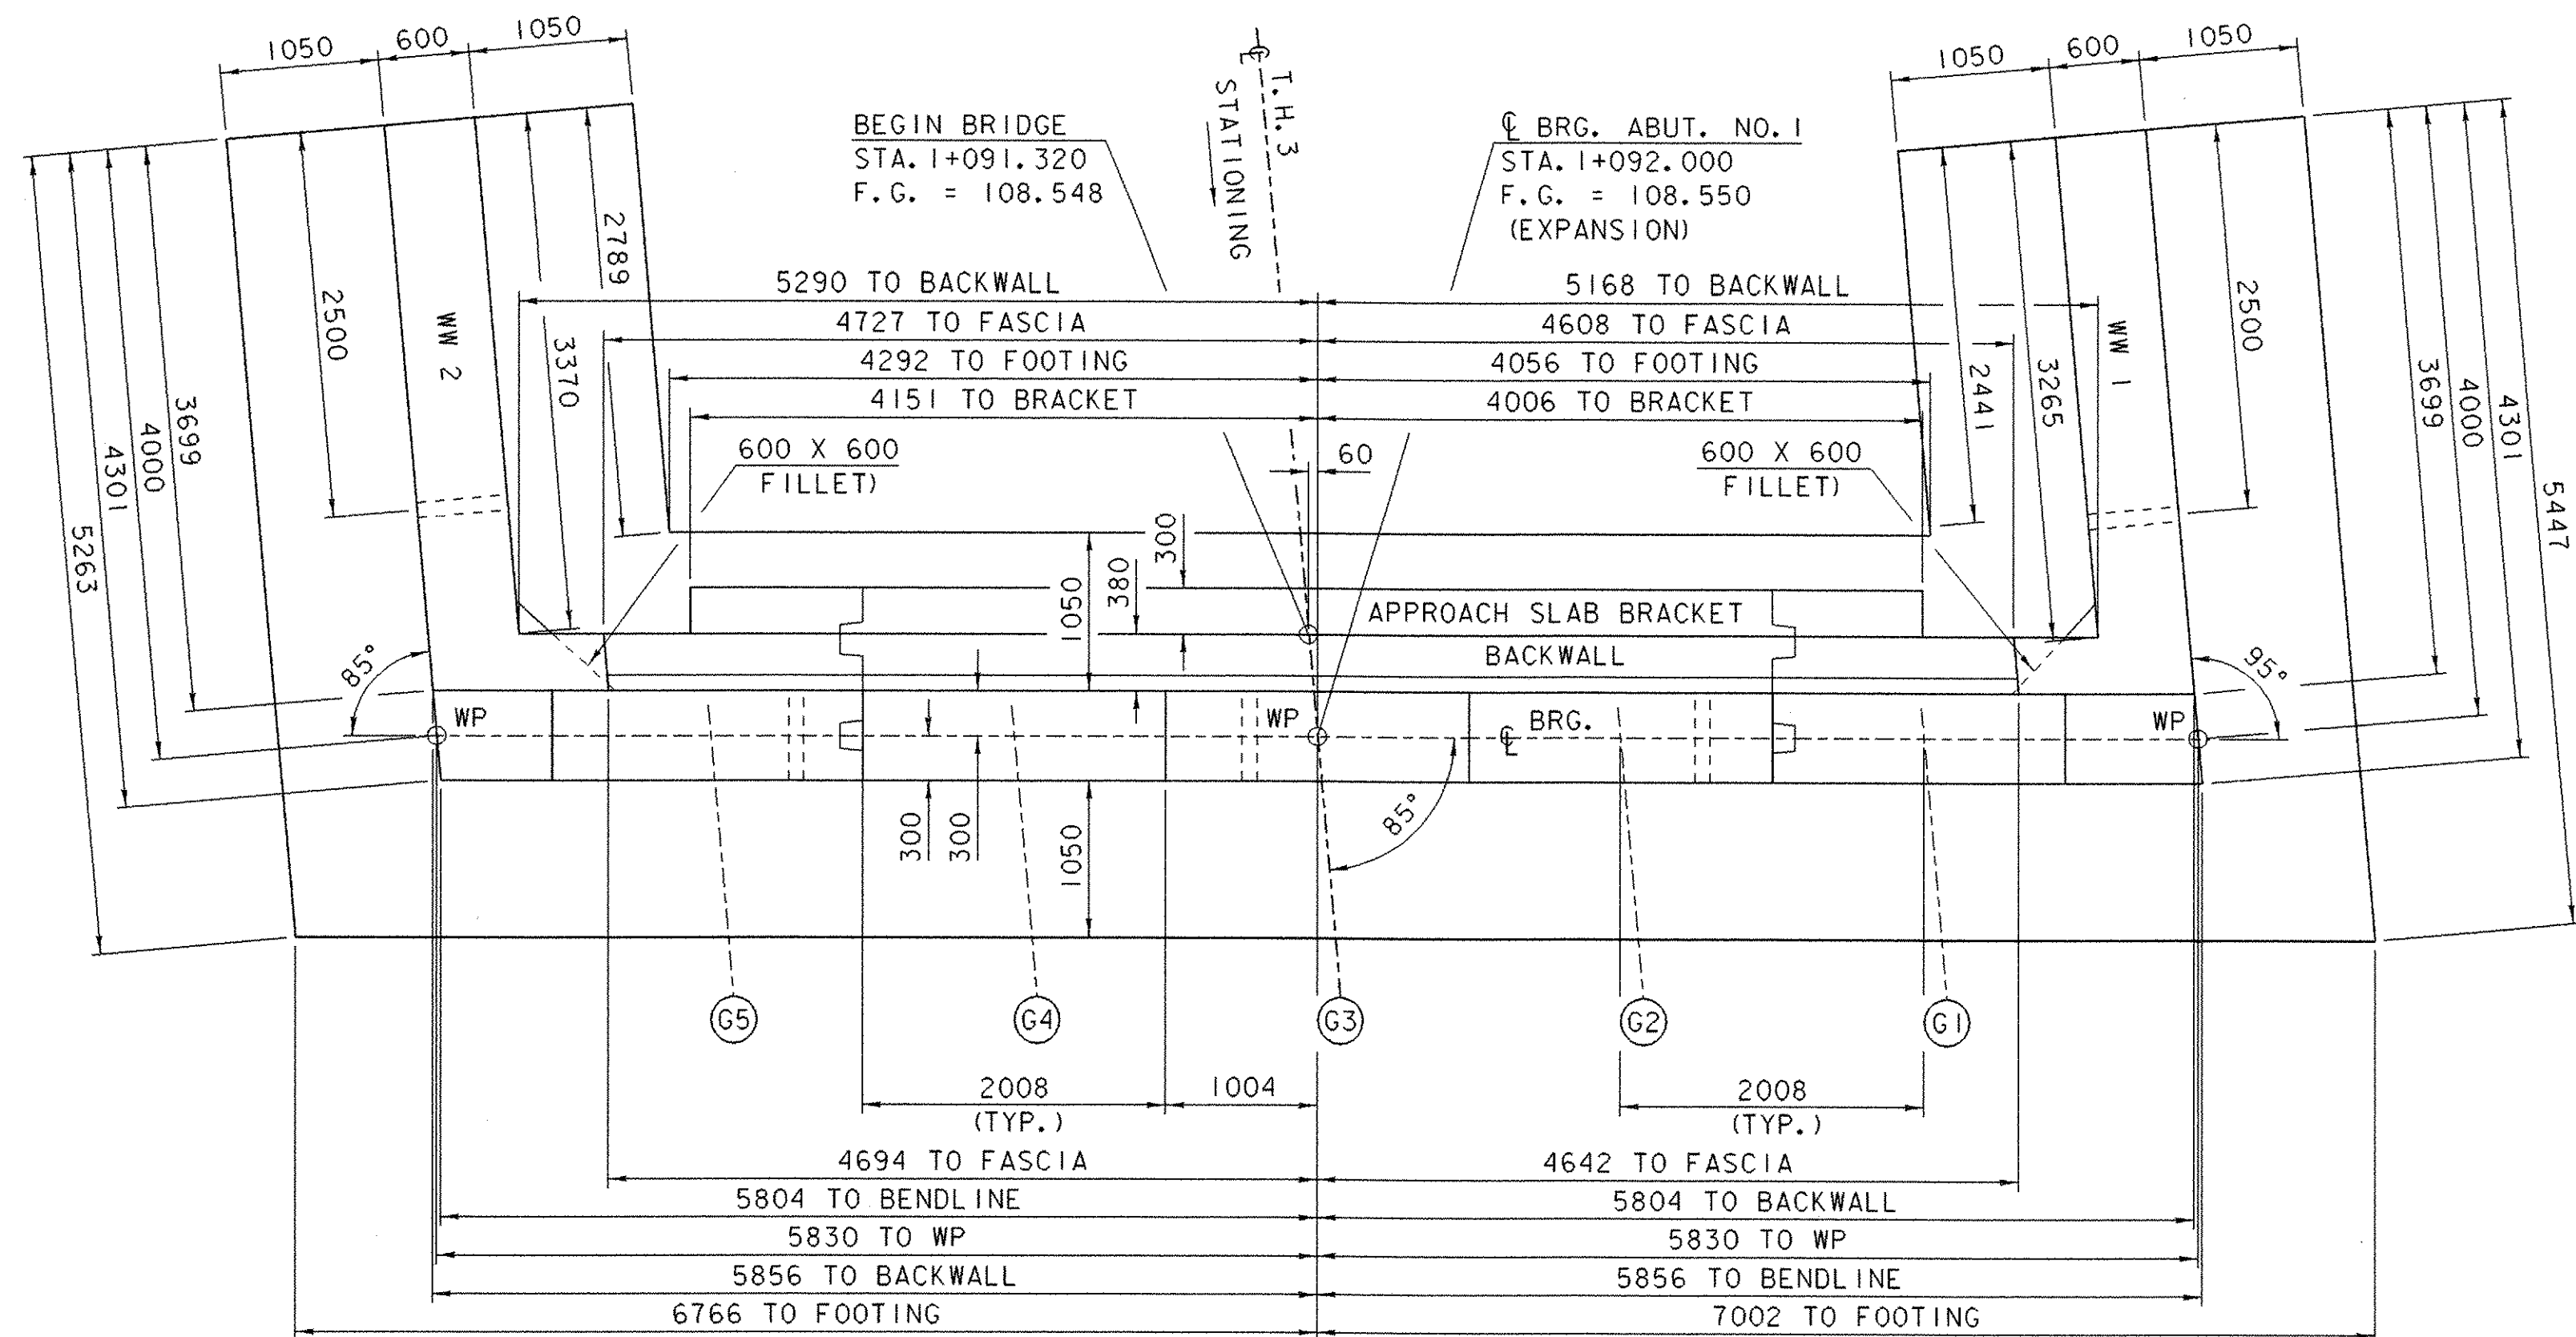


ABUTMENT NO. 1 PLAN


FLOW →

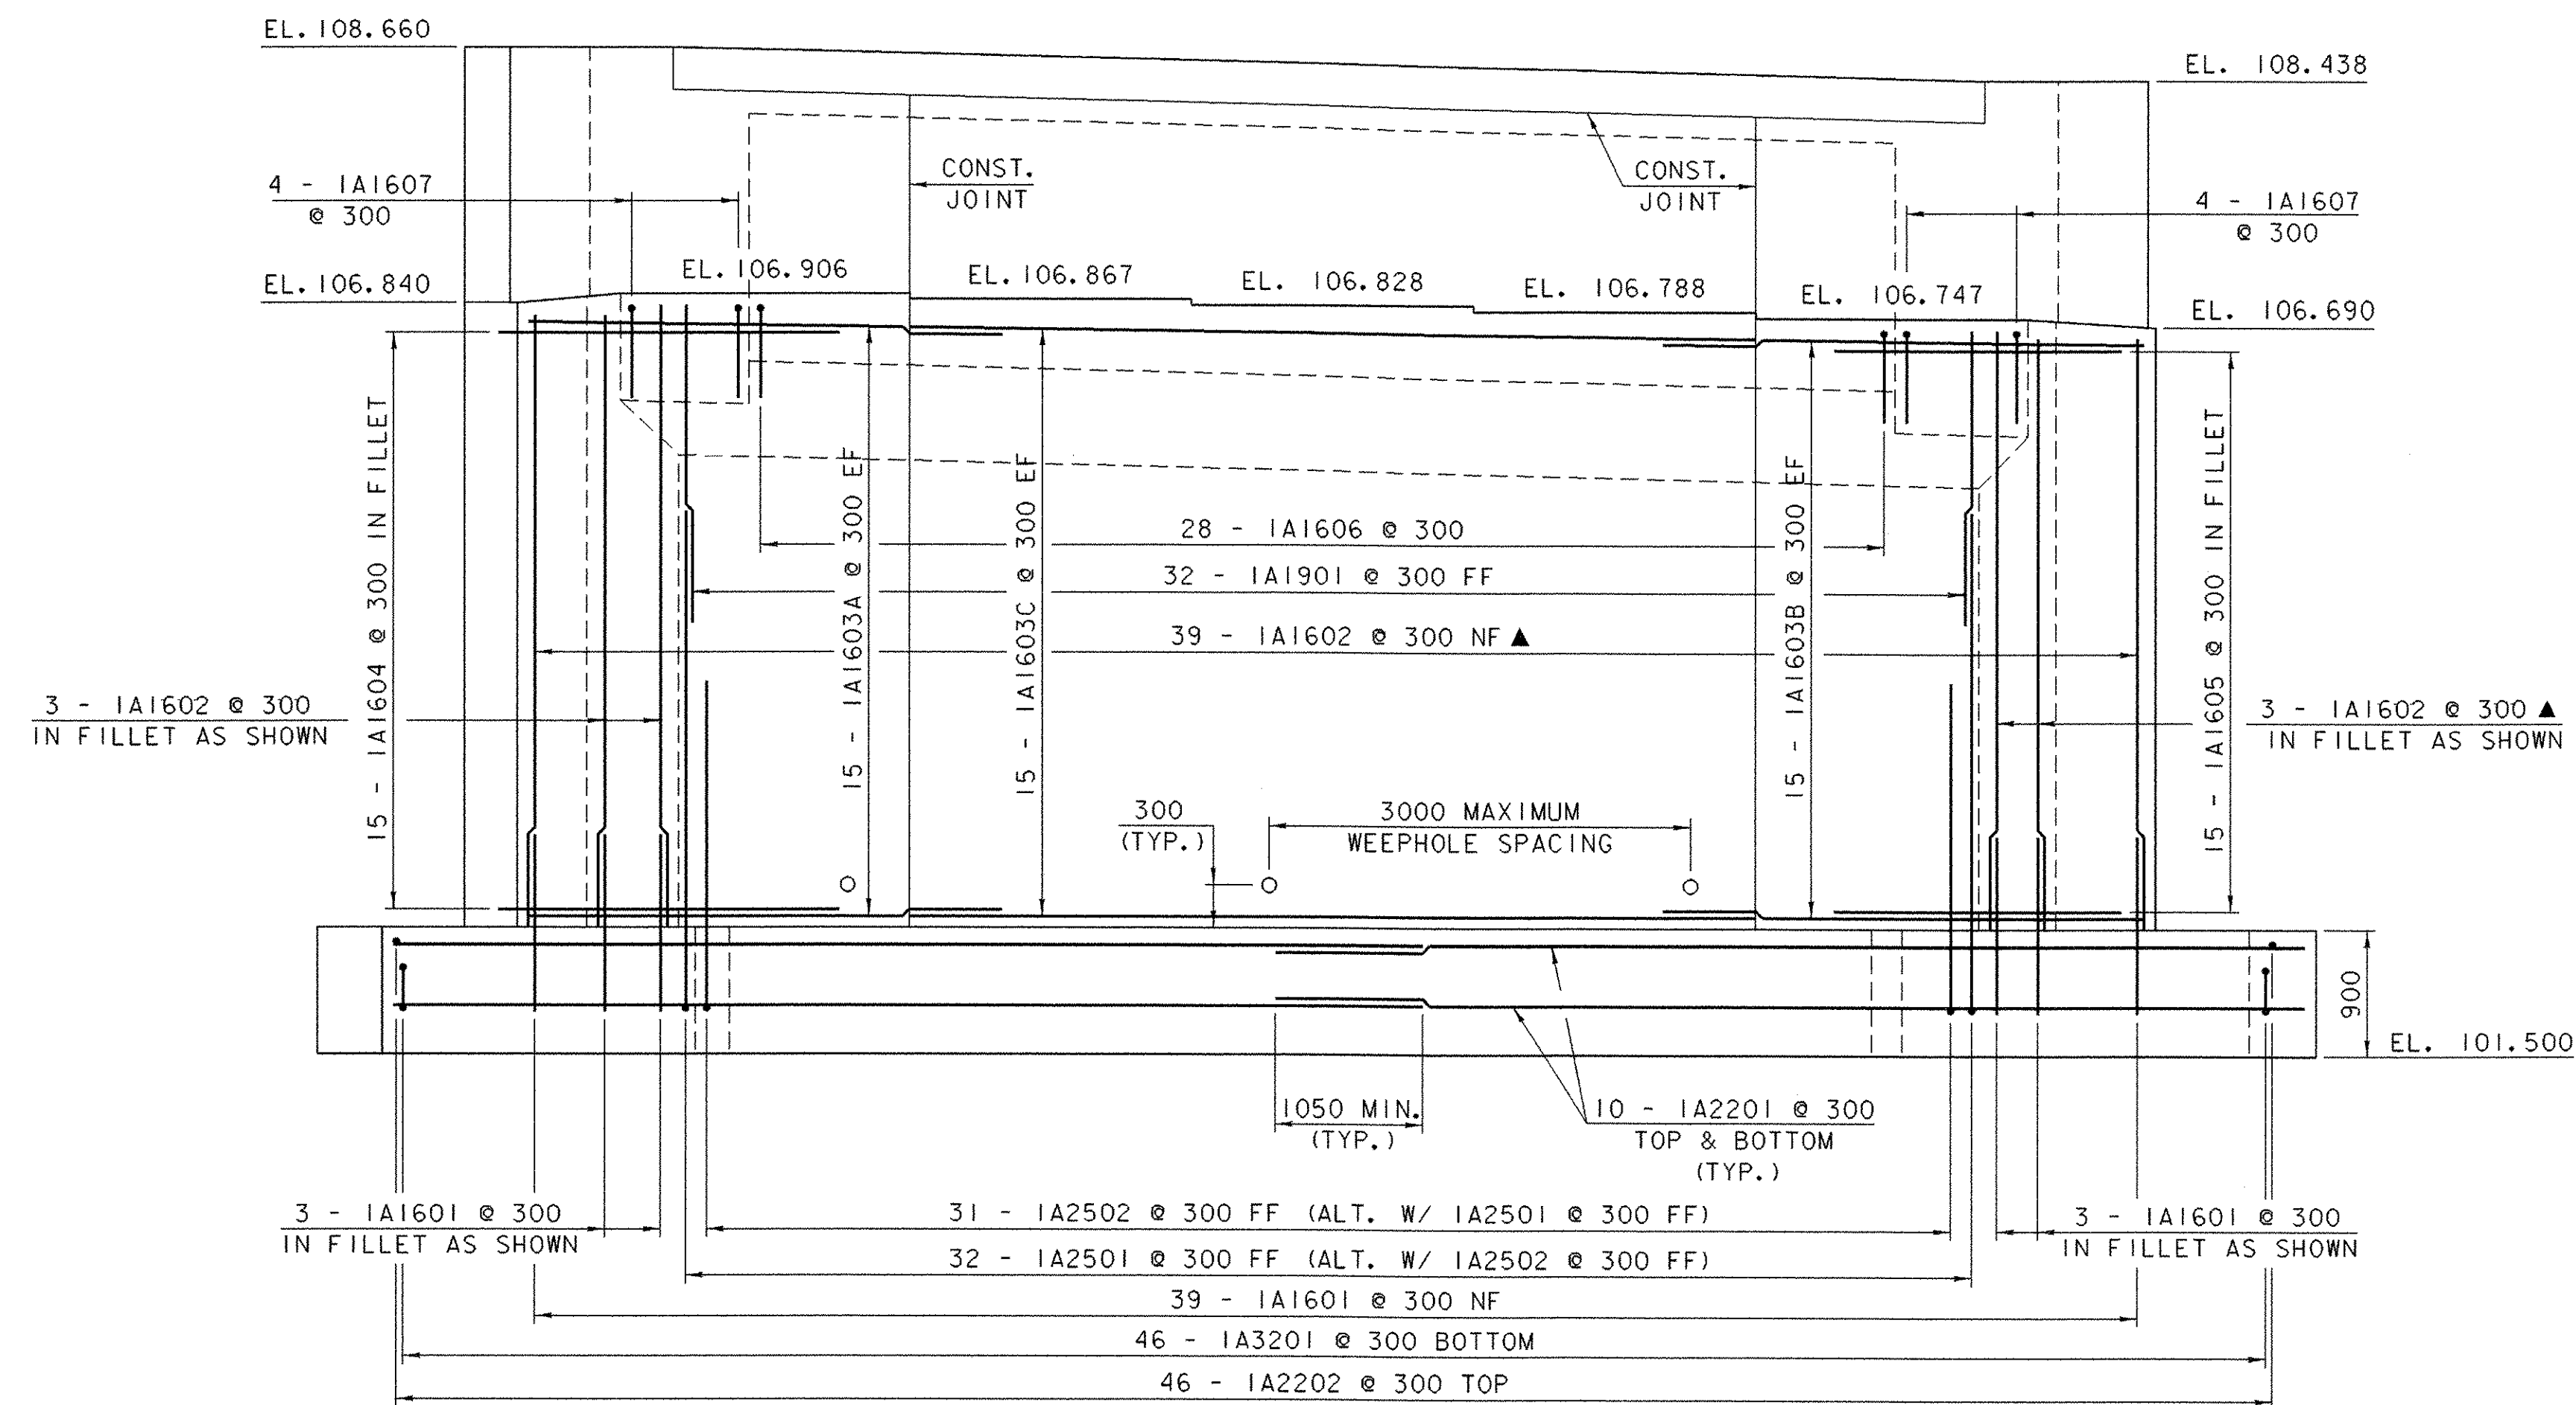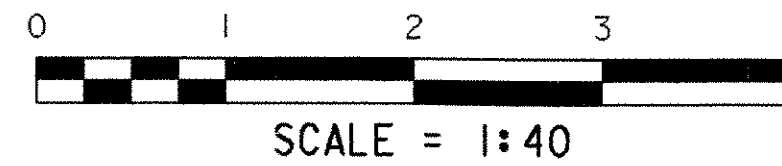

ABUTMENT NO. 1 ELEVATION

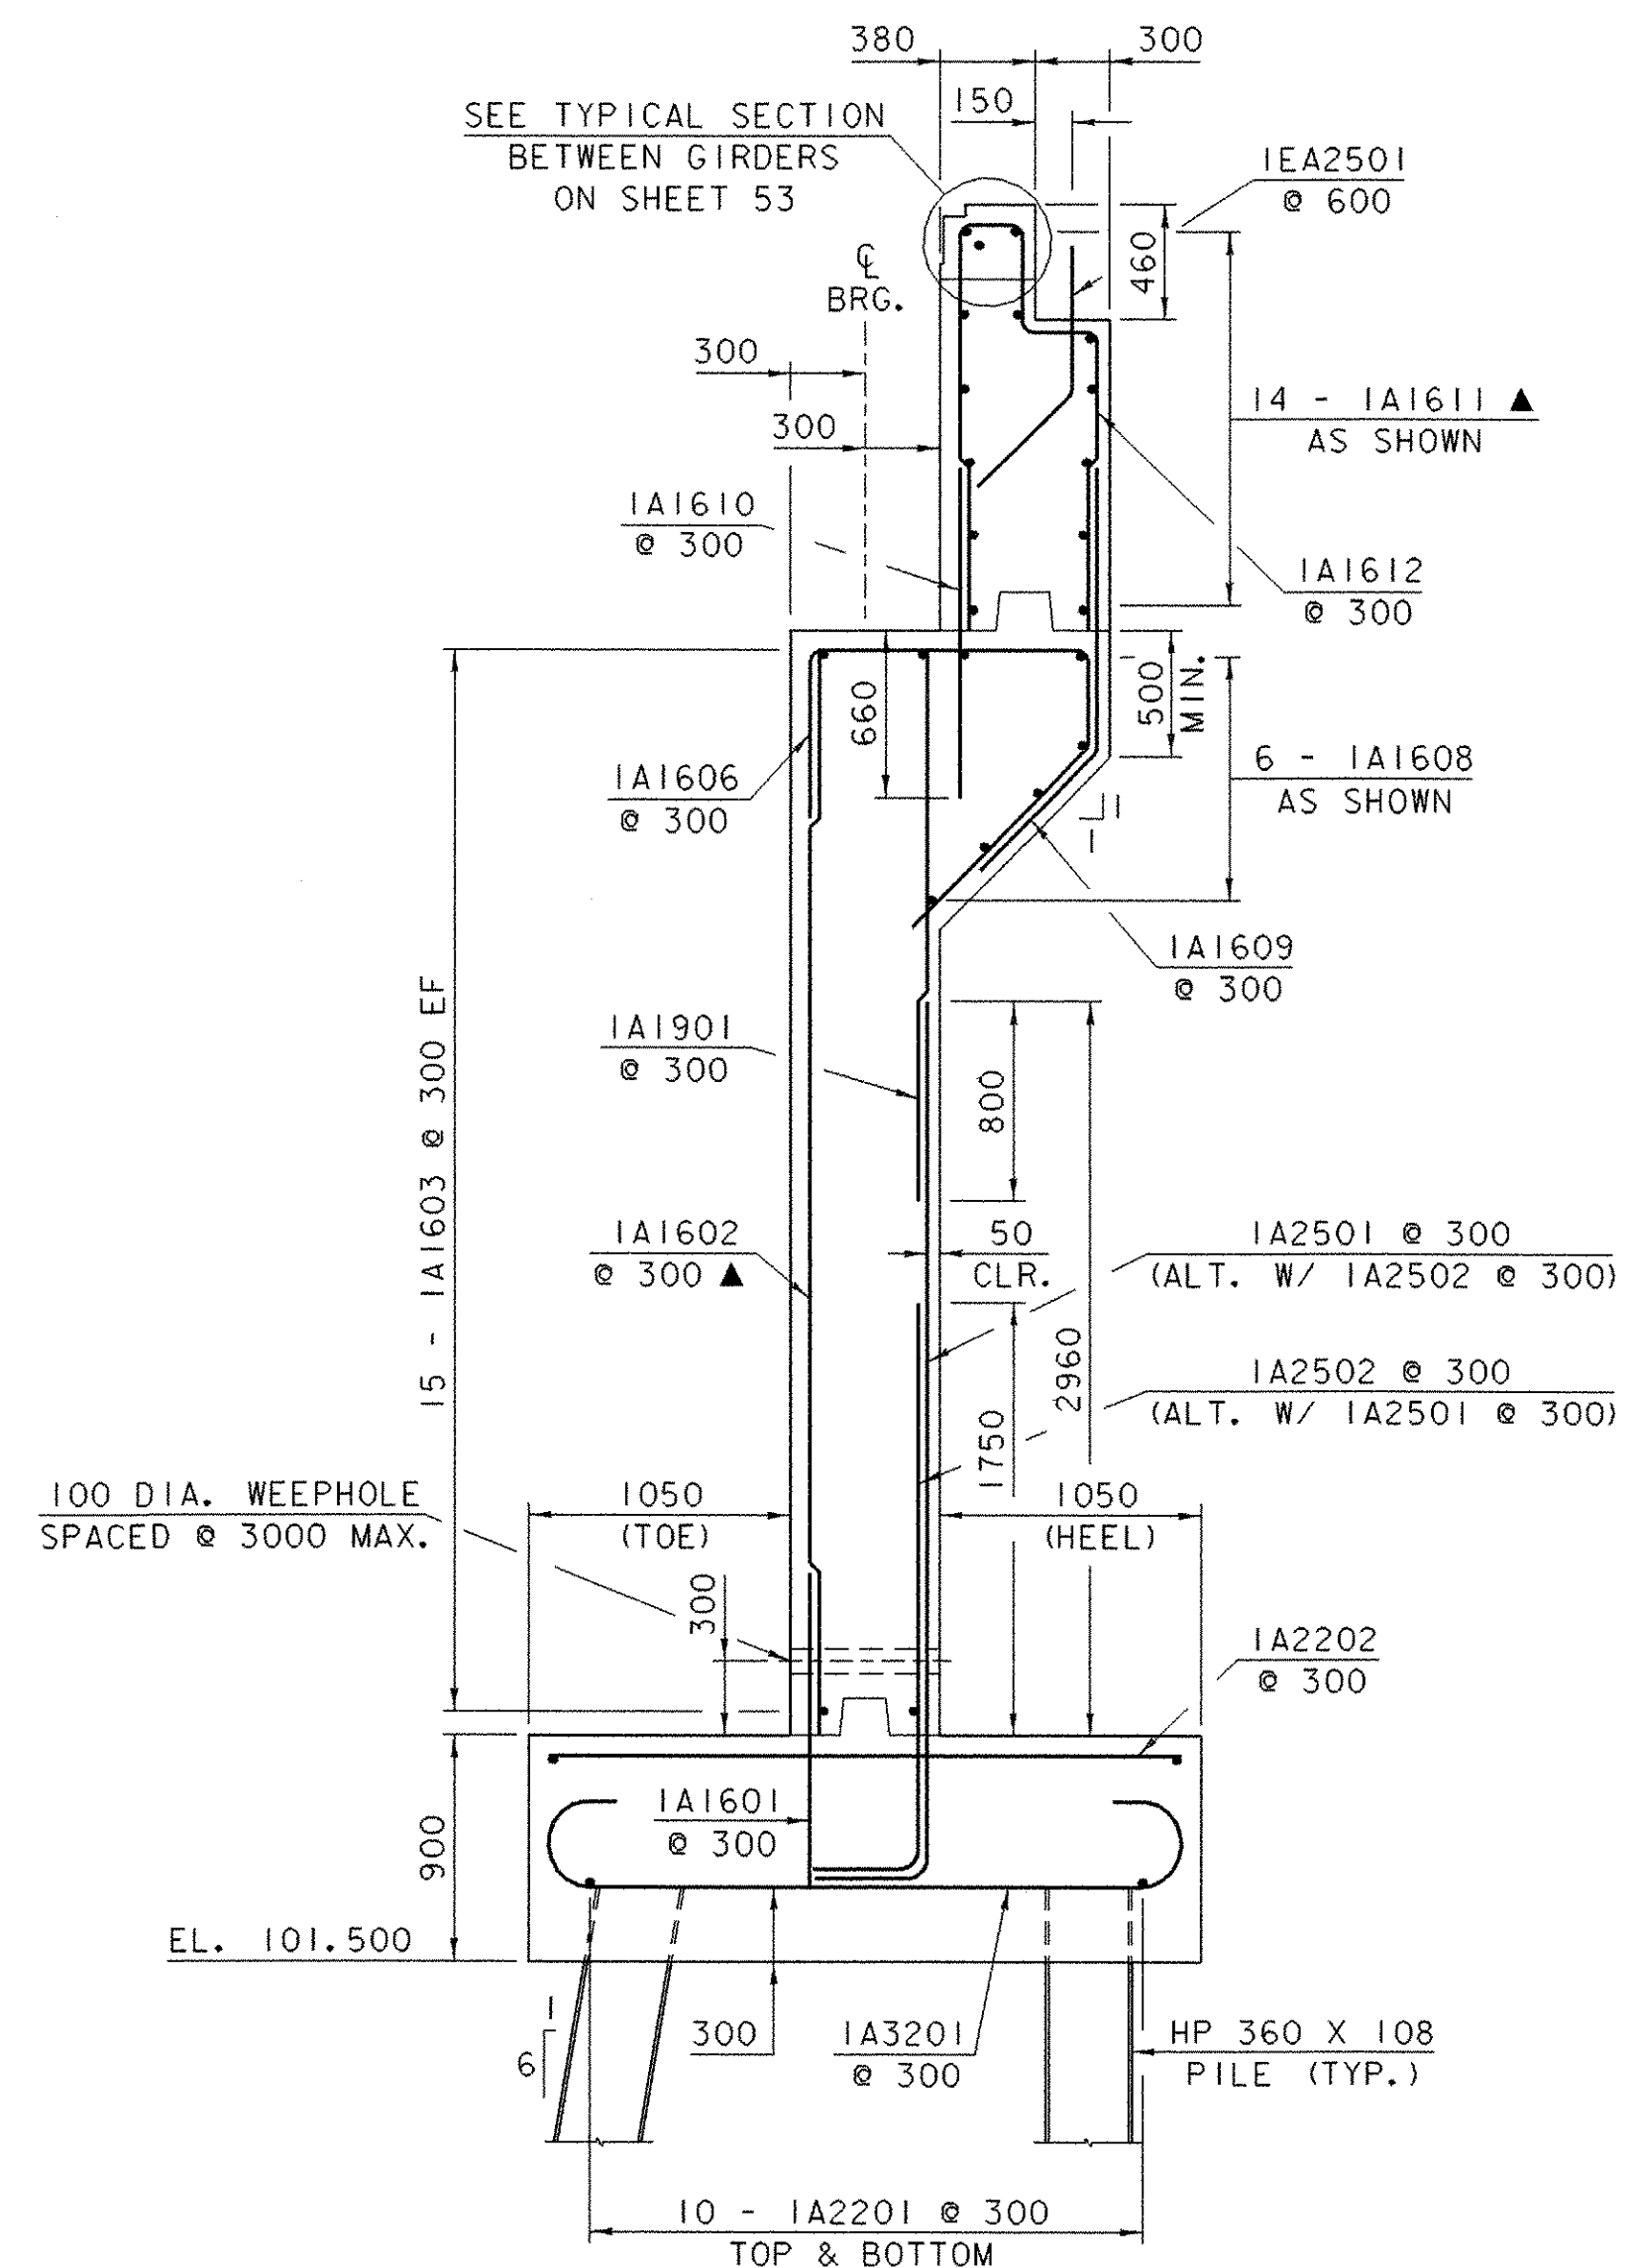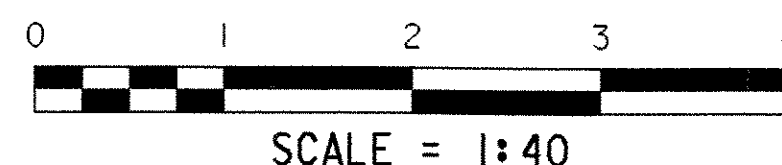


ABUTMENT NO. 1 TYPICAL


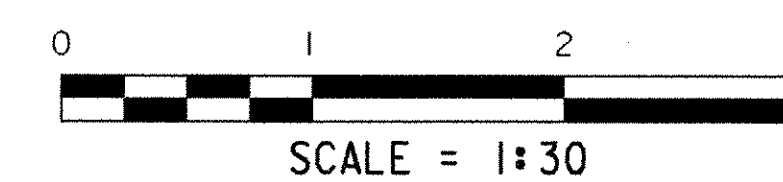


NOTE:
 NF = NEAR FACE
 FF = FAR FACE
 EF = EACH FACE
 ▲ = CUT TO FIT IN FIELD
 80 CLR. UNLESS OTHERWISE NOTED
 660 BAR LAP UNLESS OTHERWISE NOTED



SHEET NAME: ABUTMENT NO. 1 DETAILS	
PROJECT NAME: LEICESTER	HIGHWAY NO.: TH 1
PROJECT NUMBER: BRF 0160(3)S	BRIDGE NO.: 6
	OVER: OTTER CREEK
FILE NAME: 95j288\Structures\sj288sub.dgn	PLOT DATE: 17-AUG-2005
PROJECT MANAGER: R. R. WHITCOMB	DRAWN BY: G. ROY
DESIGNED BY: C. CARLSON	IPARM NAME: sj288abl1
BRIDGE SHEET NUMBER:	SHEET 58 OF 90

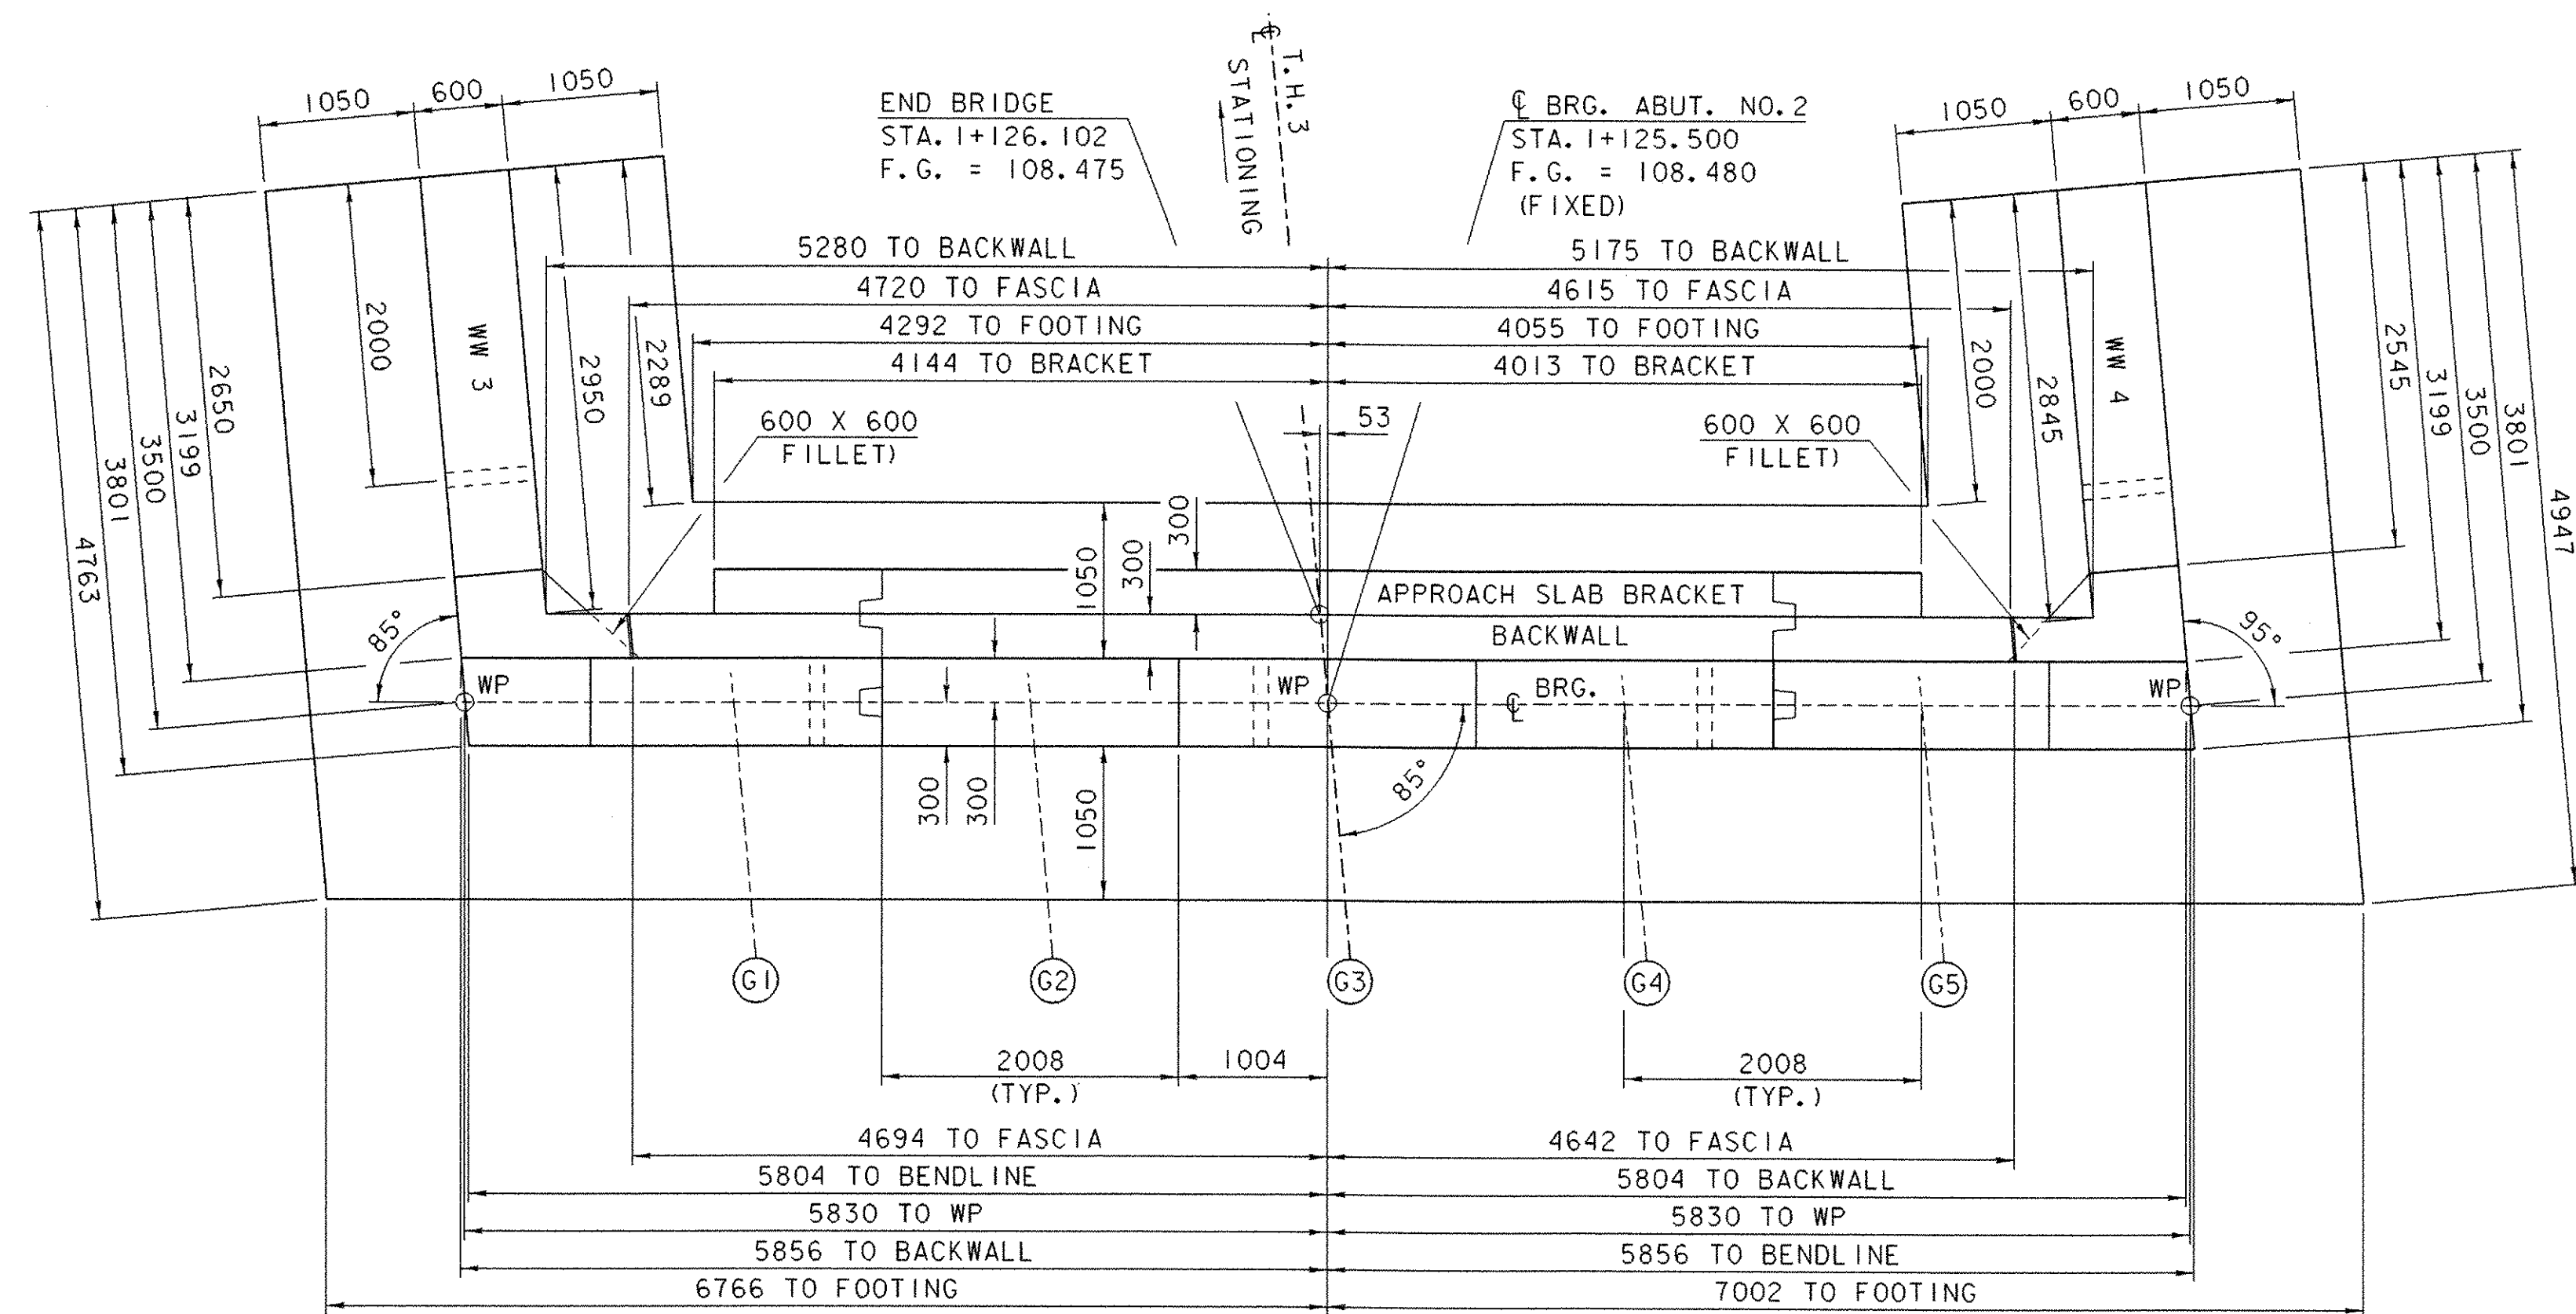


ABUTMENT NO. 2 PLAN

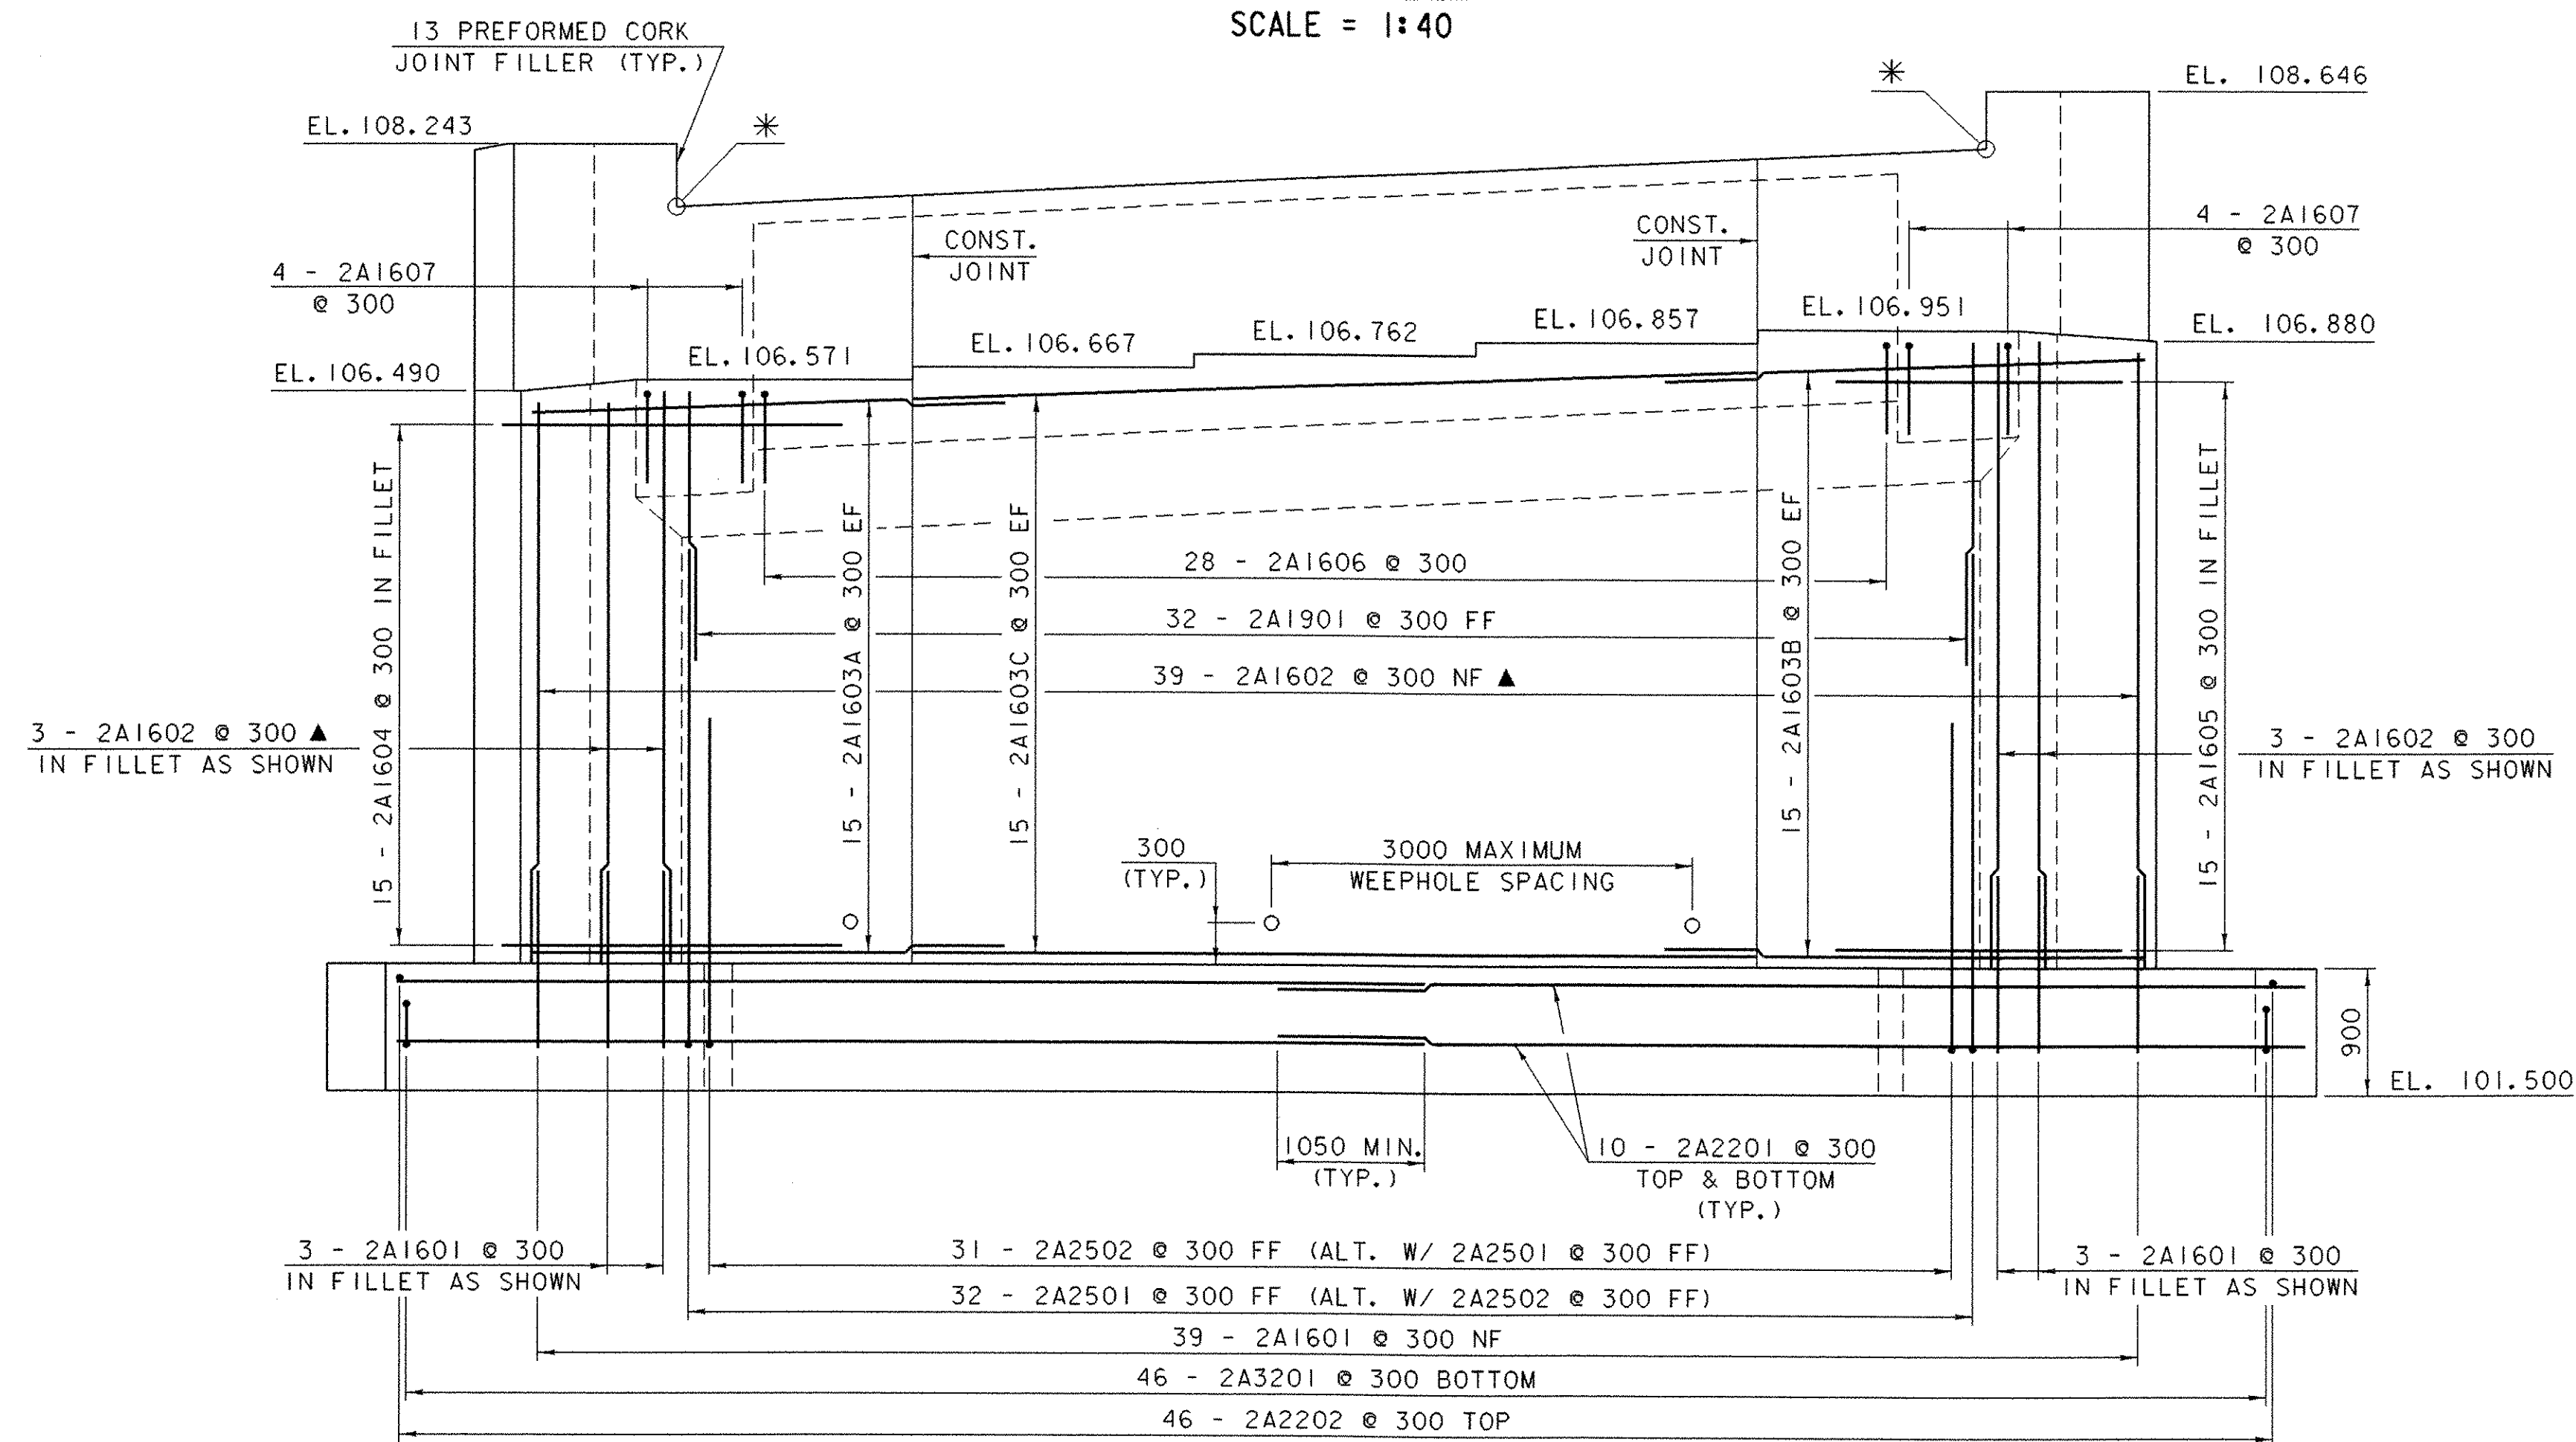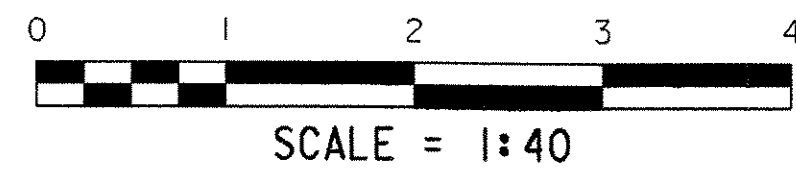

ABUTMENT NO. 2 ELEVATION

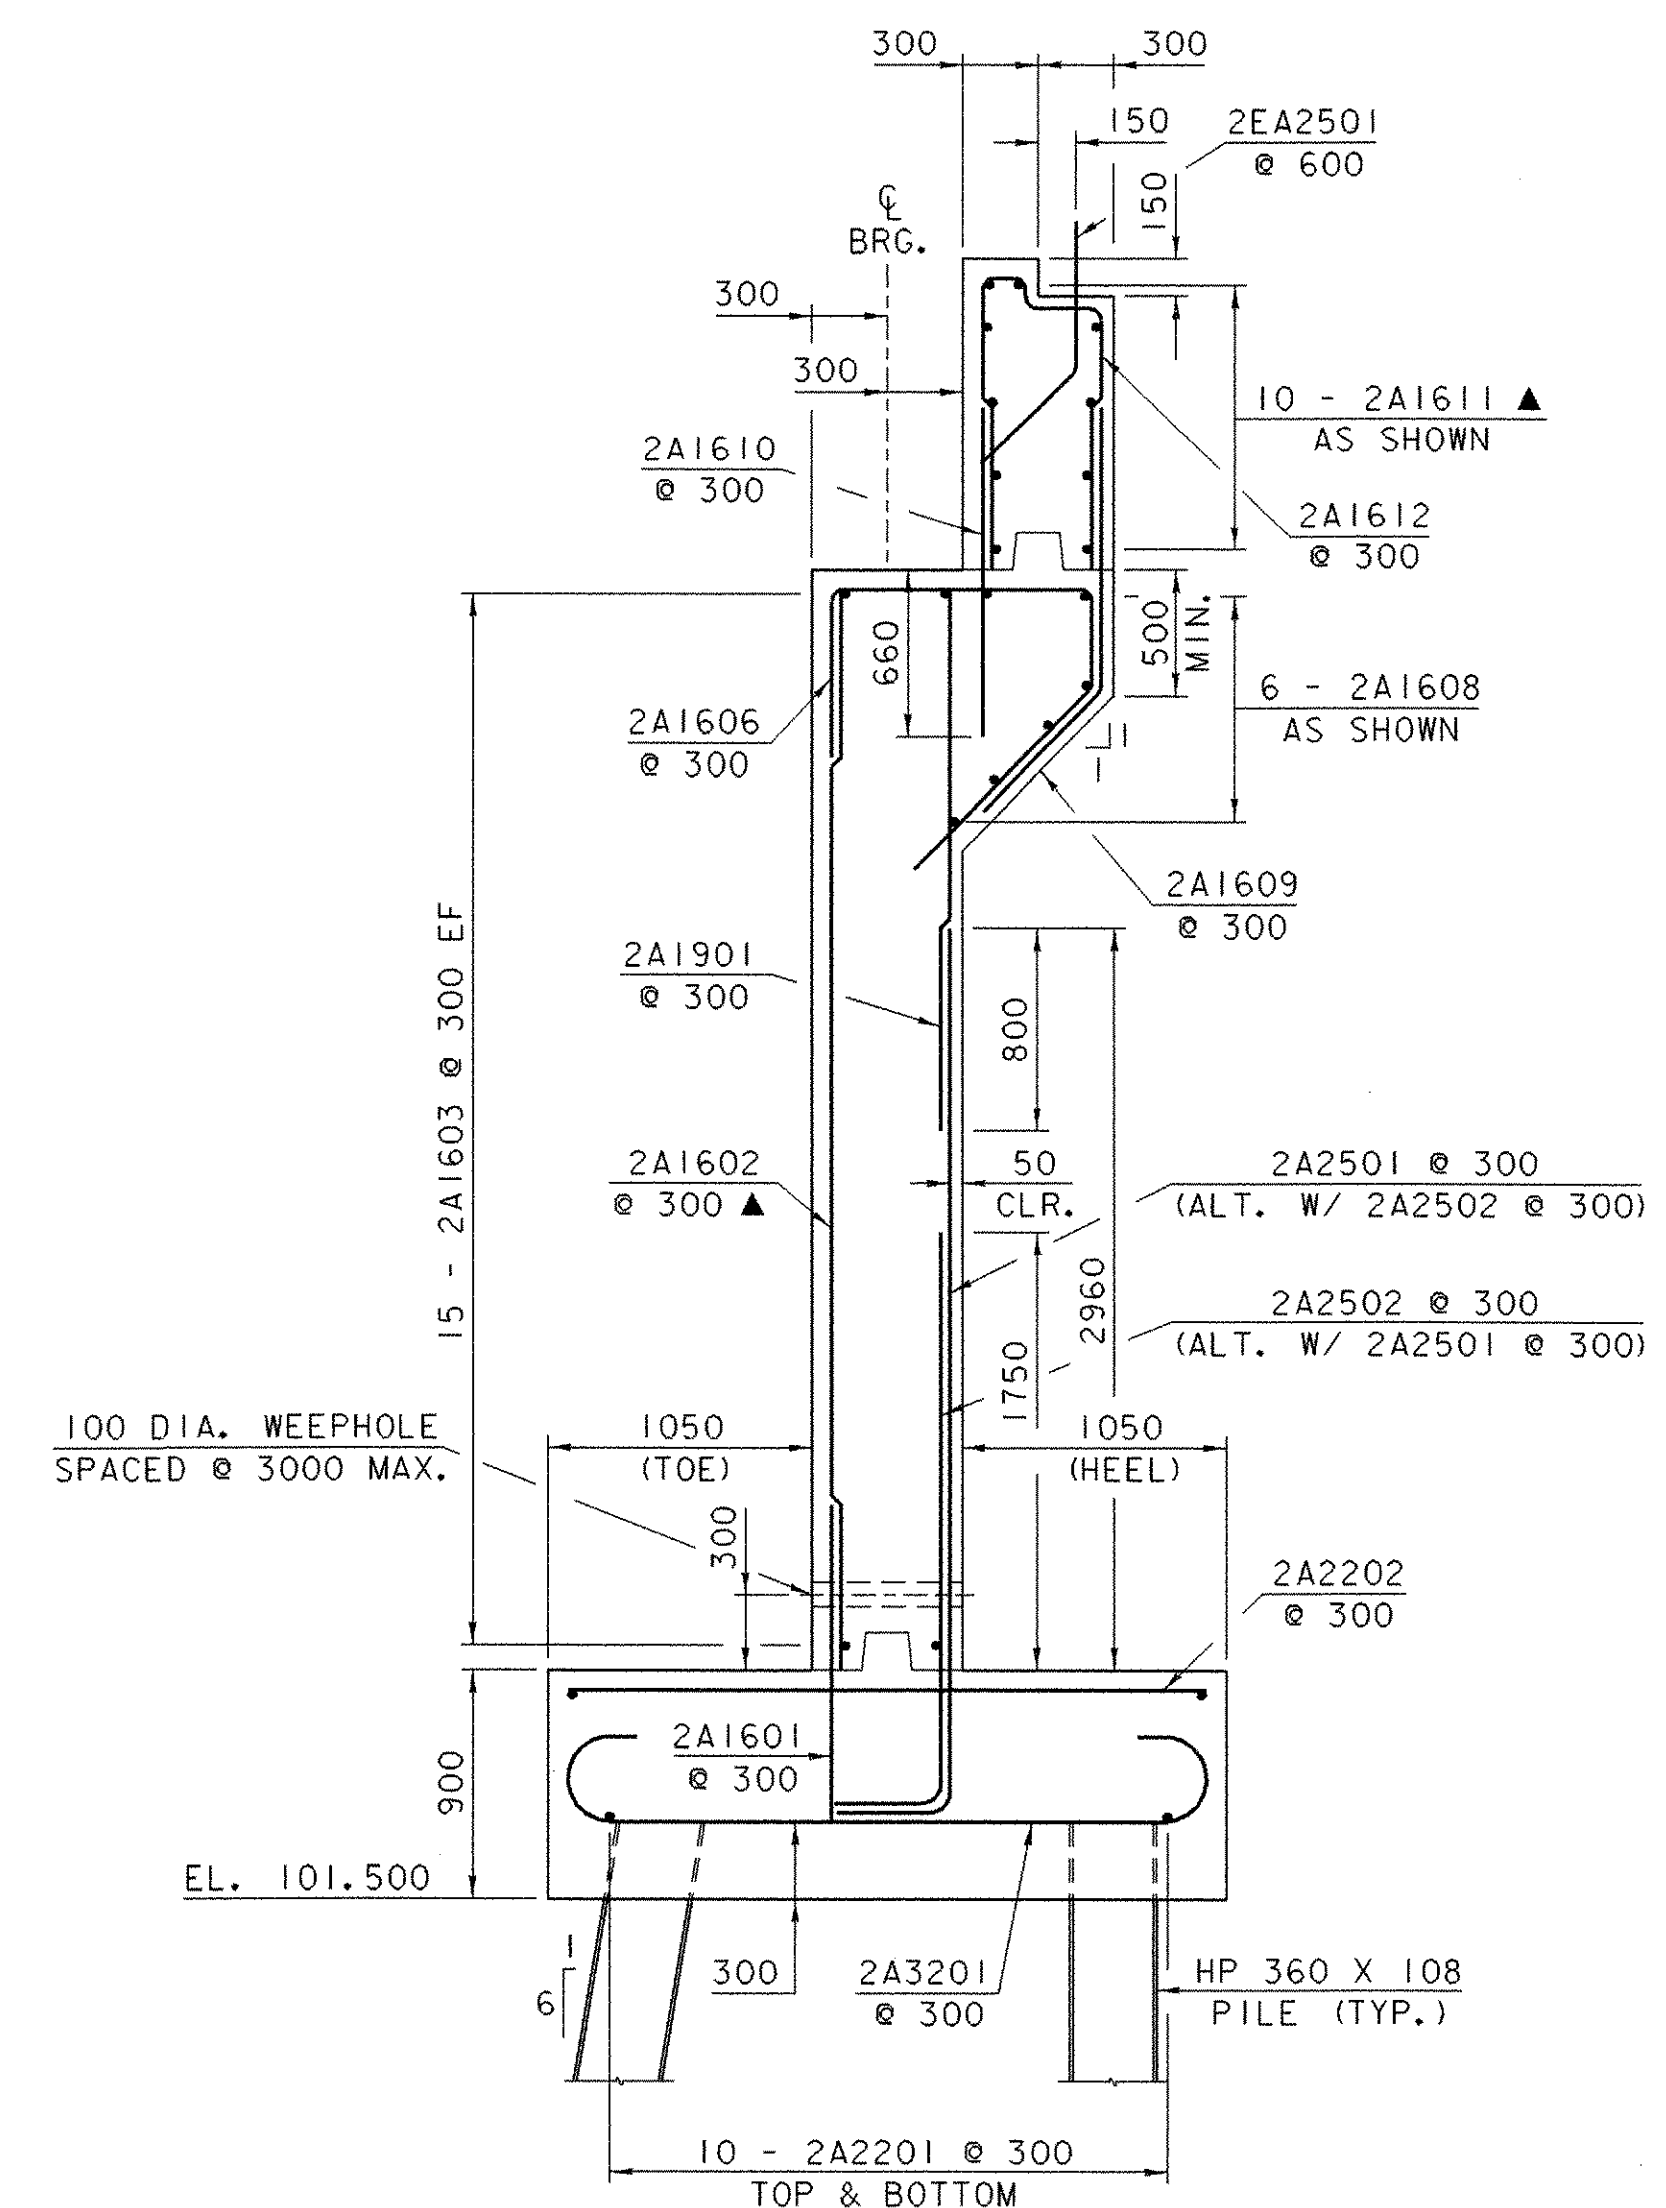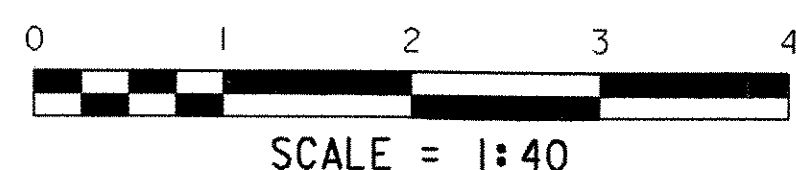


ABUTMENT NO. 2 TYPICAL

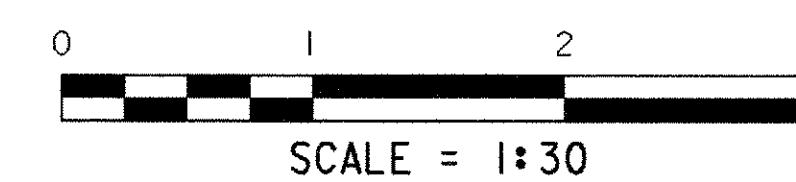



* ELEVATIONS AT BACKFACE OF BACKWALL TO BE DETERMINED IN THE FIELD AFTER STRUCTURAL STEEL IS SET.

NOTE:
 NF = NEAR FACE
 FF = FAR FACE
 EF = EACH FACE
 ▲ = CUT TO FIT IN FIELD
 80 CLR. UNLESS OTHERWISE NOTED
 660 BAR LAP UNLESS OTHERWISE NOTED



SHEET NAME: ABUTMENT NO. 2 DETAILS		
PROJECT NAME: LEICESTER	HIGHWAY NO.: TH 1	
PROJECT NUMBER: BRF 0160(3)S	BRIDGE NO.: 6	
	OVER: OTTER CREEK	
FILE NAME: 95J288\Structures\sj288sub.dgn	PLOT DATE: 17-AUG-2005	
PROJECT MANAGER: R. R. WHITCOMB	DRAWN BY: G. ROY	
DESIGNED BY: C. CARLSON	IPARM NAME: sj288ab2.1	
BRIDGE SHEET NUMBER:	SHEET 59 OF 90	

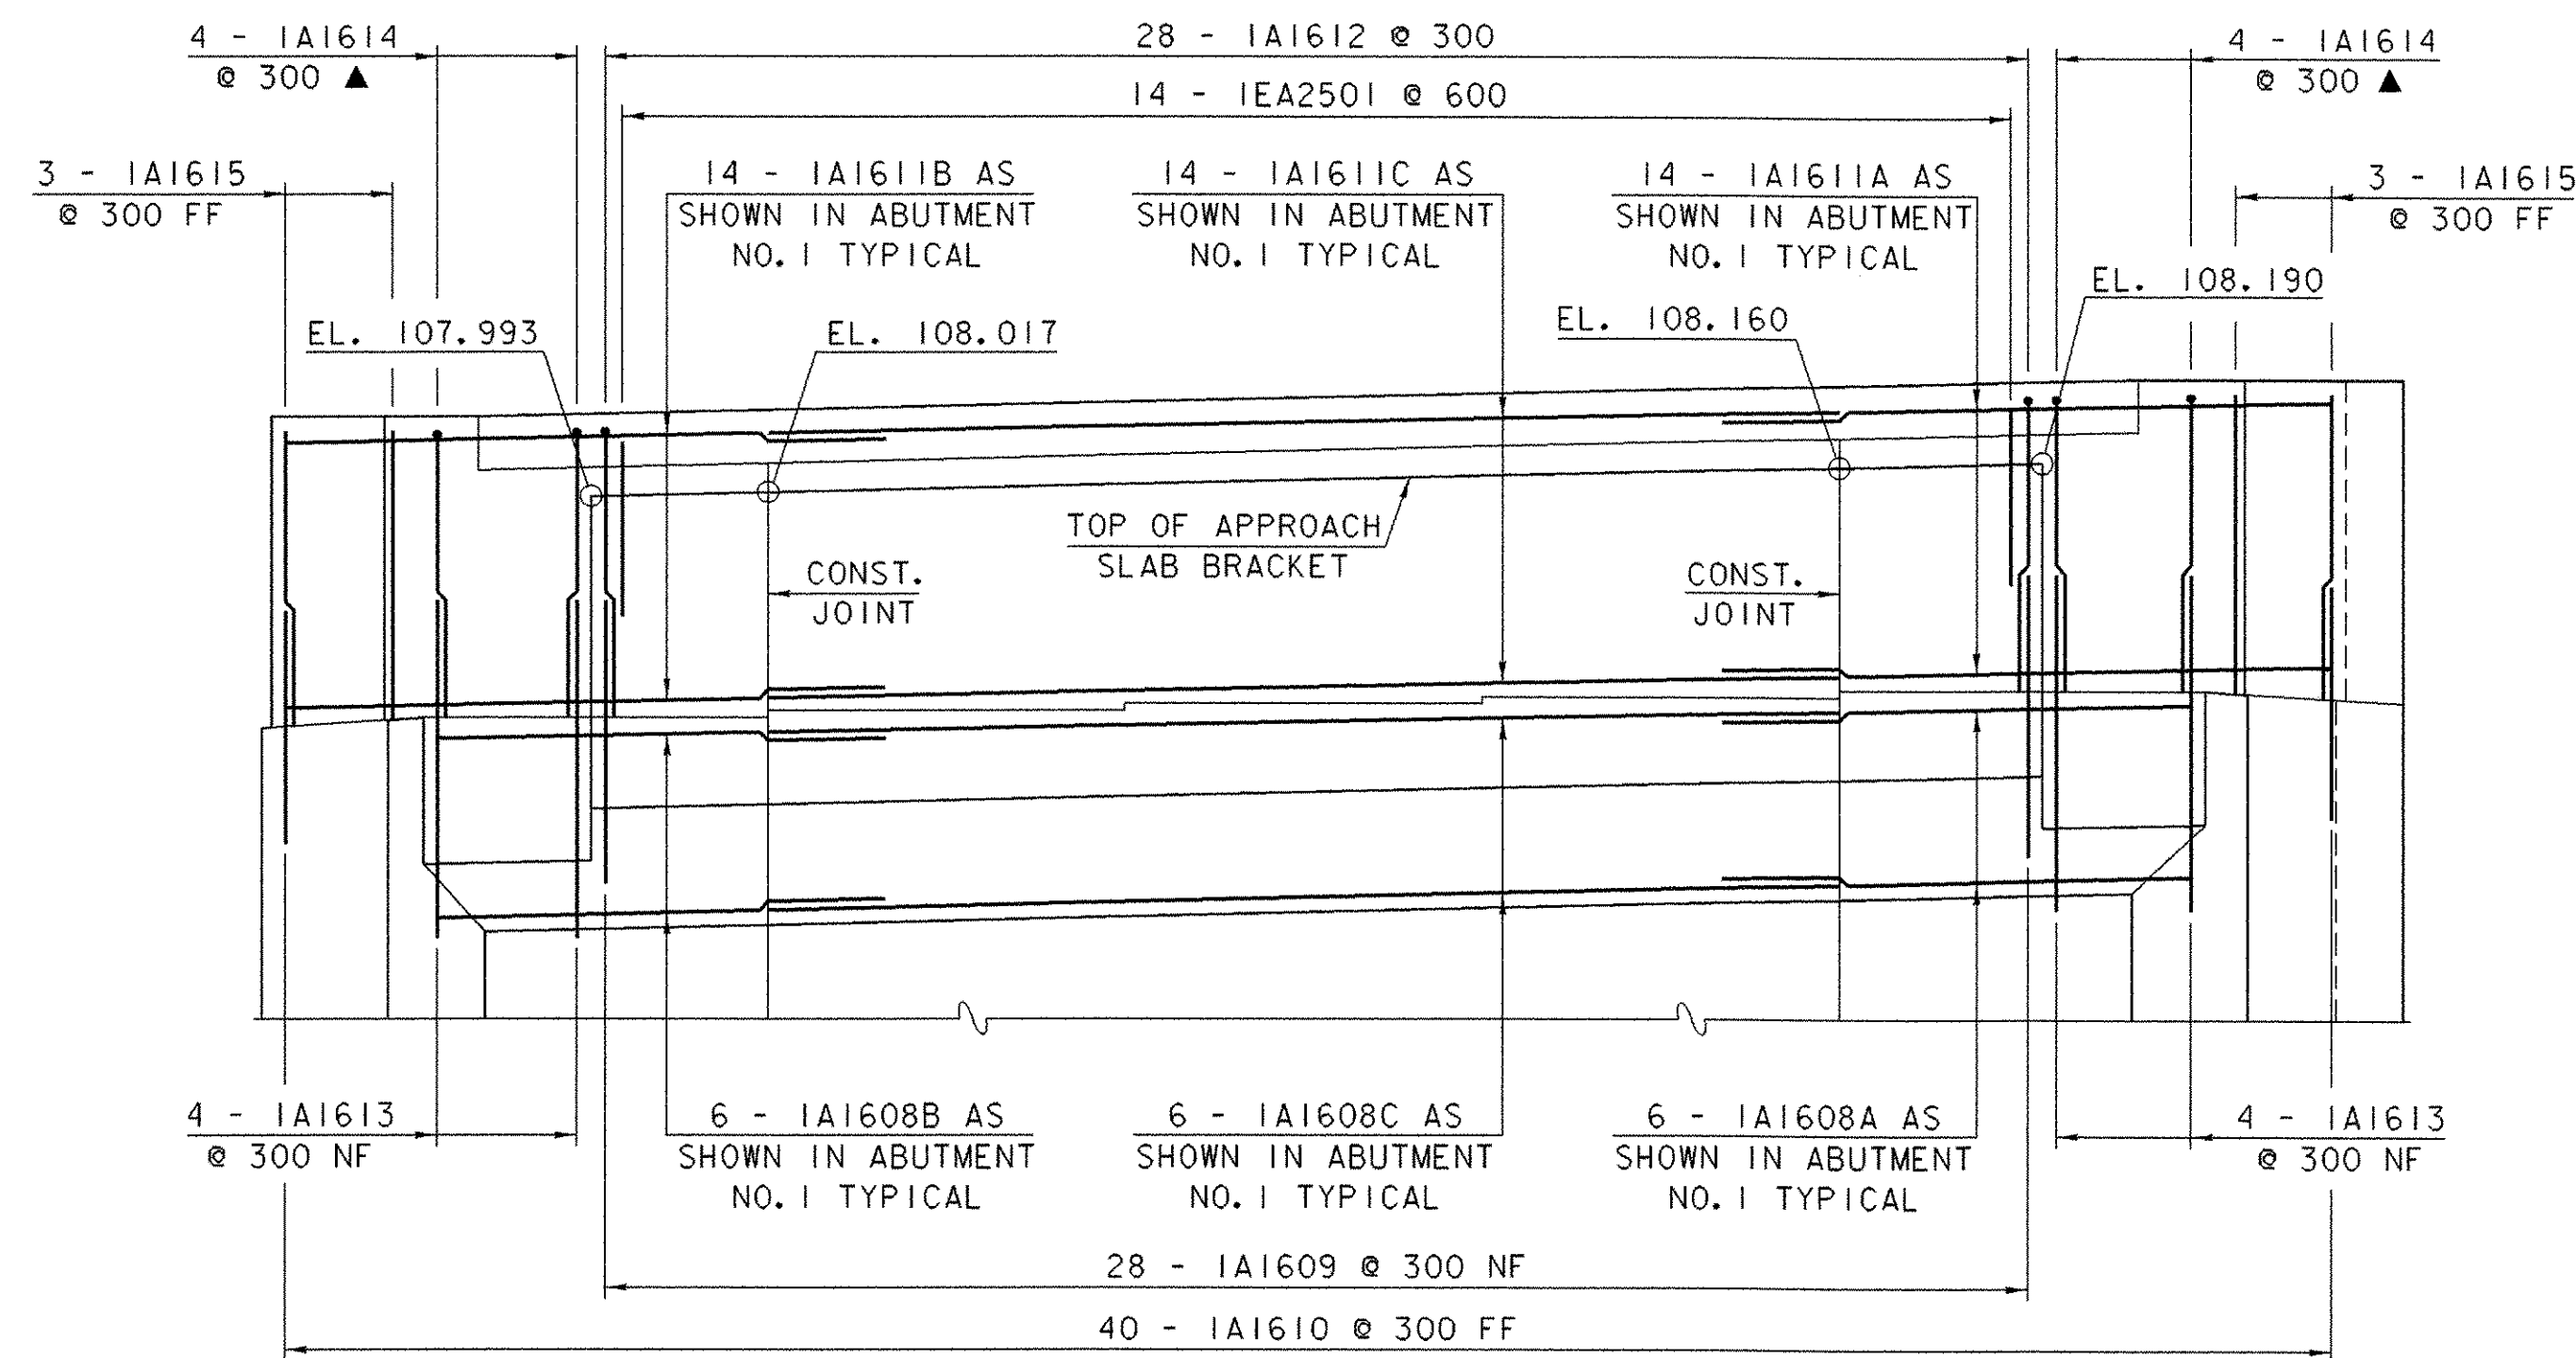



**ABUTMENT NO. 1 BACKWALL ELEVATION
(LOOKING AT BACK OF ABUTMENT)**

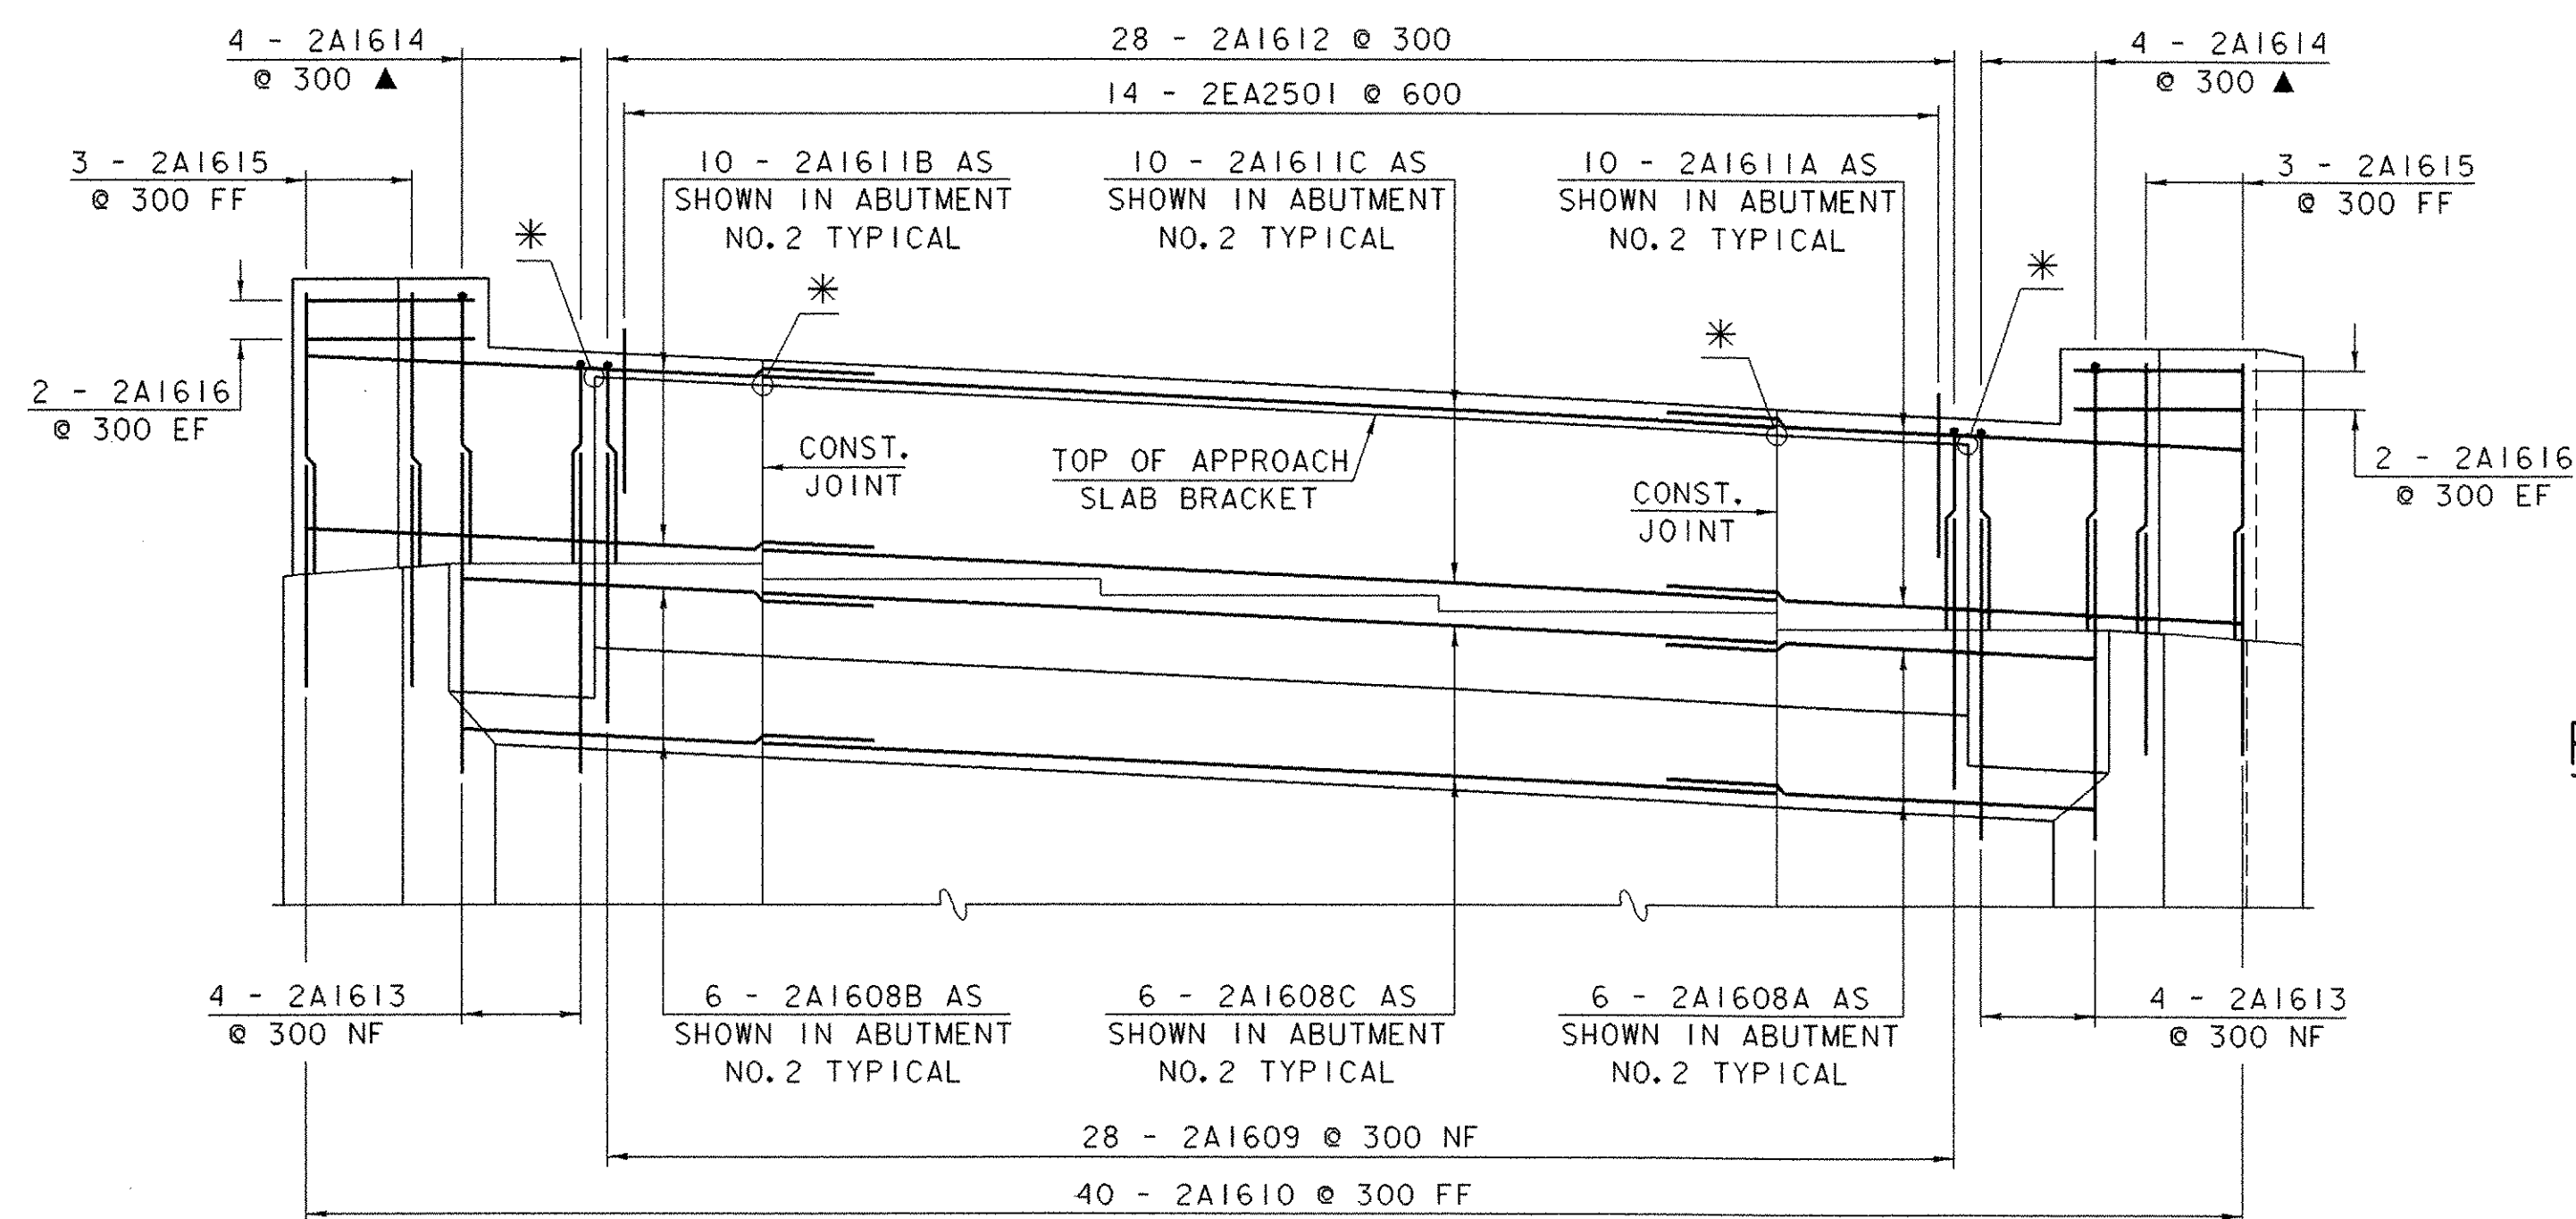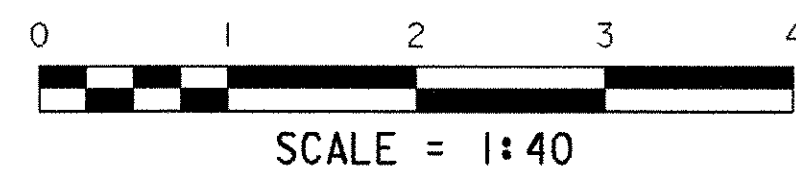



**ABUTMENT NO. 2 BACKWALL ELEVATION
(LOOKING AT BACK OF ABUTMENT)**

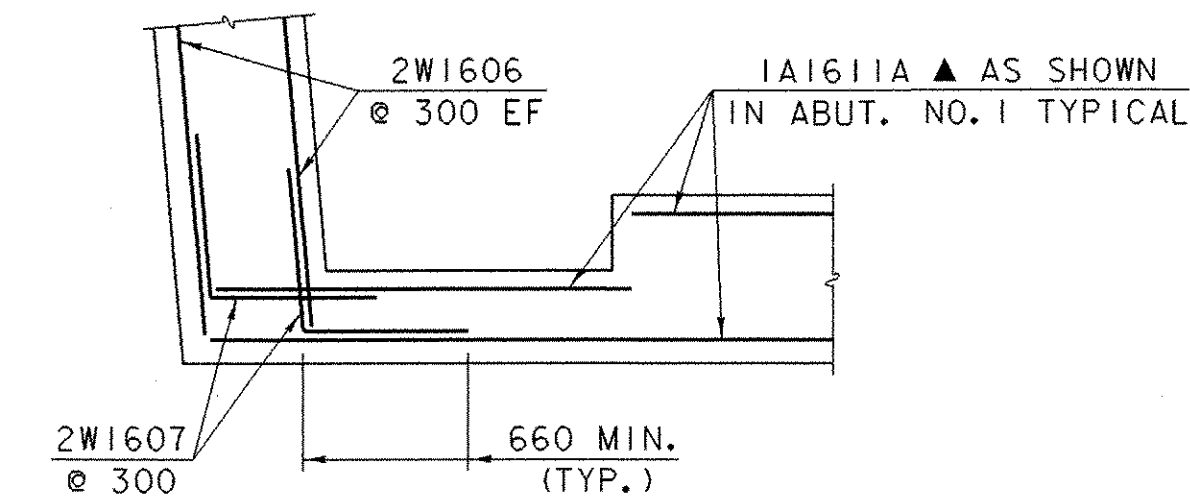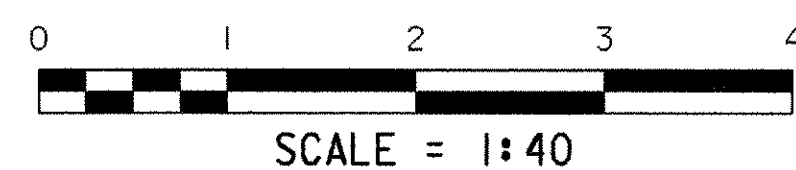



**WINGWALL NO. 2 CORNER
REINFORCING ABOVE BRIDGE SEAT**

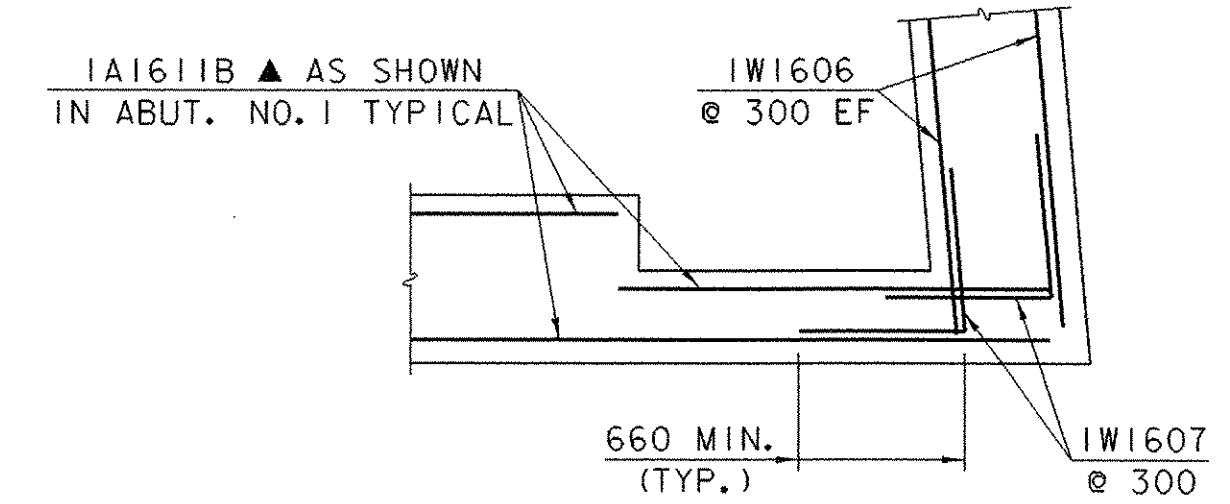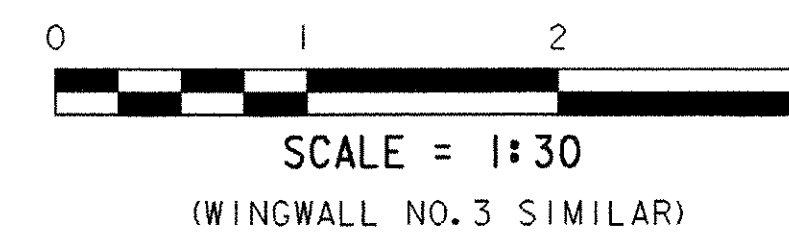


**WINGWALL NO. 1 CORNER
REINFORCING ABOVE BRIDGE SEAT**

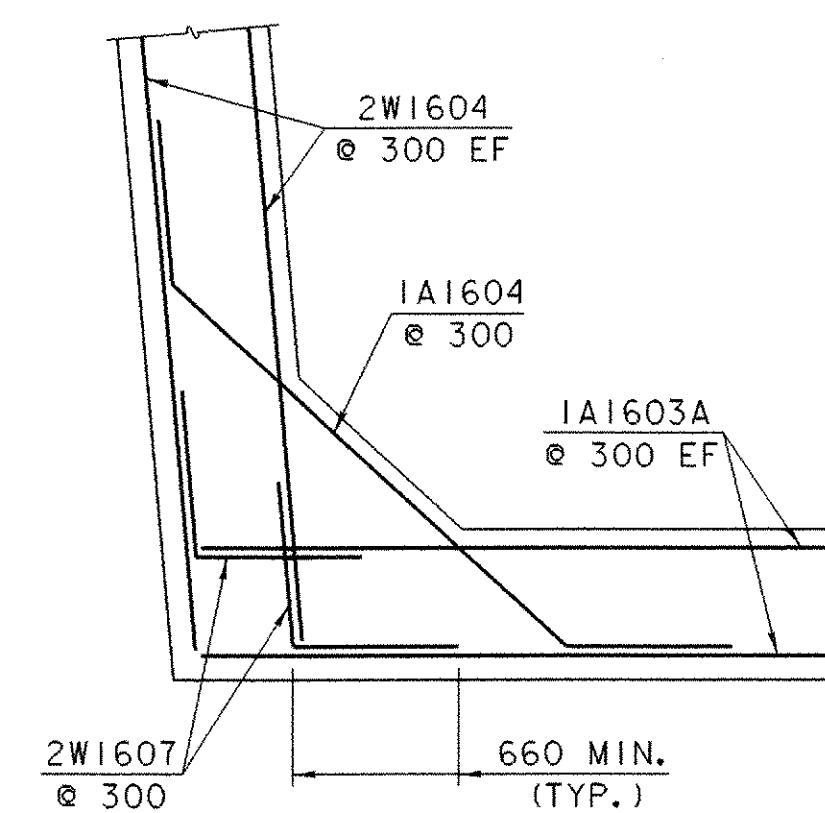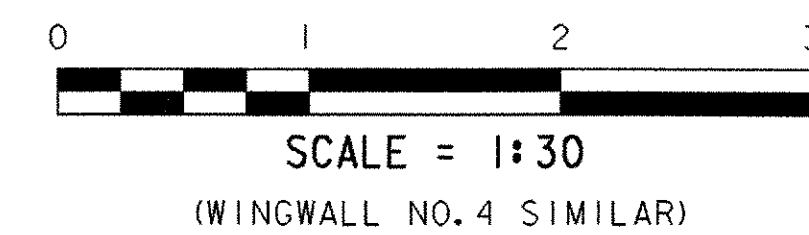

**WINGWALL NO. 2 CORNER
REINFORCING BELOW BRIDGE SEAT**

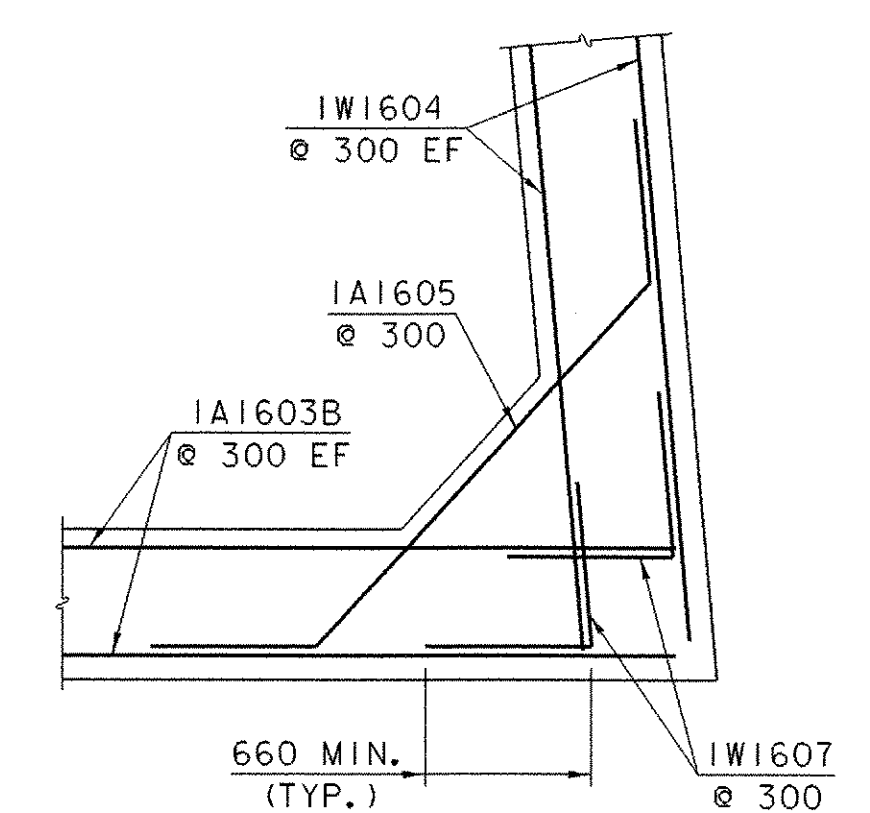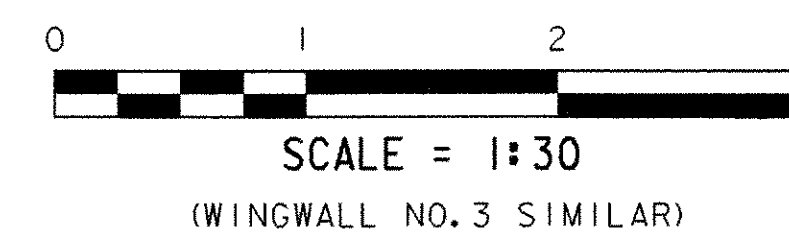


**WINGWALL NO. 1 CORNER
REINFORCING BELOW BRIDGE SEAT**

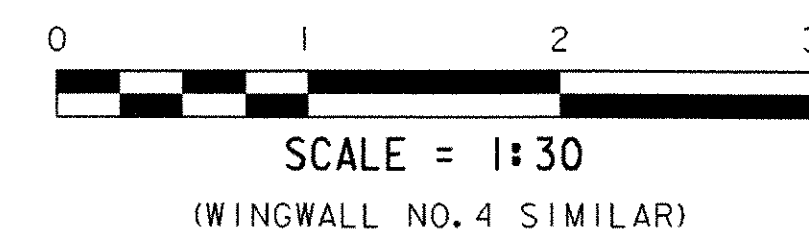



* ELEVATIONS AT TOP OF APPROACH SLAB BRACKET TO BE DETERMINED IN THE FIELD AFTER STRUCTURAL STEEL IS SET.

NOTE:
 NF = NEAR FACE
 FF = FAR FACE
 EF = EACH FACE
 ▲ = CUT TO FIT IN FIELD
 80 CLR. UNLESS OTHERWISE NOTED
 660 BAR LAP UNLESS OTHERWISE NOTED



SHEET NAME: BACKWALL & CORNER REINFORCING DETAILS		
PROJECT NAME: LEICESTER	HIGHWAY NO.: TH 1	
PROJECT NUMBER: BRF 0160(3)S	BRIDGE NO.: 6	OVER: OTTER CREEK
FILE NAME: 95j288\Structures\sj288sub.dgn	PLOT DATE: 17-AUG-2005	
PROJECT MANAGER: R. R. WHITCOMB	DRAWN BY: G. ROY	
DESIGNED BY: C. CARLSON	IPARM NAME: sj288bwd.1	
BRIDGE SHEET NUMBER:	SHEET 60 OF 90	

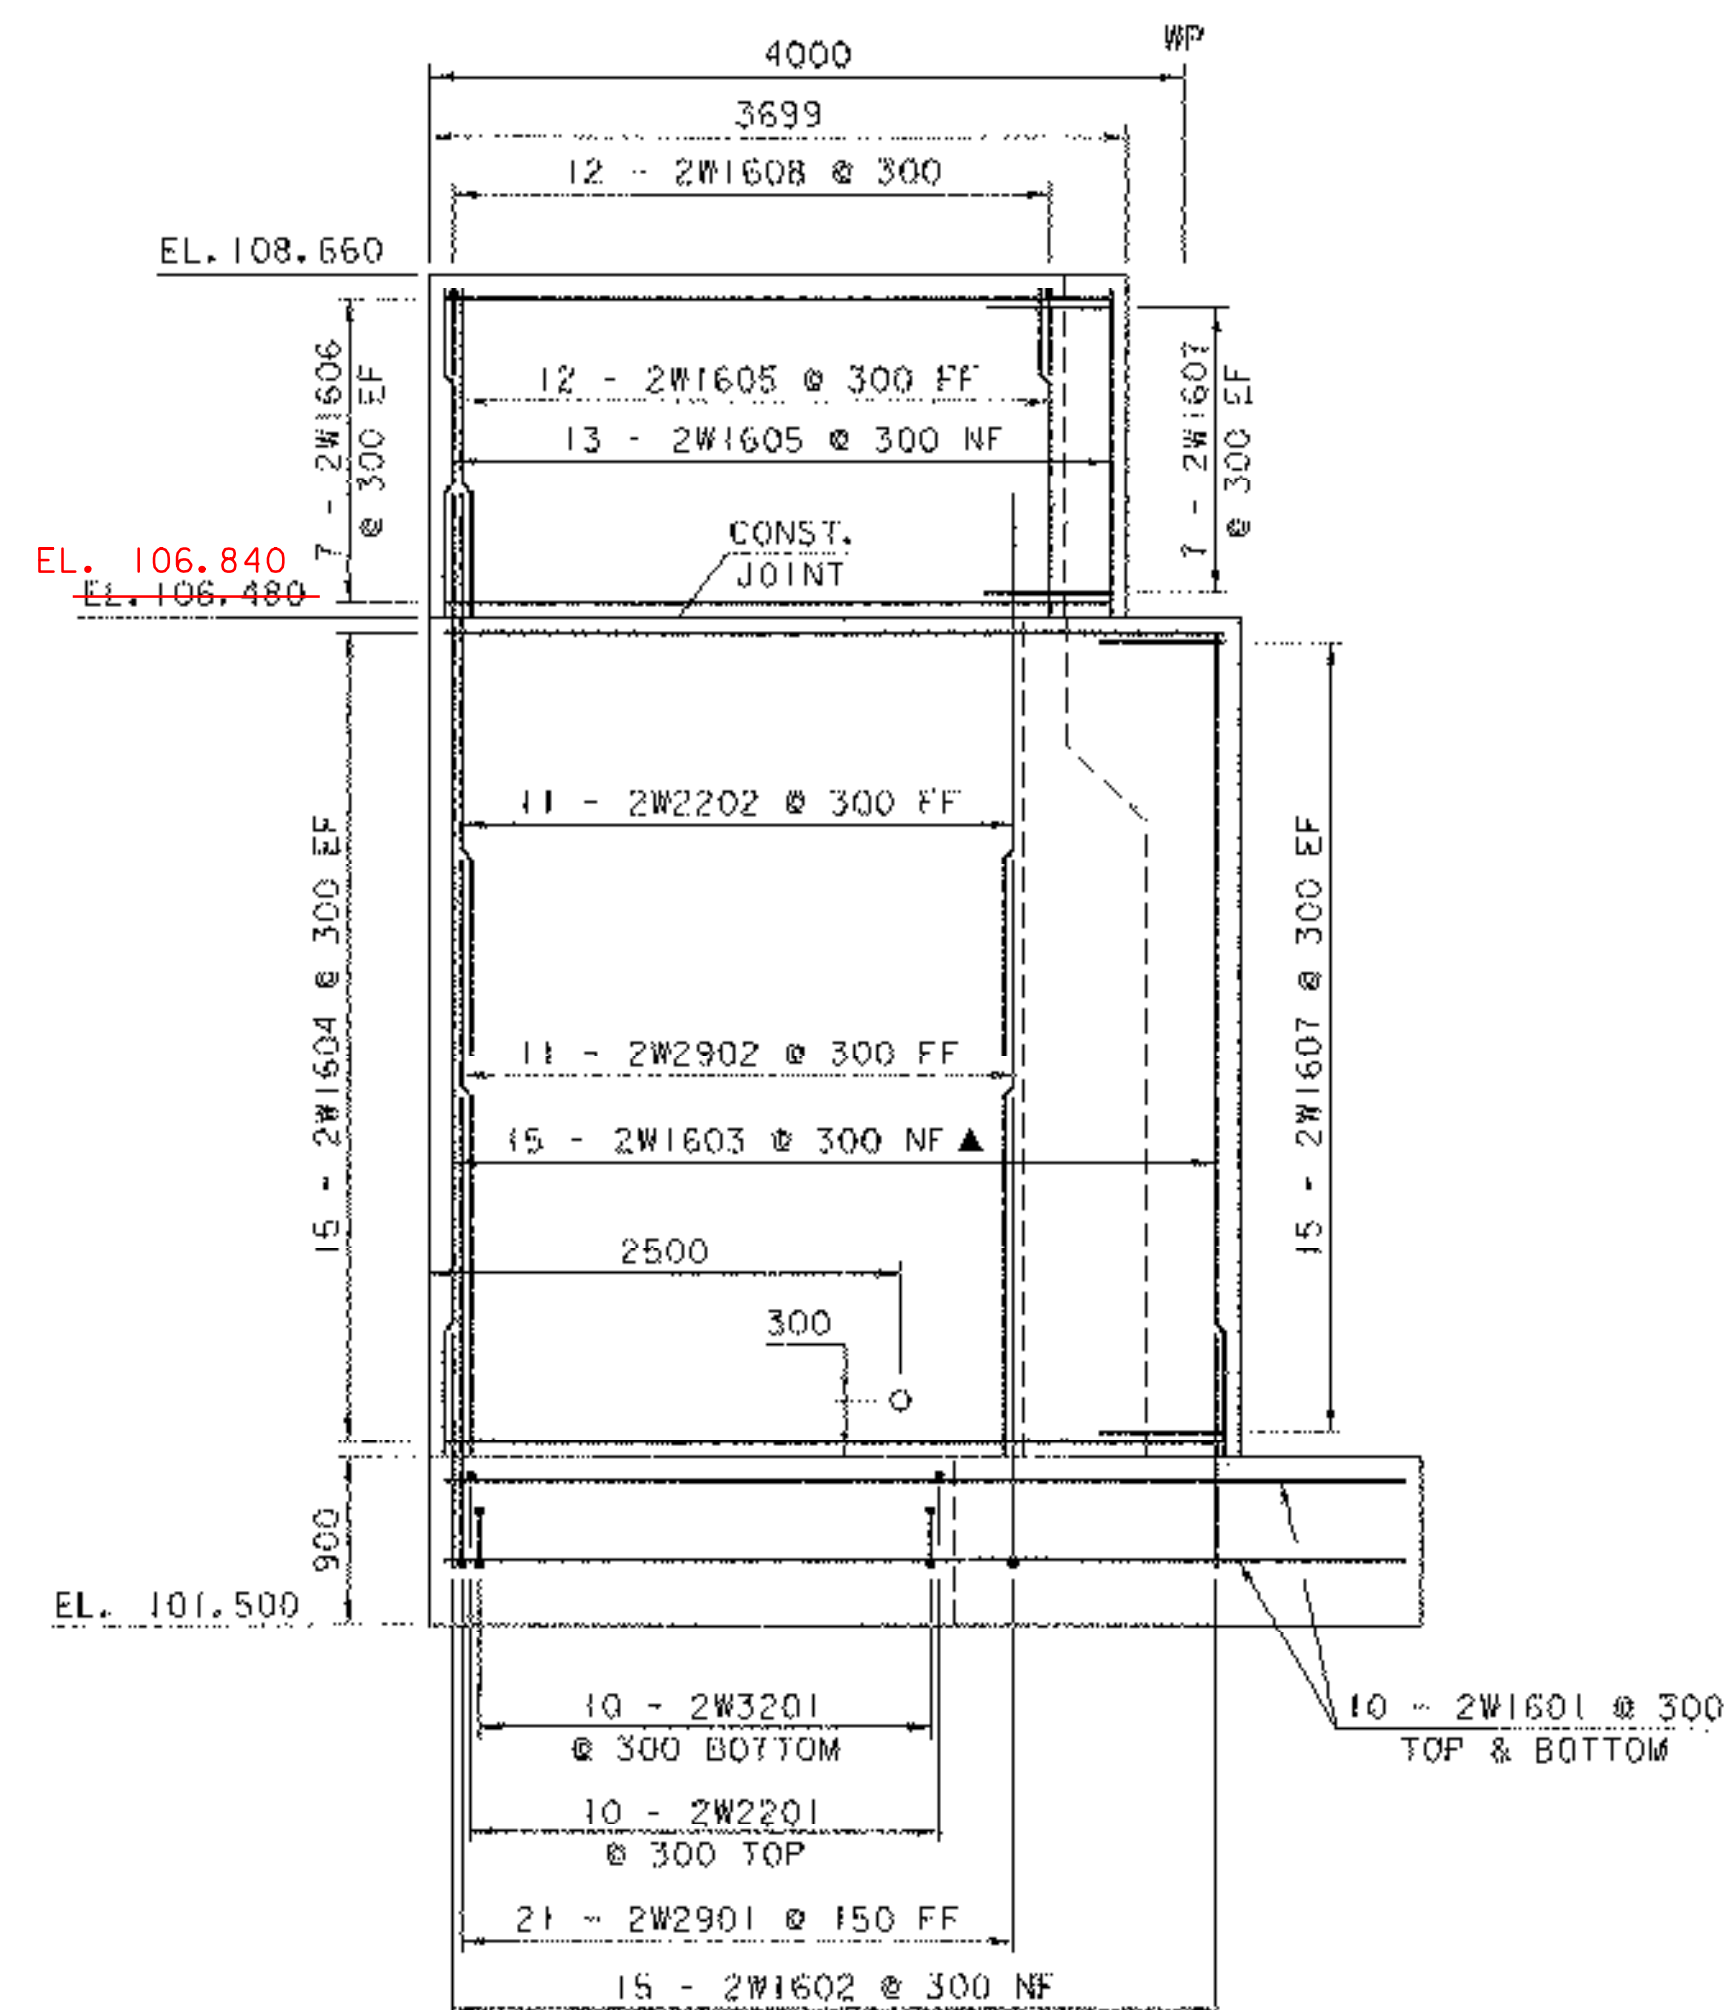


WINGWALL NO. 2 ELEVATION

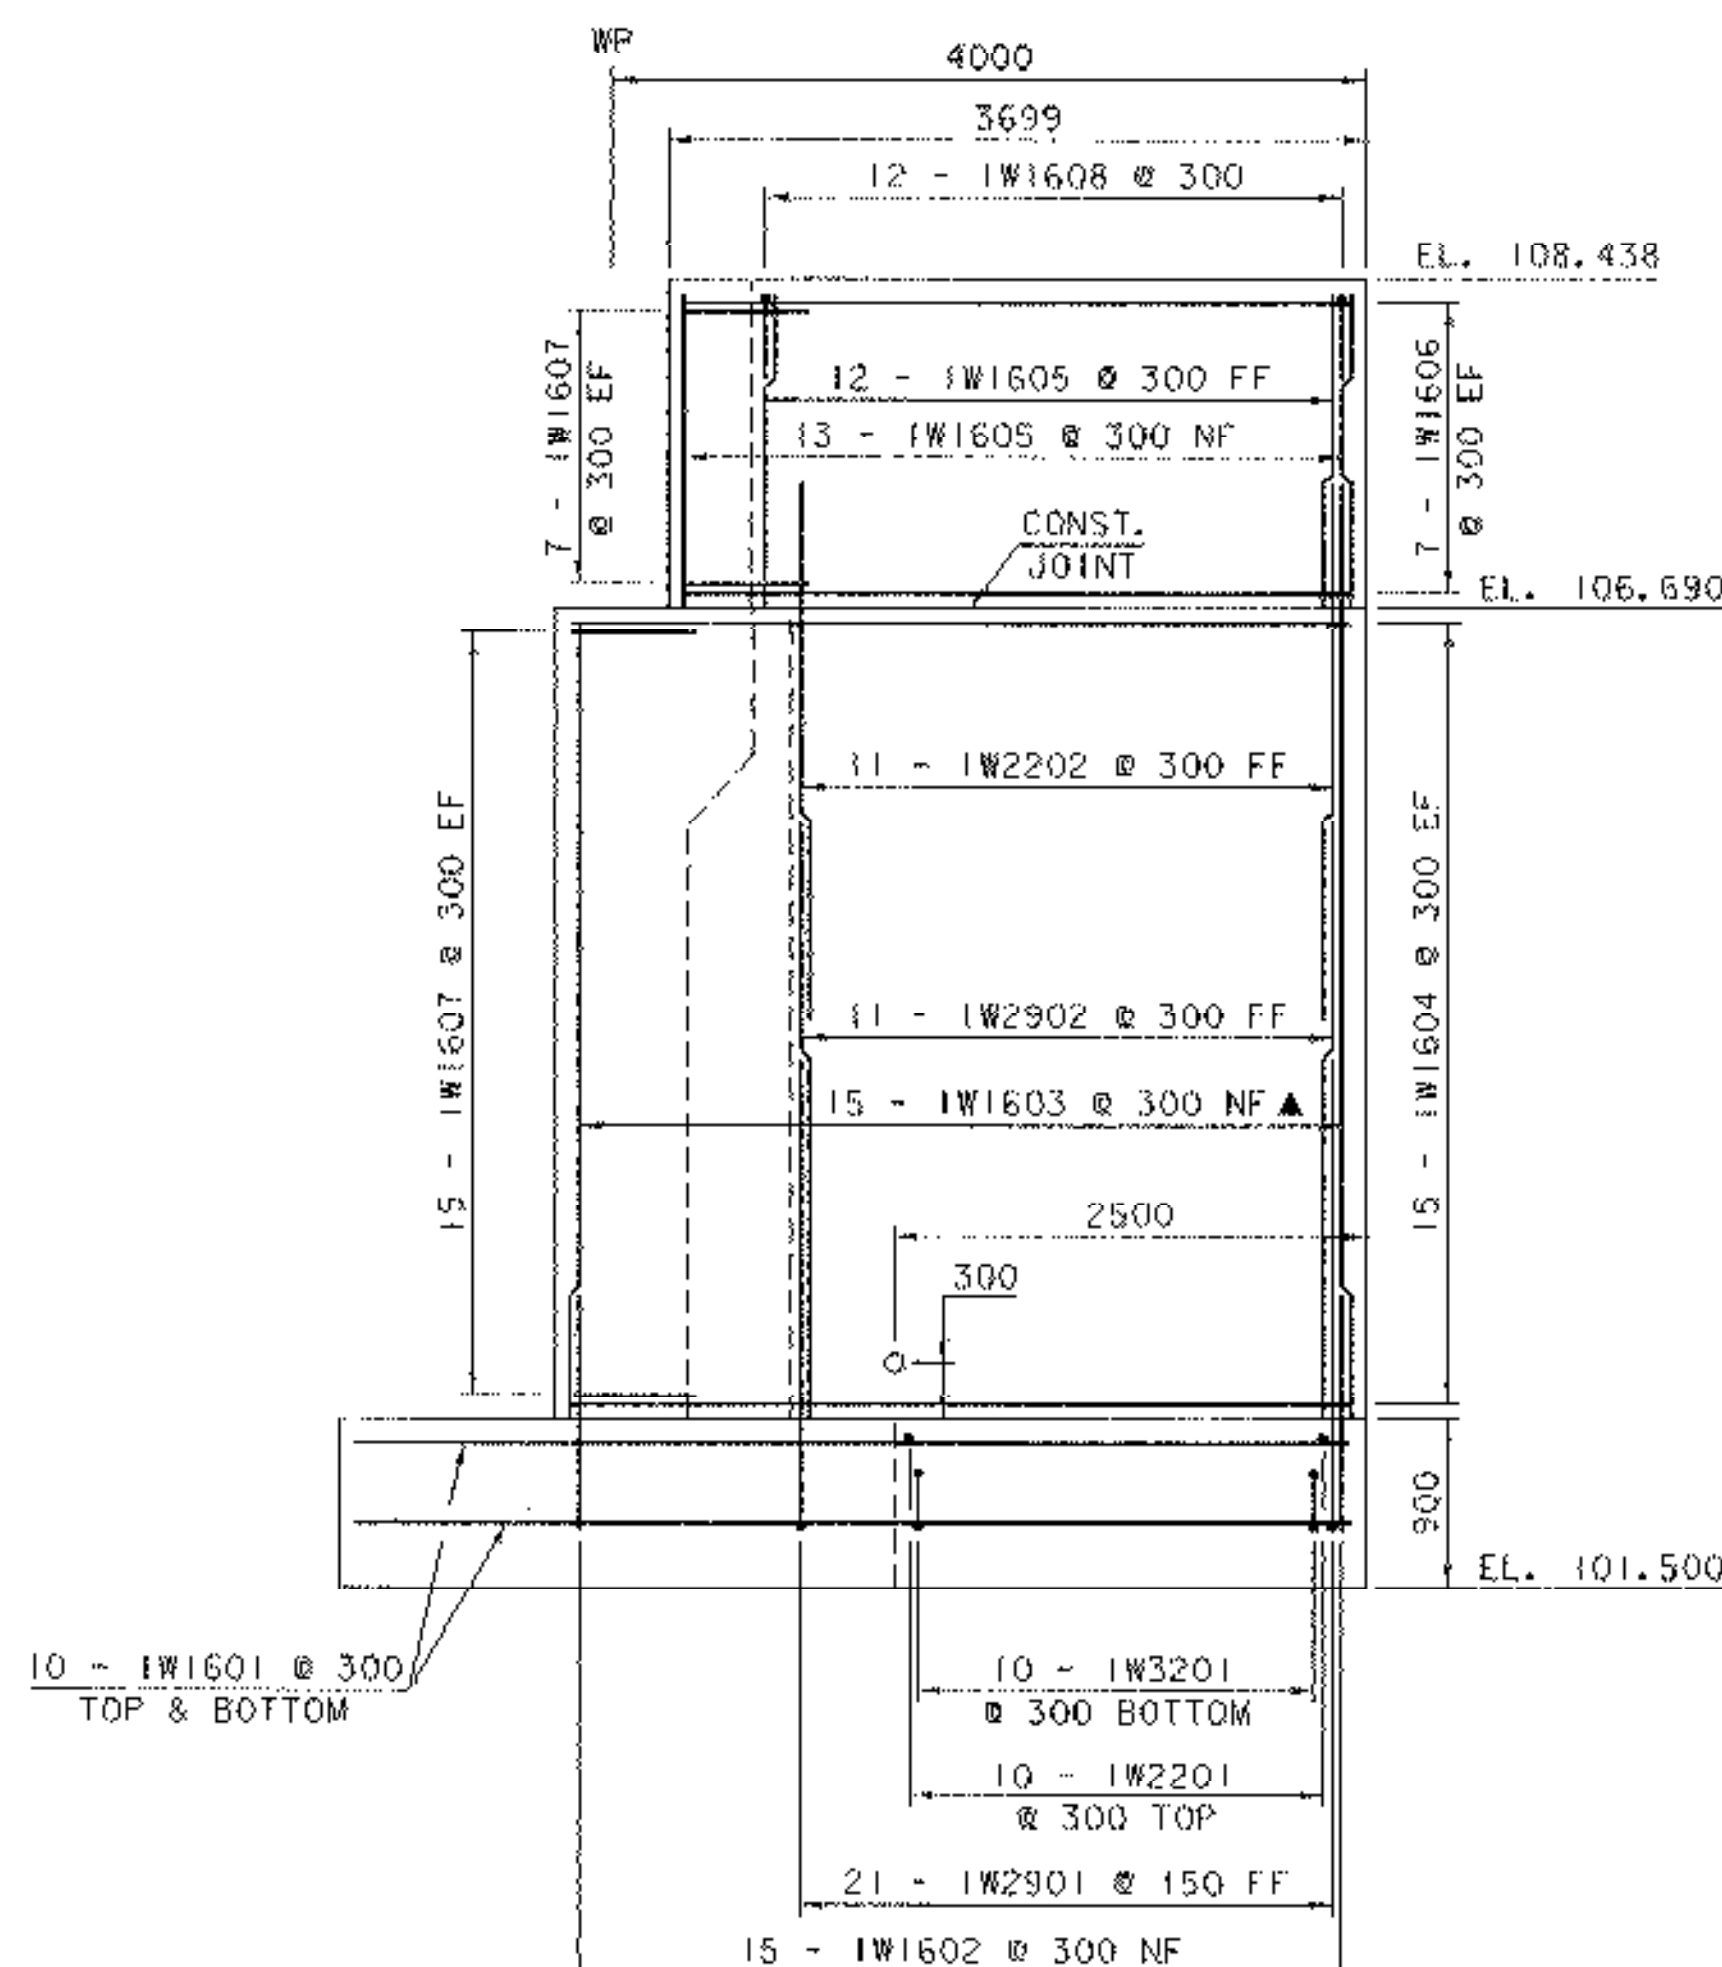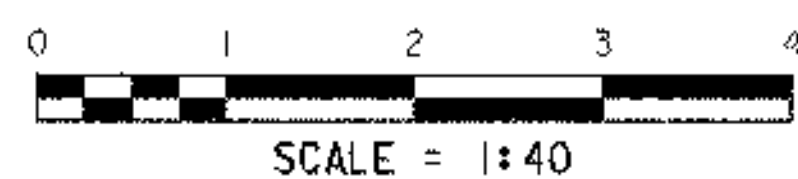

WINGWALL NO. 1 ELEVATION

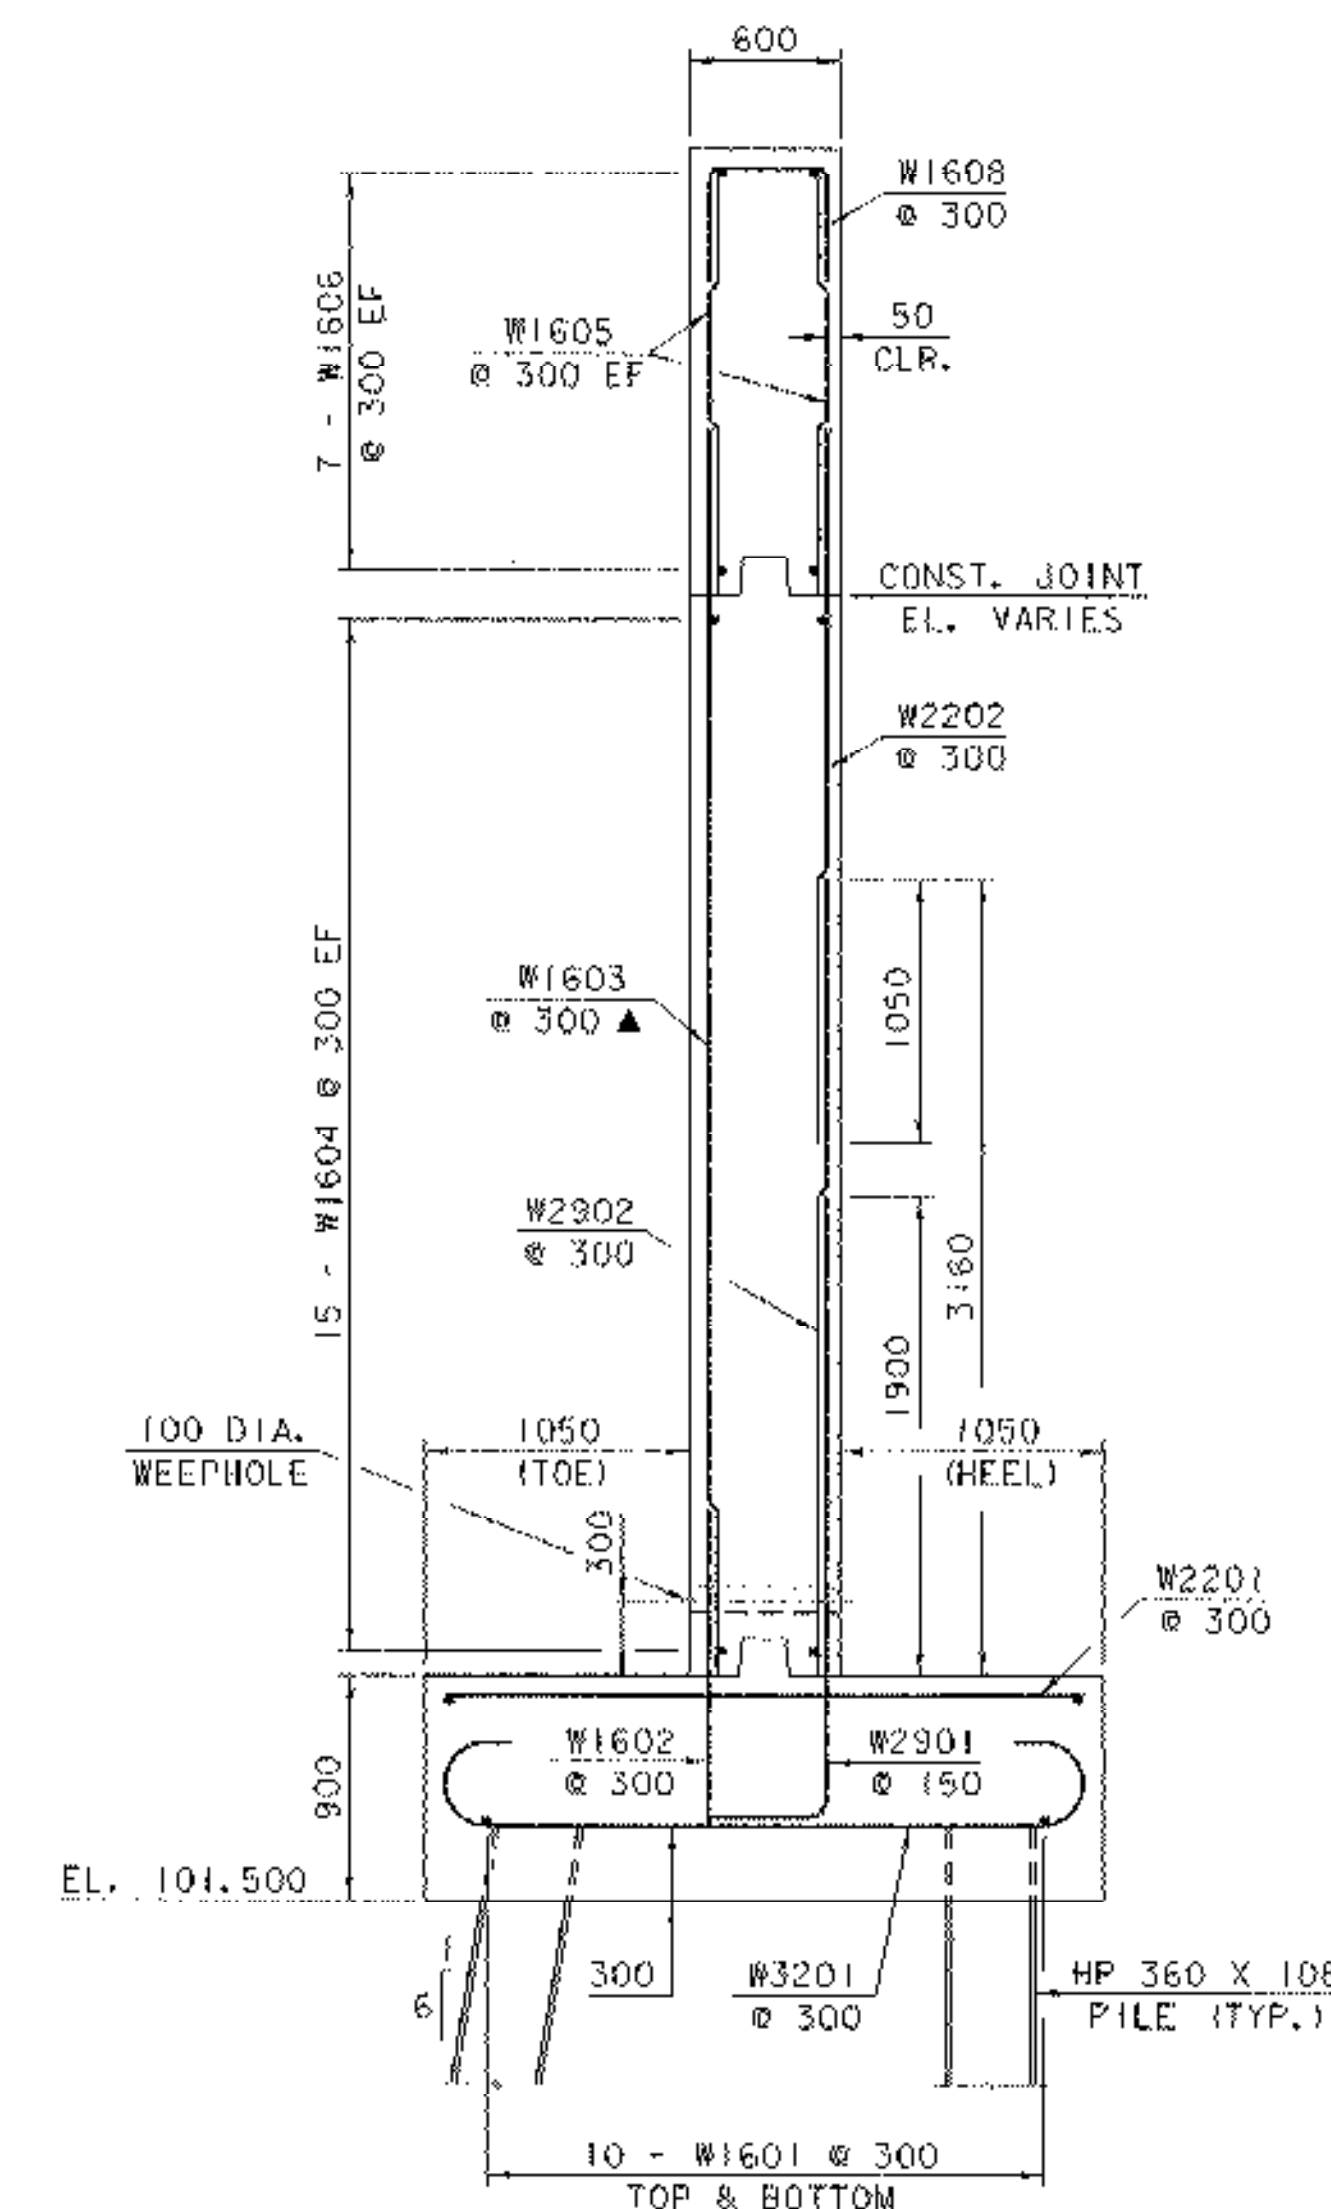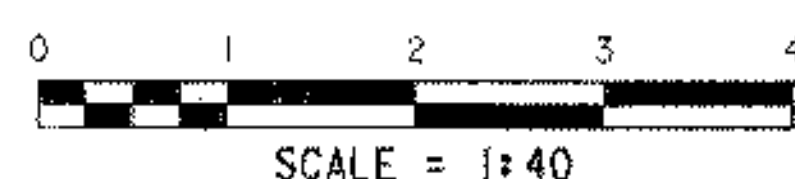


WINGWALL TYPICAL


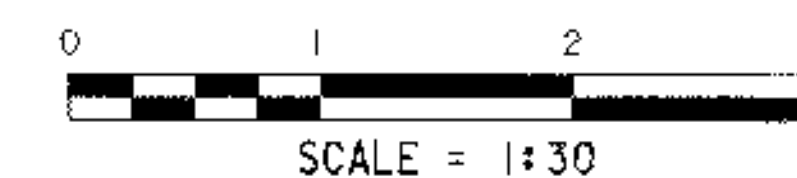


NOTE:
 NF = NEAR FACE
 FF = FAR FACE
 EF = EACH FACE
 ▲ = CUT TO FIT IN FIELD
 80 CLR. UNLESS OTHERWISE NOTED
 660 BAR LAP UNLESS OTHERWISE NOTED


SHEET NAME: WINGWALLS NO. 1 & 2 ELEVATIONS	
PROJECT NAME: LEICESTER	HIGHWAY NO.: TH 1
PROJECT NUMBER: BRF 0160(3)S	BRIDGE NO.: 6
	OVER: OTTER CREEK
FILE NAME: 951288\Structures\sj288sub.dgn	PLOT DATE: 17-AUG-2005
PROJECT MANAGER: R. R. WHITCOMB	DRAWN BY: G. ROY
DESIGNED BY: C. CARLSON	IPARM NAME: sj288wwl1
BRIDGE SHEET NUMBER:	SHEET 61 OF 90

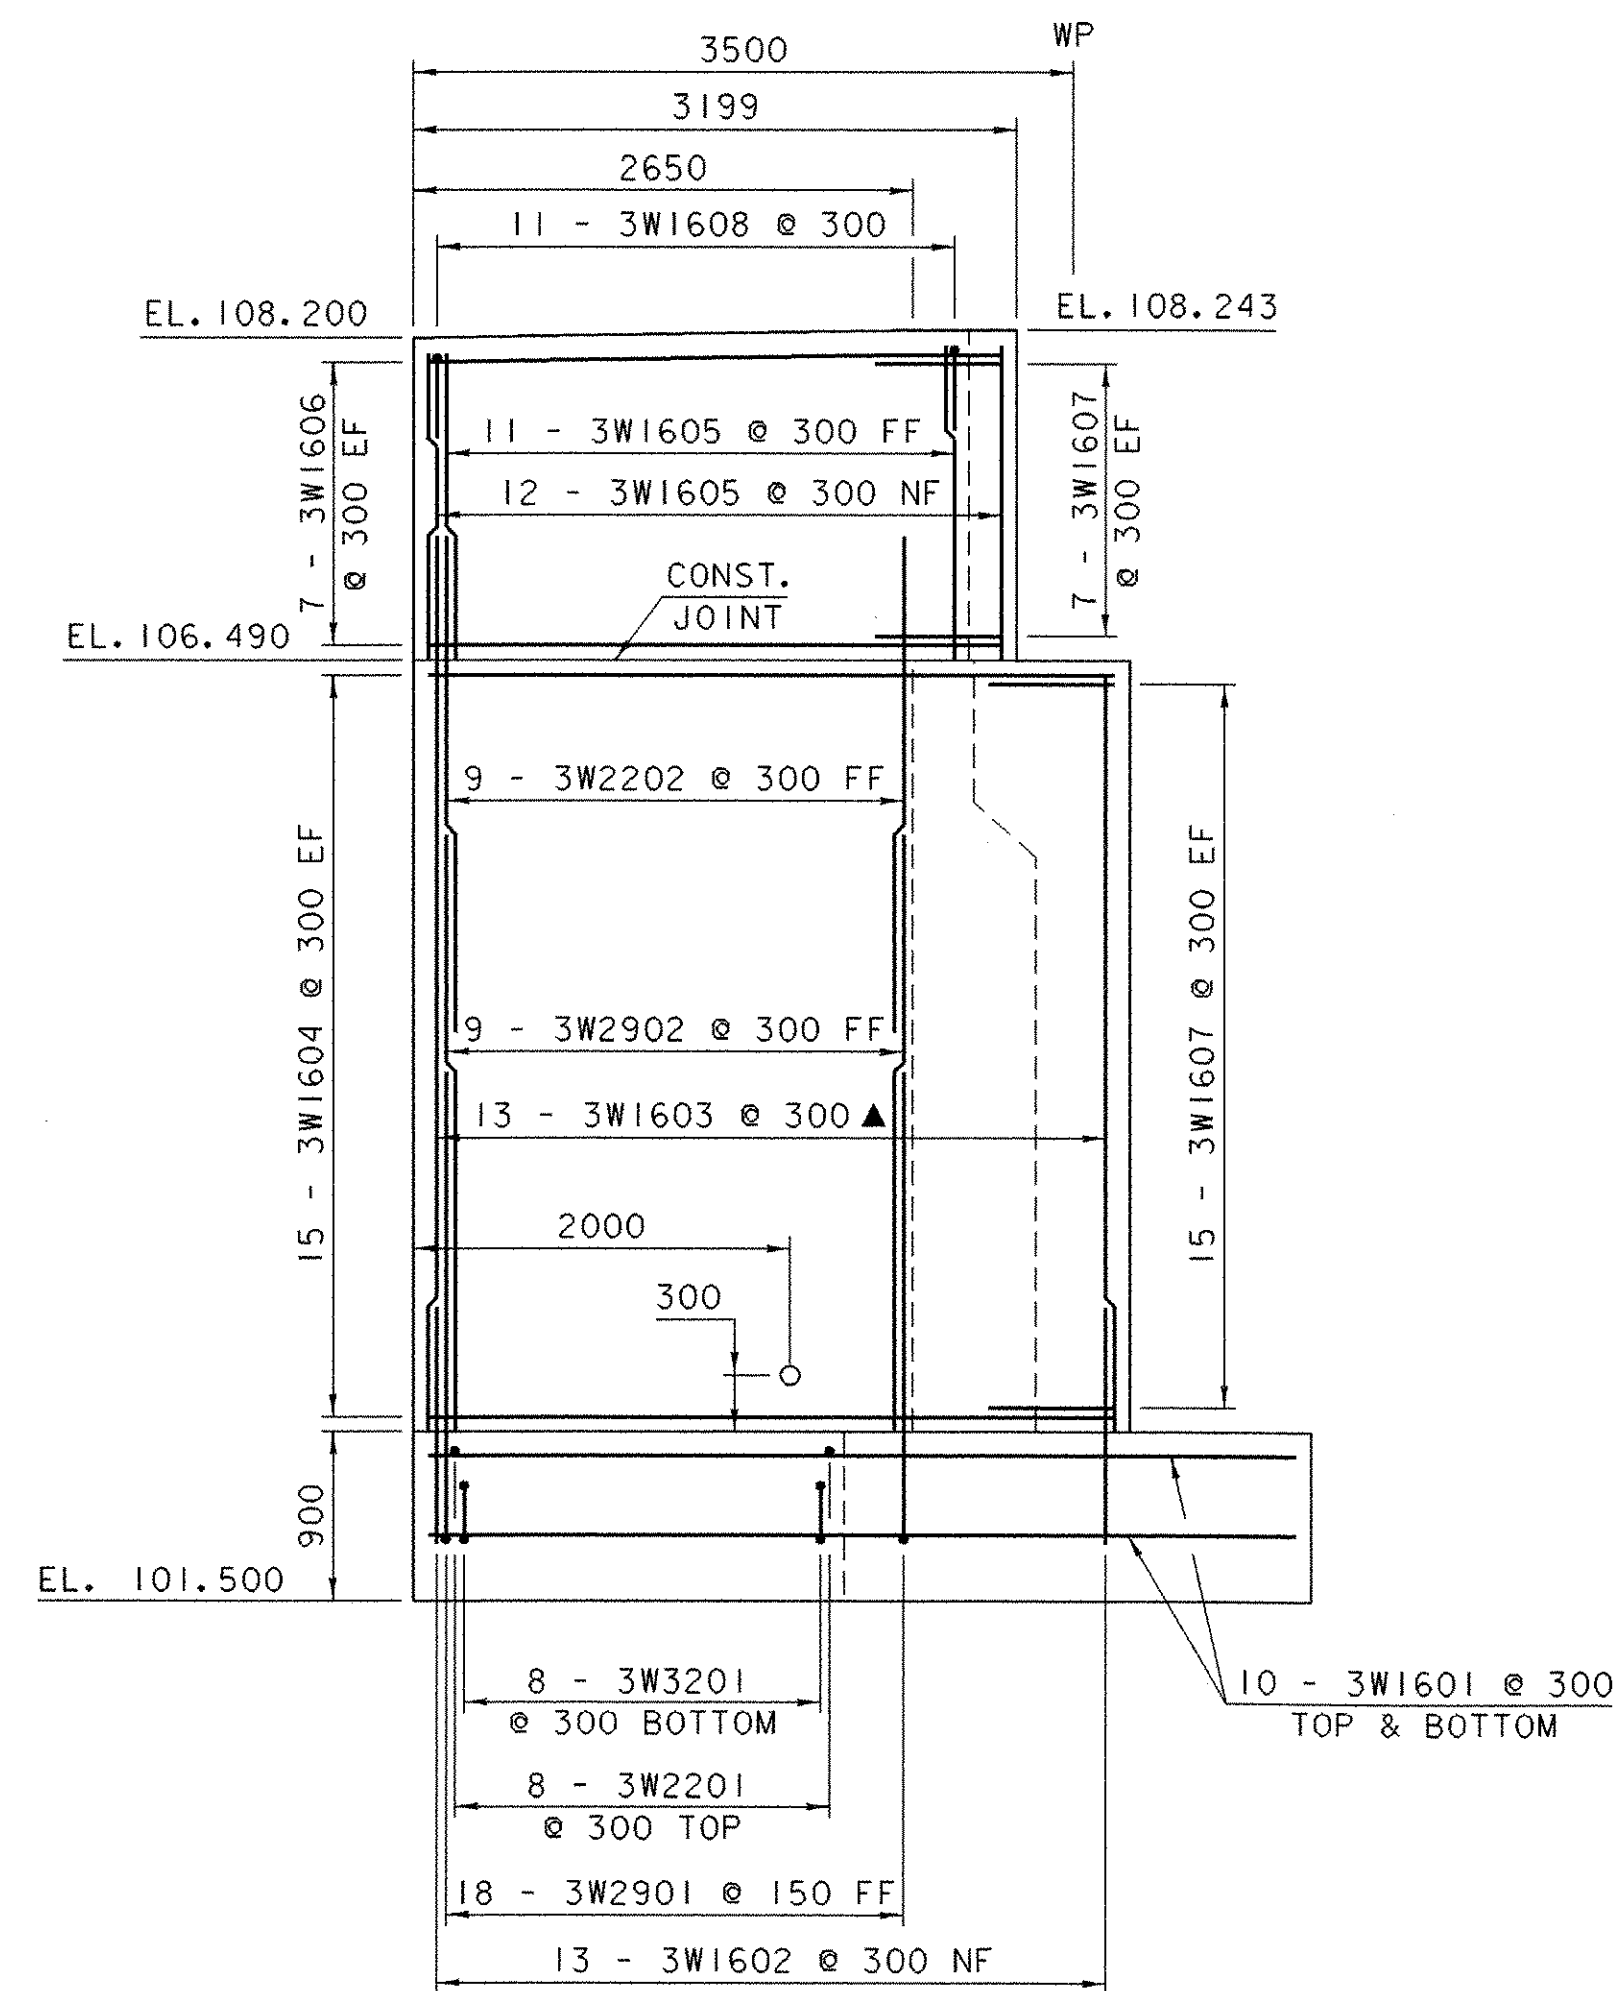

WINGWALL NO. 3 ELEVATION

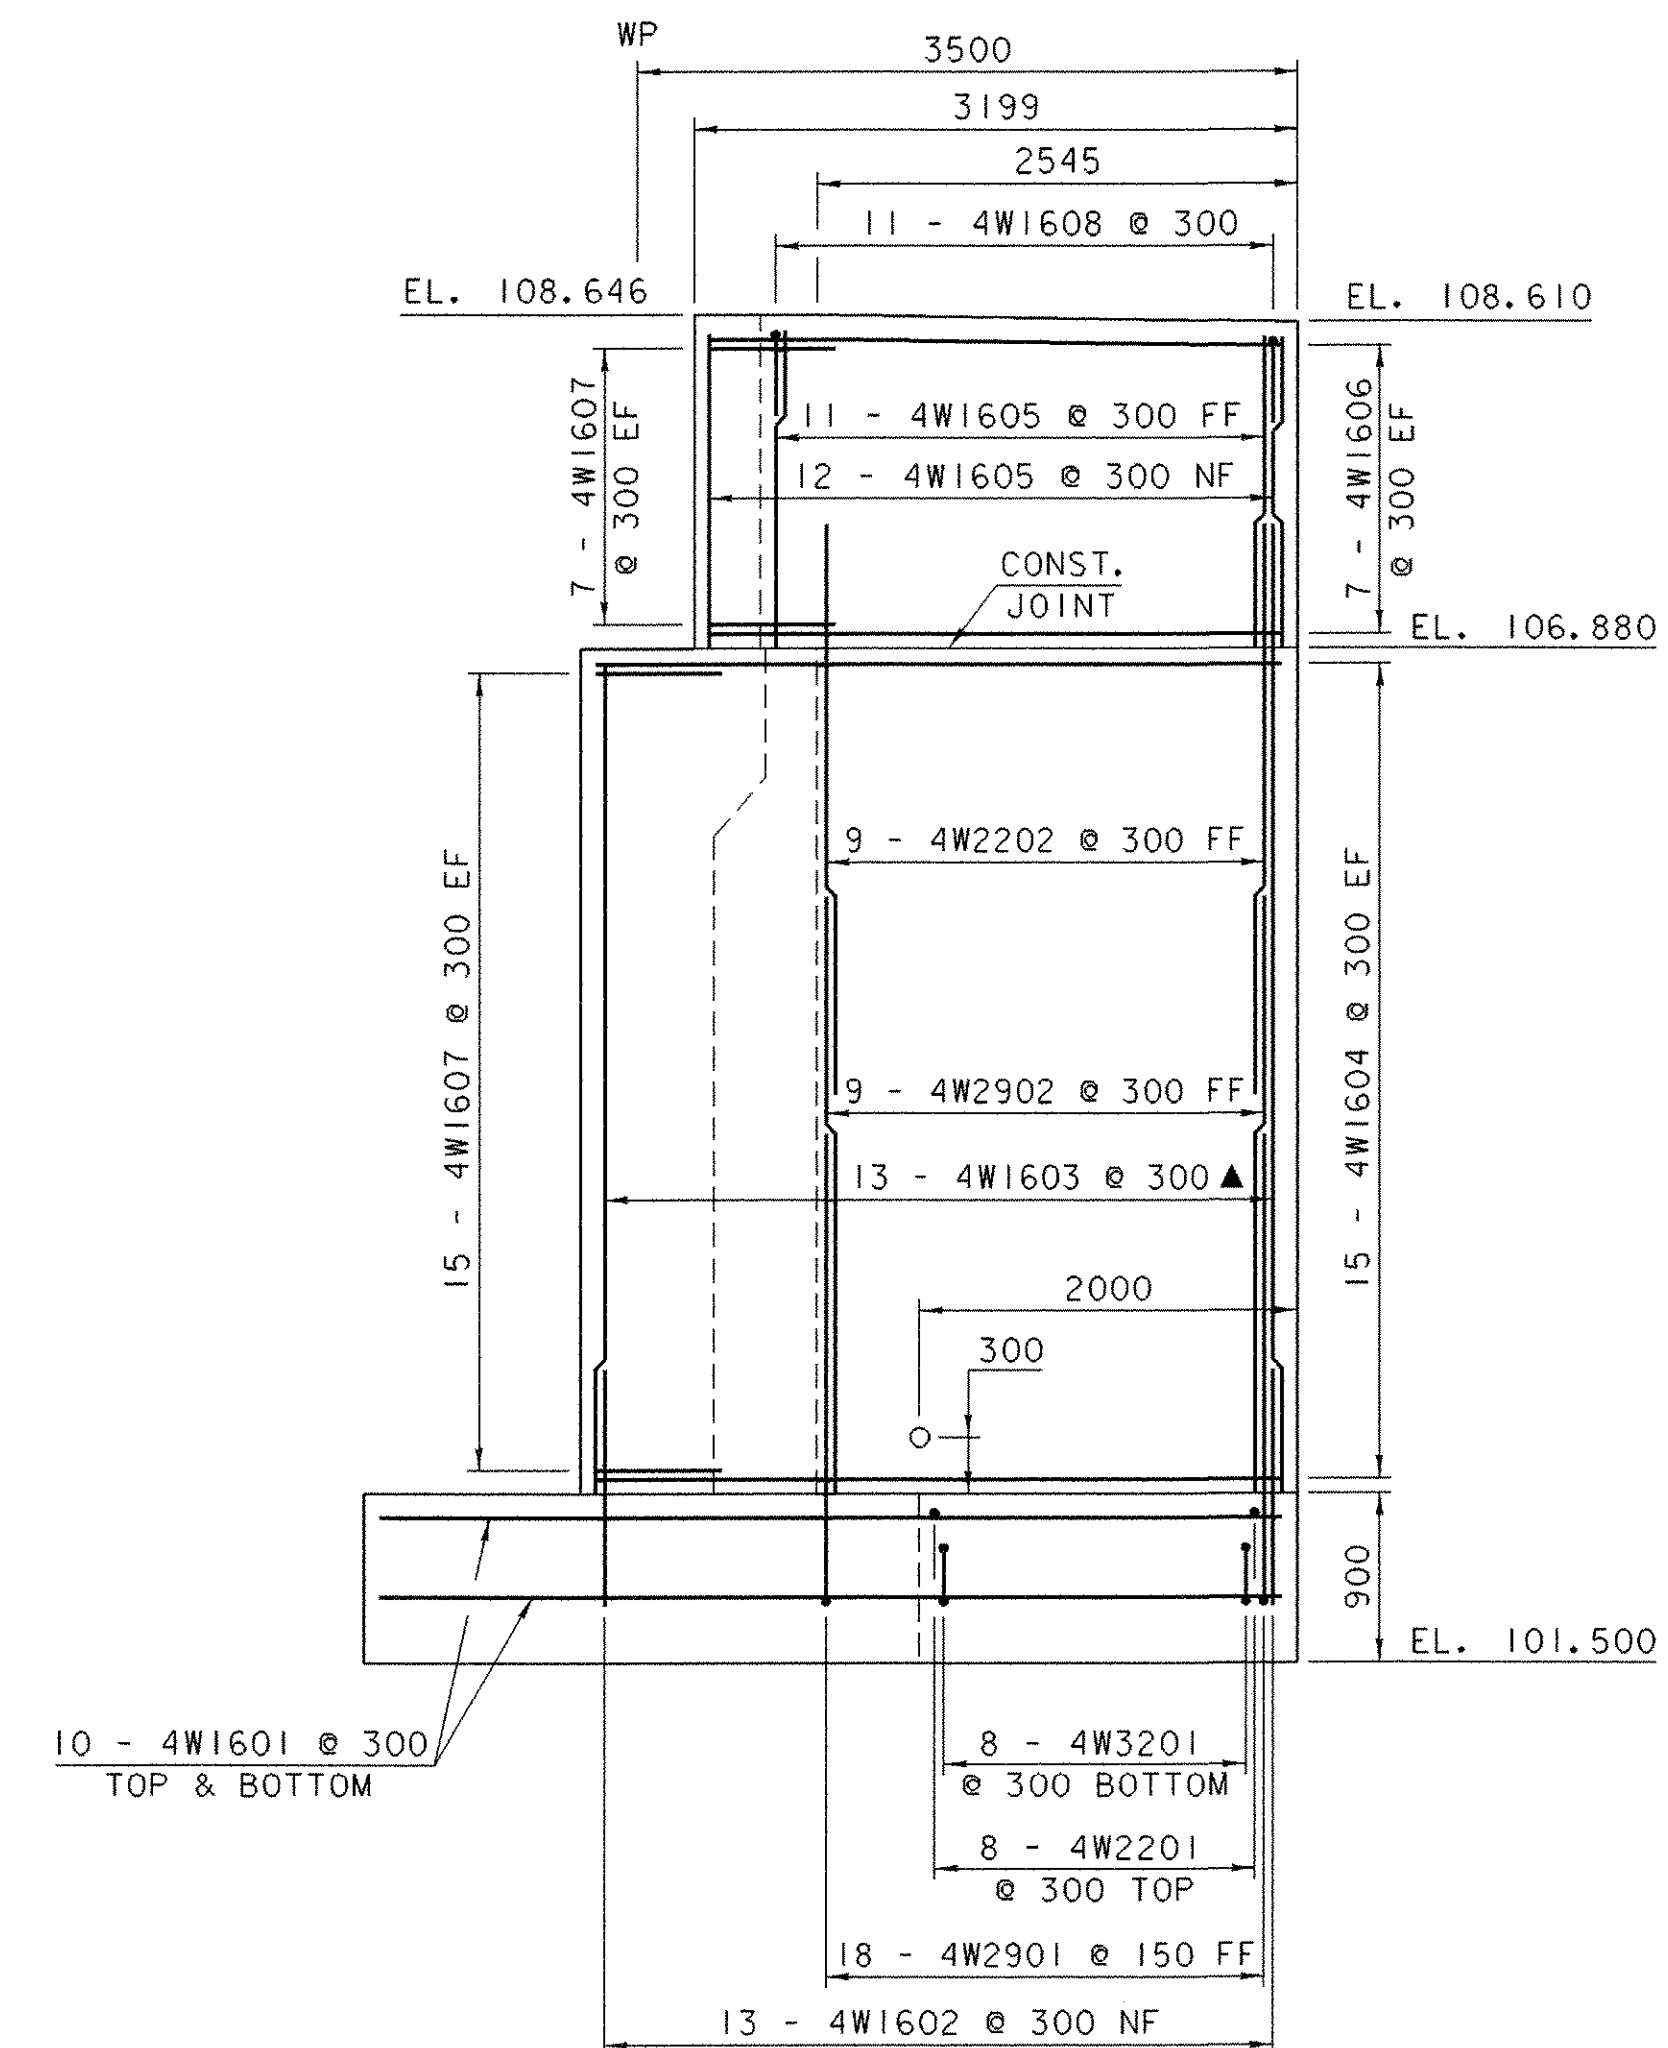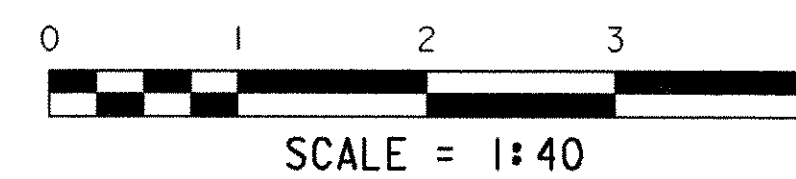


WINGWALL NO. 4 ELEVATION


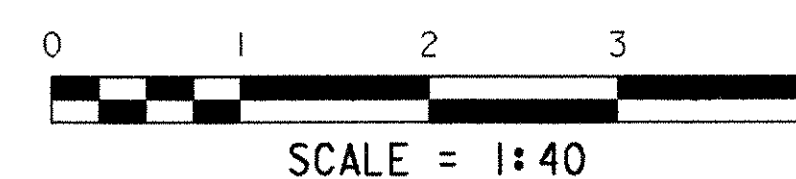


NOTE:
 NF = NEAR FACE
 FF = FAR FACE
 EF = EACH FACE
 ▲ = CUT TO FIT IN FIELD
 80 CLR. UNLESS OTHERWISE NOTED
 660 BAR LAP UNLESS OTHERWISE NOTED


SHEET NAME: WINGWALLS NO. 3 & 4 ELEVATIONS	
PROJECT NAME: LEICESTER	HIGHWAY NO.: TH 1
PROJECT NUMBER: BRF 0160(3)S	BRIDGE NO.: 6
	OVER: OTTER CREEK
FILE NAME: 95J288\Structures\sj288sub.dgn	PLOT DATE: 17-AUG-2005
PROJECT MANAGER: R. R. WHITCOMB	DRAWN BY: G. ROY
DESIGNED BY: C. CARLSON	IPARM NAME: sj288ww2.1
BRIDGE SHEET NUMBER:	SHEET 62 OF 90

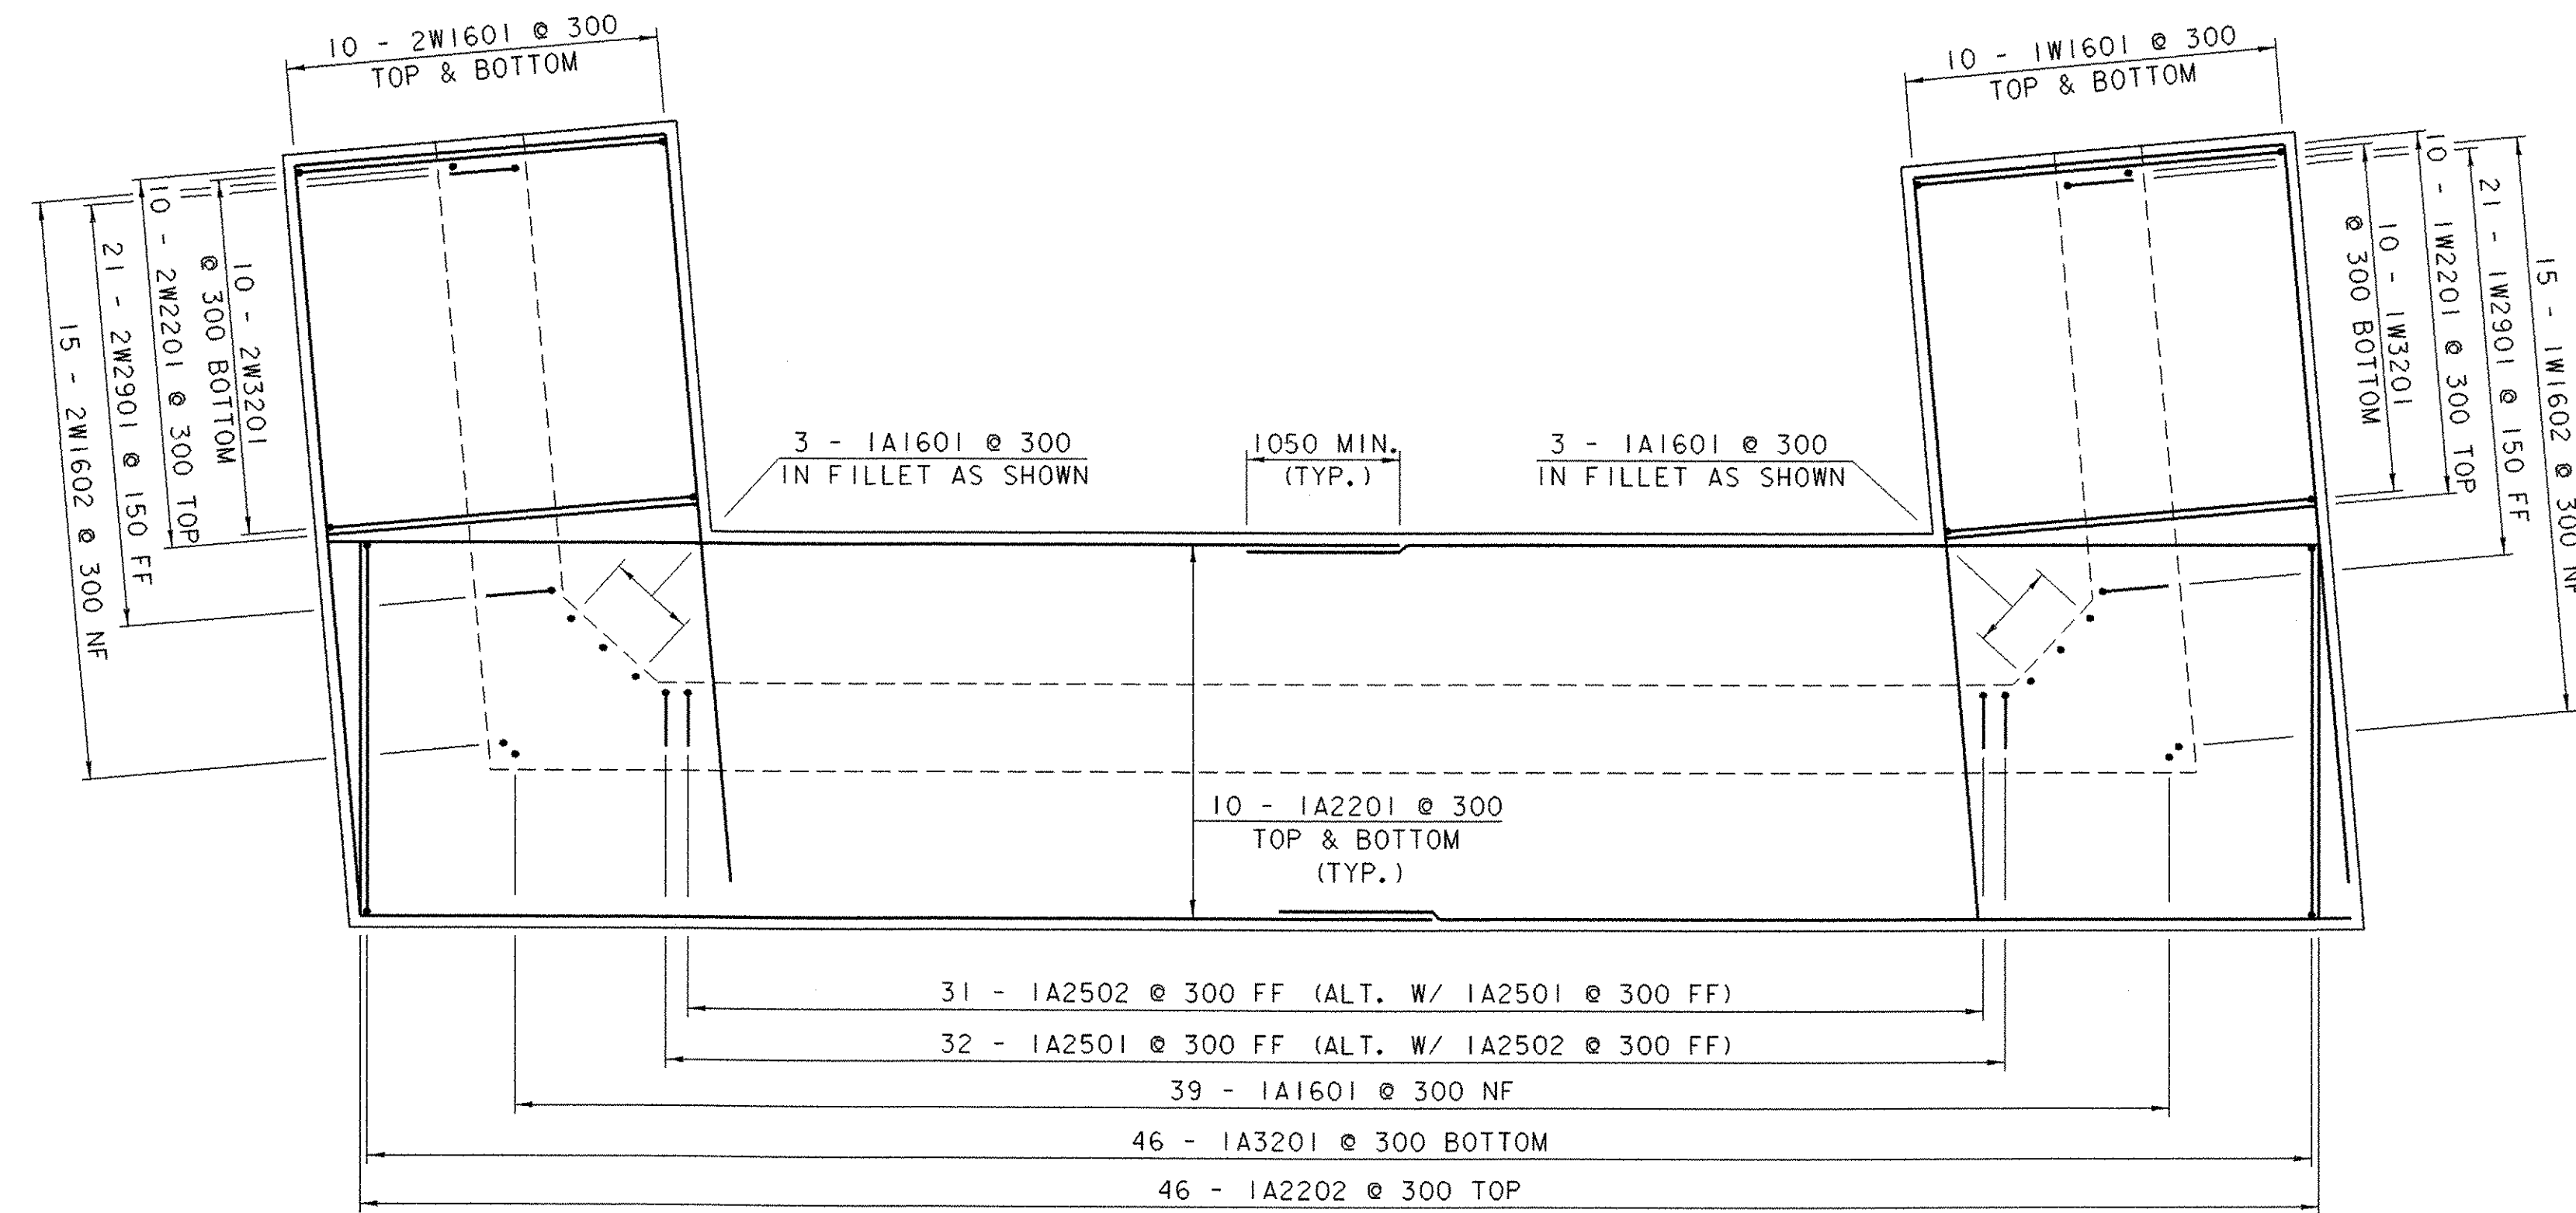

ABUTMENT NO. 1 FOOTING REINFORCING PLAN

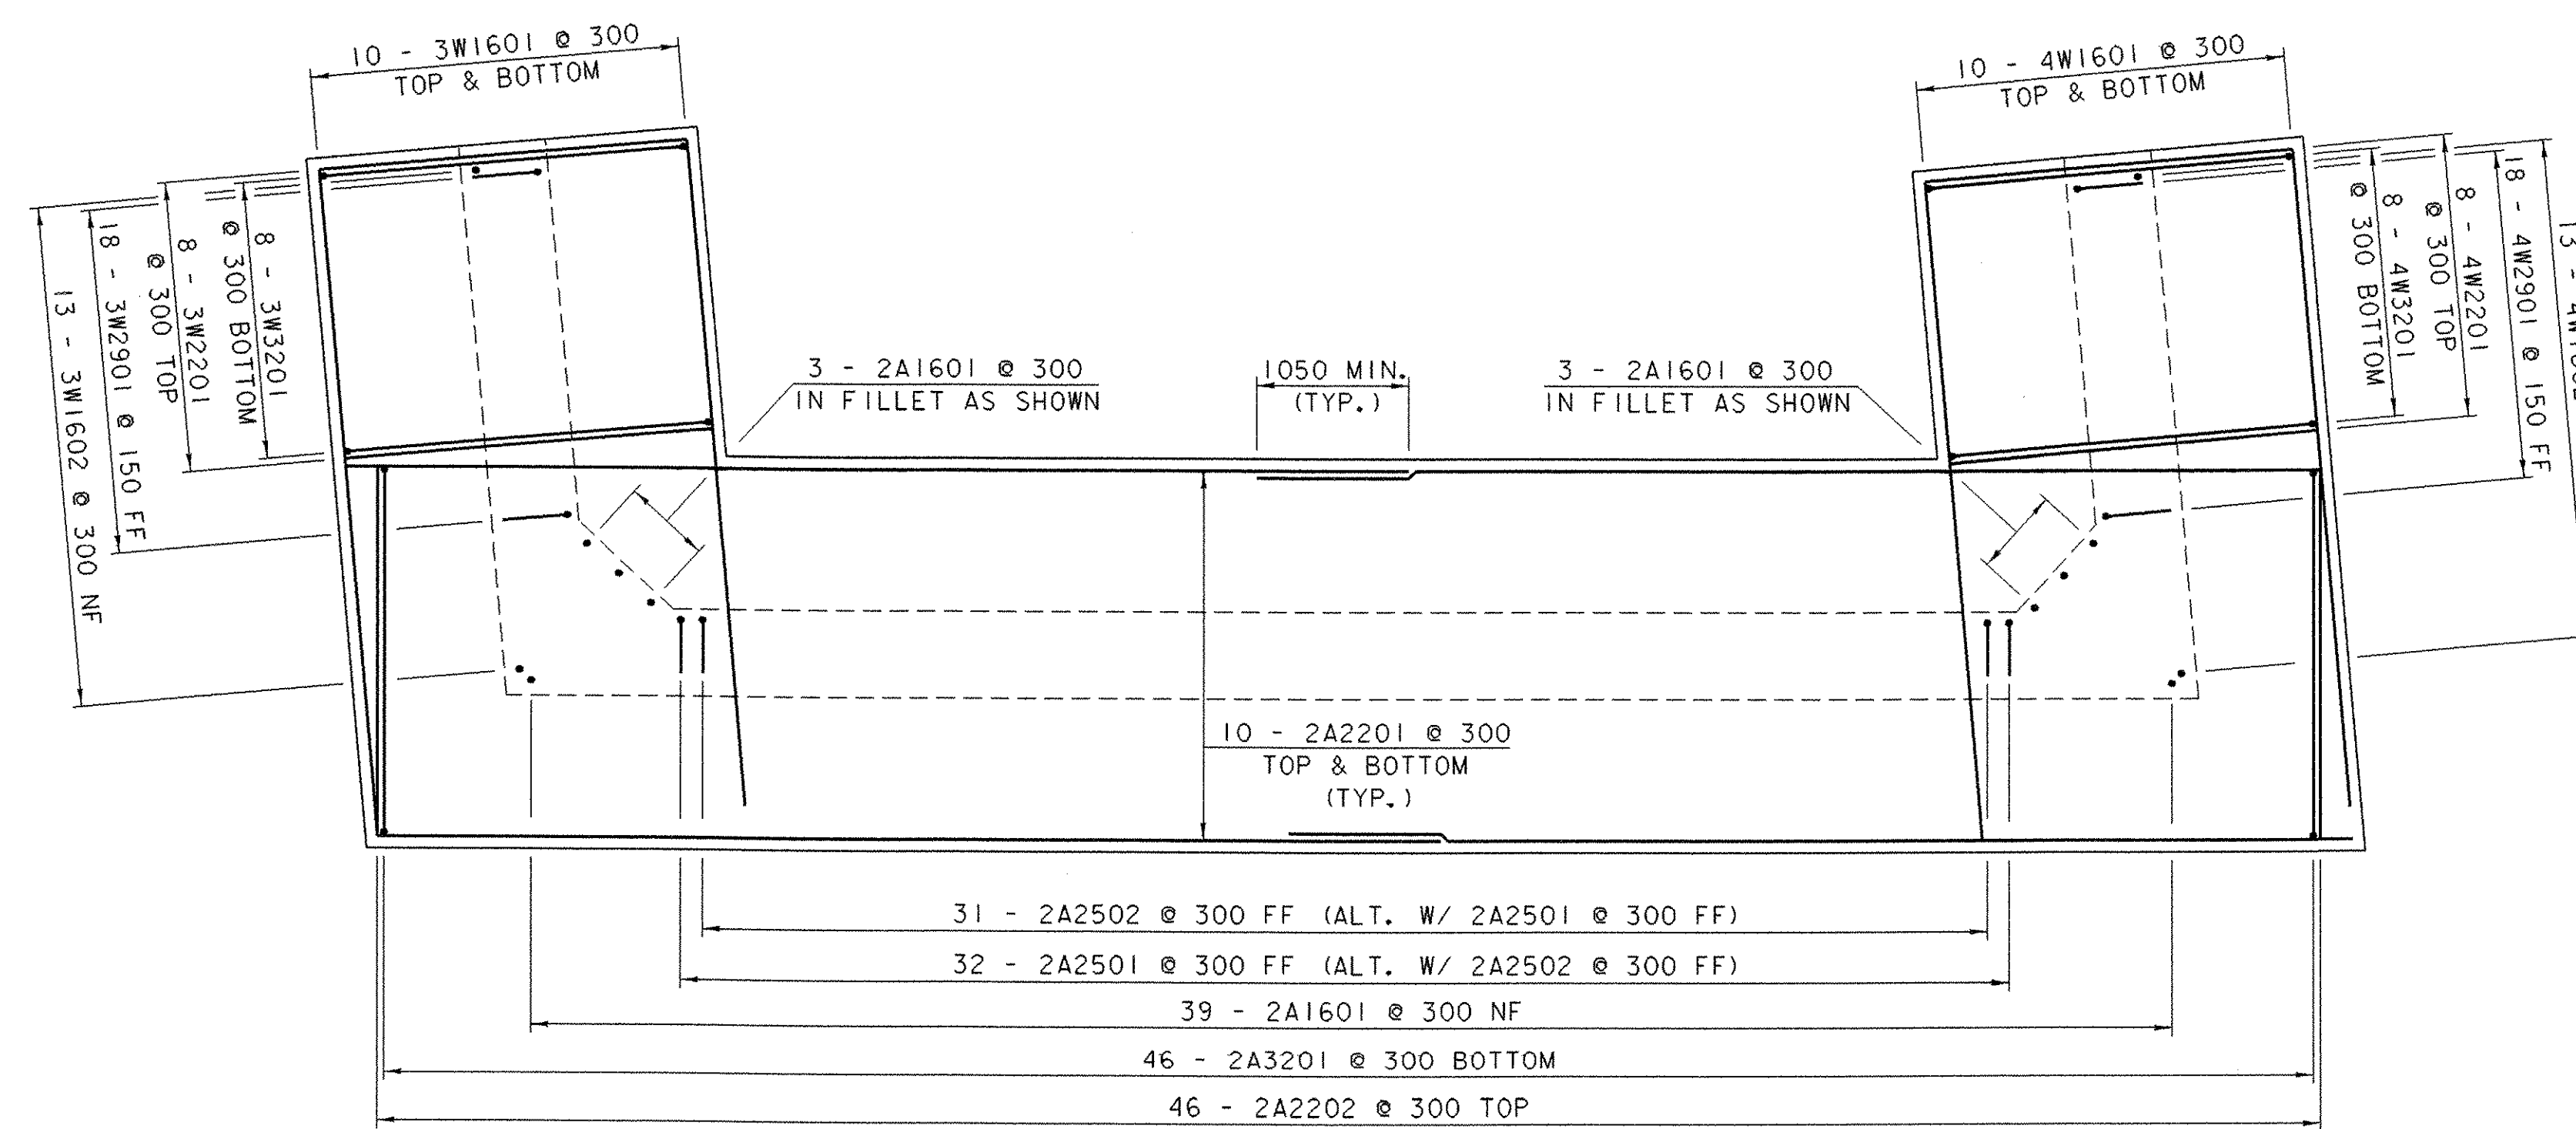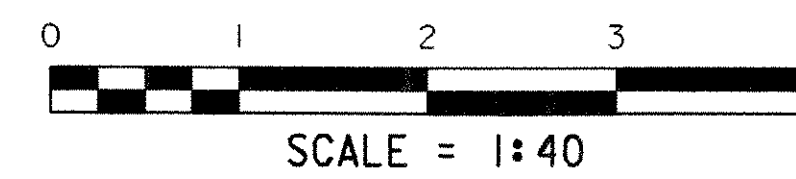


ABUTMENT NO. 2 FOOTING REINFORCING PLAN


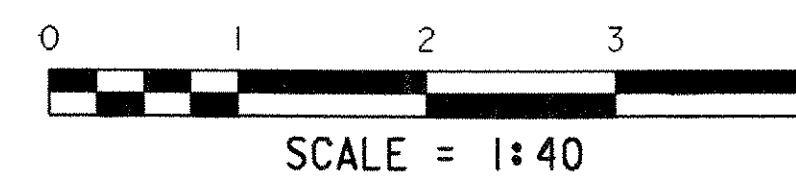


NOTE:
 NF = NEAR FACE
 FF = FAR FACE
 EF = EACH FACE
 ▲ = CUT TO FIT IN FIELD
 80 CLR. UNLESS OTHERWISE NOTED
 660 BAR LAP UNLESS OTHERWISE NOTED

SHEET NAME: FOOTING REINFORCING PLAN	
PROJECT NAME: LEICESTER	HIGHWAY NO.: TH 1
PROJECT NUMBER: BRF 0160(3)S	BRIDGE NO.: 6
	OVER: OTTER CREEK
FILE NAME: 95j288\Structures\sj288sub.dgn	PLOT DATE: 17-AUG-2005
PROJECT MANAGER: R. R. WHITCOMB	DRAWN BY: C. ROY
DESIGNED BY: C. CARLSON	IPARM NAME: sj288ftg.1
BRIDGE SHEET NUMBER:	SHEET 63 OF 90

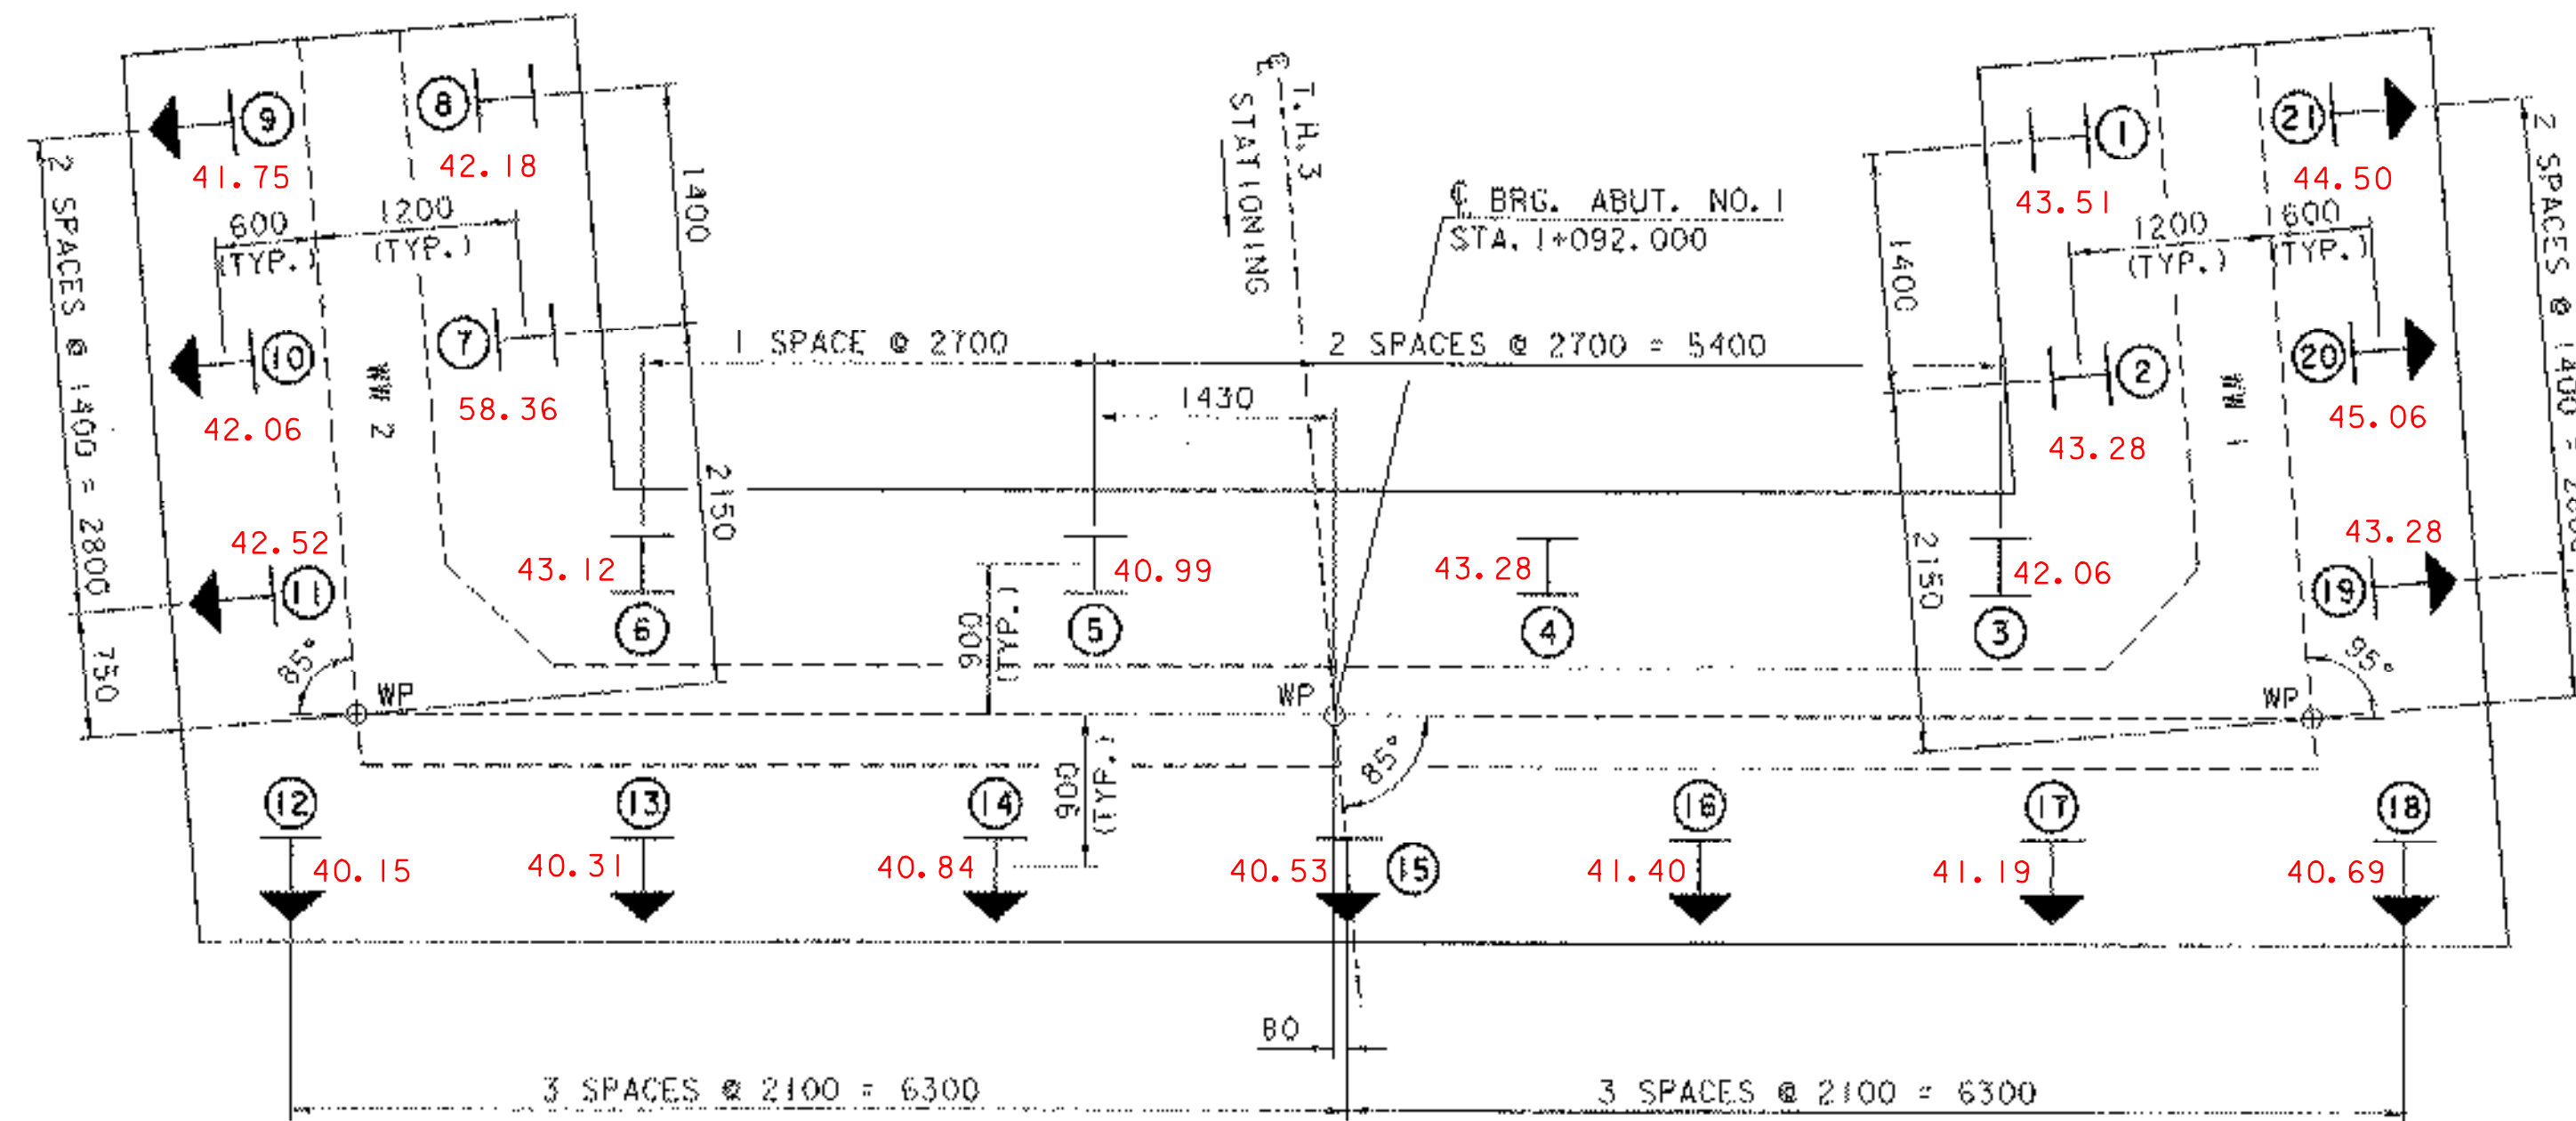

ABUTMENT NO. 1 PILE LAYOUT

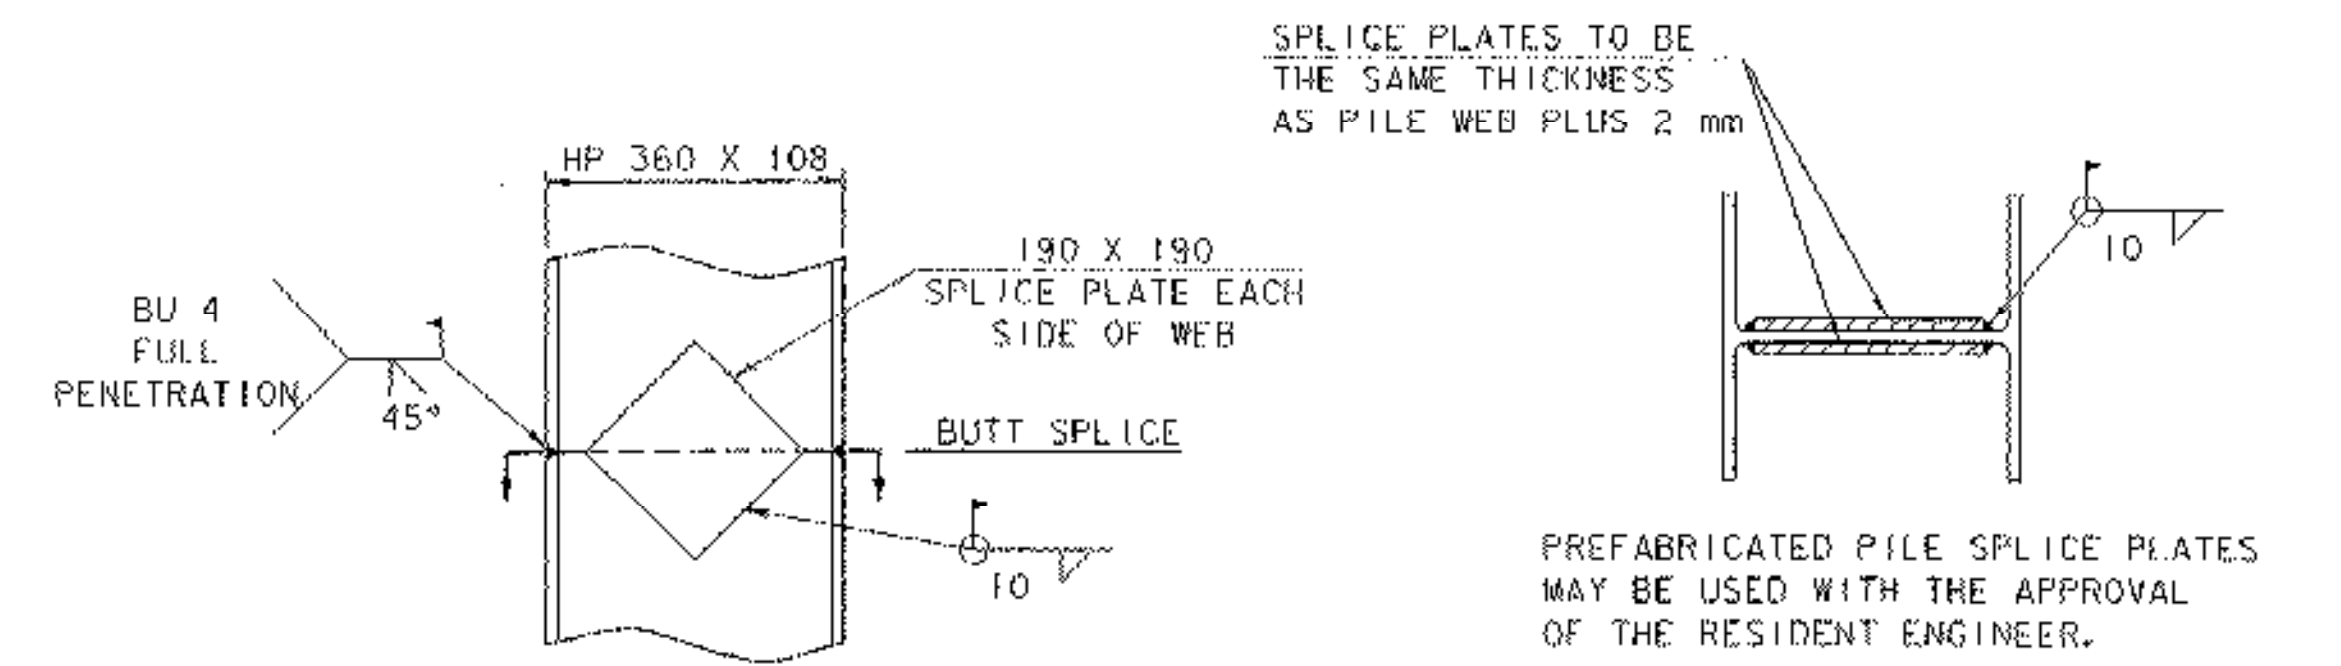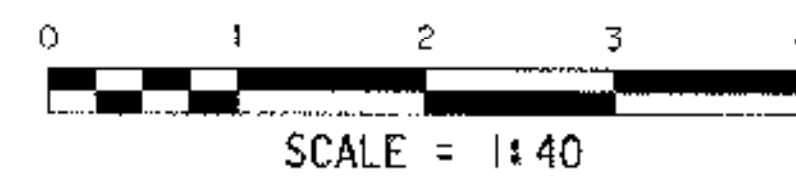


PILE SPLICE DETAIL


NOT TO SCALE

PILE NOTES


1. H - INDICATES LOCATION OF A VERTICAL H-PILE.
 2. H- - INDICATES LOCATION OF A BATTERED H-PILE 1:6.
 3. PILE SIZE: HP 360 X 108
 4. PILE STEEL: ASTM A572/A572M GR 354
 5. ULTIMATE PILE CAPACITY: 1650 KN (INCLUDES 2.75 FACTOR OF SAFETY)
- WELDING PROCEDURES TO BE APPROVED BY THE STRUCTURES ENGINEER PRIOR TO WELDING.

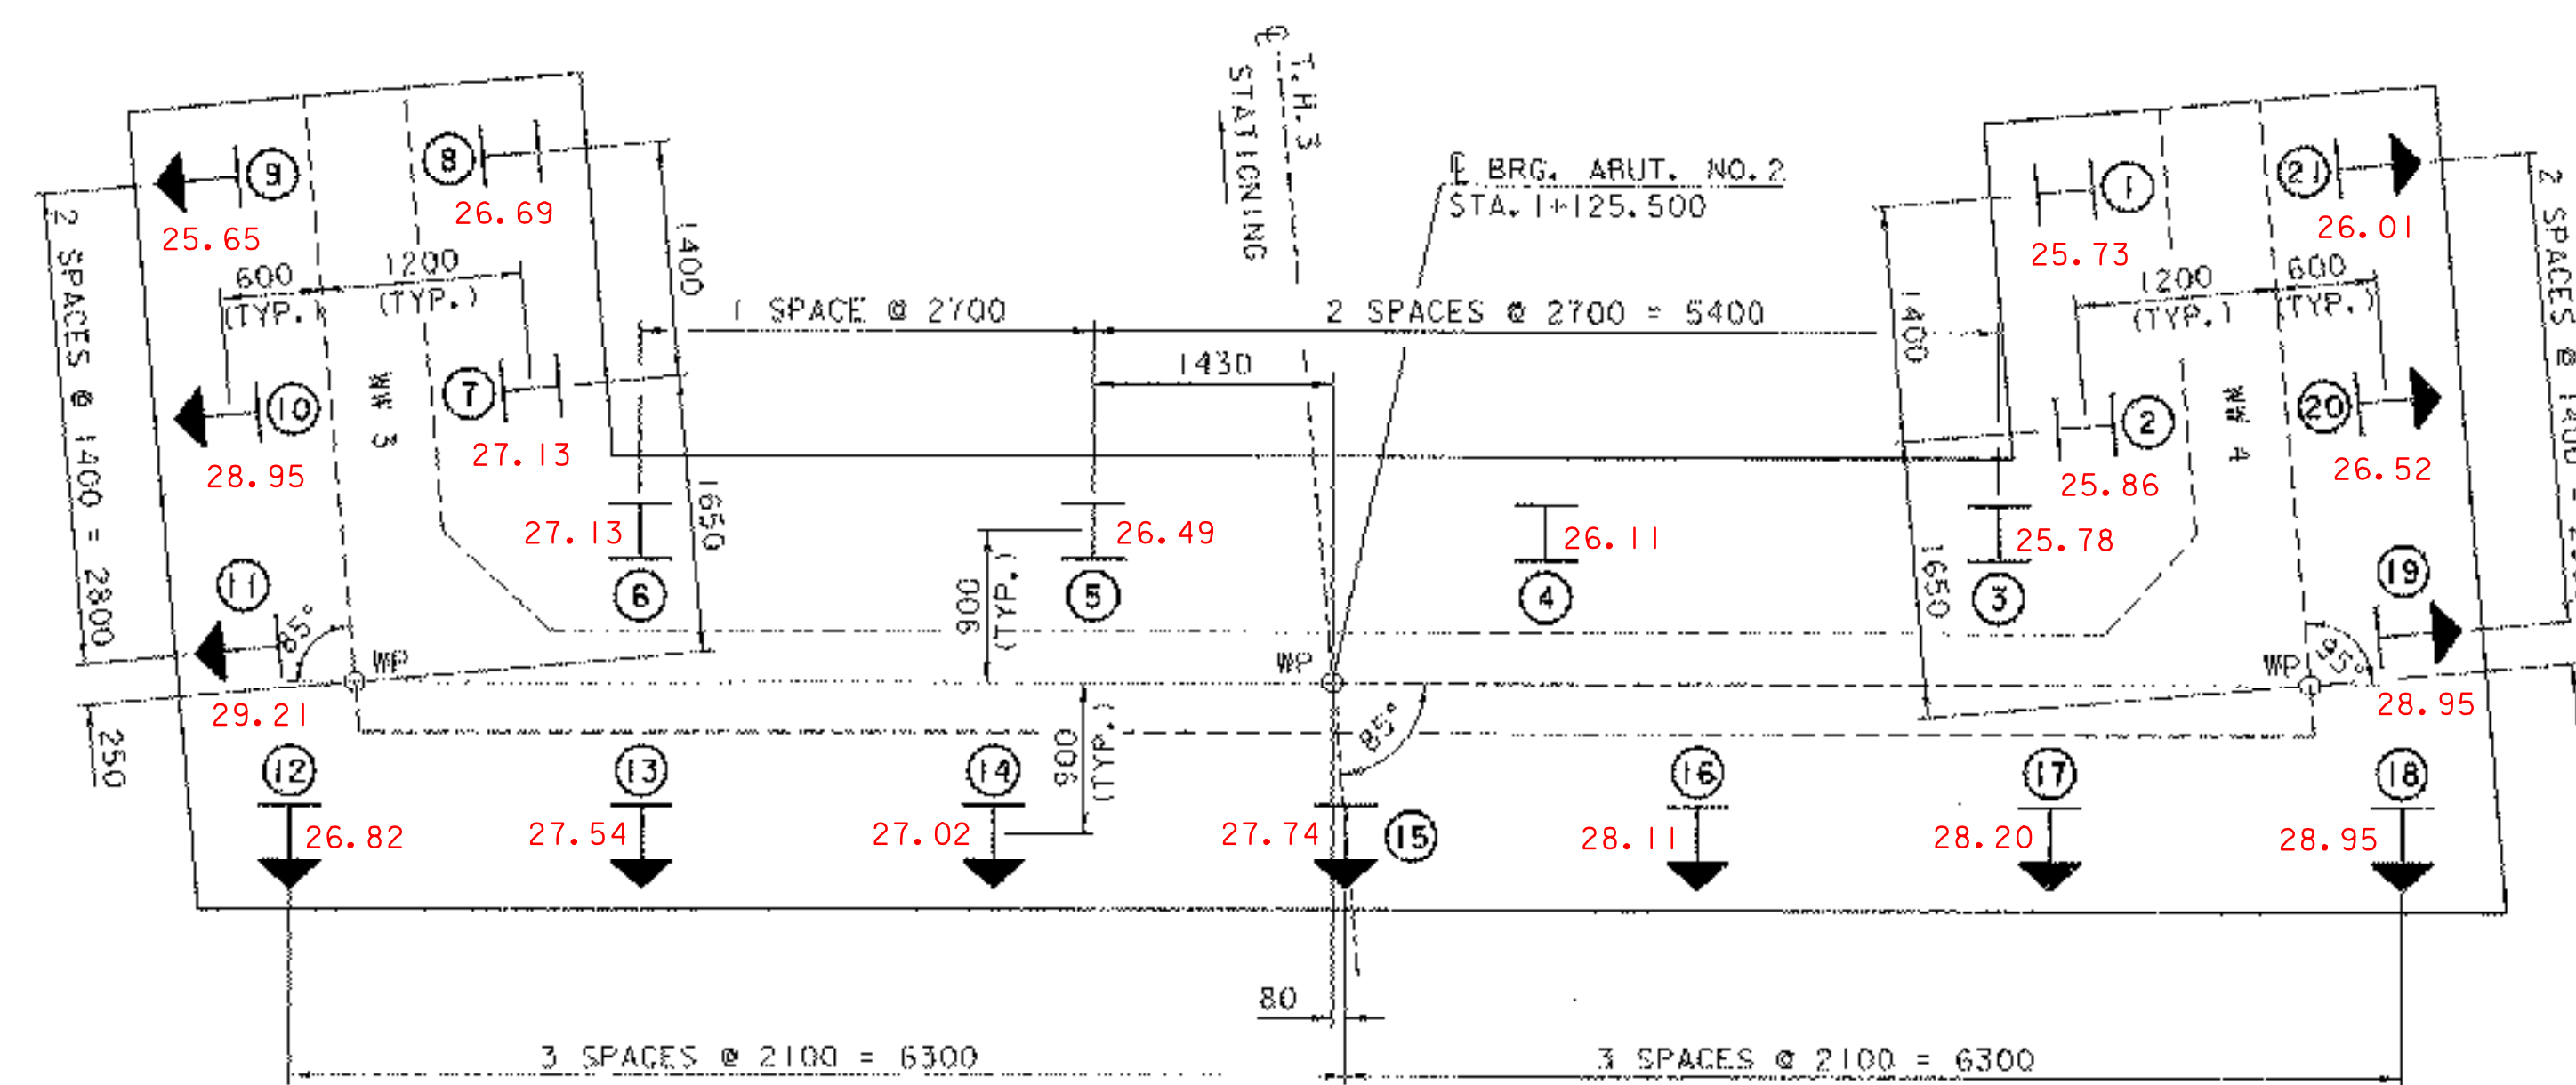

ABUTMENT NO. 2 PILE LAYOUT

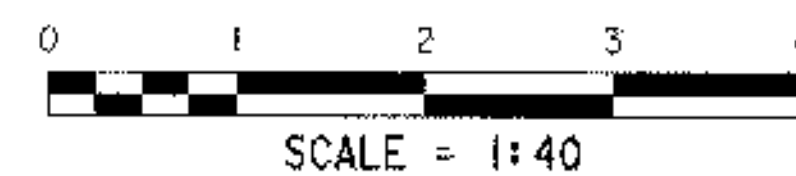

SHEET NAME: PILE LAYOUT PLAN	
PROJECT NAME: LEICESTER	HIGHWAY NO.: TH 1
PROJECT NUMBER: BRF 0160(3)S	BRIDGE NO.: 6
	OVER: OTTER CREEK
FILE NAME: 951288\Structures\s1288sub.dgn	PLOT DATE: 17-AUG-2005
PROJECT MANAGER: R. R. WHITCOMB	DRAWN BY: G. ROY
DESIGNED BY: C. CARLSON	IPARM NAME: s1288plp.j
BRIDGE SHEET NUMBER:	SHEET 64 OF 90


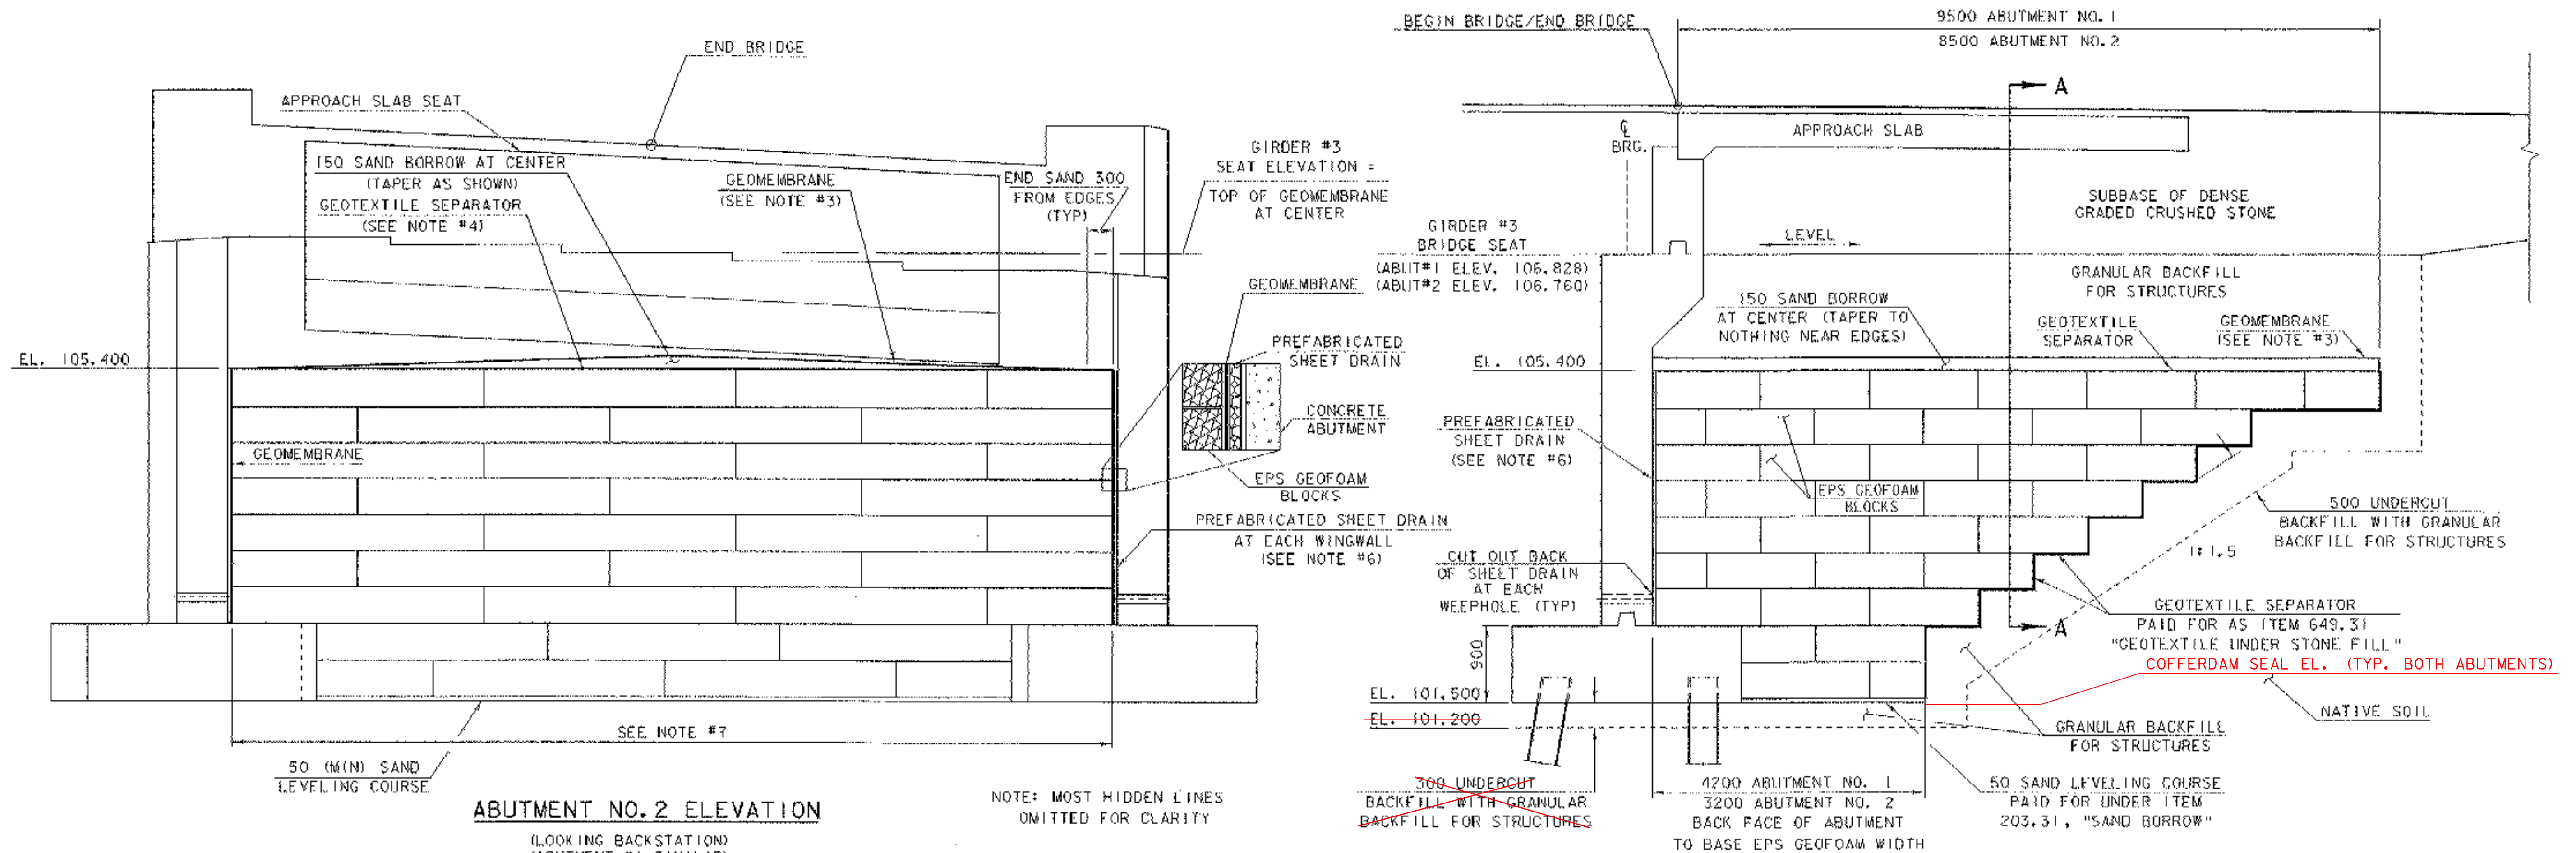


ABUTMENT NO. 2 ELEVATION
(LOOKING BACKSTATION)
(ABUTMENT #1 SIMILAR)


ABUTMENT CROSS SECTION
AT ROADWAY CENTERLINE

EPS GEOFOAM NOTES


1. EXPANDED POLYSTYRENE (EPS) GEOFOAM BLOCK CONFIGURATION AND SIZES INDICATED ARE FOR ILLUSTRATIVE PURPOSES ONLY. IN ACCORDANCE WITH THE SPECIAL PROVISIONS, ACTUAL BLOCK SIZES AND CONFIGURATION TO BE DESIGNED BY GEOFOAM BLOCK SUPPLIER AND SUBMITTED TO THE ENGINEER FOR REVIEW. ALL BLOCKS SHALL BE 100 KPA CAPACITY. EPS GEOFOAM BLOCKS SHALL BE PAID FOR UNDER ITEM 204.30, "GRANULAR BACKFILL FOR STRUCTURES (MOD. - EPS100 GEOFOAM)".
2. LIMITS OF EPS GEOFOAM BLOCKS INDICATED ARE TO BE ADHERED TO BY CUTTING BLOCKS IN THE FIELD AS REQUIRED.
3. PROVIDE DRAINAGE FROM TOP OF EPS GEOFOAM BLOCKS BY TAPERING SAND BORROW FROM 150 AT CENTER TO NOTHING 300 FROM EDGE OF BLOCKS AND COVERING WITH GEOMEMBRANE. PAY ITEM 649.11 "GEOTEXTILE FOR ROADBED SEPARATOR (MOD.)".
4. USE ITEM 649.31 "GEOTEXTILE UNDER STONE FILL" TO PROVIDE A BARRIER BETWEEN EPS GEOFOAM BLOCKS AND SAND BORROW TO PREVENT SAND FROM PENETRATING INTO THE SEAMS BETWEEN BLOCKS.
5. TIGHT SPACING AND STAGGERING SEAMS ARE CRUCIAL TO THE PERFORMANCE OF THE EPS GEOFOAM BLOCK FILL. ALL FIELD CUTS AND FITMENT SHOULD BE CAREFULLY PERFORMED.
6. INSTALL PREFABRICATED SHEET DRAIN, PAY ITEM 649.41 "GEOTEXTILE FOR UNDERDRAIN TRENCH LINING (MOD.)", BETWEEN ABUTMENT AND EPS GEOFOAM BLOCKS AS WELL AS BETWEEN WINGWALLS AND EPS GEOFOAM BLOCKS TO PROVIDE A FREE DRAINING SURFACE BETWEEN BLOCKS AND ABUTMENT. THE PREFABRICATED SHEET DRAIN SHALL BE MIRAFI CONSTRUCTION PRODUCTS GIGON SHEET DRAIN OR AN APPROVED EQUAL.
7. OVERALL WIDTH OF EPS GEOFOAM BLOCKS BETWEEN WINGWALLS WILL DEPEND UPON THICKNESS OF SHEET DRAINAGE SYSTEM CHOSEN.

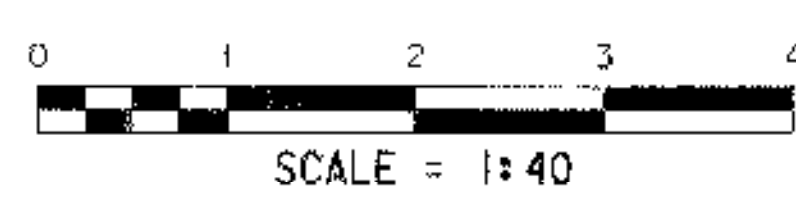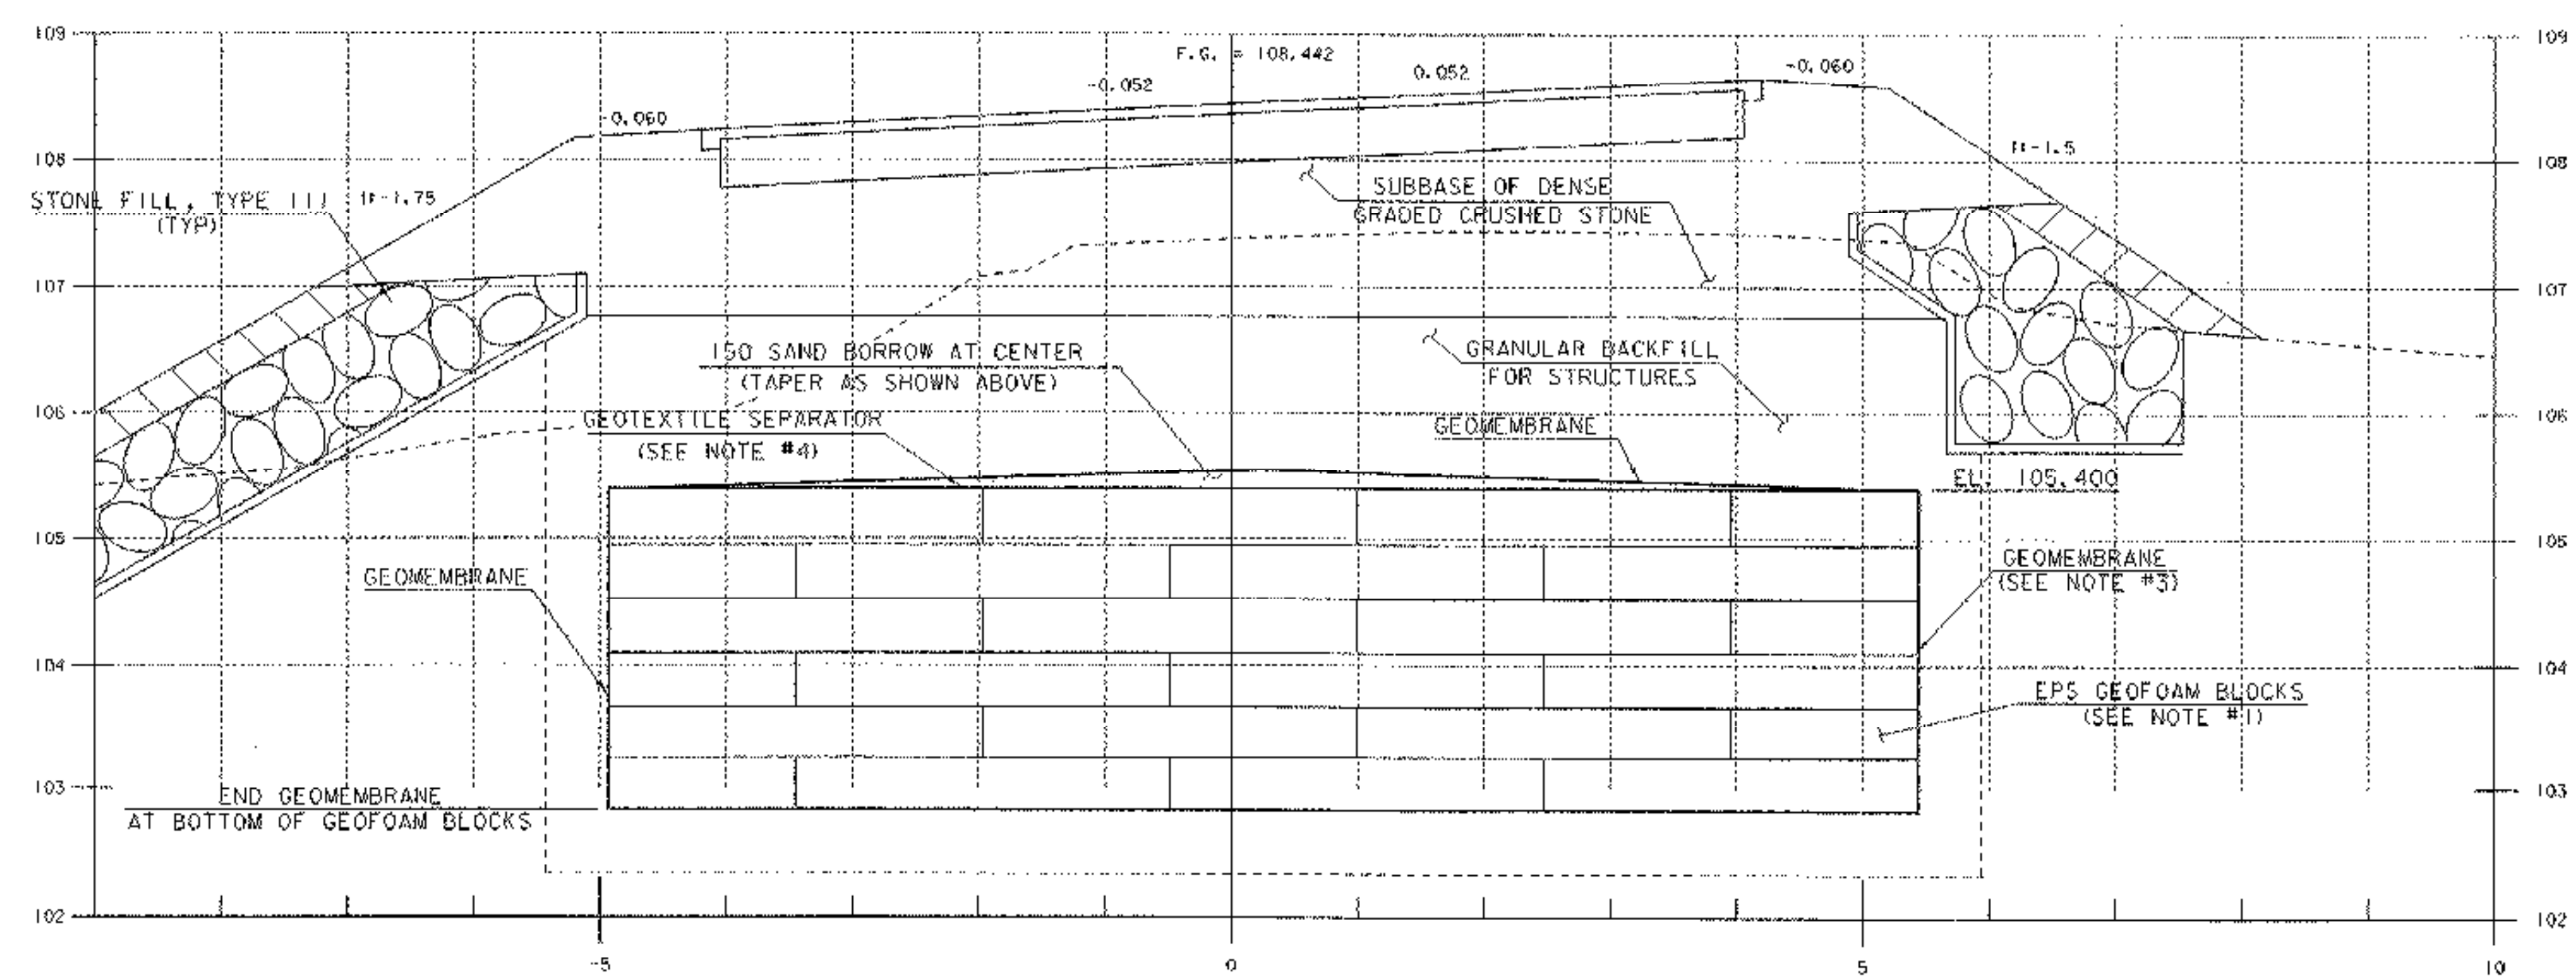

SHEET NAME: EPS GEOFOAM BLOCK DETAILS	
PROJECT NAME: LEICESTER	HIGHWAY NO.: TH 1
PROJECT NUMBER: BRF 0160(3)S	BRIDGE NO.: 6
	OVER: OTTER CREEK
FILE NAME: 95J288\Structures\sj288sub.dgn	PLOT DATE: 17-AUG-2005
PROJECT MANAGER: R. R. WHITCOMB	DRAWN BY: D. BONNEAU
DESIGNED BY: C. CARLSON	IPARM NAME: sj288eps.1
BRIDGE SHEET NUMBER:	SHEET 65 OF 90

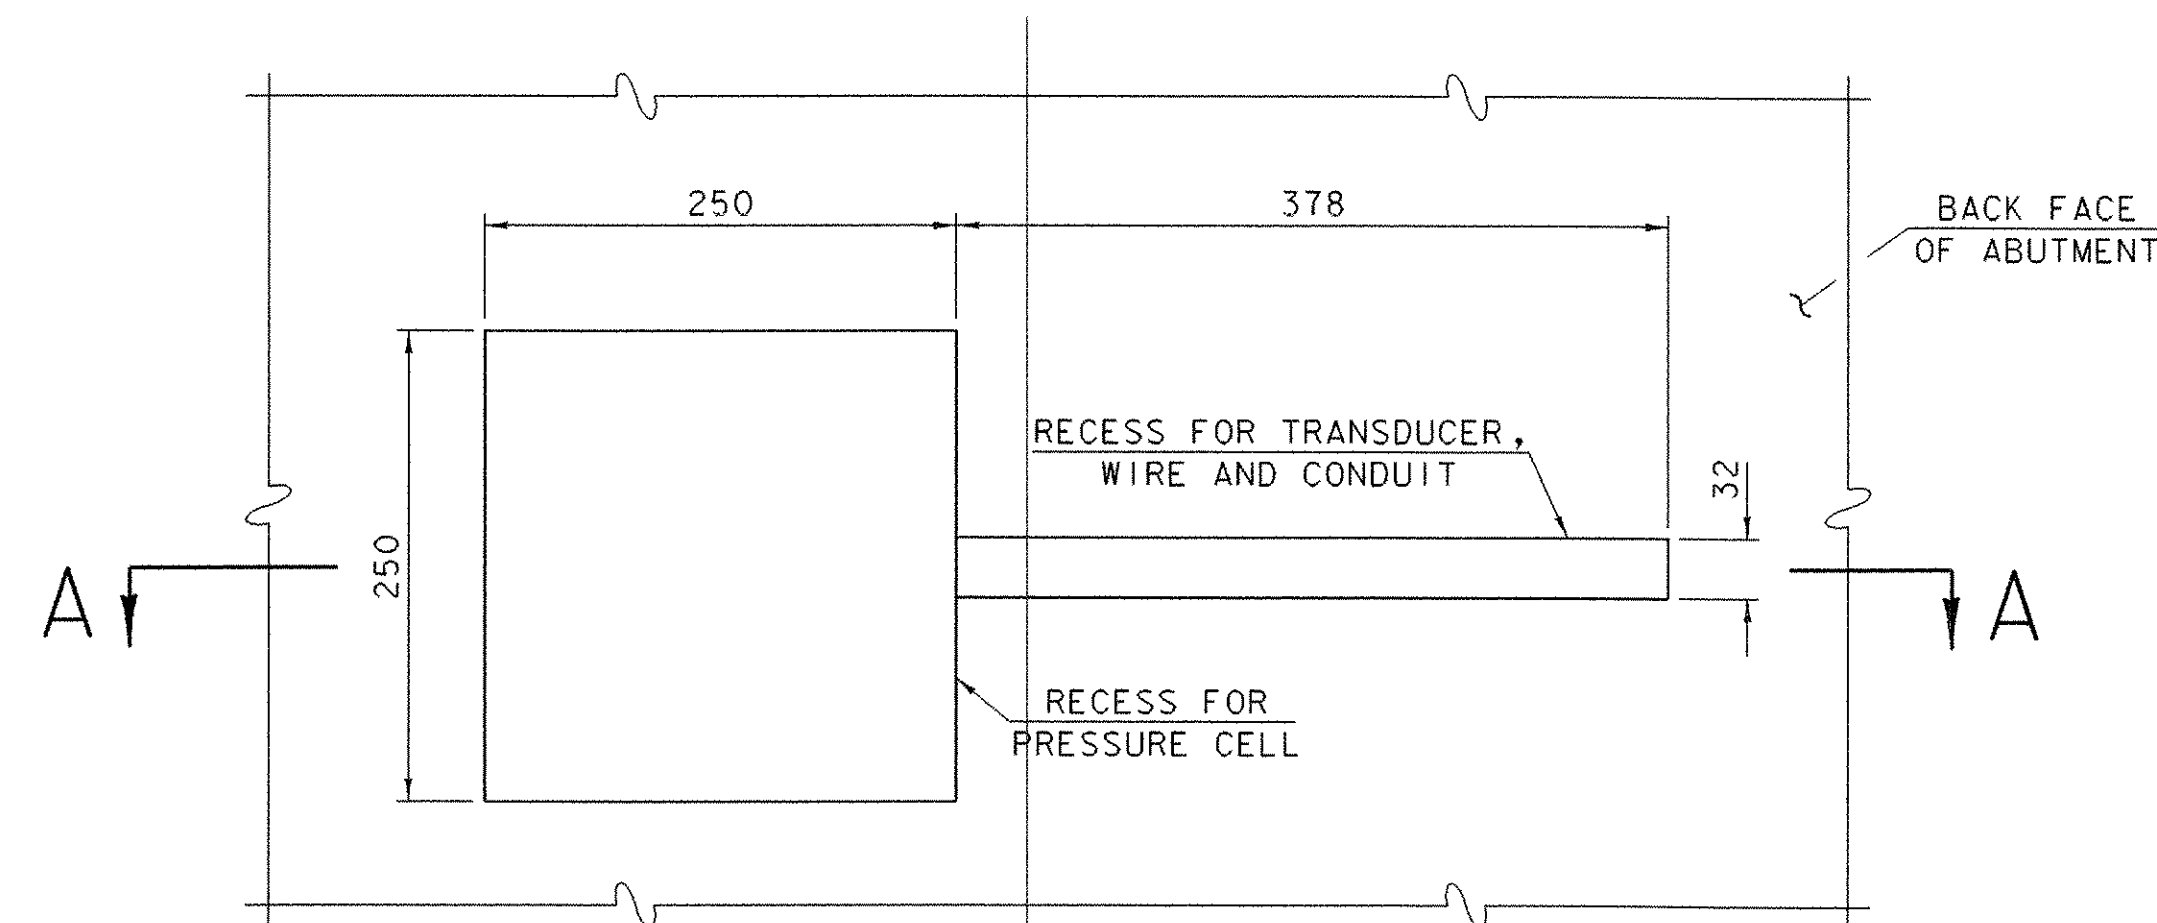


ELEVATION

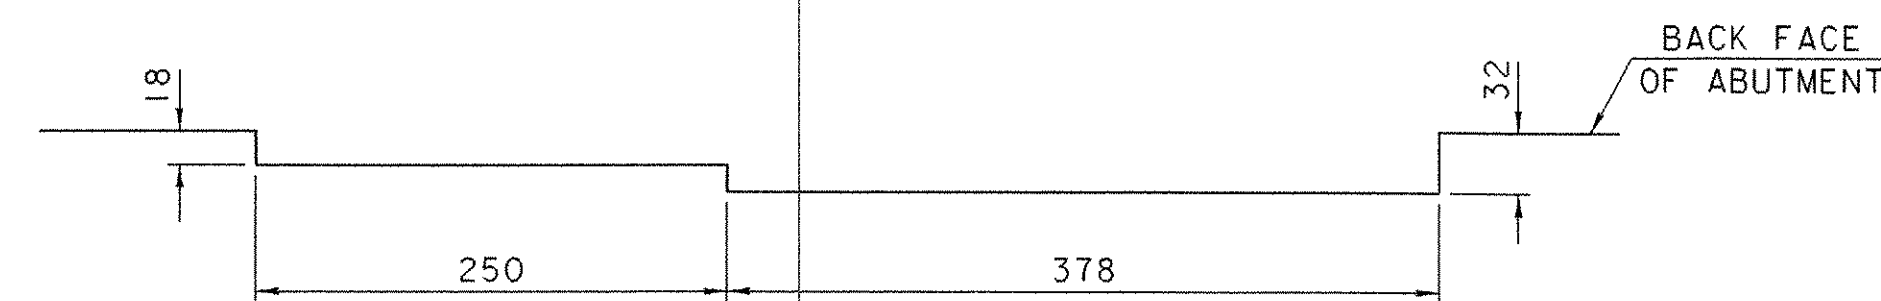

SECTION "A-A"


CONCRETE RECESS FOR EARTH PRESSURE CELL

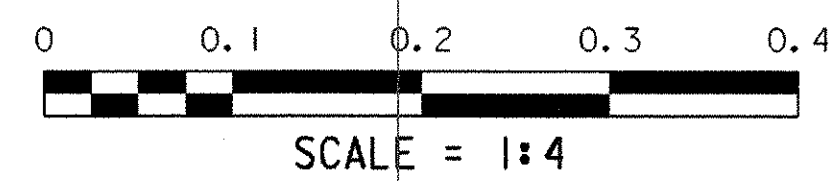


(CONCRETE RECESS SHALL BE PROVIDED FOR EARTH PRESSURE CELLS 1A2, 1A3, 2A2, AND 2A3)

NOTES:

1. PRESSURE CELLS 1A1 - 1A4 AND 2A1 - 2A4 ARE TO BE PLACED AT ROADWAY CENTERLINE. ALSO CELLS 1A1 AND 2A1 SHALL BE AT TOP OF SAND LEVELING COURSE.
2. PRESSURE CELLS 1A5 AND 2A5 ARE TO BE PLACED 1000 LEFT OF ROADWAY CENTERLINE AND TOP OF EPS GEOFOAM BLOCKS BELOW SAND BORROW.
3. PRESSURE CELLS 1A6 AND 2A6 ARE TO BE PLACED 1000 RIGHT OF ROADWAY CENTERLINE. AND TOP OF EPS GEOFOAM BLOCKS BELOW SAND BORROW.


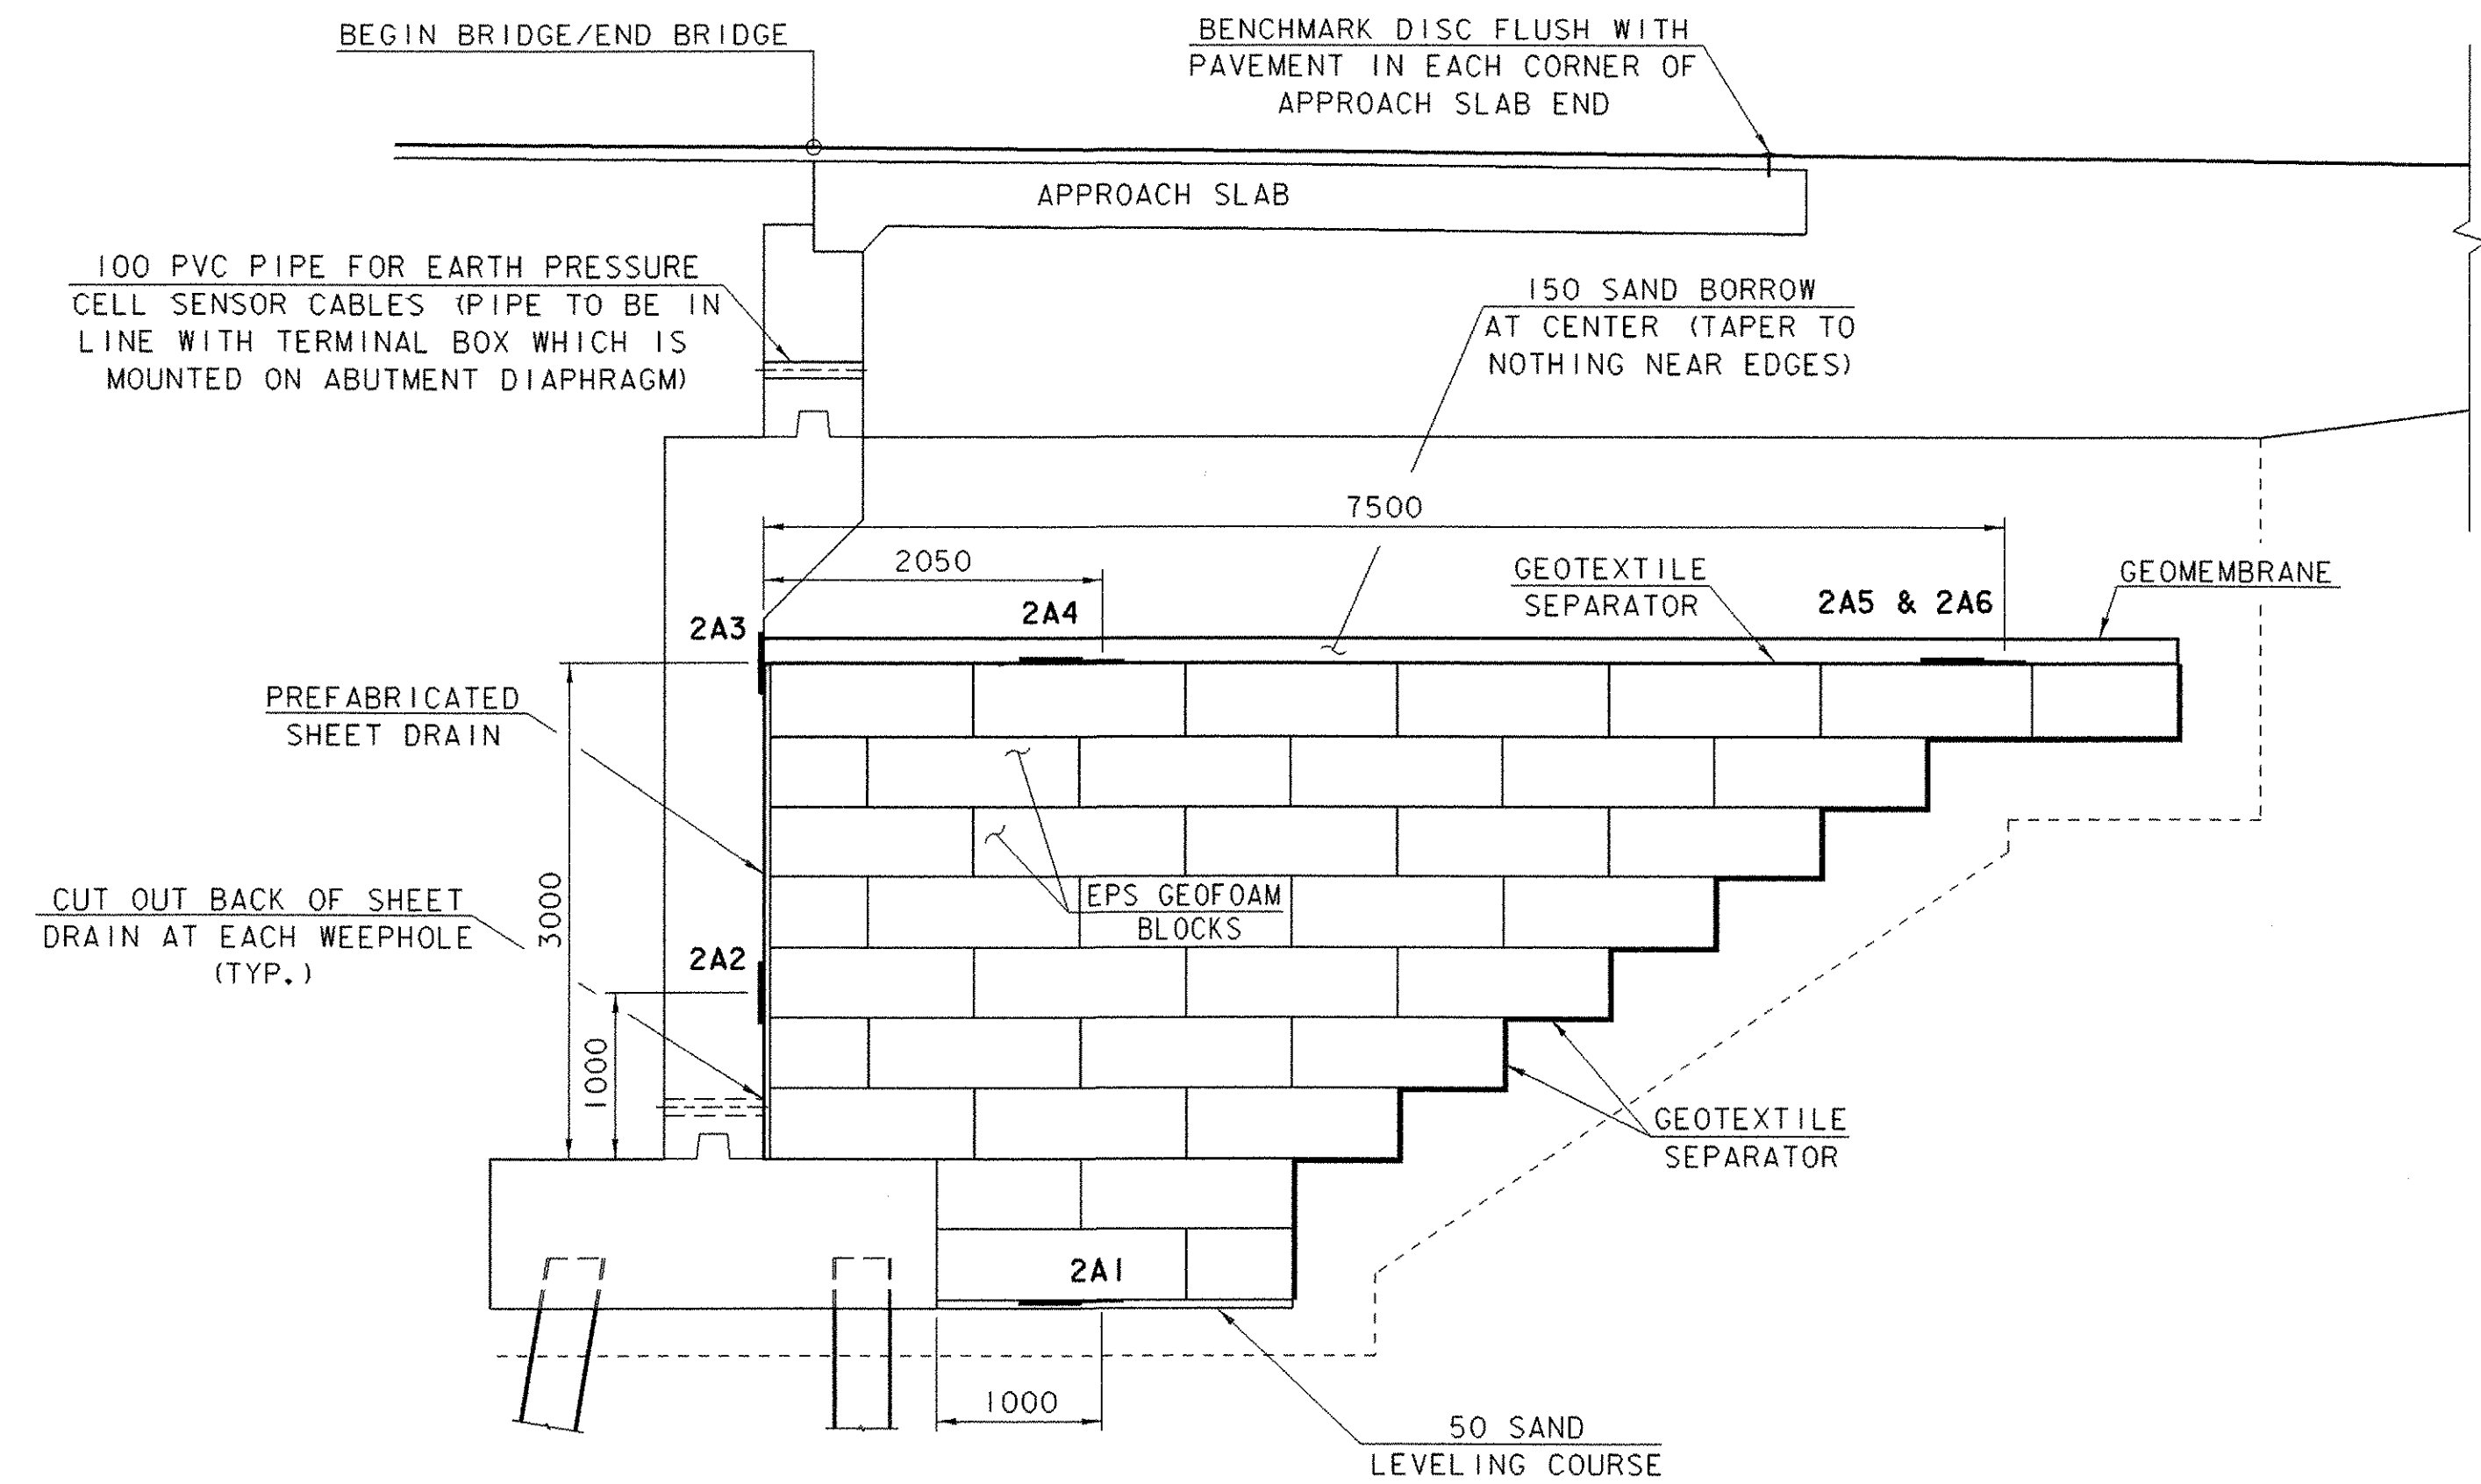


EARTH PRESSURE CELL LOCATIONS AT ABUTMENT NO. 2

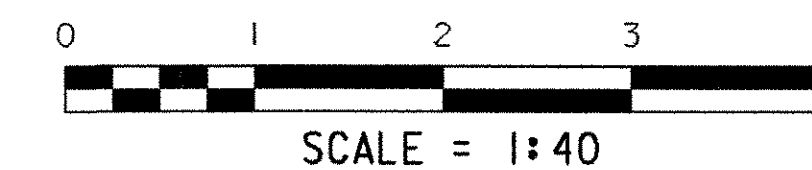

(ABUTMENT NO. 1 SIMILAR EXCEPT EARTH PRESSURE CELLS START WITH 1A INSTEAD OF 2A)

SHEET NAME: EARTH PRESSURE CELL DETAILS	
PROJECT NAME: LEICESTER	HIGHWAY NO.: TH 1
PROJECT NUMBER: BRF 0160(3)S	BRIDGE NO.: 6
	OVER: OTTER CREEK
FILE NAME: 95J288\Structures\sj288sub.dgn	PLOT DATE: 17-AUG-2005
PROJECT MANAGER: R. R. WHITCOMB	DRAWN BY: G. ROY
DESIGNED BY: C. CARLSON	IPARM NAME: sj288epod.i
BRIDGE SHEET NUMBER:	SHEET 65a OF 90

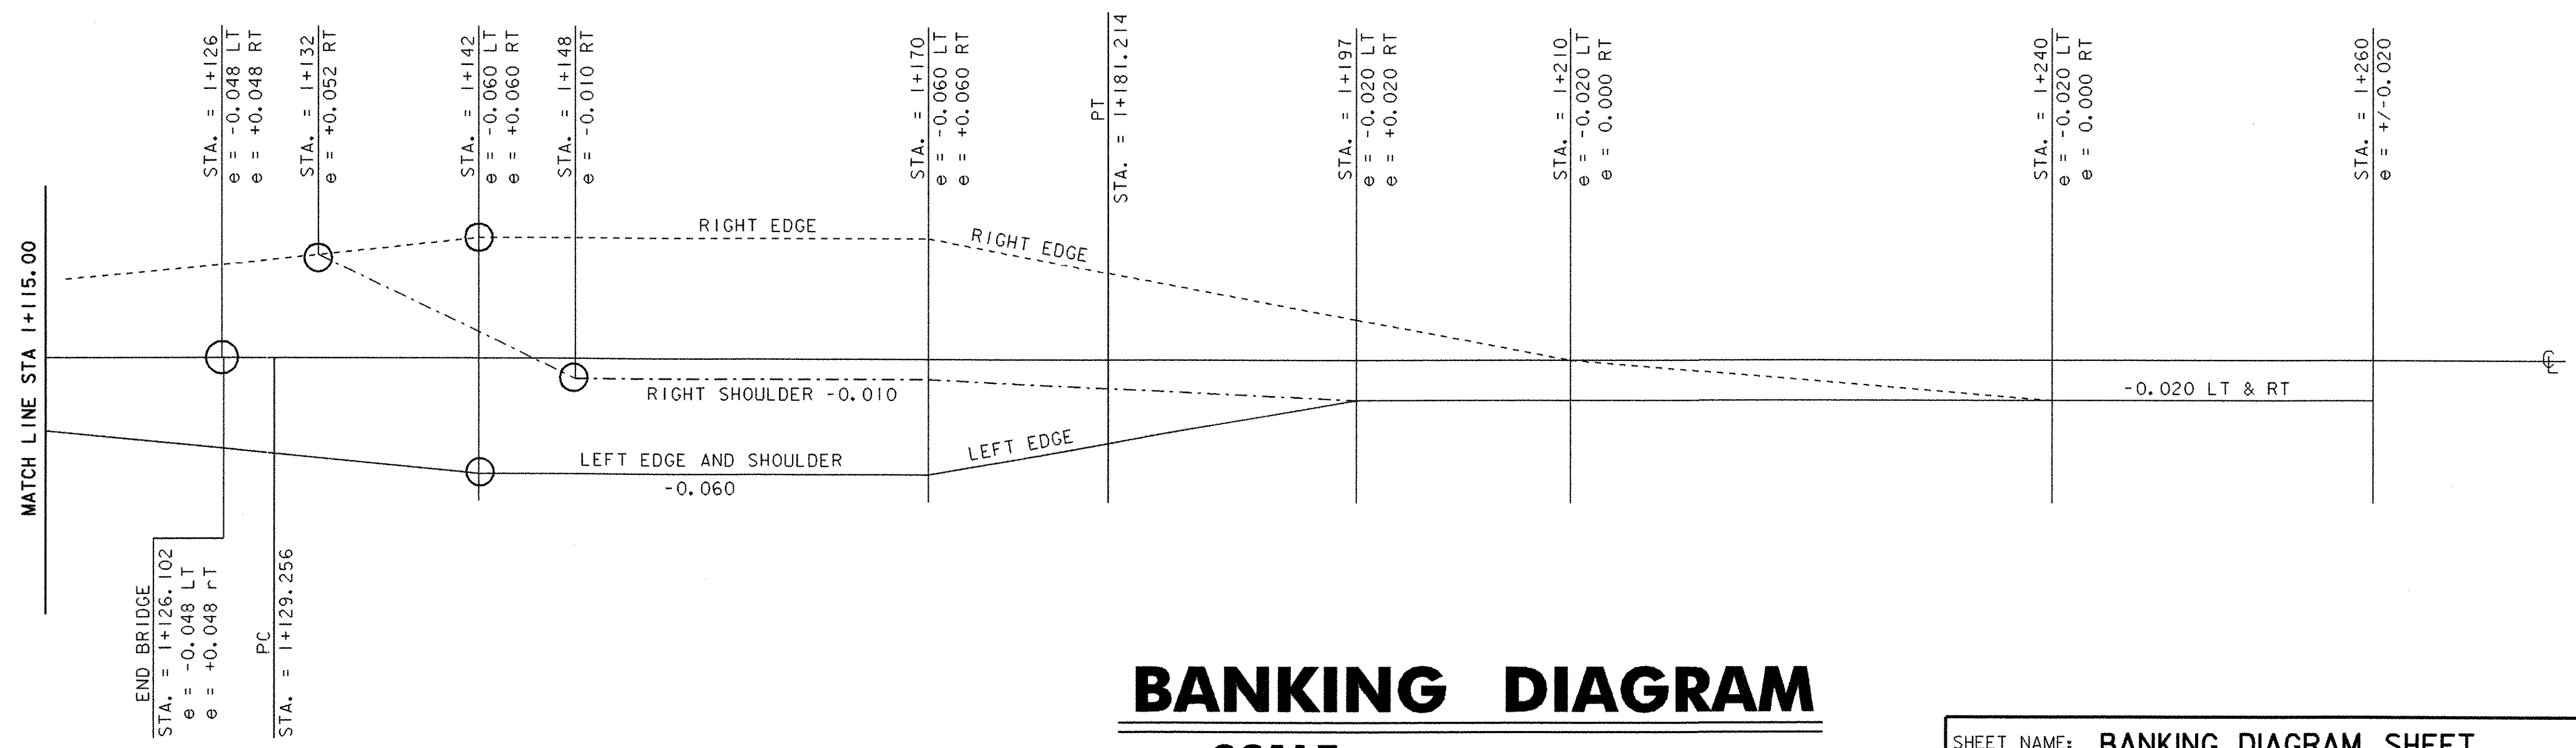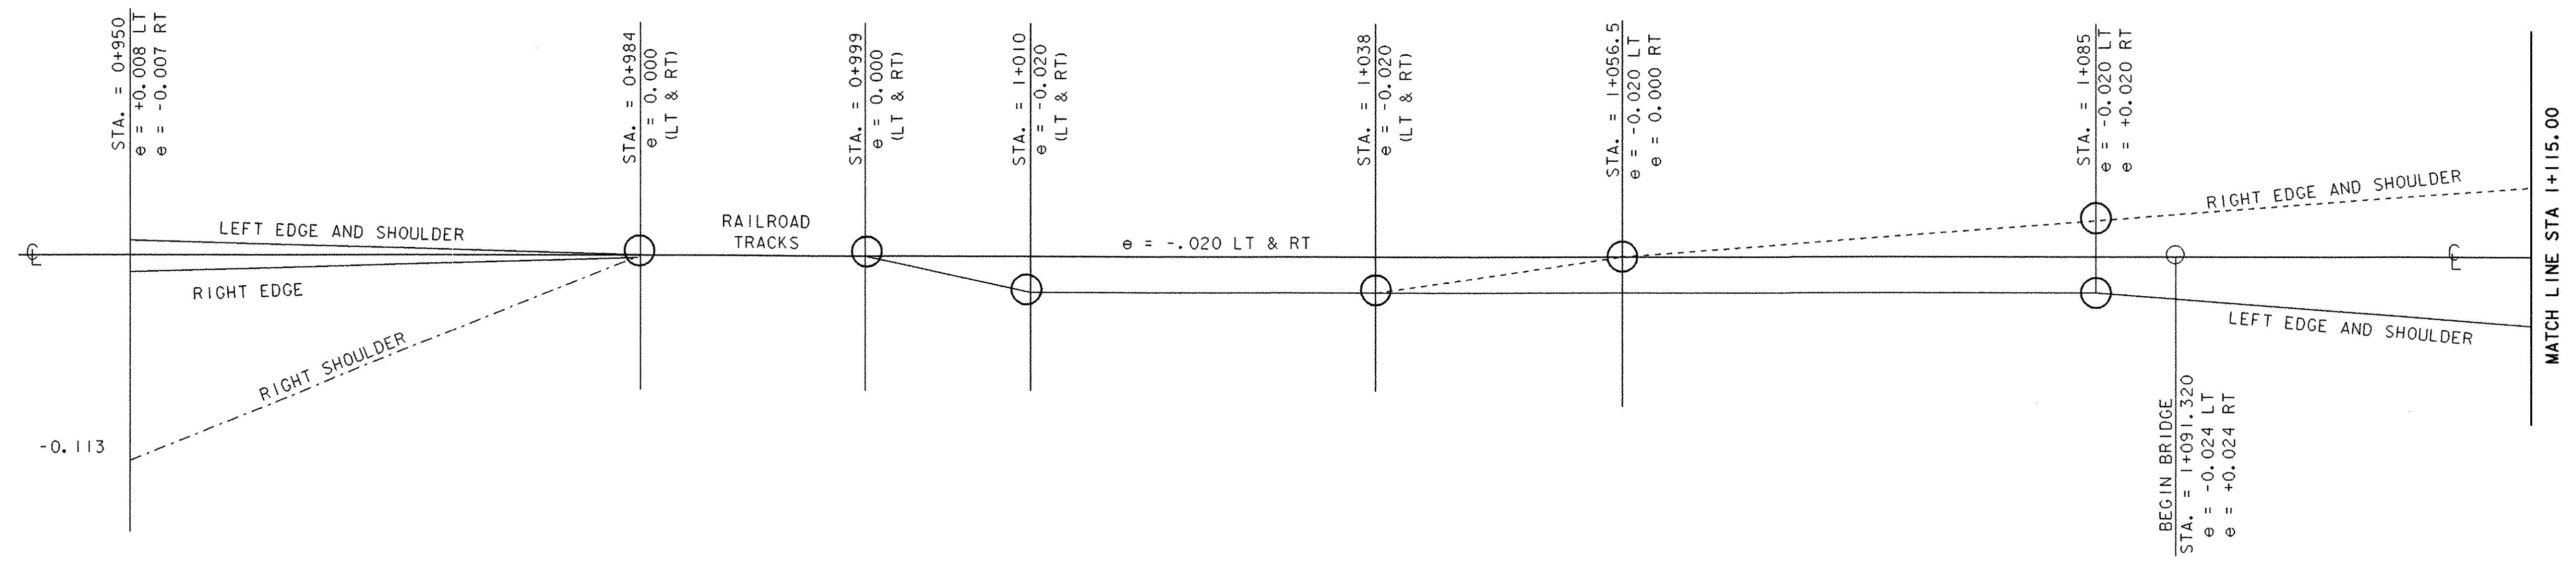

BANKING DIAGRAM

SCALE:
1:250 HORIZONTALLY
1:10 VERTICALLY


SHEET NAME: BANKING DIAGRAM SHEET	
PROJECT NAME: LEICESTER	HIGHWAY NO.: FAS 0160
PROJECT NUMBER: BRF 0160(3)S	BRIDGE NO.: 6
	OVER: OTTER CREEK
FILE NAME: 95J288\Structures\sj288xsl.dgn	PLOT DATE: 17-AUG-2005
PROJECT MANAGER: R. R. WHITCOMB	DRAWN BY: J. GILMORE
DESIGNED BY: C. CARLSON	IPARM NAME: sj088bd.1
	SHEET 67 OF 90

BEGIN APPROACH STA 0+950
END APPROACH STA 1+260






STA 0+955.000
STA 1+256.250

STA 0+972.000
STA 1+240.500






STA 0+975.000
STA 1+237.500

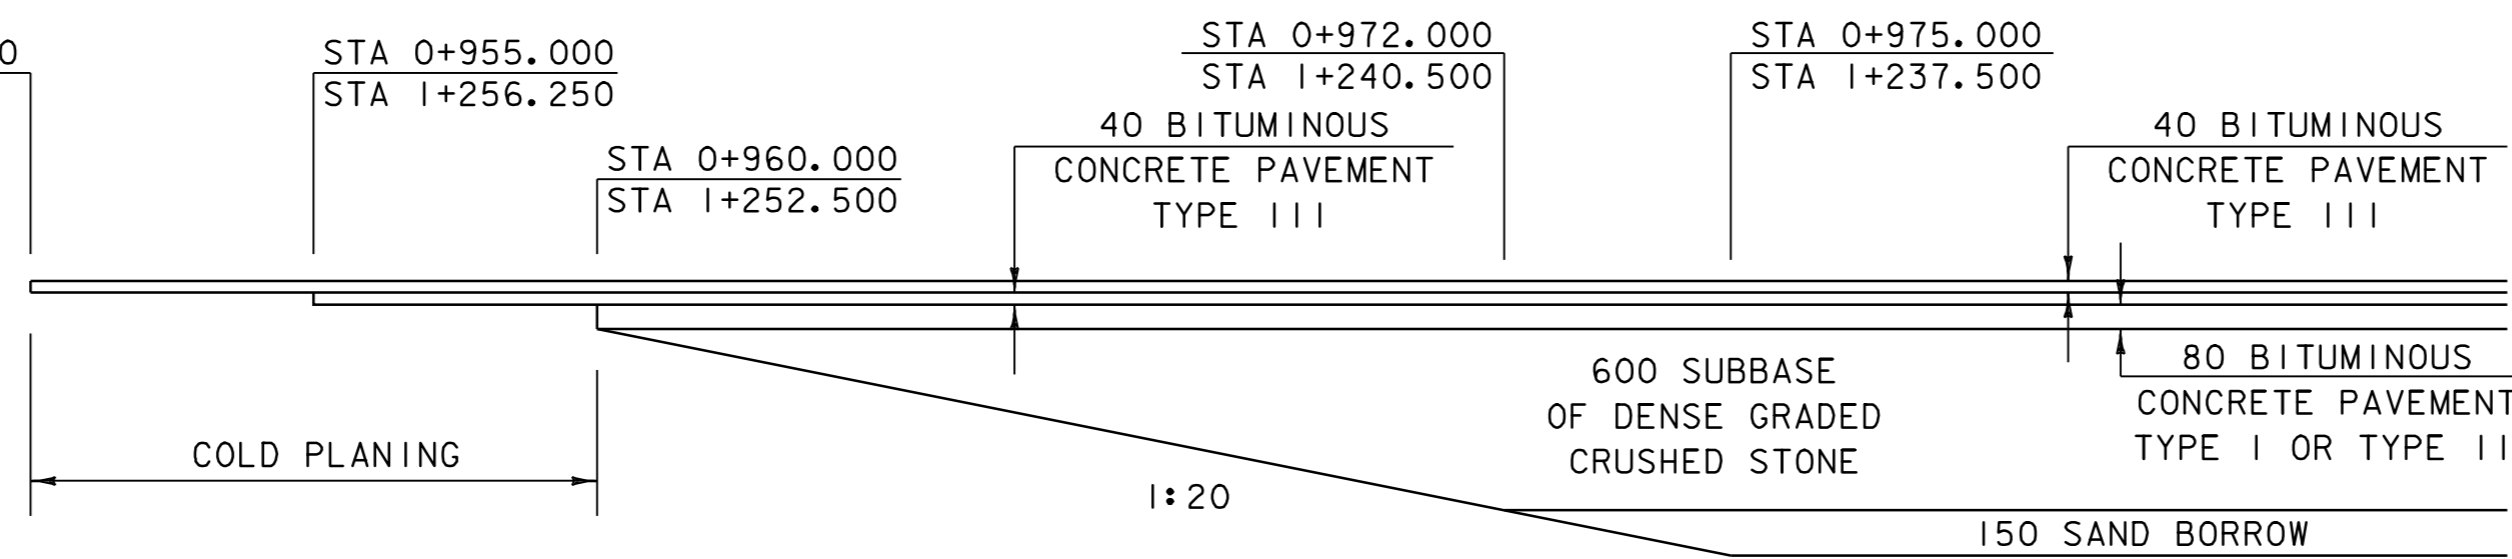


SUBBASE TRANSITION DIAGRAM
N. T. S.

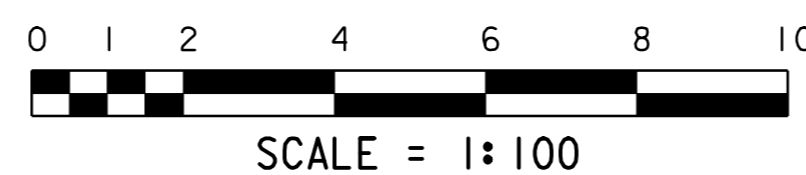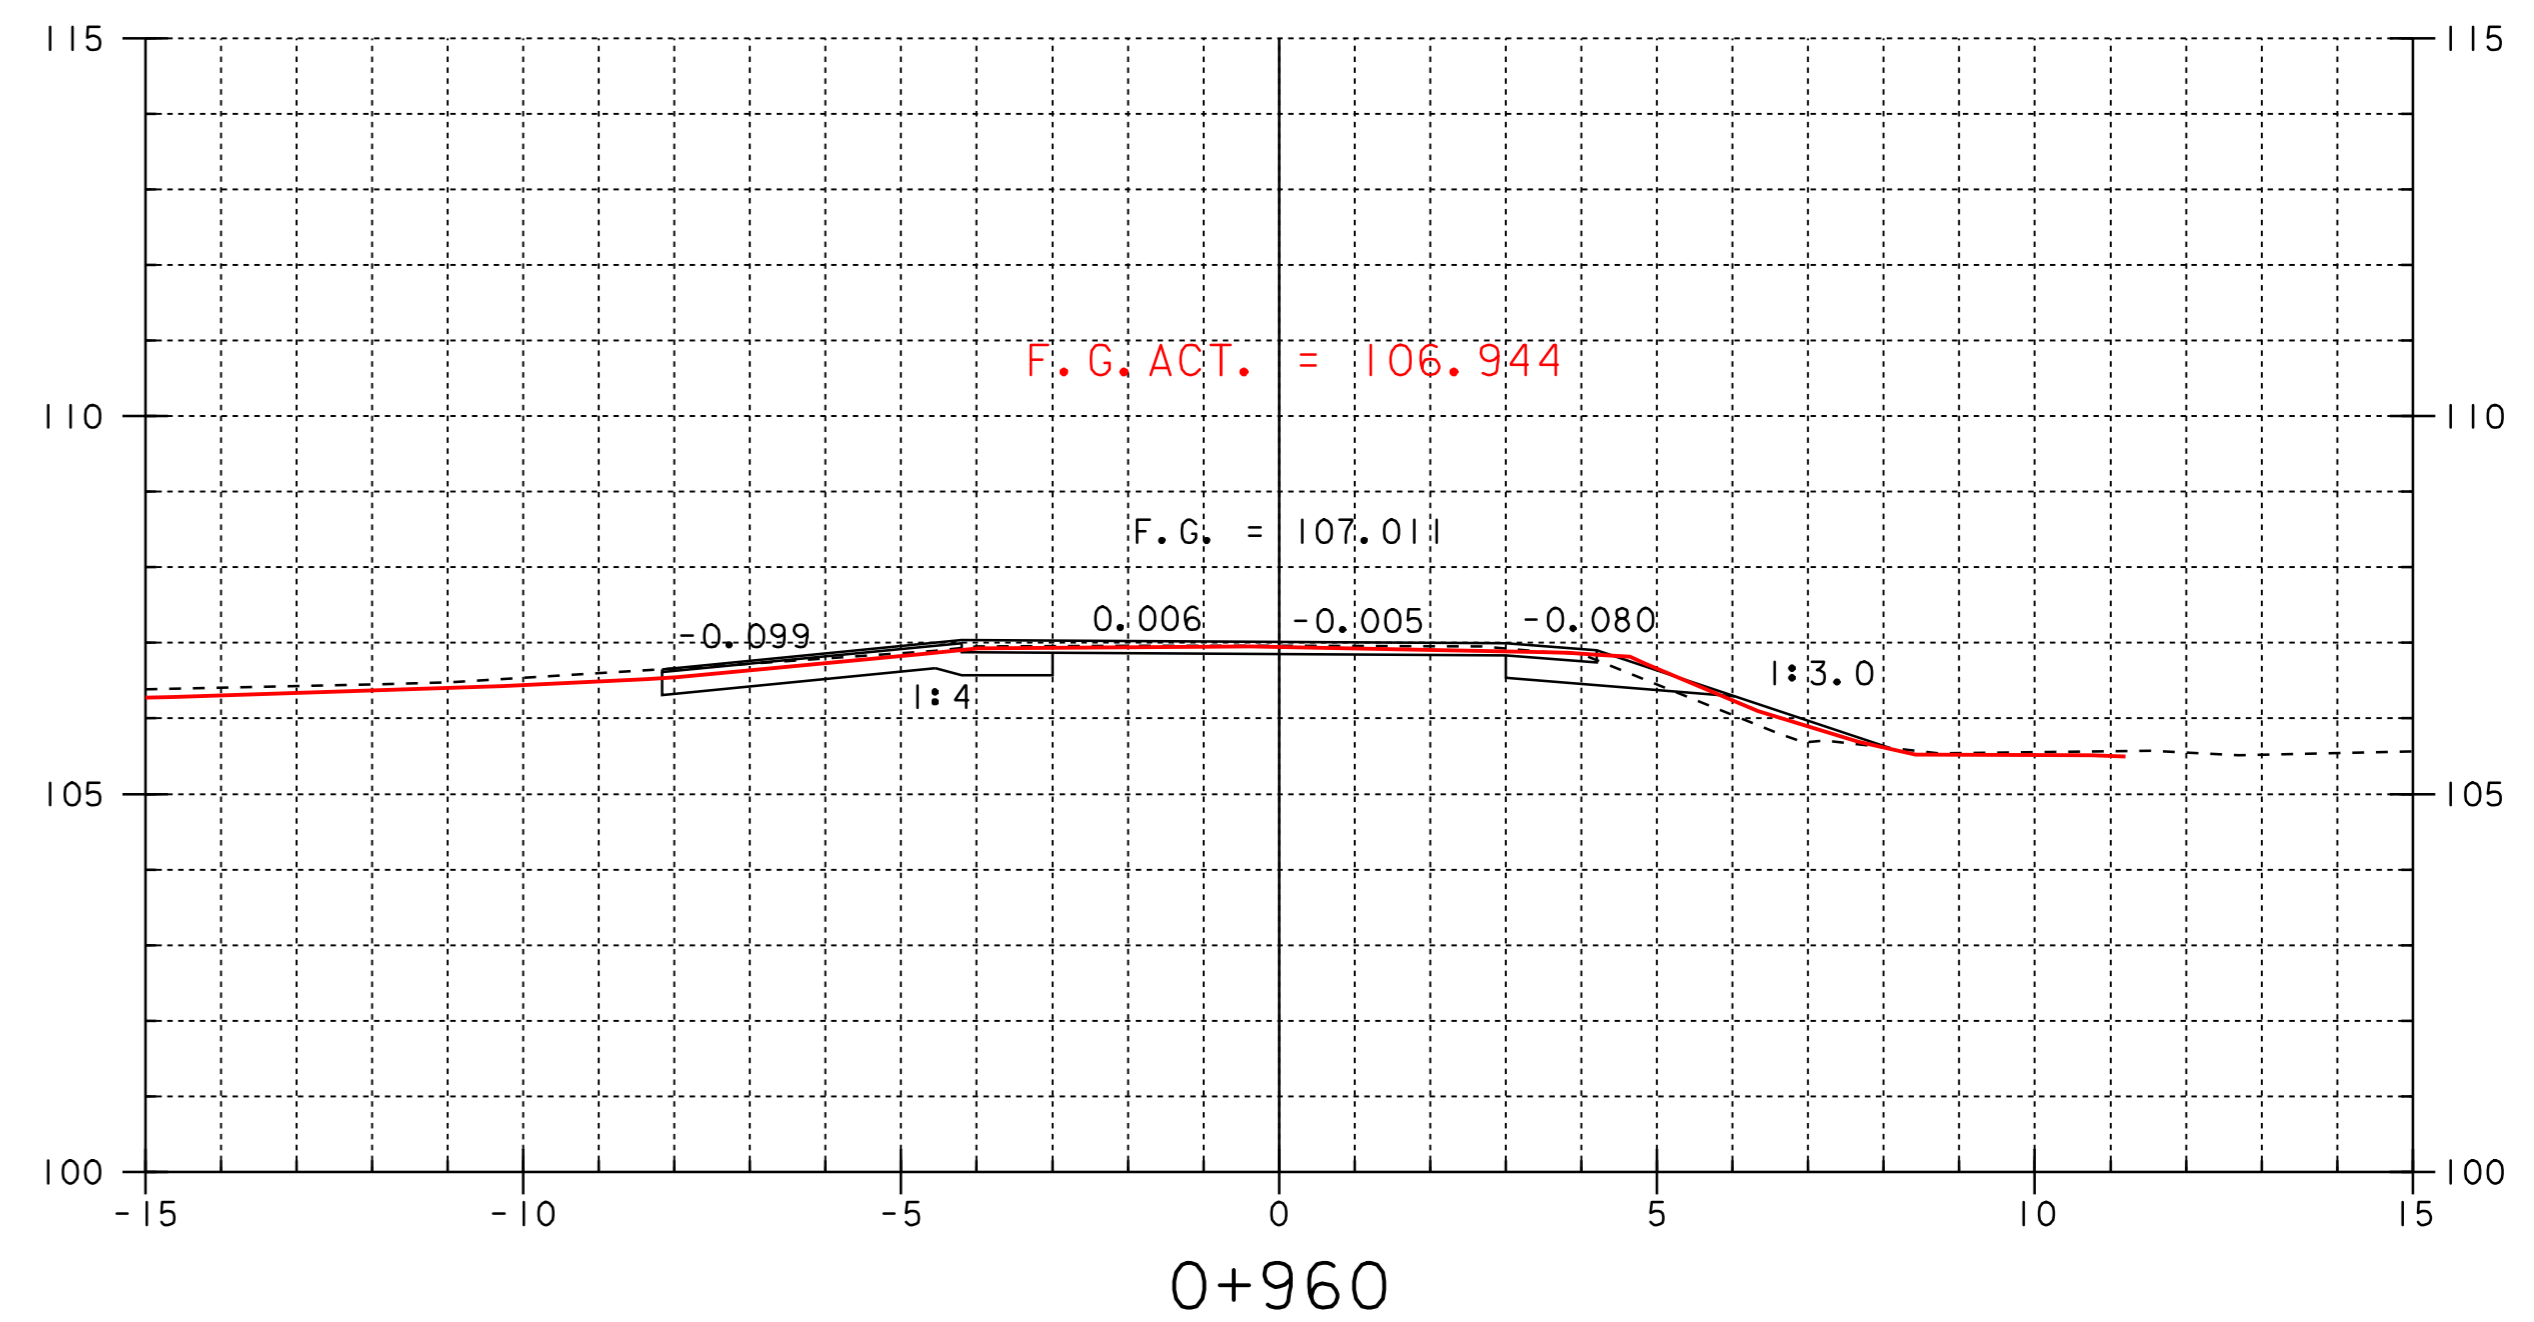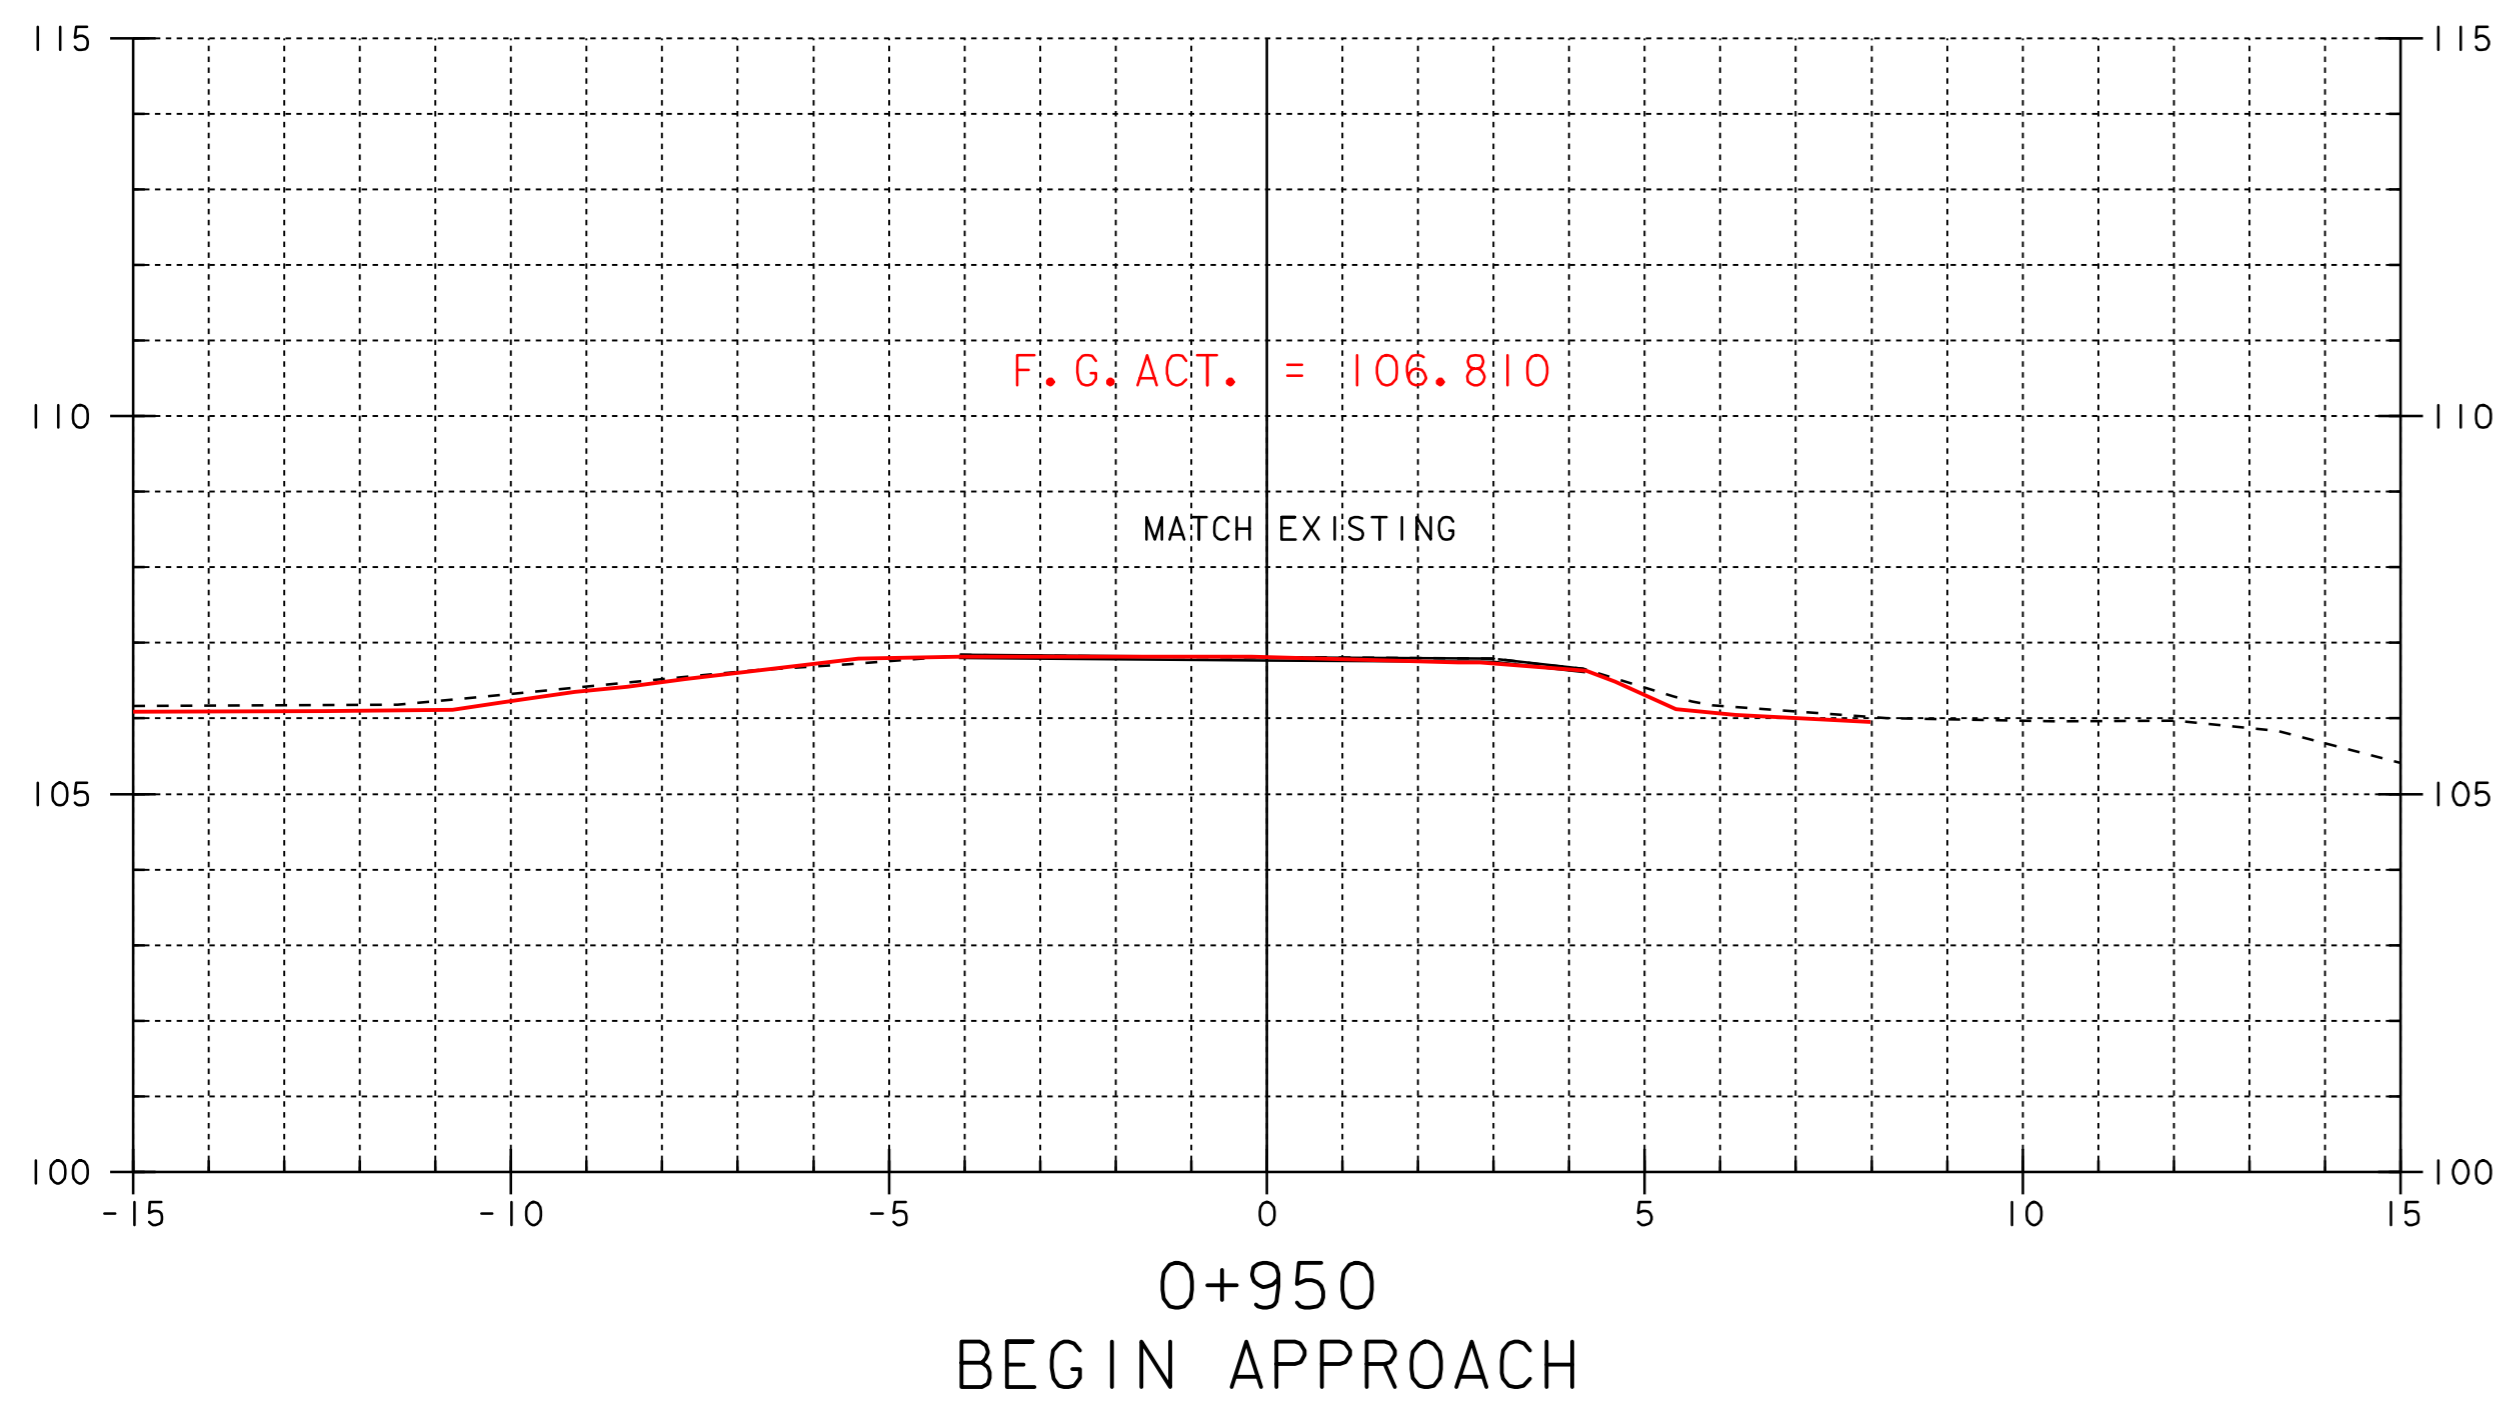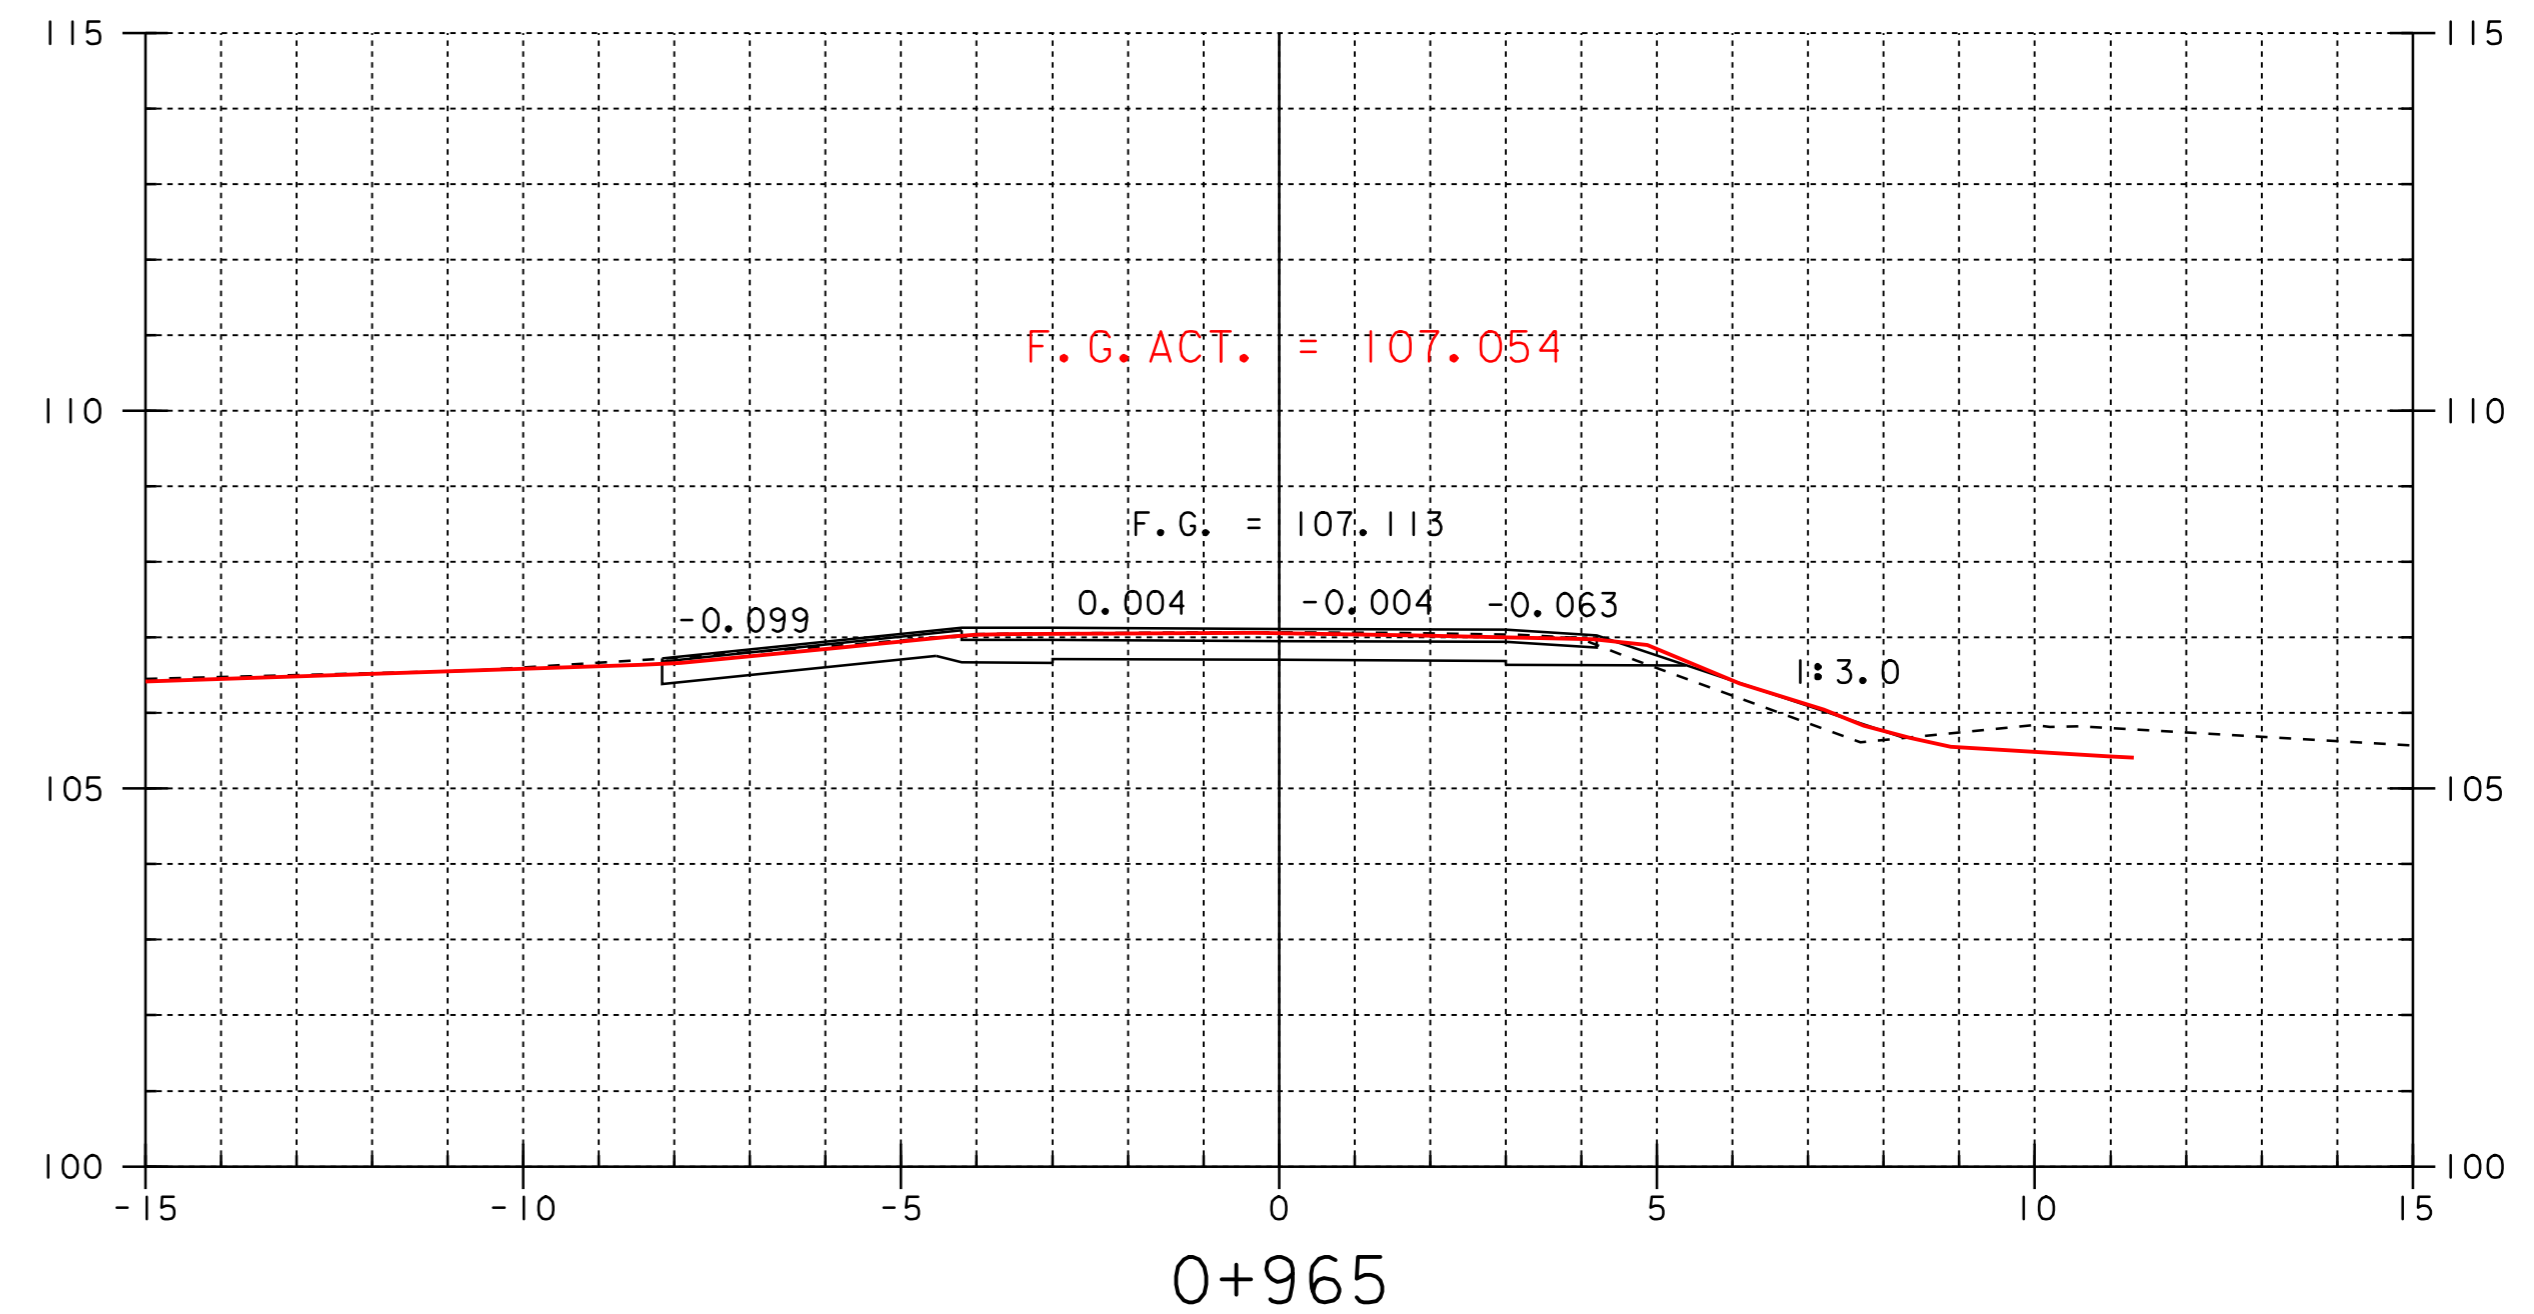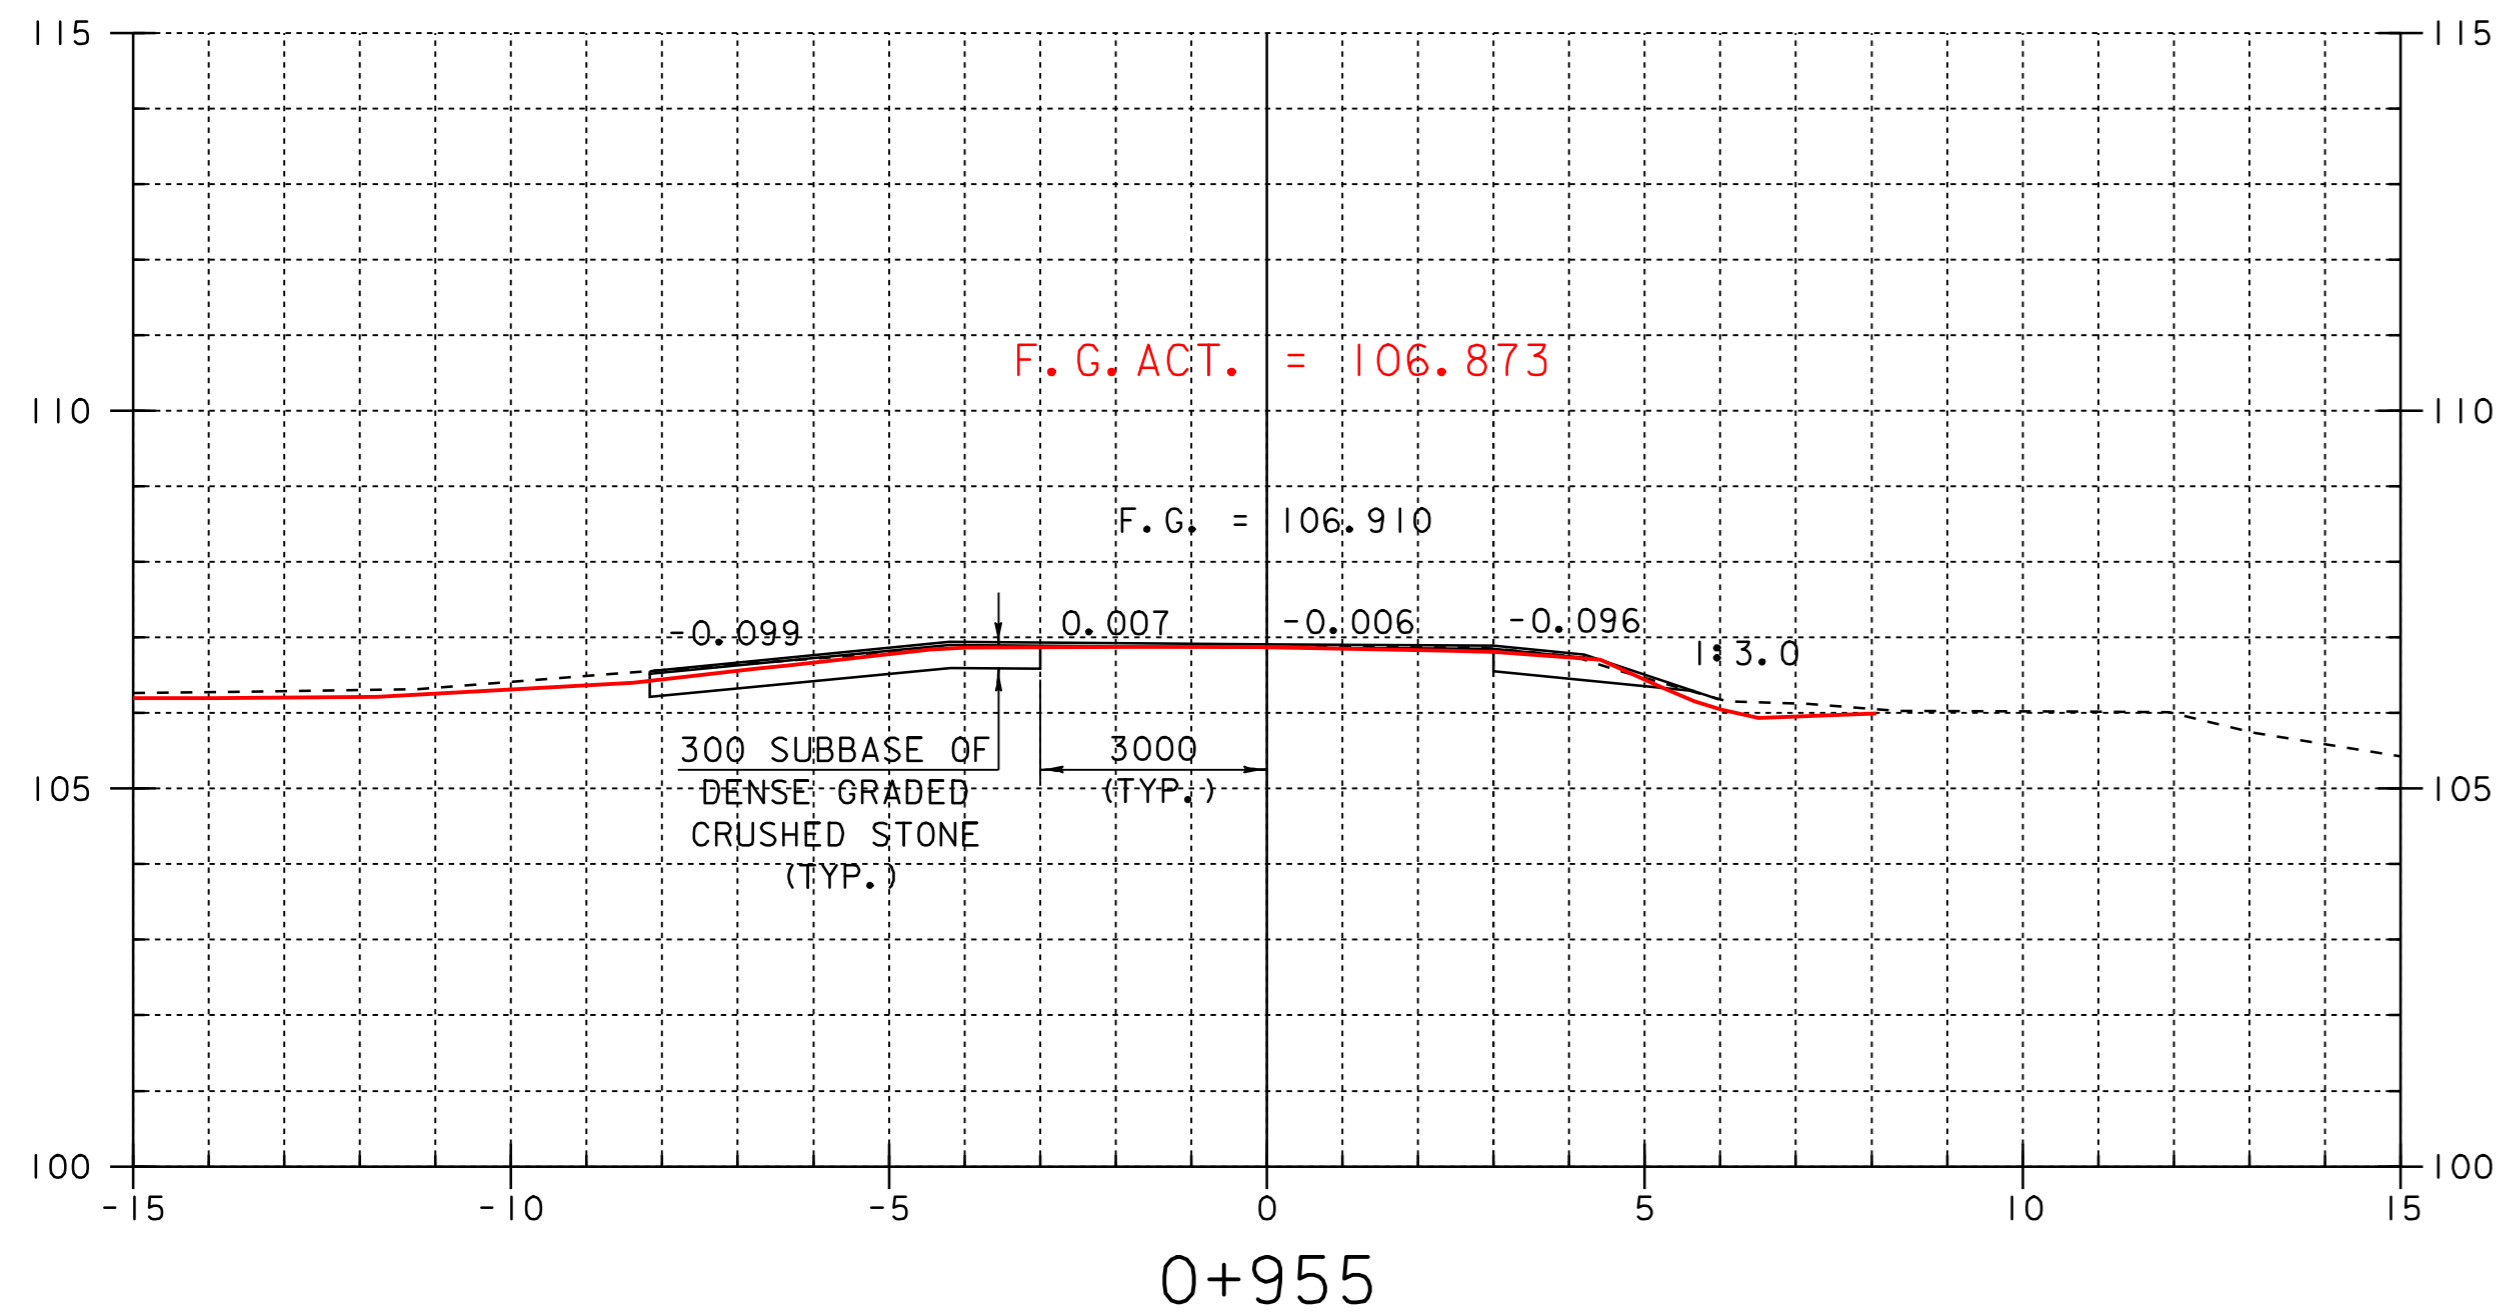






SHEET NAME: <u>MAINLINE CROSS SECTIONS</u>		
PROJECT NAME: <u>LEICESTER</u>	HIGHWAY NO.: <u>EAS_0160</u>	
PROJECT NUMBER: <u>BRE_0160(3)S</u>	BRIDGE NO.: <u>6</u>	OVER: <u>QUIER CREEK</u>
FILE NAME: <u>95J288\Structures\sj288xsl.dgn</u>	PLOT DATE: <u>02-OCT-2008 11:00</u>	
PROJECT MANAGER: <u>B.B. WHITCOMB</u>	DRAWN BY: <u>J. GILMORE</u>	
DESIGNED BY: <u>C. CARLSON</u>	IPARM NAME: <u>sj088.drl</u>	
	SHEET <u>68</u> OF <u>90</u>	

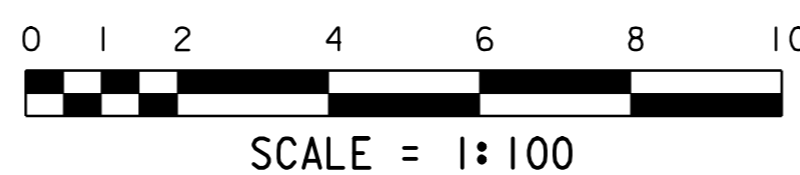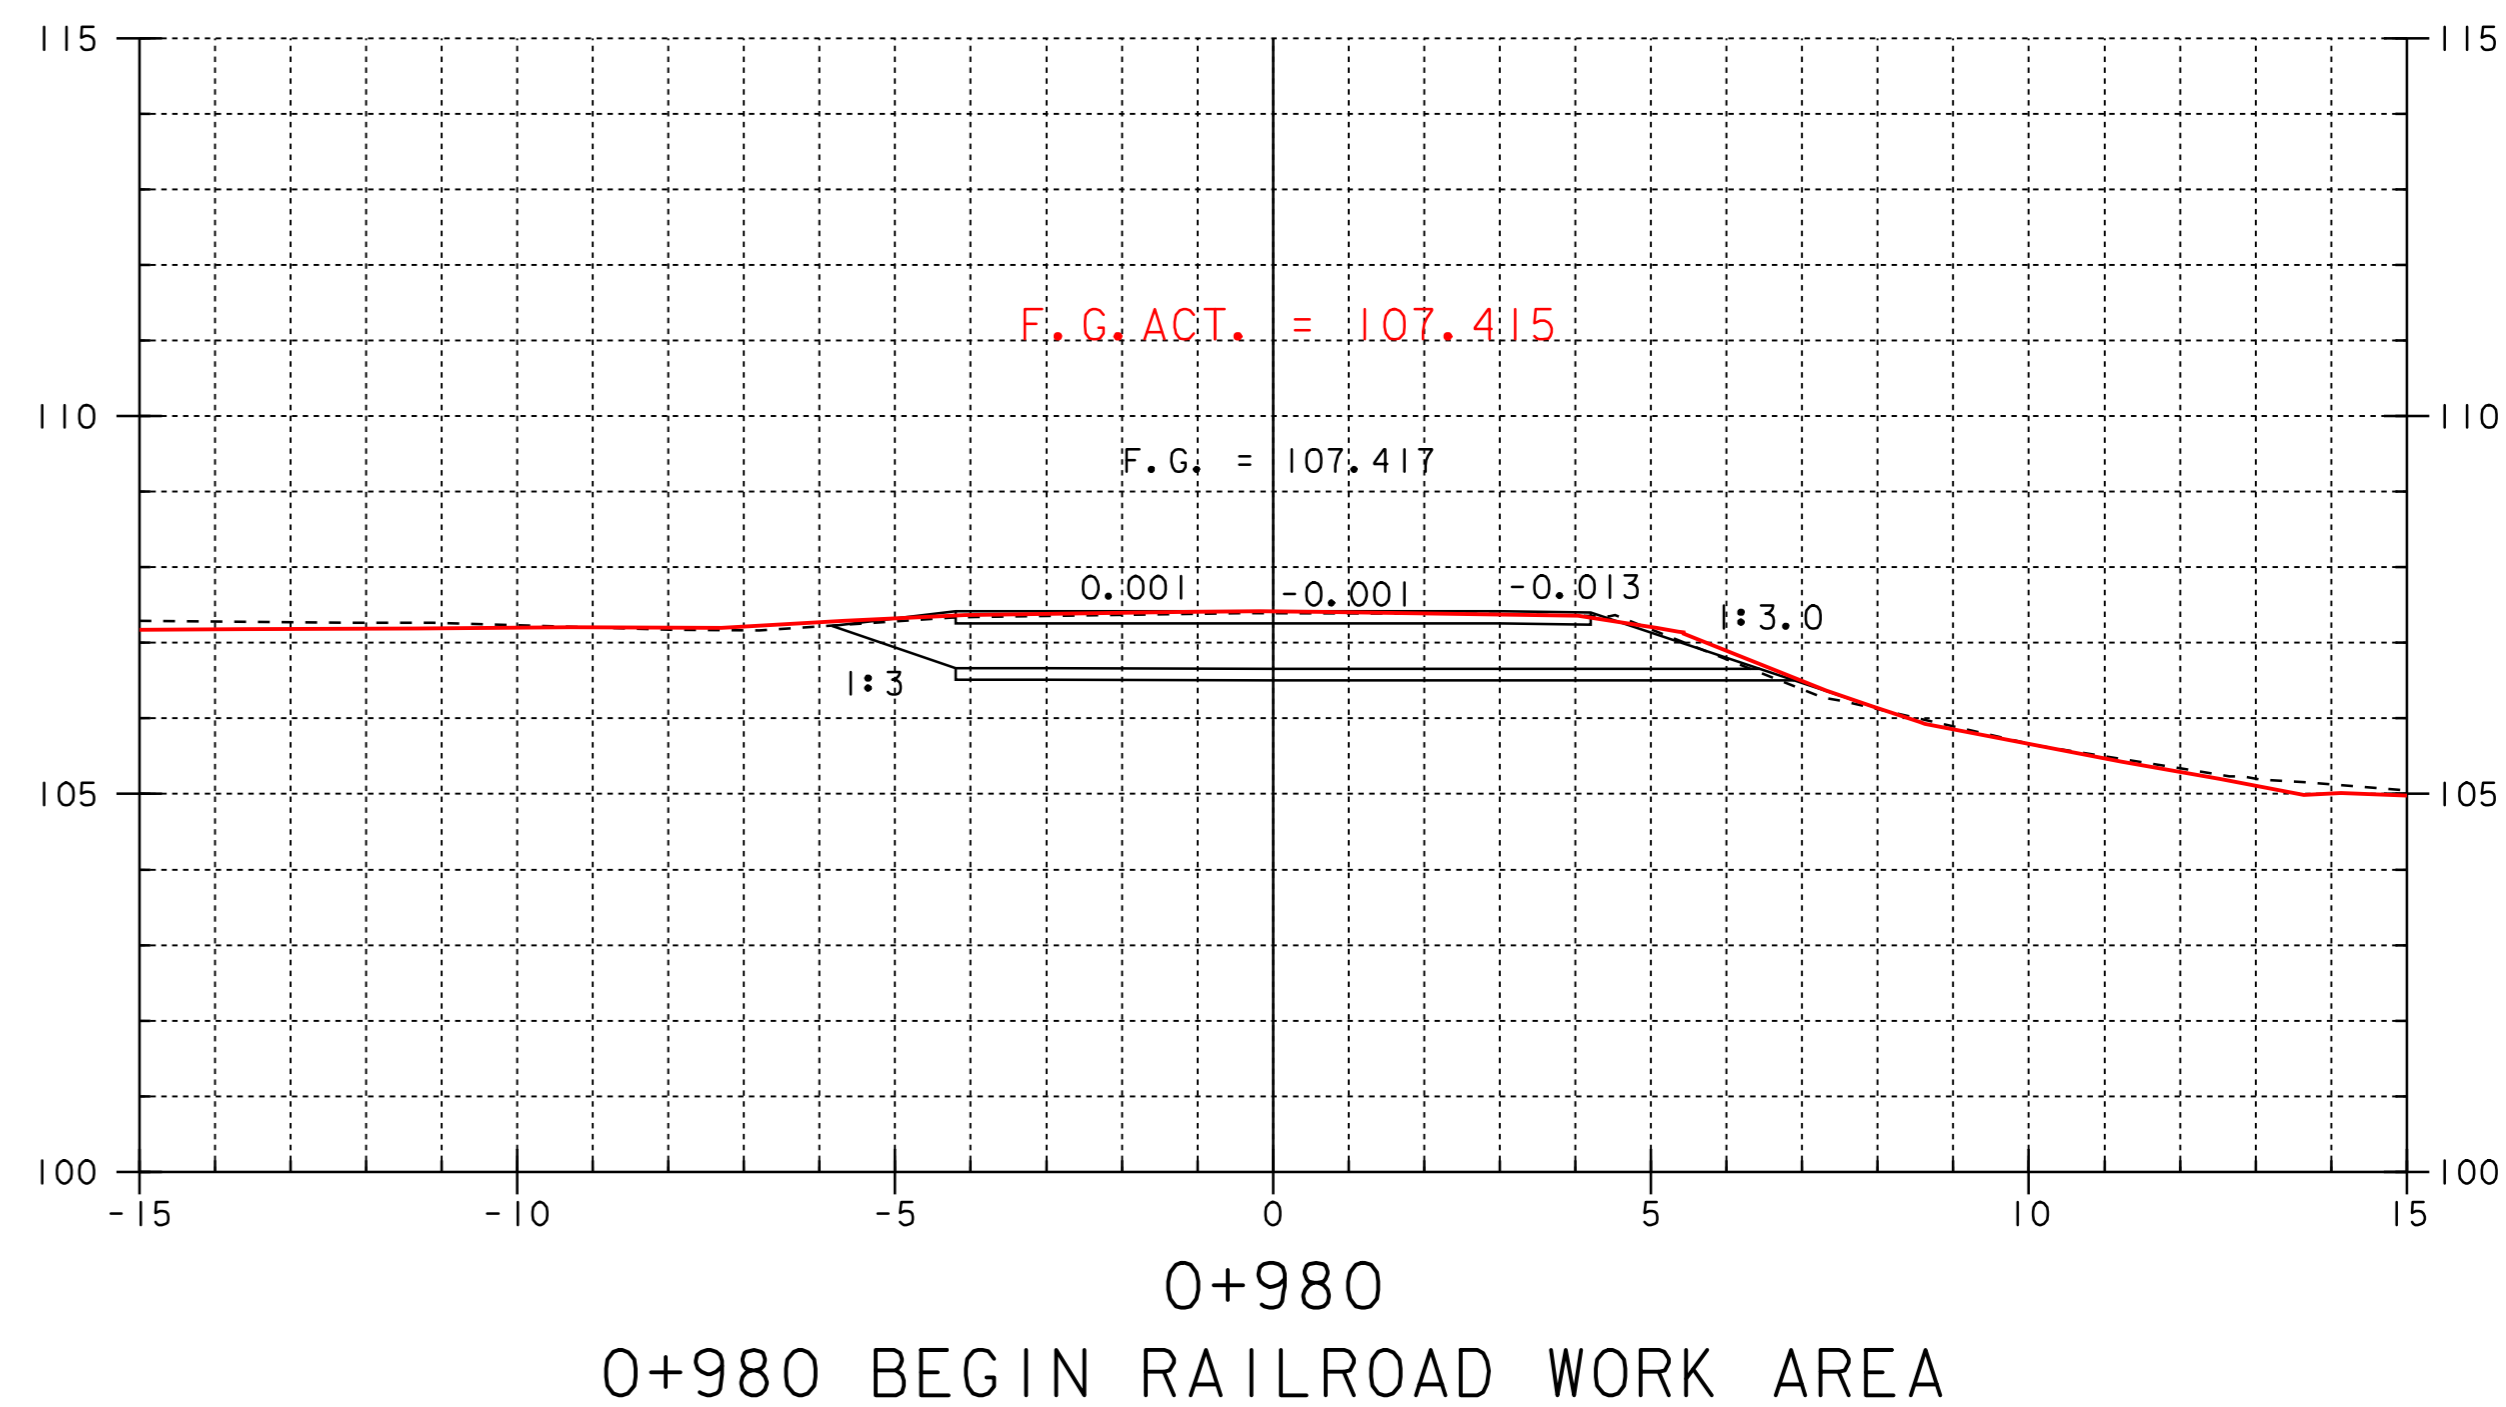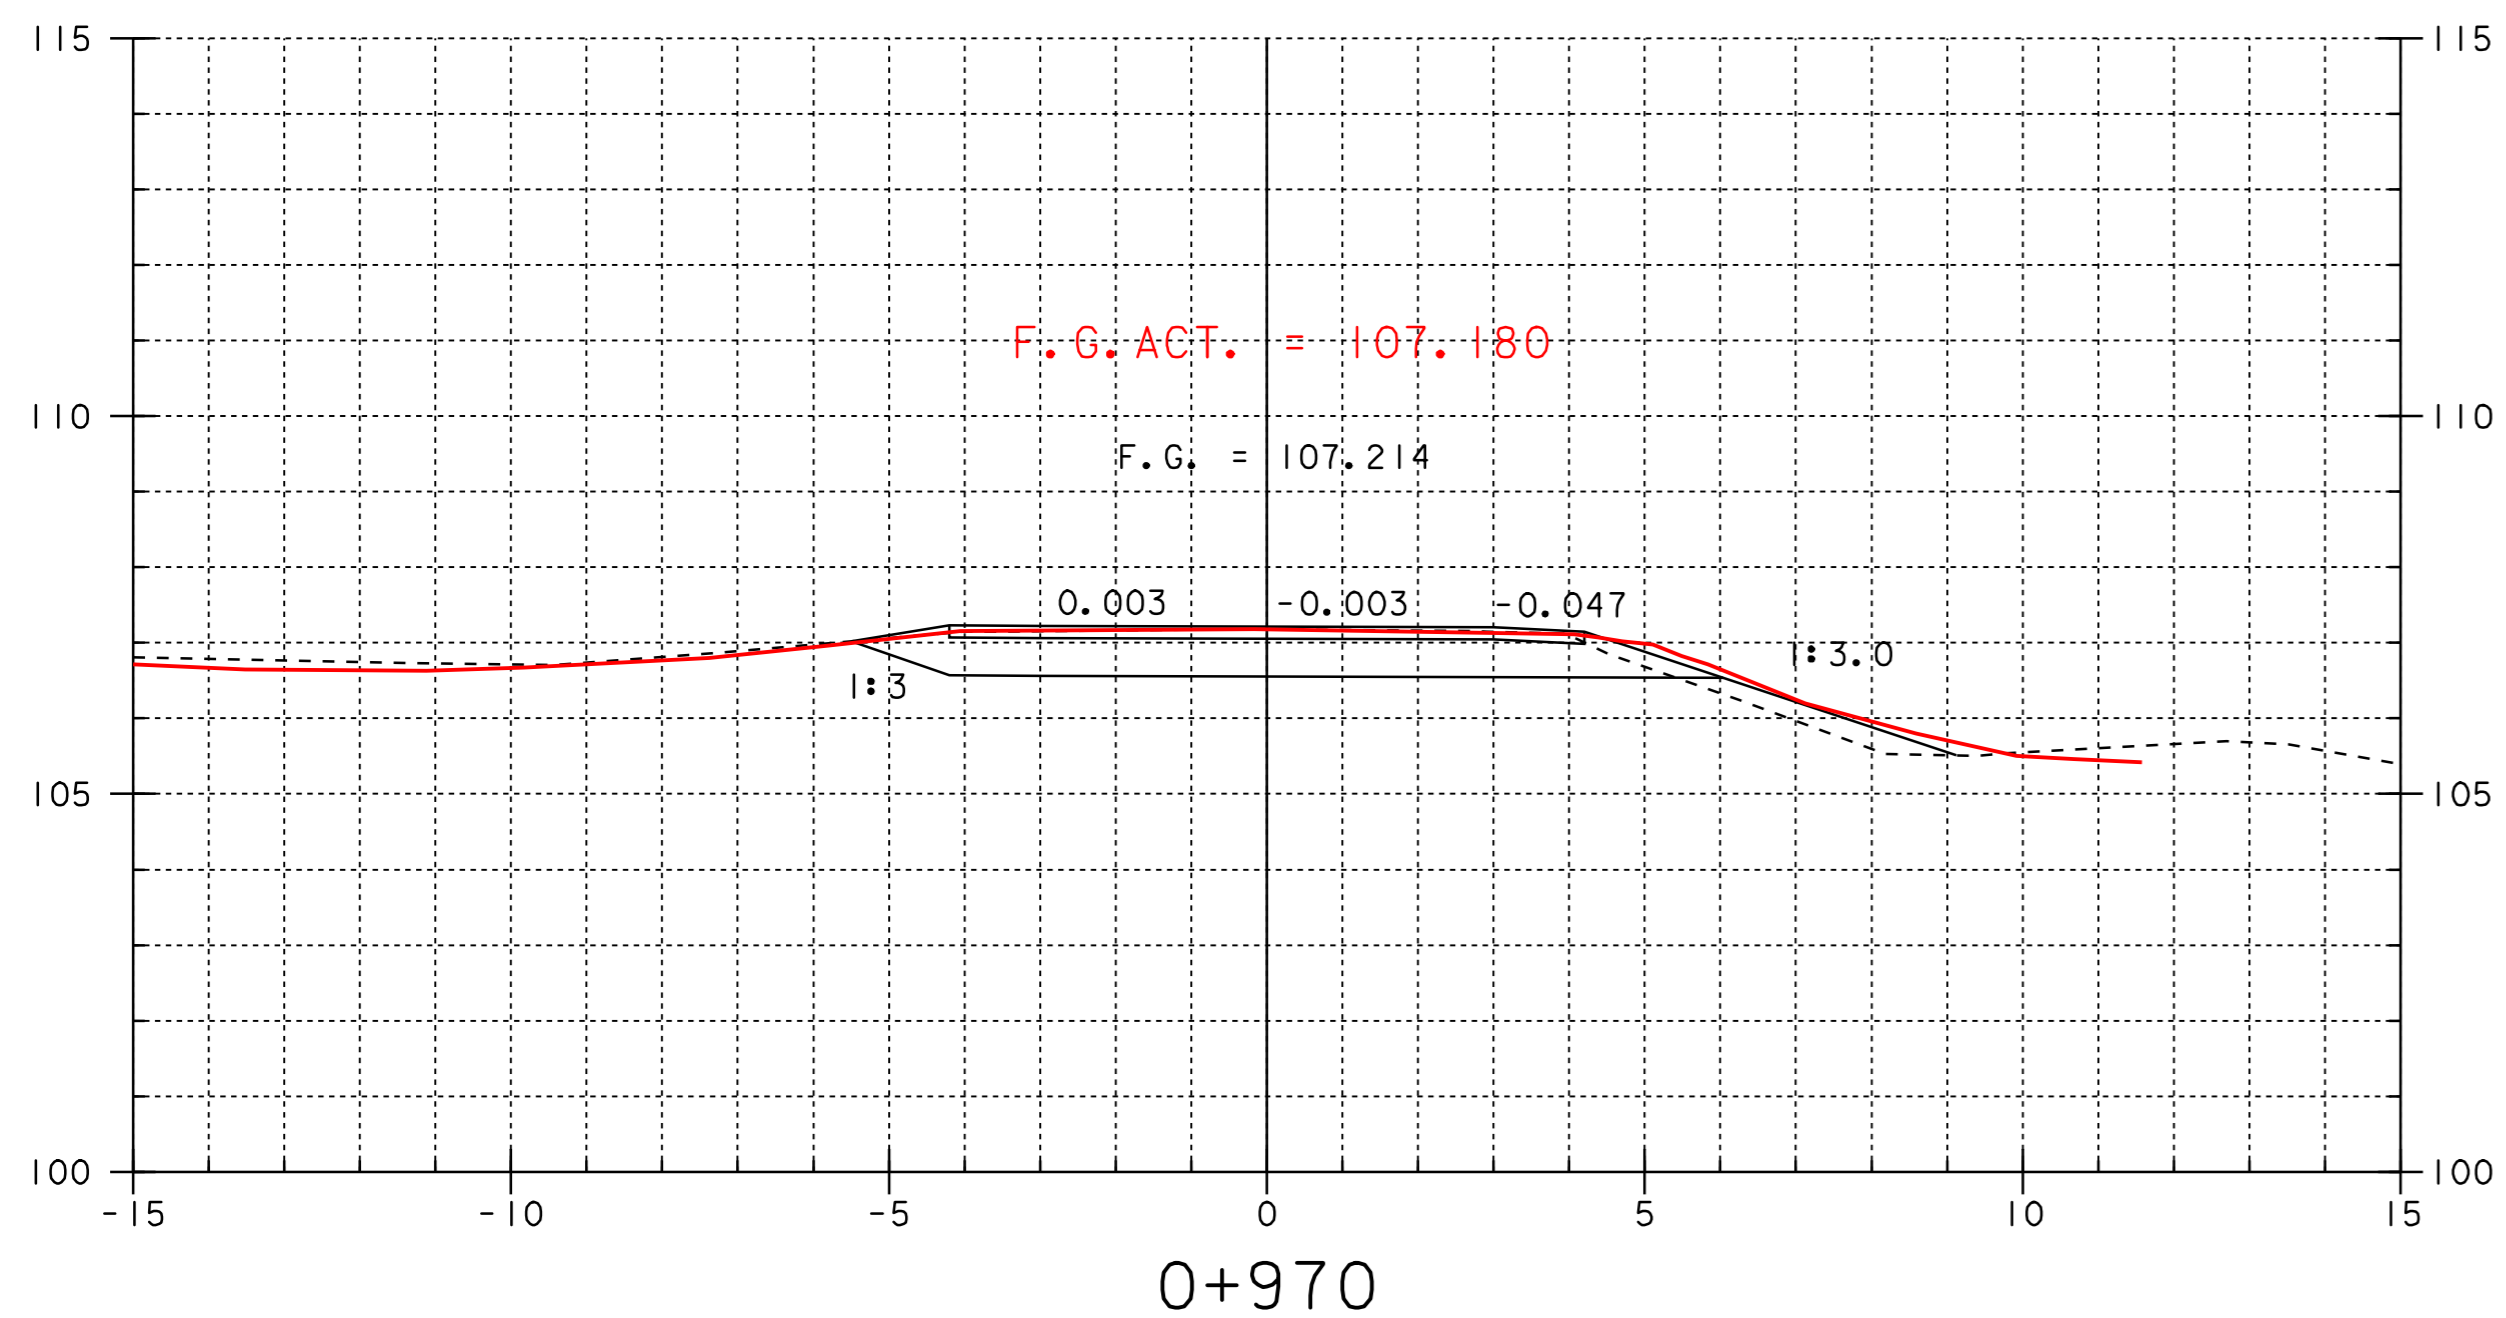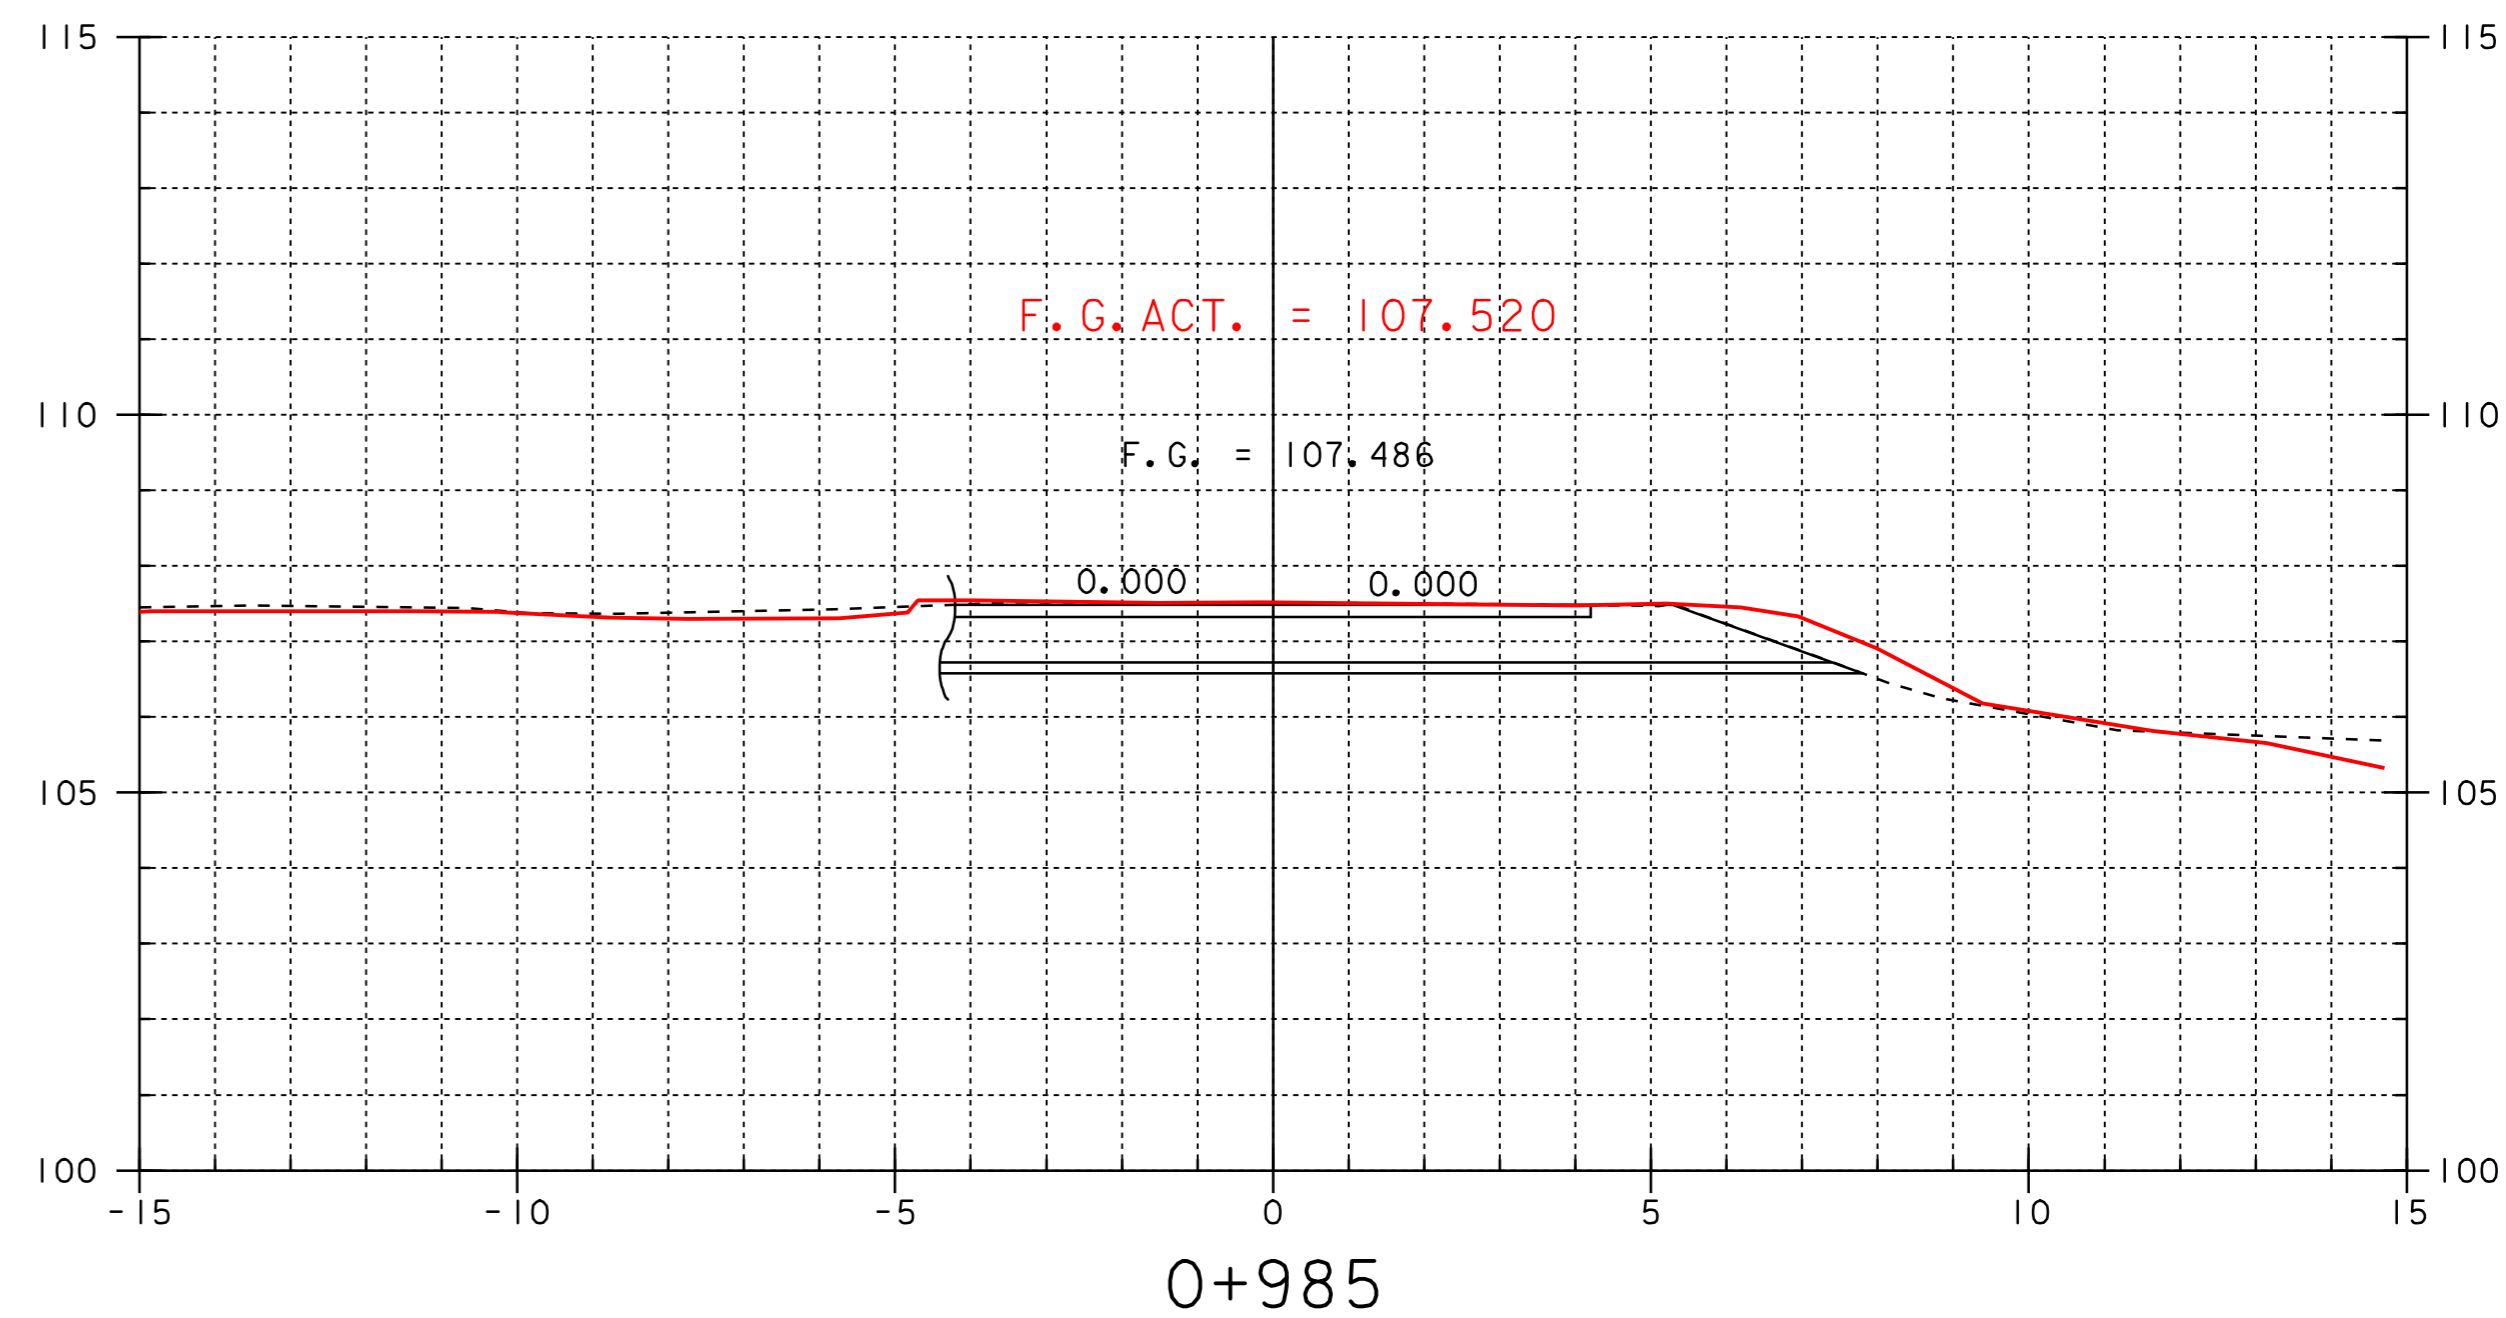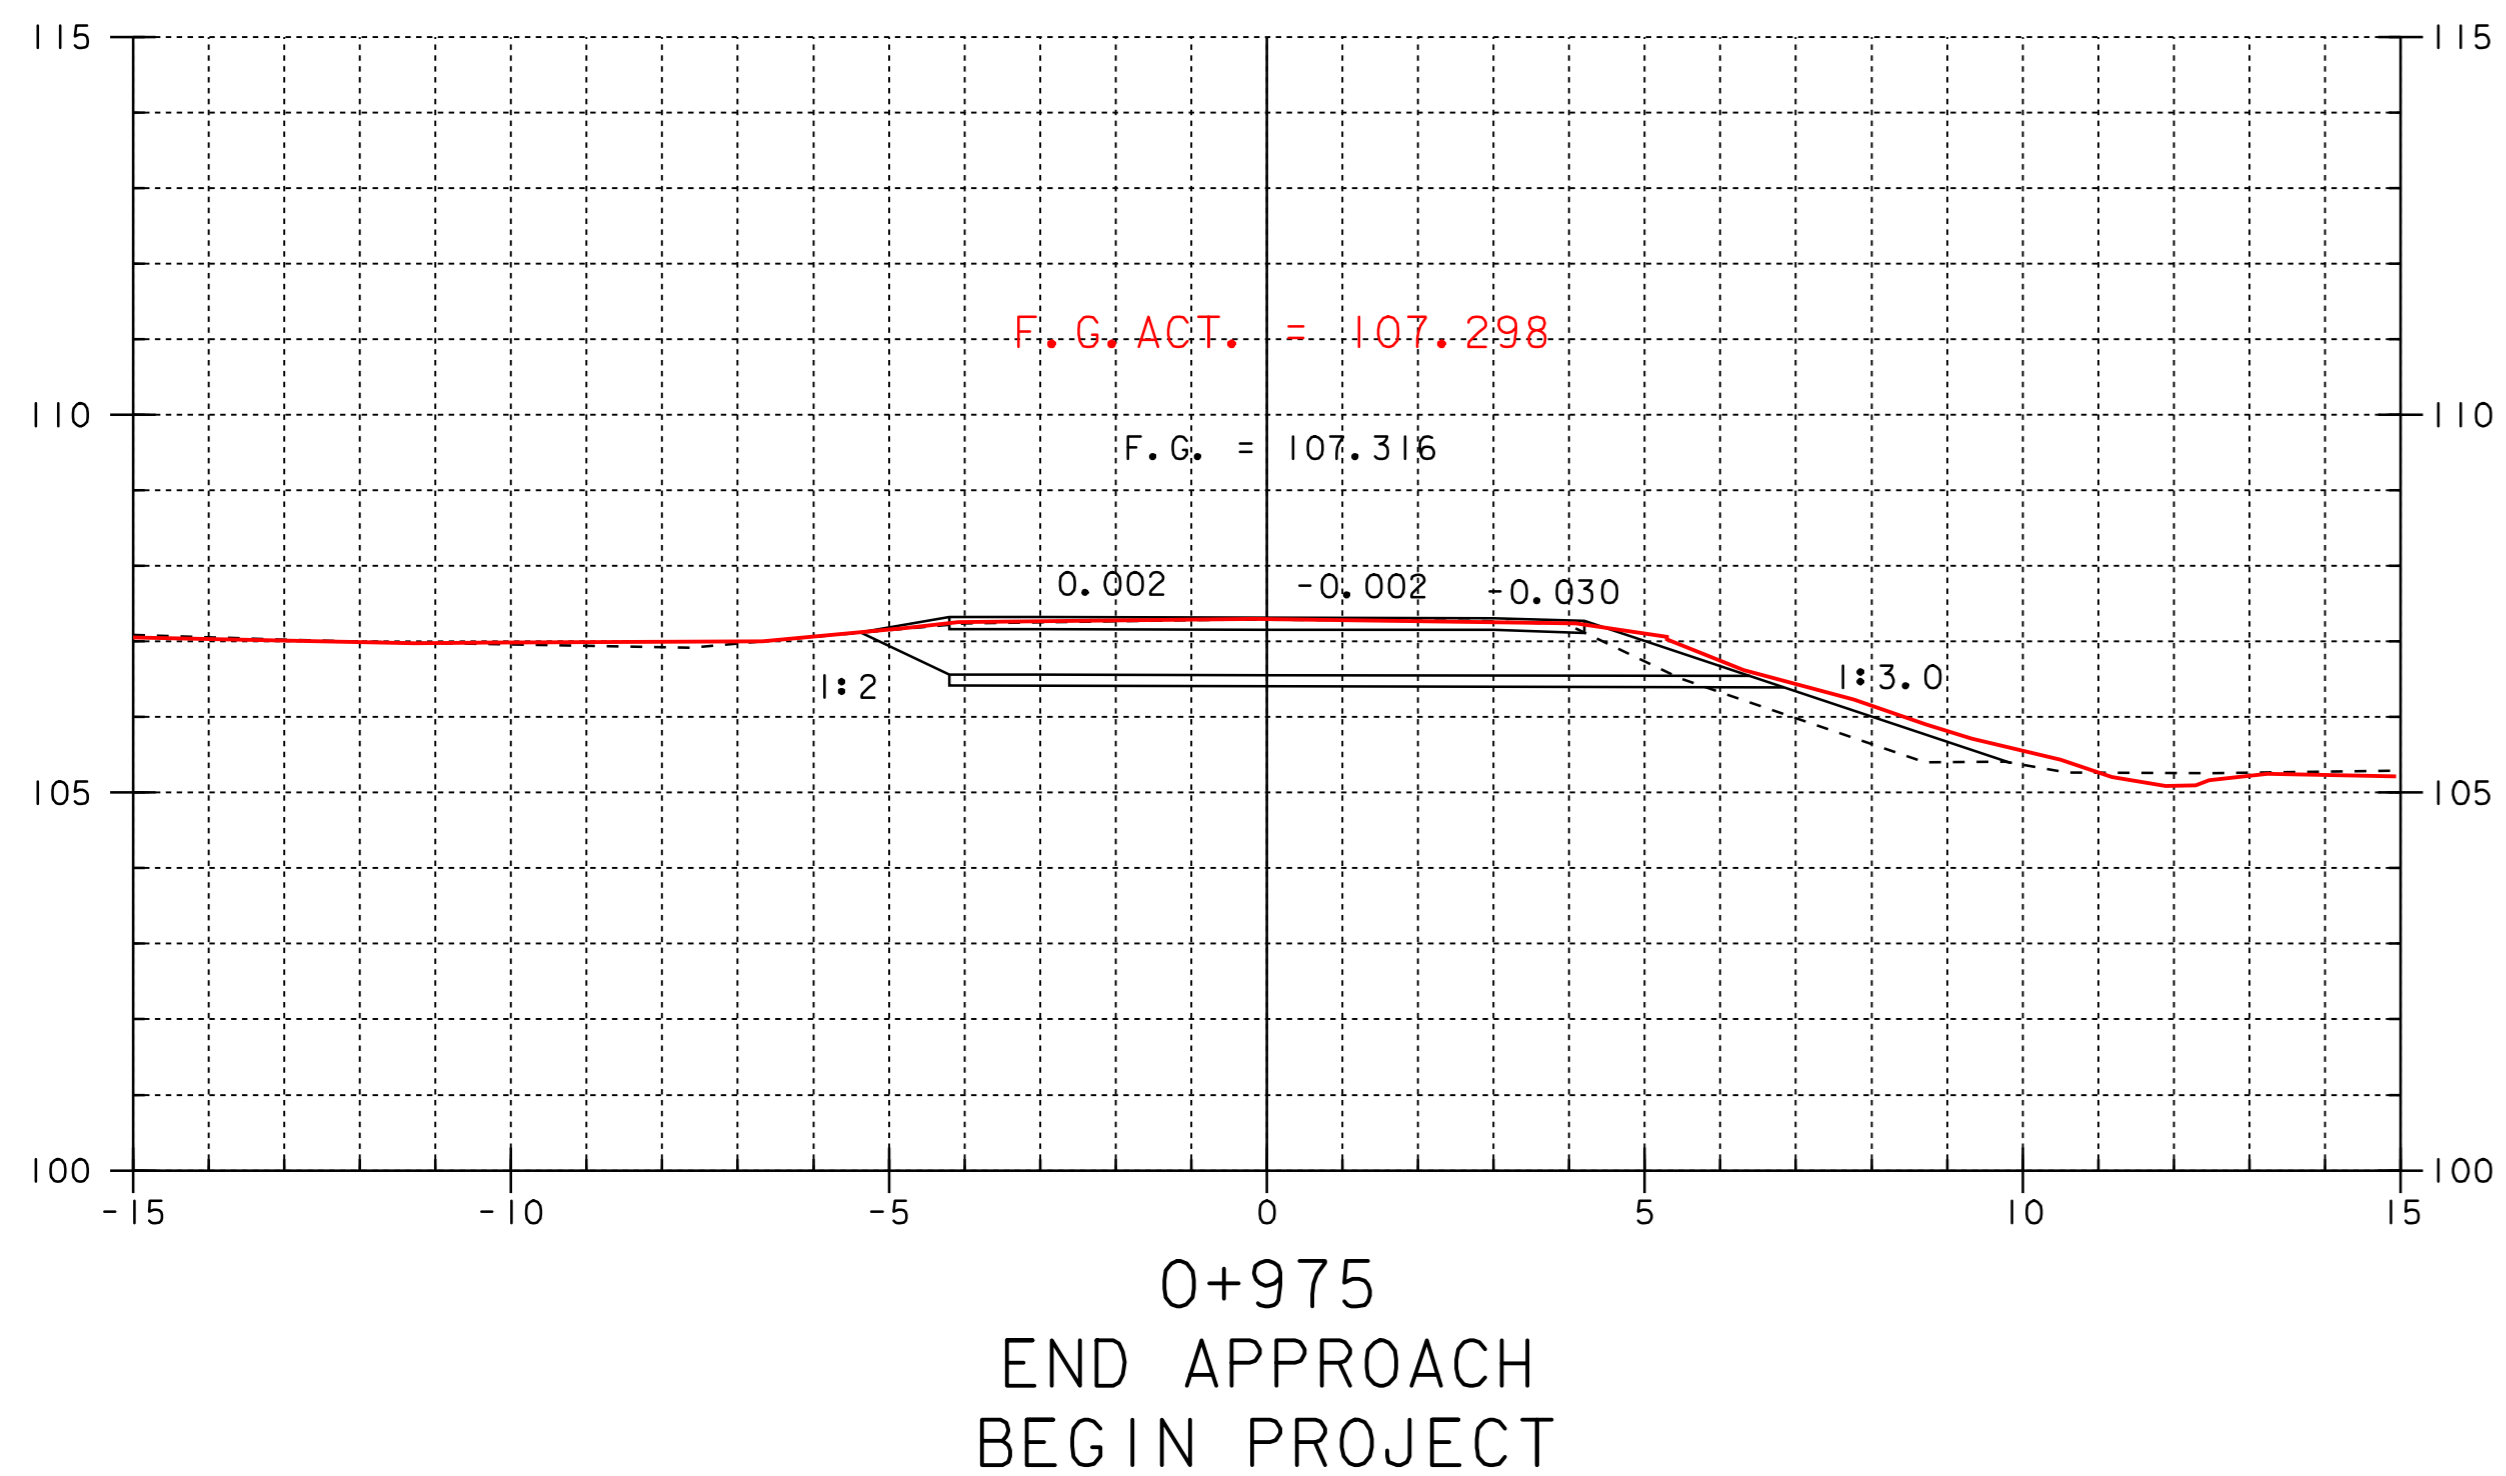

SHEET NAME: <u>MAINLINE CROSS SECTIONS</u>		
PROJECT NAME: <u>LEICESTER</u>	HIGHWAY NO.: <u>EAS_0160</u>	
PROJECT NUMBER: <u>BRE_0160(3)S</u>	BRIDGE NO.: <u>6</u>	
	OVER: <u>QUIER CREEK</u>	
FILE NAME: <u>95J288\Structures\sj288xsl.dgn</u>	PLOT DATE: <u>02-OCT-2008 11:00</u>	
PROJECT MANAGER: <u>B.B. WHITCOMB</u>	DRAWN BY: <u>J. GILMORE</u>	
DESIGNED BY: <u>C. CARLSON</u>	IPARM NAME: <u>sj088dr2.l</u>	
	SHEET <u>69</u> OF <u>90</u>	





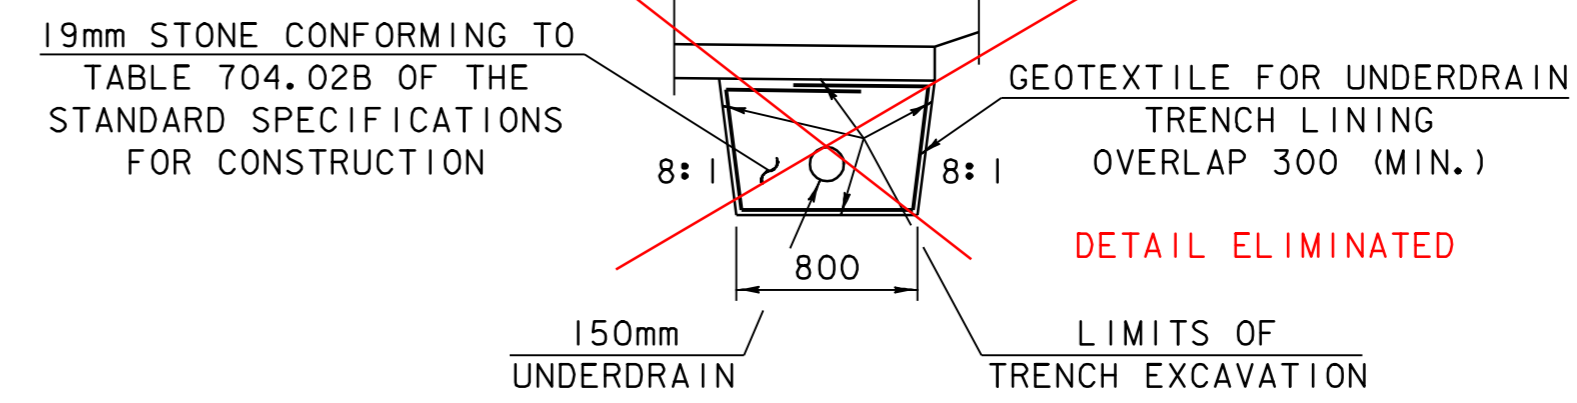


UNDERDRAIN TYPICAL SECTION
NOT TO SCALE

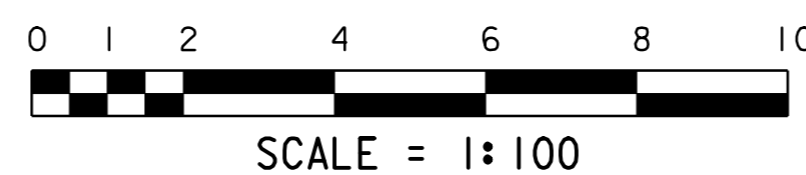
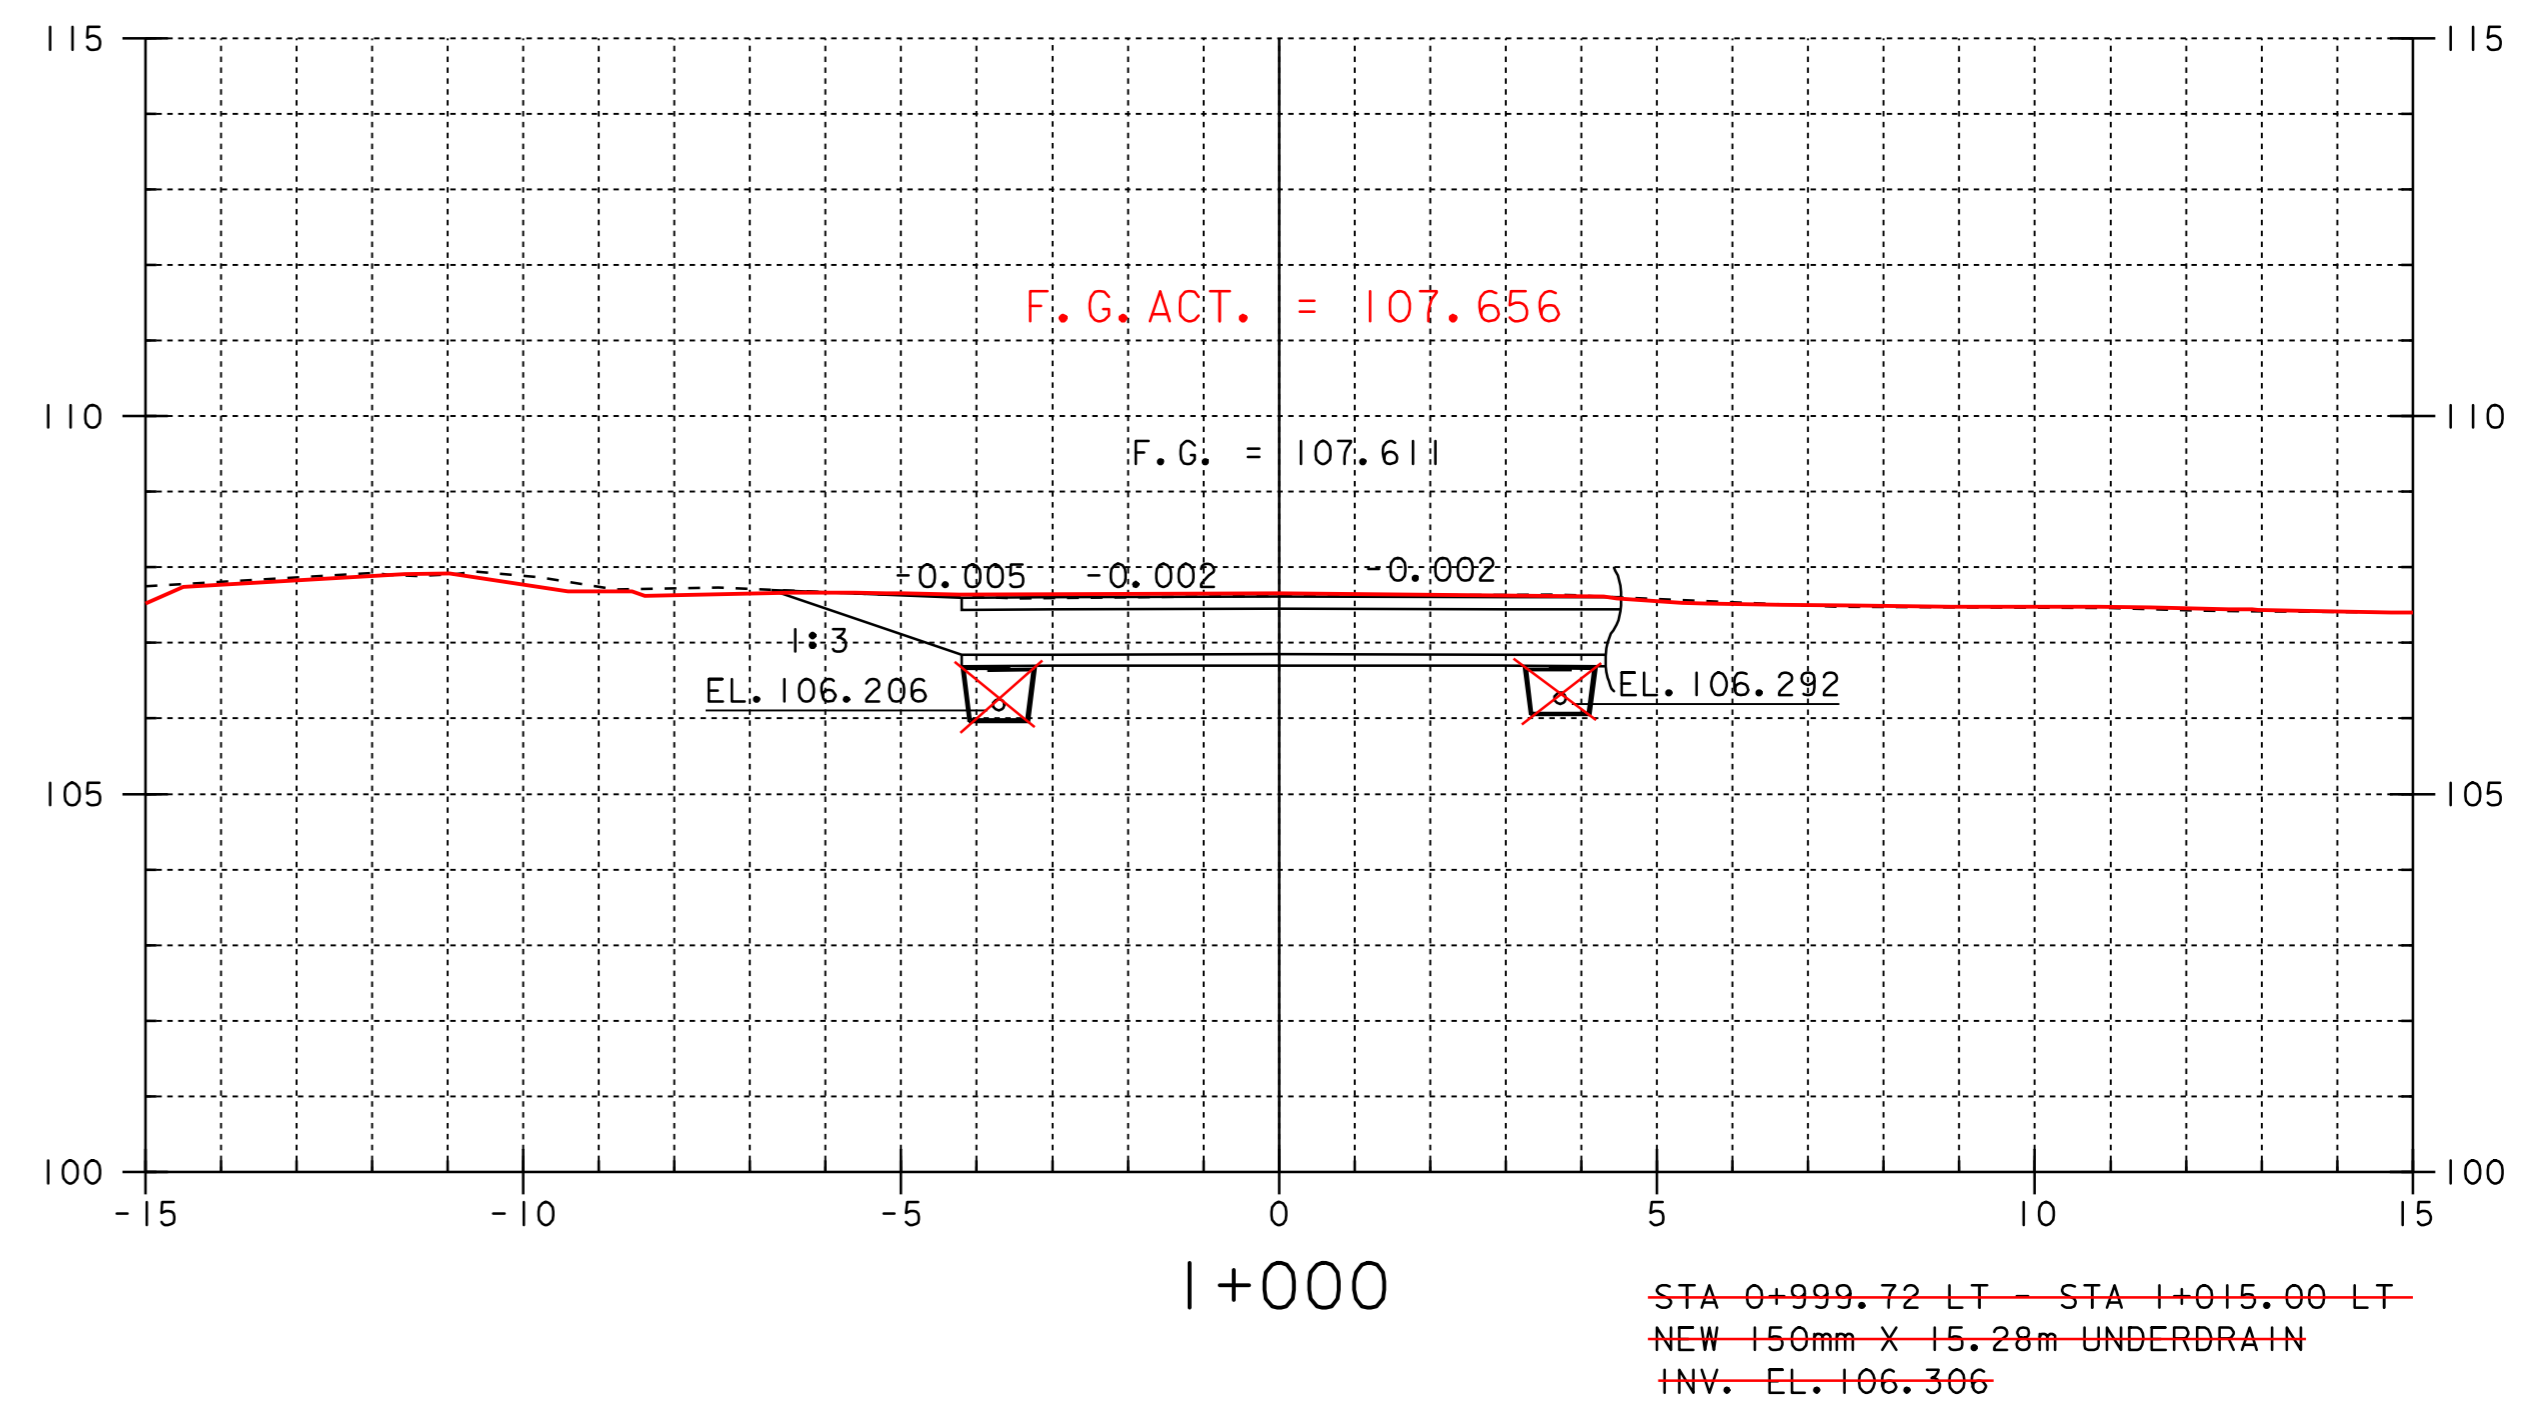
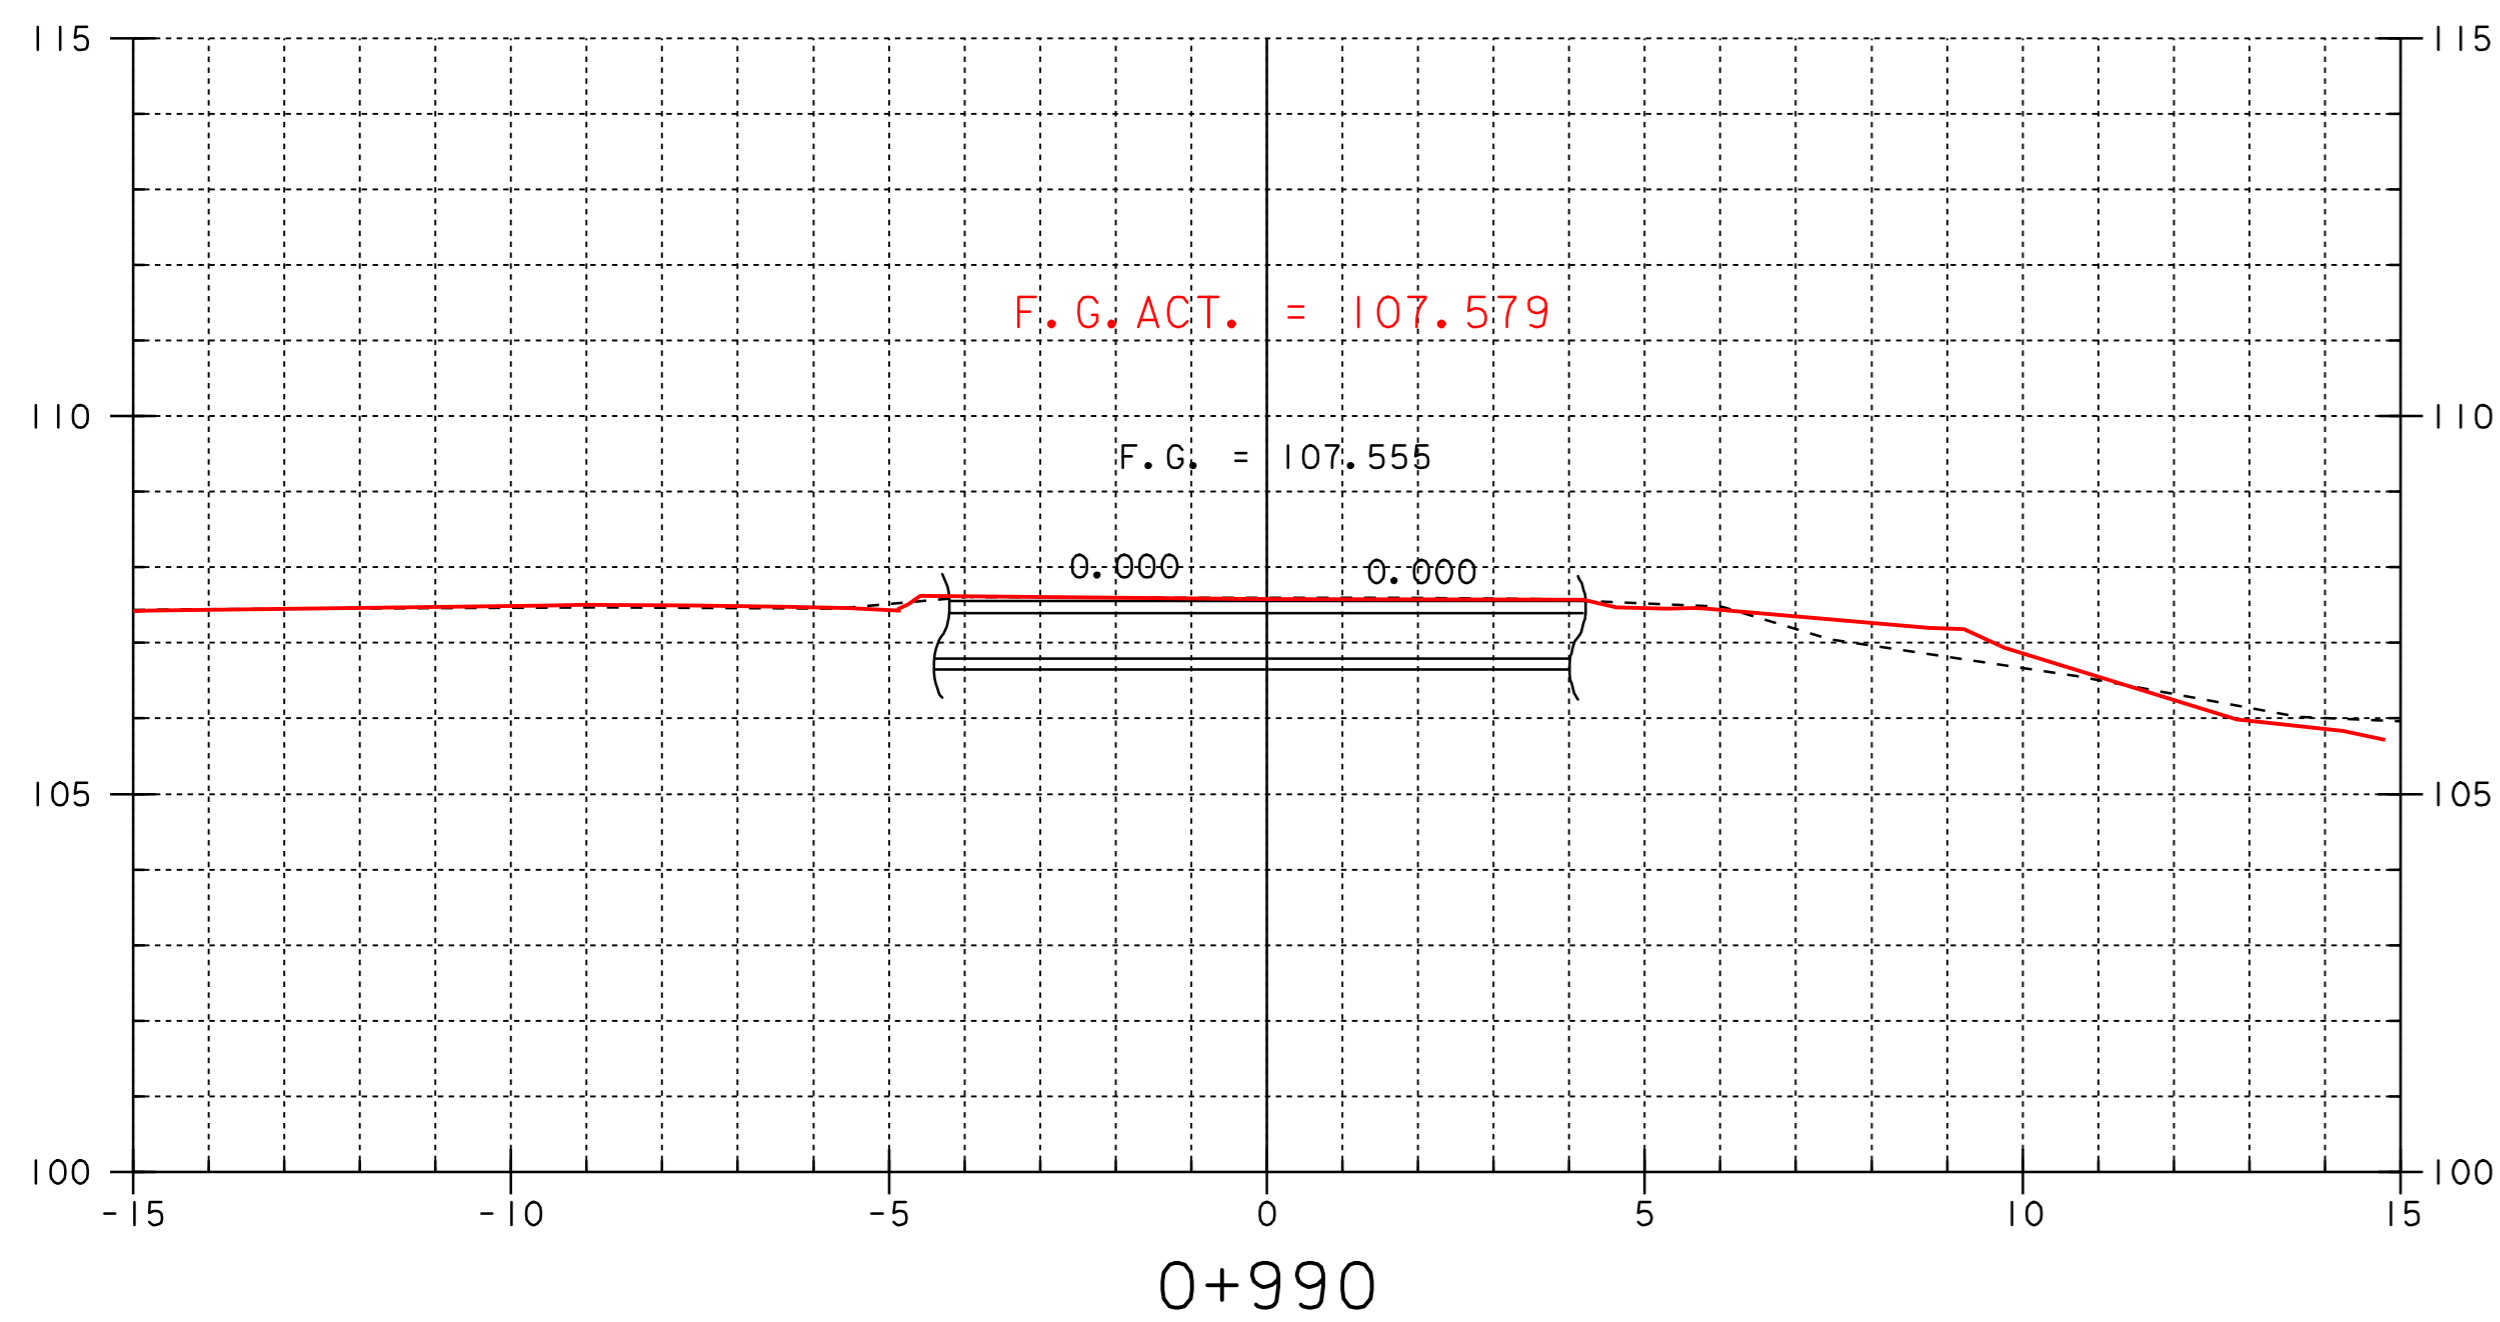
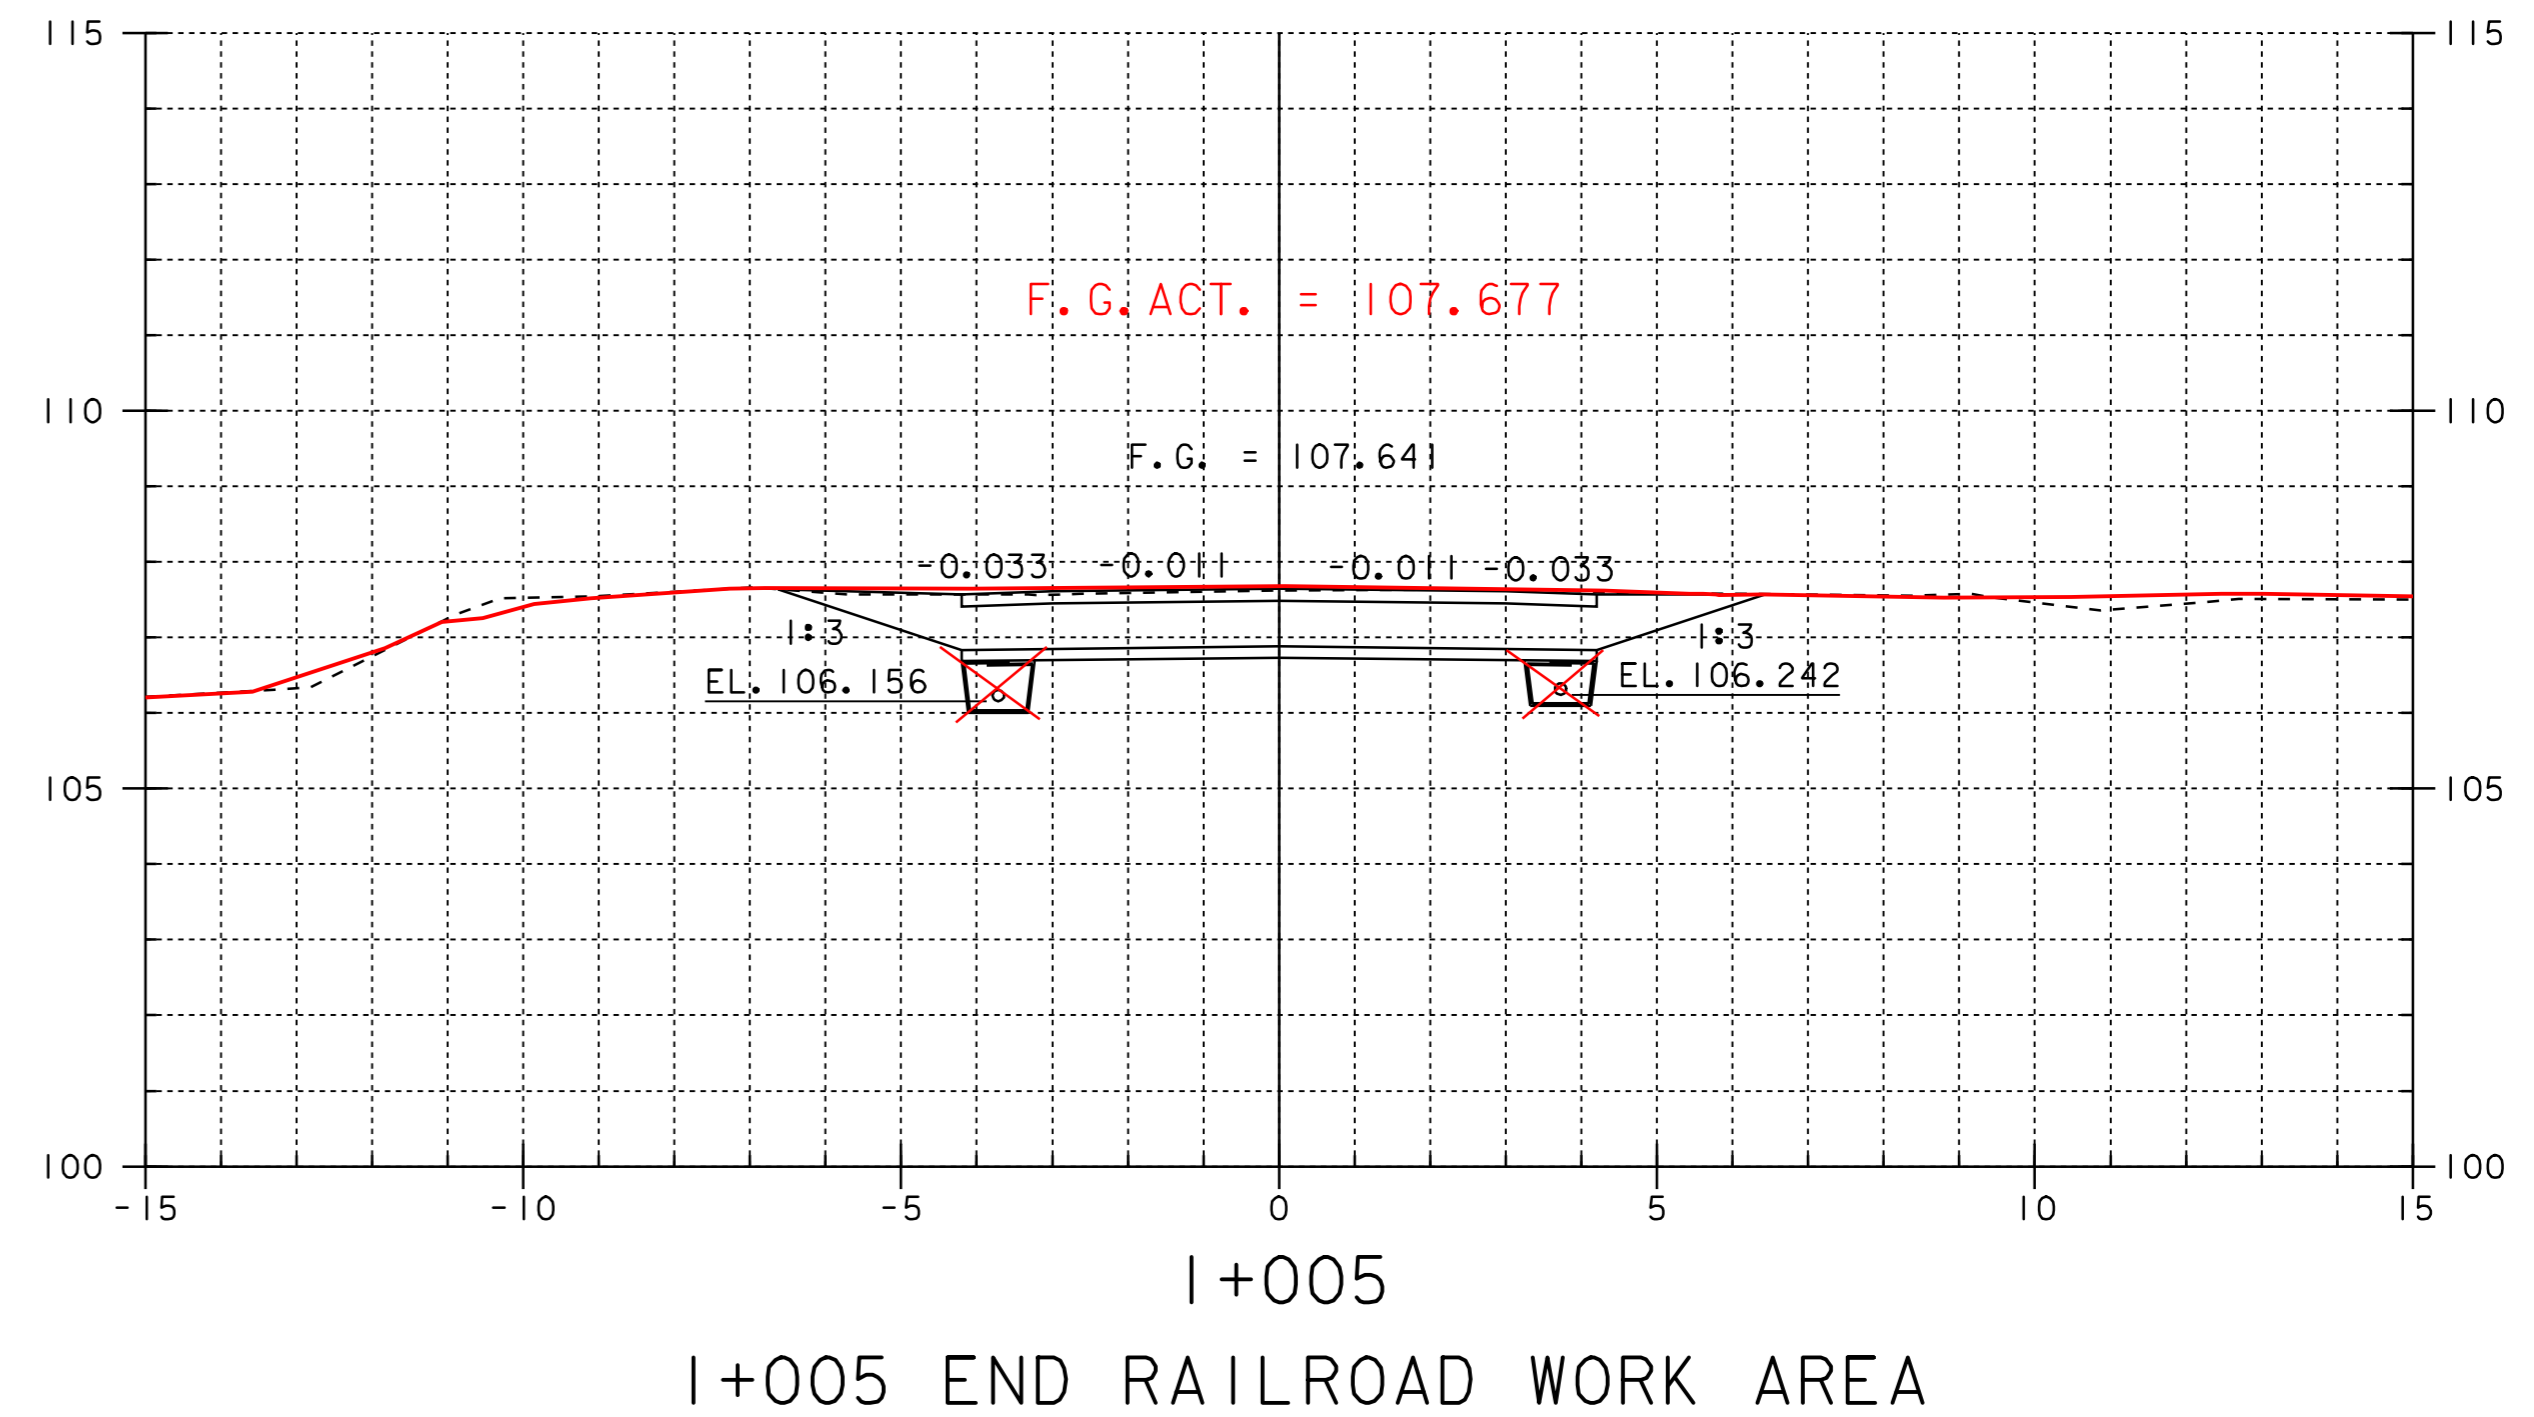
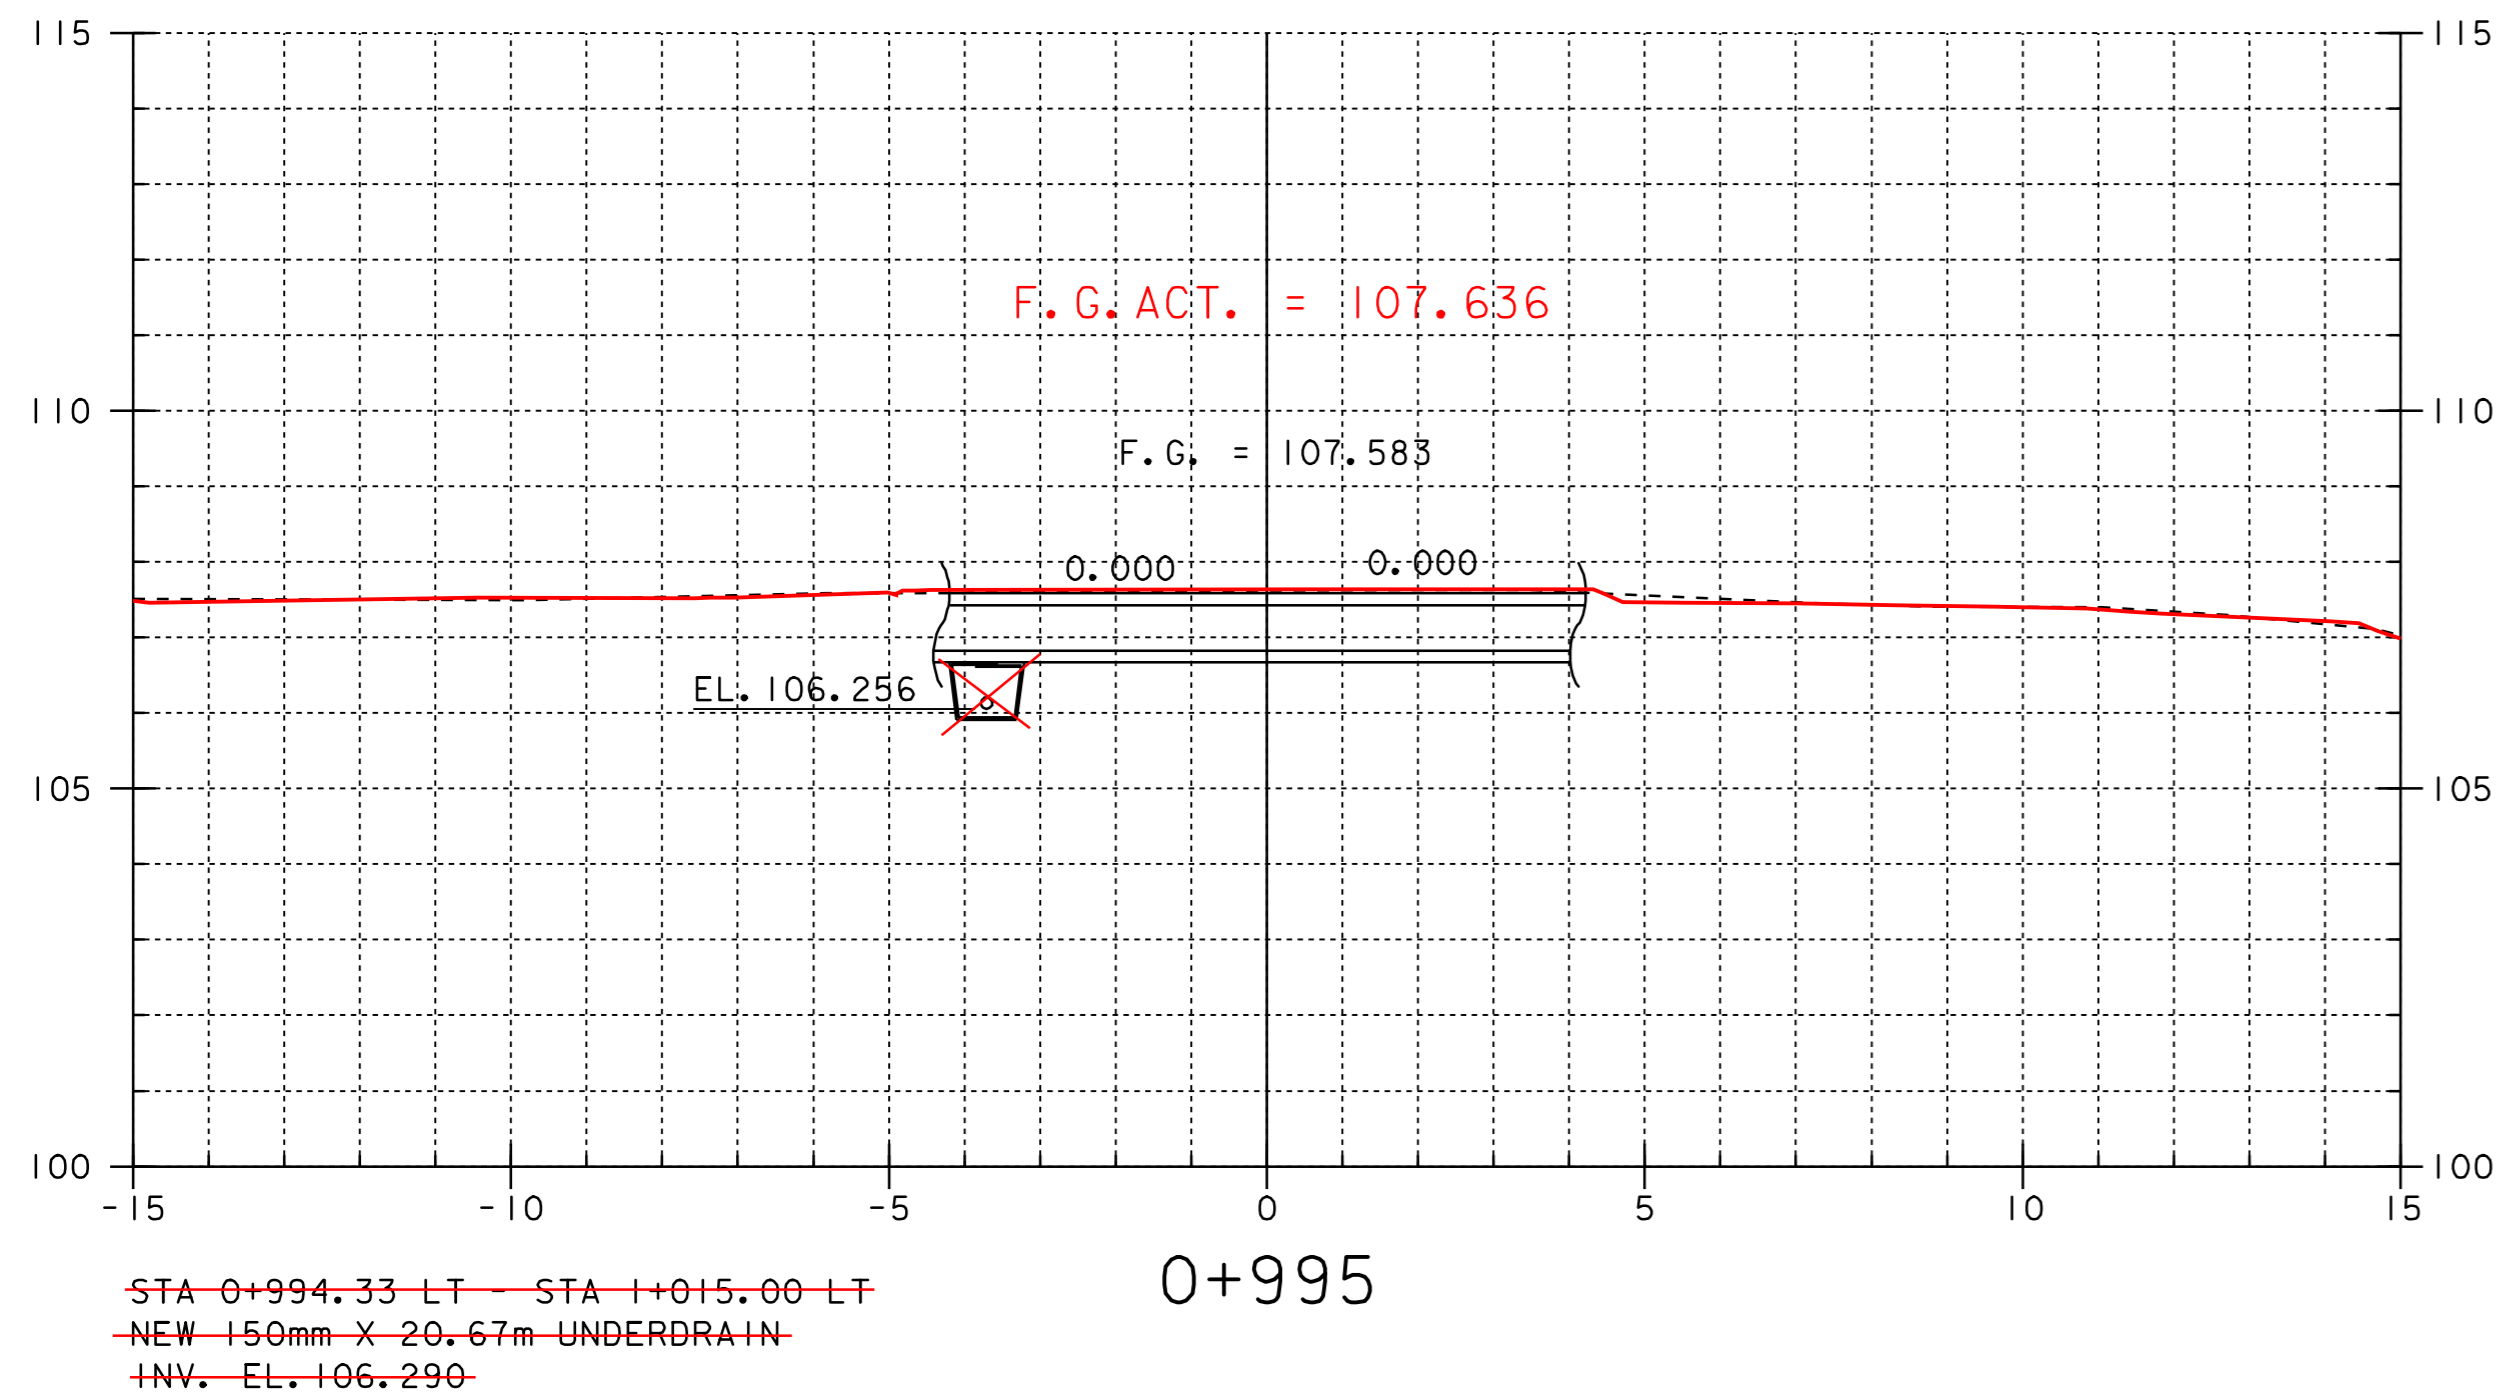


SHEET NAME: <u>MAINLINE CROSS SECTIONS</u>	
PROJECT NAME: <u>LEICESTER</u>	HIGHWAY NO.: <u>EAS_0160</u>
PROJECT NUMBER: <u>BRE_0160(3)S</u>	BRIDGE NO.: <u>6</u>
	OVER: <u>QUIER CREEK</u>
FILE NAME: <u>95J288\Structures\sj288xsl.dgn</u>	PLOT DATE: <u>02-OCT-2008 11:00</u>
PROJECT MANAGER: <u>B.B.WHITCOMB</u>	DRAWN BY: <u>J.GILMORE</u>
DESIGNED BY: <u>C.CARLSON</u>	IPARM NAME: <u>sj088d3.i</u>
	SHEET <u>10</u> OF <u>90</u>




CONSTRUCT FIELD DRIVE
 STA 1+026 LT
 SEE SHEET 17 FOR
 FIELD DRIVE PROFILE

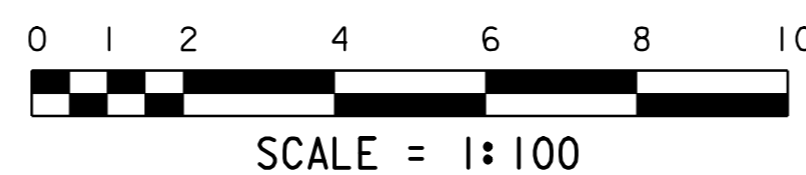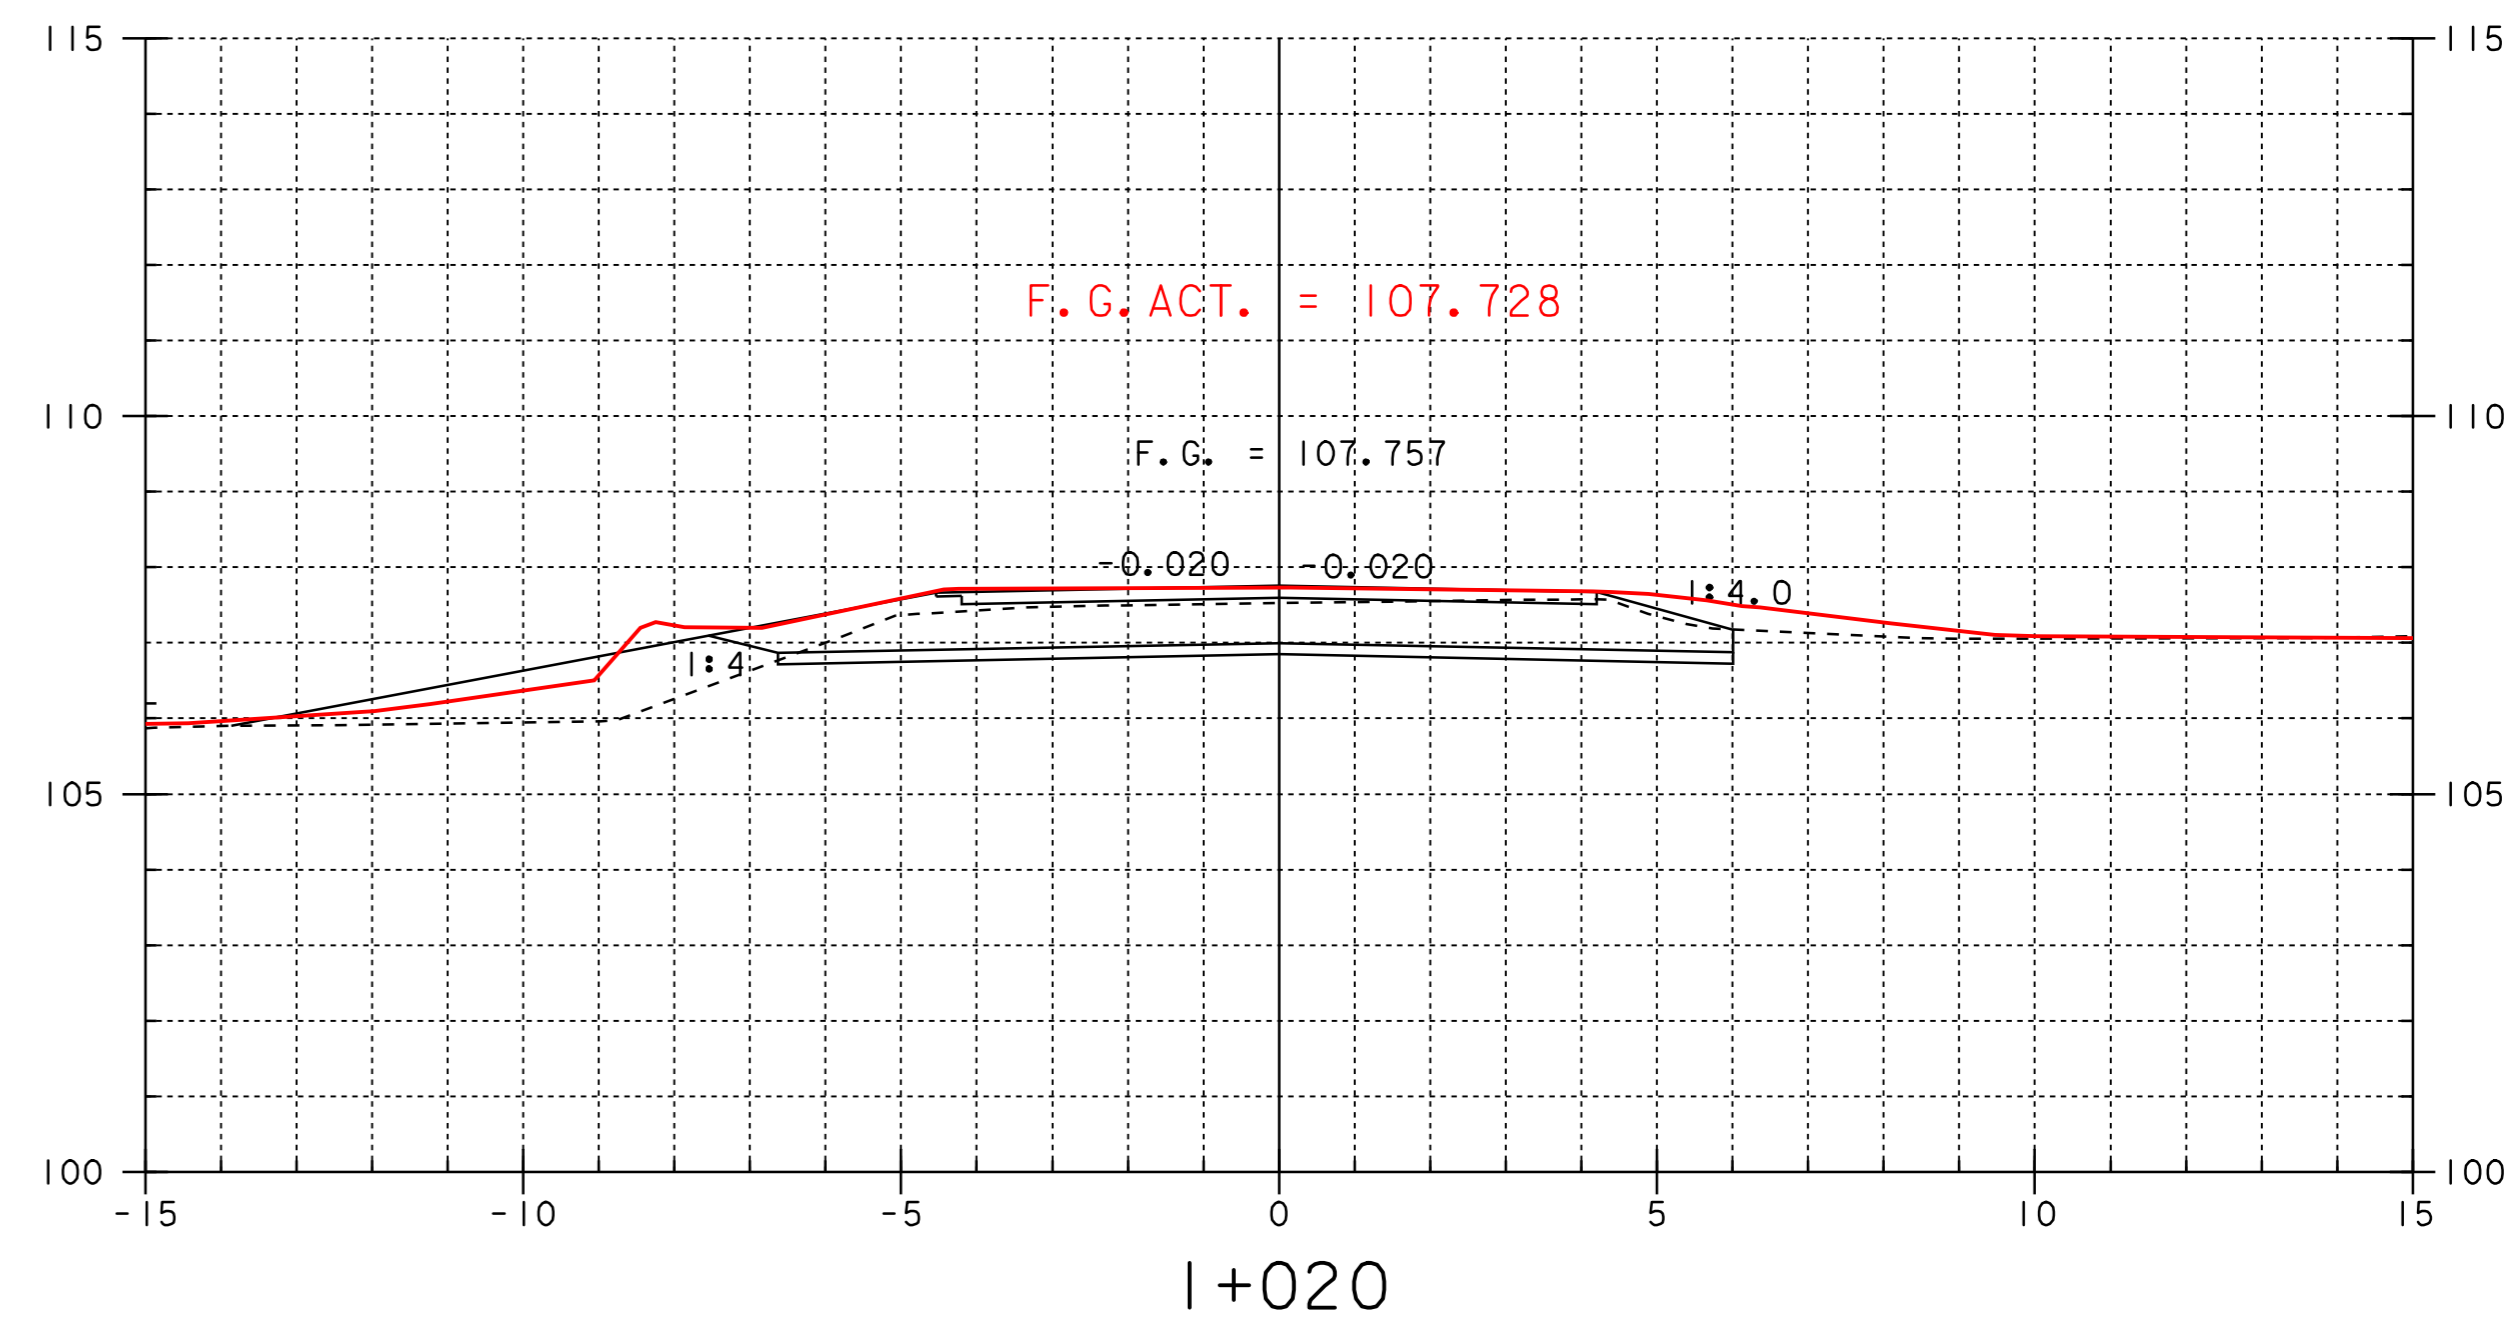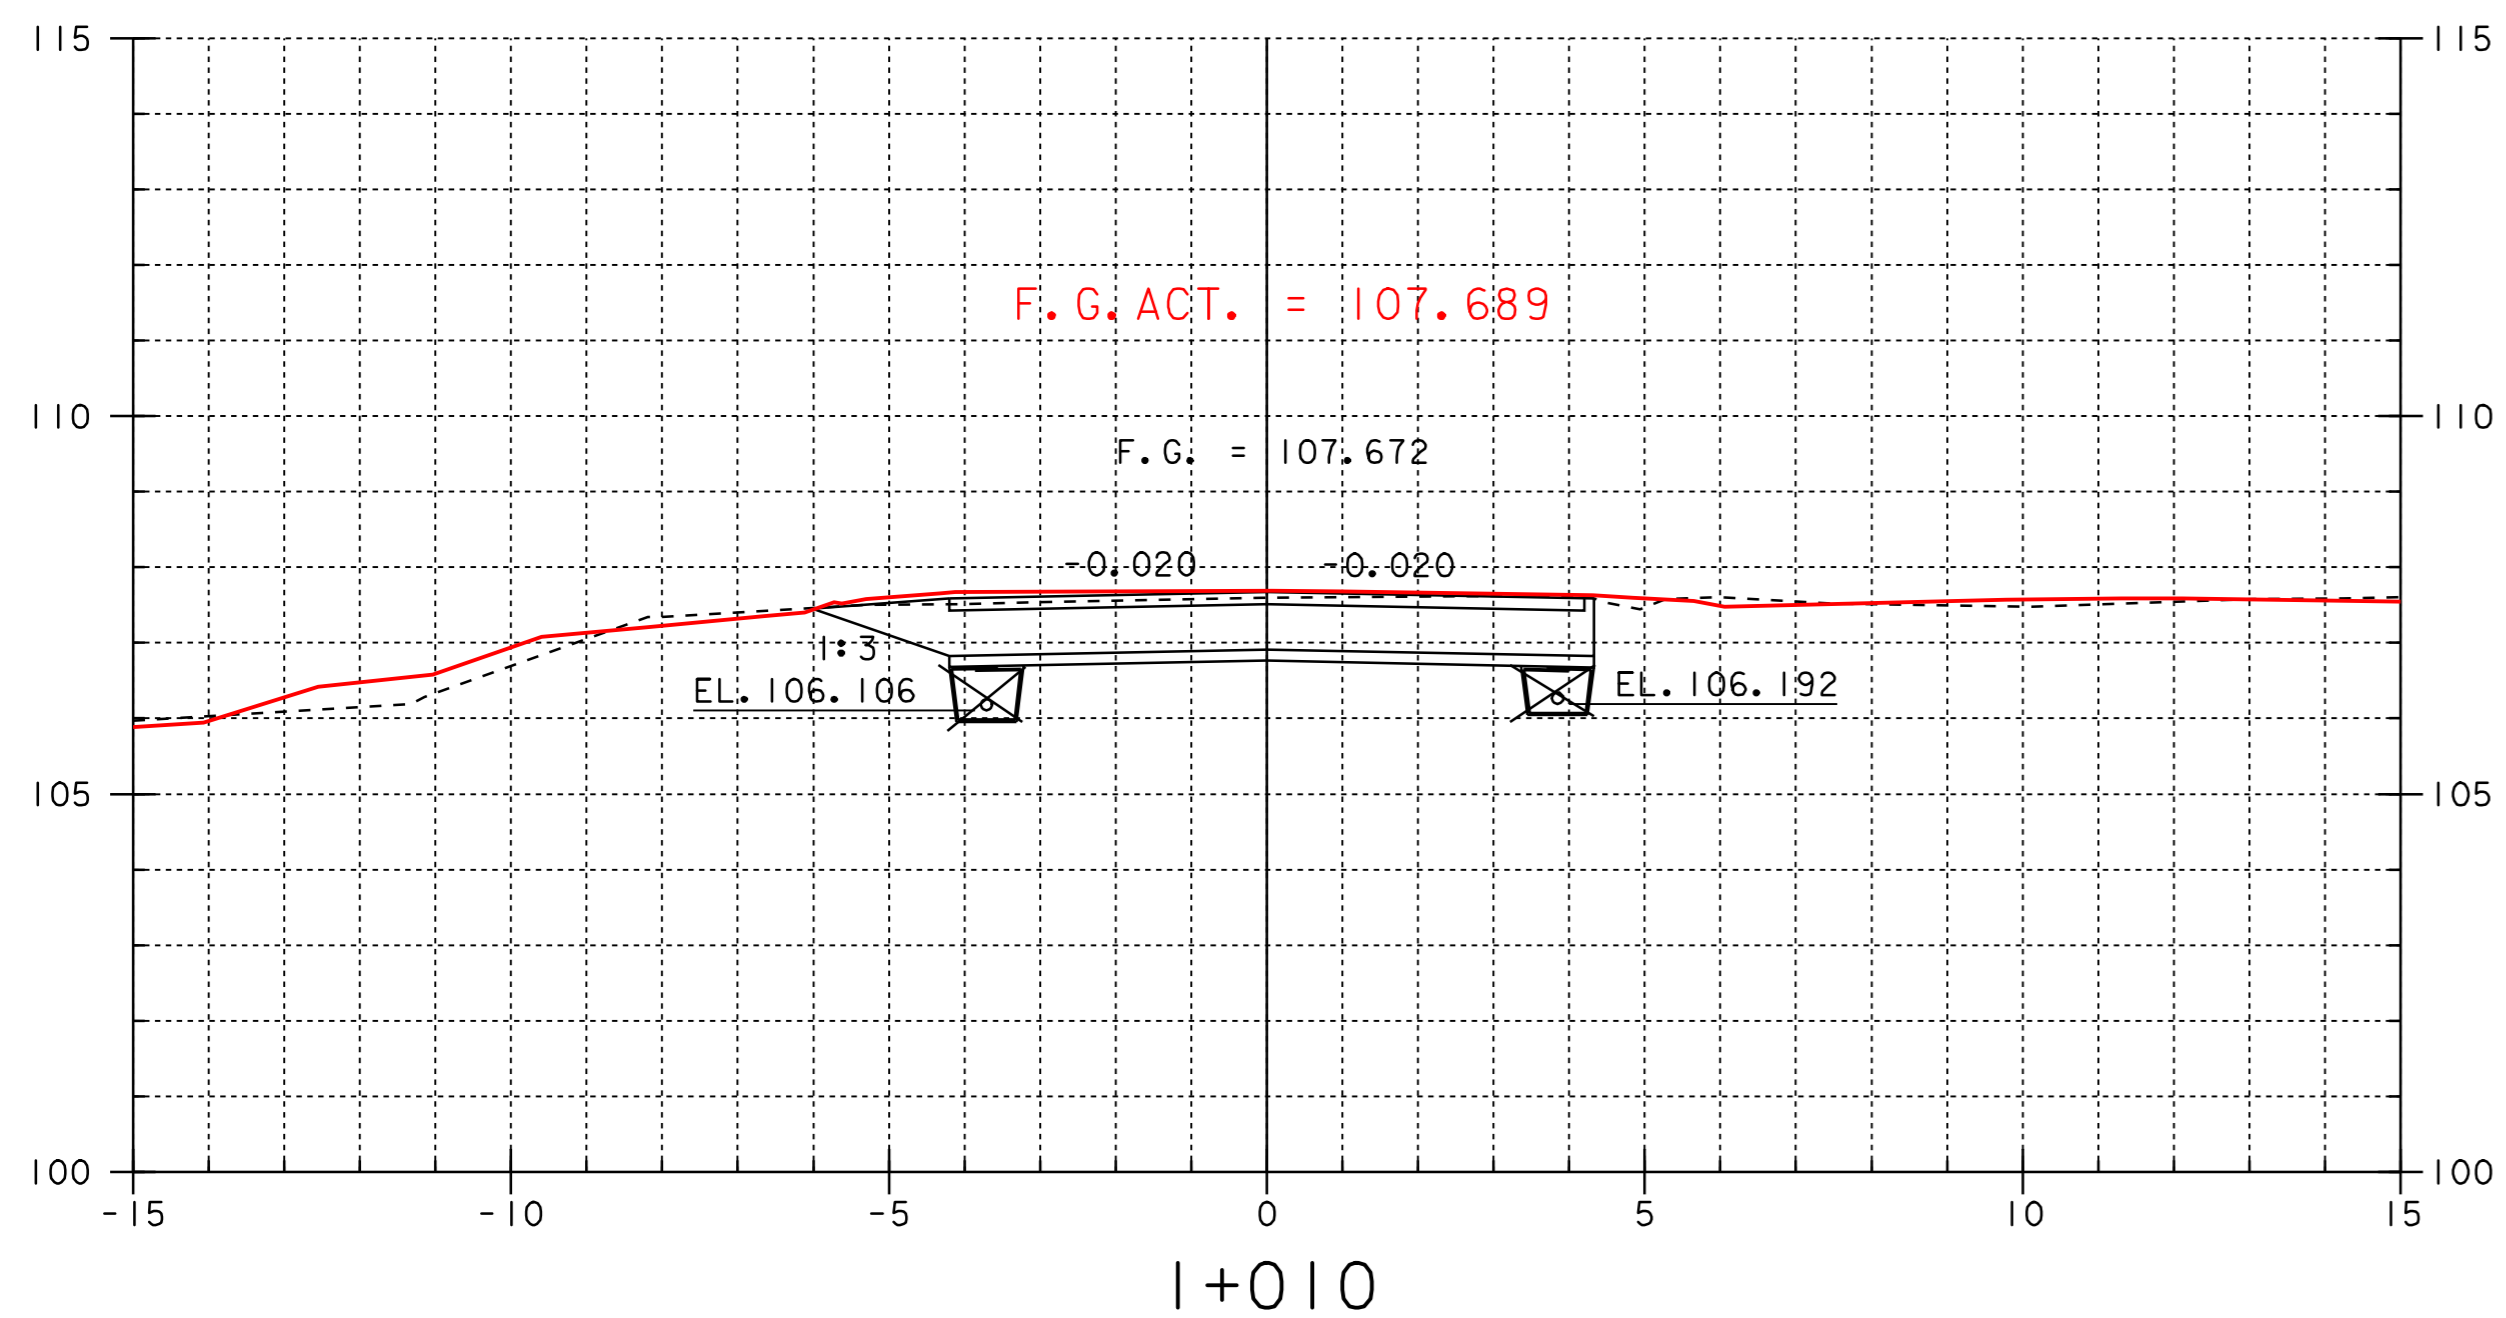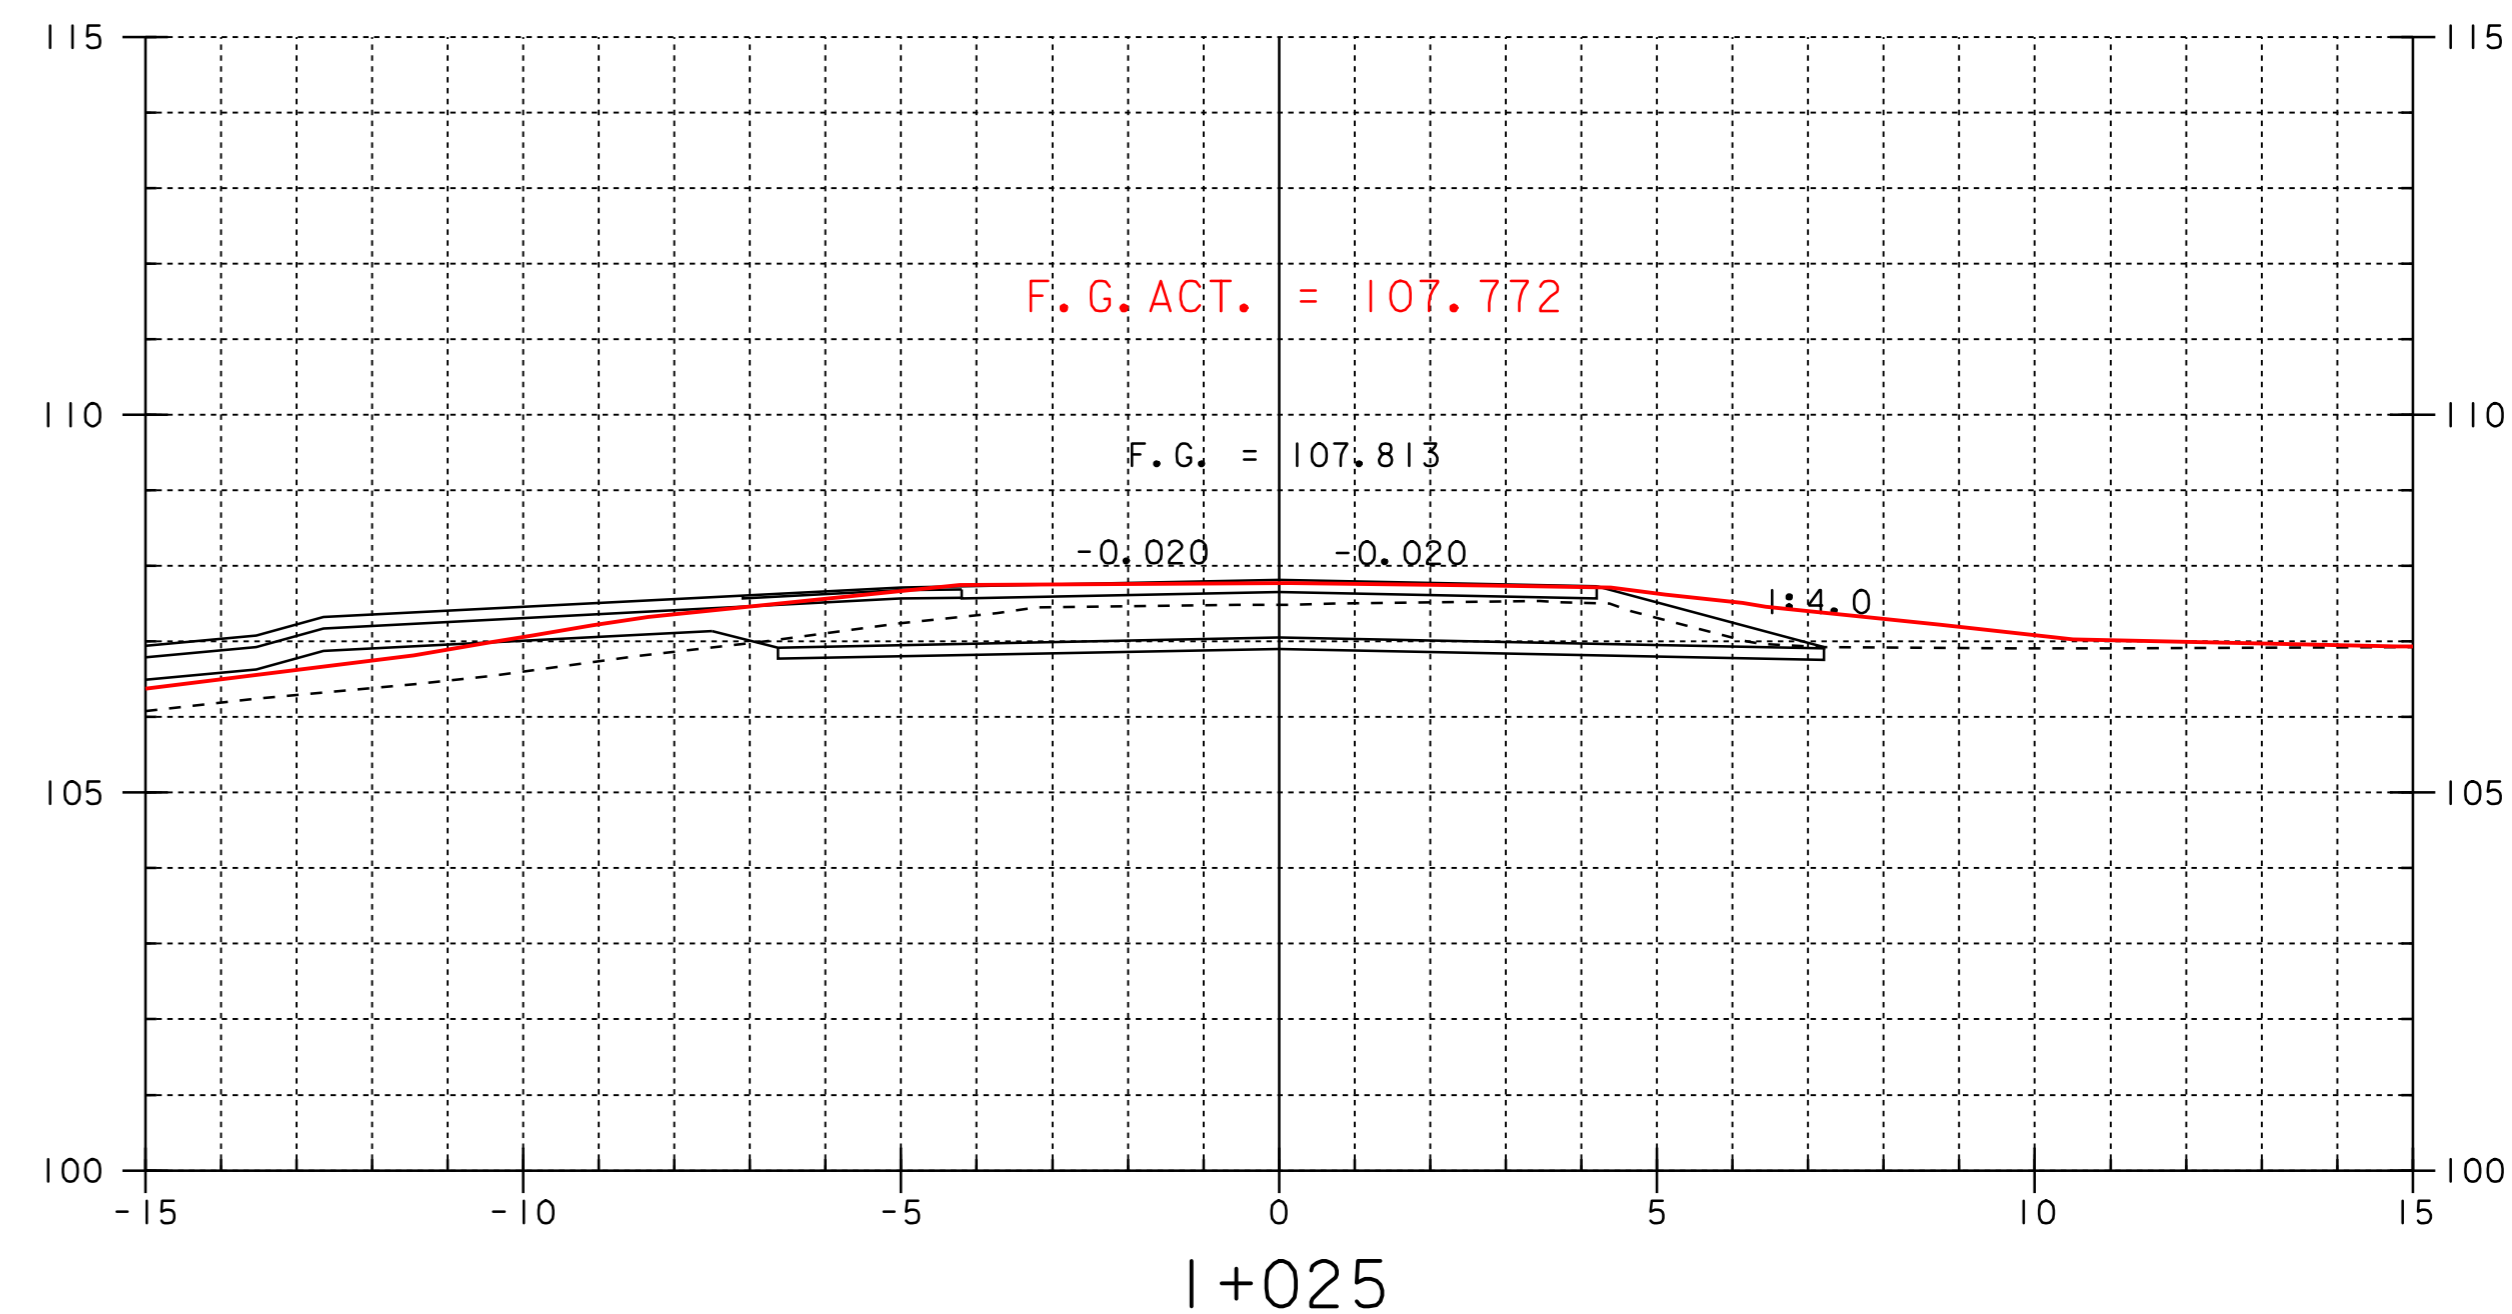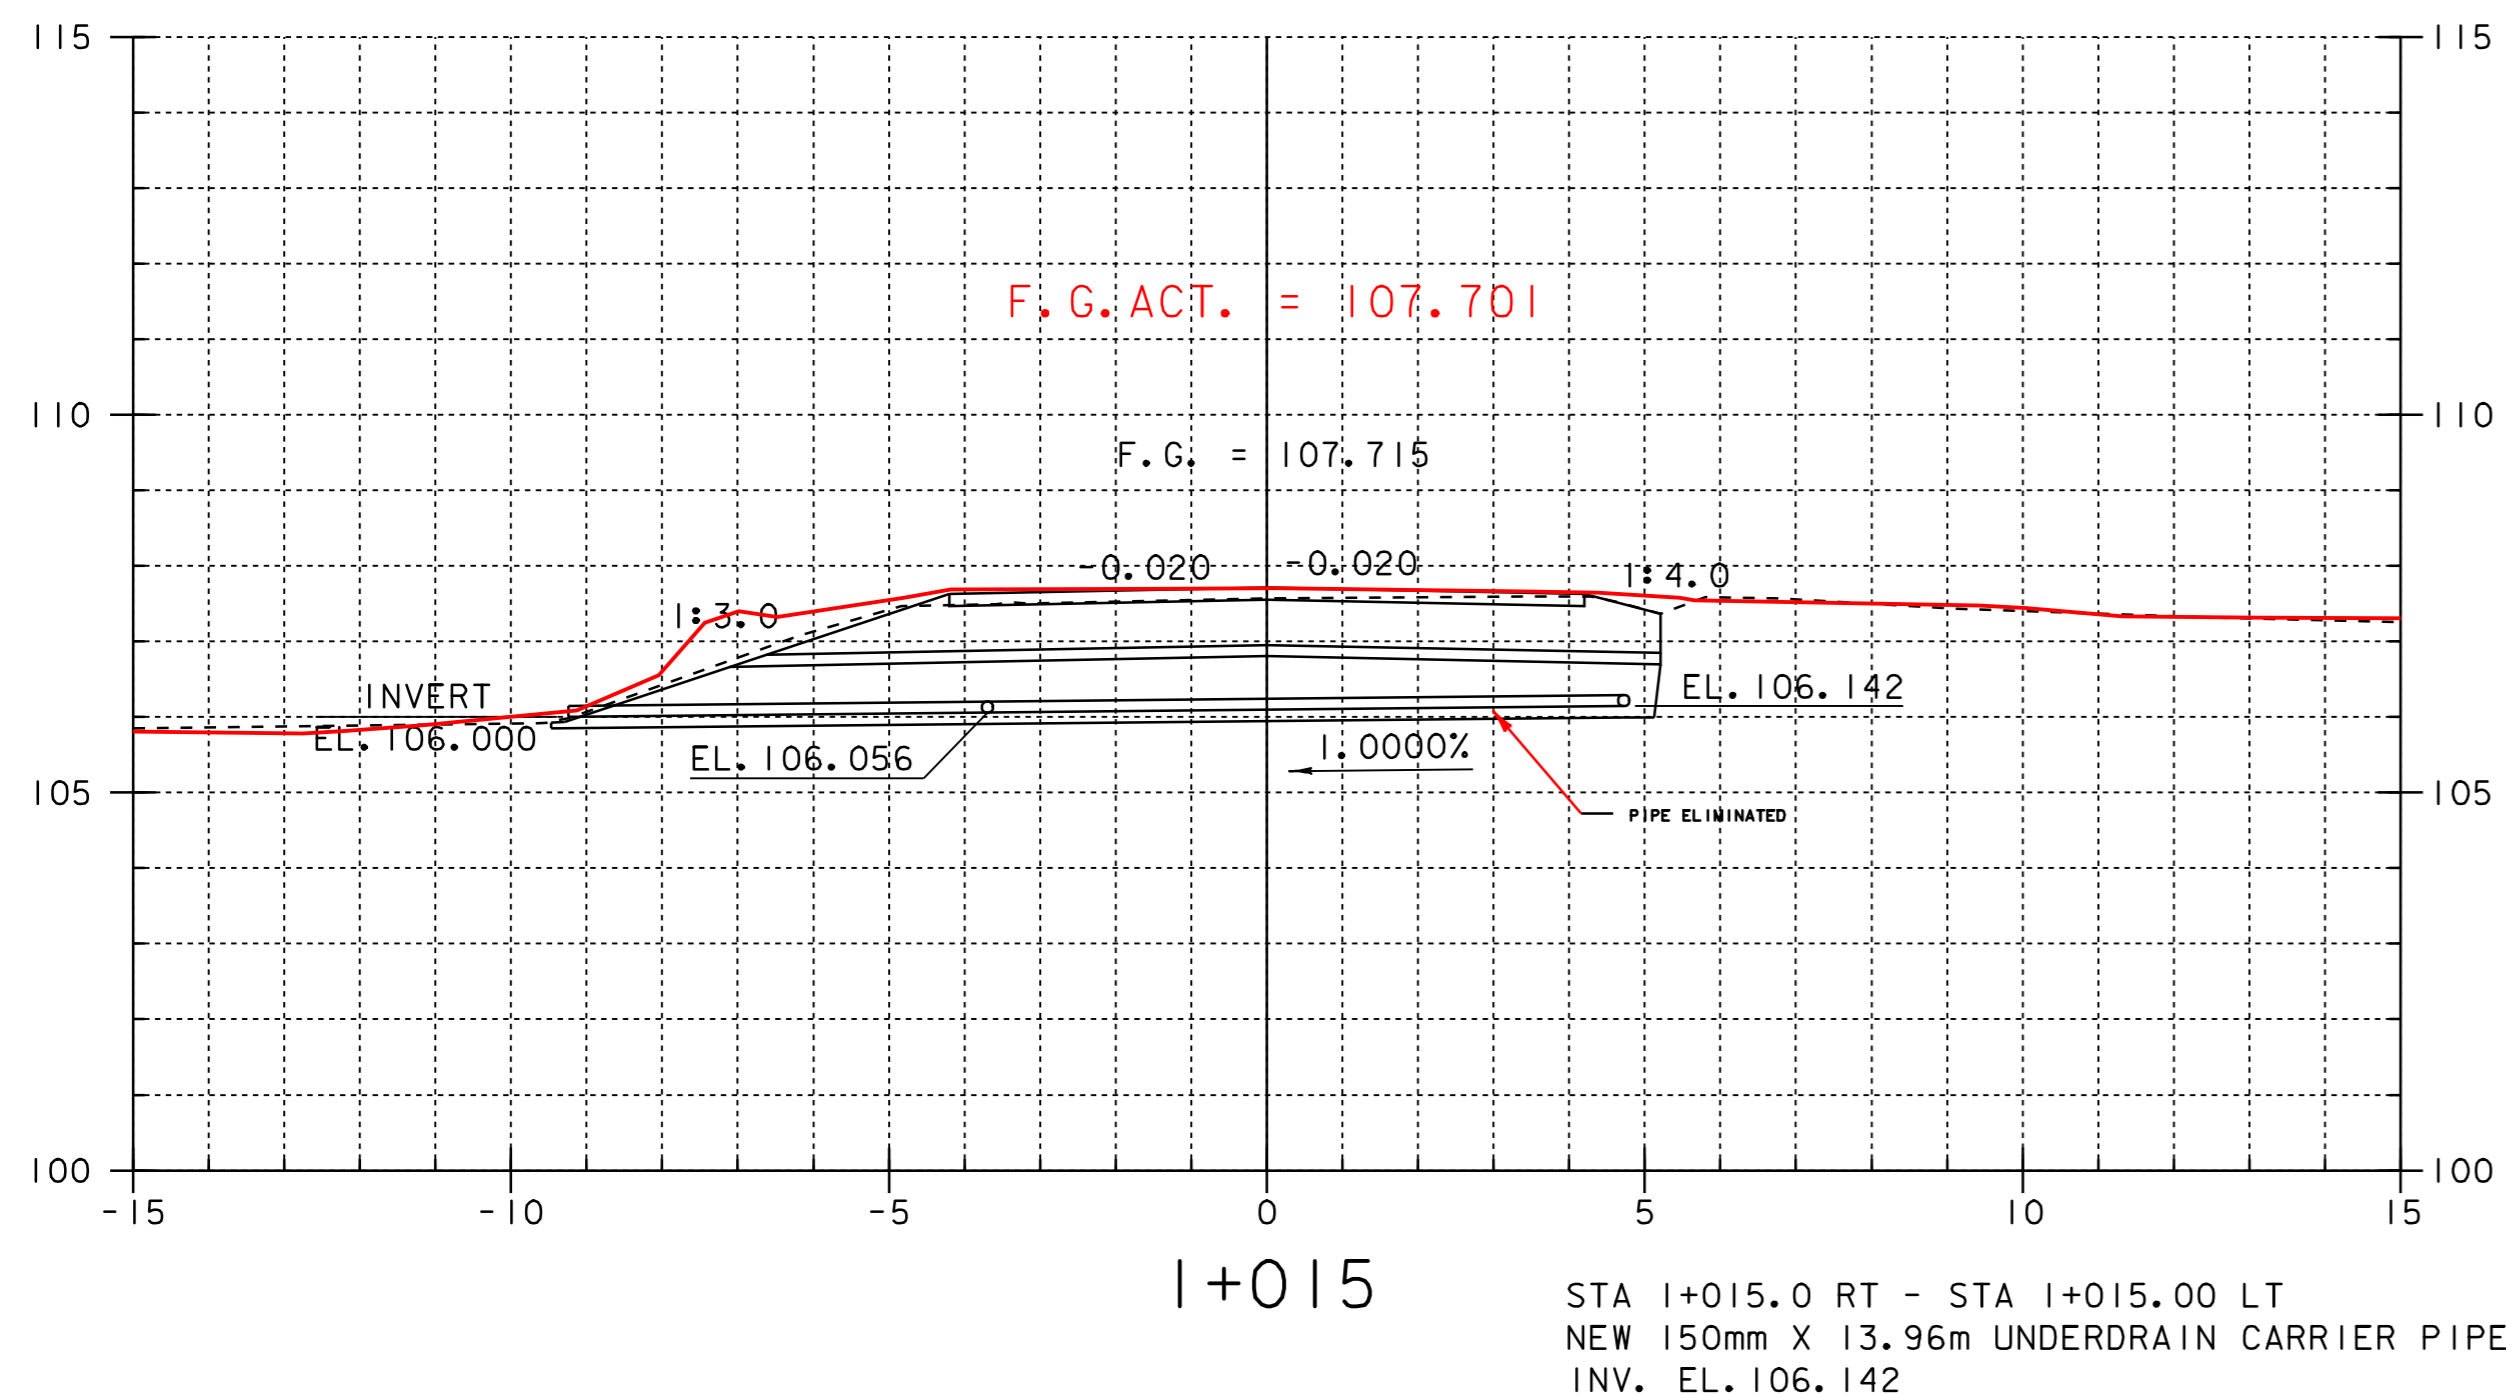





SHEET NAME: <u>MAINLINE CROSS SECTIONS</u>	
PROJECT NAME: <u>LEICESTER</u>	HIGHWAY NO.: <u>EAS_0160</u>
PROJECT NUMBER: <u>BRE_0160(3)S</u>	BRIDGE NO.: <u>6</u>
	OVER: <u>QUIER CREEK</u>
FILE NAME: <u>95J288\Structures\sj288xsl.dgn</u>	PLOT DATE: <u>02-OCT-2008 11:00</u>
PROJECT MANAGER: <u>B.B. WHITCOMB</u>	DRAWN BY: <u>J. GILMORE</u>
DESIGNED BY: <u>C. CARLSON</u>	IPARM NAME: <u>sj088dr4.l</u>
	SHEET <u>11</u> OF <u>20</u>

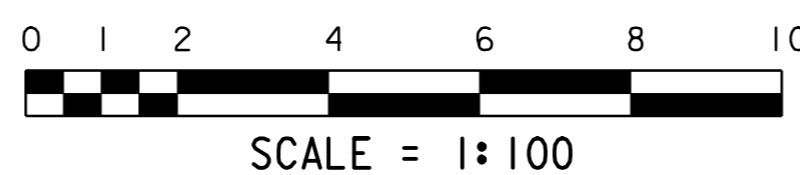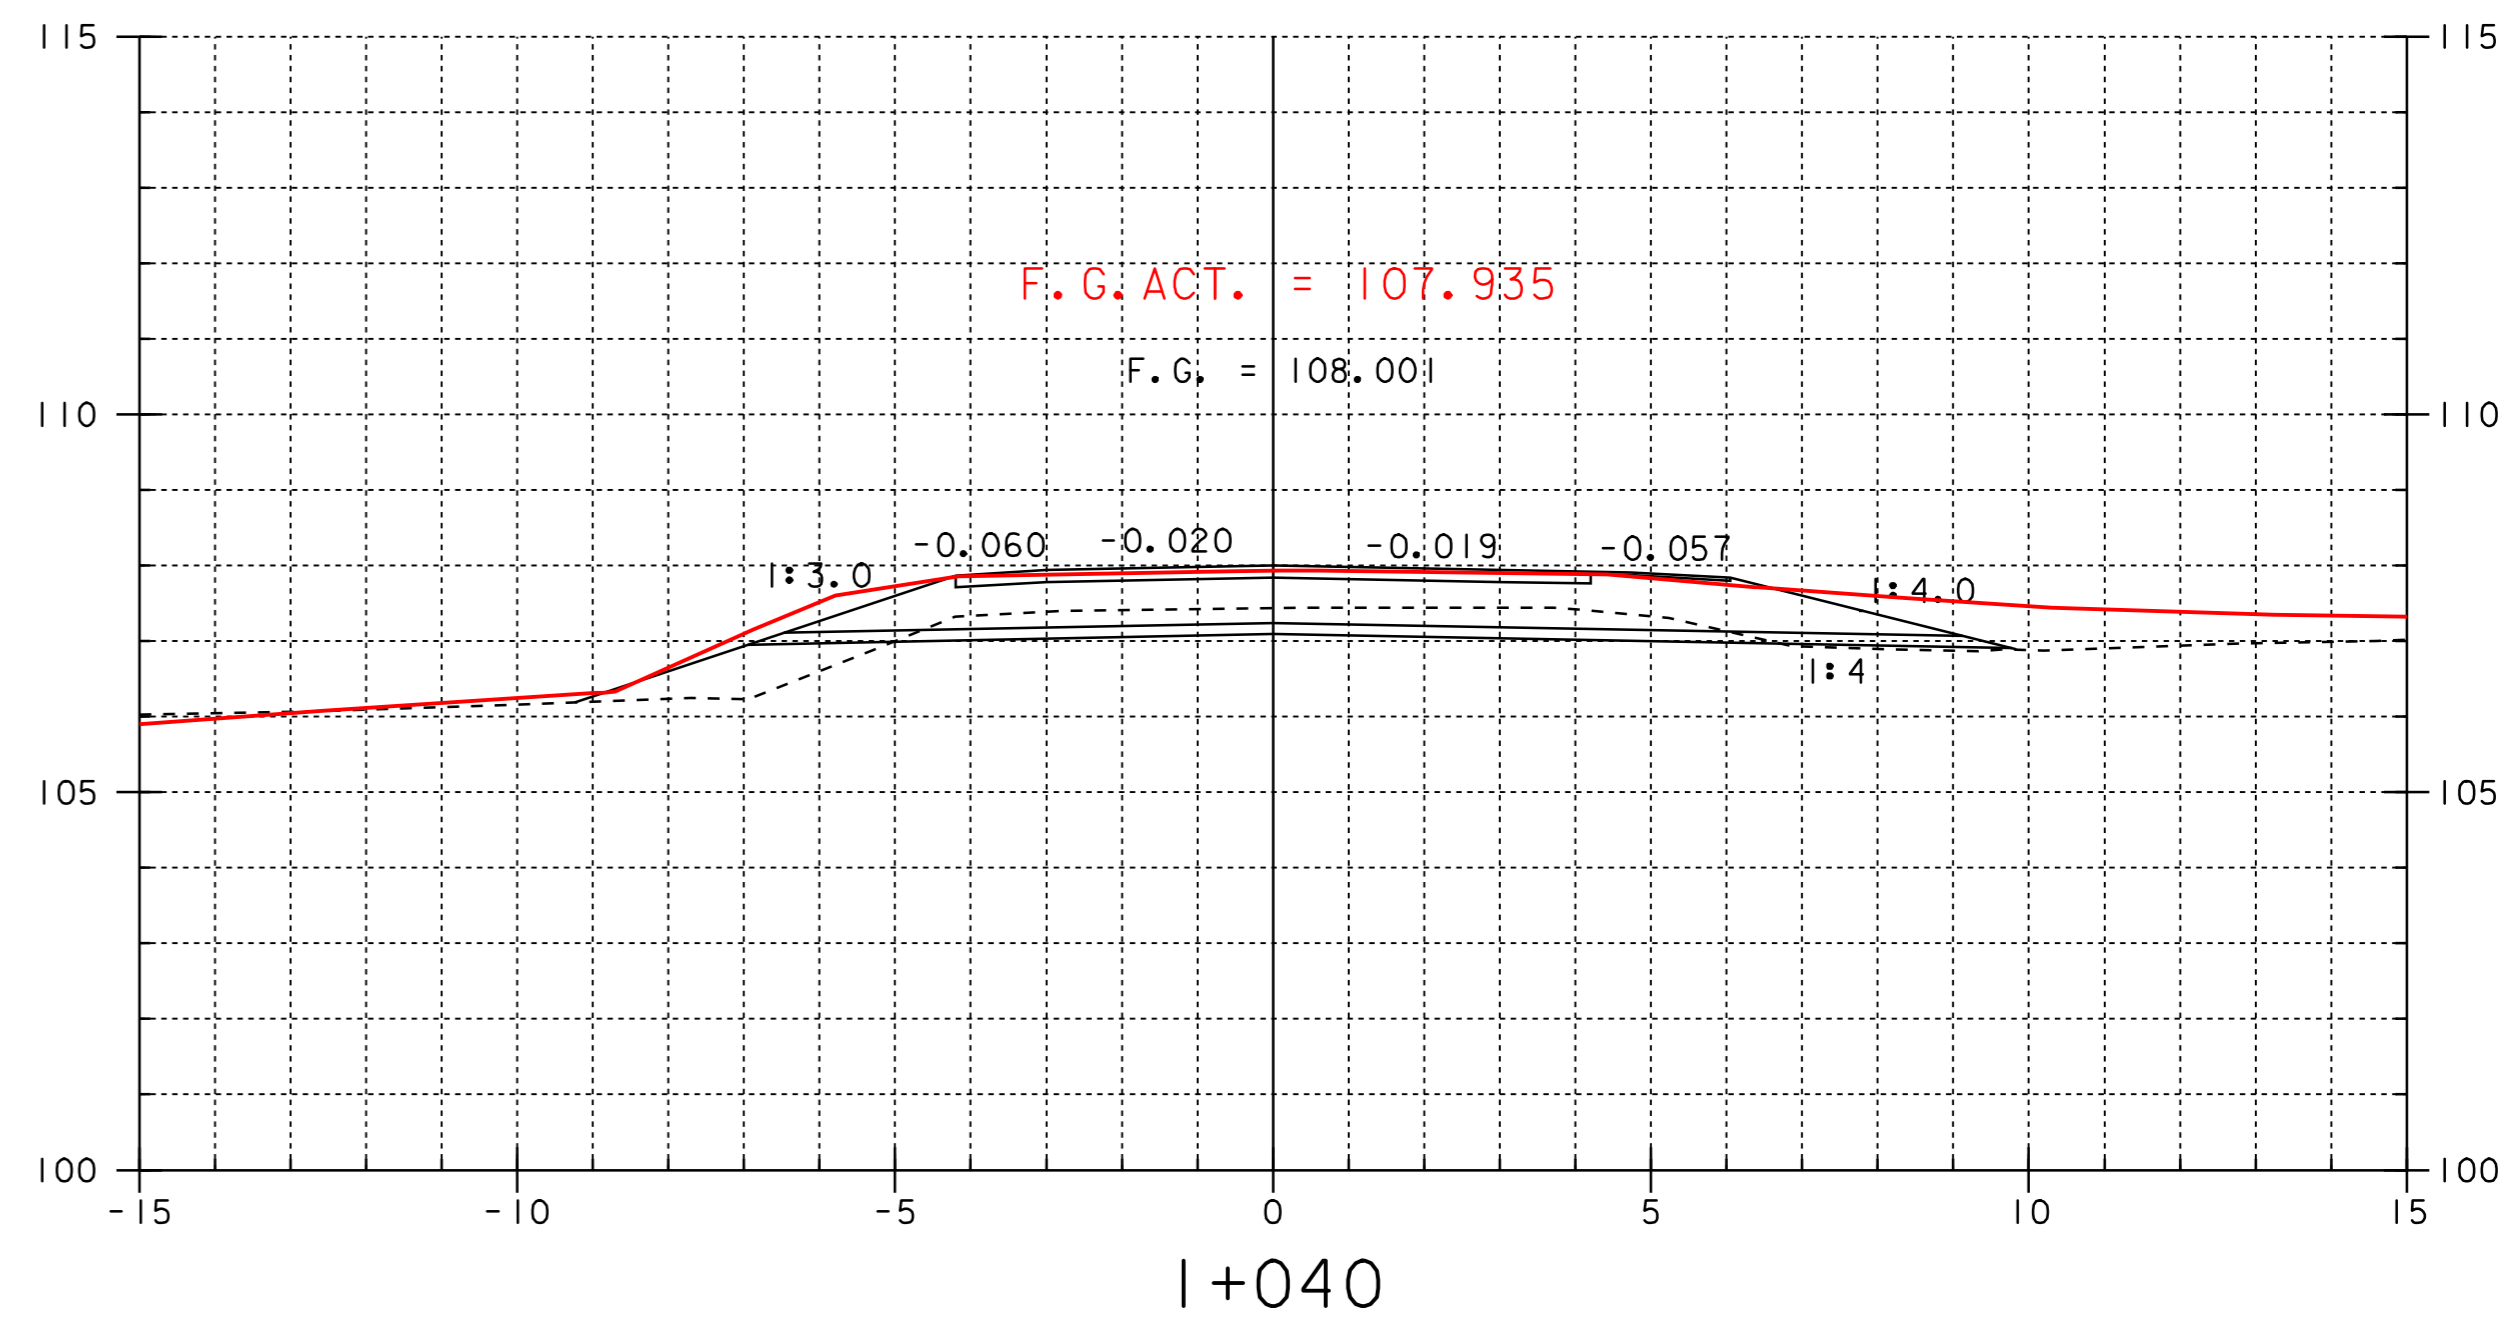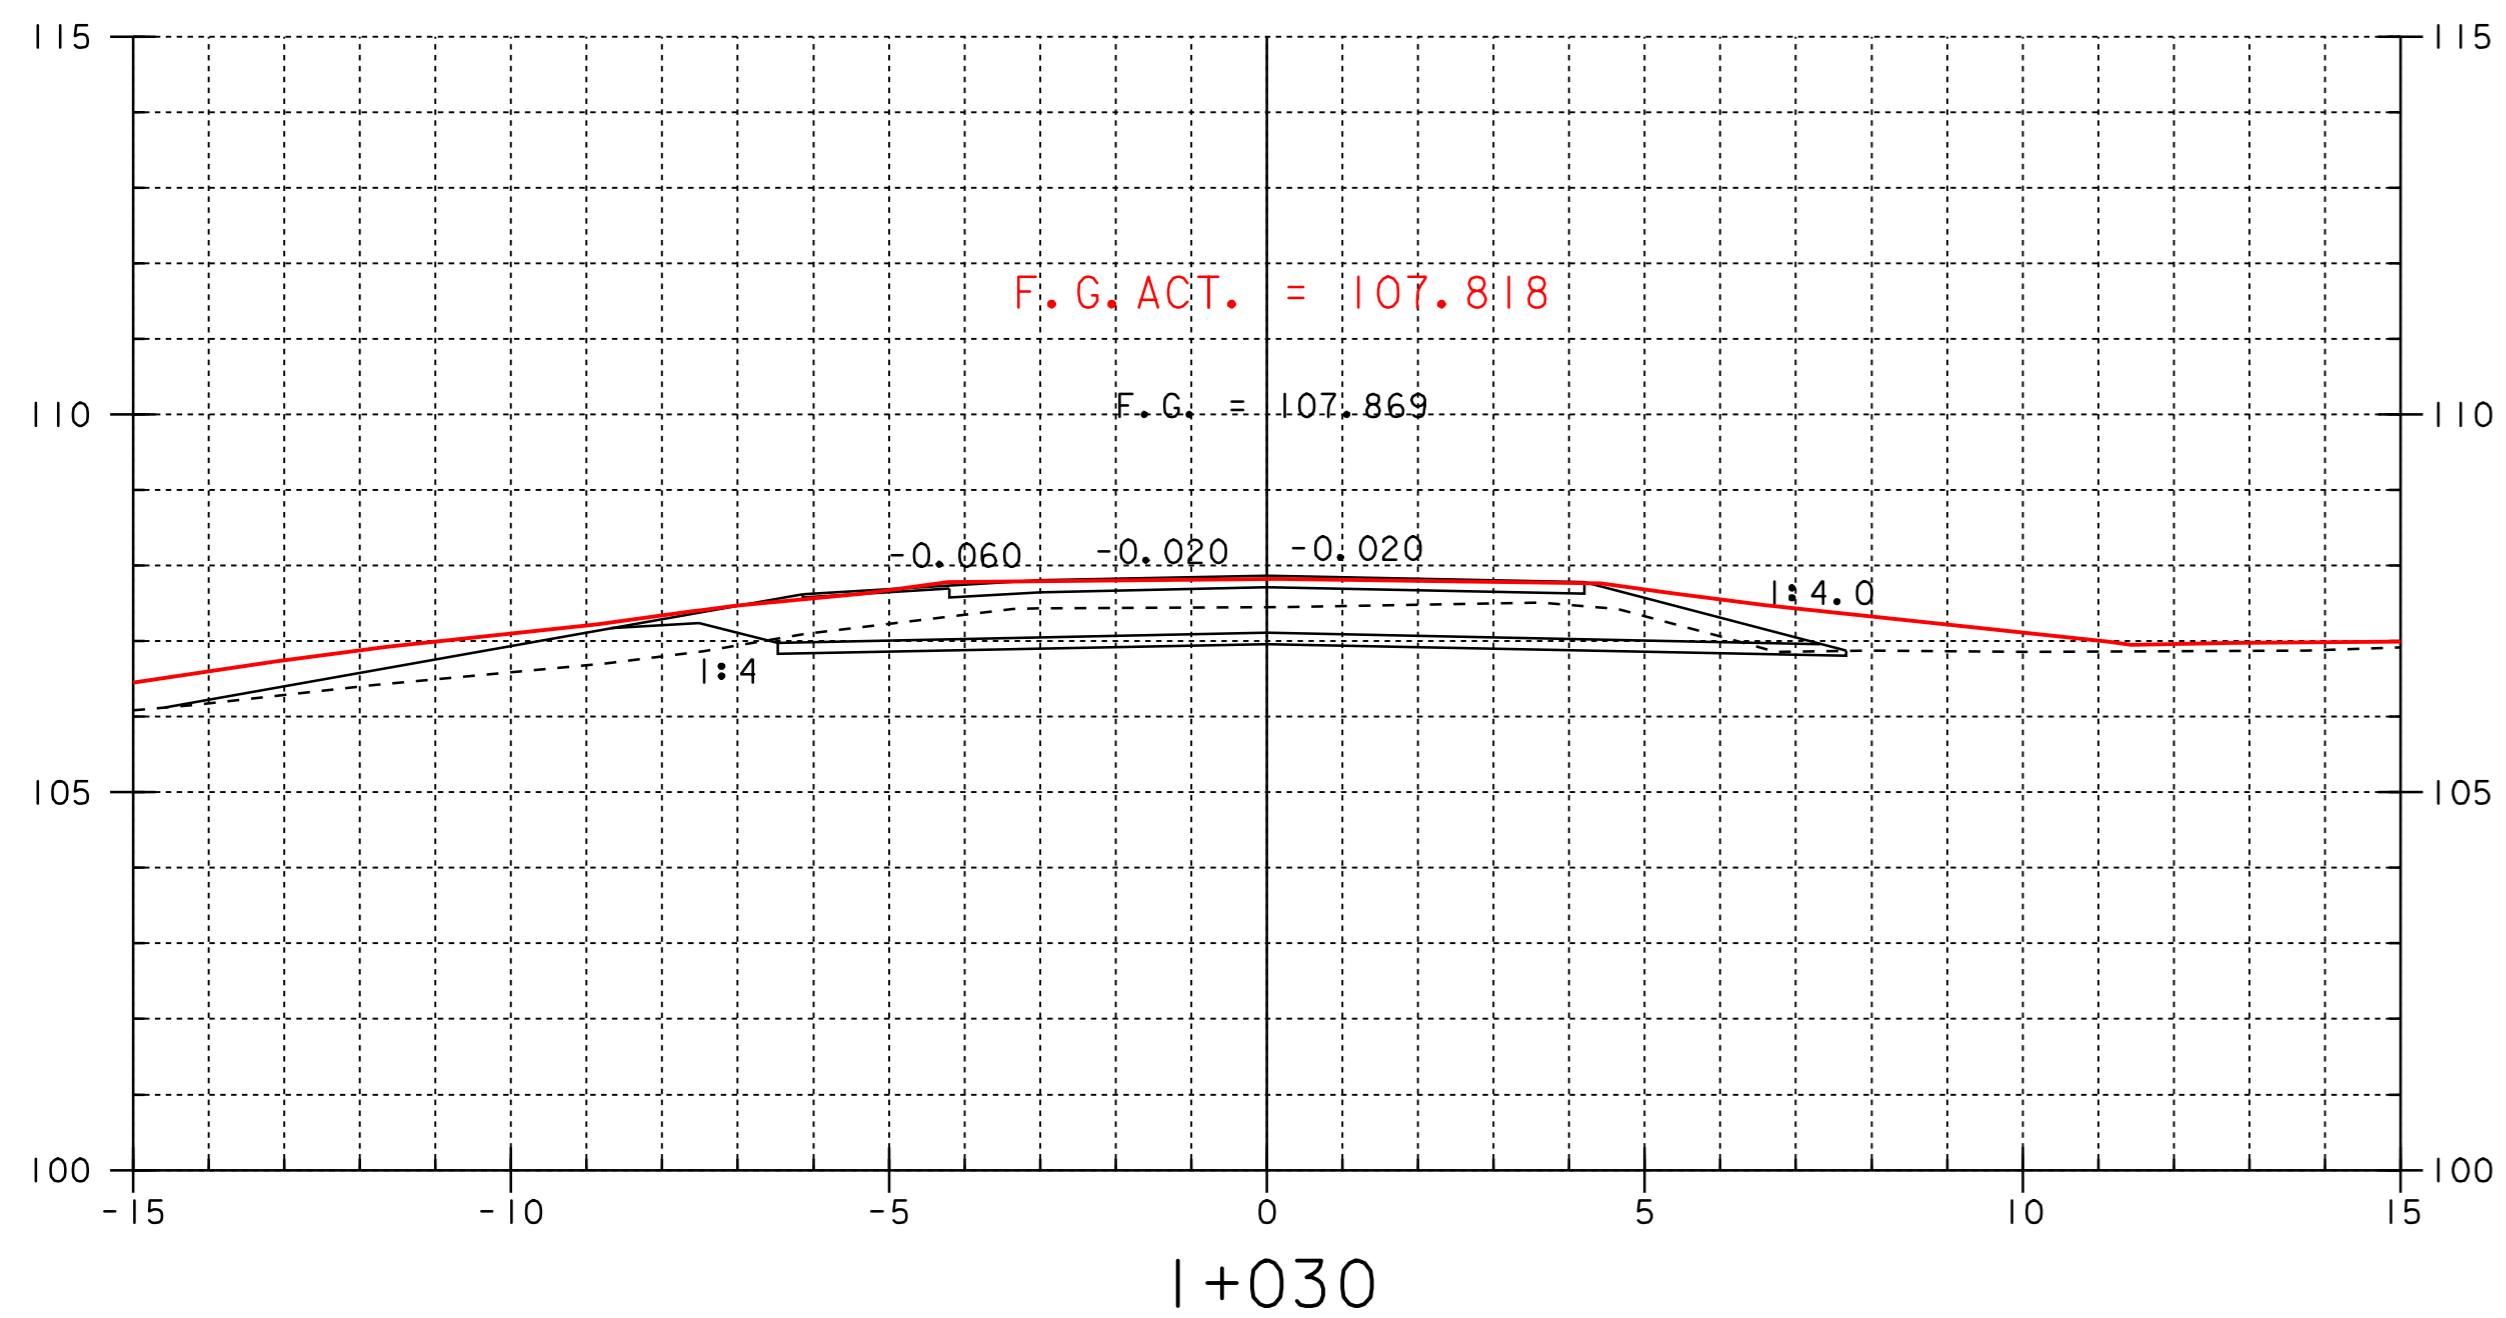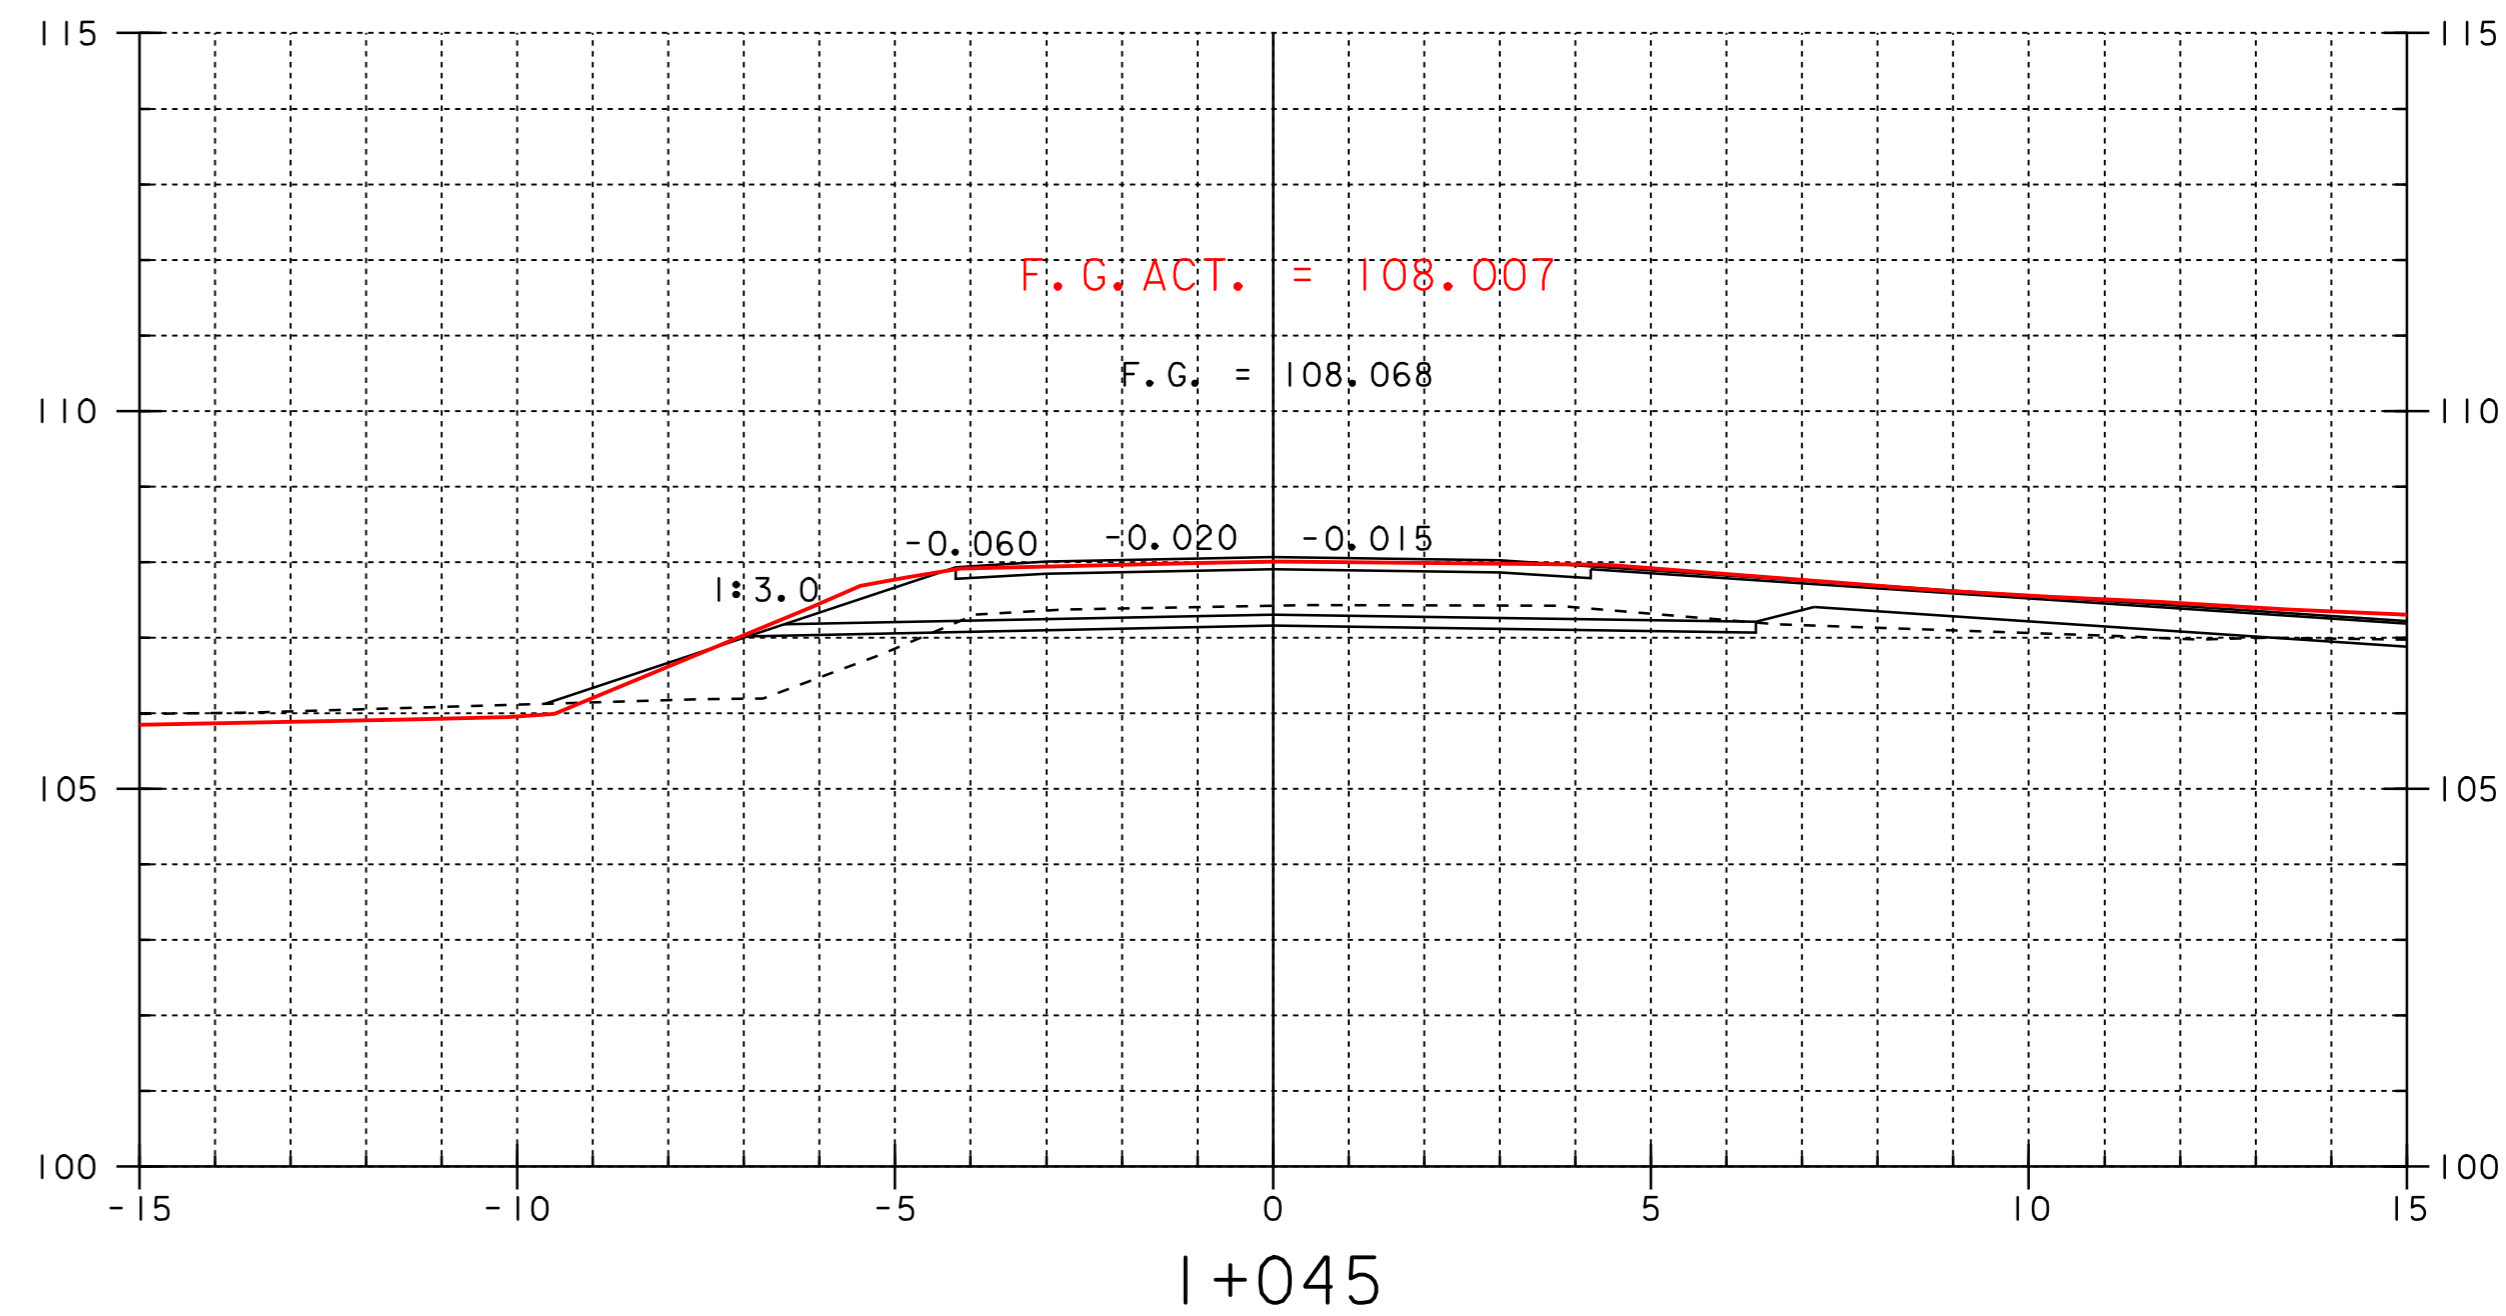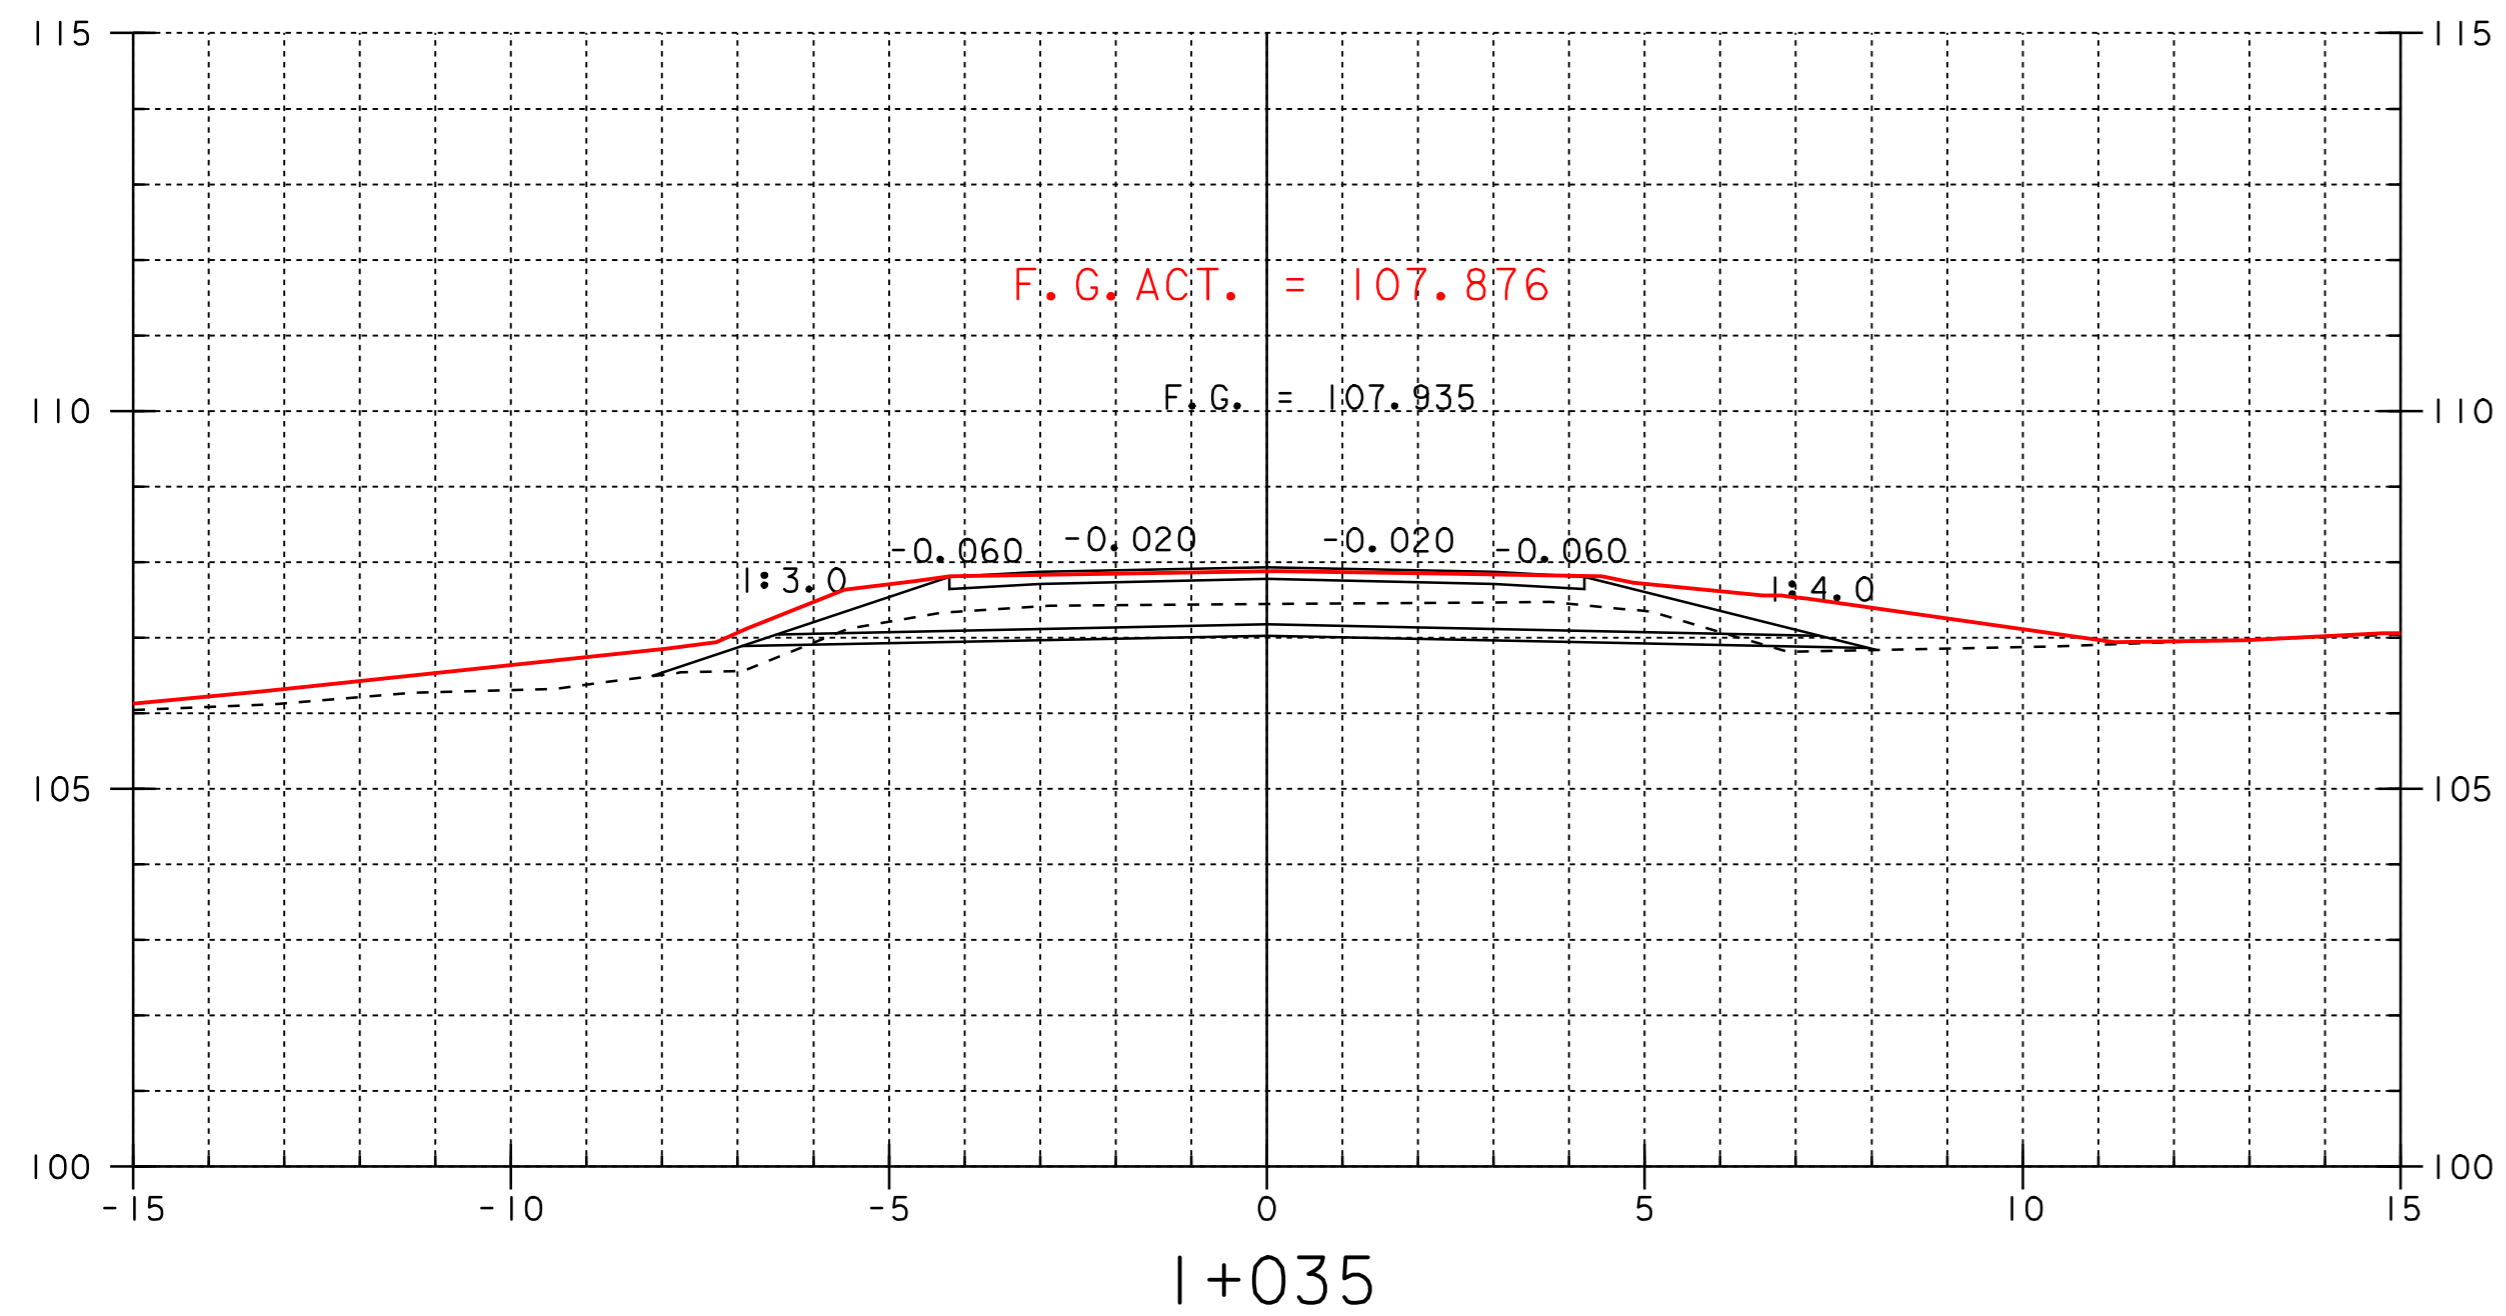


SHEET NAME: <u>MAINLINE CROSS SECTIONS</u>		
PROJECT NAME: <u>LEICESTER</u>	HIGHWAY NO.: <u>EAS_0160</u>	
PROJECT NUMBER: <u>BRE_0160(3)S</u>	BRIDGE NO.: <u>6</u>	OVER: <u>QUIER CREEK</u>
FILE NAME: <u>95J288\Structures\sj288xsl.dgn</u>	PLOT DATE: <u>02-OCT-2008 11:00</u>	
PROJECT MANAGER: <u>B.B. WHITCOMB</u>	DRAWN BY: <u>J. GILMORE</u>	
DESIGNED BY: <u>C. CARLSON</u>	IPARM NAME: <u>sj088dr5.l</u>	
		SHEET <u>72</u> OF <u>90</u>

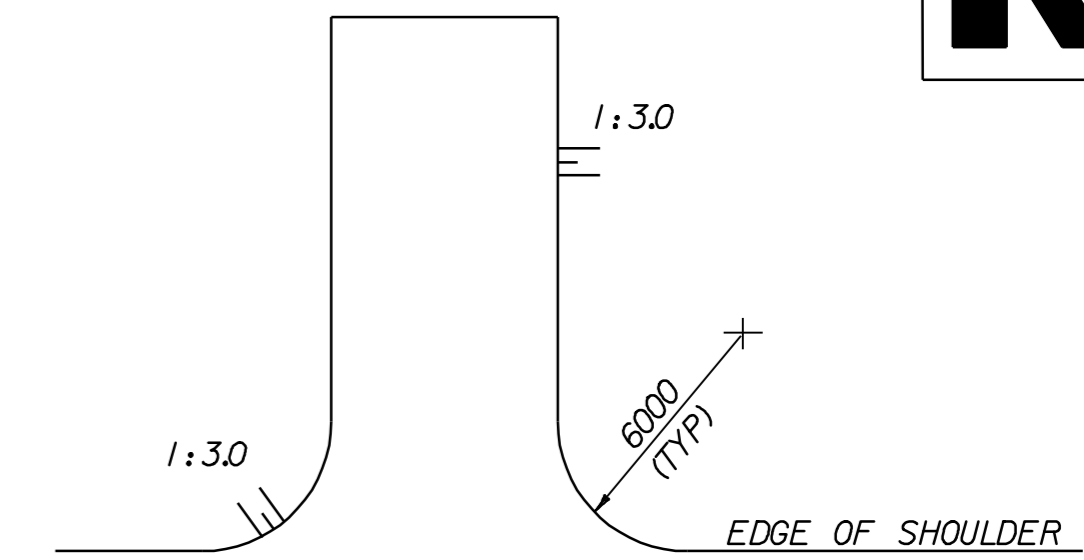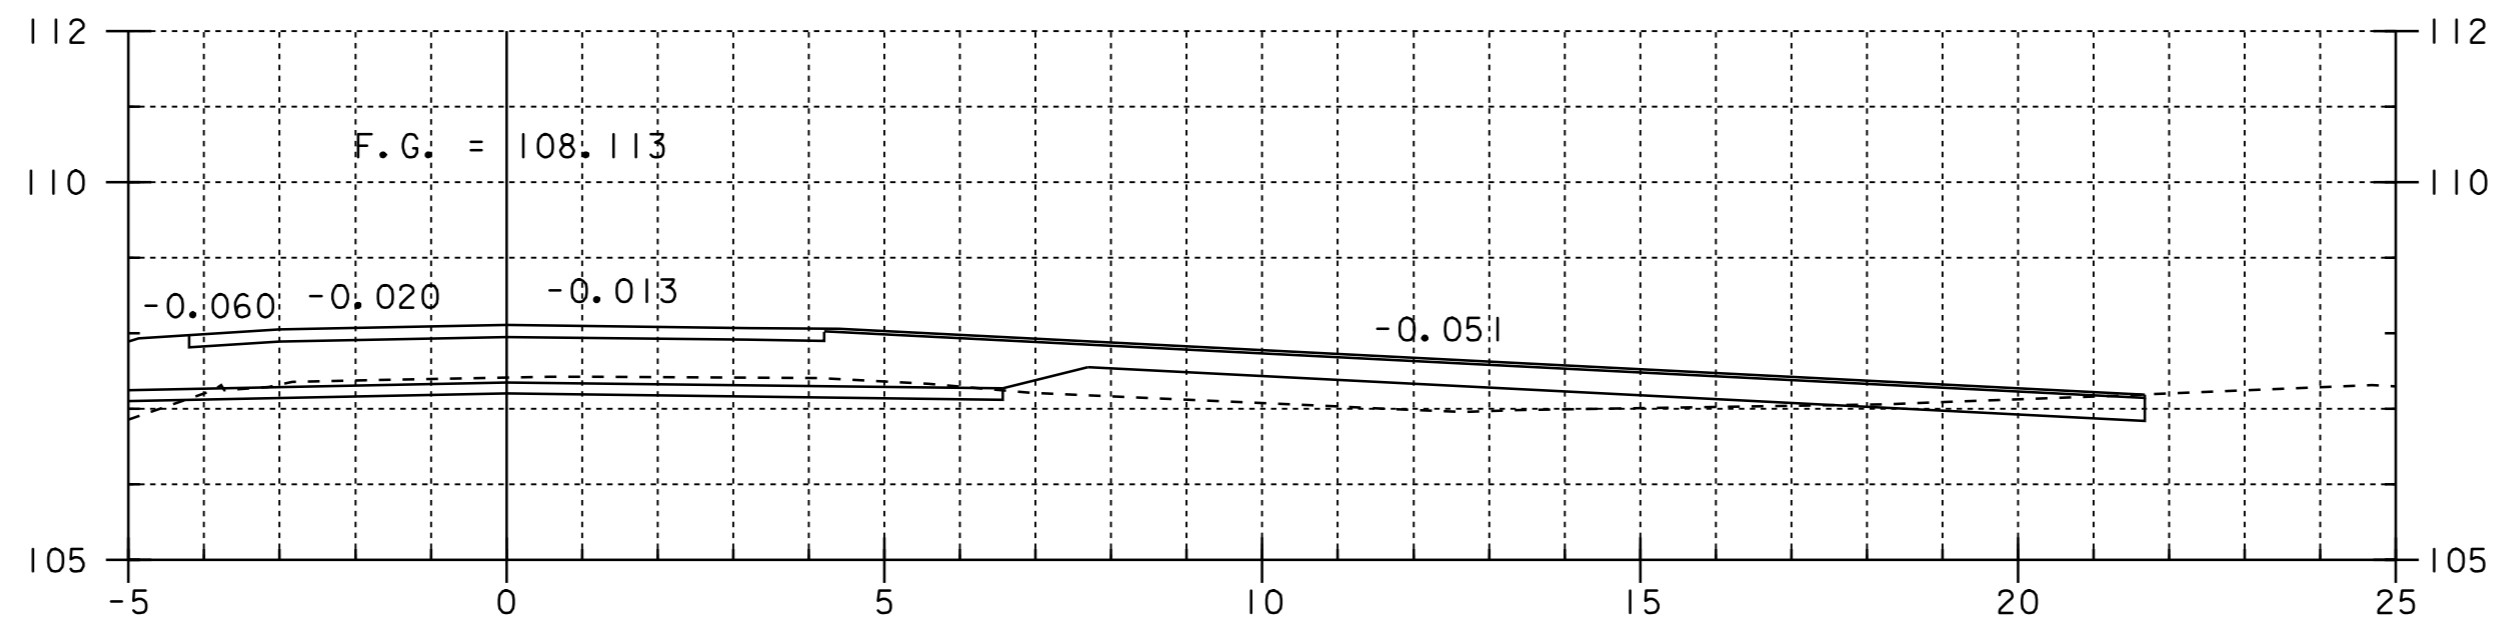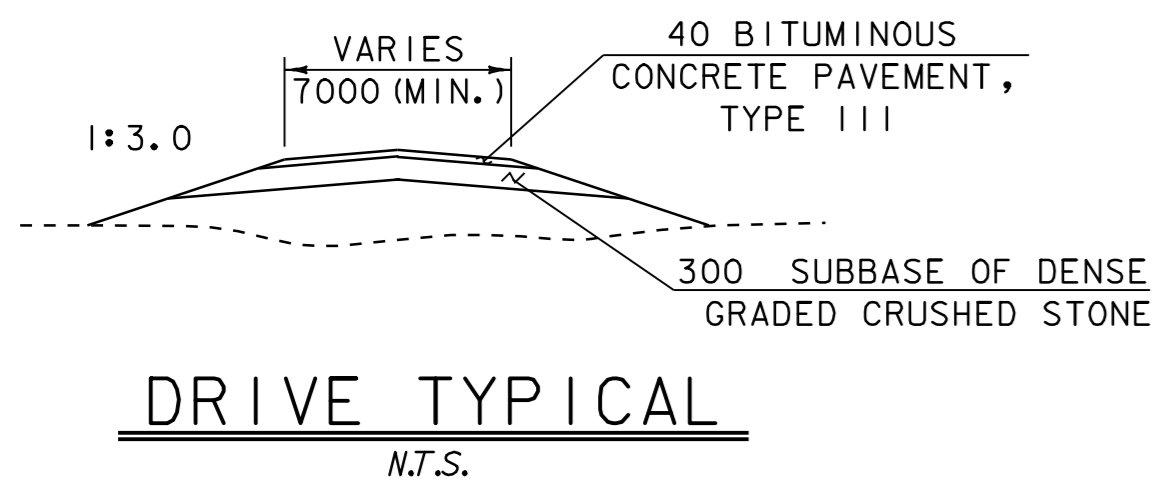


I+048.381
DRIVE RIGHT
SKEW = 20.128°

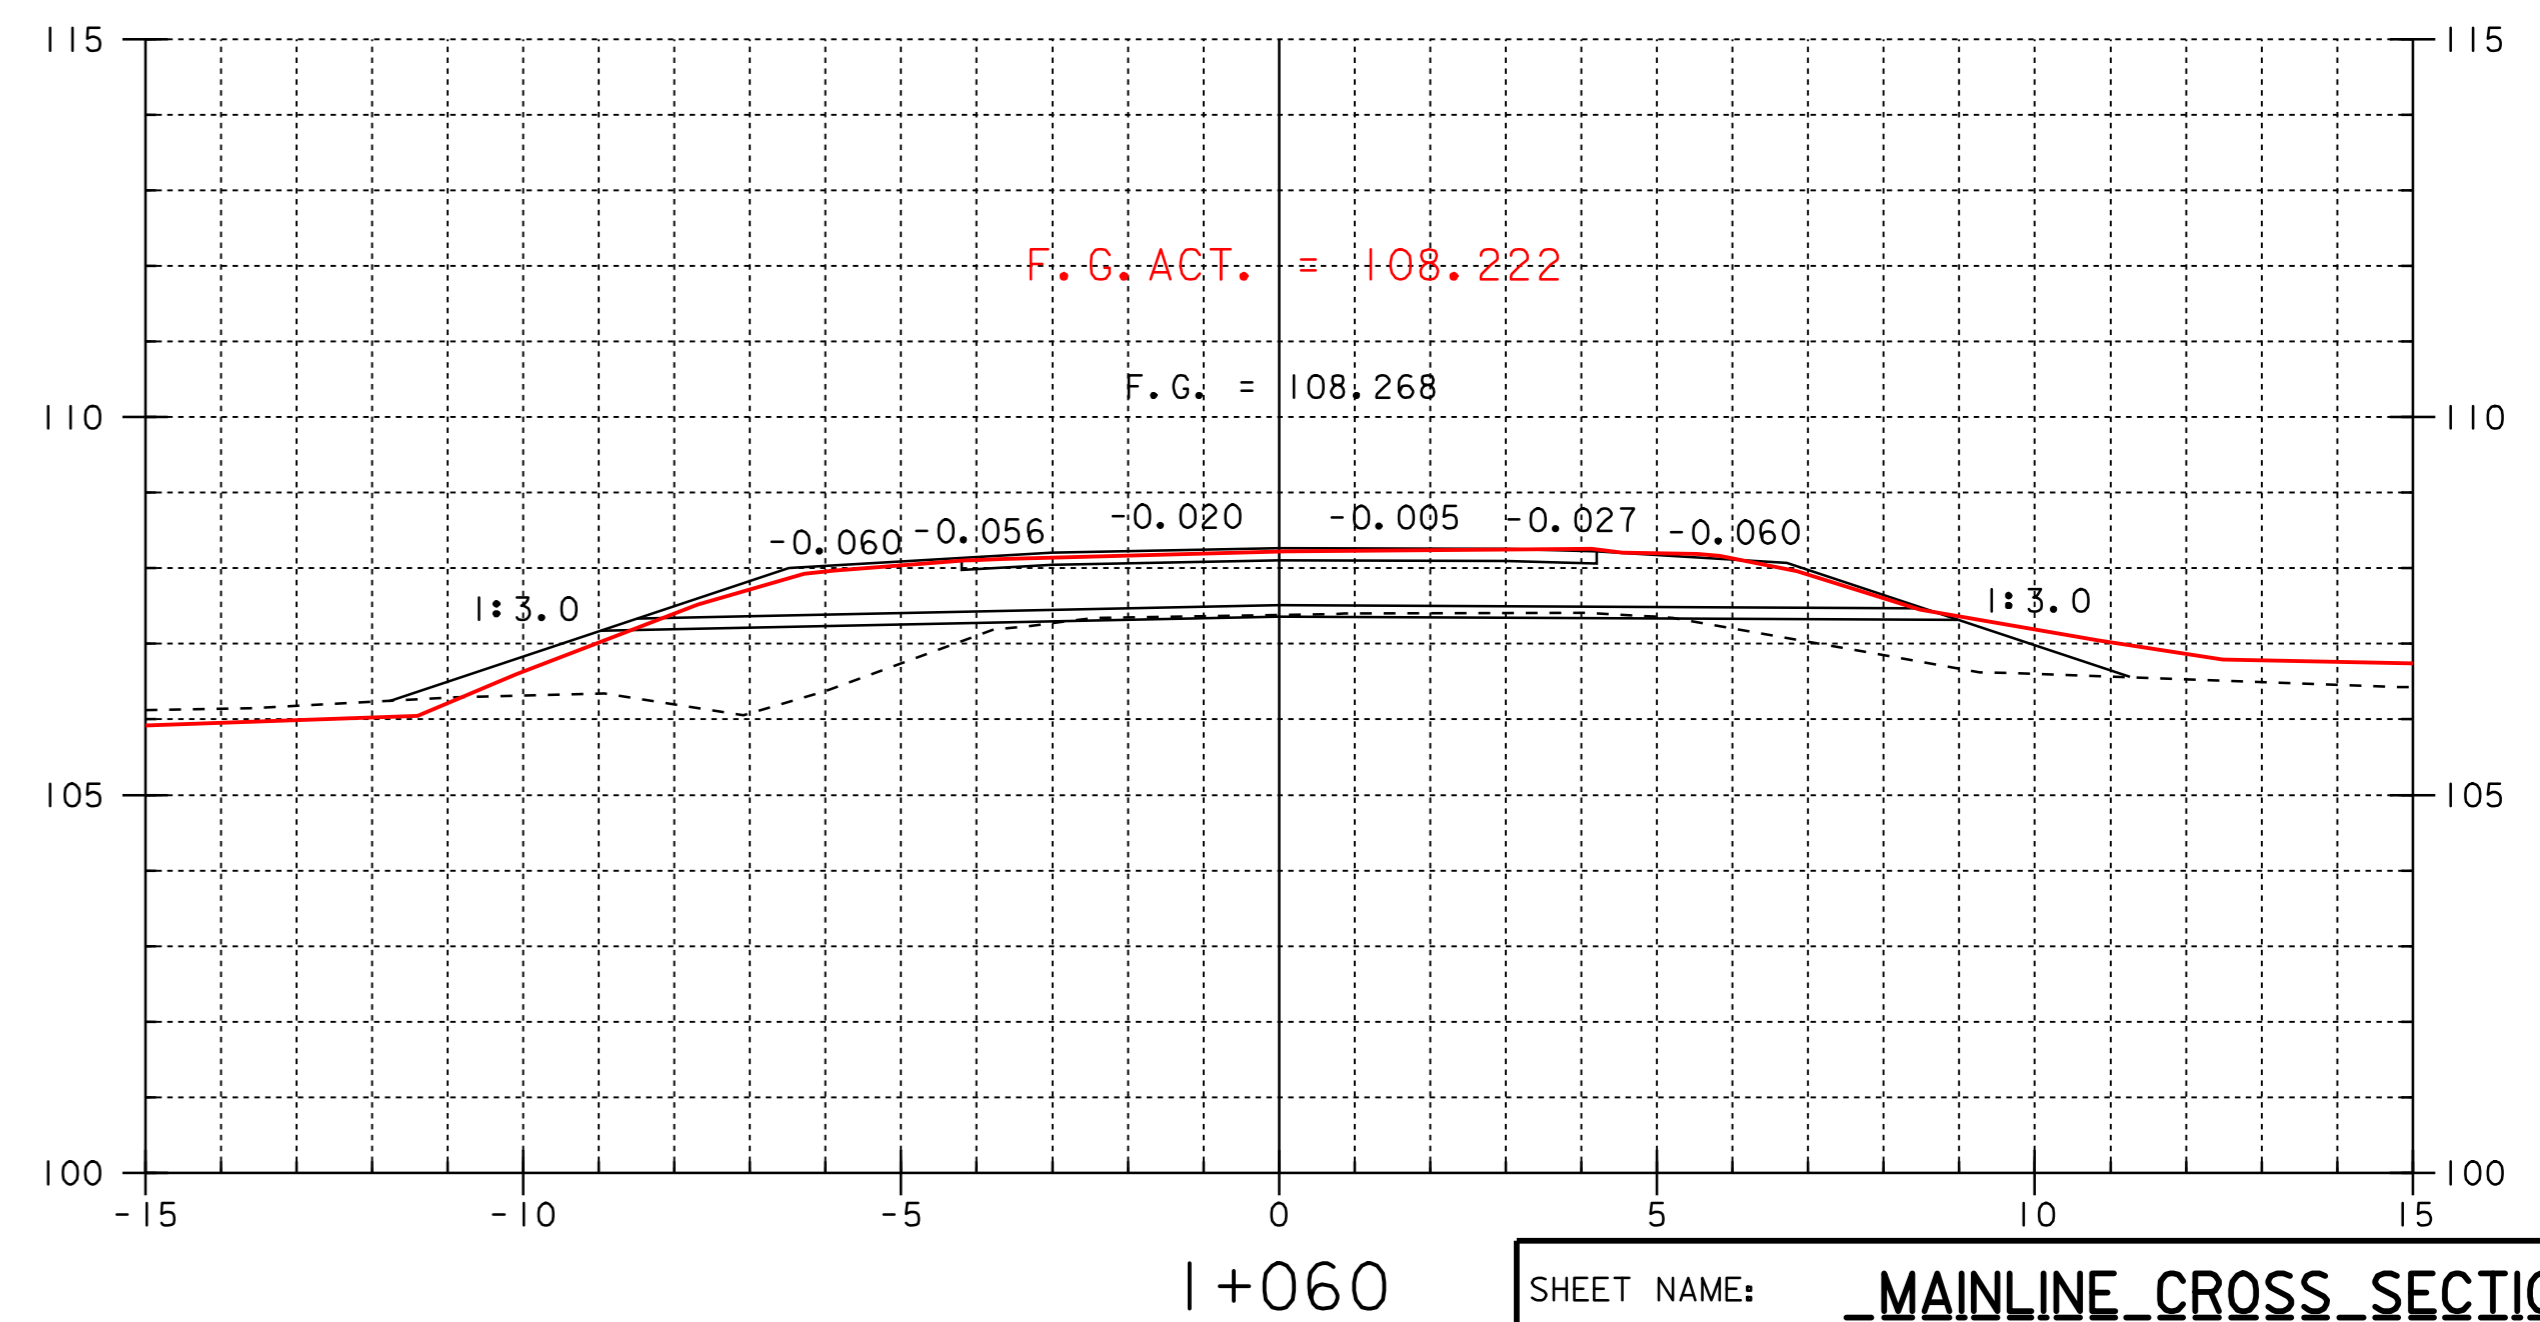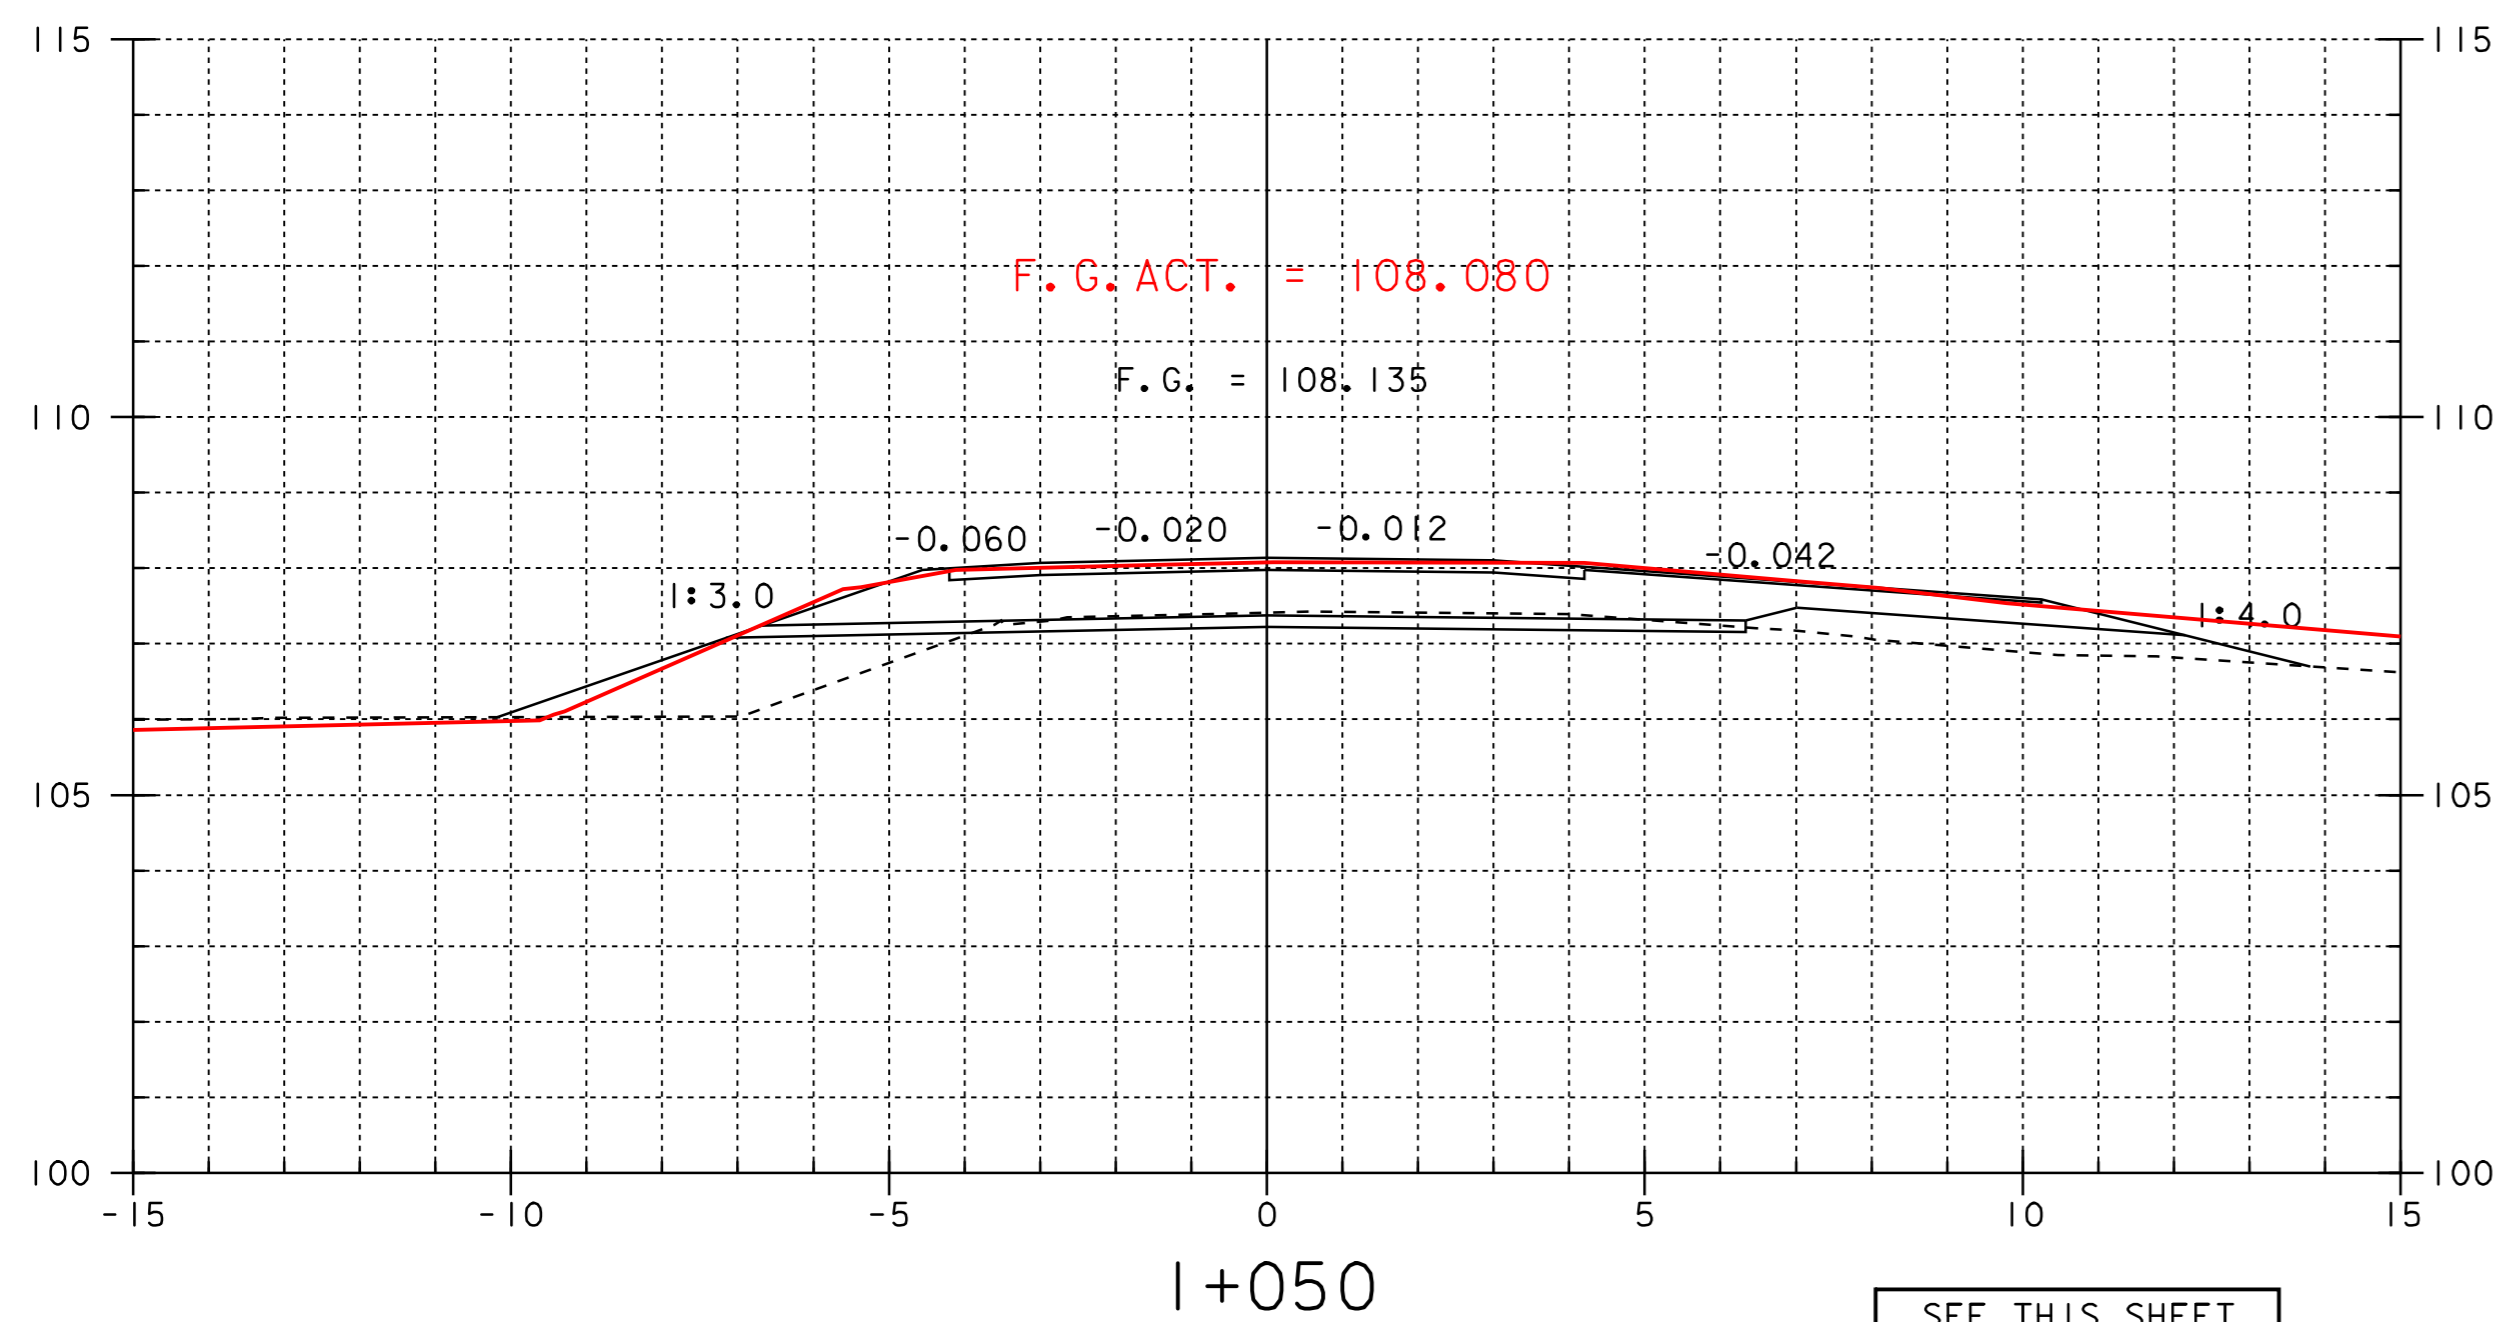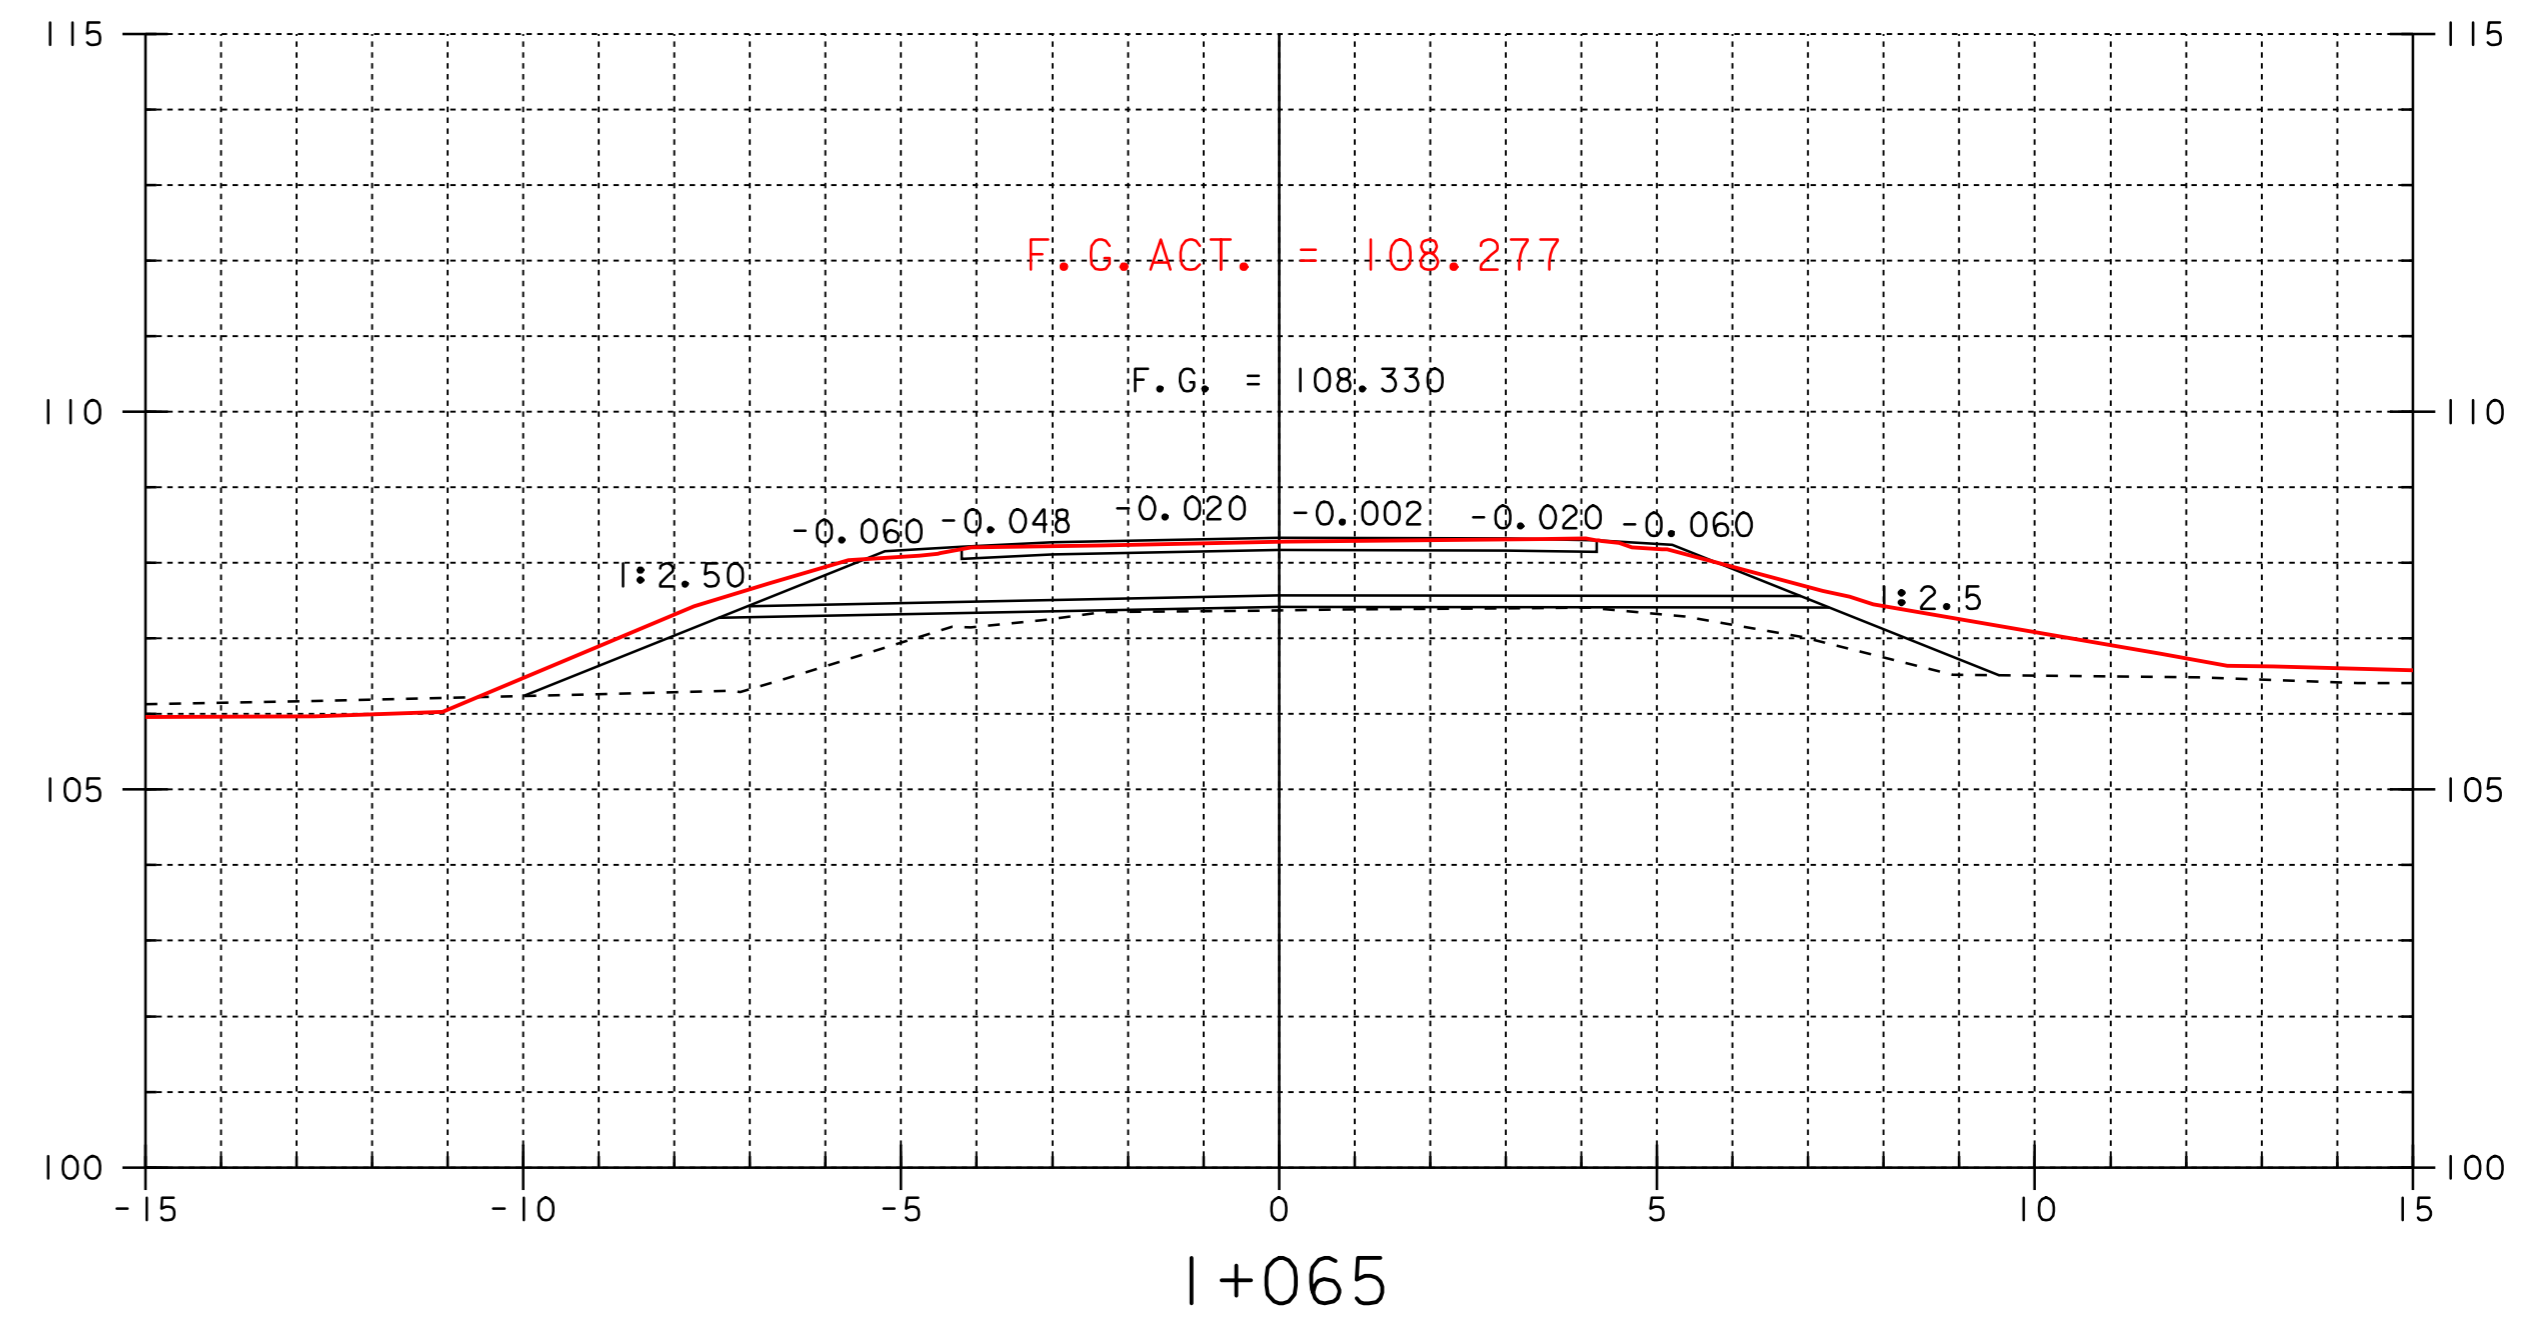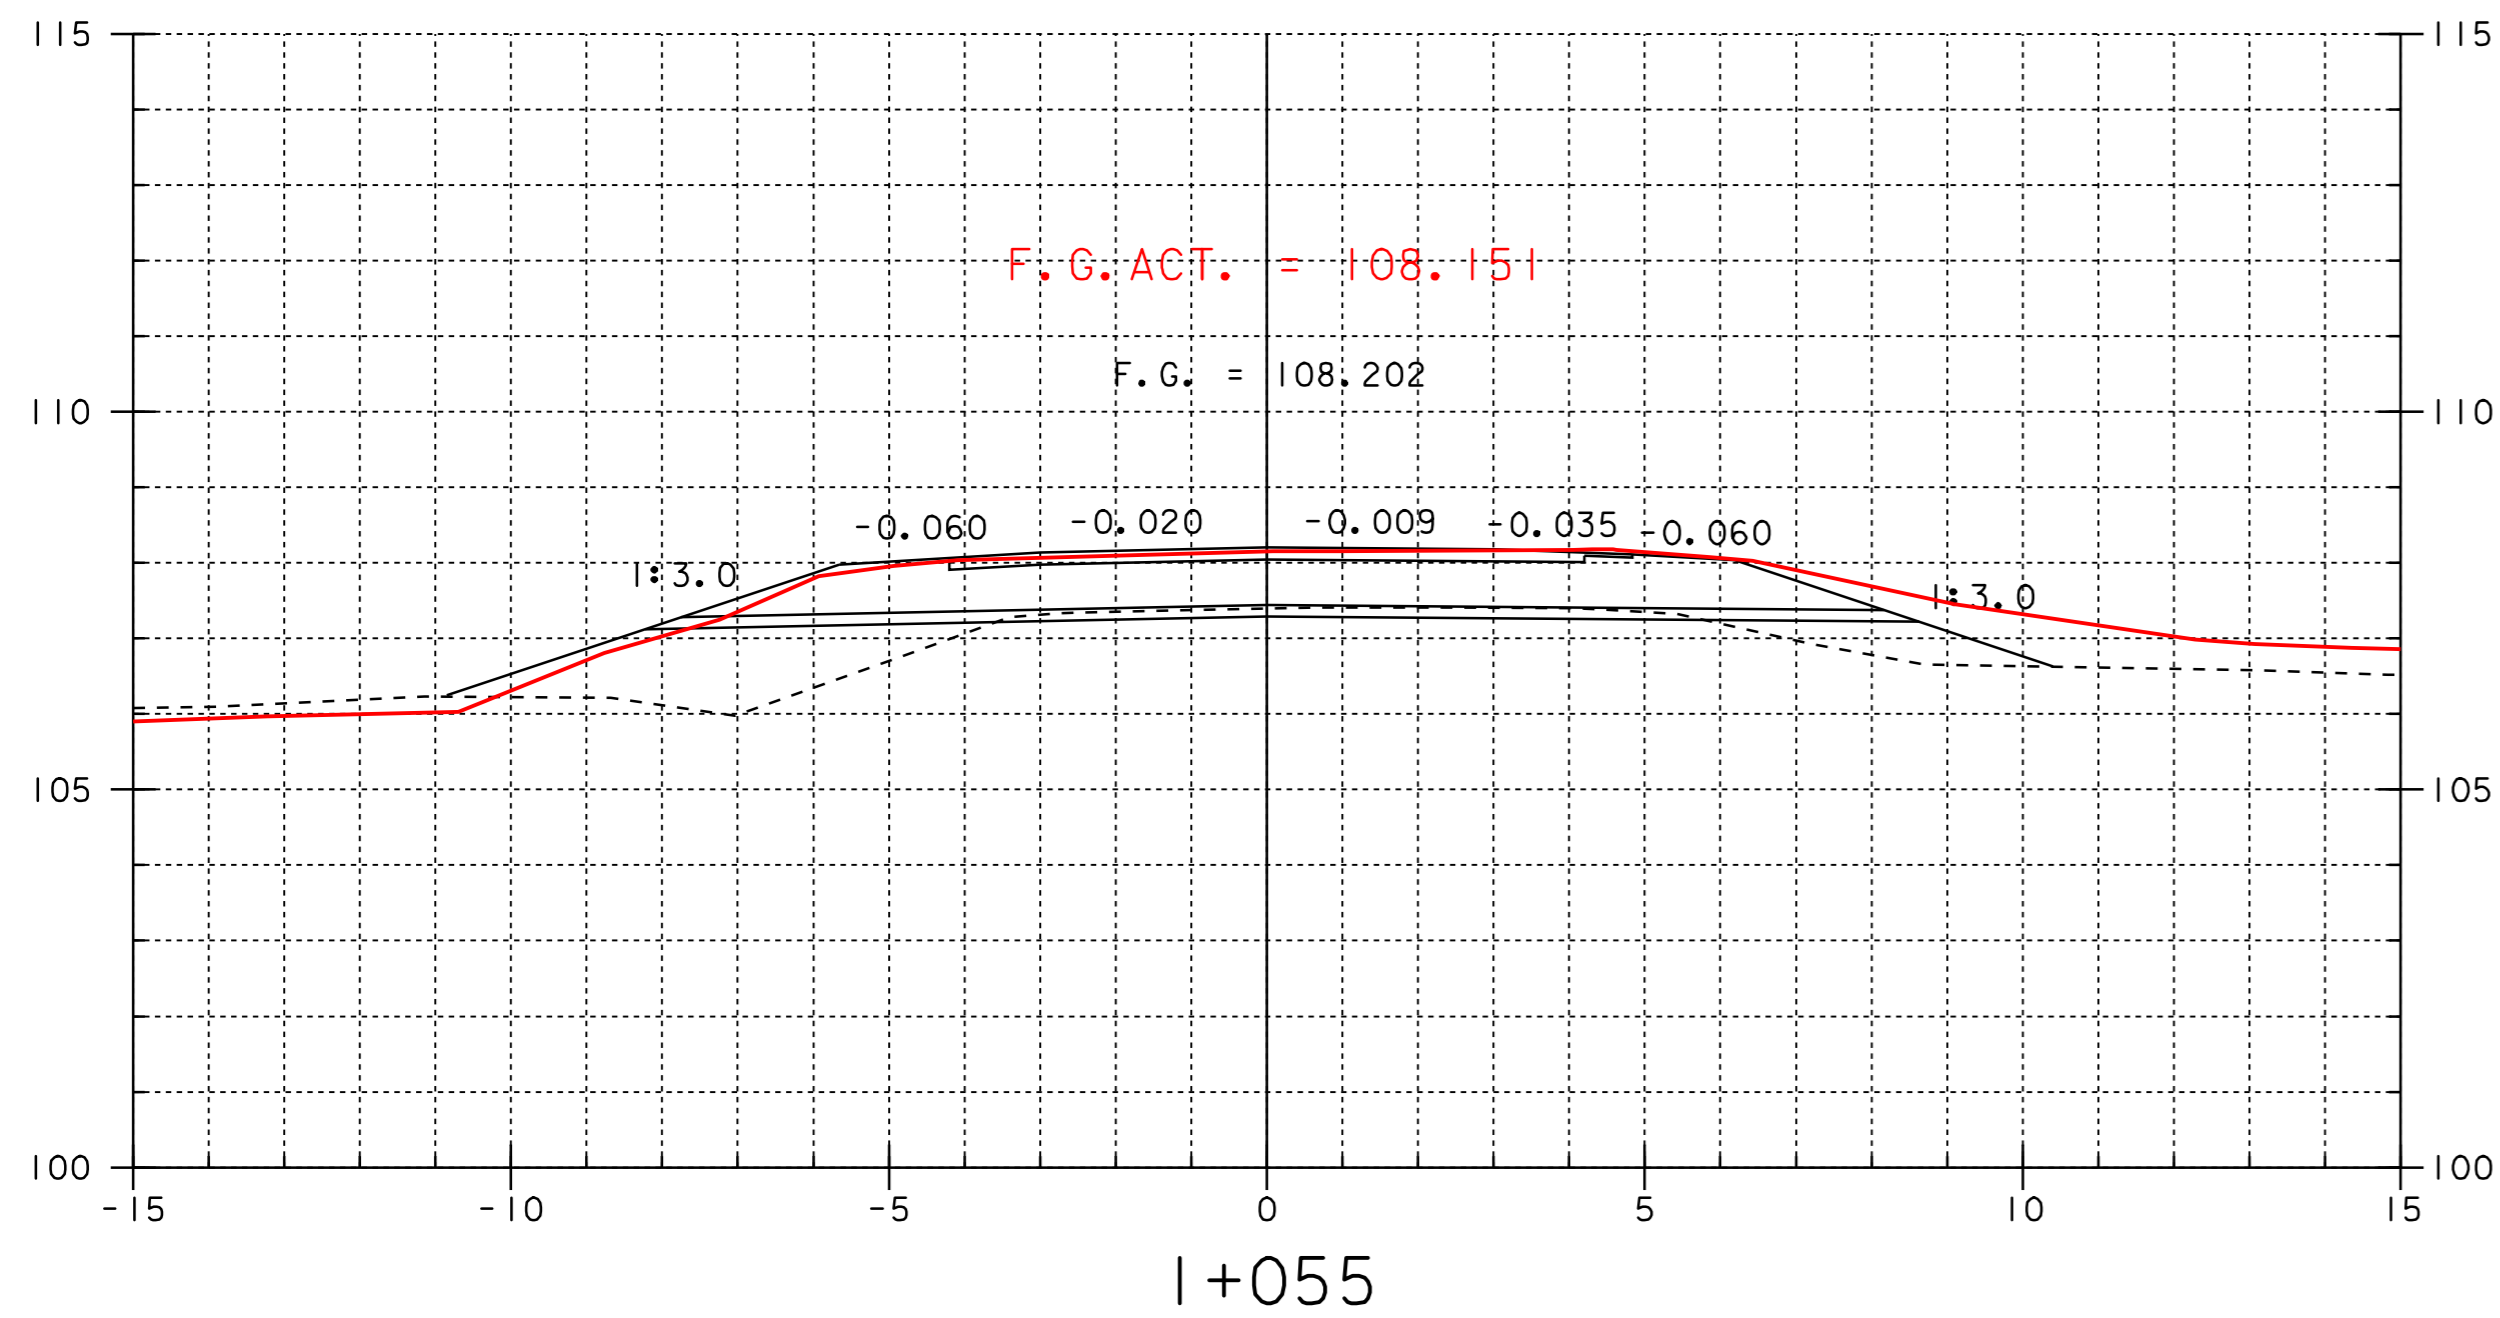

SEE THIS SHEET
FOR DRIVE SECTION
AT STA I+048.381

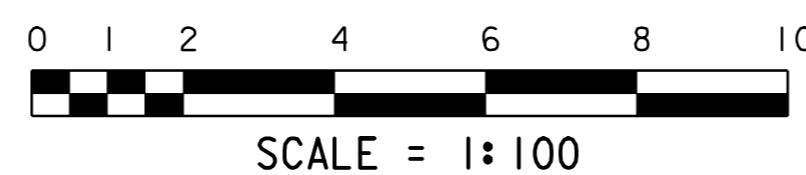


SHEET NAME: <u>MAINLINE CROSS SECTIONS</u>	
PROJECT NAME: <u>LEICESTER</u>	HIGHWAY NO.: <u>EAS_0160</u>
PROJECT NUMBER: <u>BRE_0160(3)S</u>	BRIDGE NO.: <u>6</u>
	OVER: <u>QUIER CREEK</u>
FILE NAME: <u>95J288\Structures\sj288xsl.dgn</u>	PLOT DATE: <u>02-OCT-2008 11:00</u>
PROJECT MANAGER: <u>B.B. WHITCOMB</u>	DRAWN BY: <u>J. GILMORE</u>
DESIGNED BY: <u>C. CARLSON</u>	IPARM NAME: <u>sj088dr6.1</u>
	SHEET <u>73</u> OF <u>90</u>

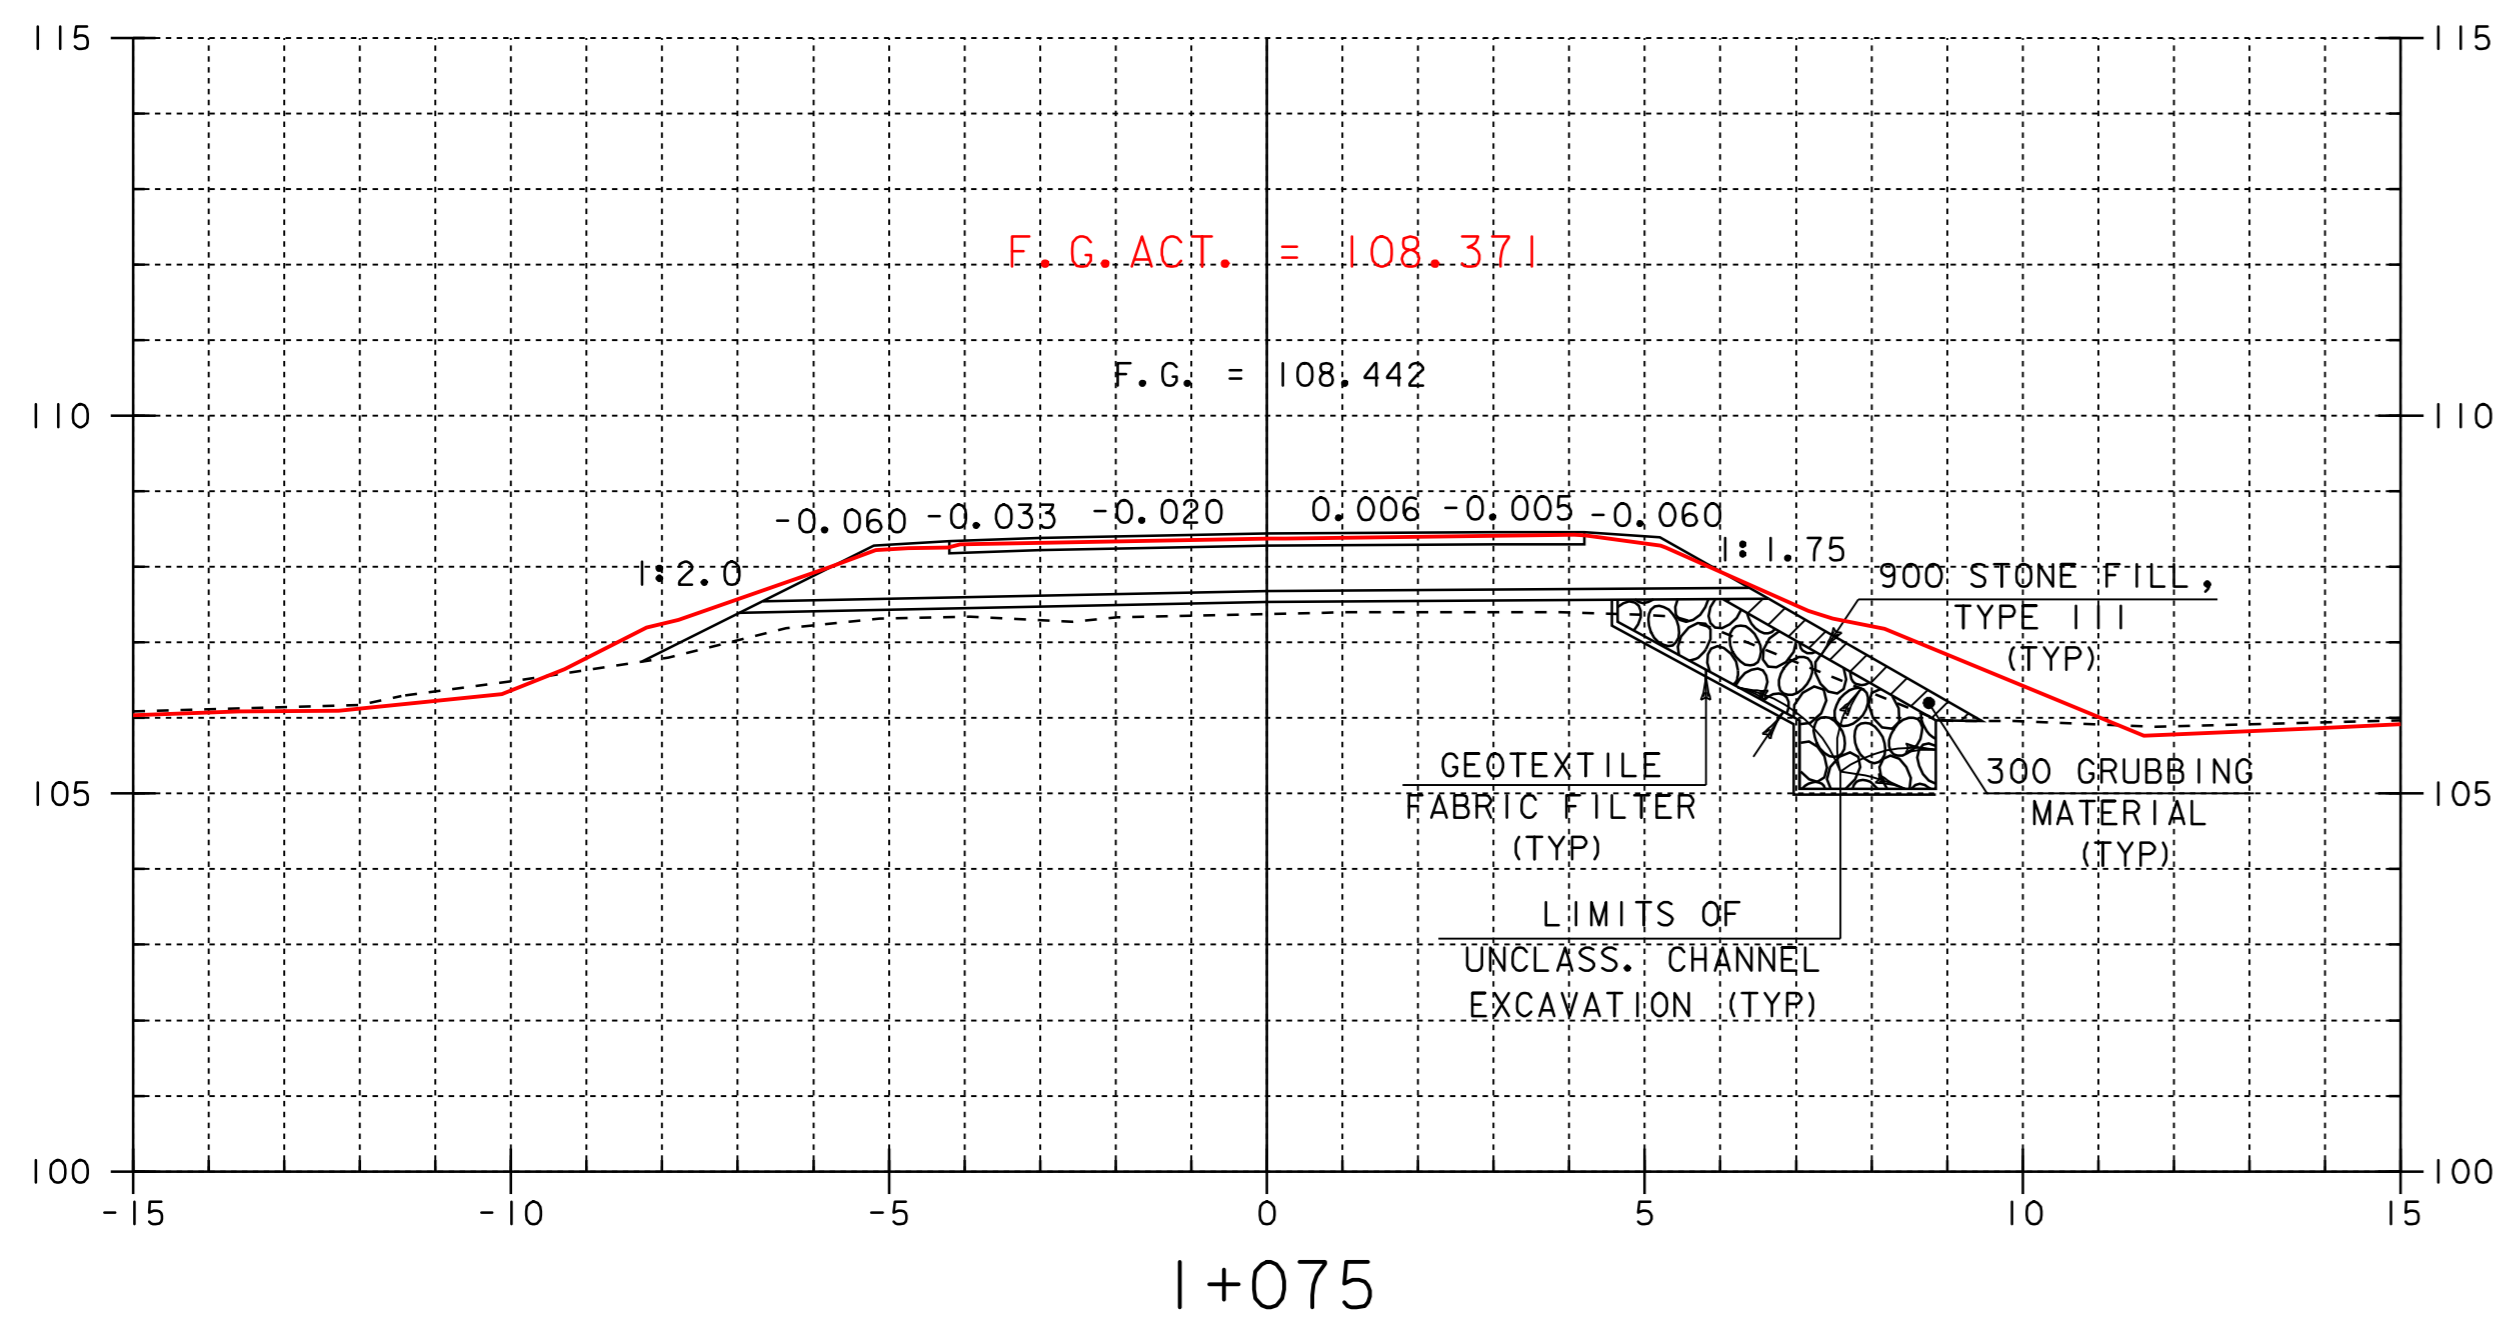


I+075

STA I+074.5 RIGHT
 BEGIN UNCLASS. CHANNEL EXCAVATION
 BEGIN GEOTEXTILE FABRIC FILTER
 BEGIN STONE FILL, TYPE III
 BEGIN GRUBBING MATERIAL

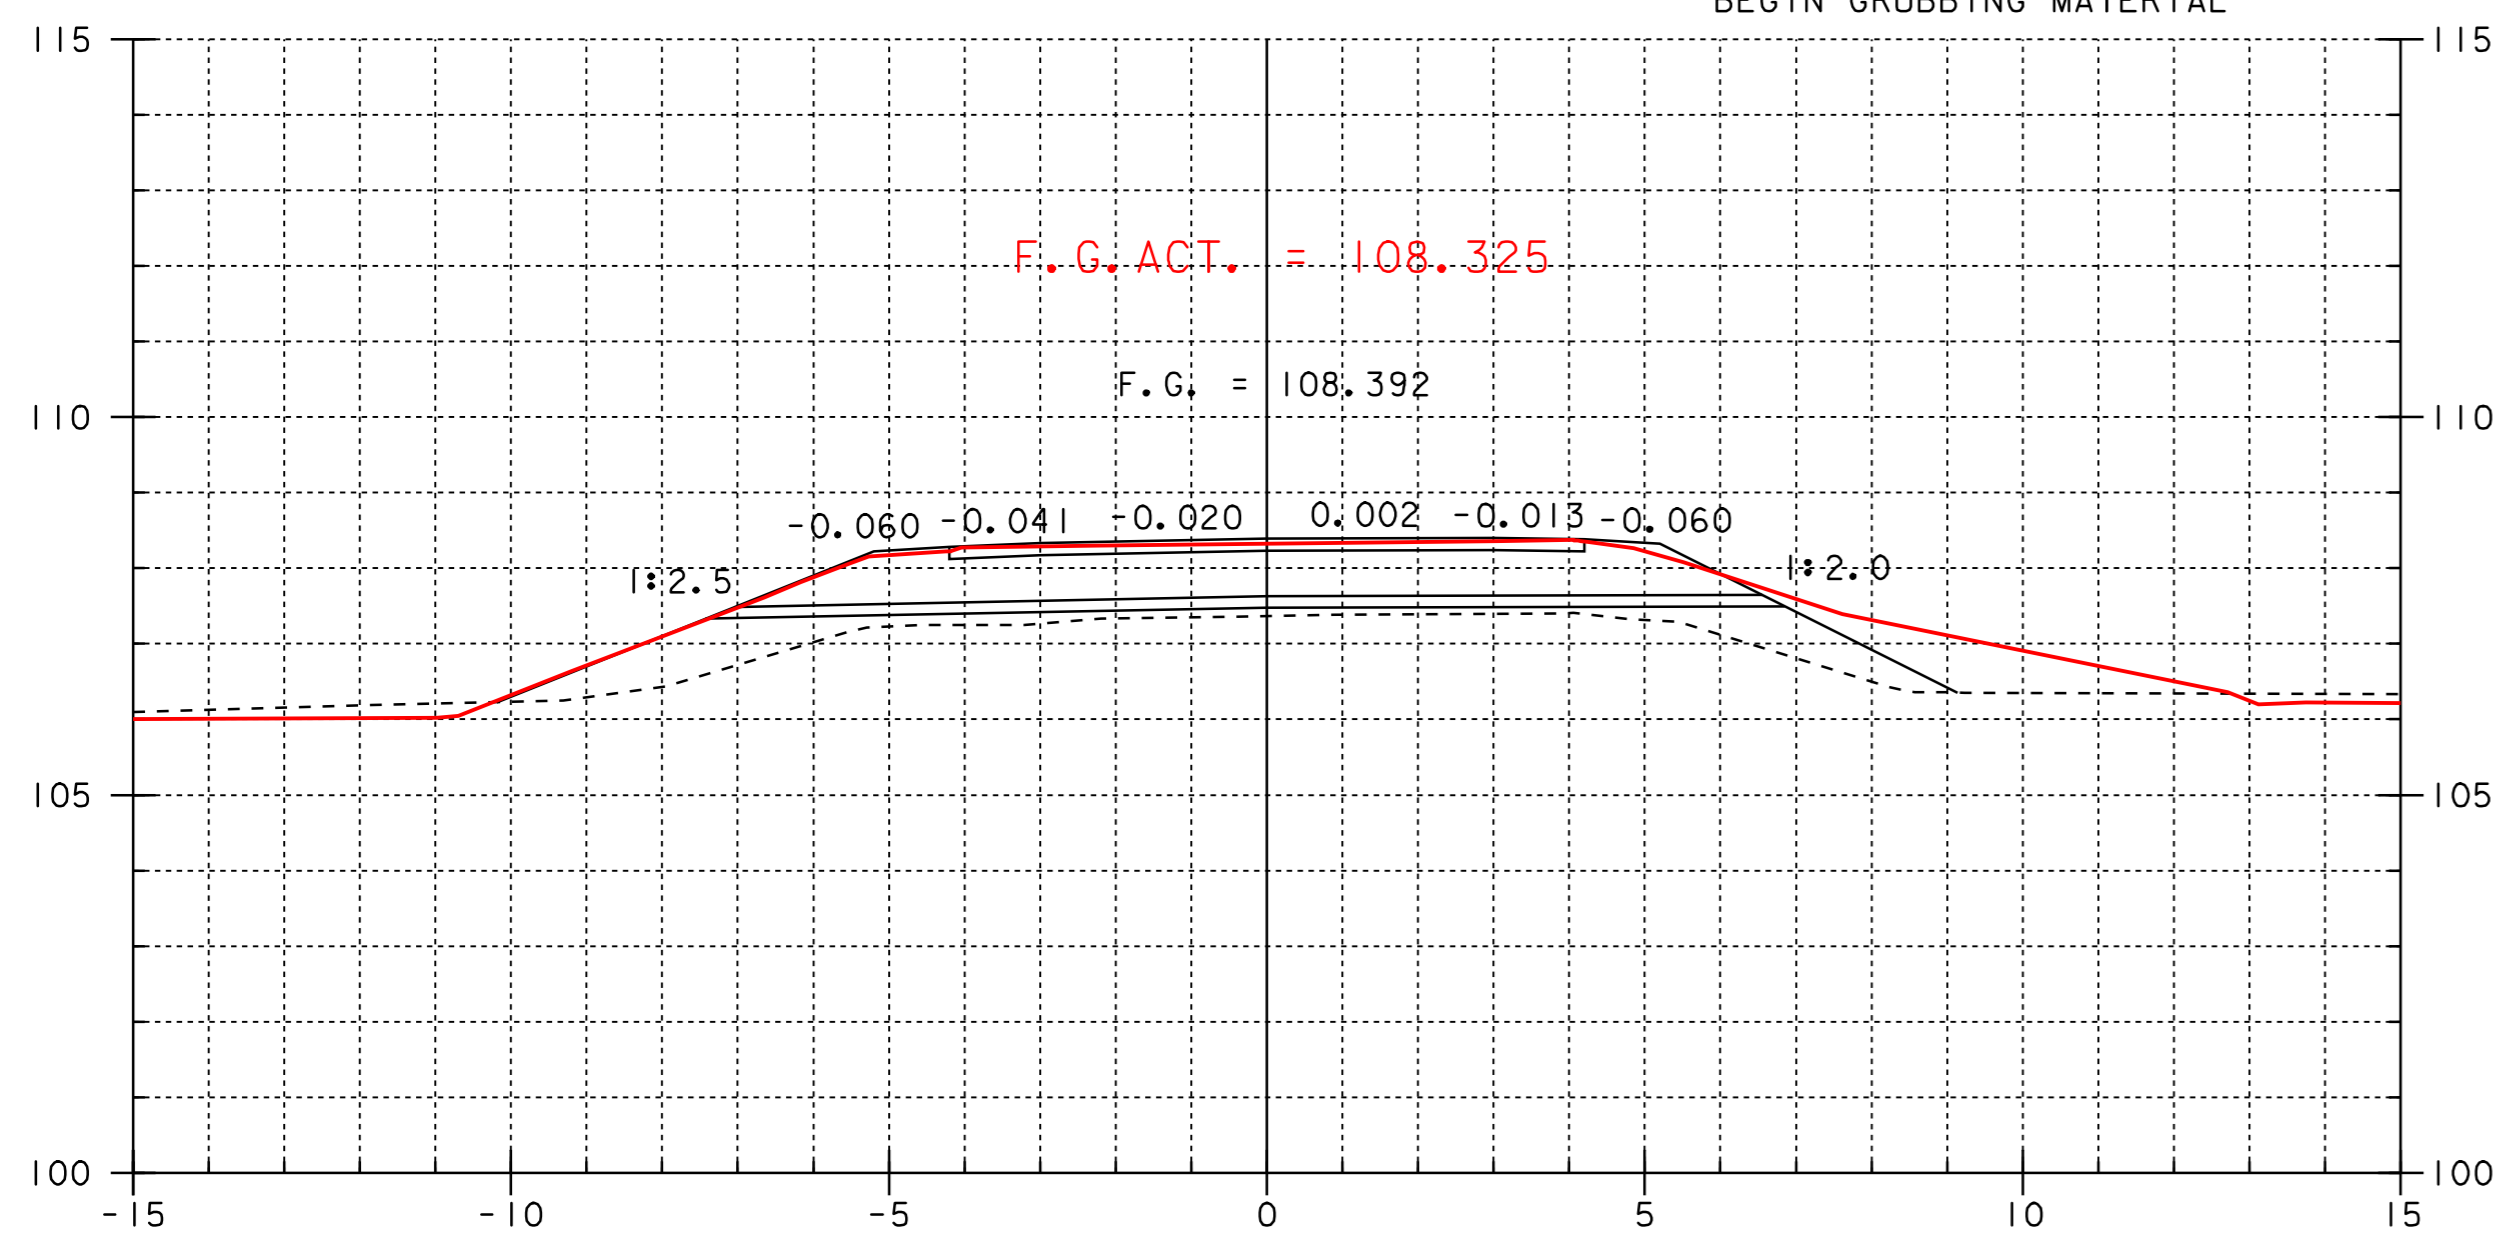

I+070

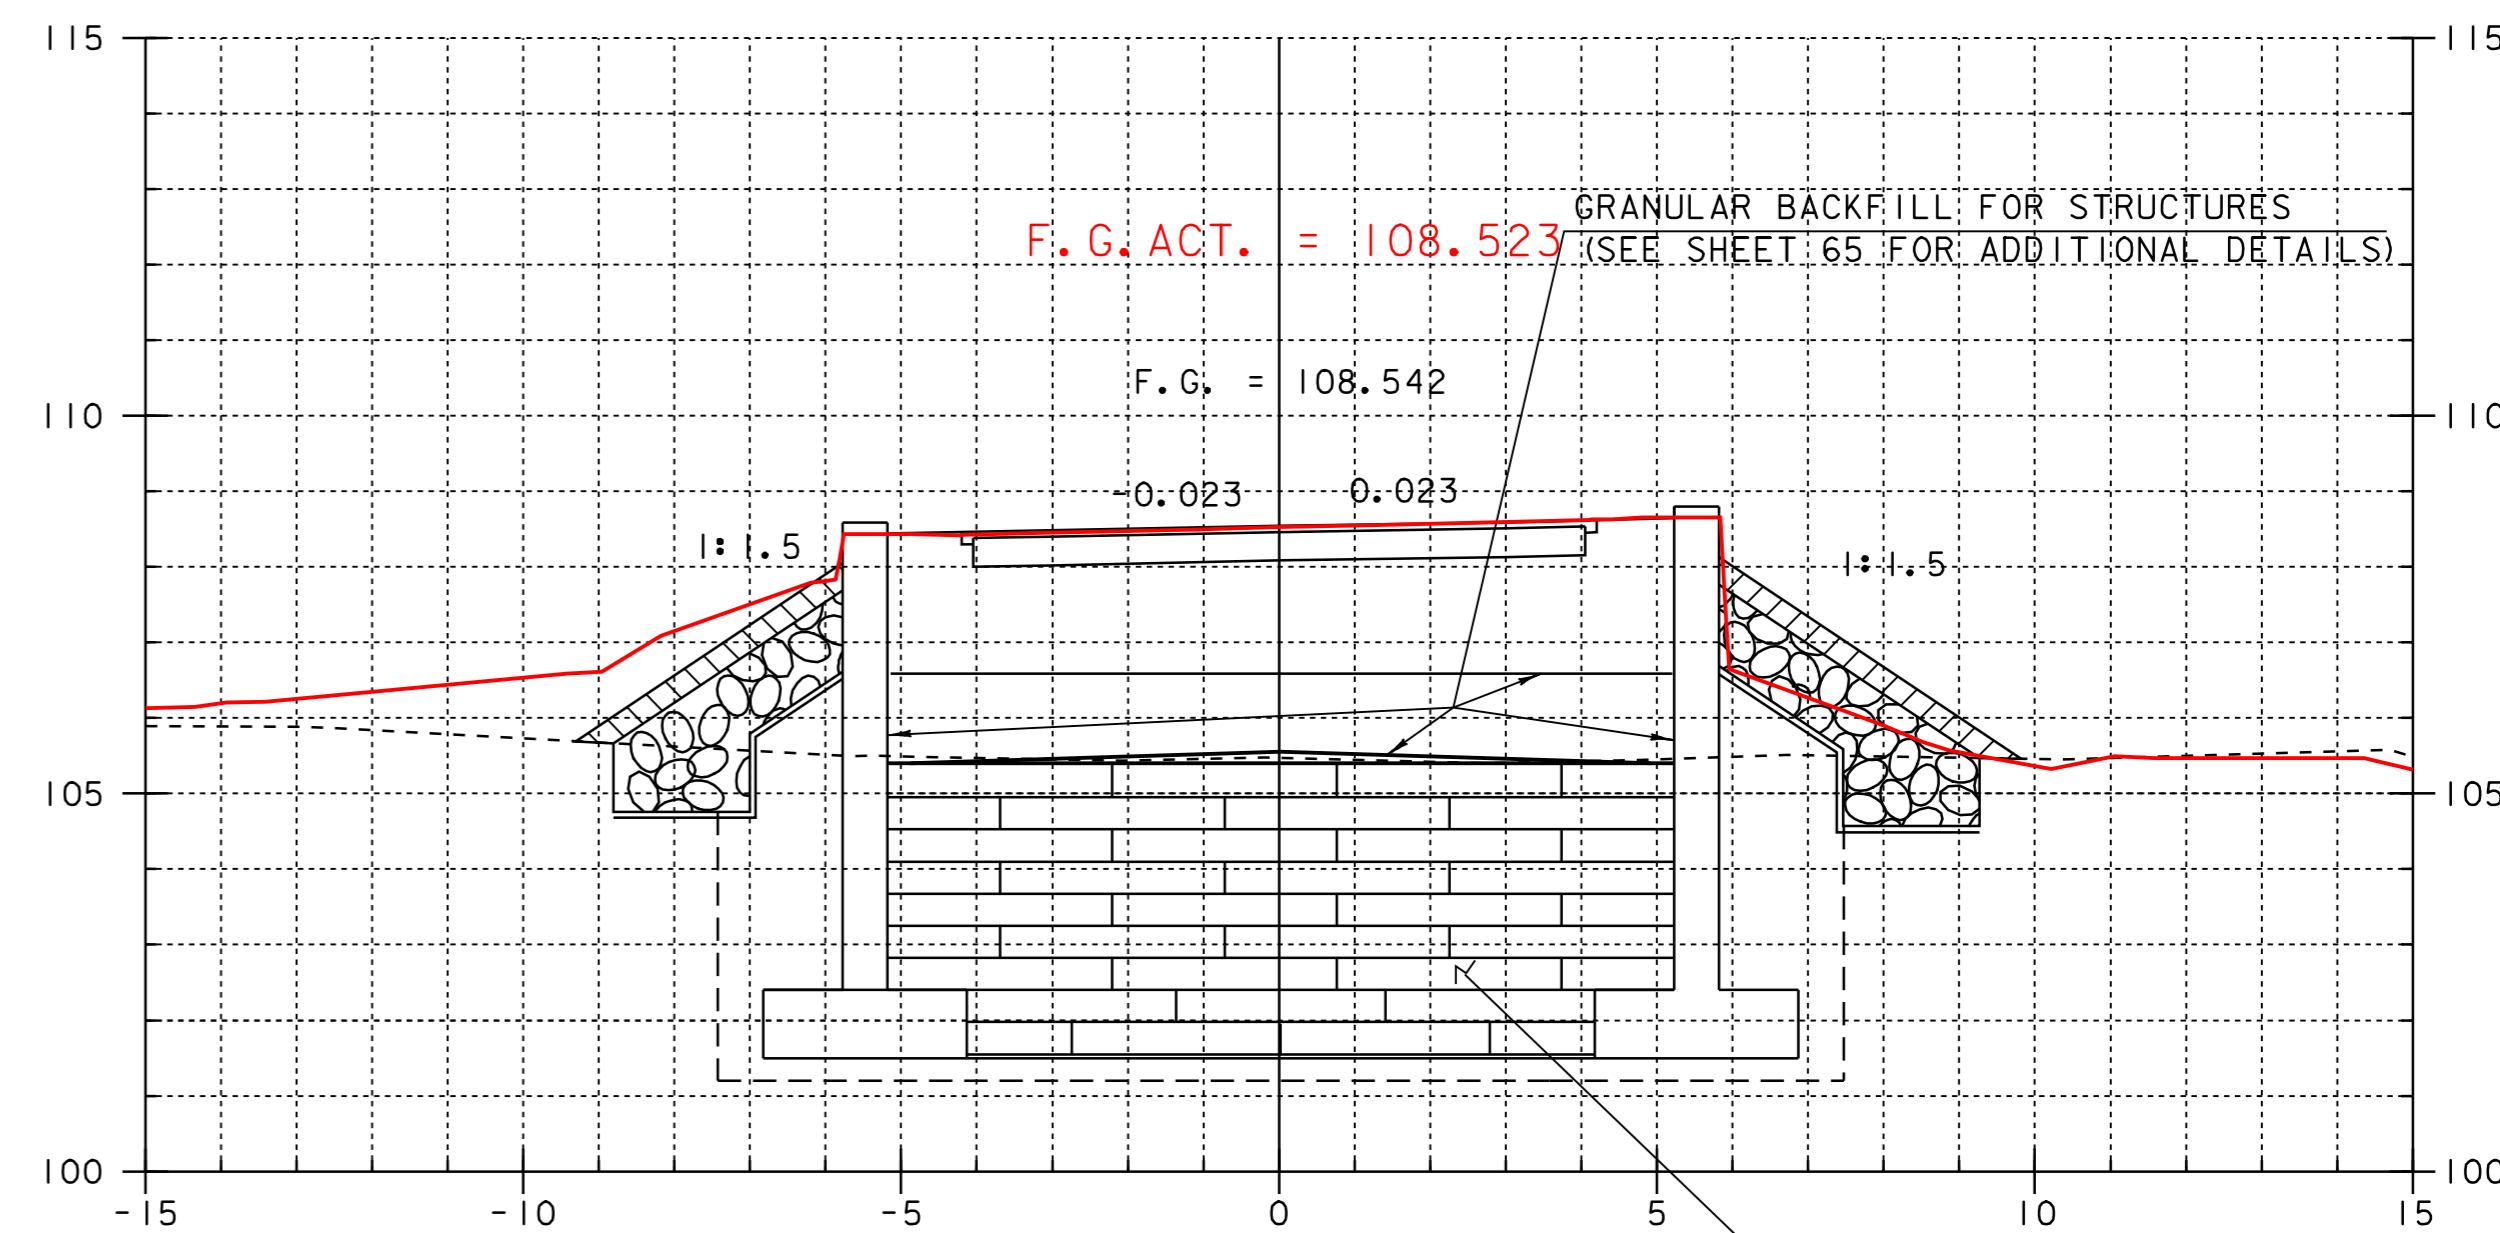


I+090

STA I+081.82
 BEGIN GRANULAR BACKFILL FOR STRUCTURES
 (MOD. - EPS100 GEOFOAM)

STA I+081.32
 BEGIN STRUCTURE EXCAVATION (FOR GEOFOAM)
 GRANULAR BACKFILL FOR STRUCTURES

GRANULAR BACKFILL FOR STRUCTURES
 (MOD. - EPS100 GEOFOAM)
 (SEE SHEET 65 FOR ADDITIONAL DETAILS)

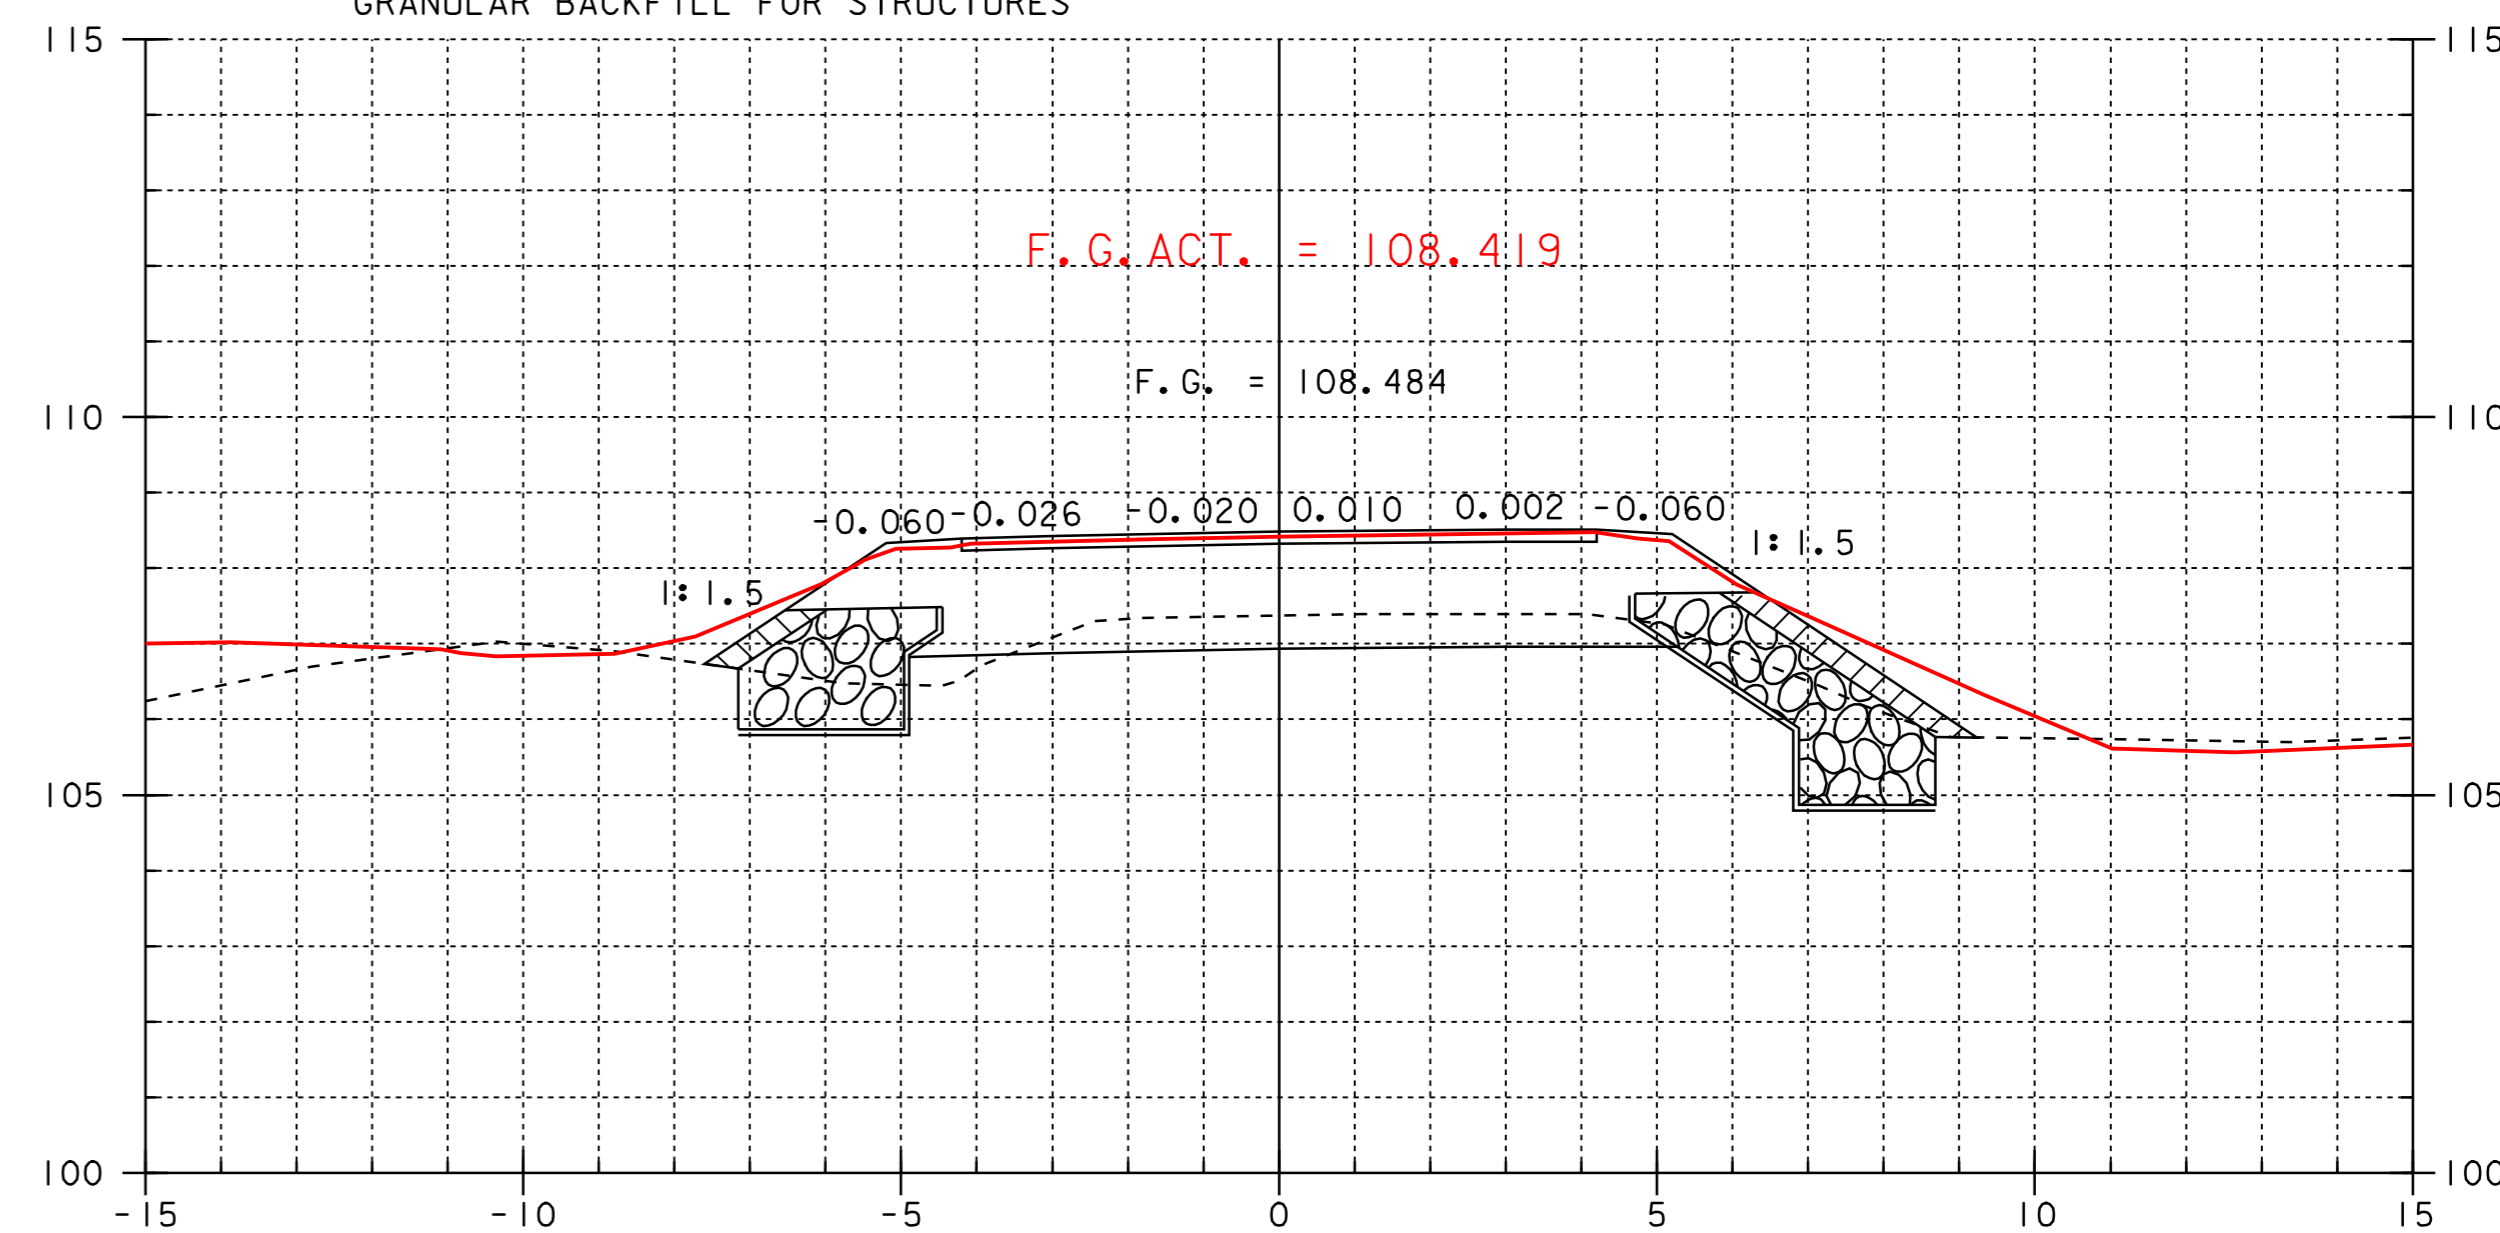






I+080

STA I+080.0 LEFT
 BEGIN UNCLASS. CHANNEL EXCAVATION
 BEGIN GEOTEXTILE FABRIC FILTER
 BEGIN STONE FILL, TYPE III
 BEGIN GRUBBING MATERIAL








SCALE = 1:100

SHEET NAME: MAINLINE CROSS SECTIONS	
PROJECT NAME: LEICESTER	HIGHWAY NO.: EAS_0160
PROJECT NUMBER: BRE_0160(3)S	BRIDGE NO.: 6
	OVER: QUIER CREEK
FILE NAME: 95J288\Structures\sj288xsl.dgn	PLOT DATE: 02-OCT-2008 11:00
PROJECT MANAGER: B.B. WHITCOMB	DRAWN BY: J. GILMORE
DESIGNED BY: C. CARLSON	IPARM NAME: sj088.dwg
	SHEET 14 OF 90

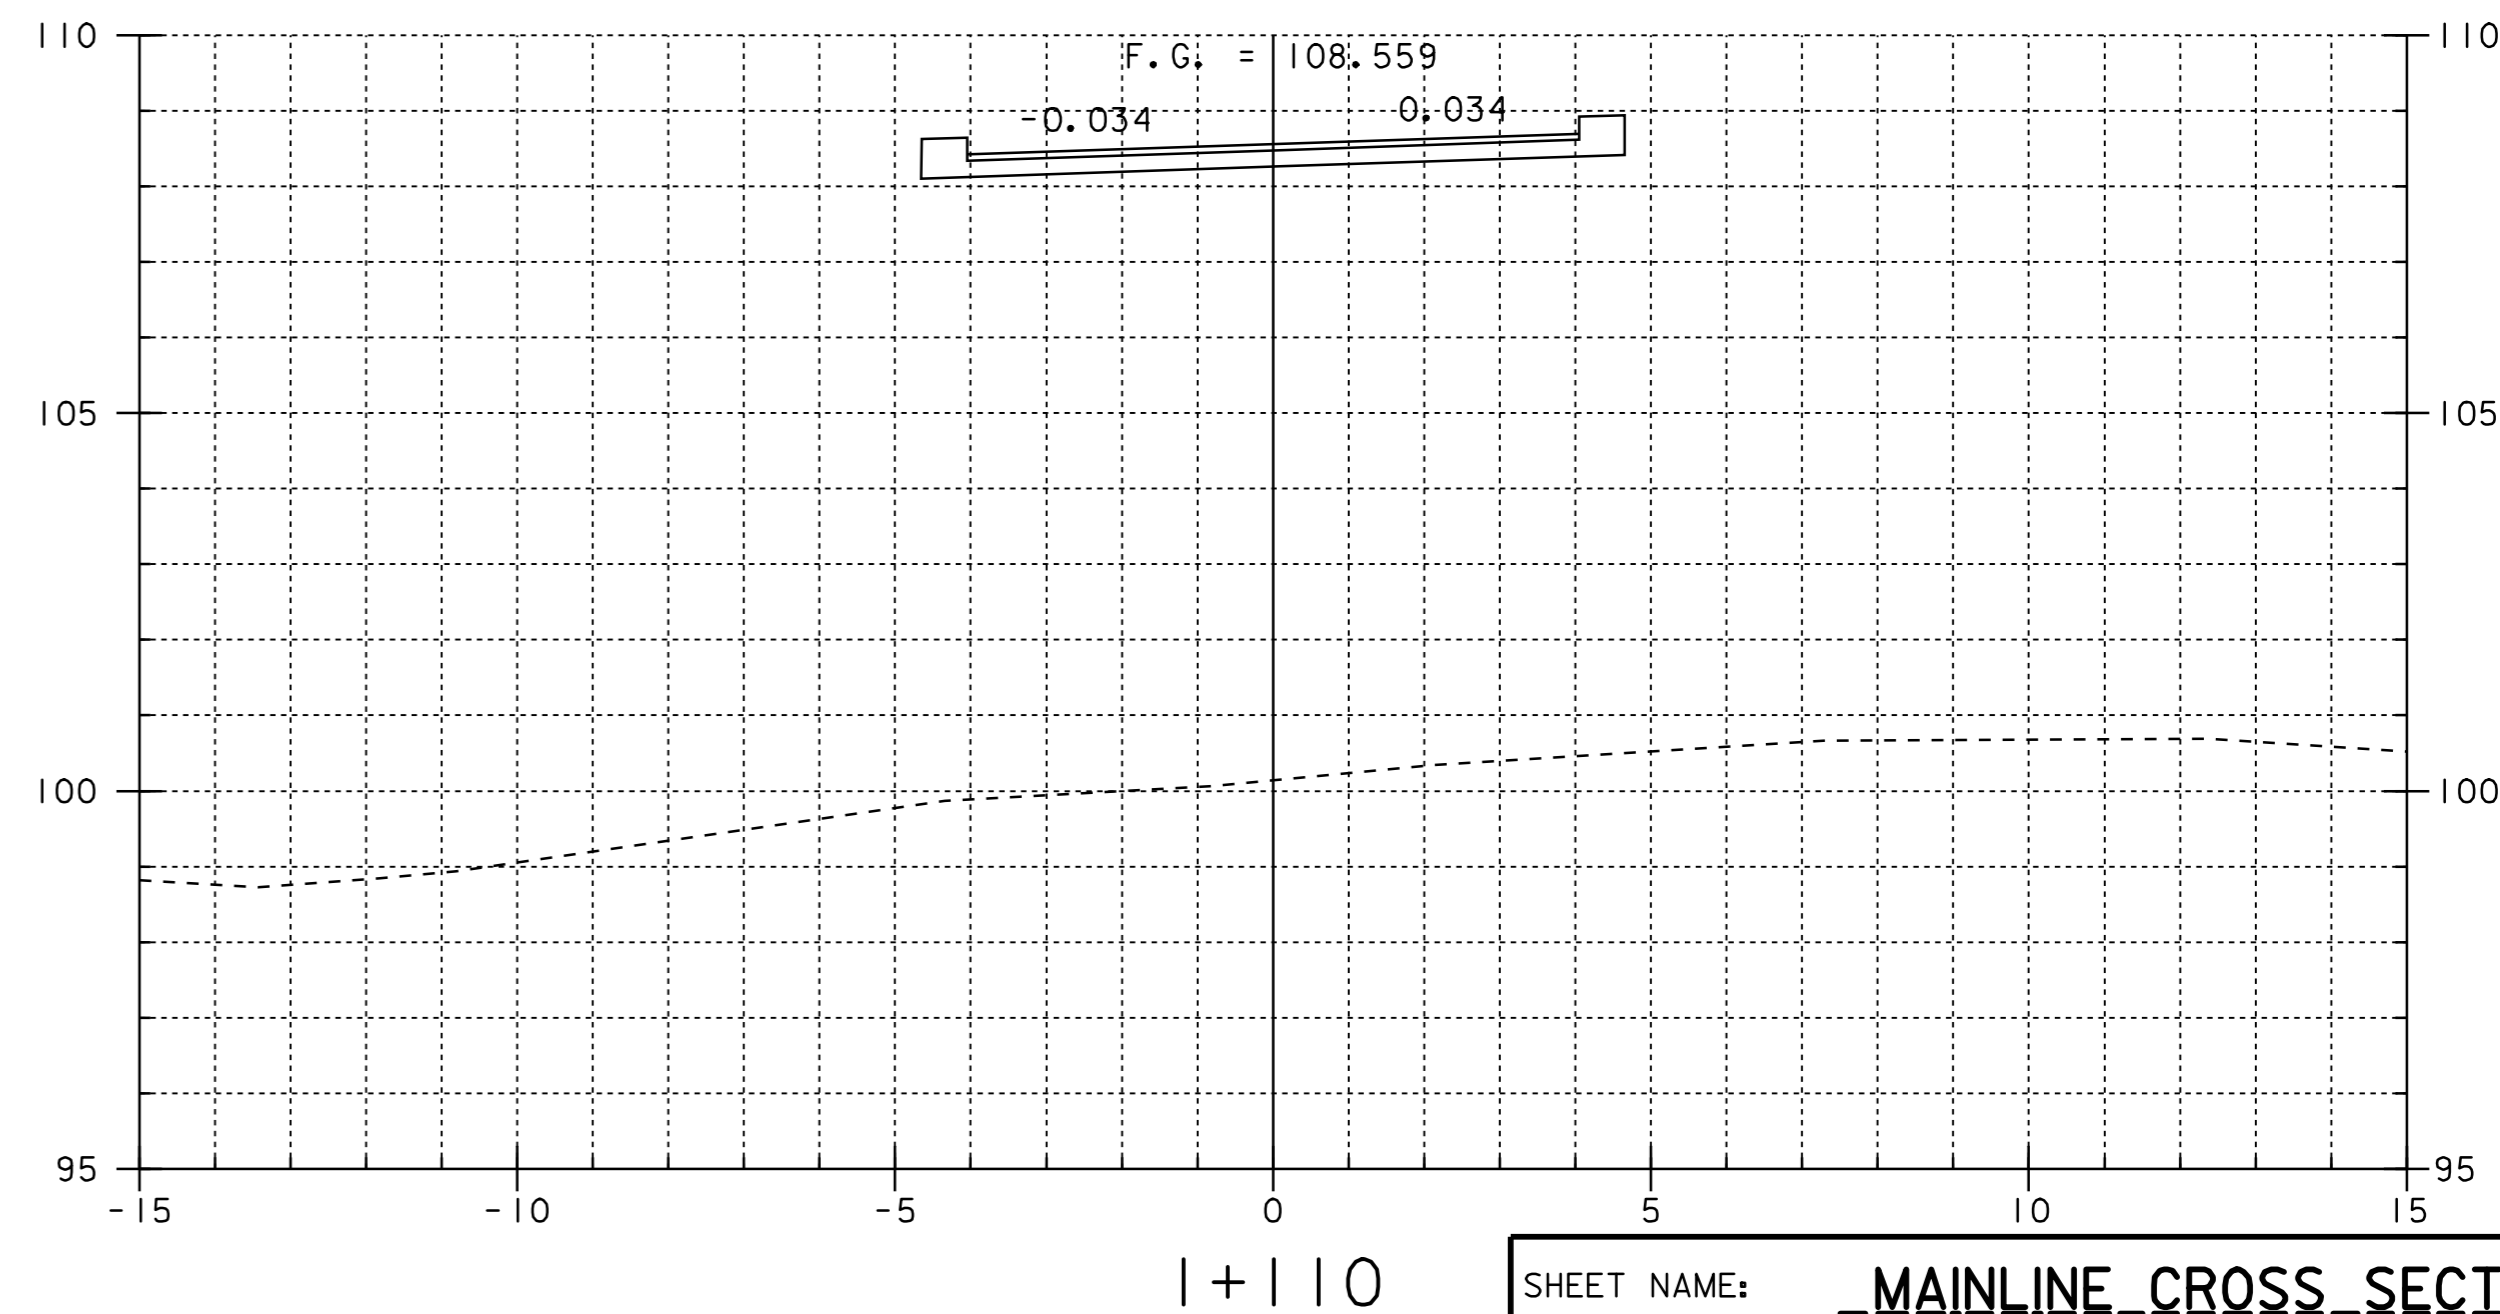
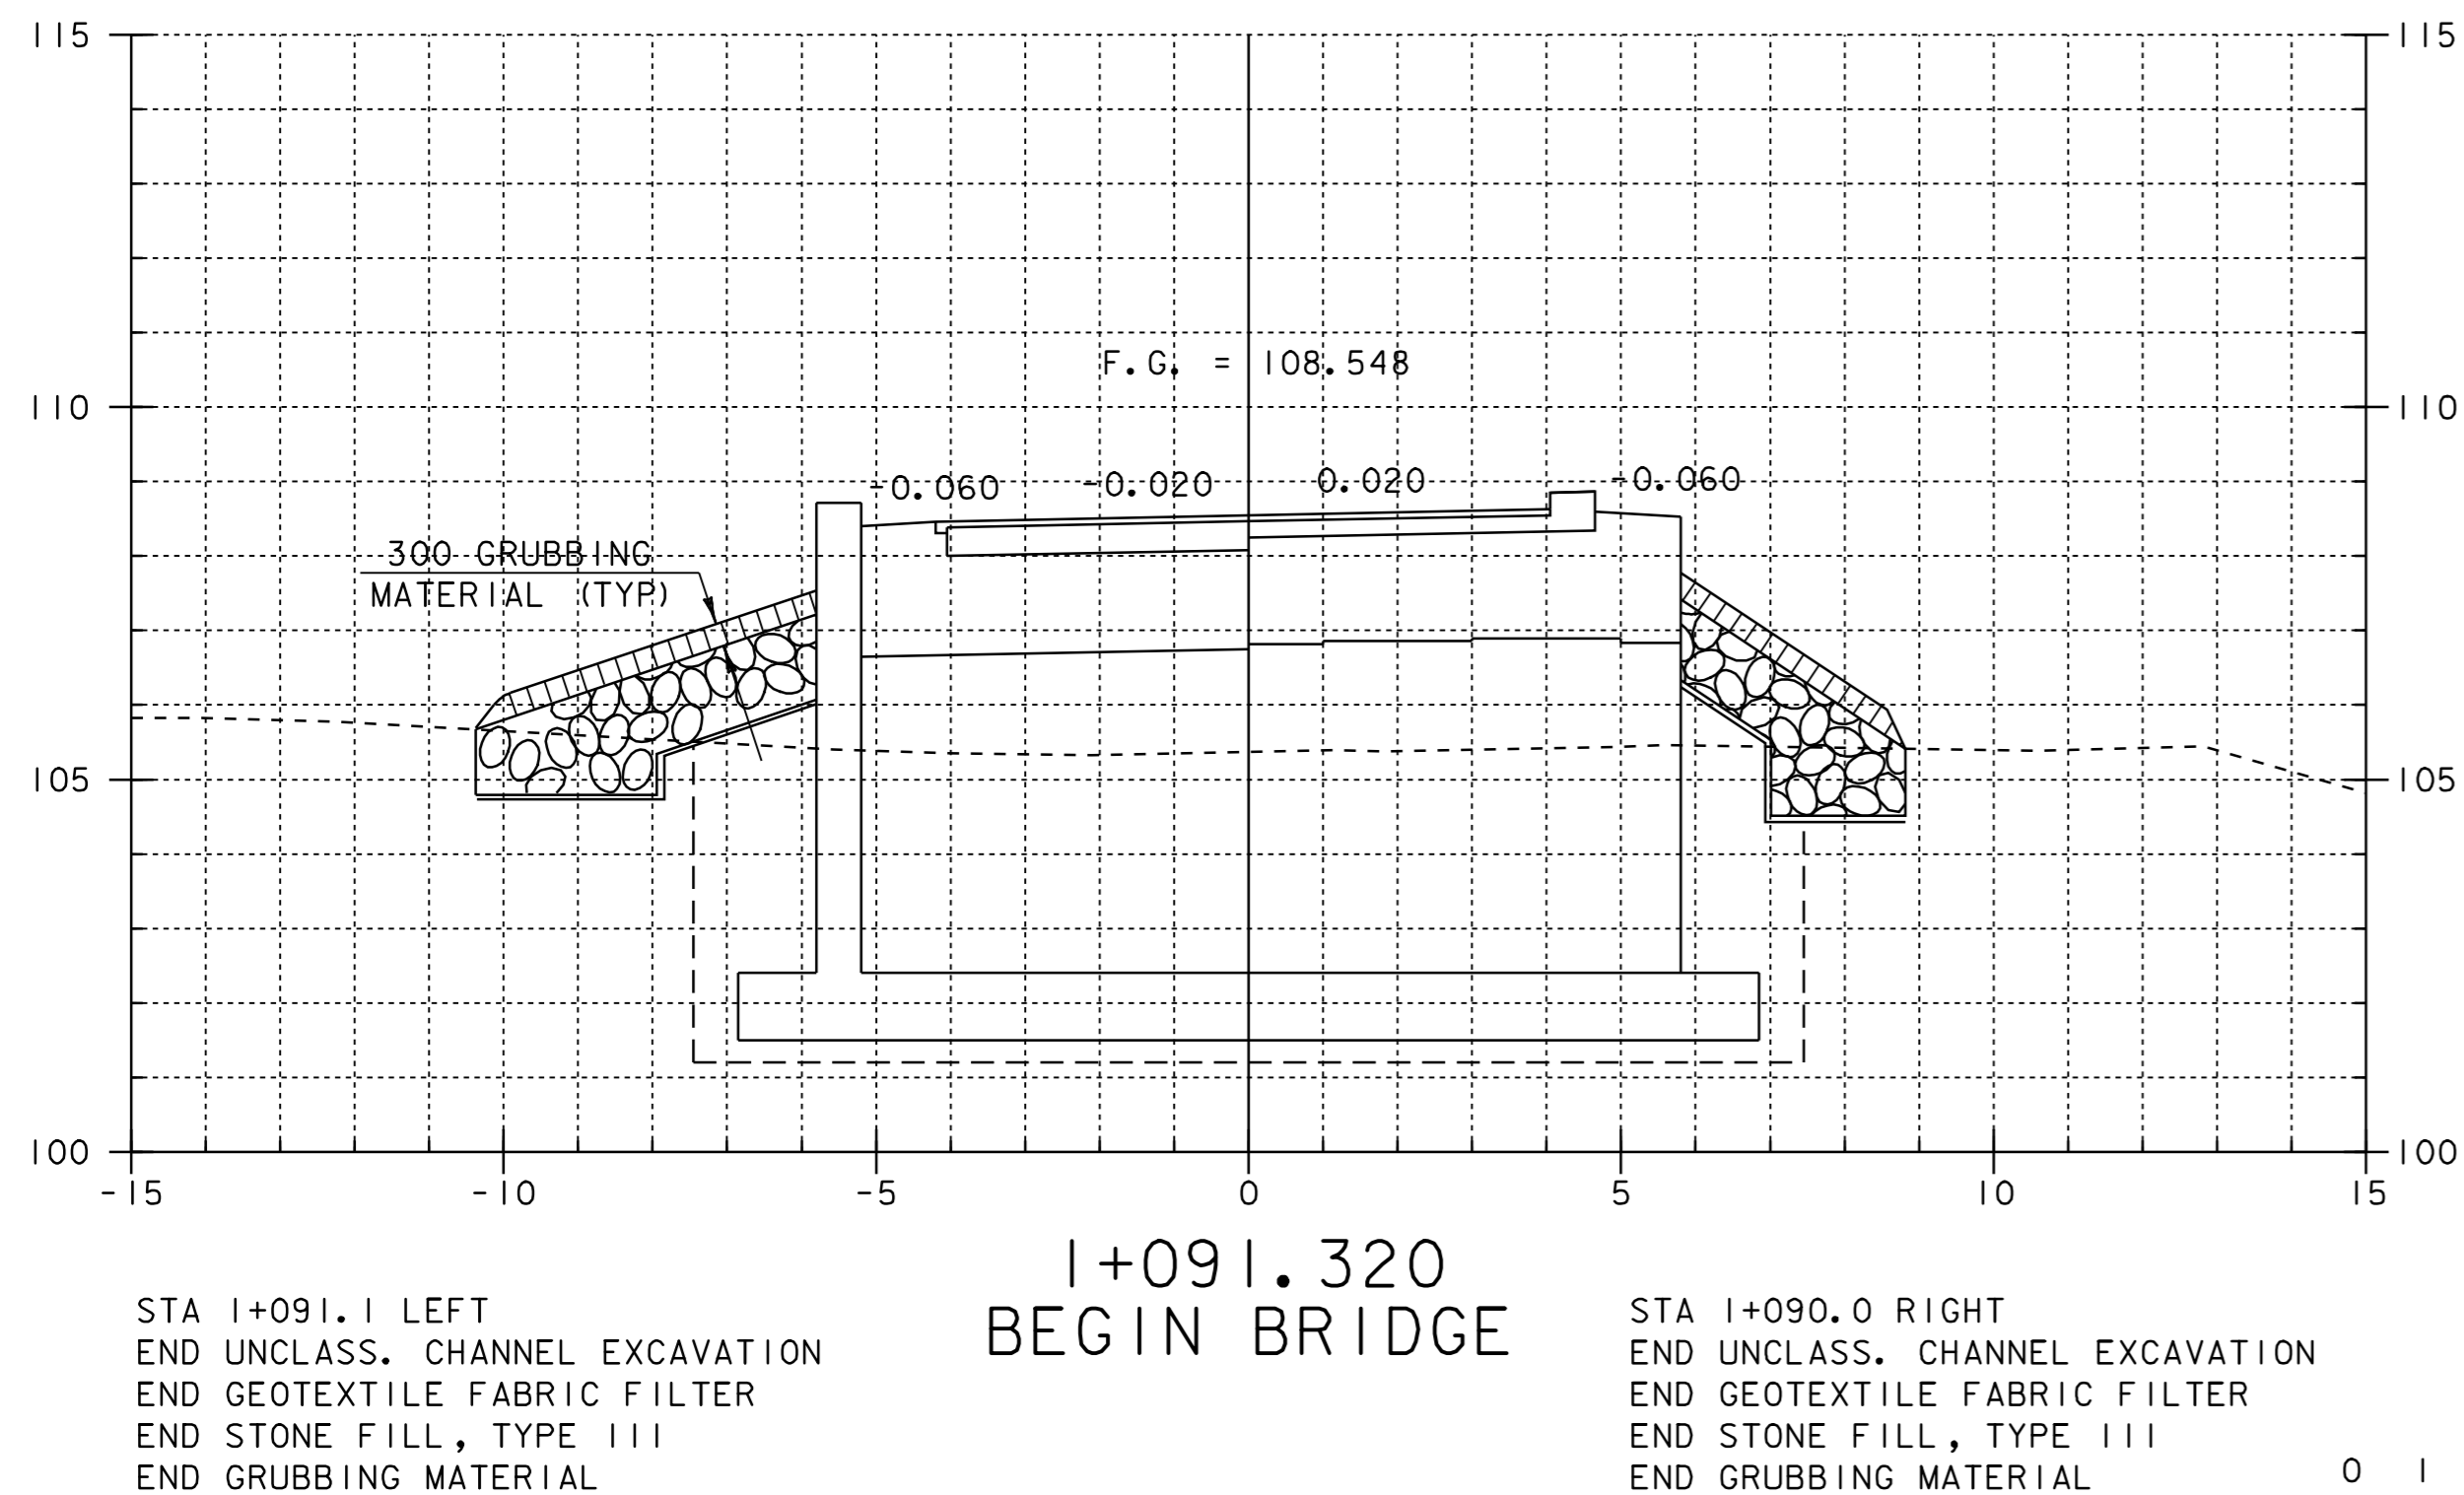
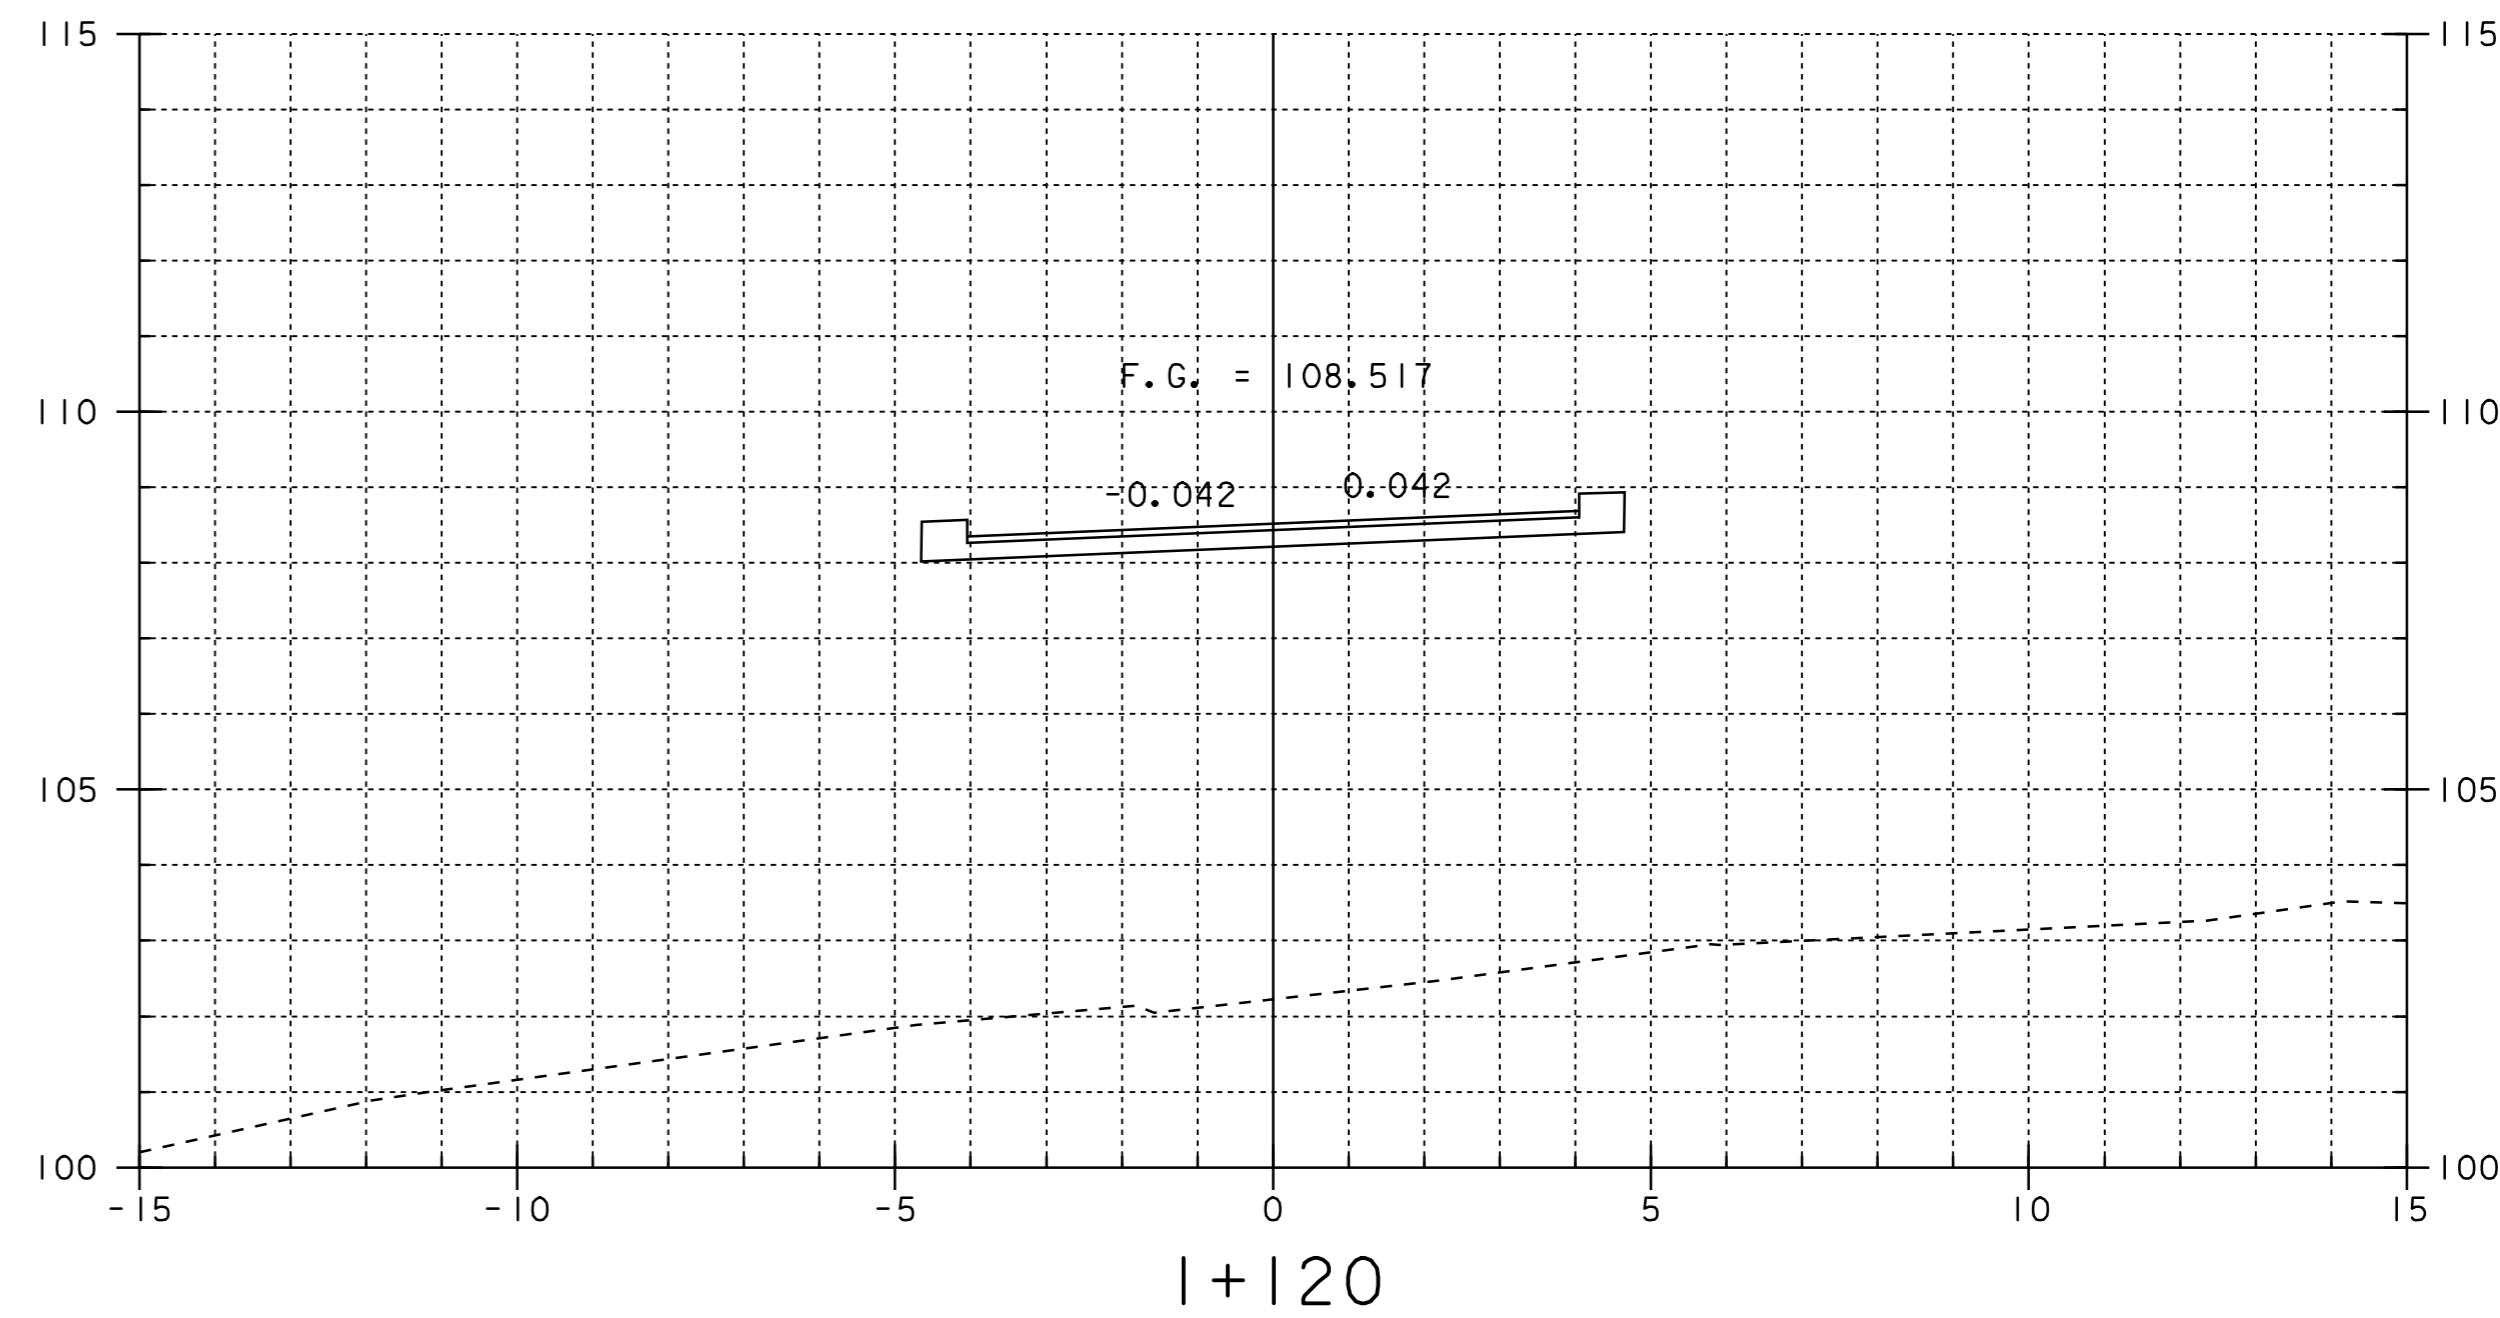
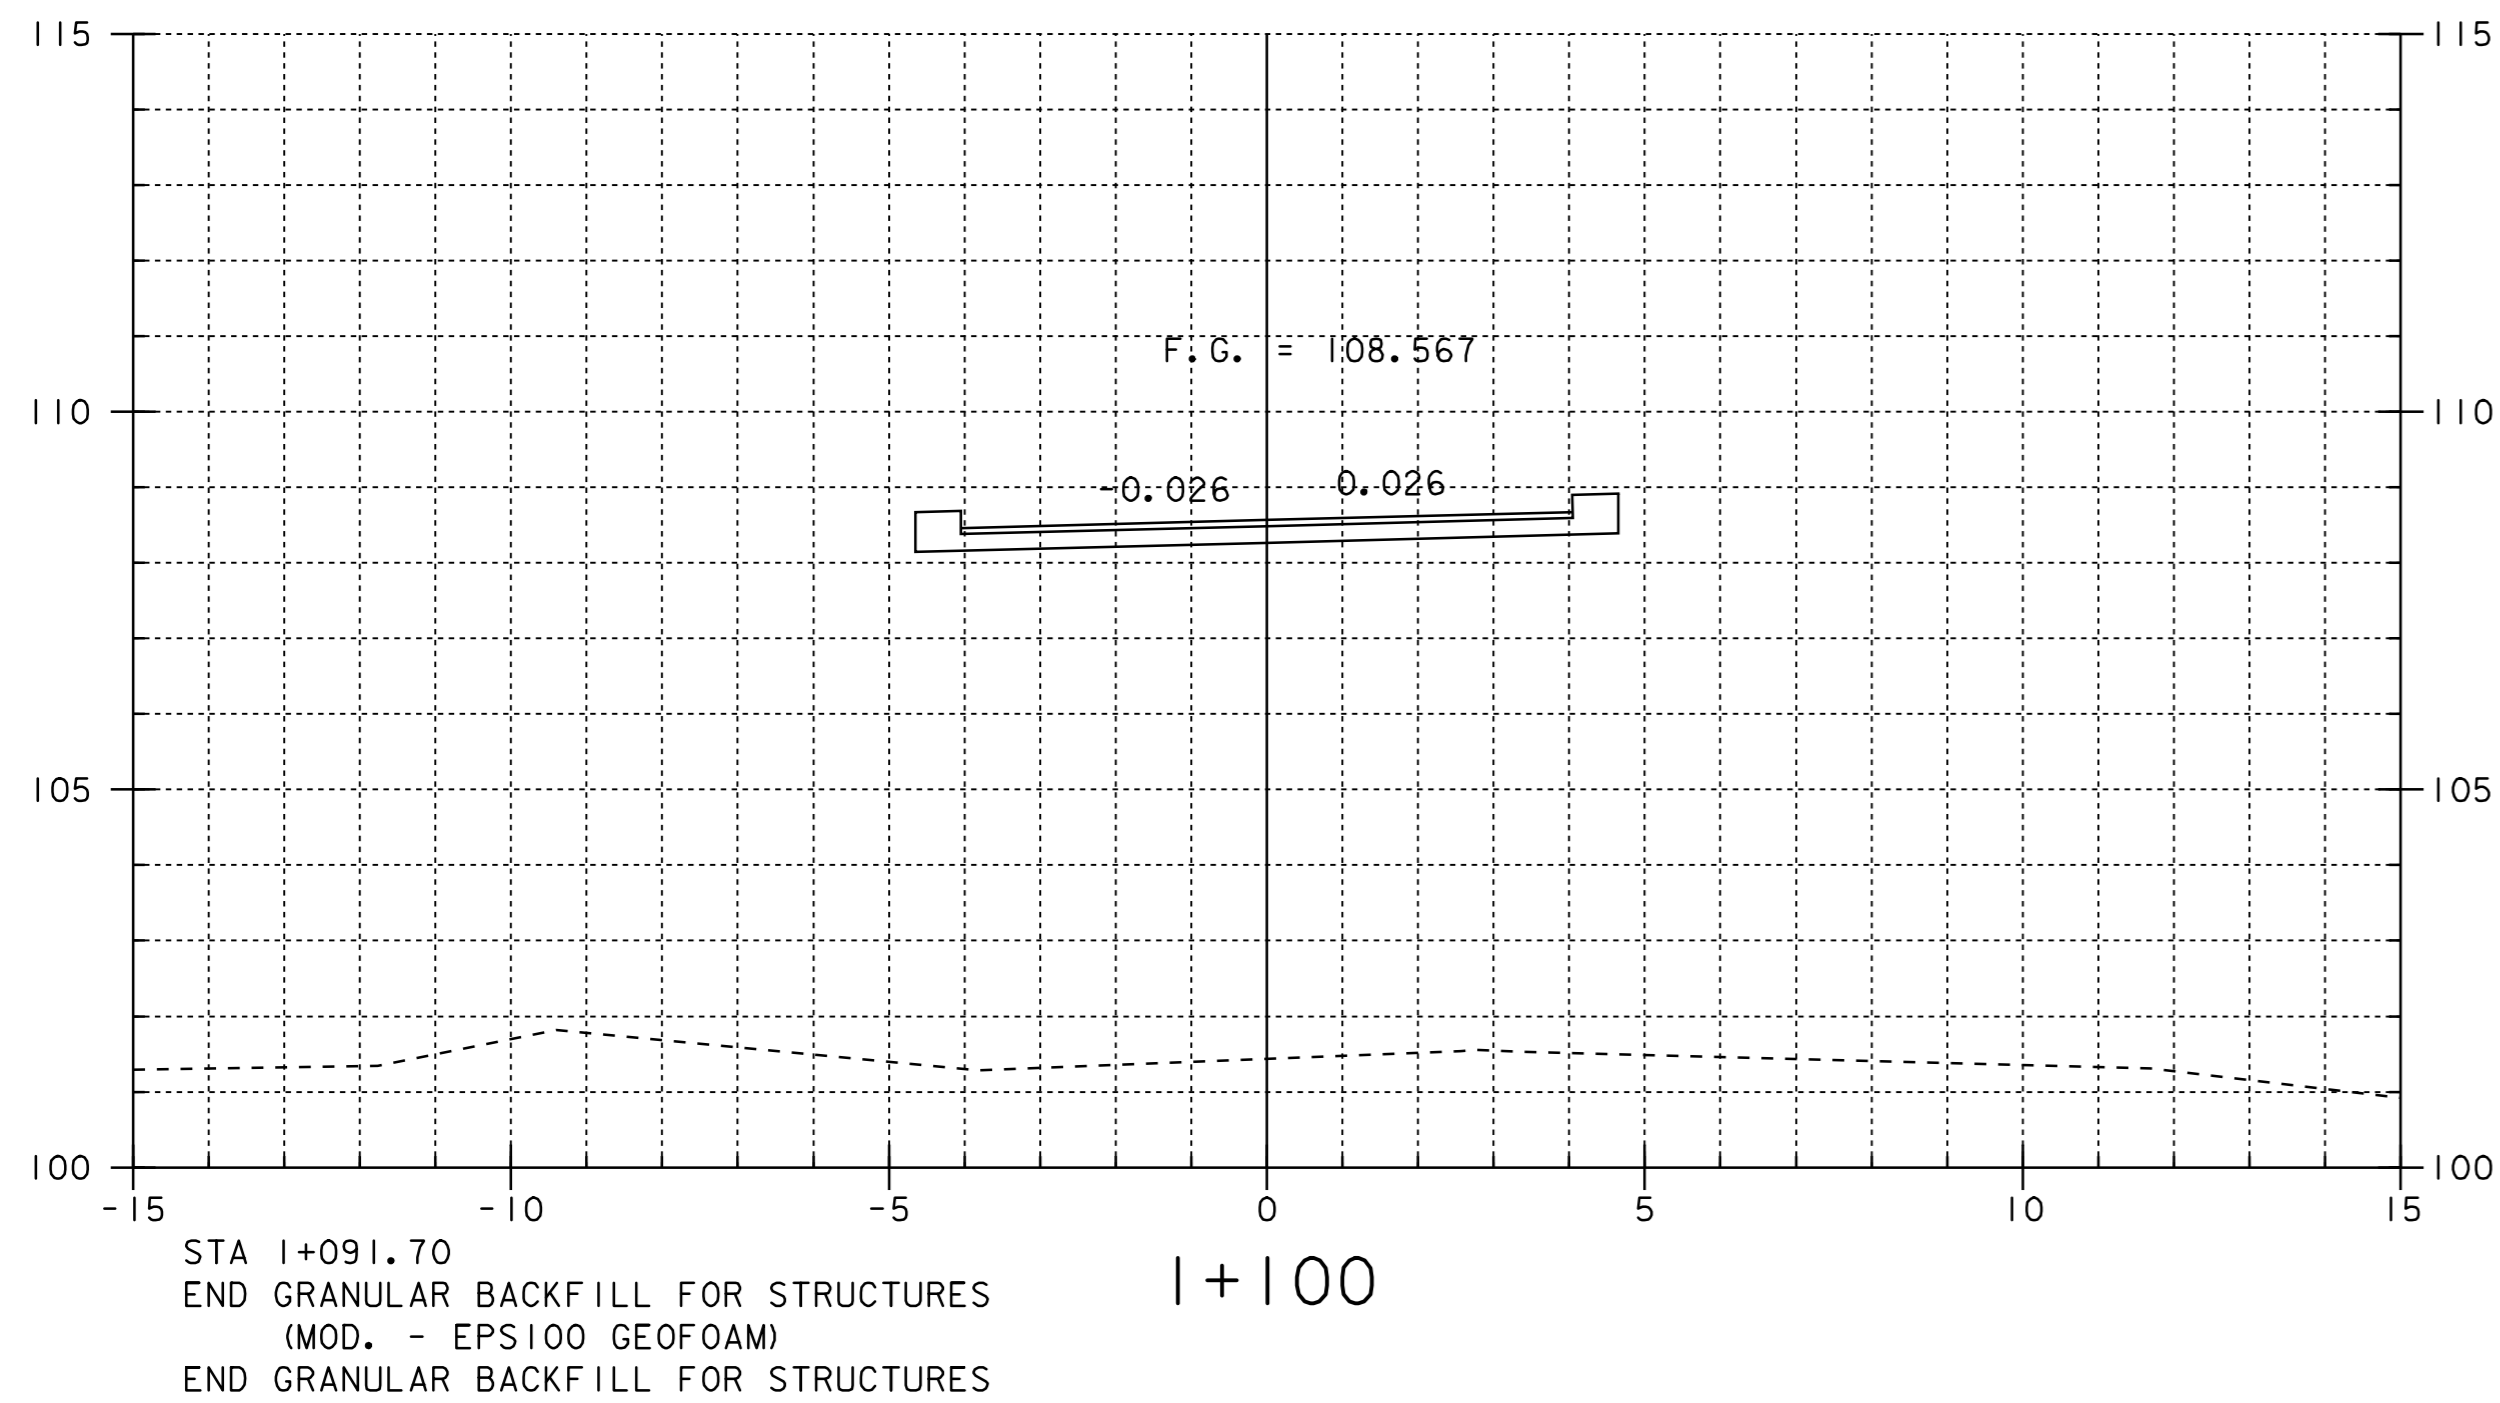
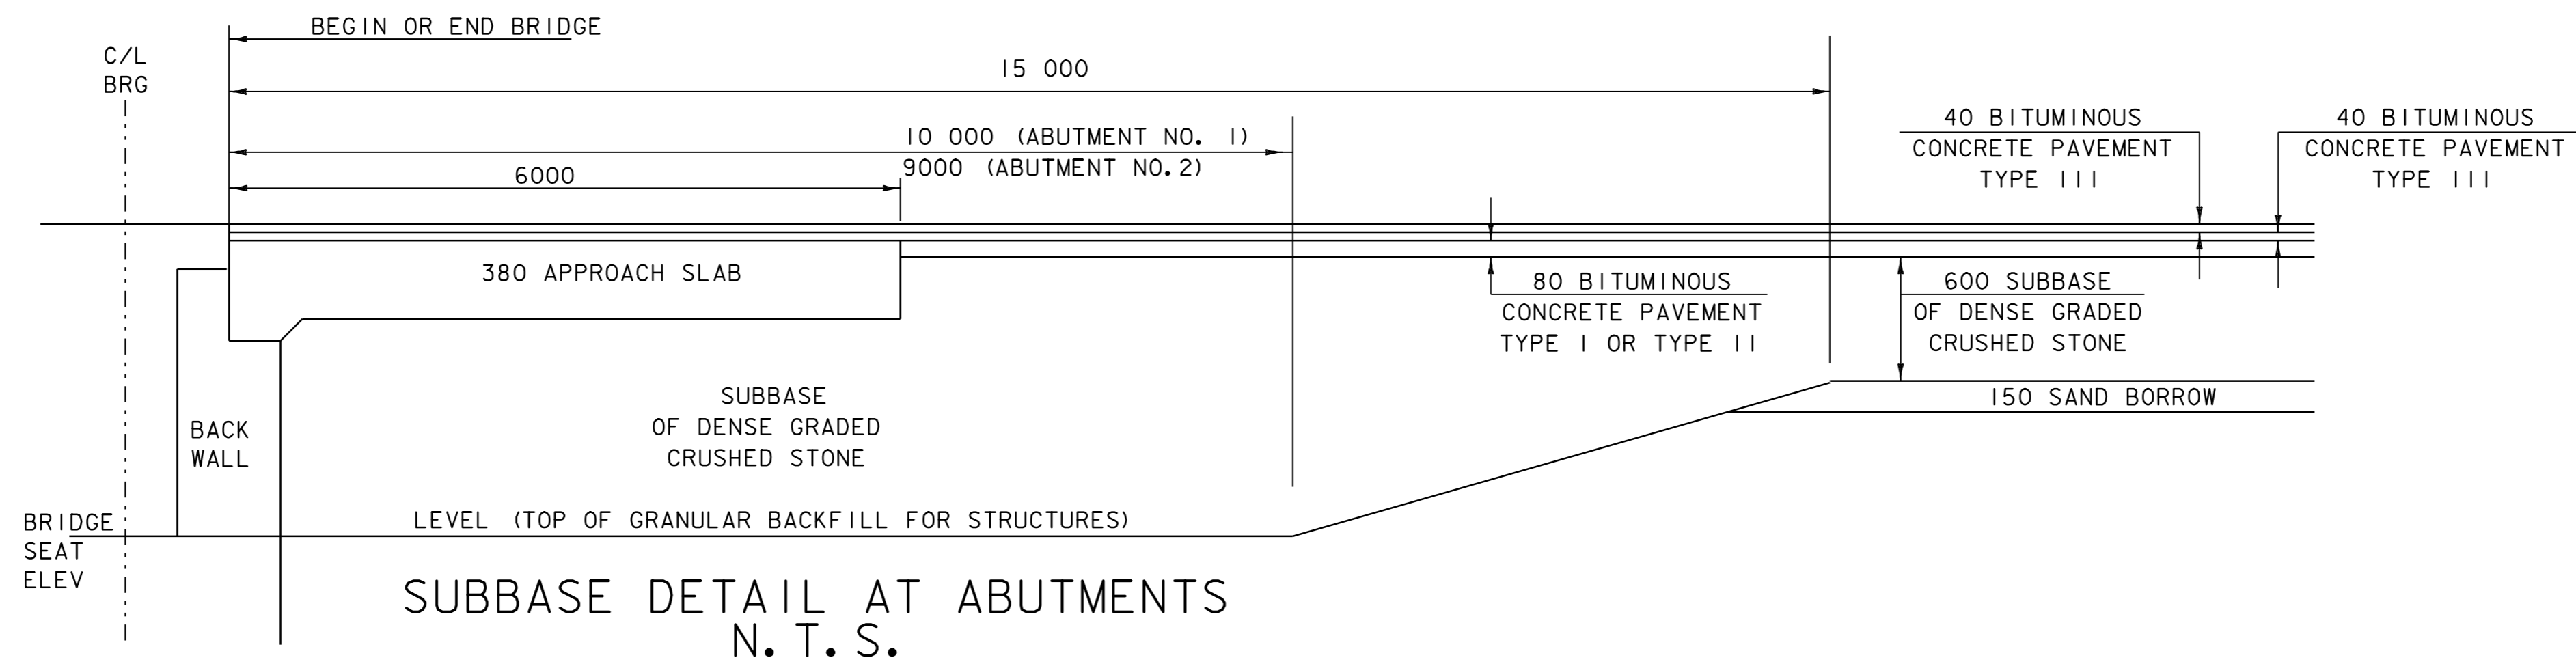


SCALE = 1:100






SHEET NAME: <u>MAINLINE CROSS SECTIONS</u>	
PROJECT NAME: <u>LEICESTER</u>	HIGHWAY NO.: <u>EAS_0160</u>
PROJECT NUMBER: <u>BRE_0160(3)S</u>	BRIDGE NO.: <u>6</u>
	OVER: <u>QUIER CREEK</u>
FILE NAME: <u>95J288\Structures\sj288xsl.dgn</u>	PLOT DATE: <u>02-OCT-2008 11:00</u>
PROJECT MANAGER: <u>B.B. WHITCOMB</u>	DRAWN BY: <u>J. GILMORE</u>
DESIGNED BY: <u>C. CARLSON</u>	IPARM NAME: <u>sj088dr8.l</u>
	SHEET <u>75</u> OF <u>90</u>

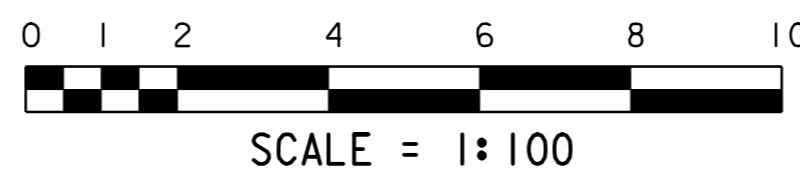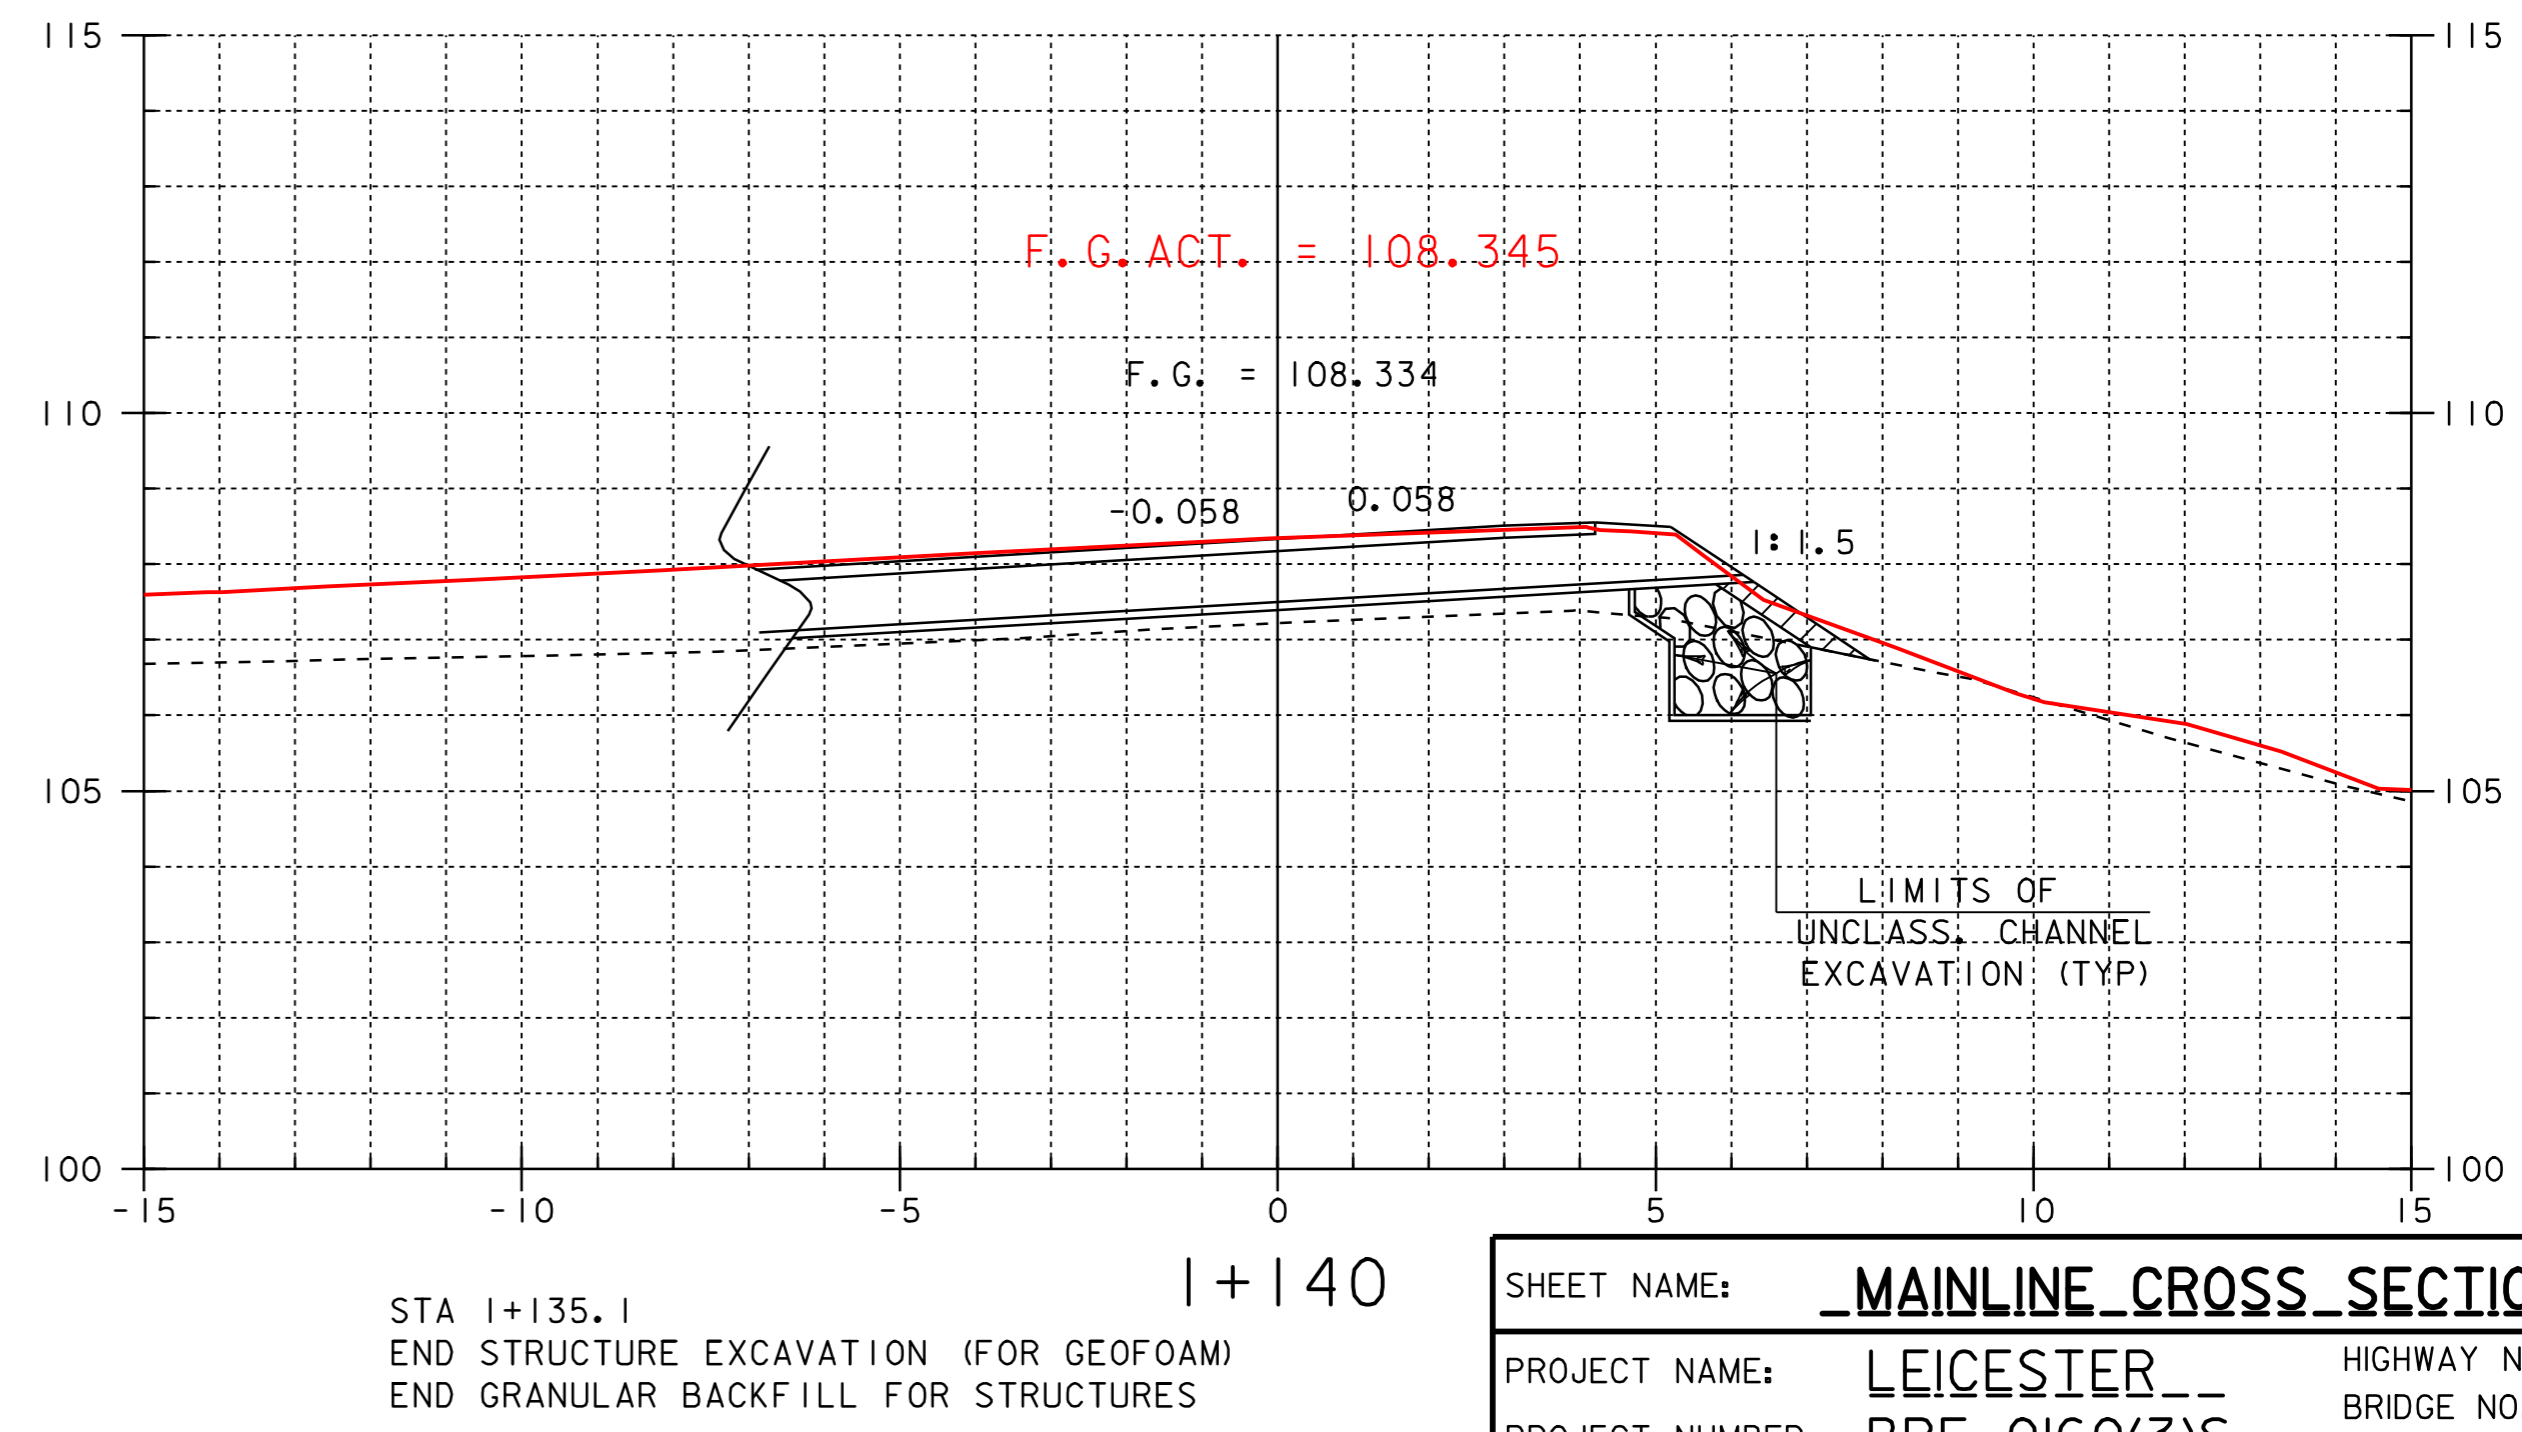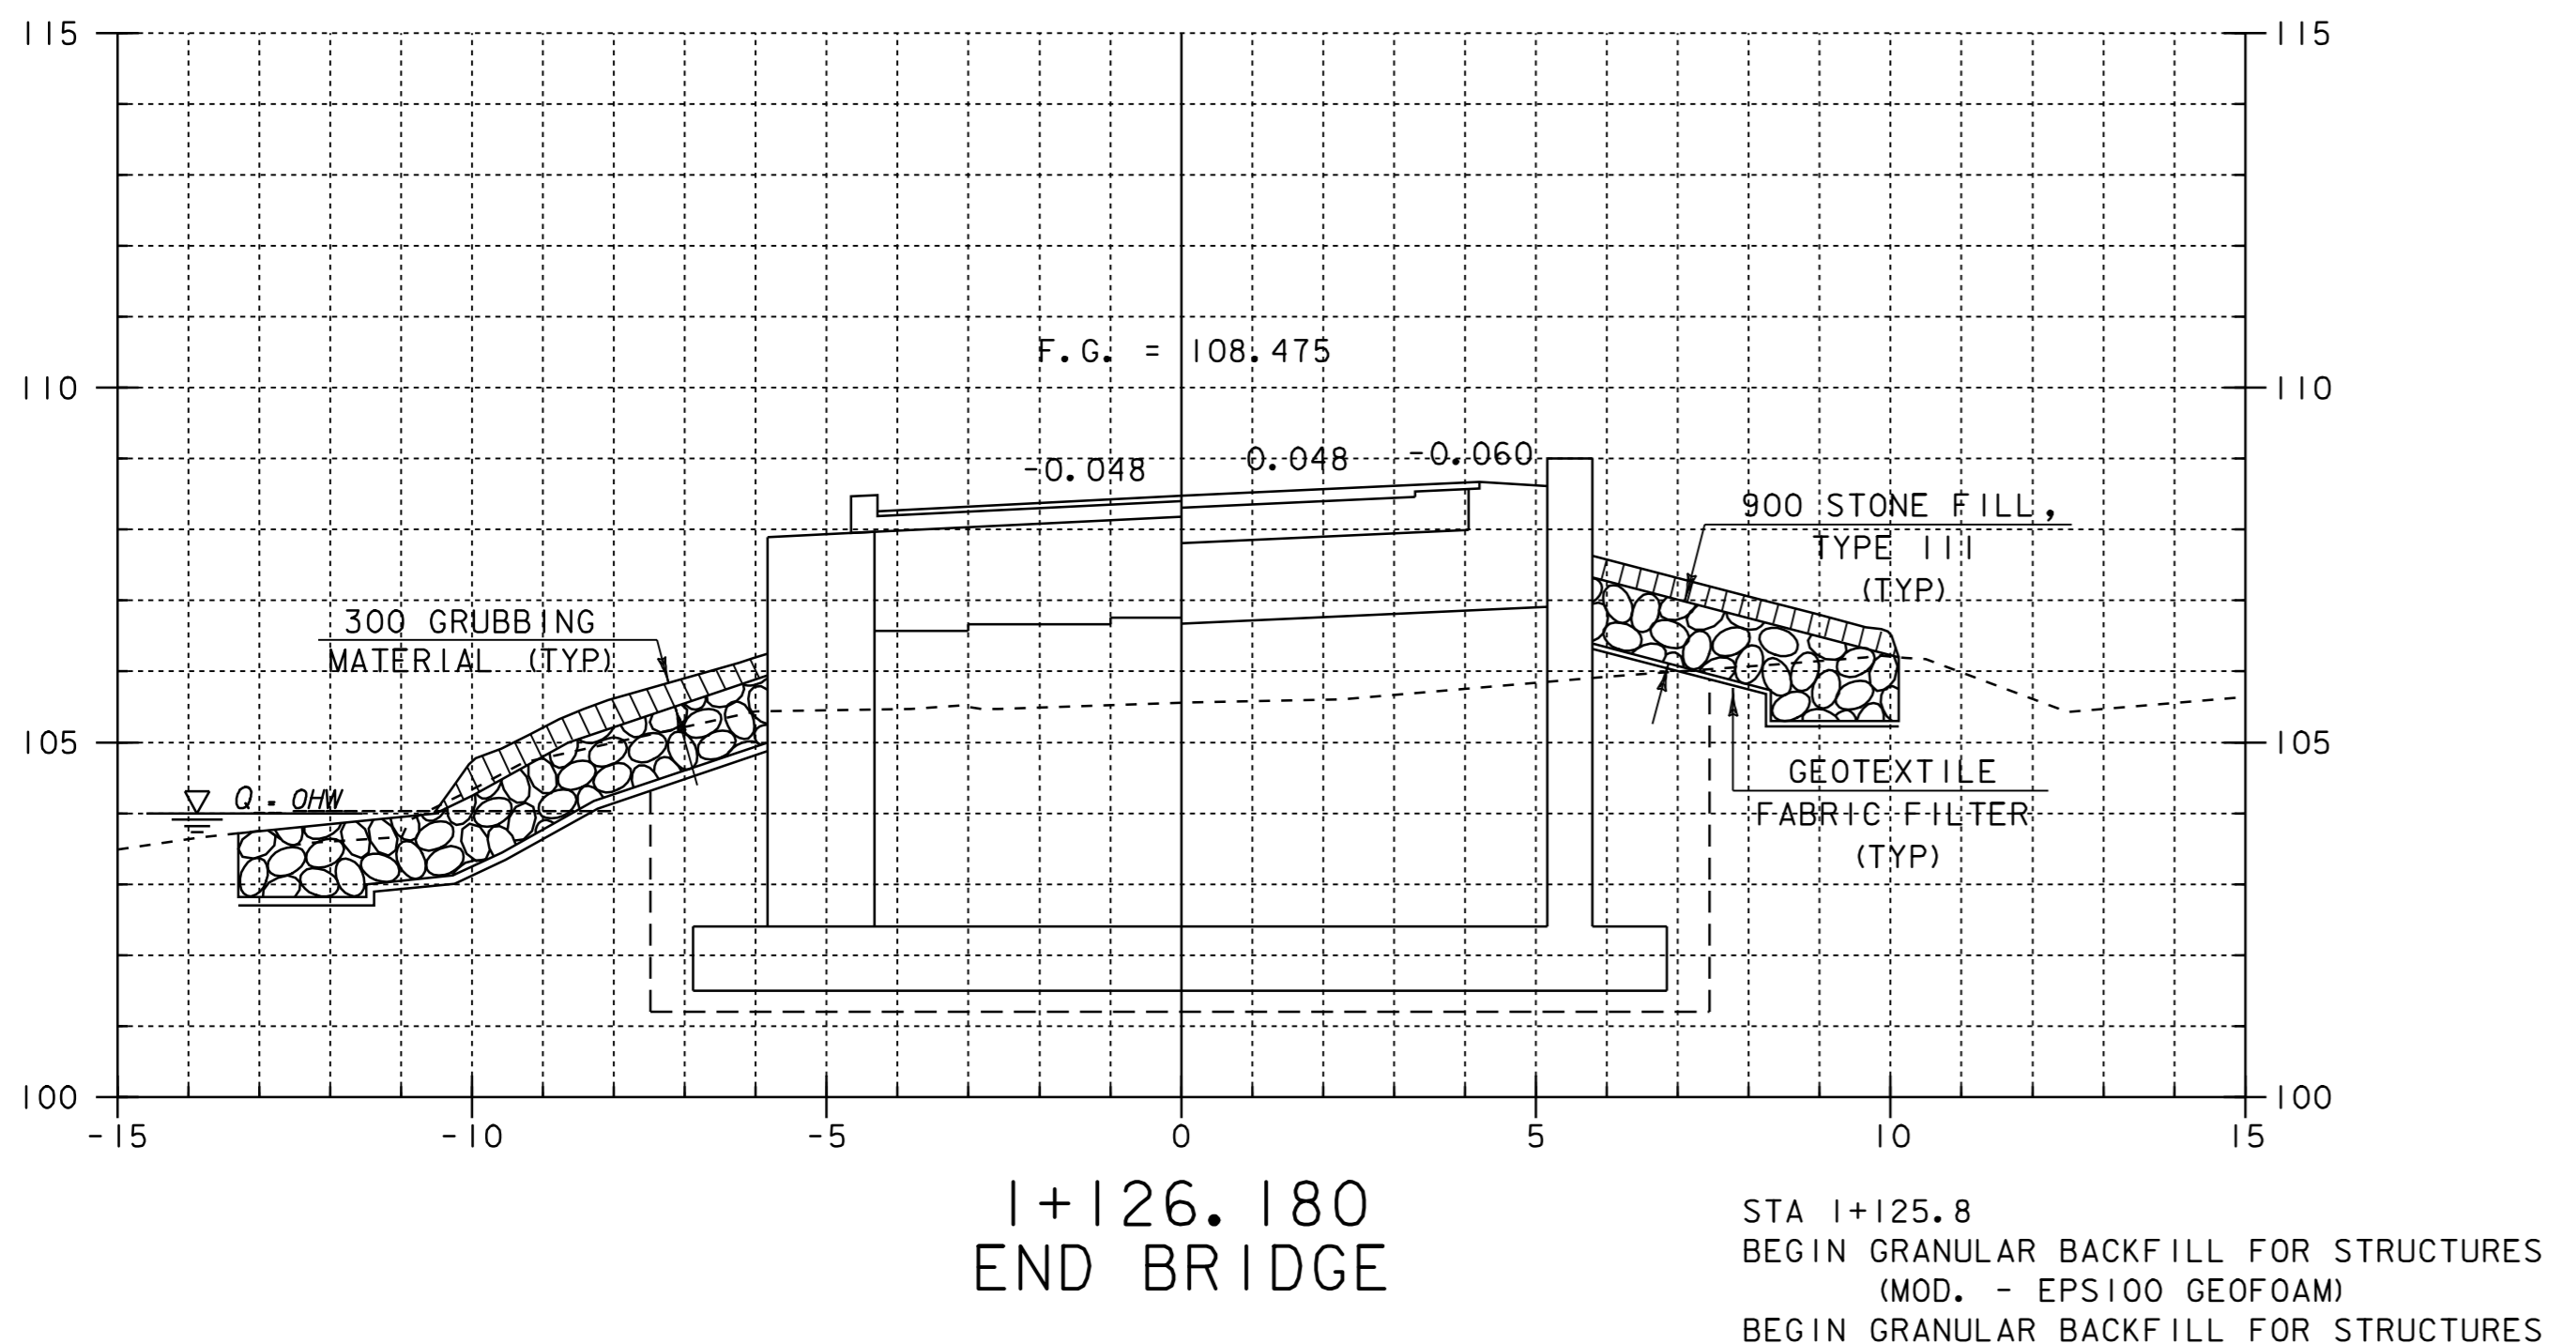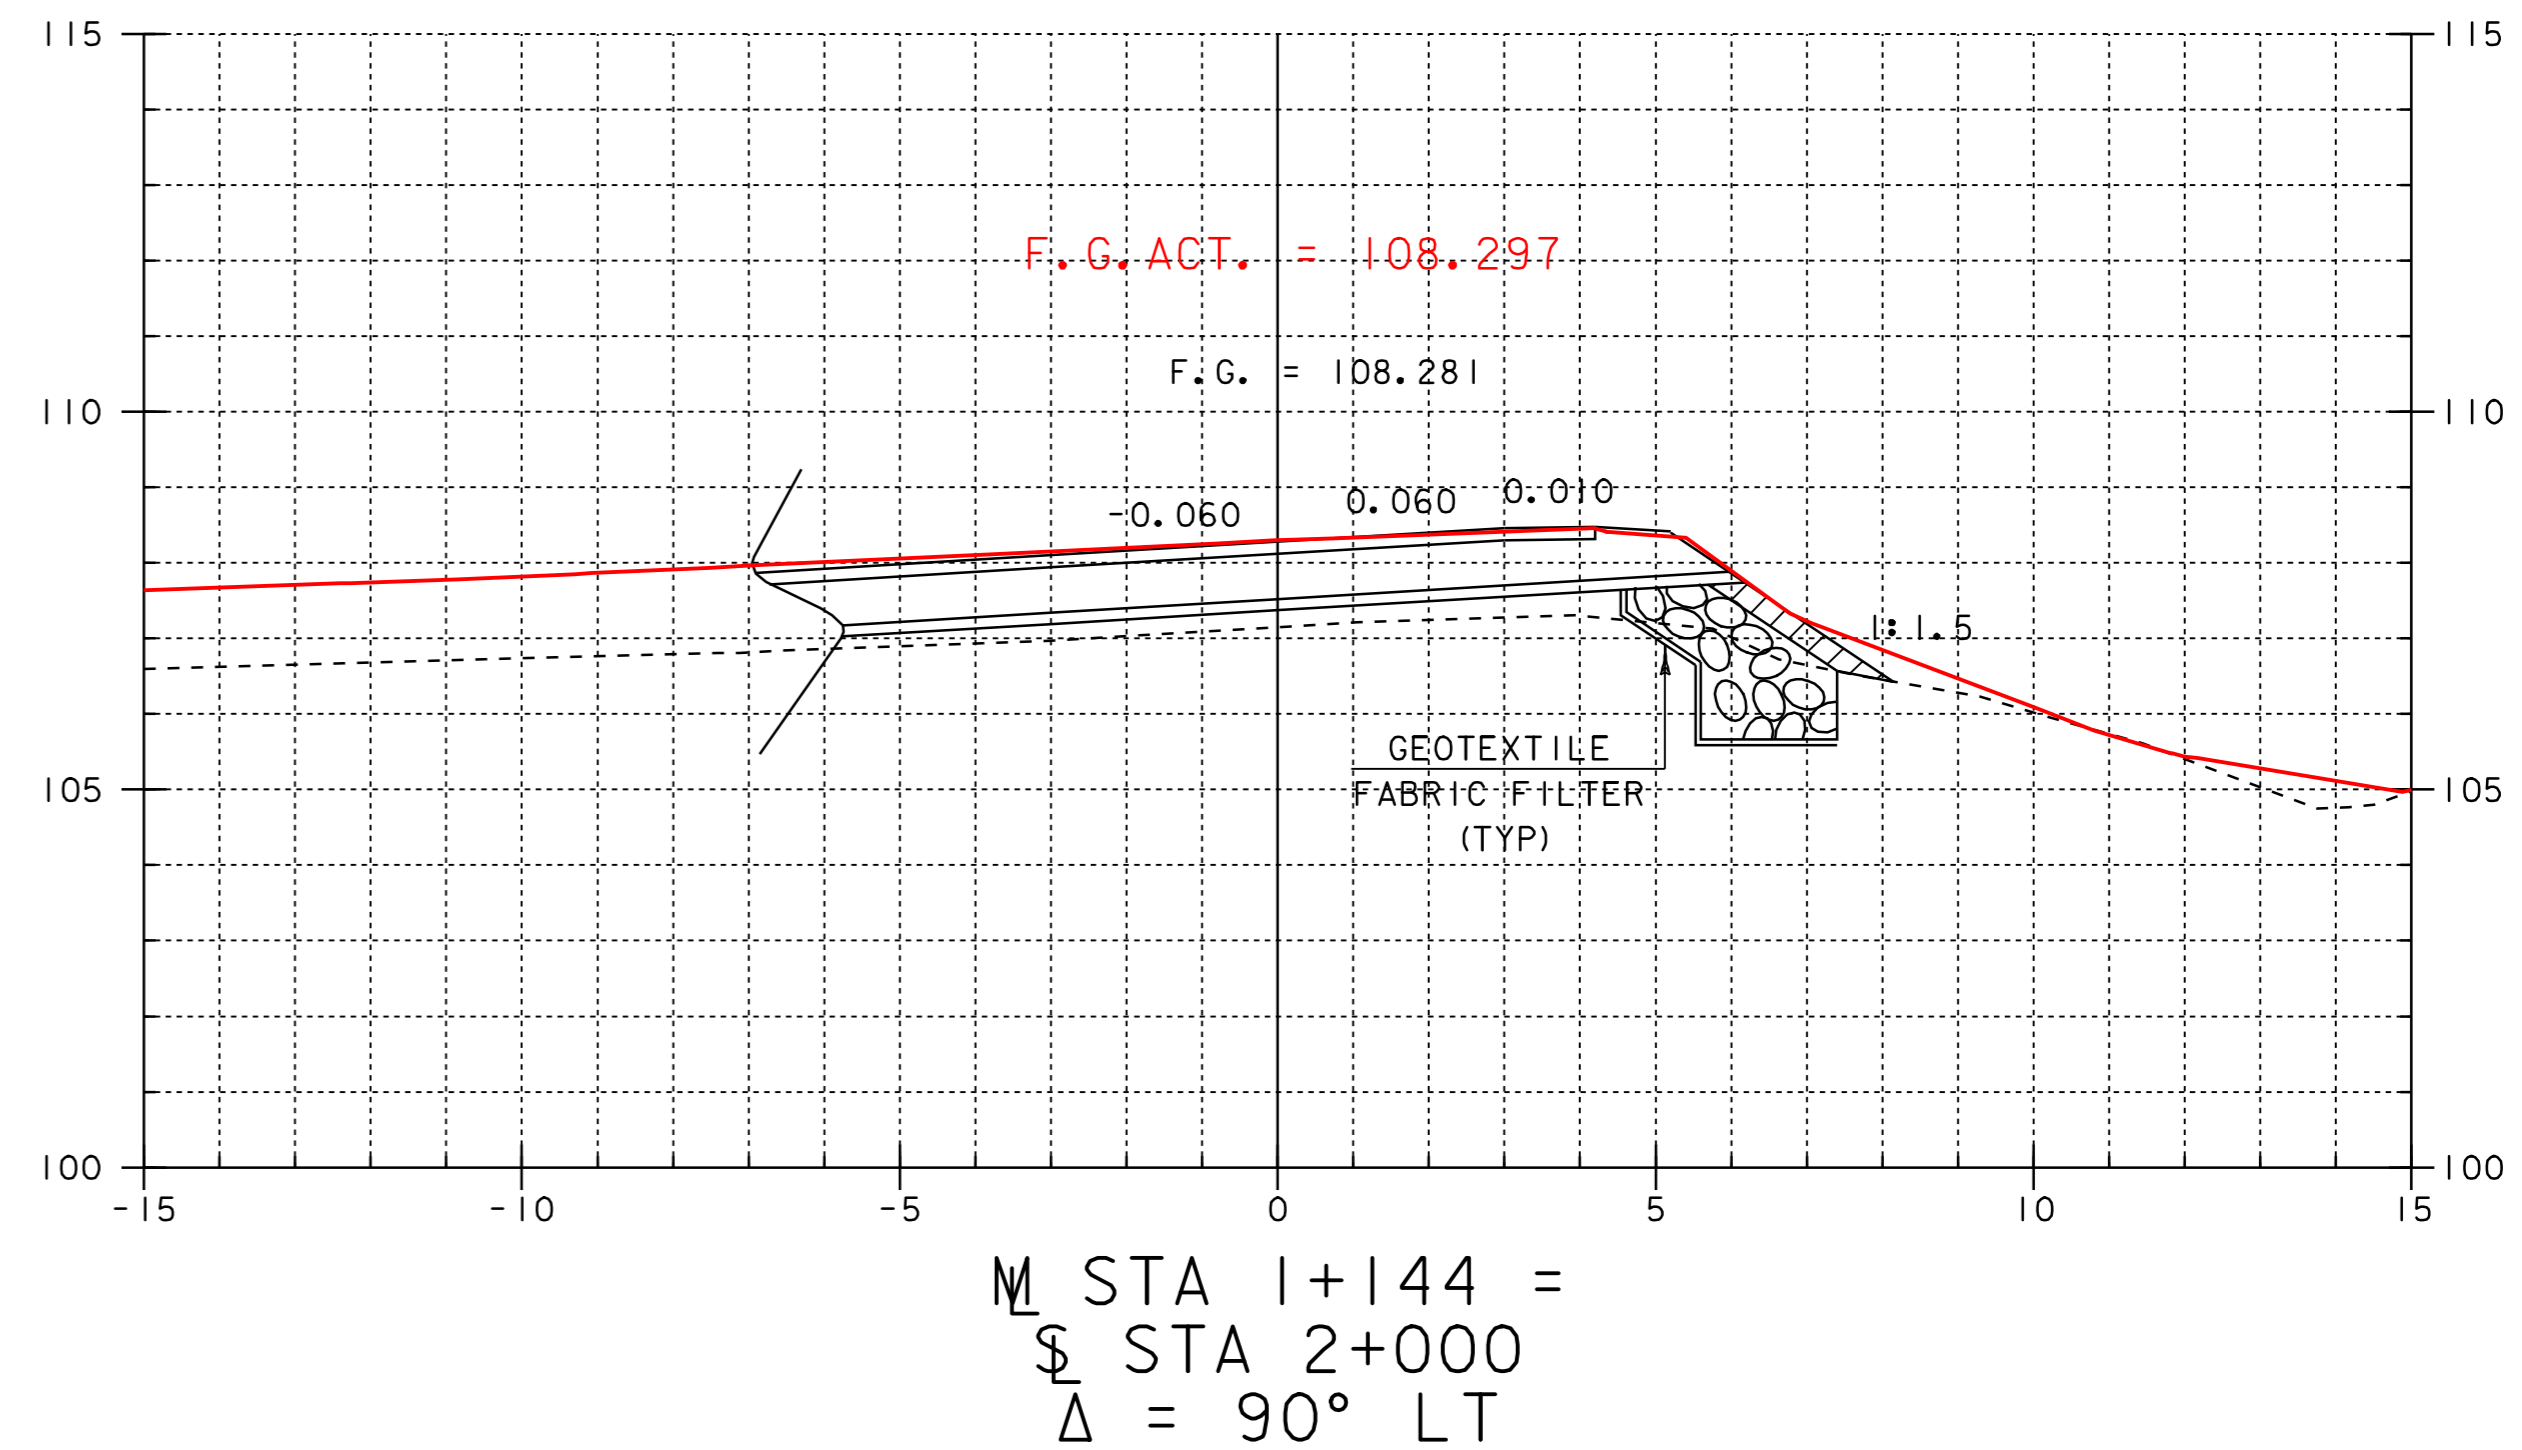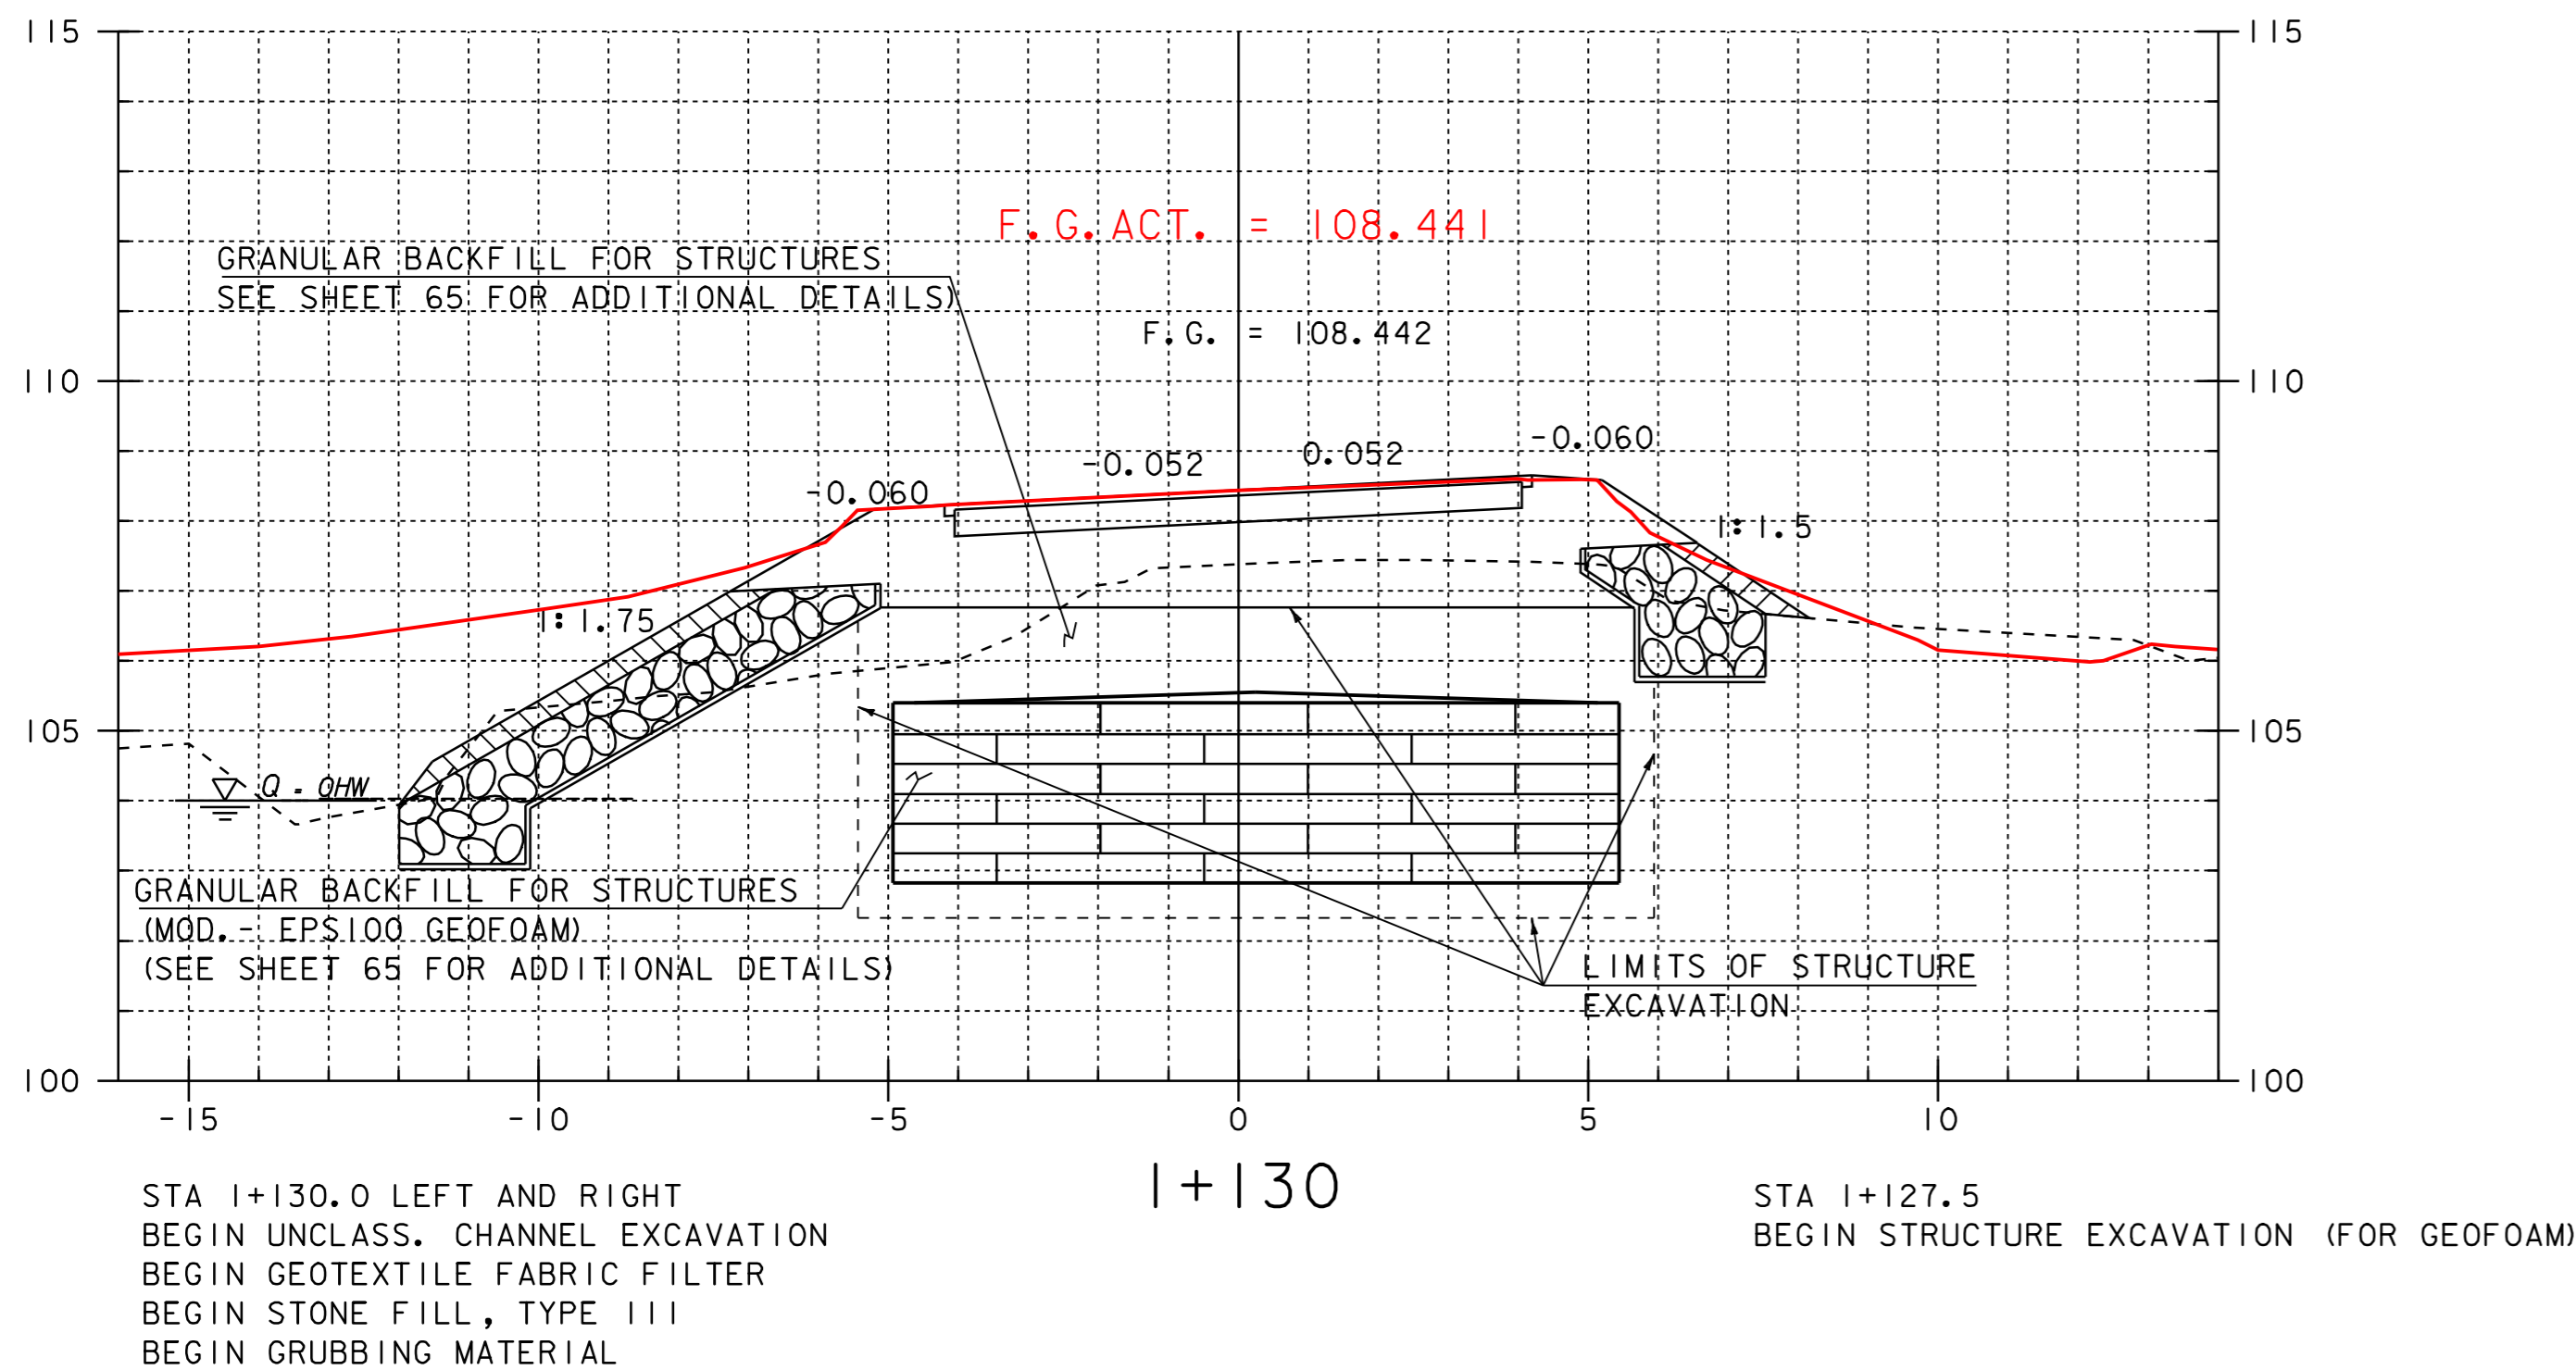






SHEET NAME: MAINLINE CROSS SECTIONS	
PROJECT NAME: LEICESTER	HIGHWAY NO.: EAS_0160
PROJECT NUMBER: BRE_0160(3)S	BRIDGE NO.: 6
	OVER: QUIER CREEK
FILE NAME: 95J288\Structures\sj288xsl.dgn	PLOT DATE: 02-OCT-2008 11:00
PROJECT MANAGER: B.B. WHITCOMB	DRAWN BY: J. GILMORE
DESIGNED BY: C. CARLSON	IPARM NAME: sj088dr9.i
	SHEET 76 OF 90

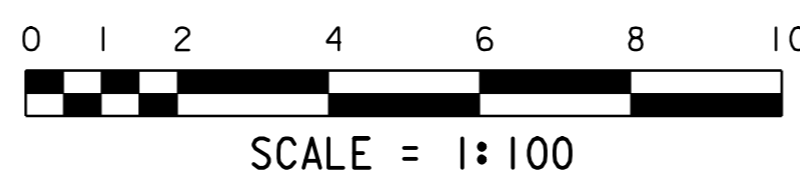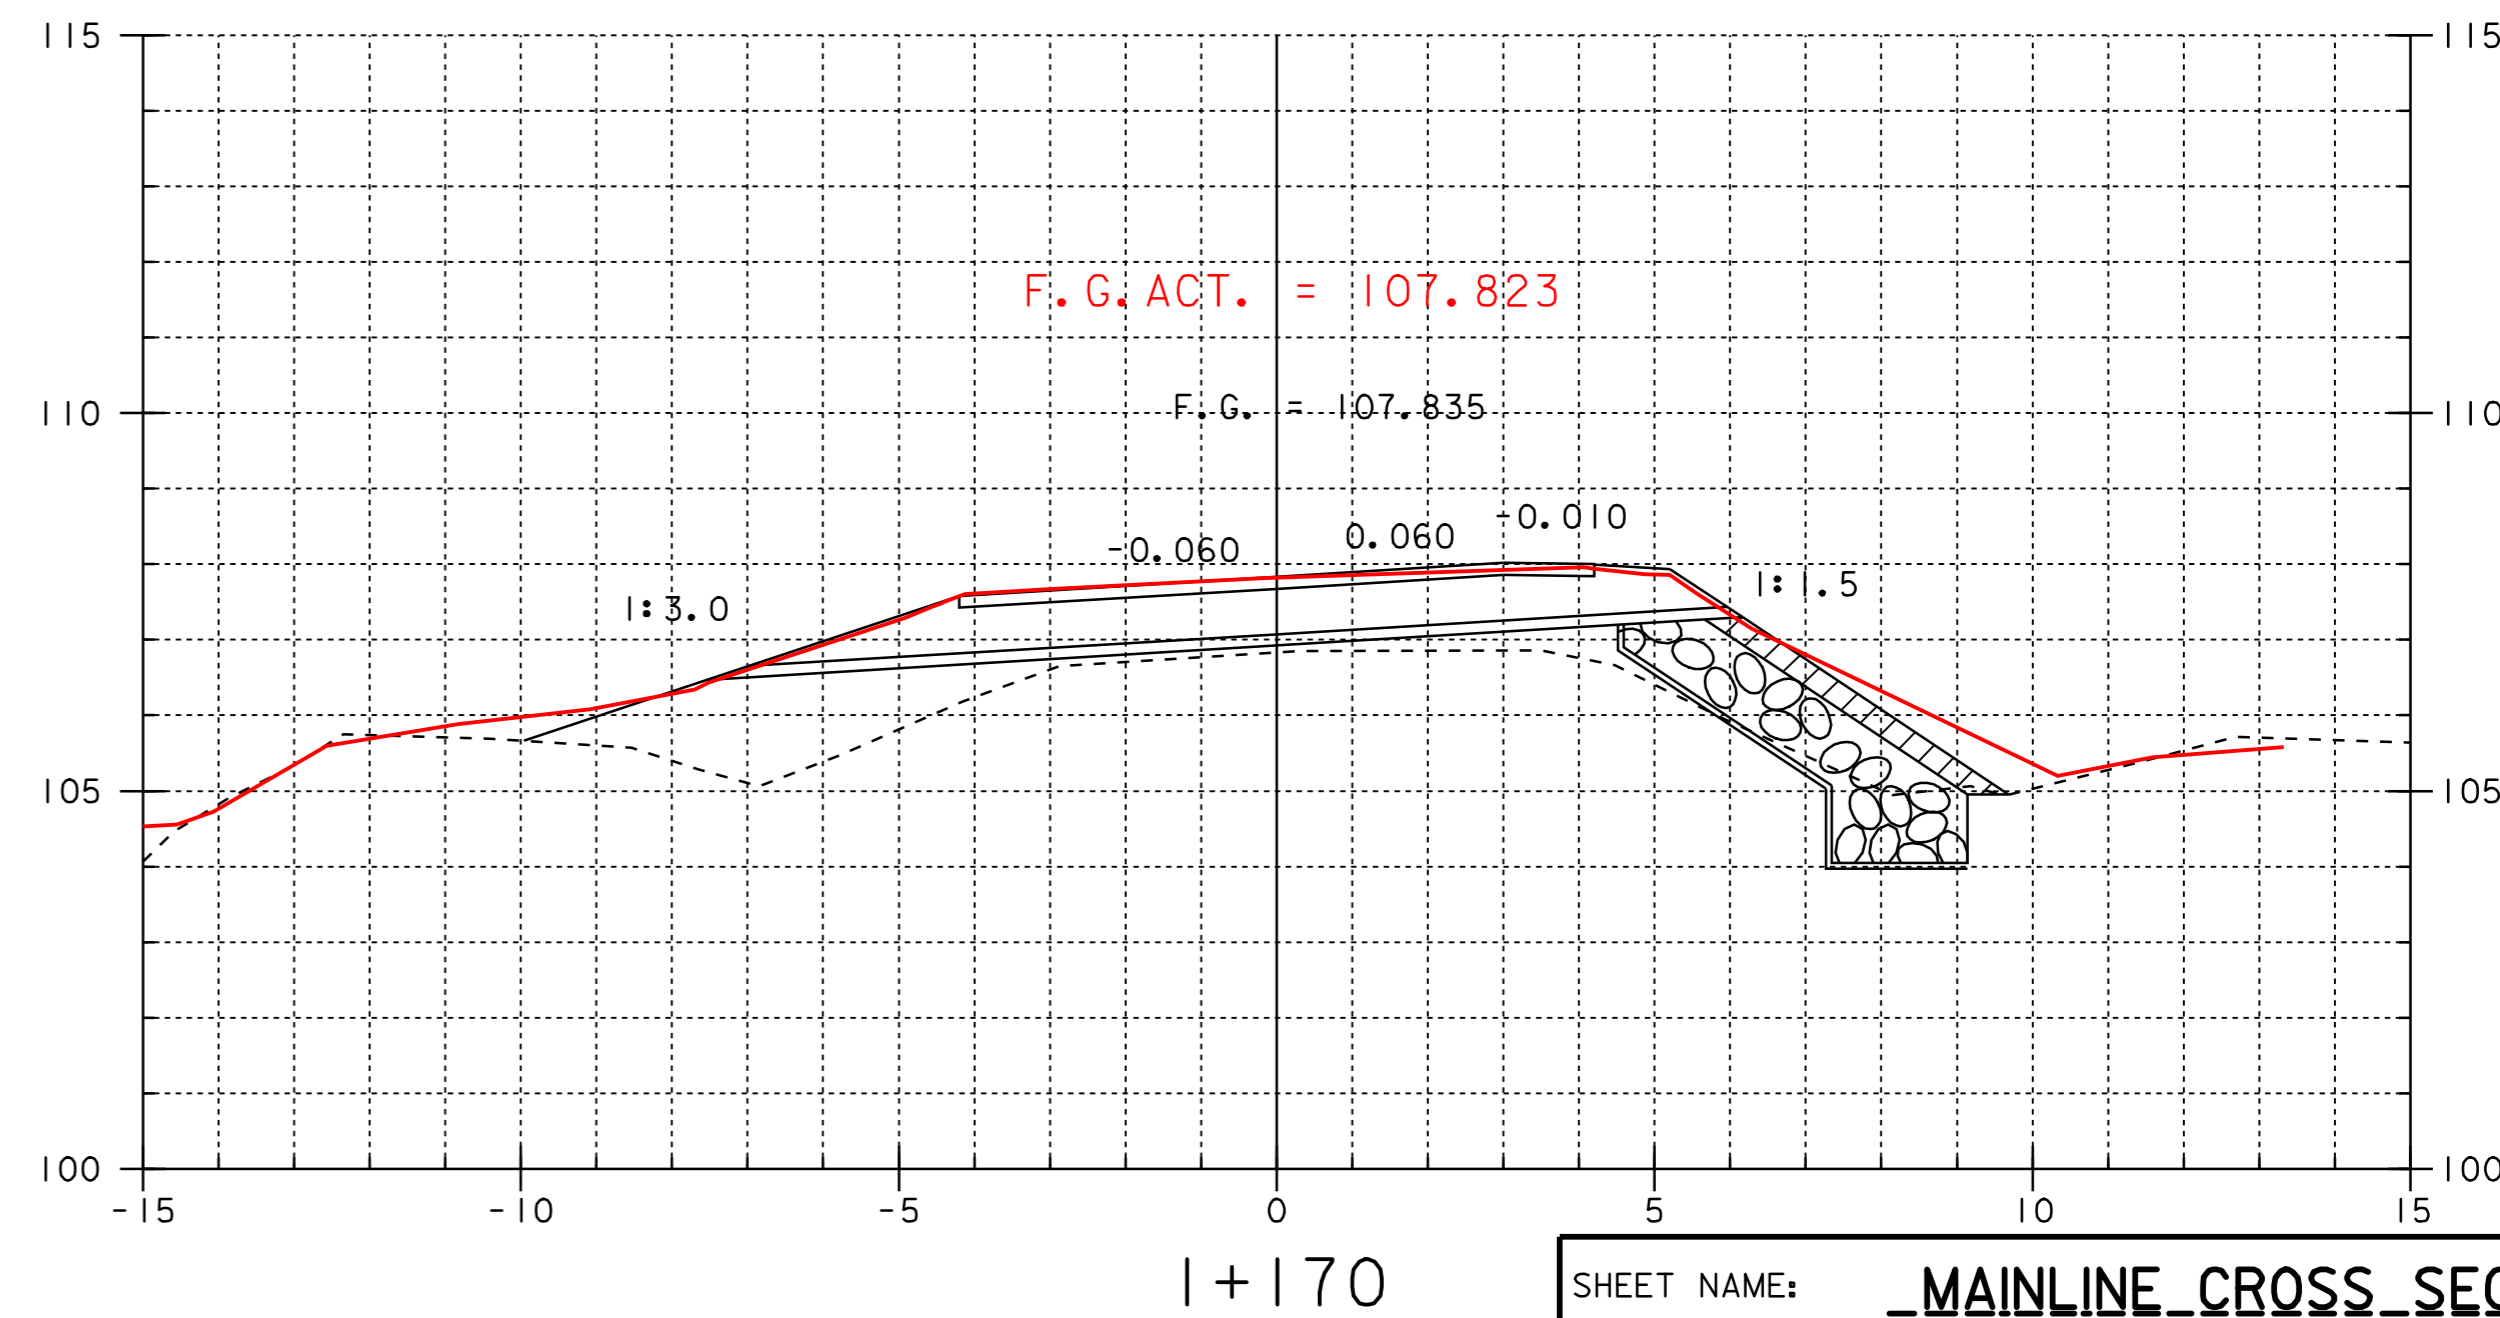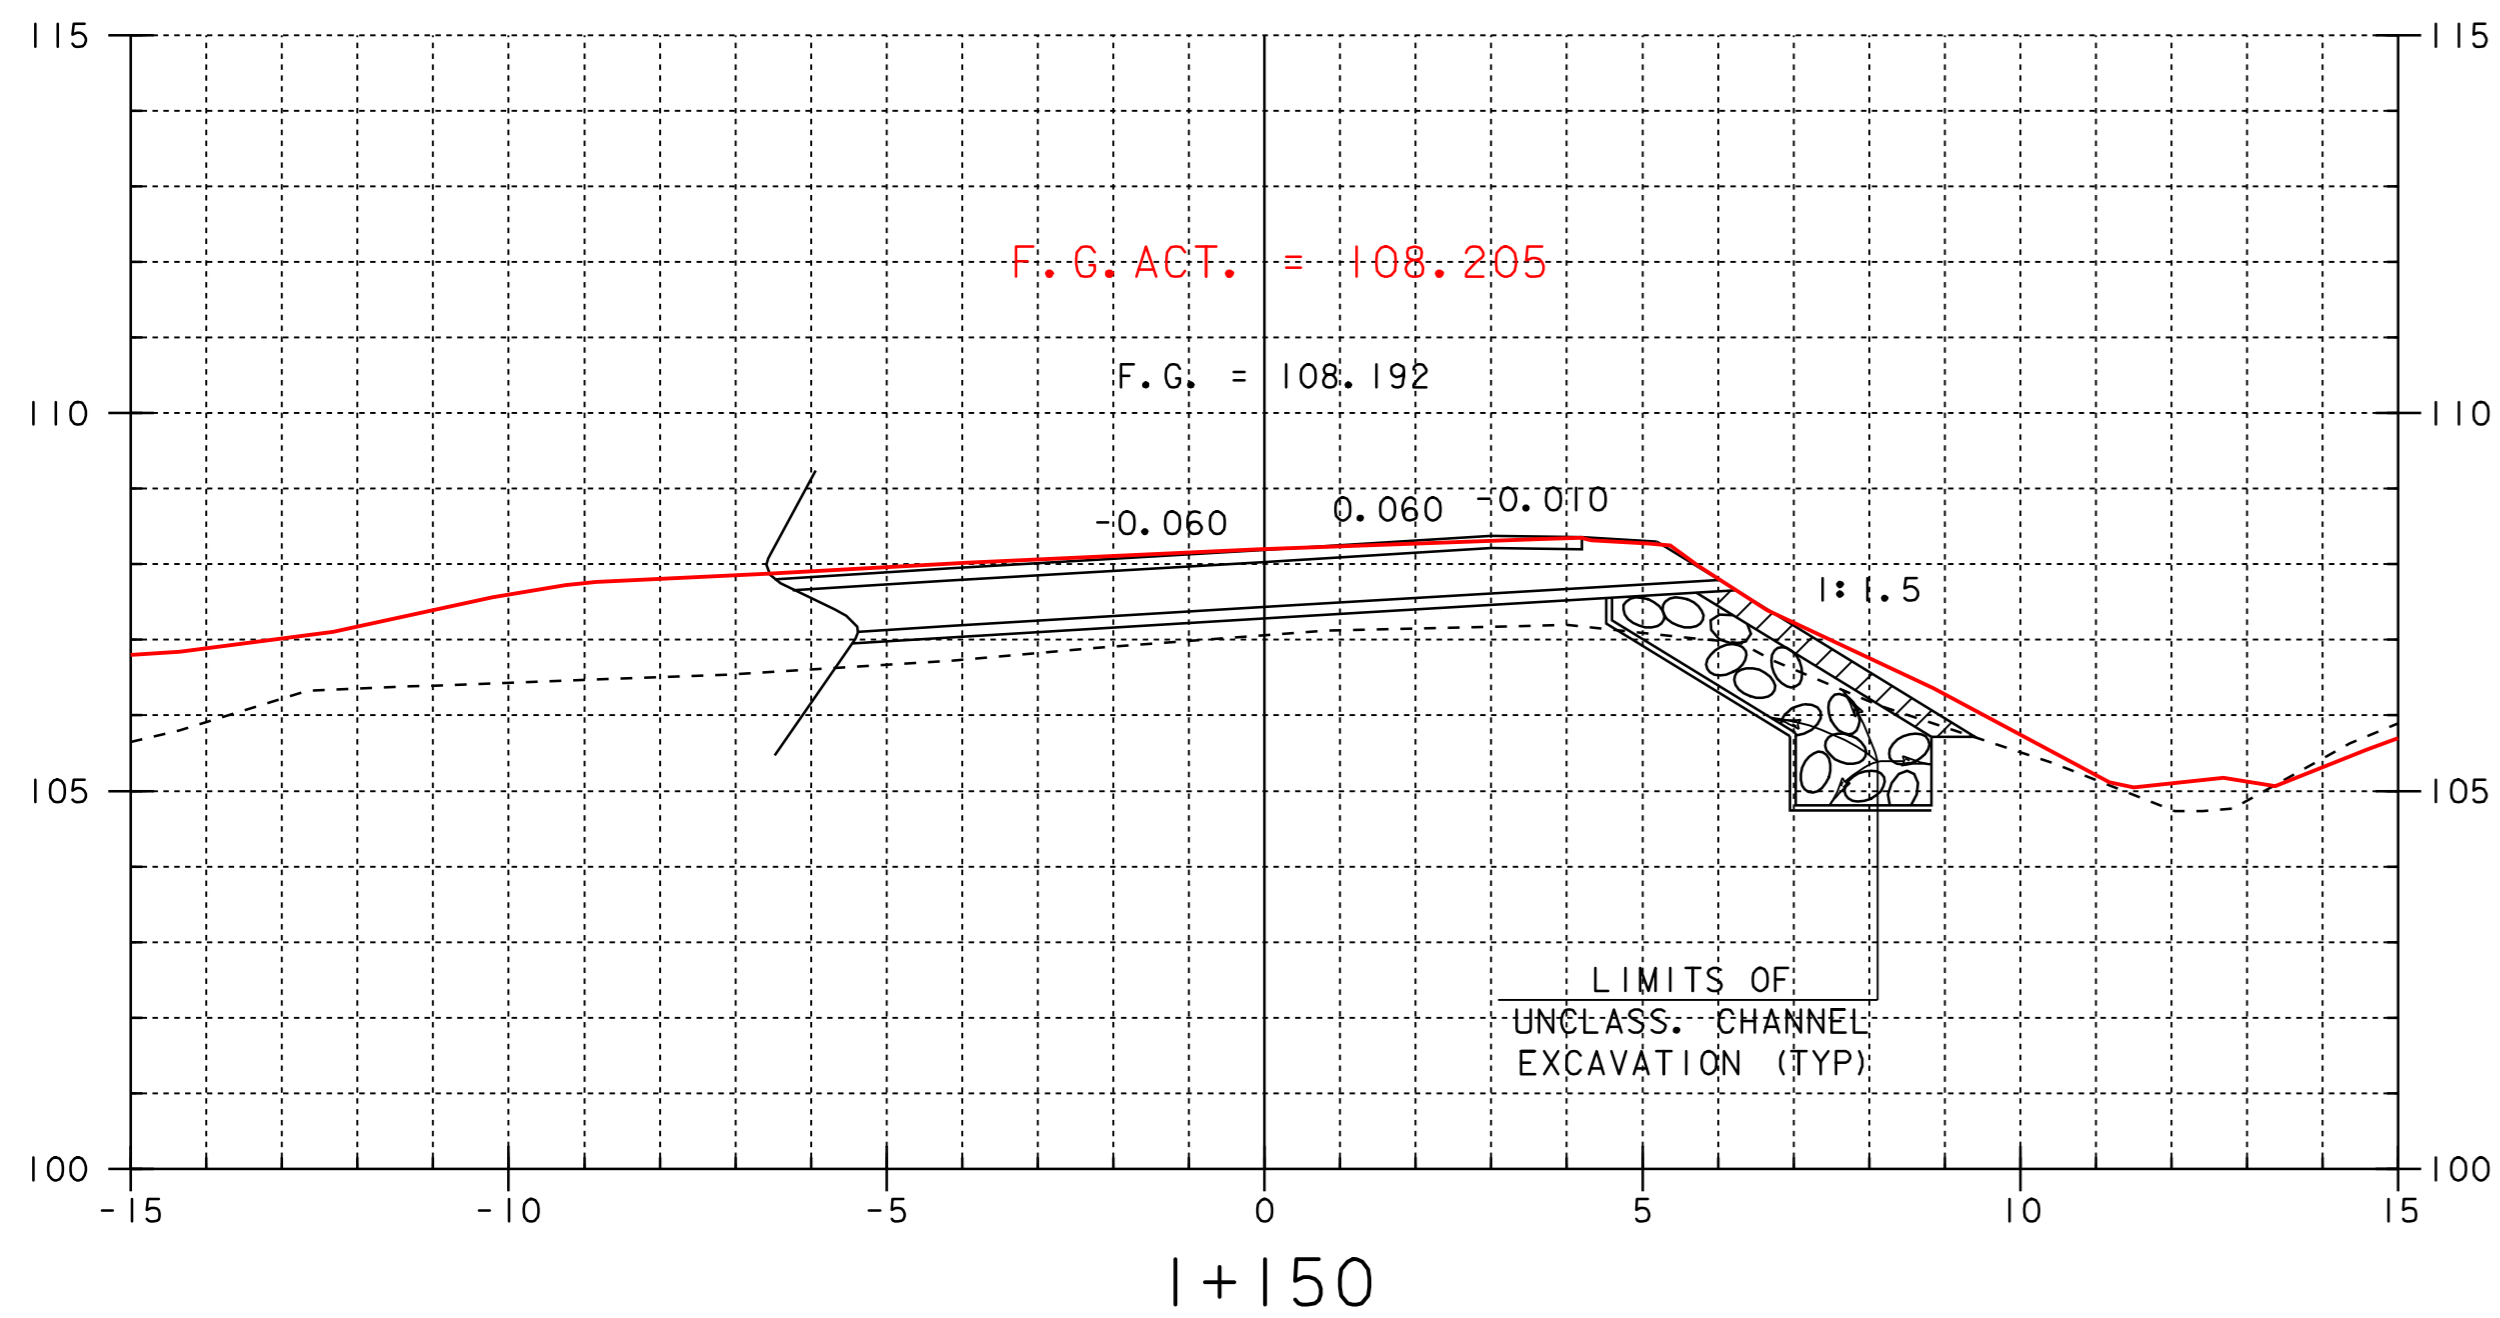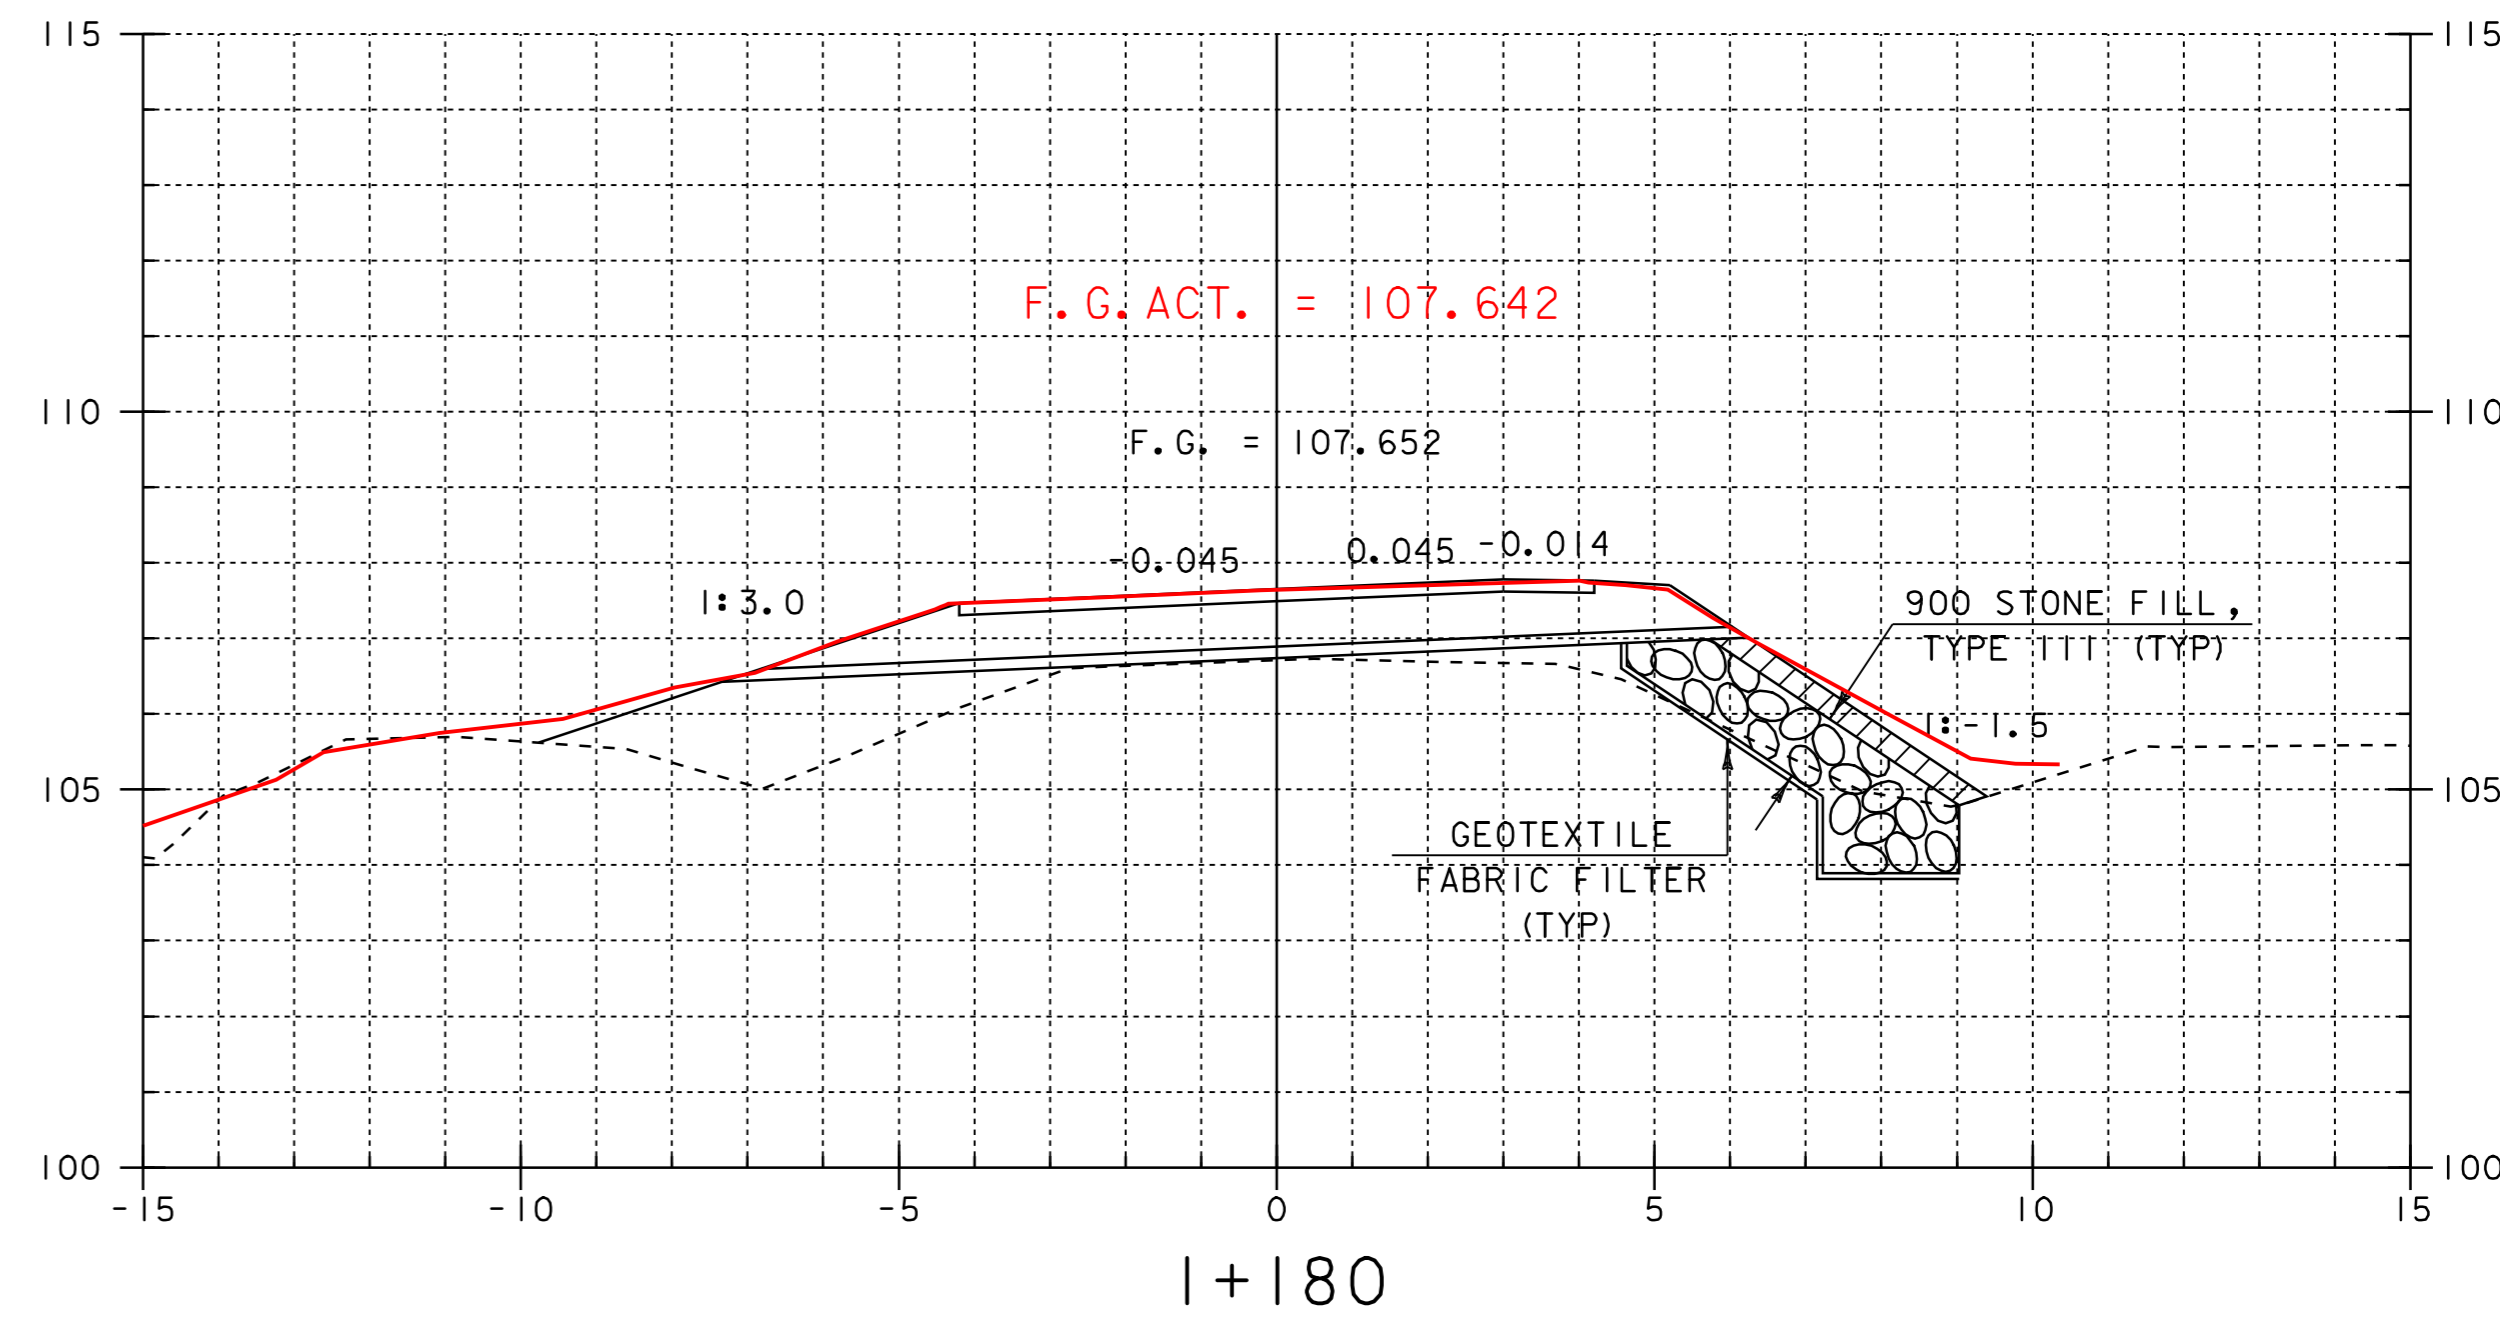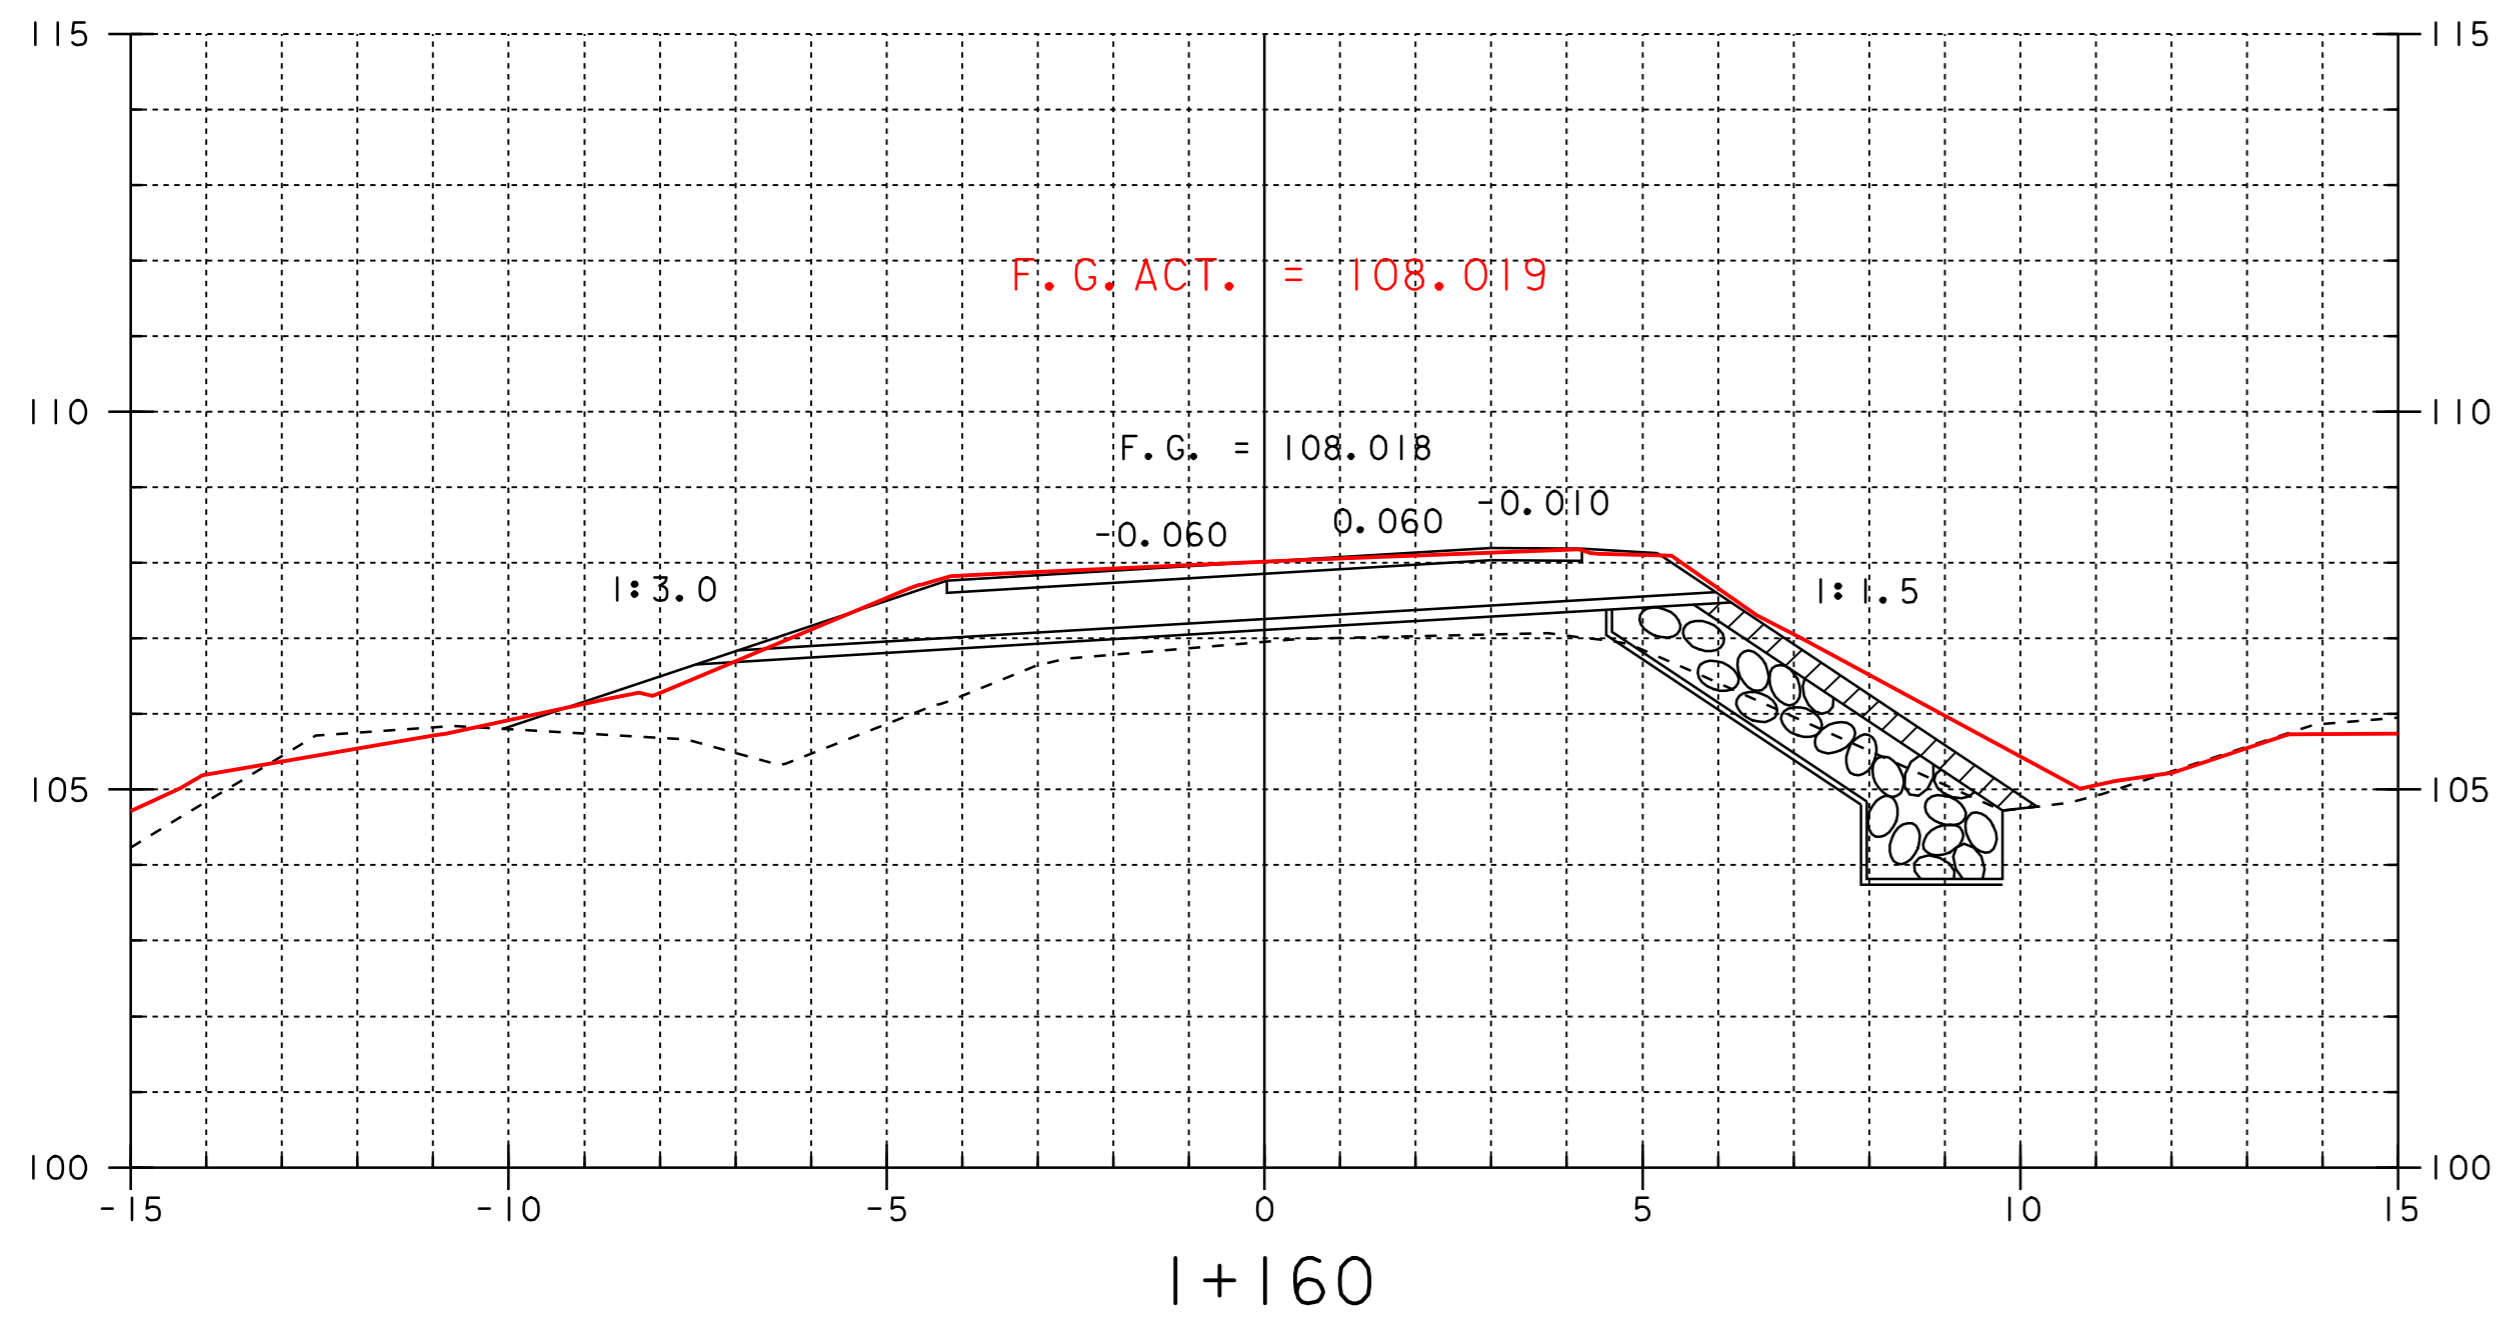

SHEET NAME:	<u>MAINLINE CROSS SECTIONS</u>	
PROJECT NAME:	<u>LEICESTER</u>	HIGHWAY NO.: <u>EAS_0160</u>
PROJECT NUMBER:	<u>BRE_0160(3)S</u>	BRIDGE NO.: <u>6</u>
		OVER: <u>QUIER CREEK</u>
FILE NAME:	<u>95J288\Structures\sj288xsl.dgn</u>	PLOT DATE: <u>02-OCT-2008 11:00</u>
PROJECT MANAGER:	<u>B.B. WHITCOMB</u>	DRAWN BY: <u>J. GILMORE</u>
DESIGNED BY:	<u>C. CARLSON</u>	IPARM NAME: <u>sj088dl0.1</u>
		SHEET <u>17</u> OF <u>90</u>

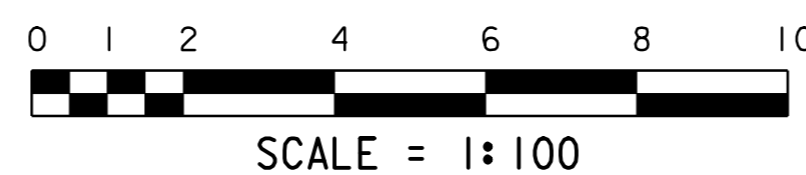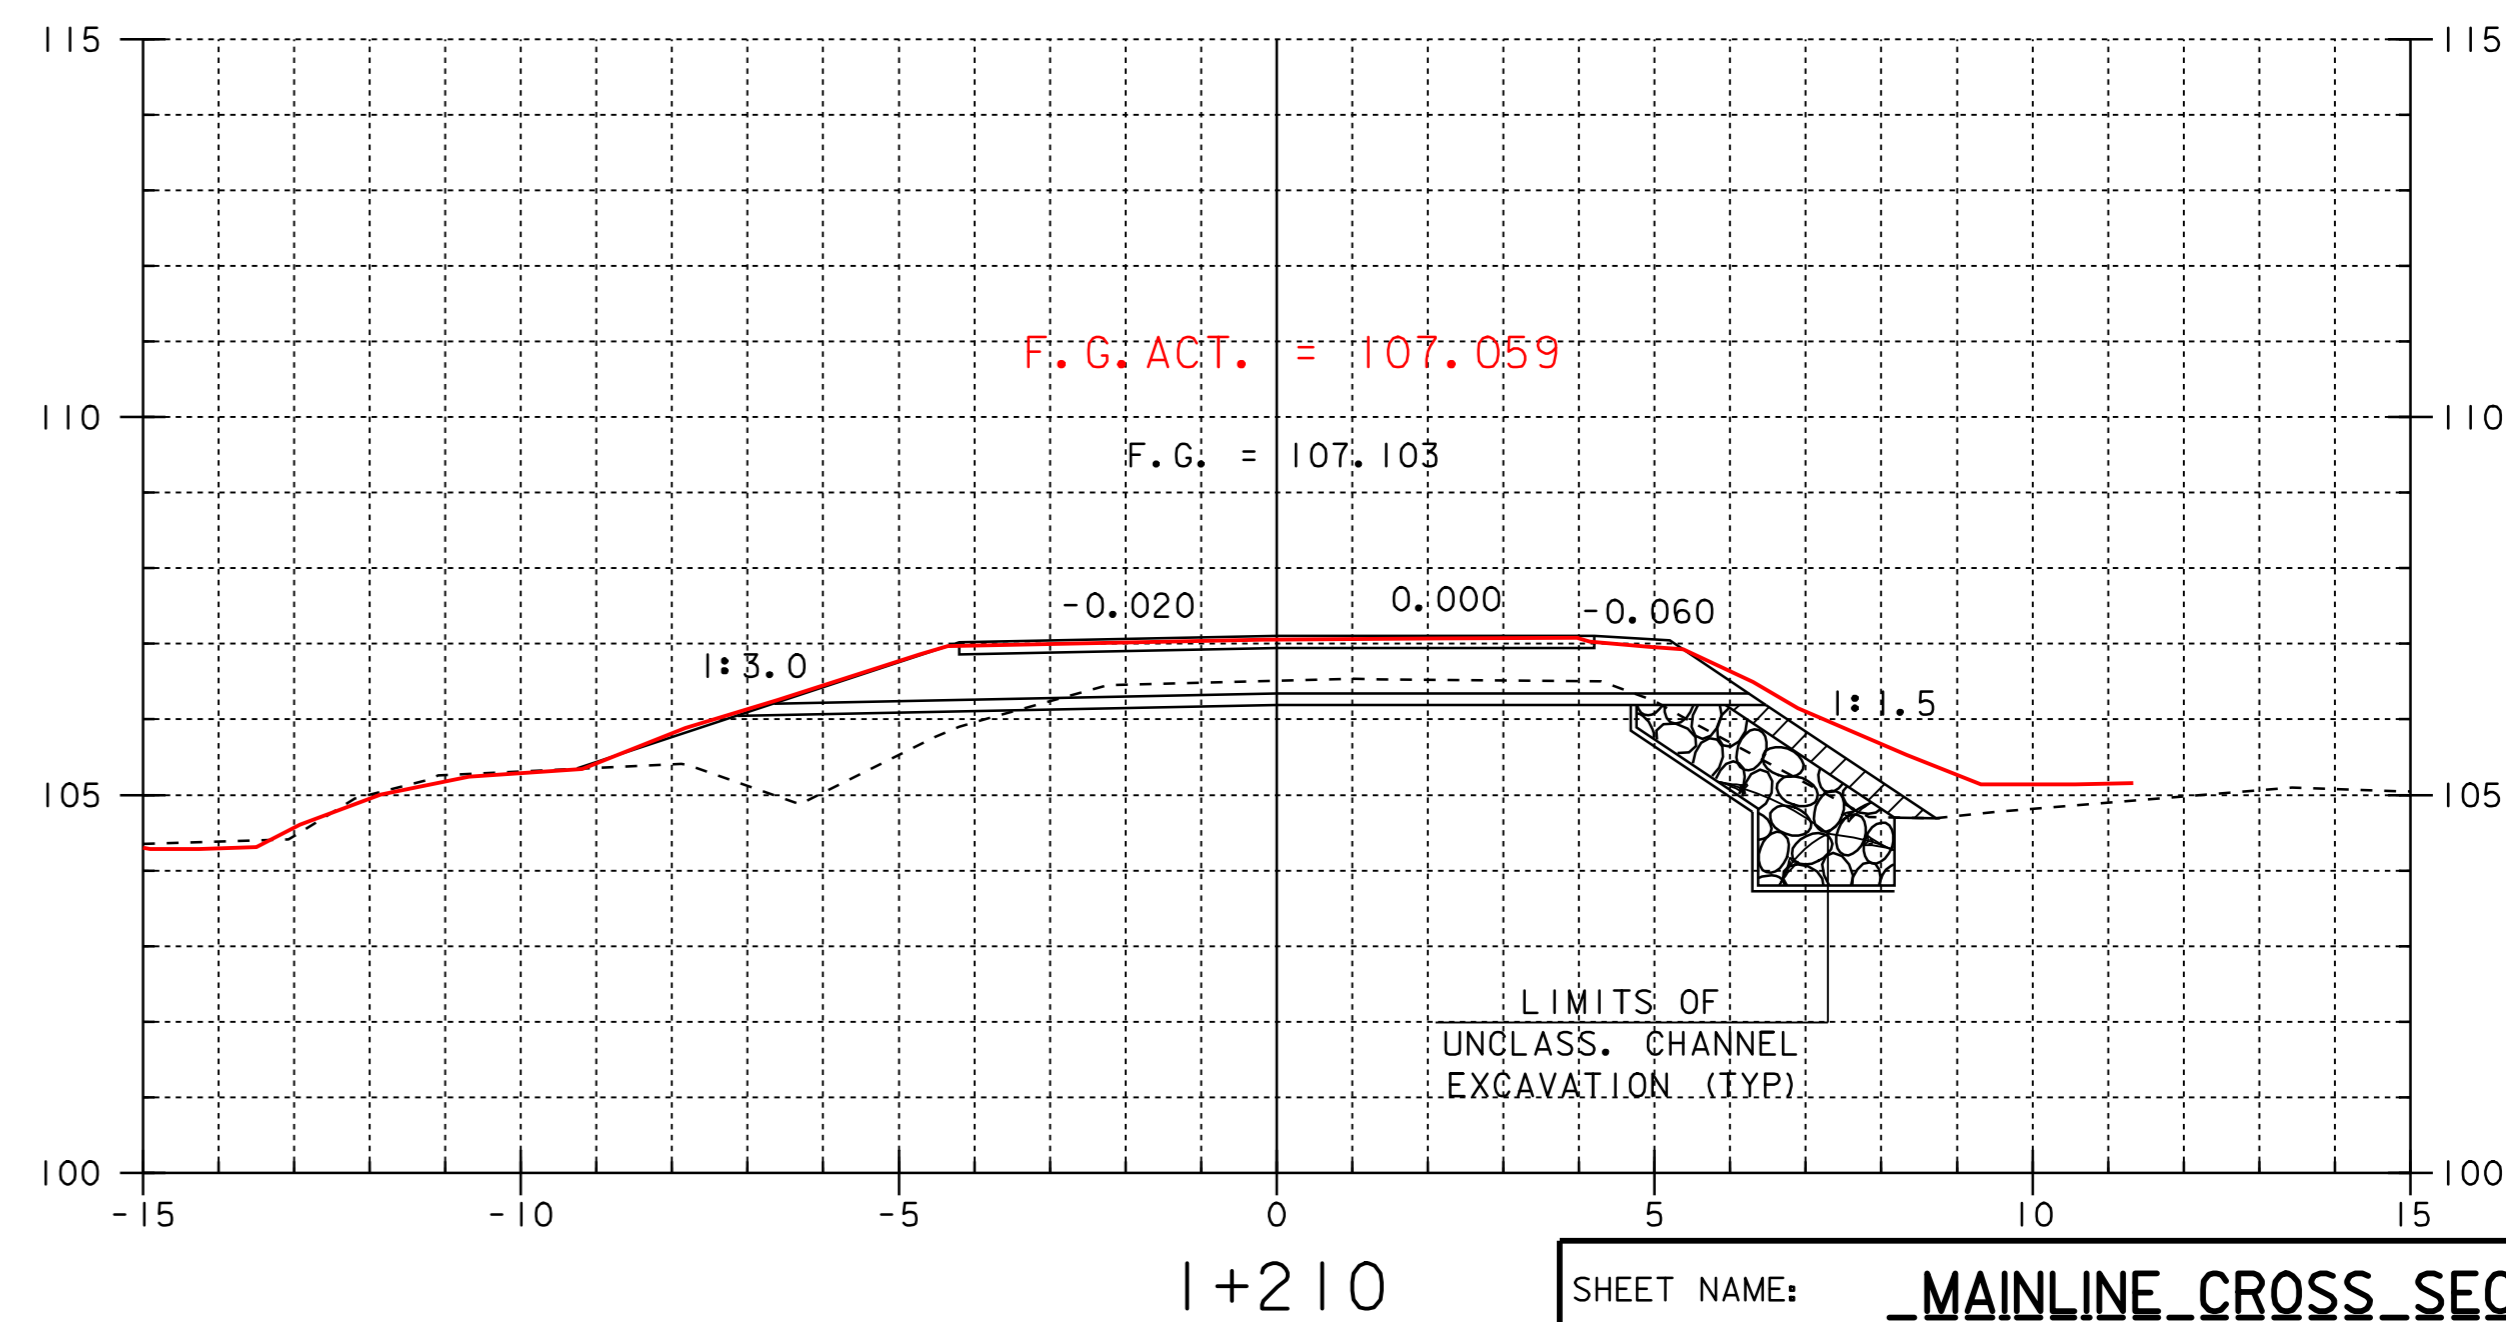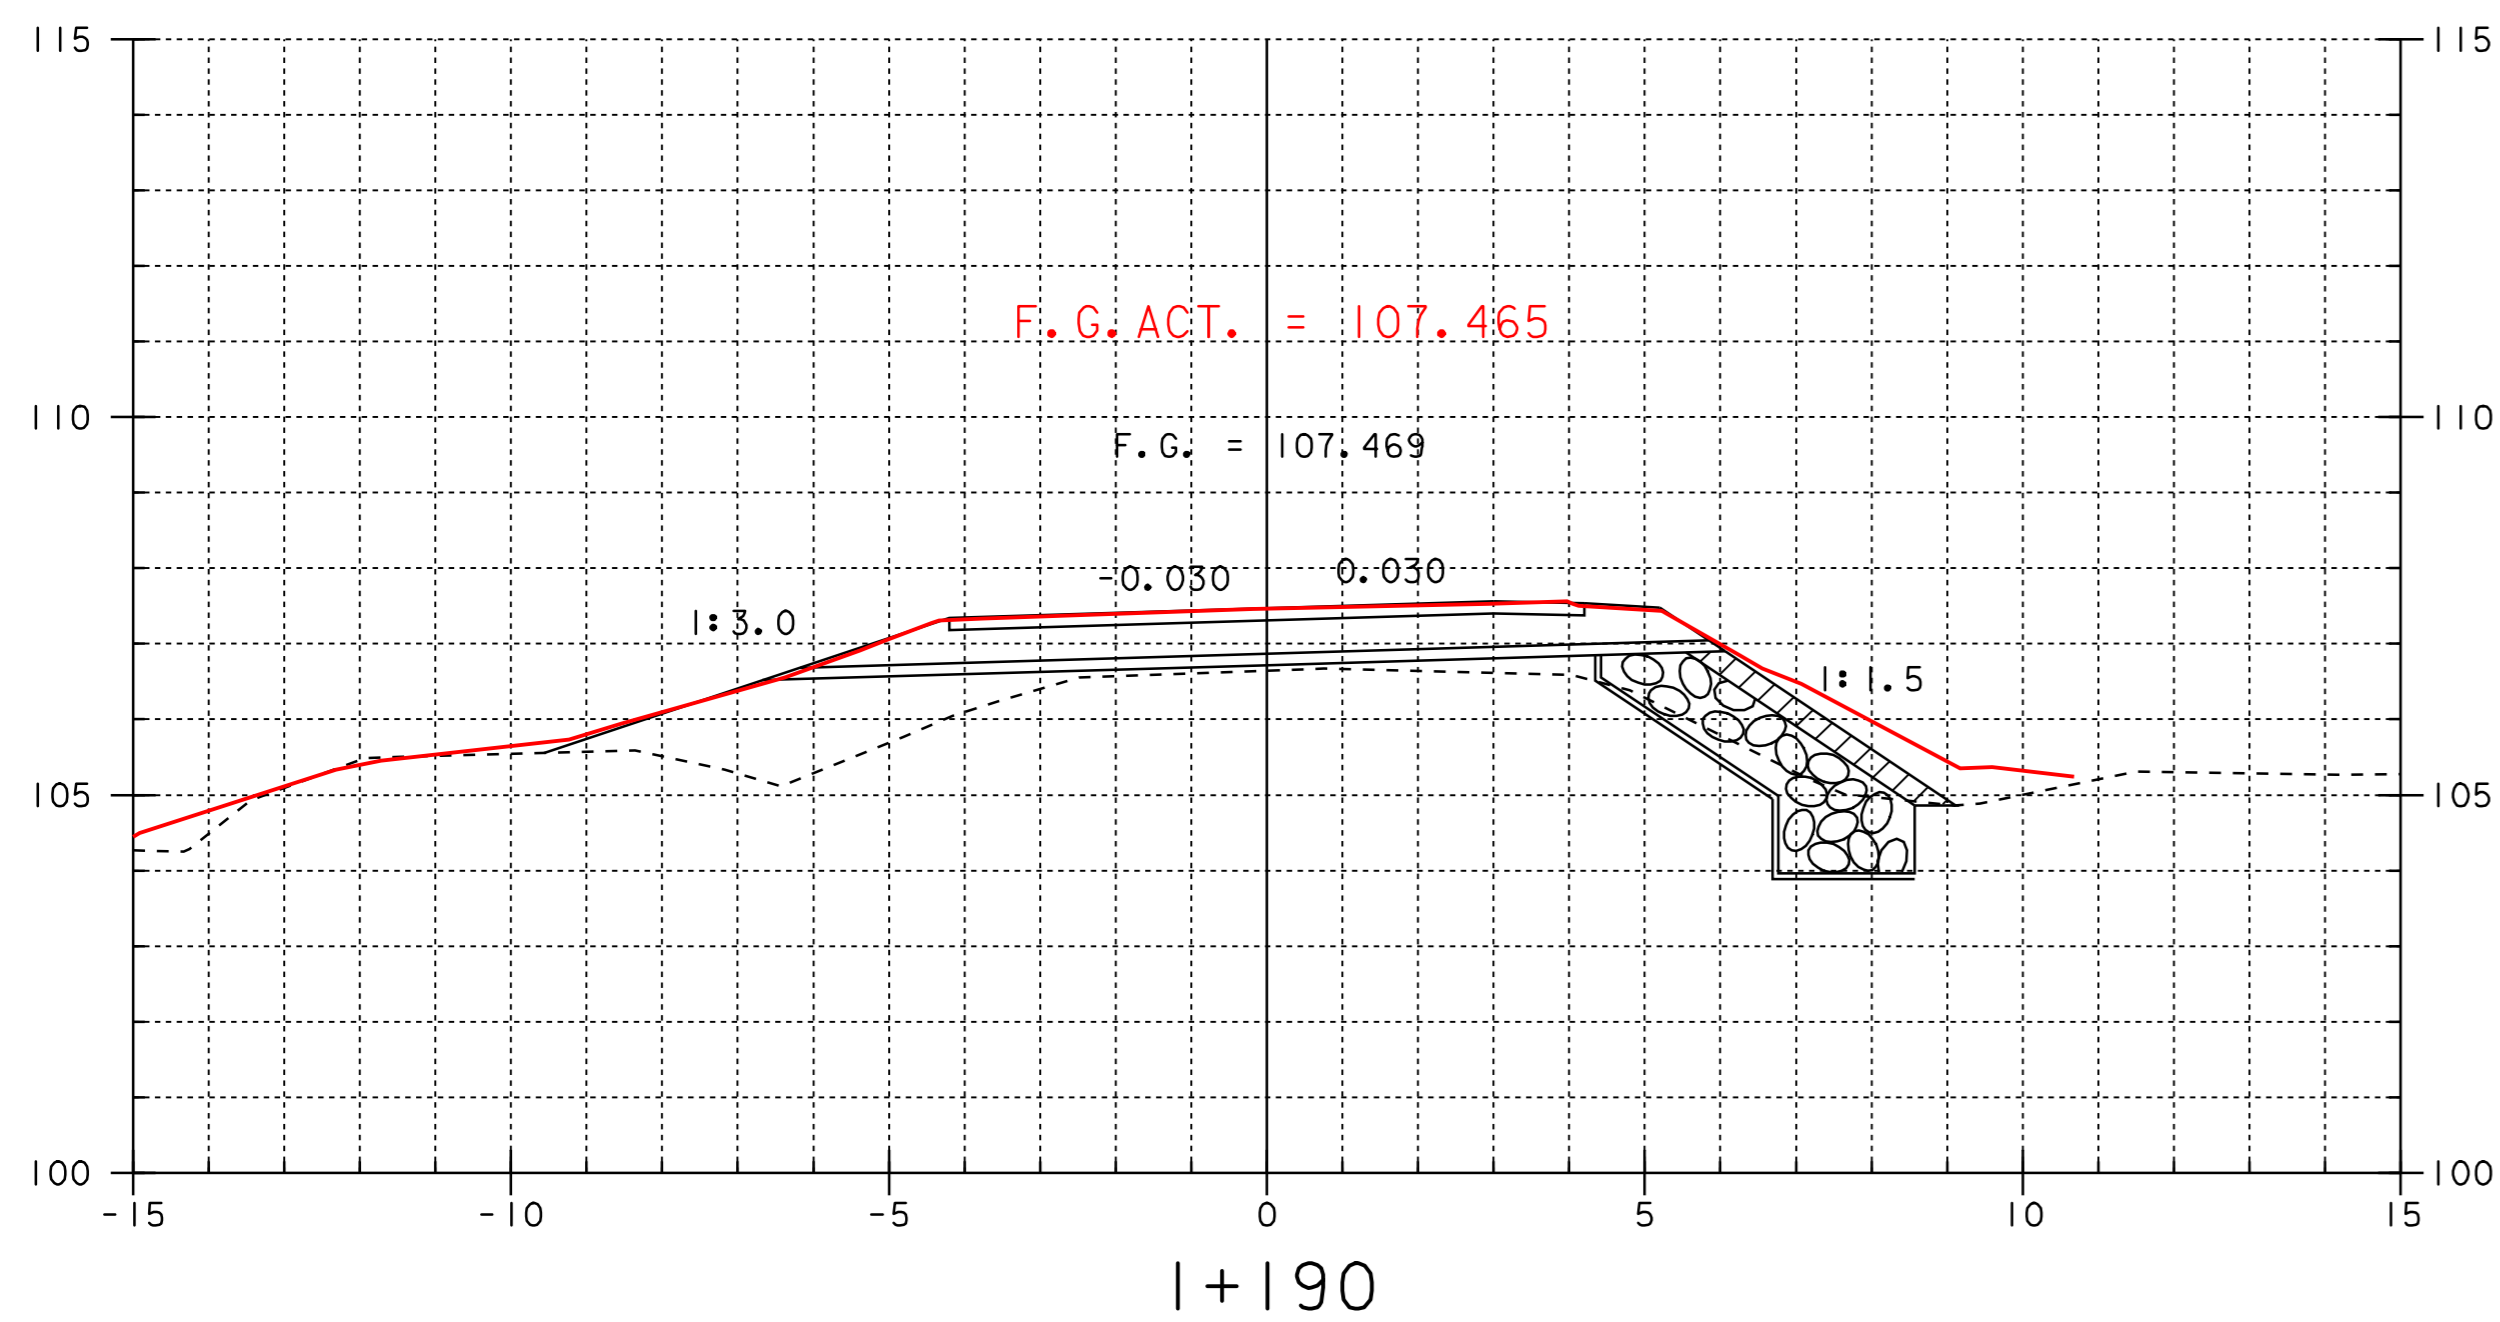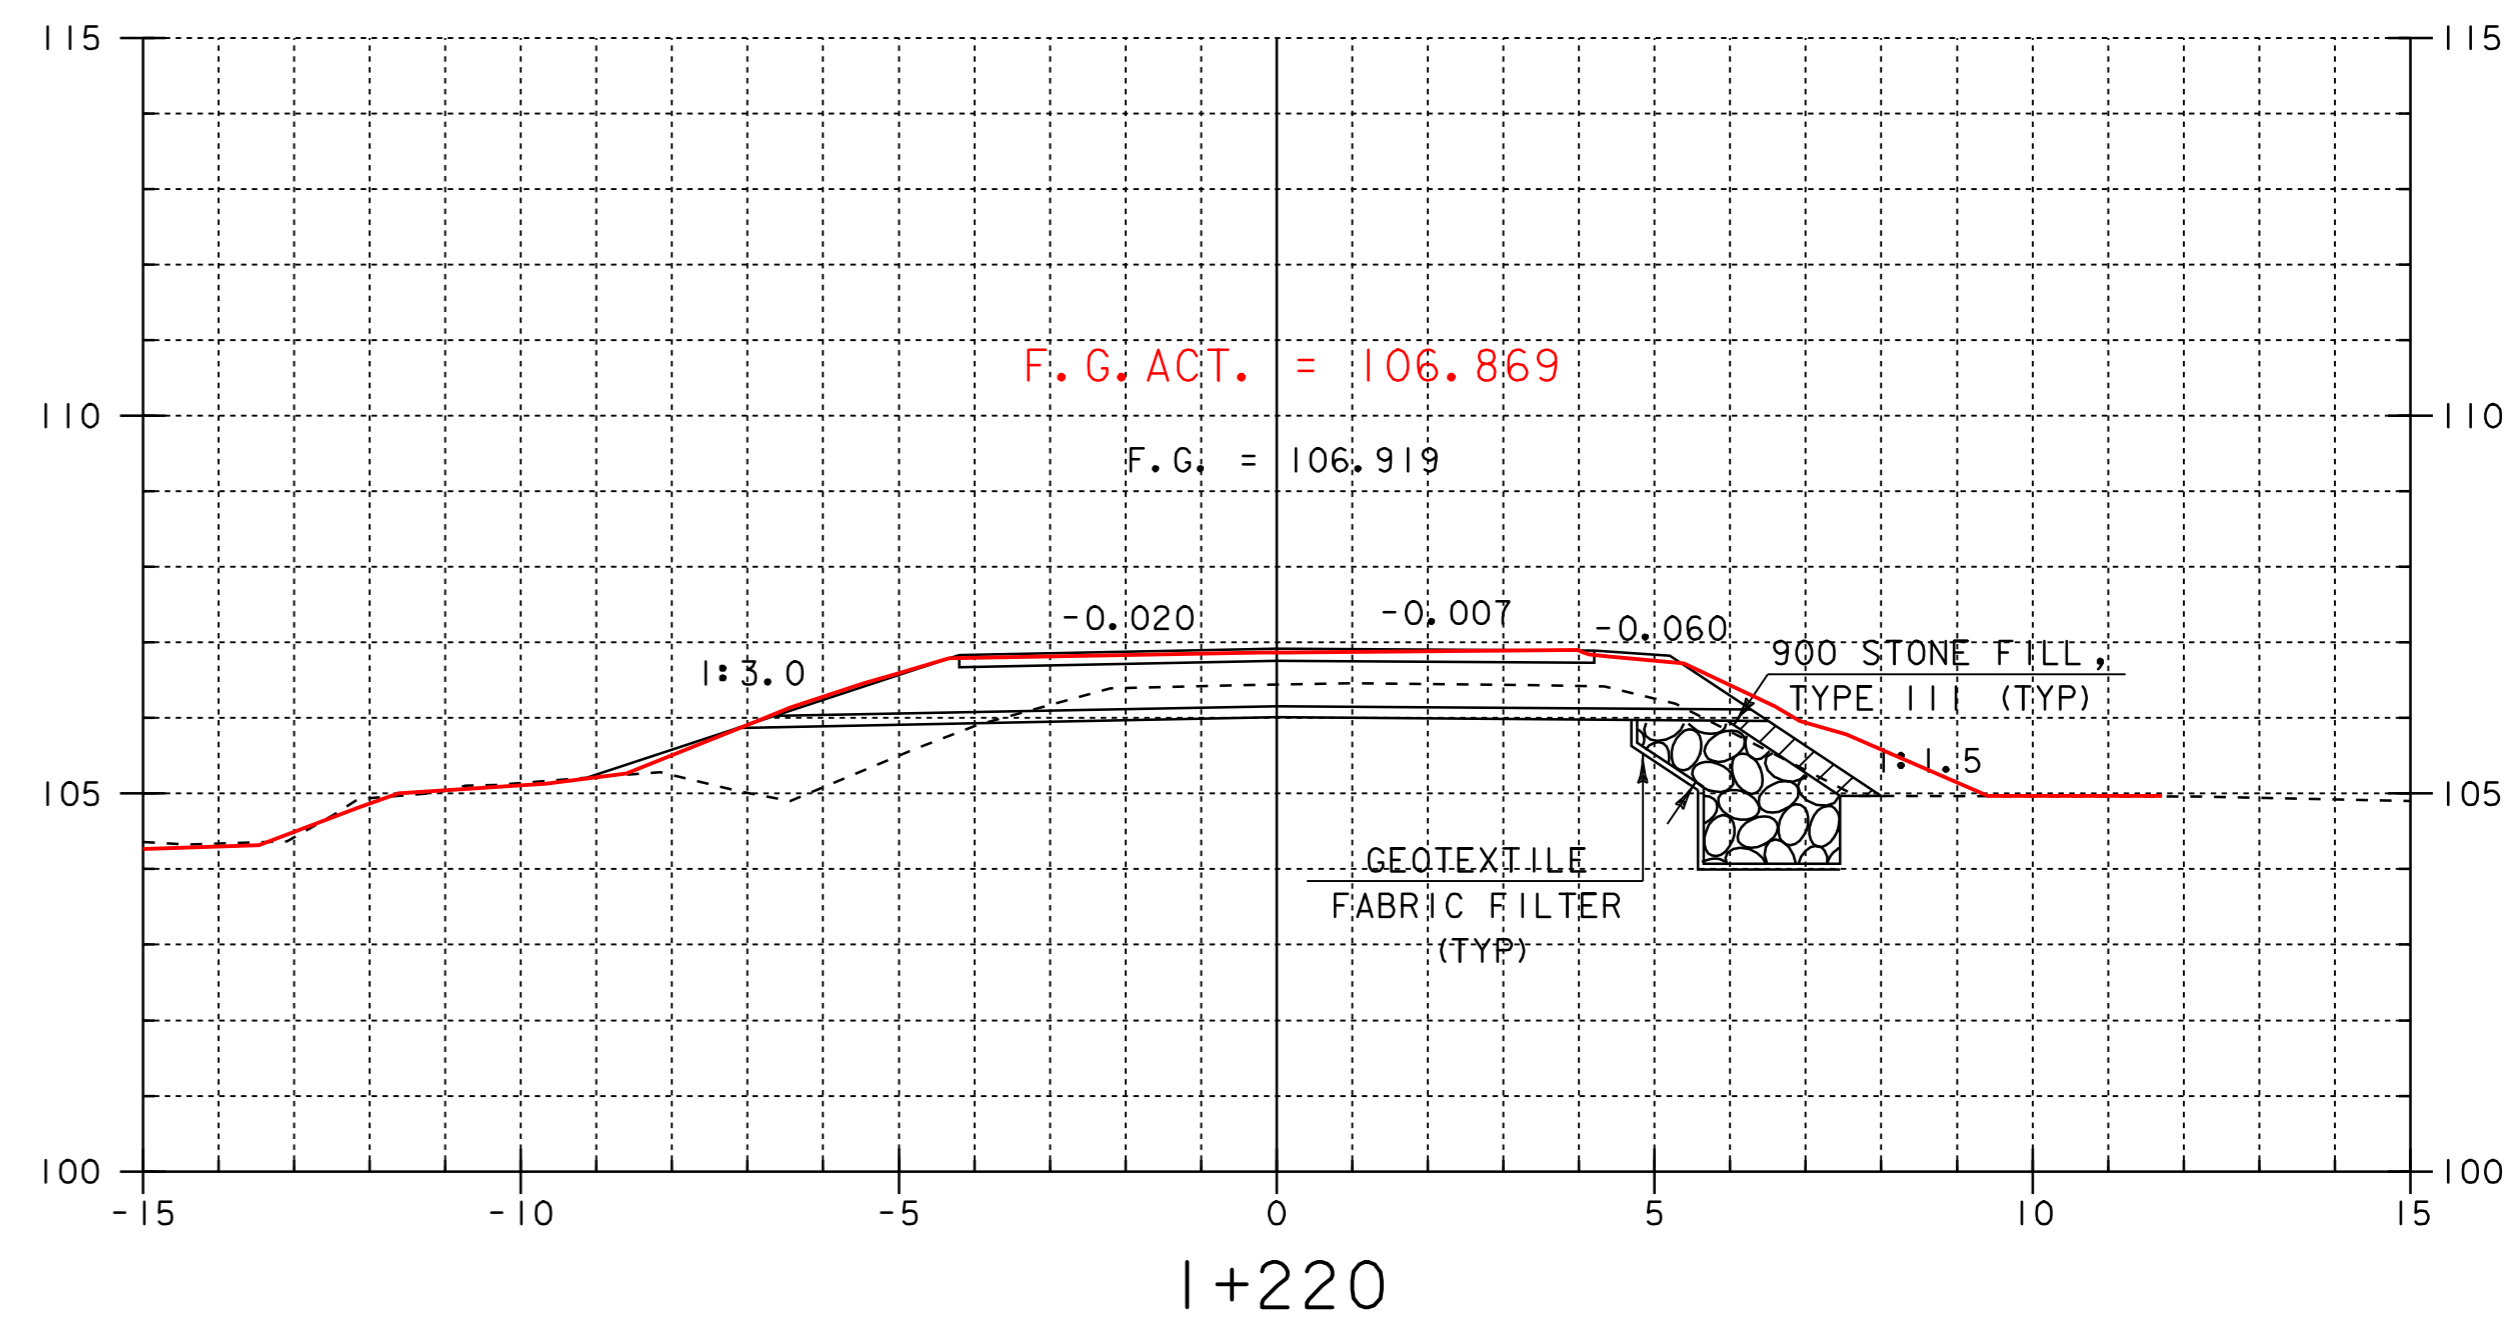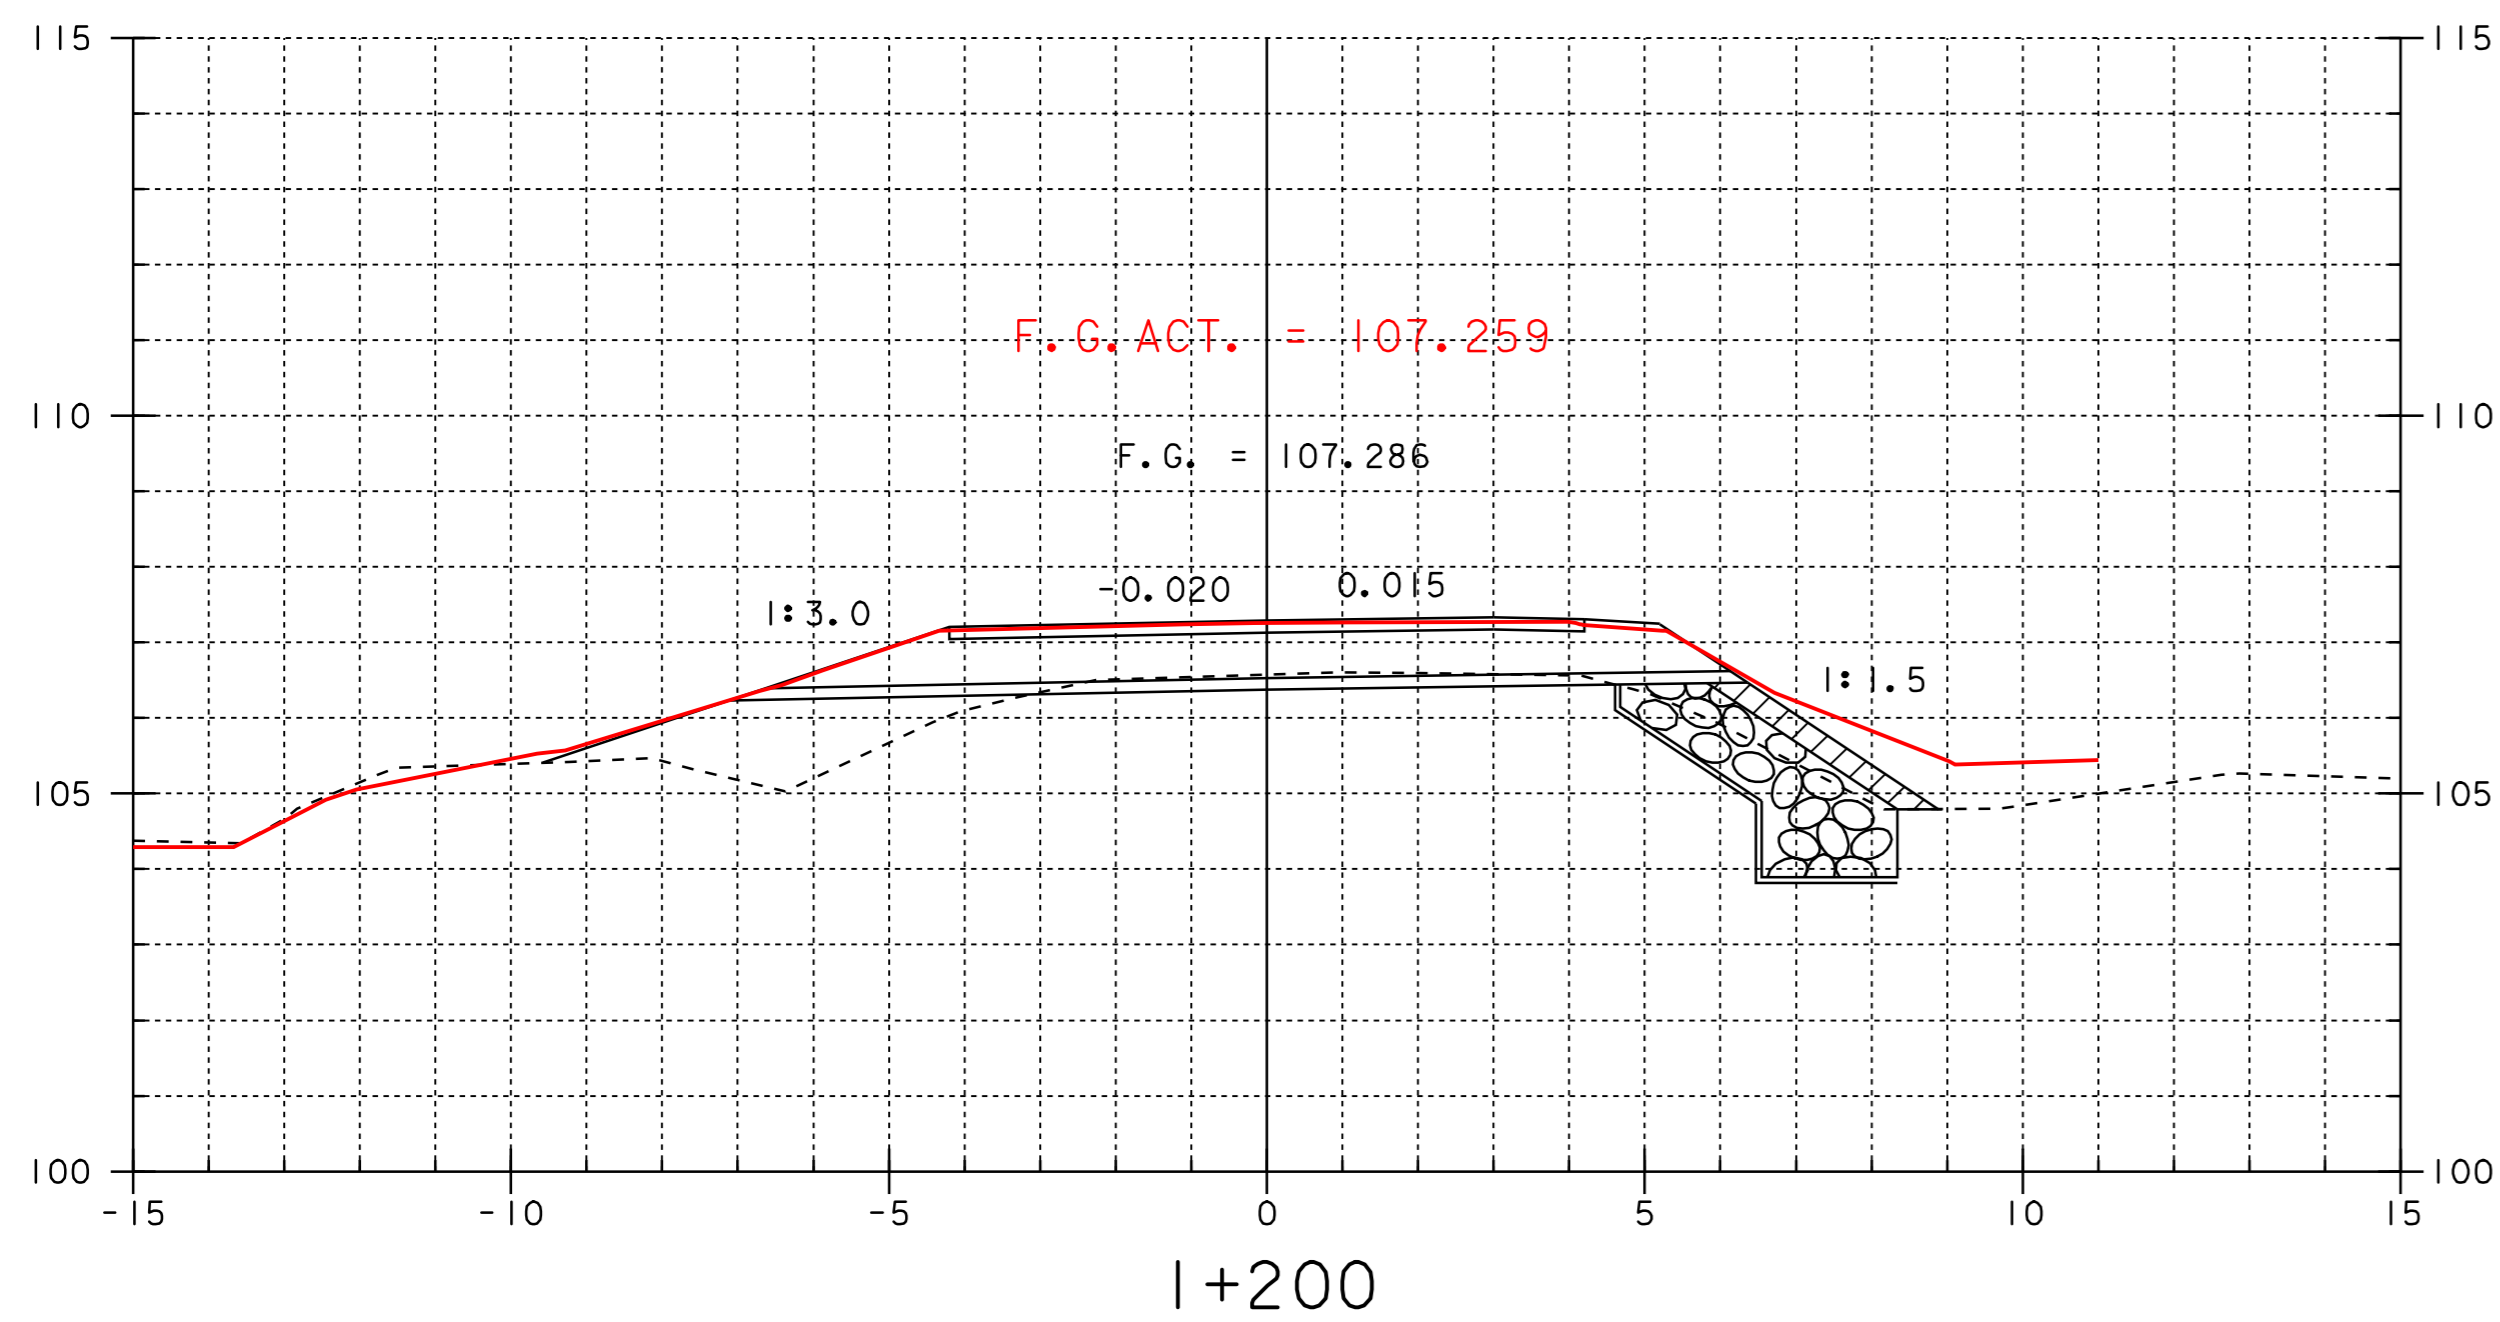


SHEET NAME: MAINLINE CROSS SECTIONS	
PROJECT NAME: LEICESTER	HIGHWAY NO.: EAS_0160
PROJECT NUMBER: BRE_0160(3)S	BRIDGE NO.: 6
	OVER: QUIER CREEK
FILE NAME: 95J288\Structures\sj288xsl.dgn	PLOT DATE: 02-OCT-2008 11:00
PROJECT MANAGER: B.B. WHITCOMB	DRAWN BY: J. GILMORE
DESIGNED BY: C. CARLSON	IPARM NAME: sj088dl.i
	SHEET 78 OF 90

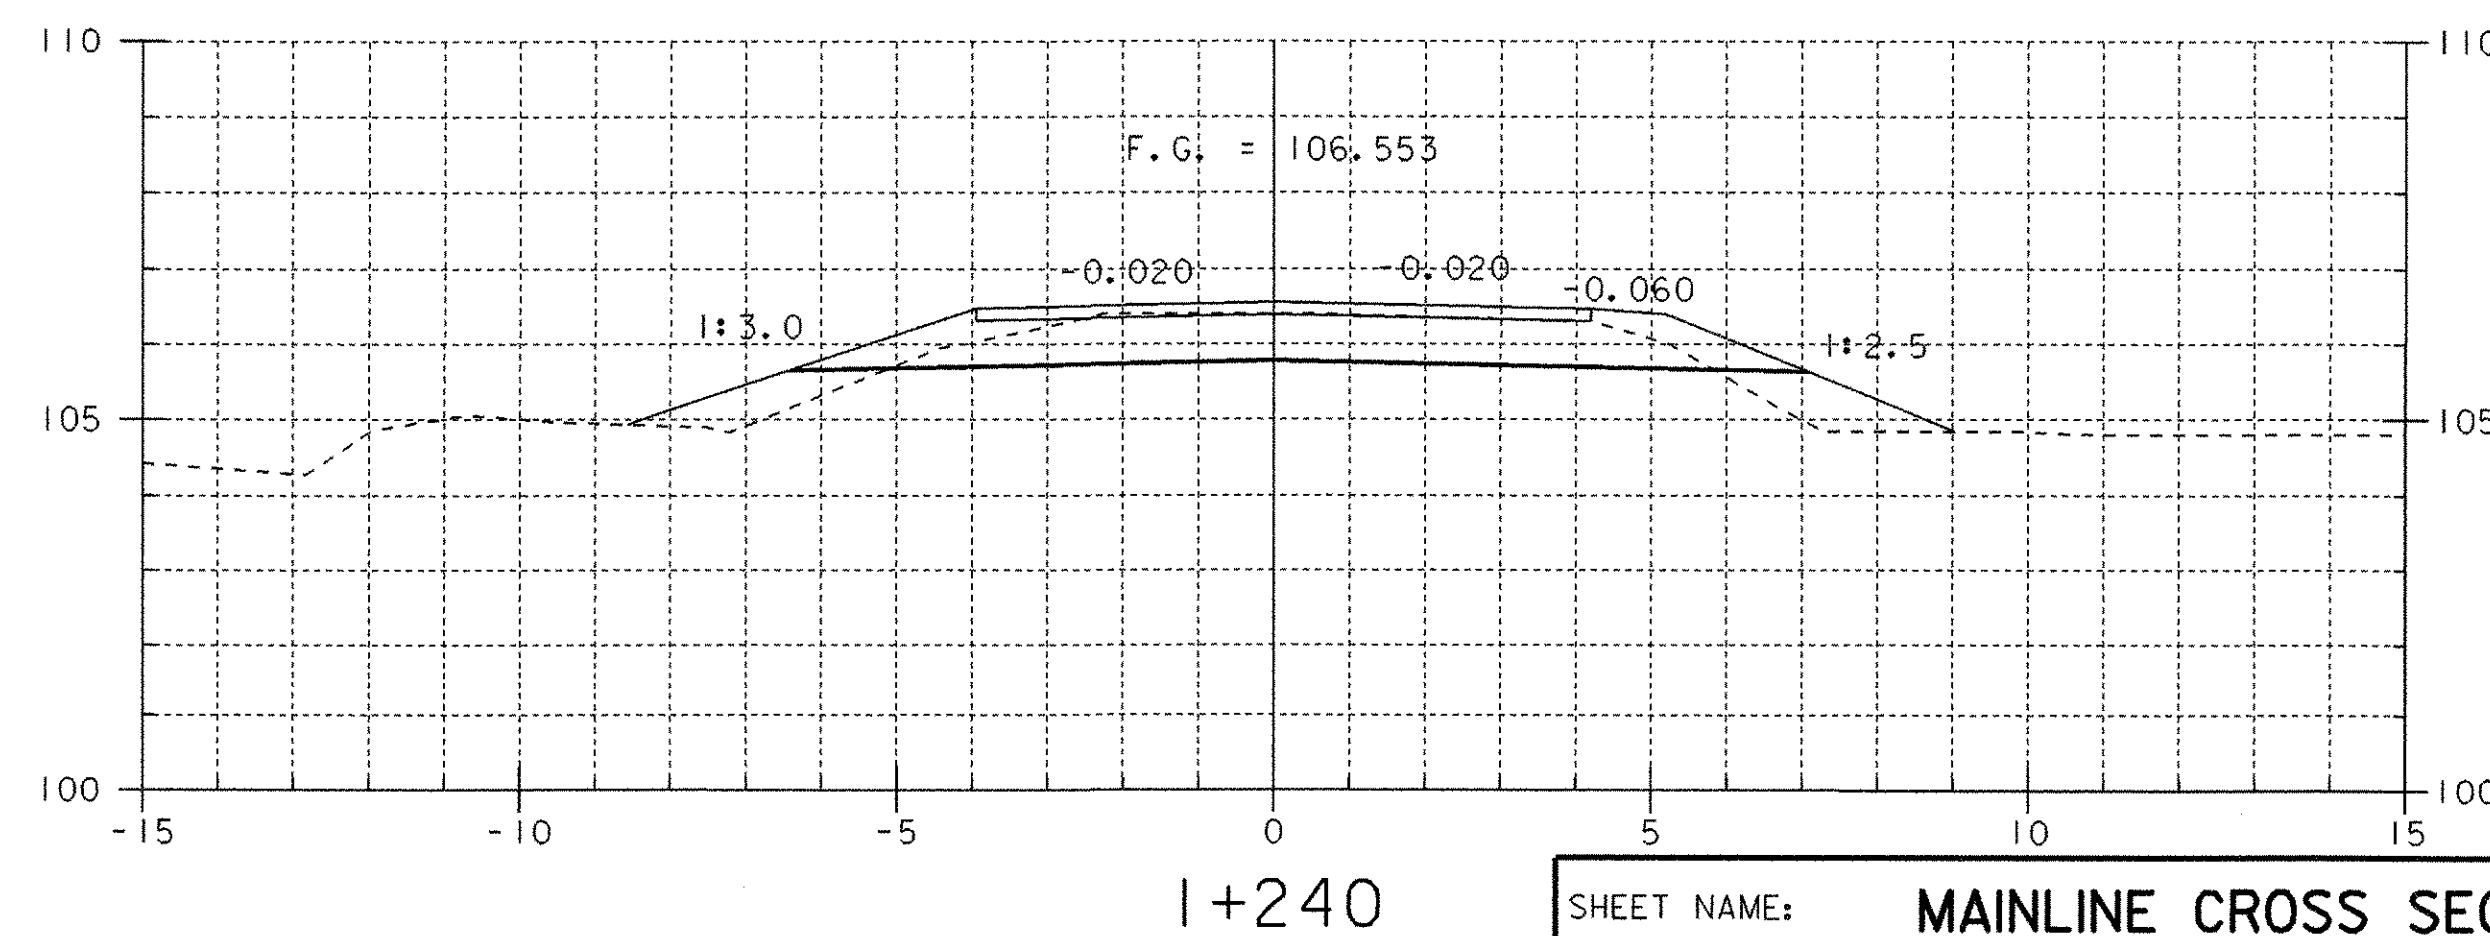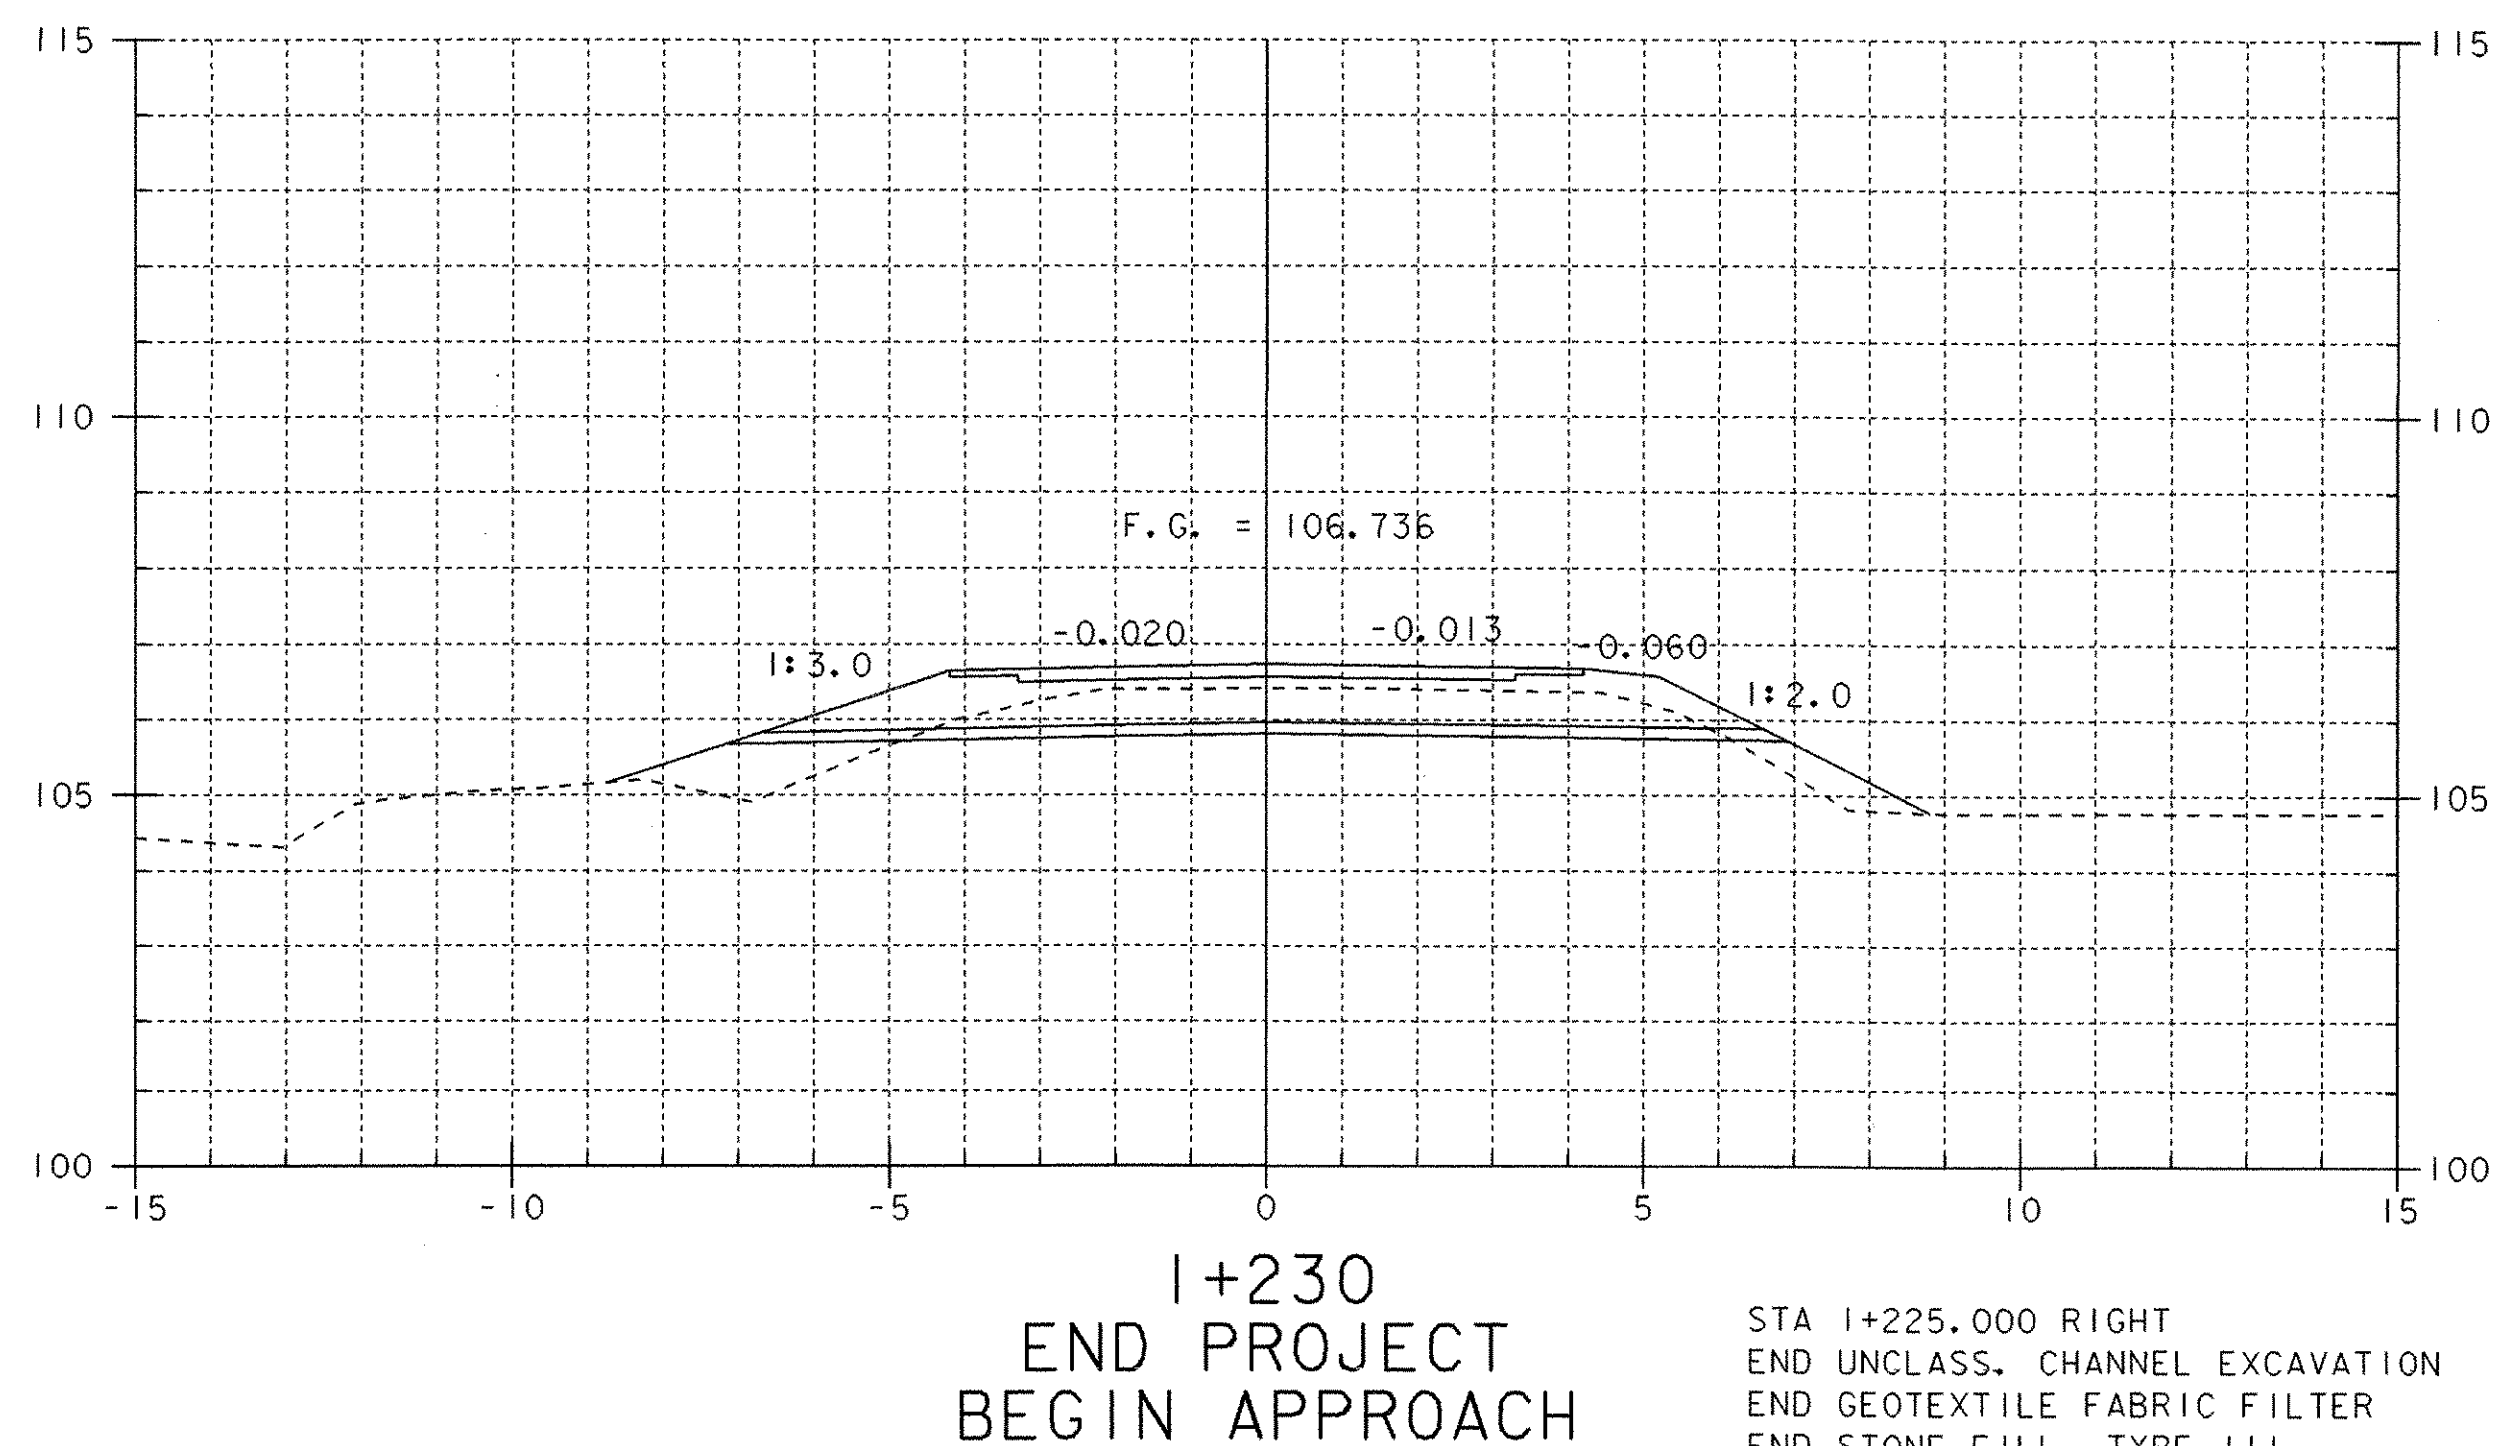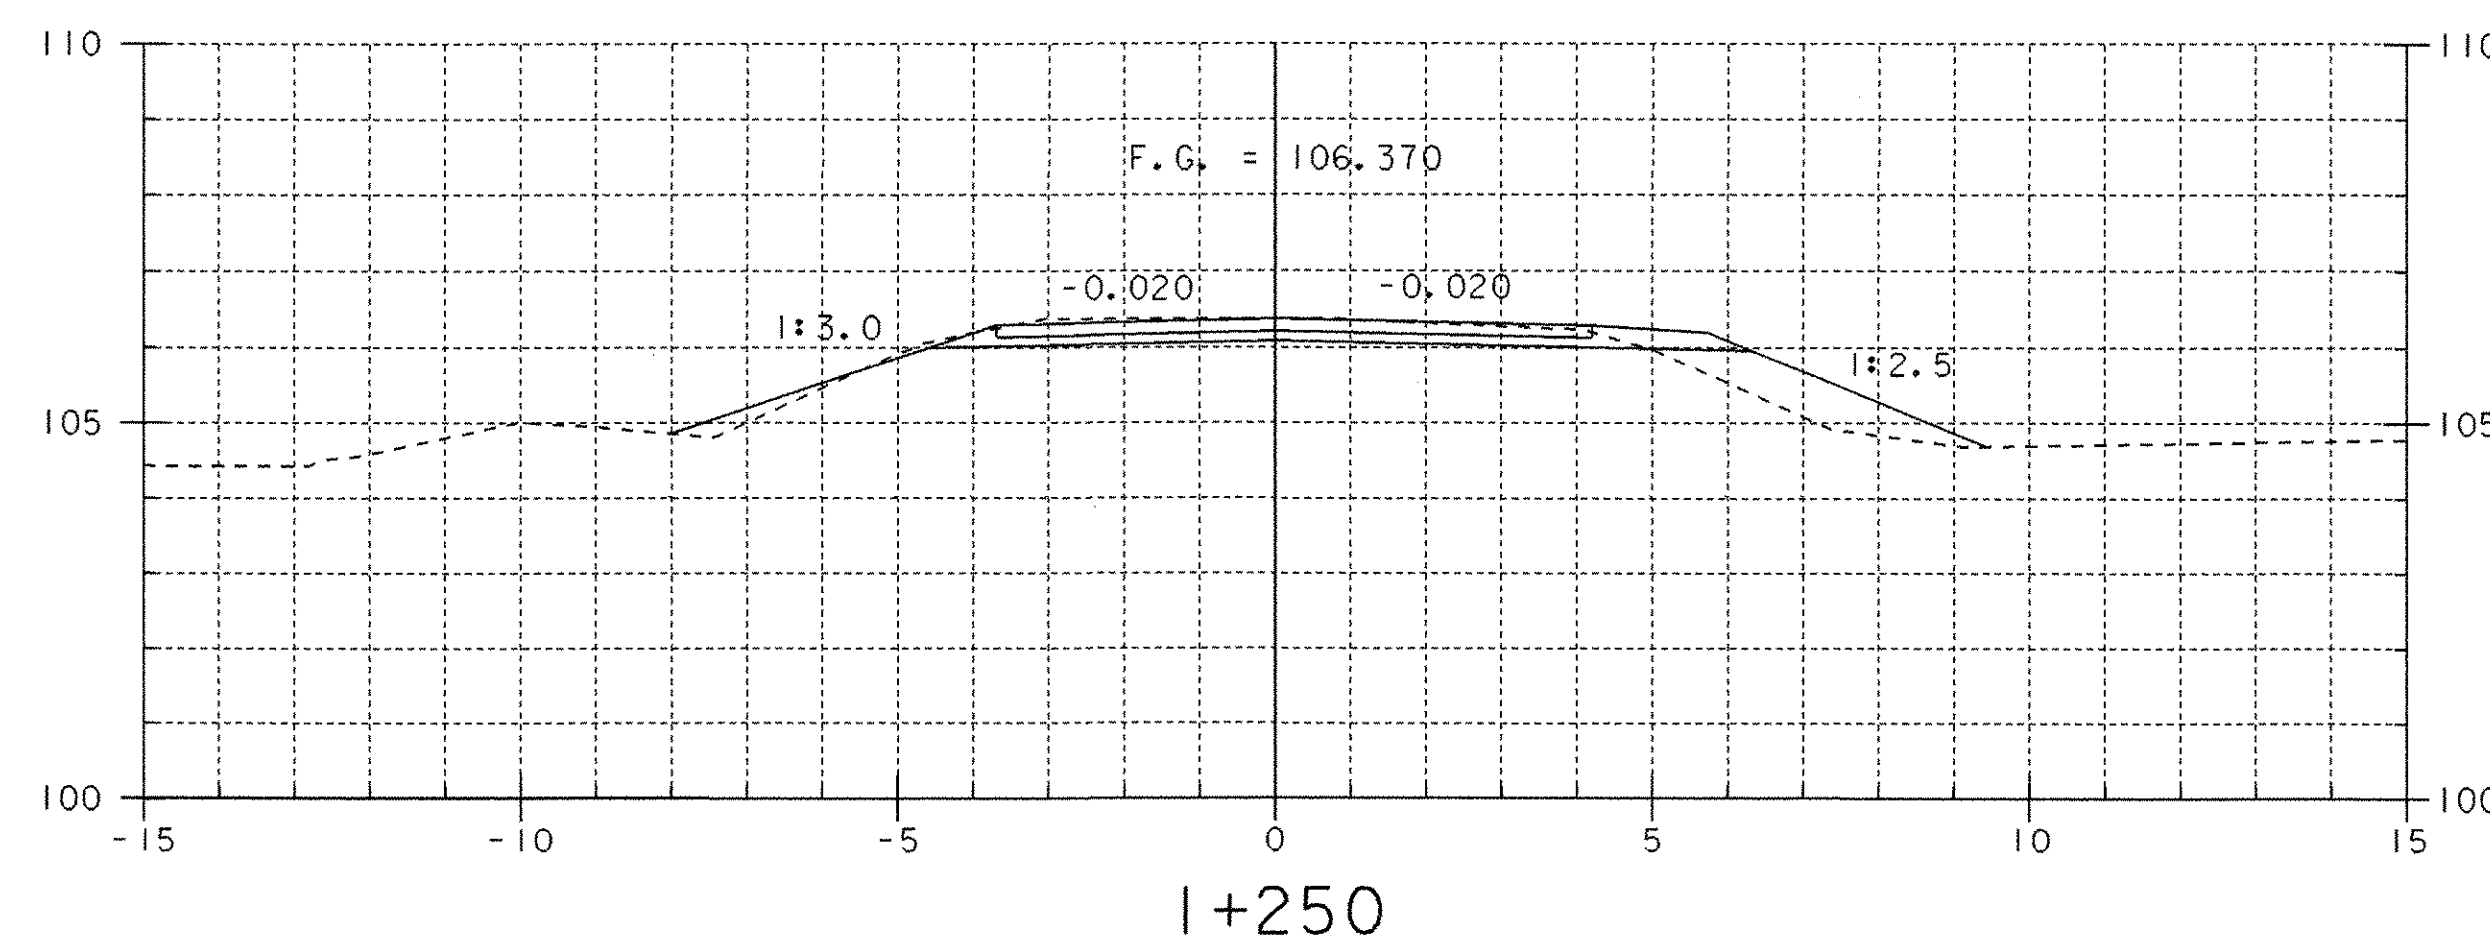
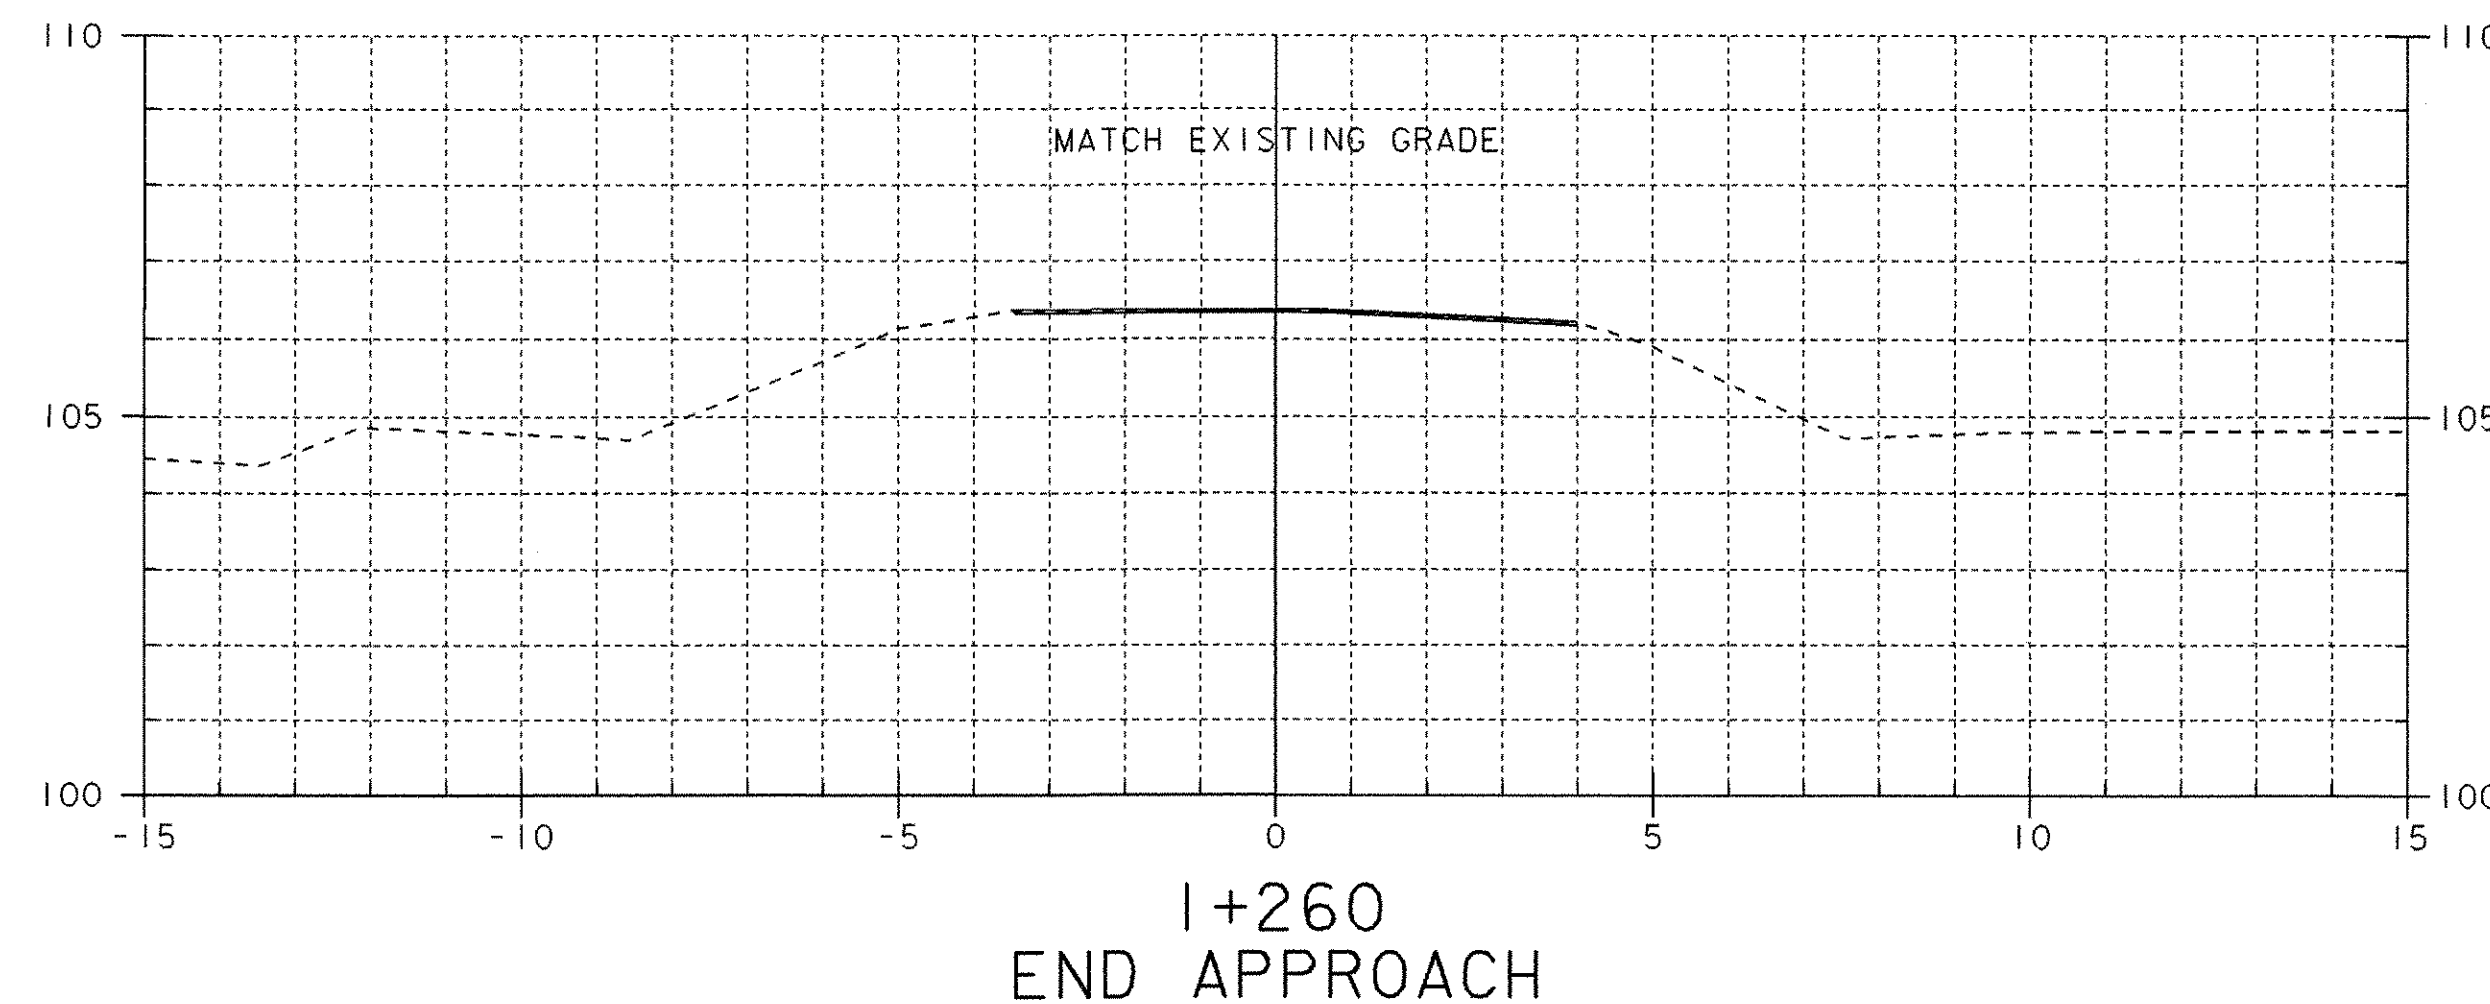
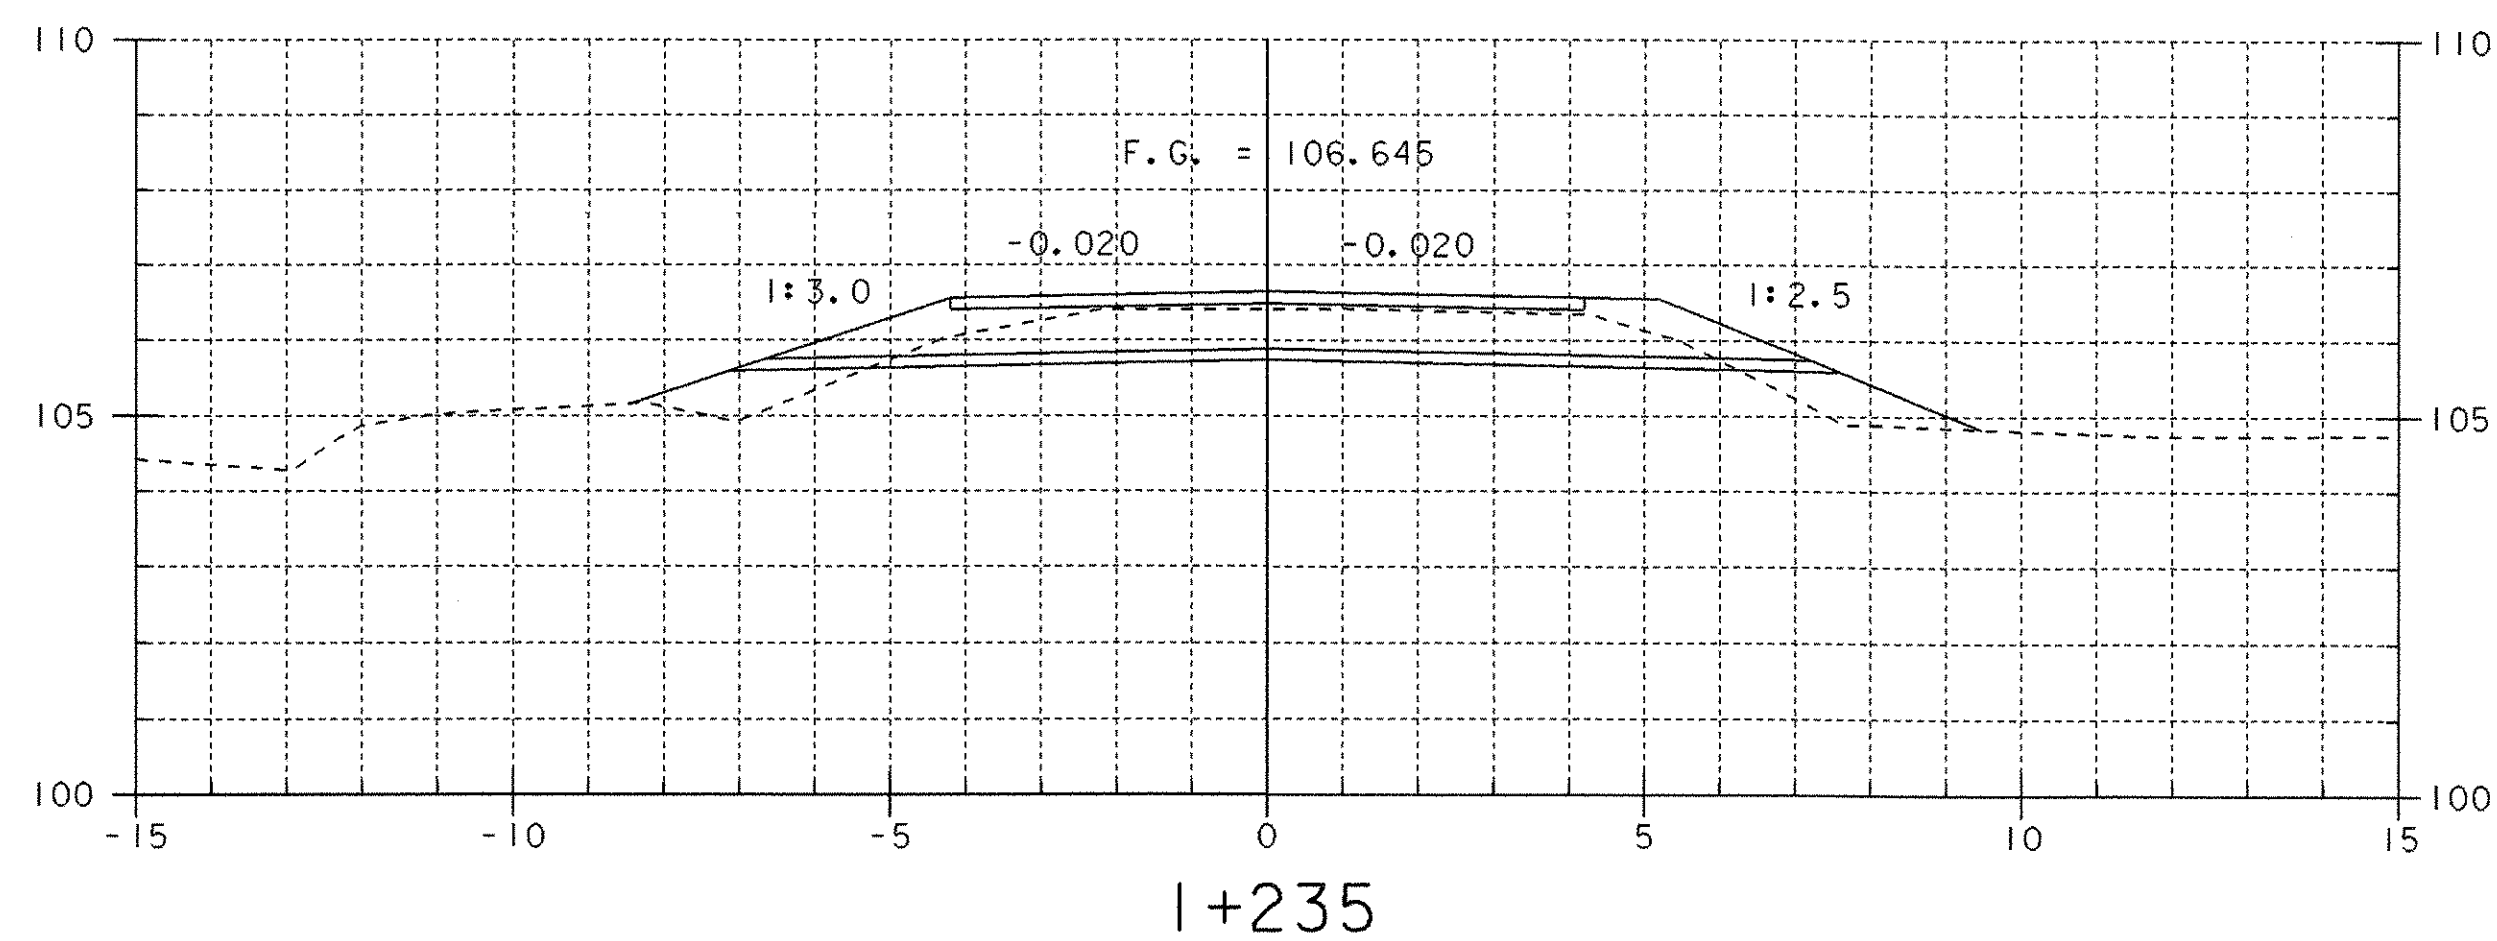


I+230
END PROJECT
BEGIN APPROACH


STA I+225.000 RIGHT
END UNCLASS. CHANNEL EXCAVATION
END GEOTEXTILE FABRIC FILTER
END STONE FILL, TYPE III
END GRUBBING MATERIAL

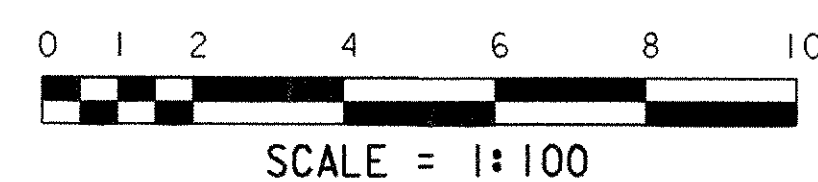




SHEET NAME: MAINLINE CROSS SECTIONS	
PROJECT NAME: LEICESTER	HIGHWAY NO.: FAS 0160
PROJECT NUMBER: BRF 0160(3S)	BRIDGE NO.: 6
	OVER: OTTER CREEK
FILE NAME: 95j288\Structures\sj288xsl.dgn	PLOT DATE: 17-AUG-2005
PROJECT MANAGER: R. R. WHITCOMB	DRAWN BY: J. GILMORE
DESIGNED BY: C. CARLSON	IPARM NAME: sj088d12.1
	SHEET 79 OF 90

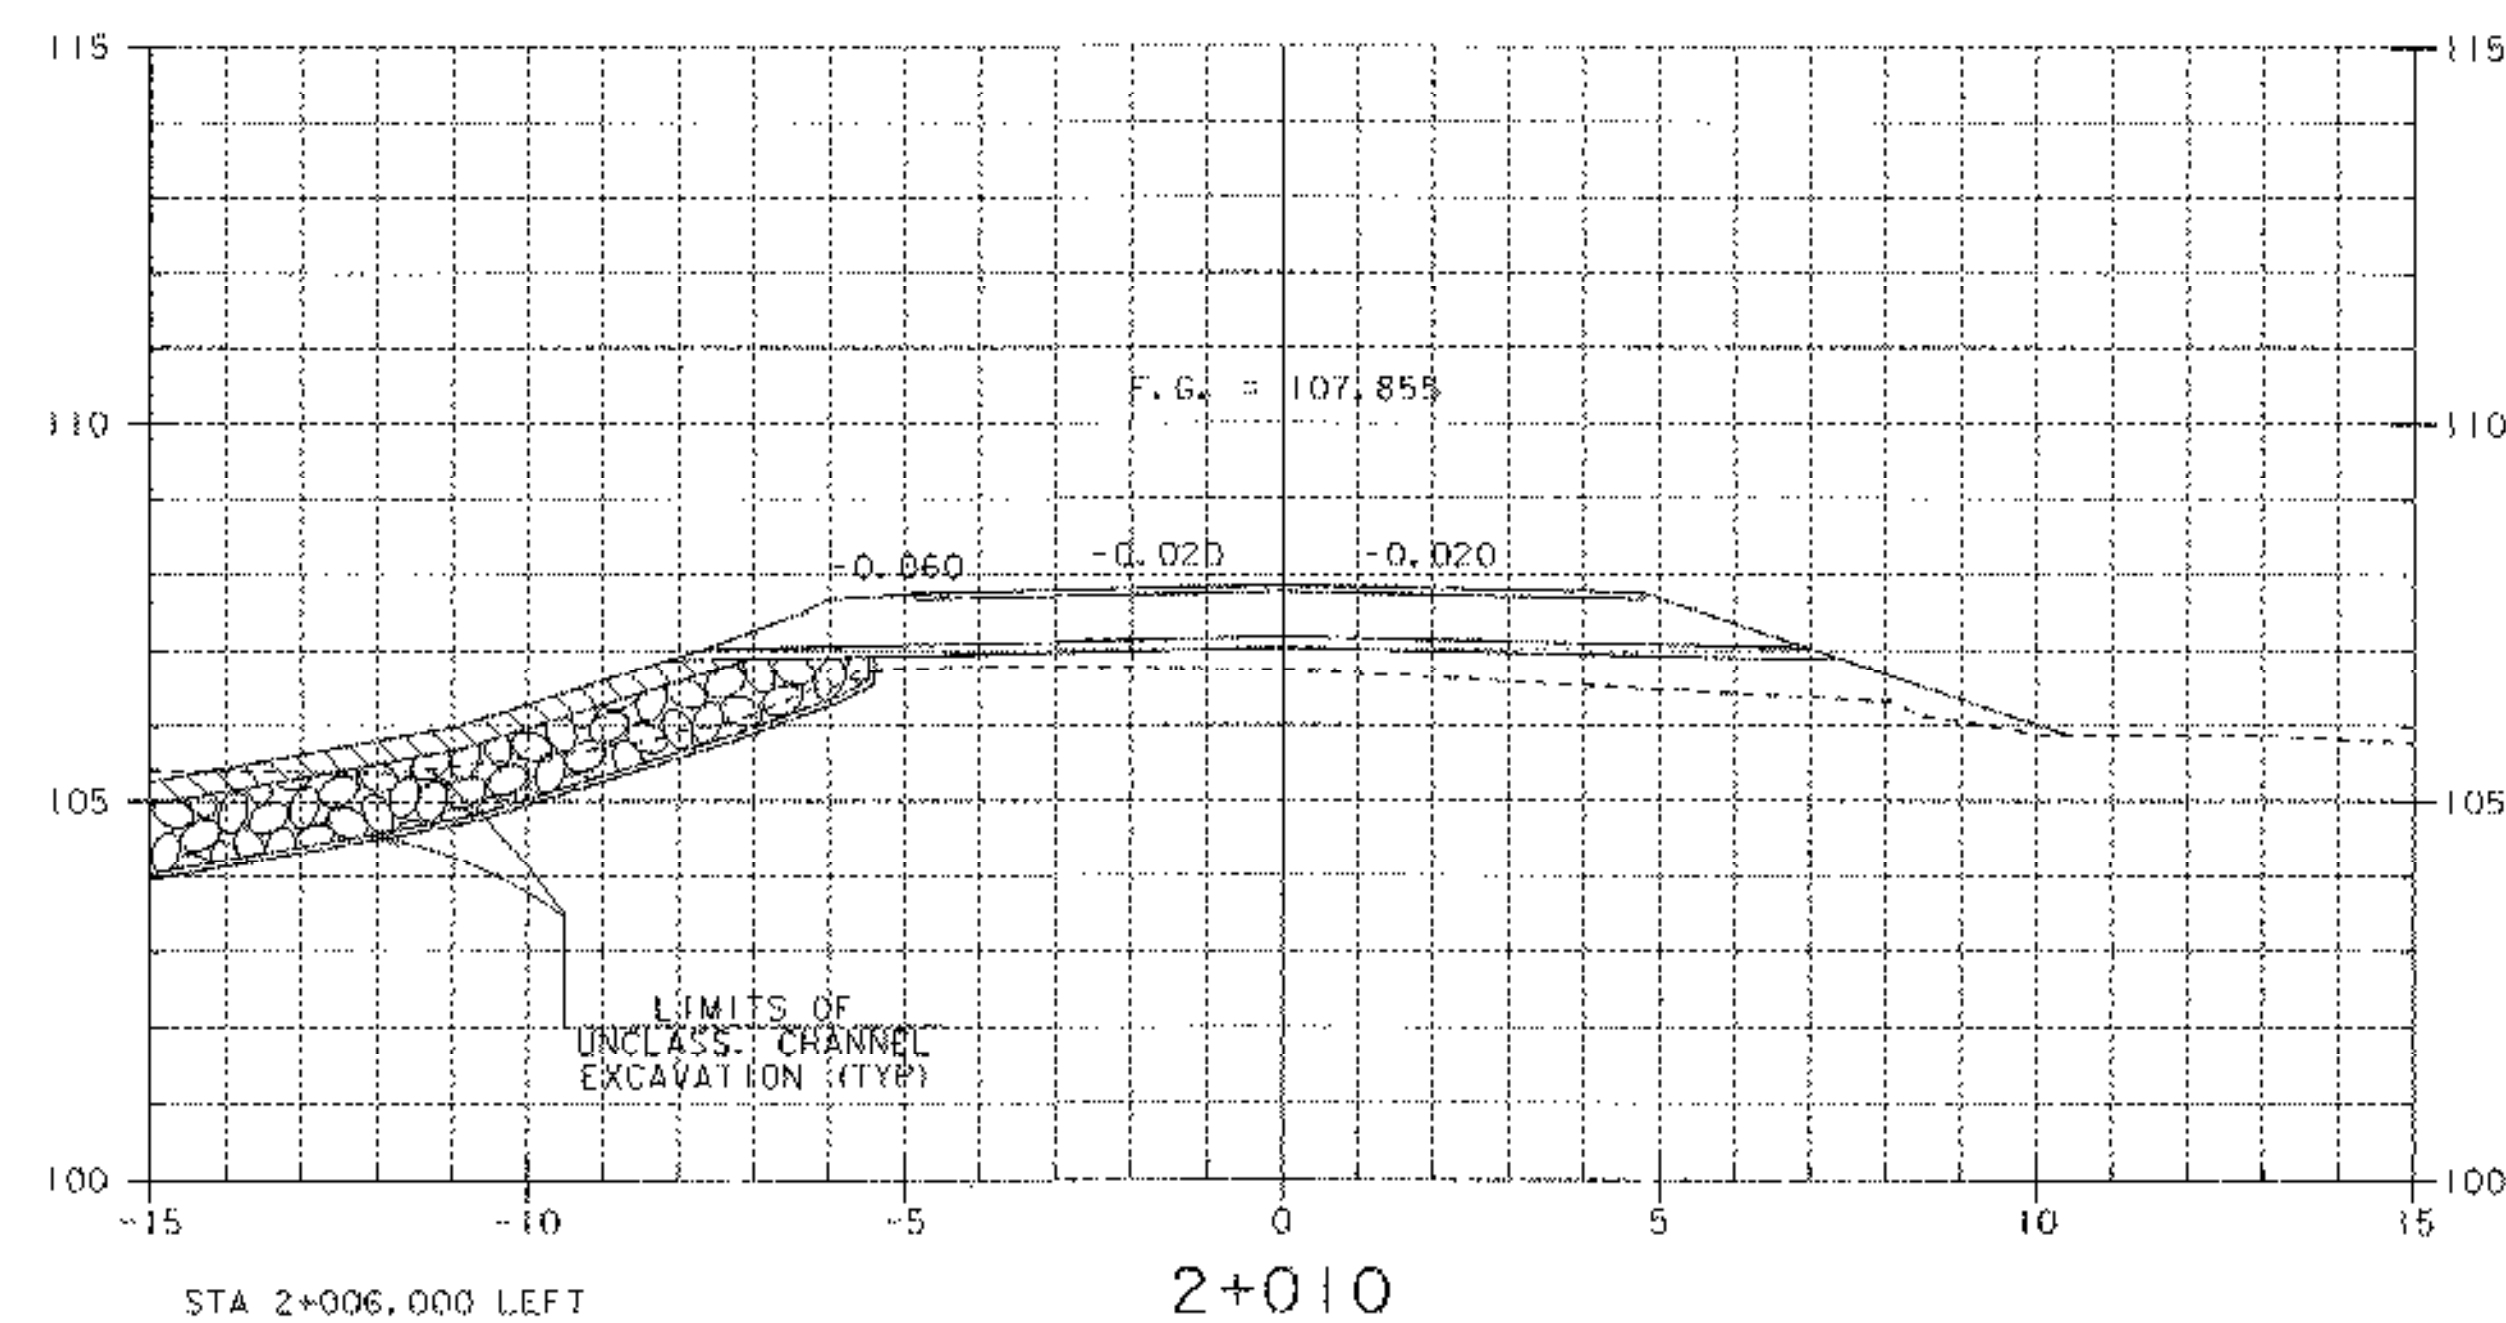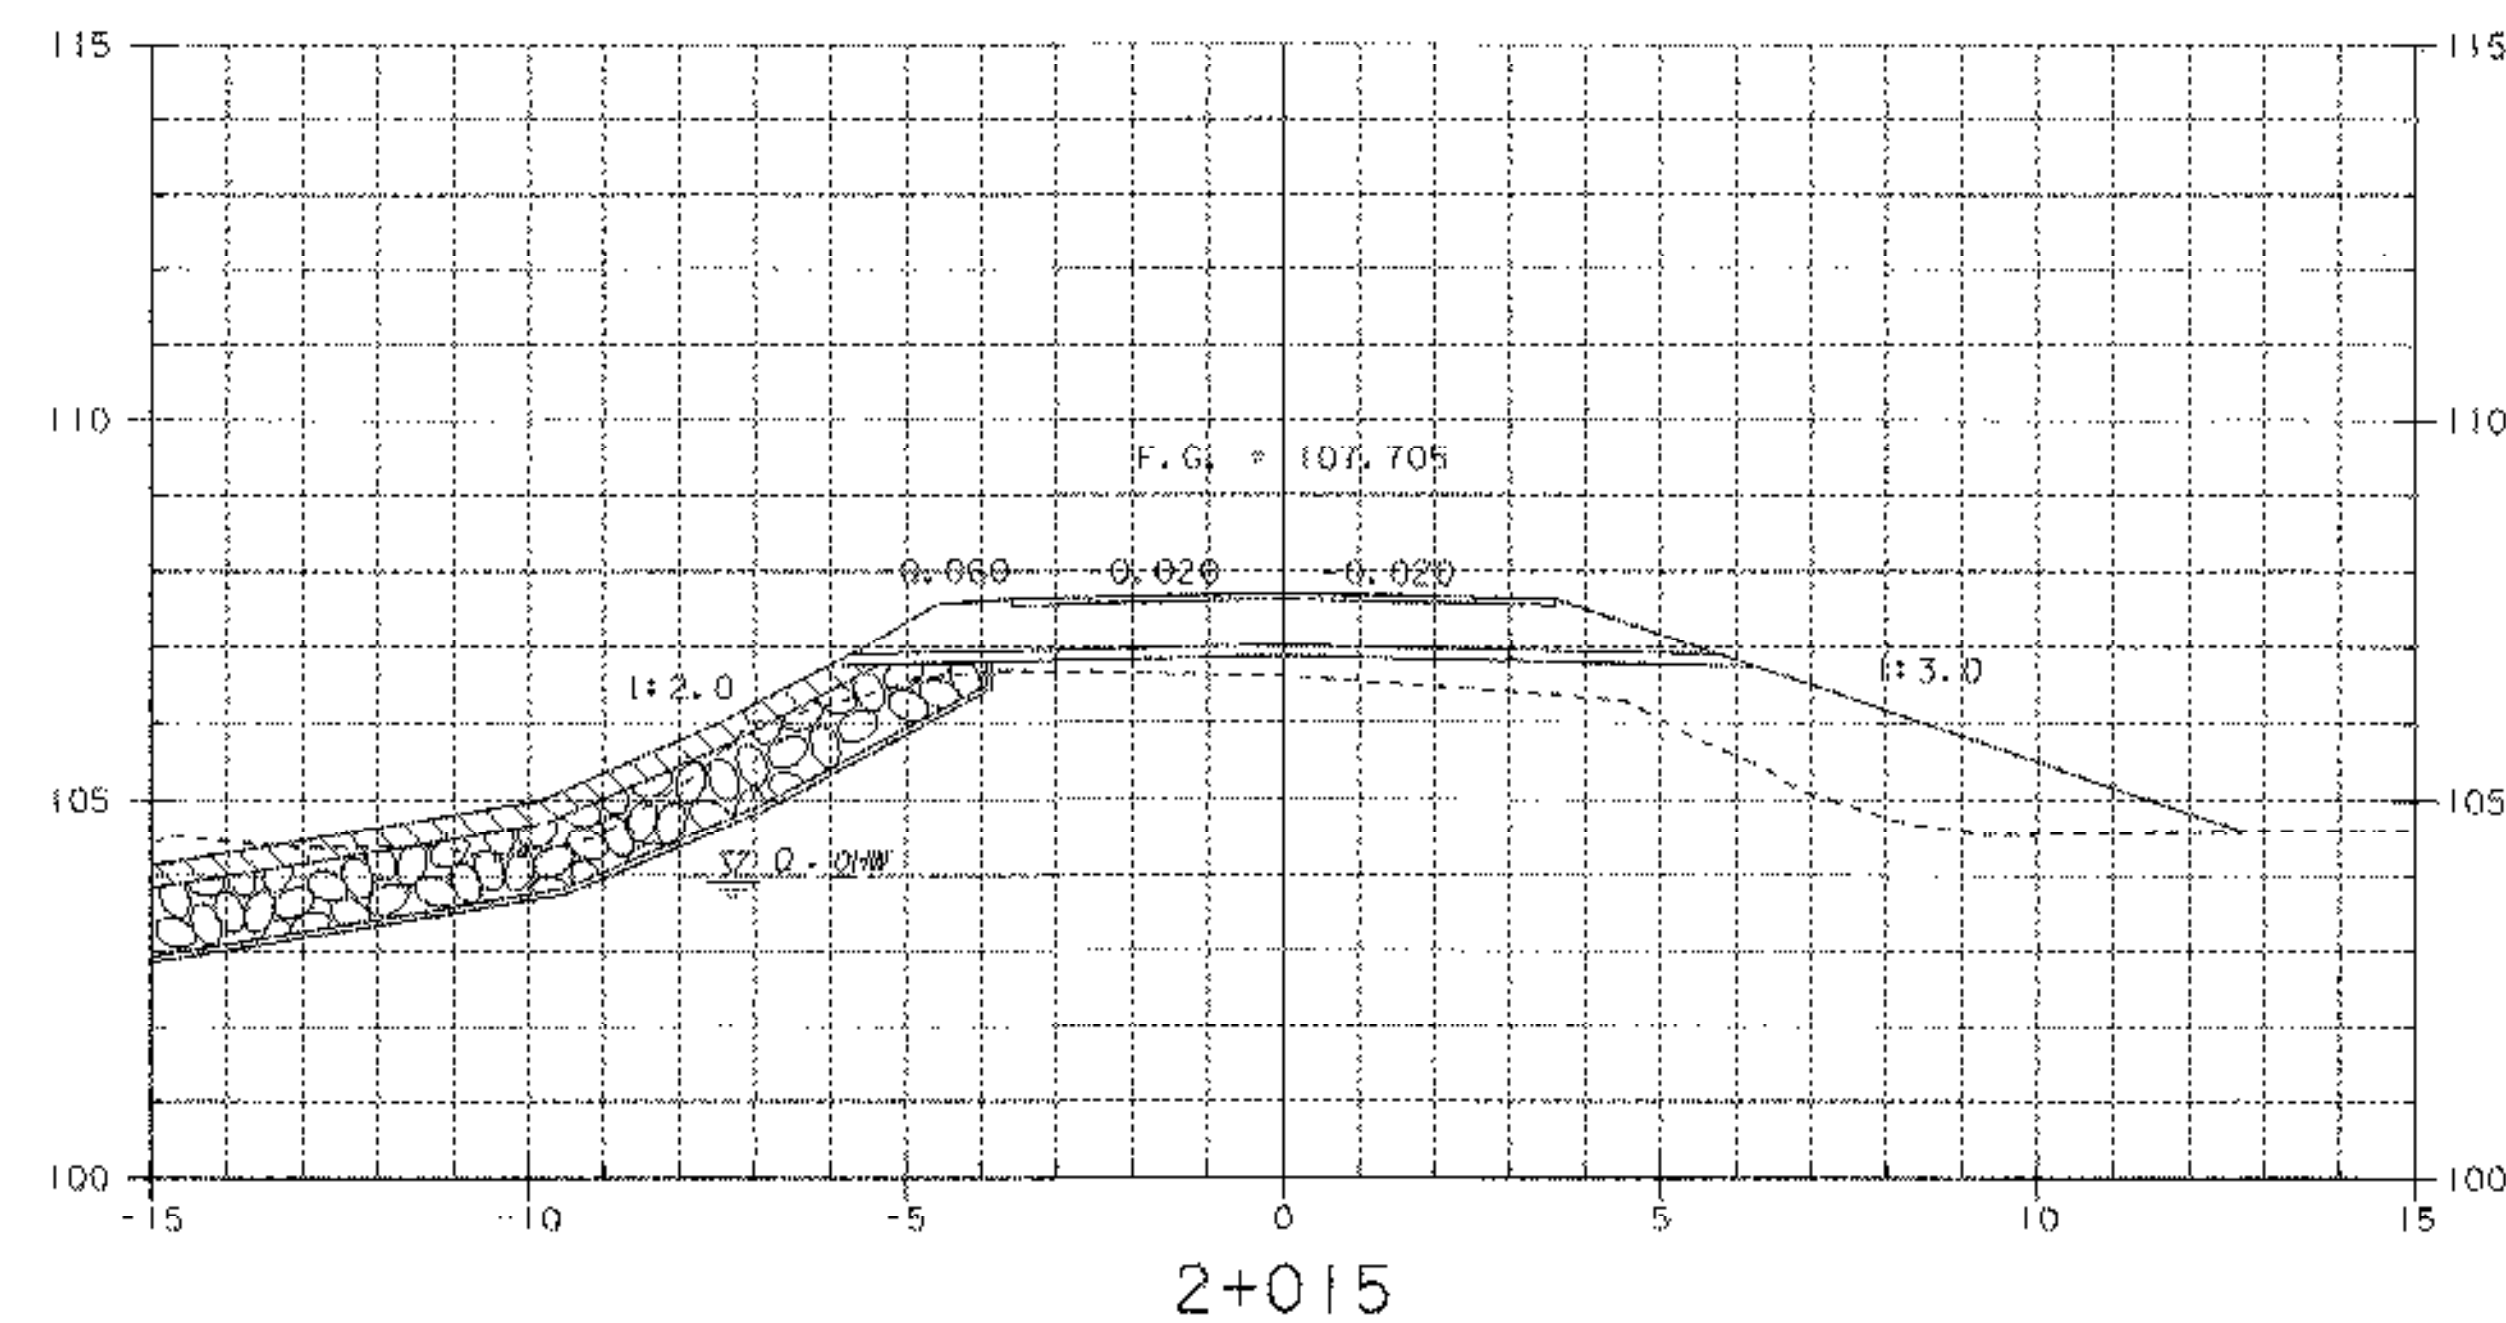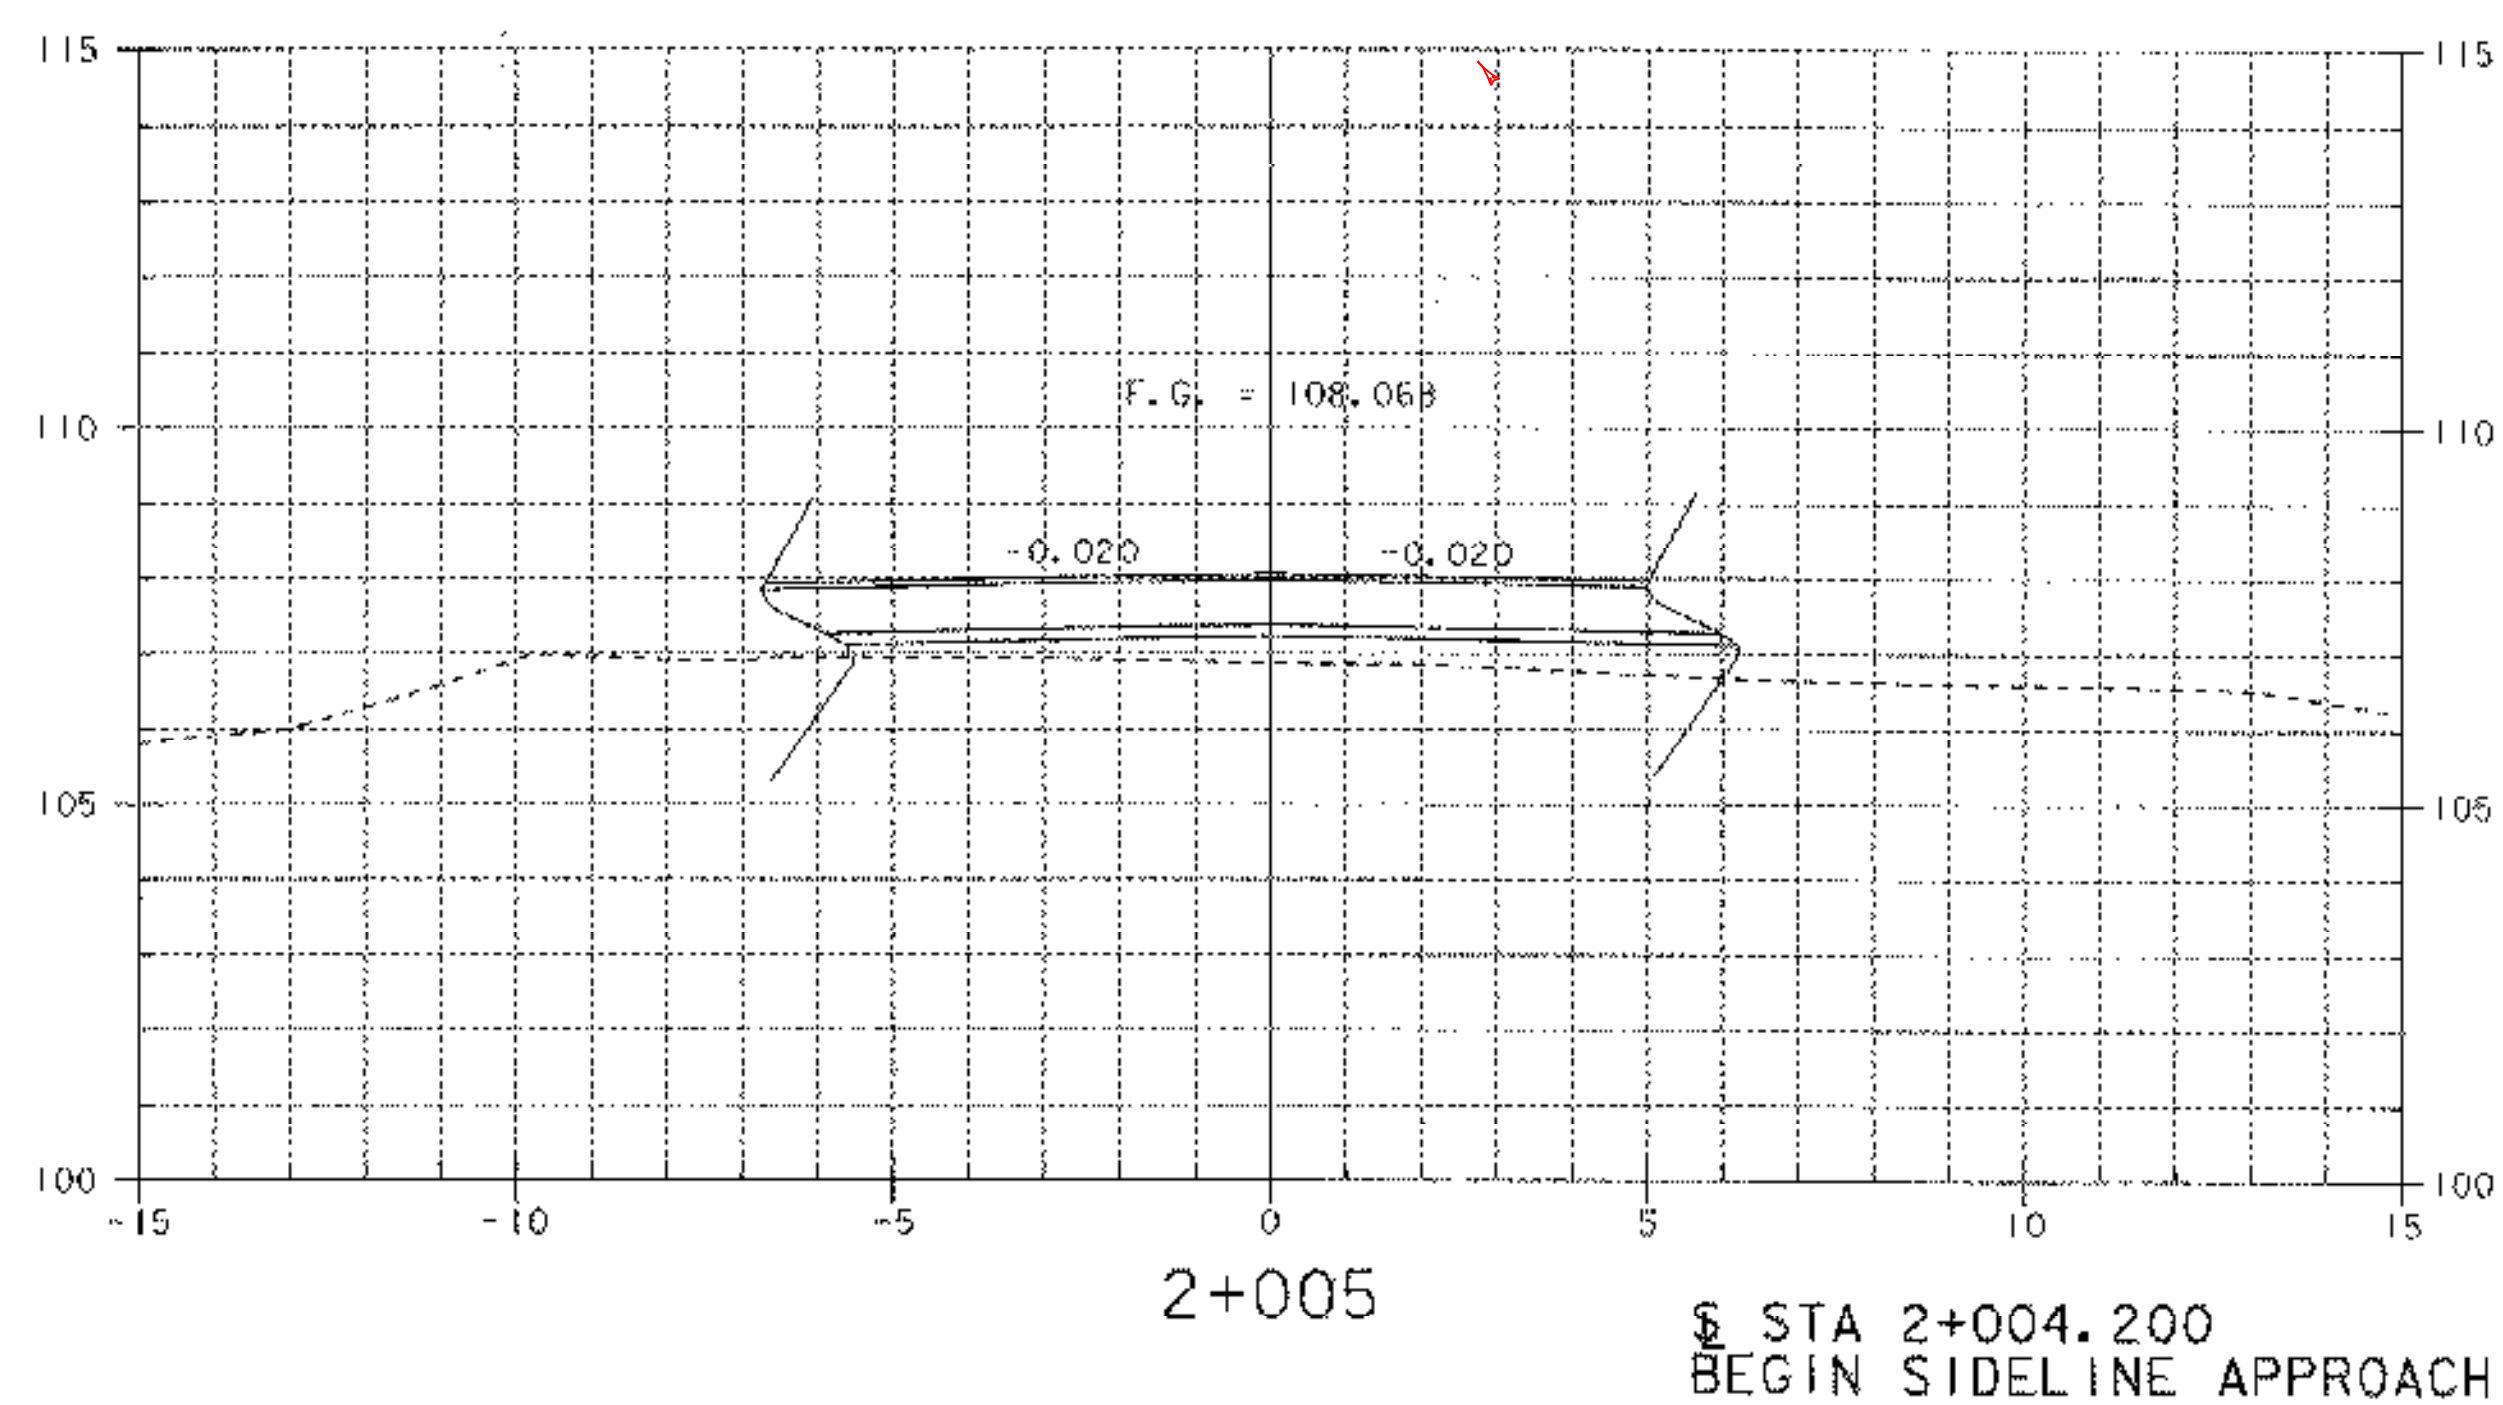



- STA 2+006.000 LEFT
- ~~BEGIN UNCLASS. CHANNEL EXCAVATION~~
- ~~BEGIN GEOTEXTILE FABRIC FILTER~~
- ~~BEGIN STONE FILL, TYPE III~~
- ~~BEGIN GRUBBING MATERIAL~~
- ITEMS ELIMINATED BY WRITTEN ORDER #10

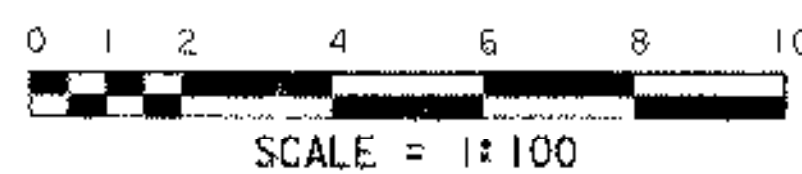








SHEET NAME: SIDELINE CROSS SECTIONS	
PROJECT NAME: LEICESTER	HIGHWAY NO.: FAS 0160
PROJECT NUMBER: BRF 0160(3)S	BRIDGE NO.: 6
	OVER: OTTER CREEK
FILE NAME: 95j288\structures\sj288xsl.dgn	PLOT DATE: 17-AUG-2005
PROJECT MANAGER: R. R. WHITCOMB	DRAWN BY: J. GILMORE
DESIGNED BY: C. CARLSON	IPARM NAME: sj088s.d1
	SHEET 80 OF 90

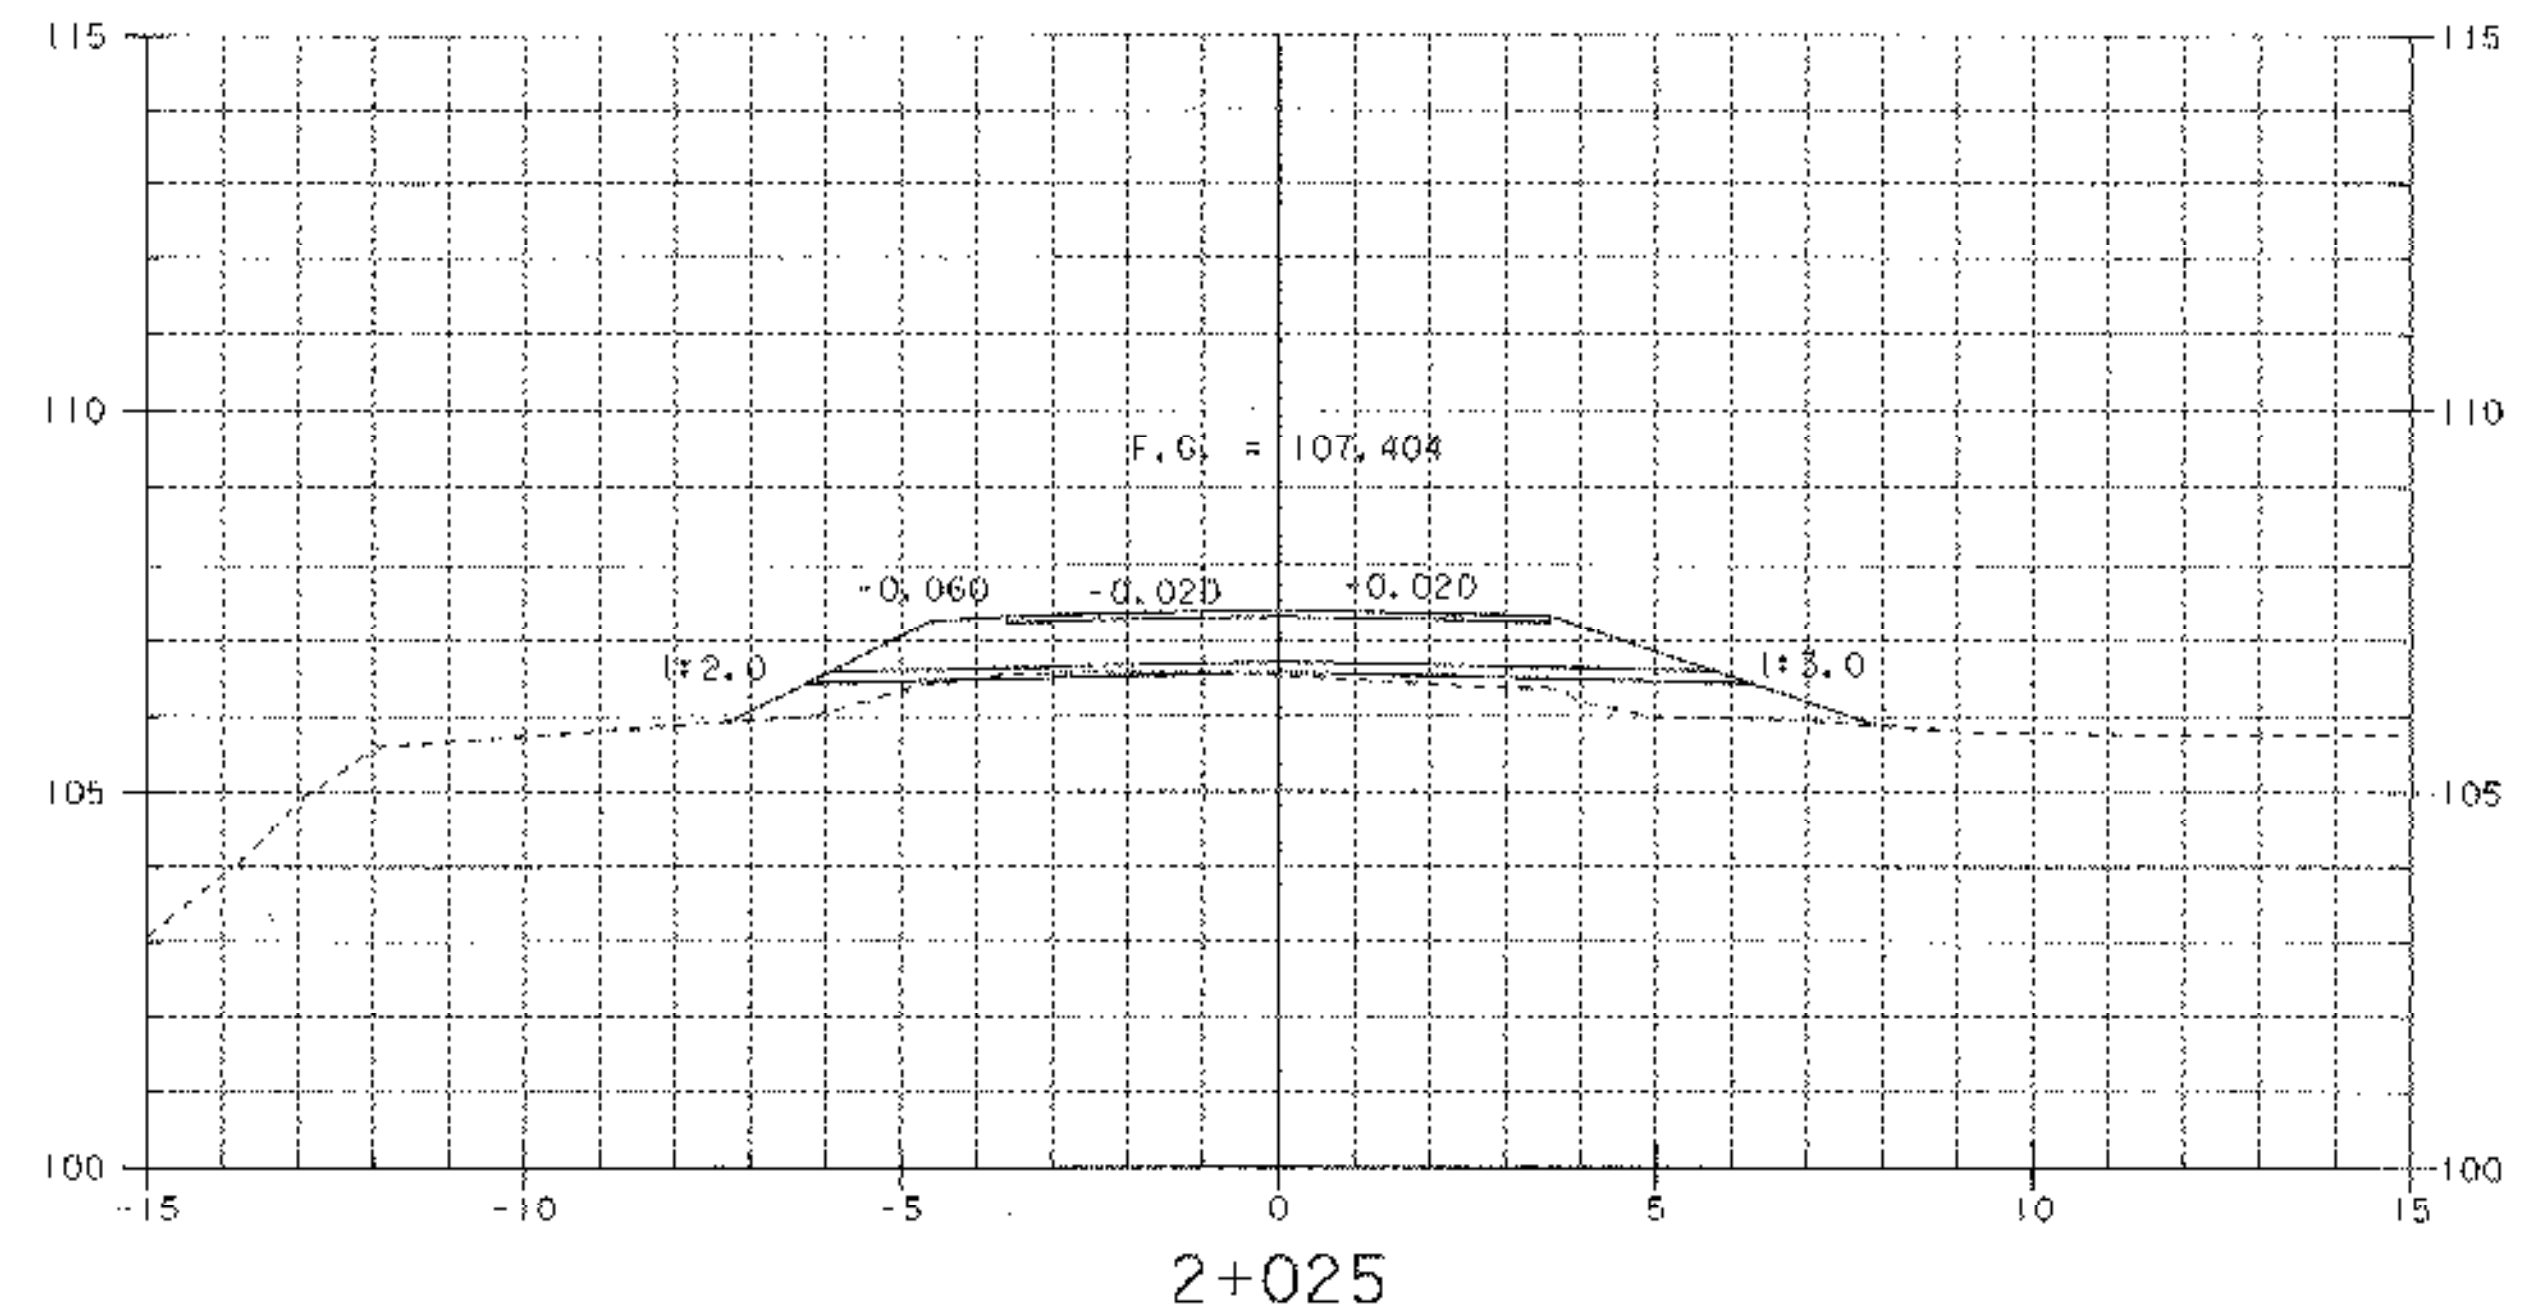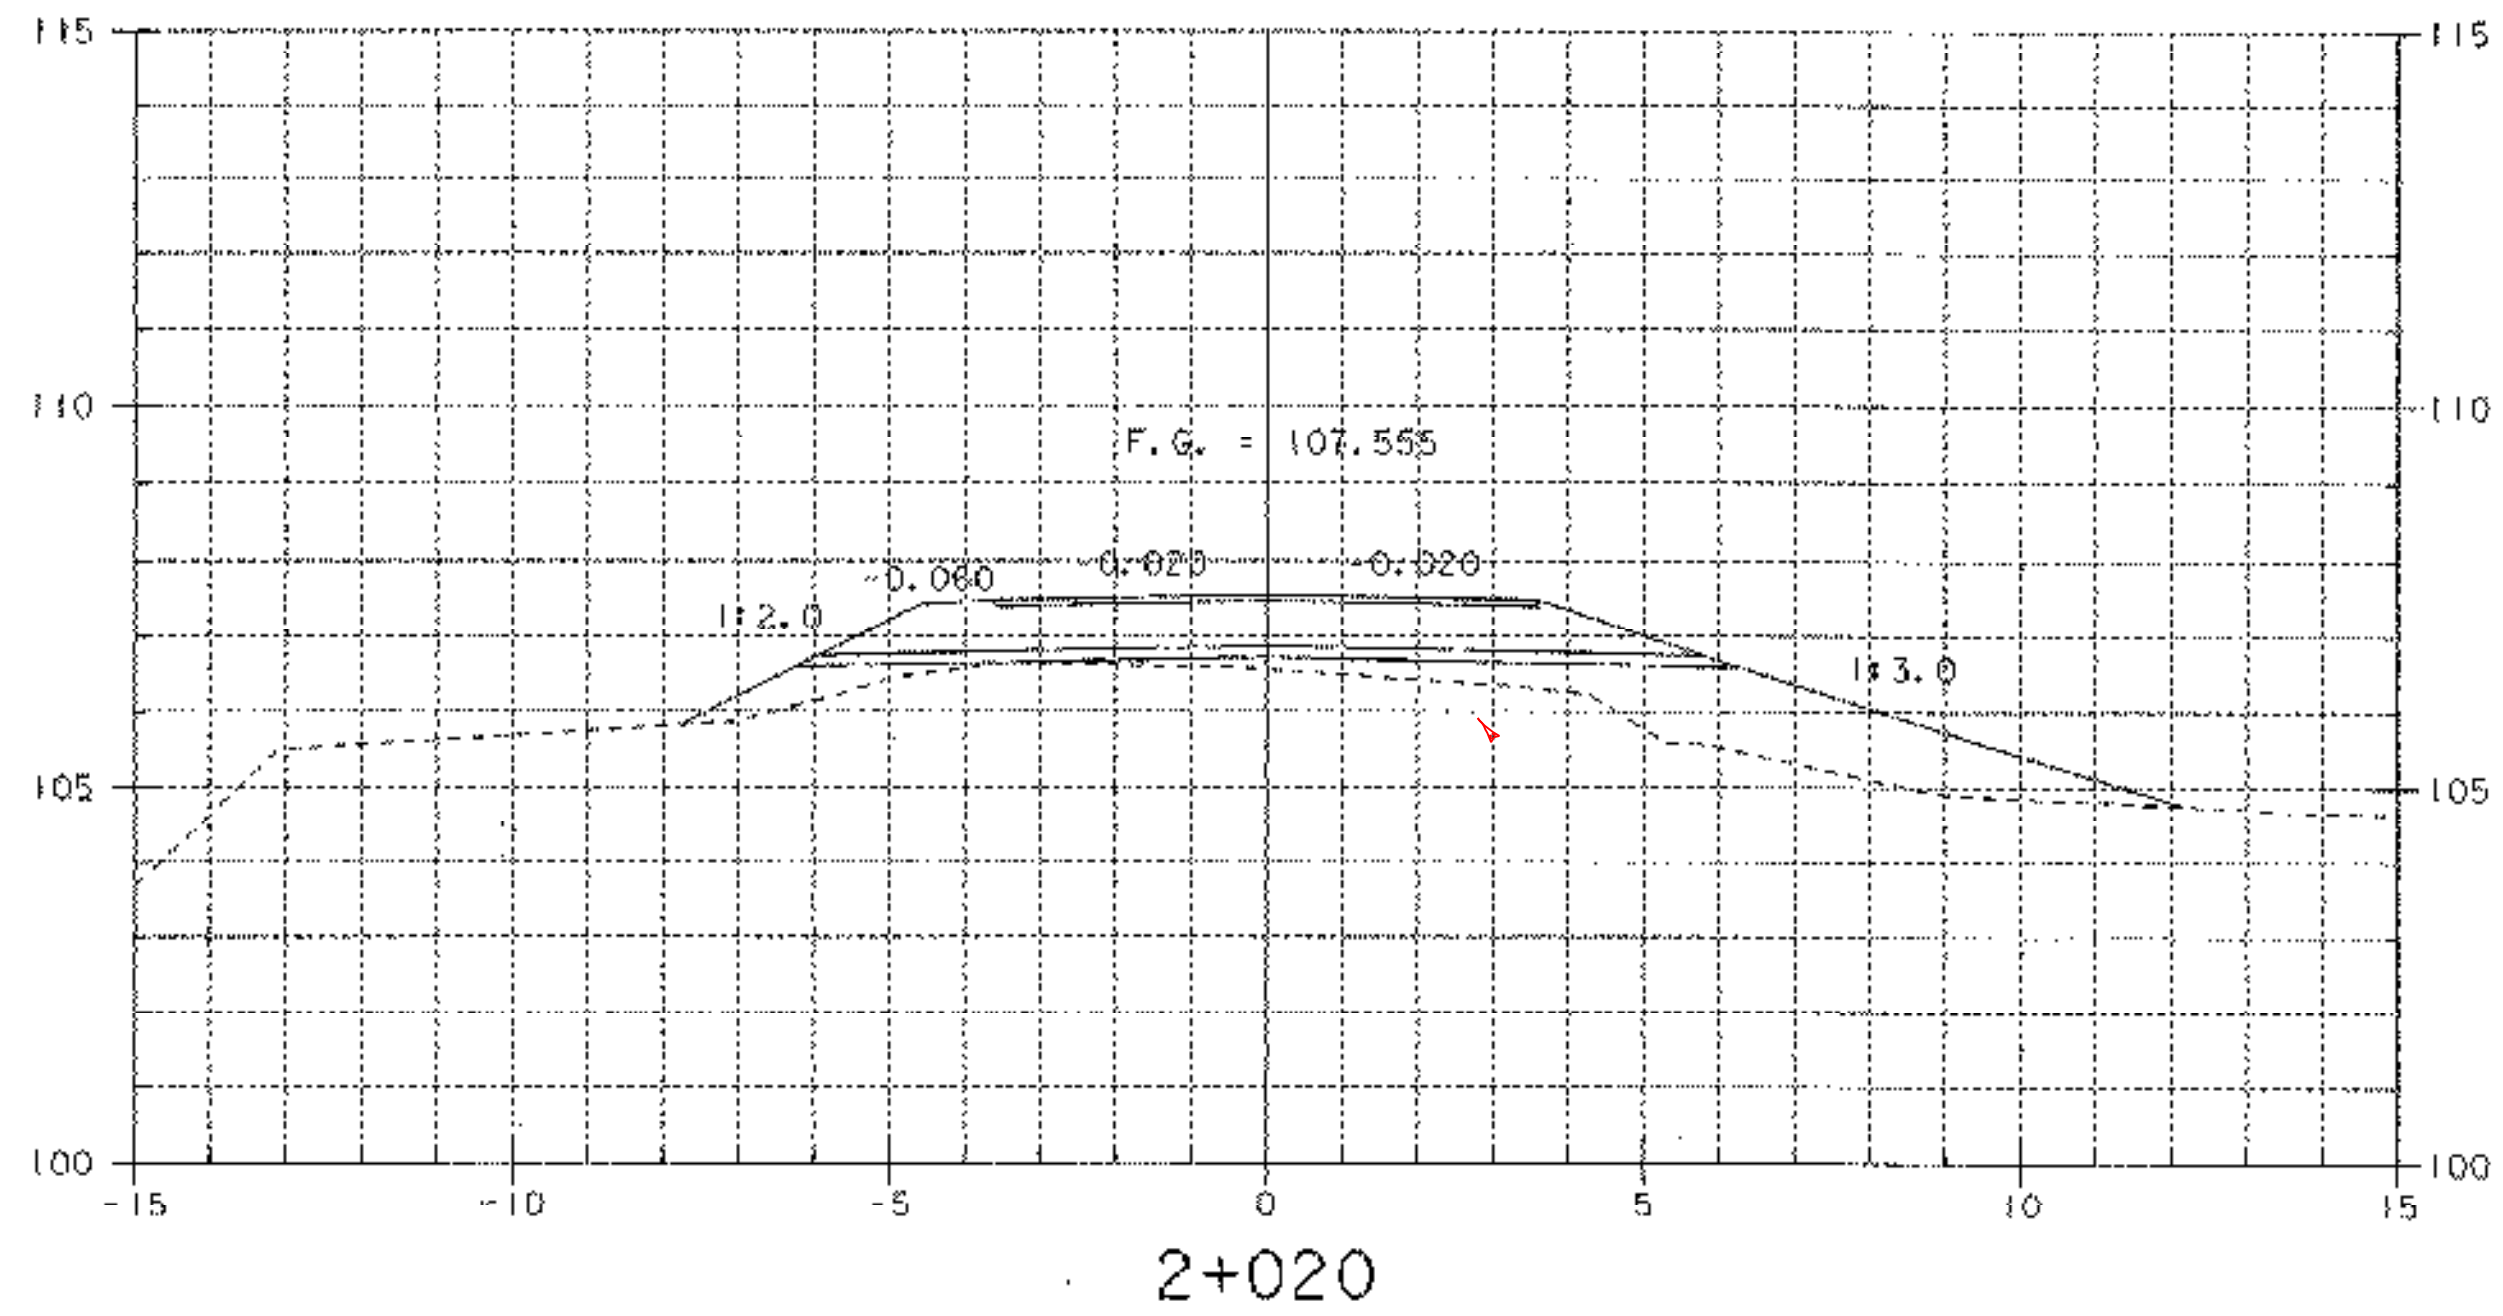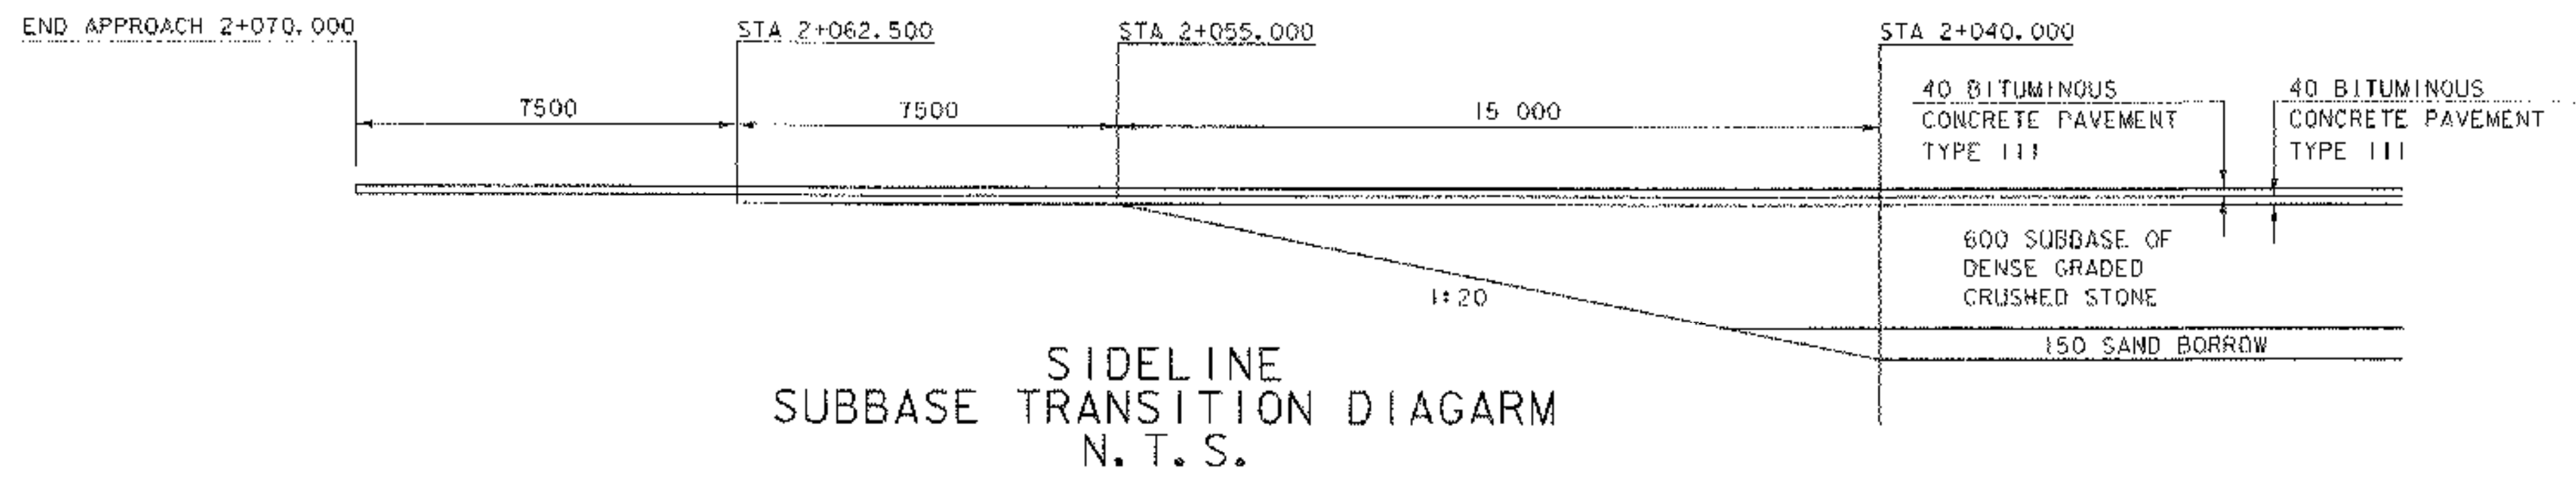


§ STA 2+017
 END UNCLASS. CHANNEL EXCAVATION
 END GEOTEXTILE FILTER FABRIC
 END STONE FILL, TYPE III
 END GRUBBING MATERIAL

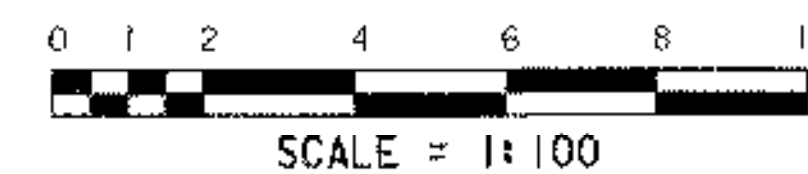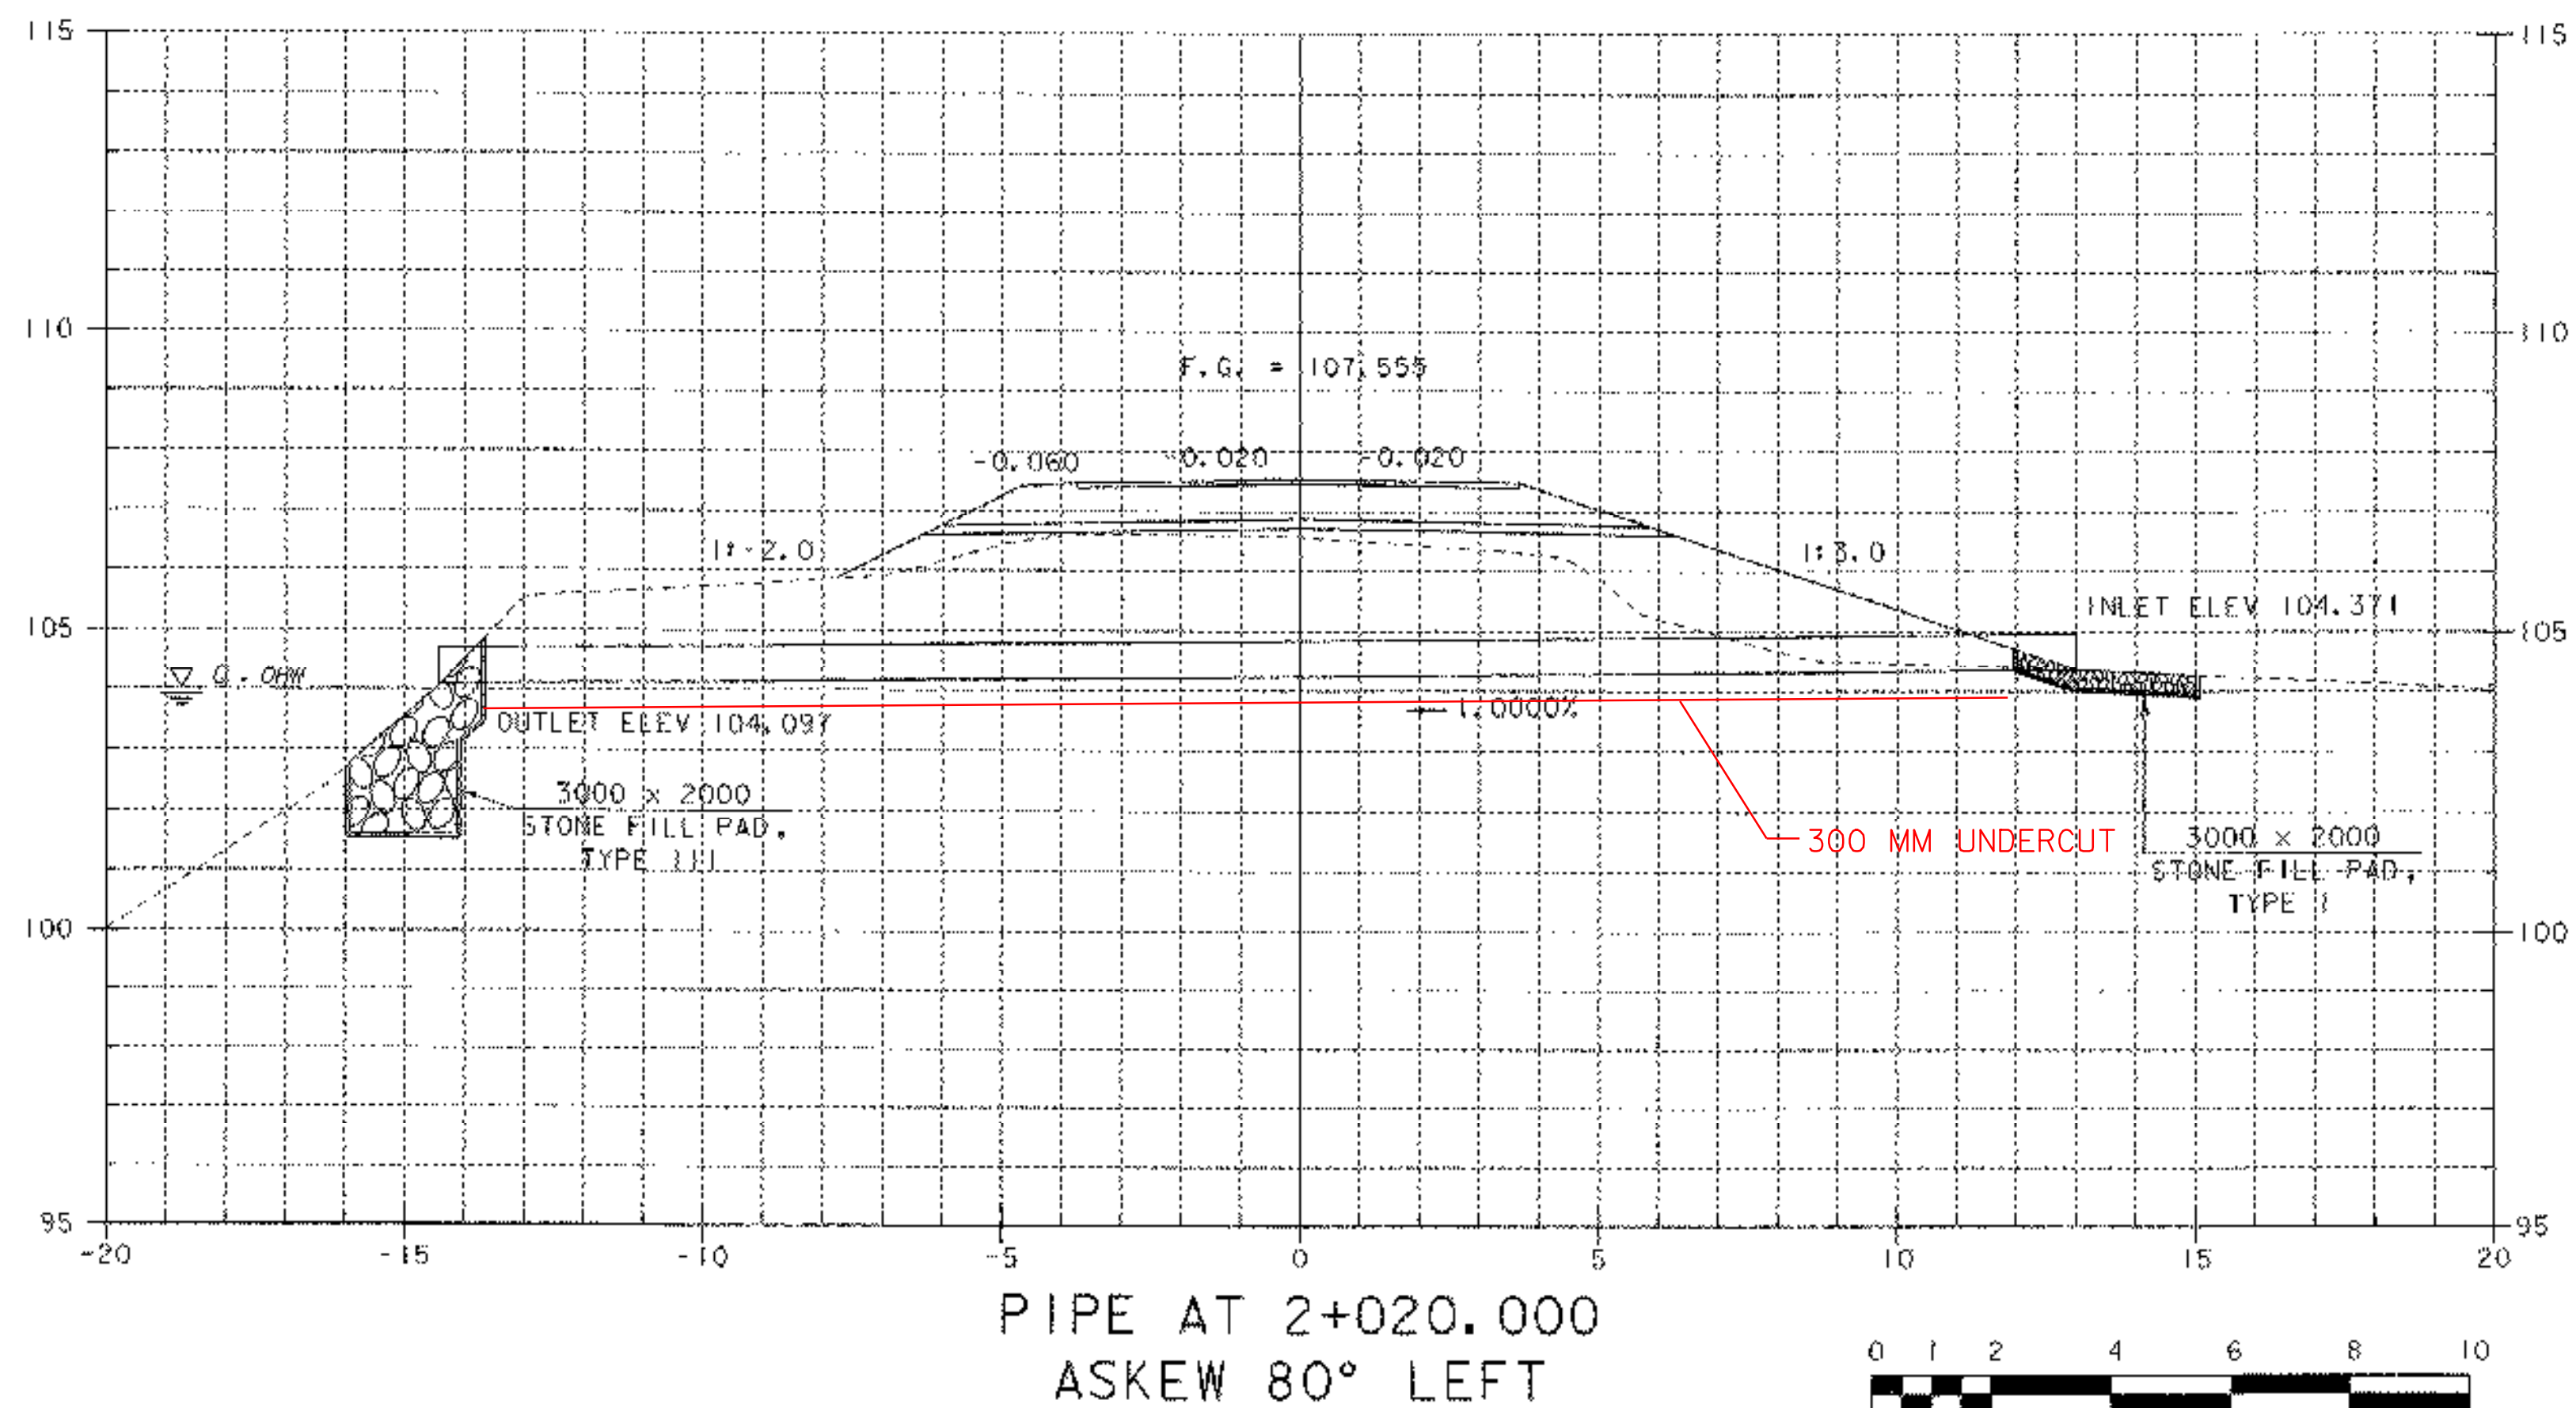

SHEET NAME: SIDELINE CROSS SECTIONS	
PROJECT NAME: LEICESTER	HIGHWAY NO.: FAS 0160
PROJECT NUMBER: BRF 0160(3)S	BRIDGE NO.: 6
	OVER: OTTER CREEK
FILE NAME: 95J288\Structures\sj288\sl.dgn	PLOT DATE: 17-AUG-2005
PROJECT MANAGER: R. R. WHITCOMB	DRAWN BY: J. GILMORE
DESIGNED BY: C. CARLSON	IPARM NAME: sj088sx2.1
	SHEET 81 OF 90

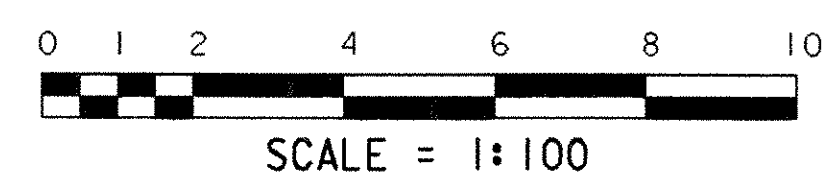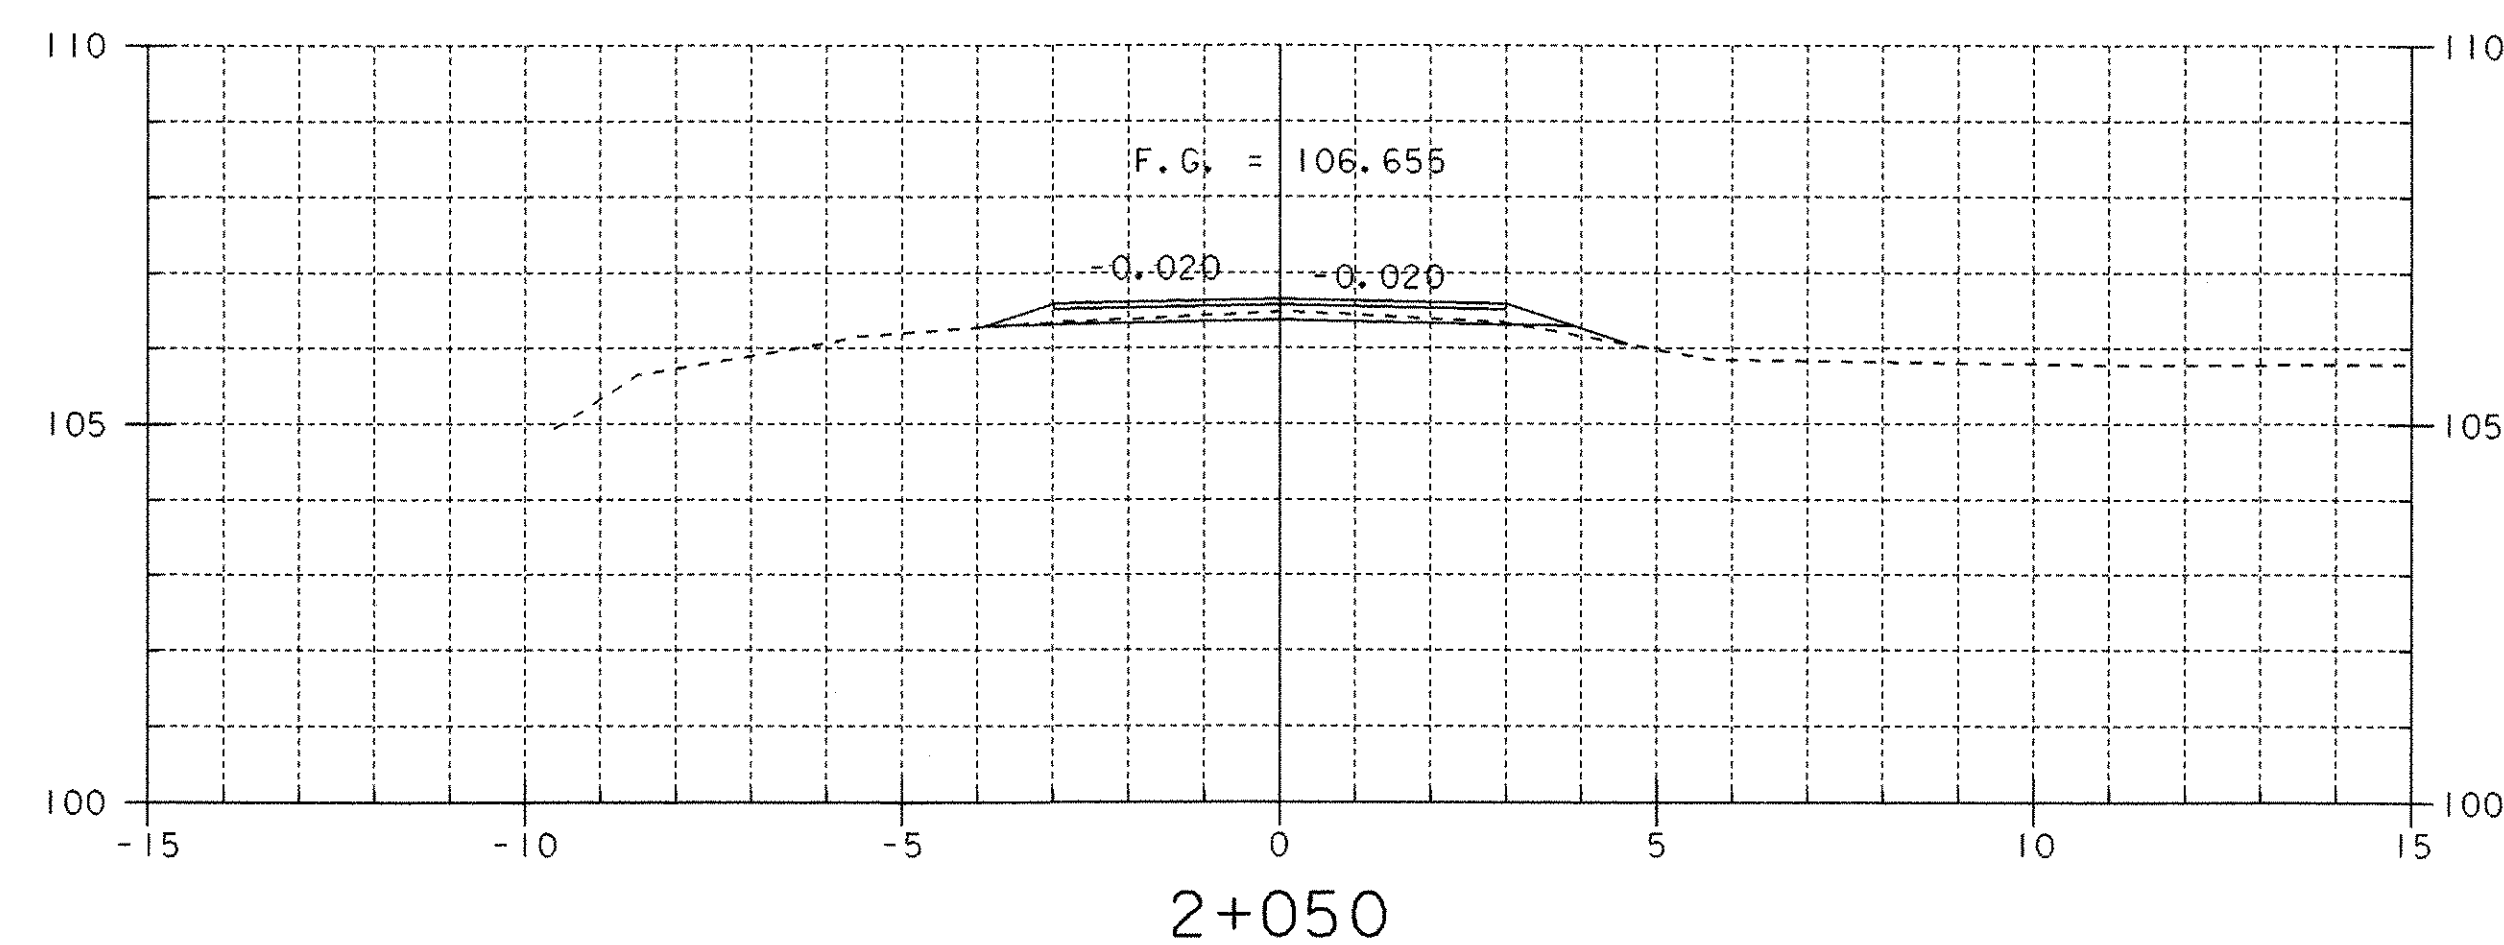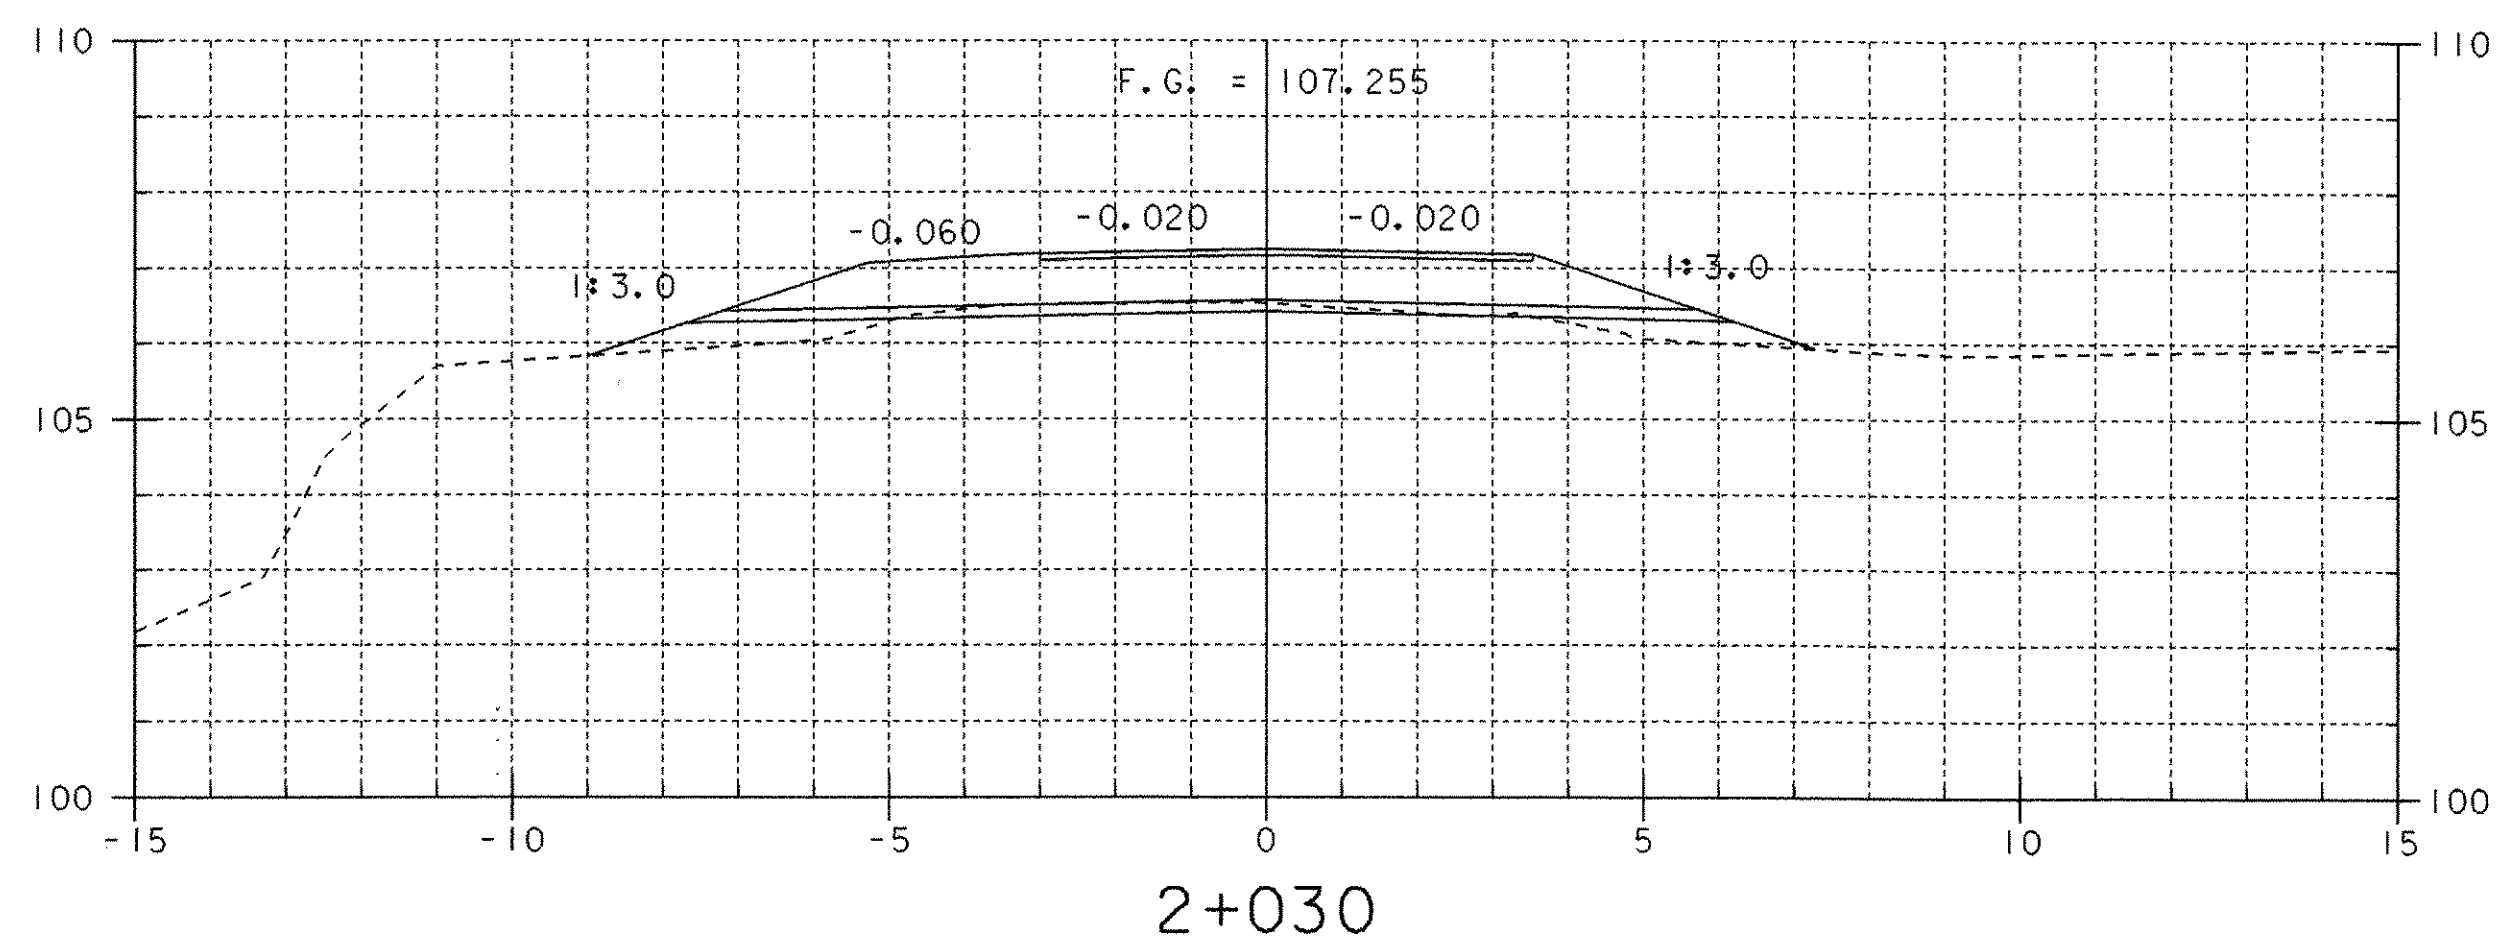
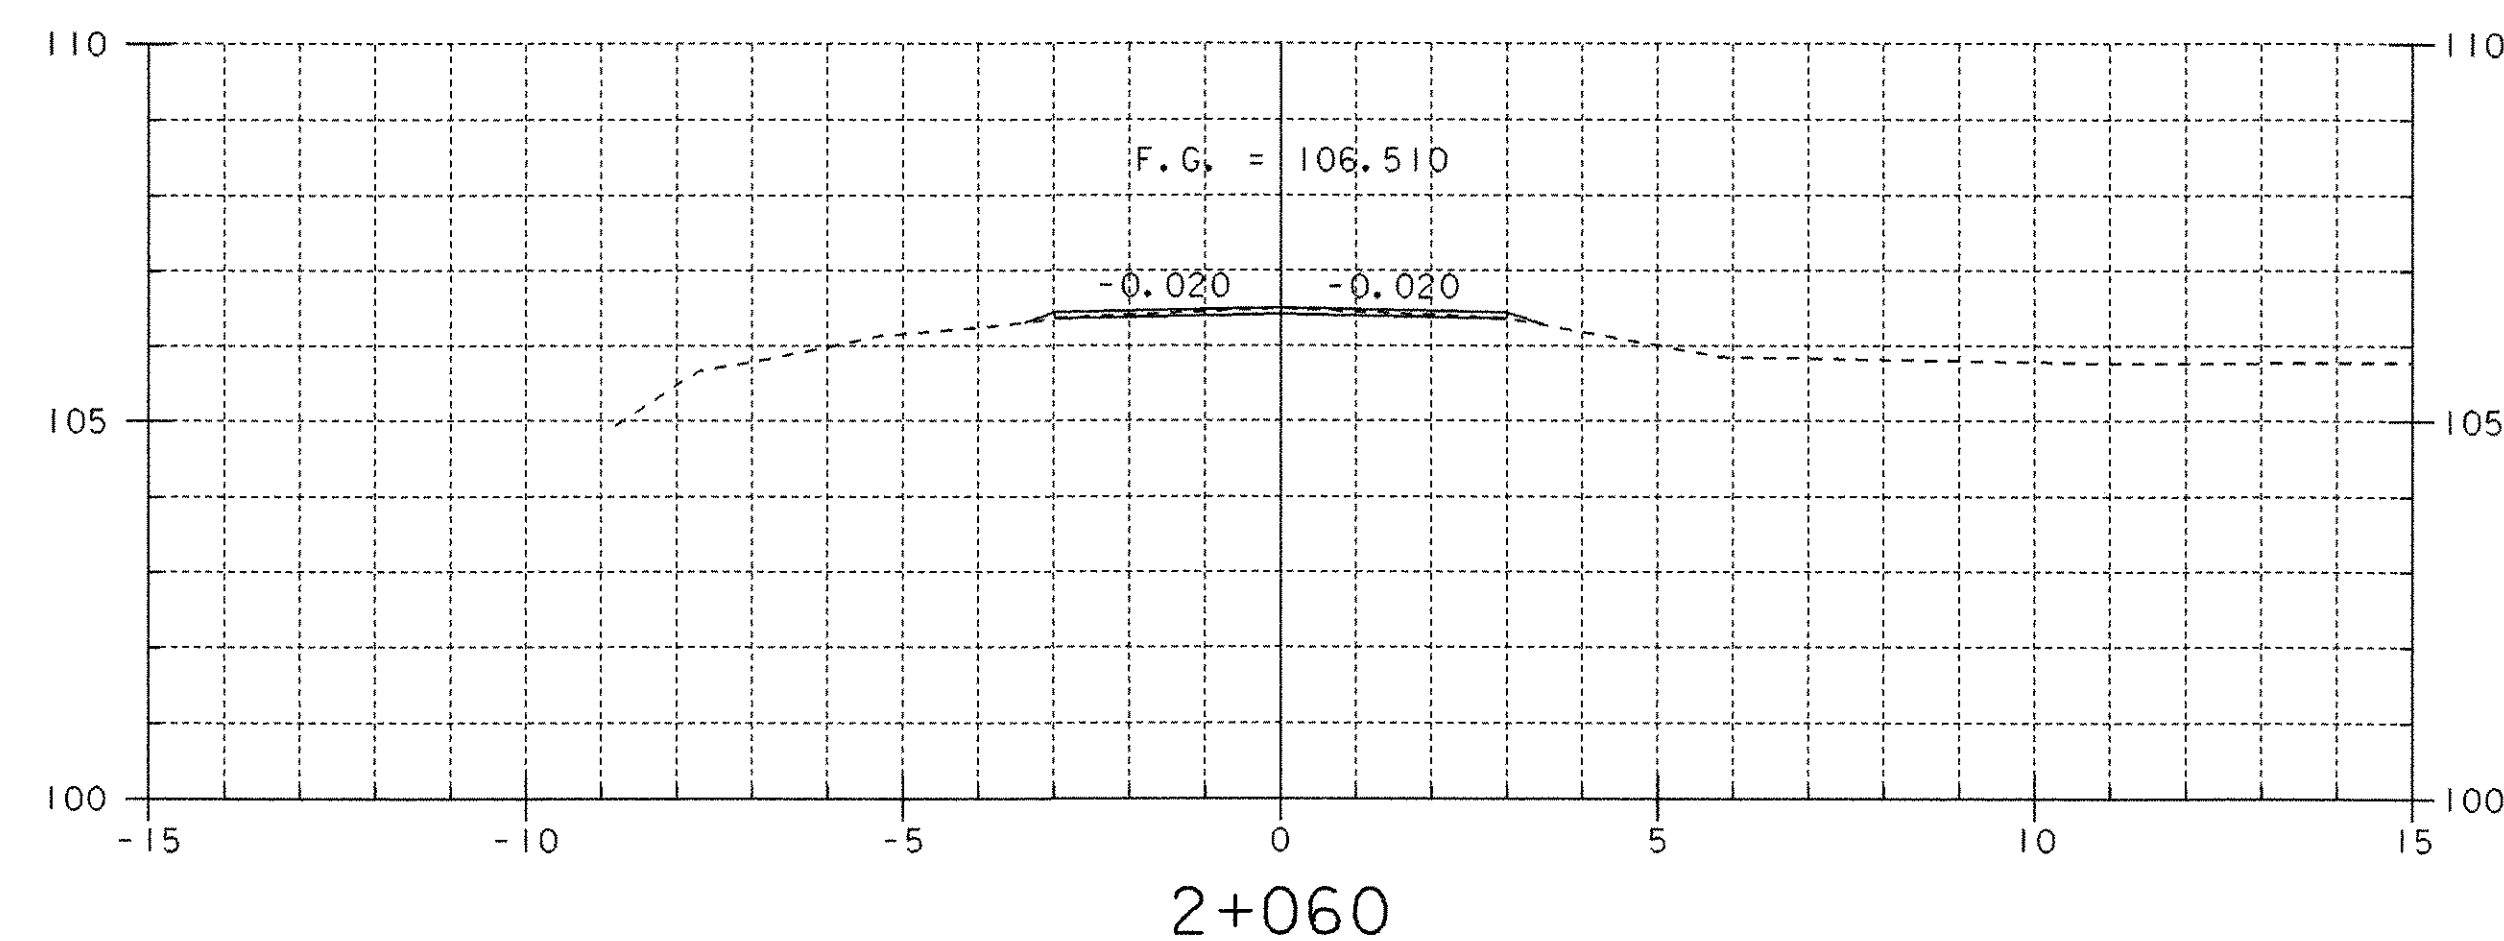
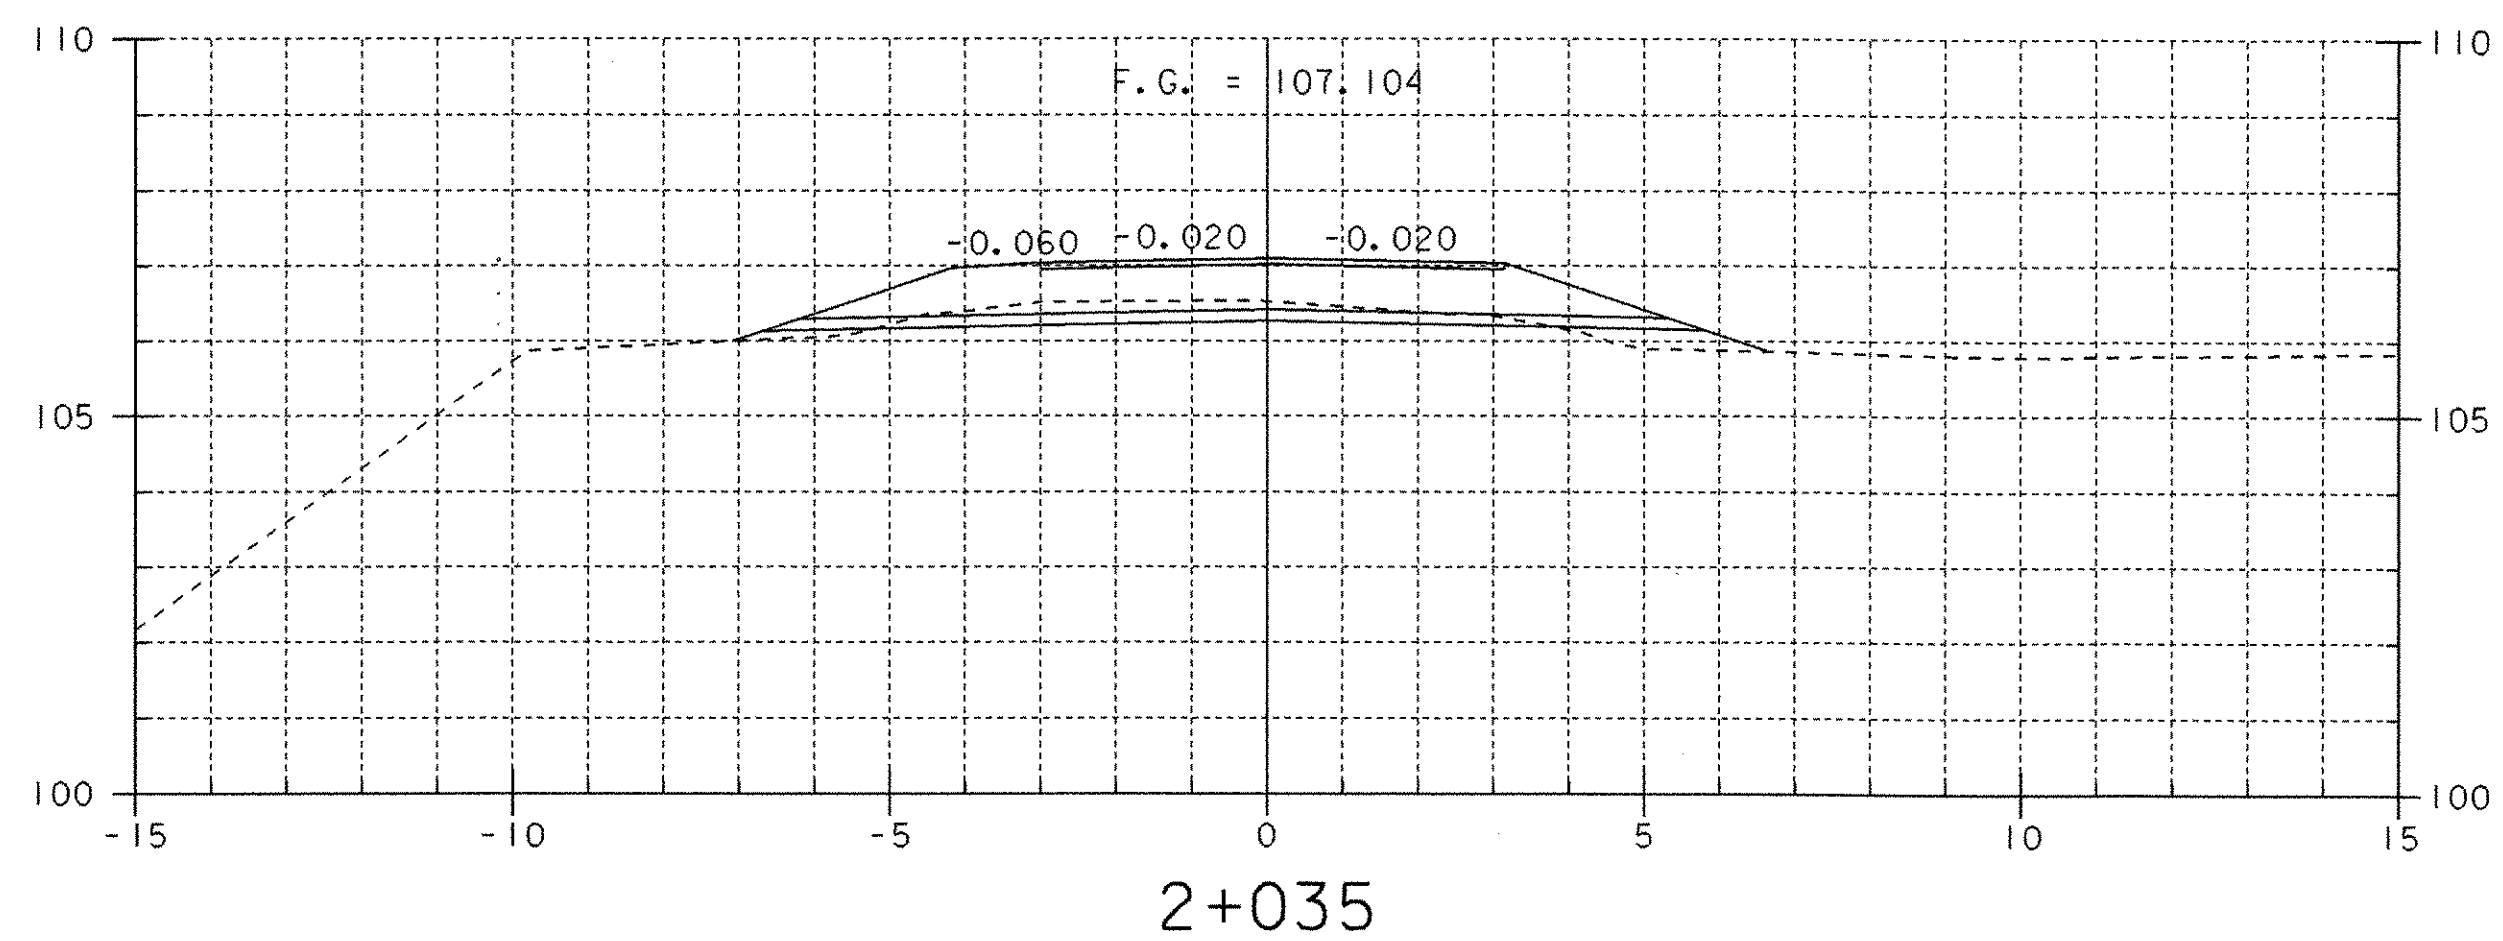
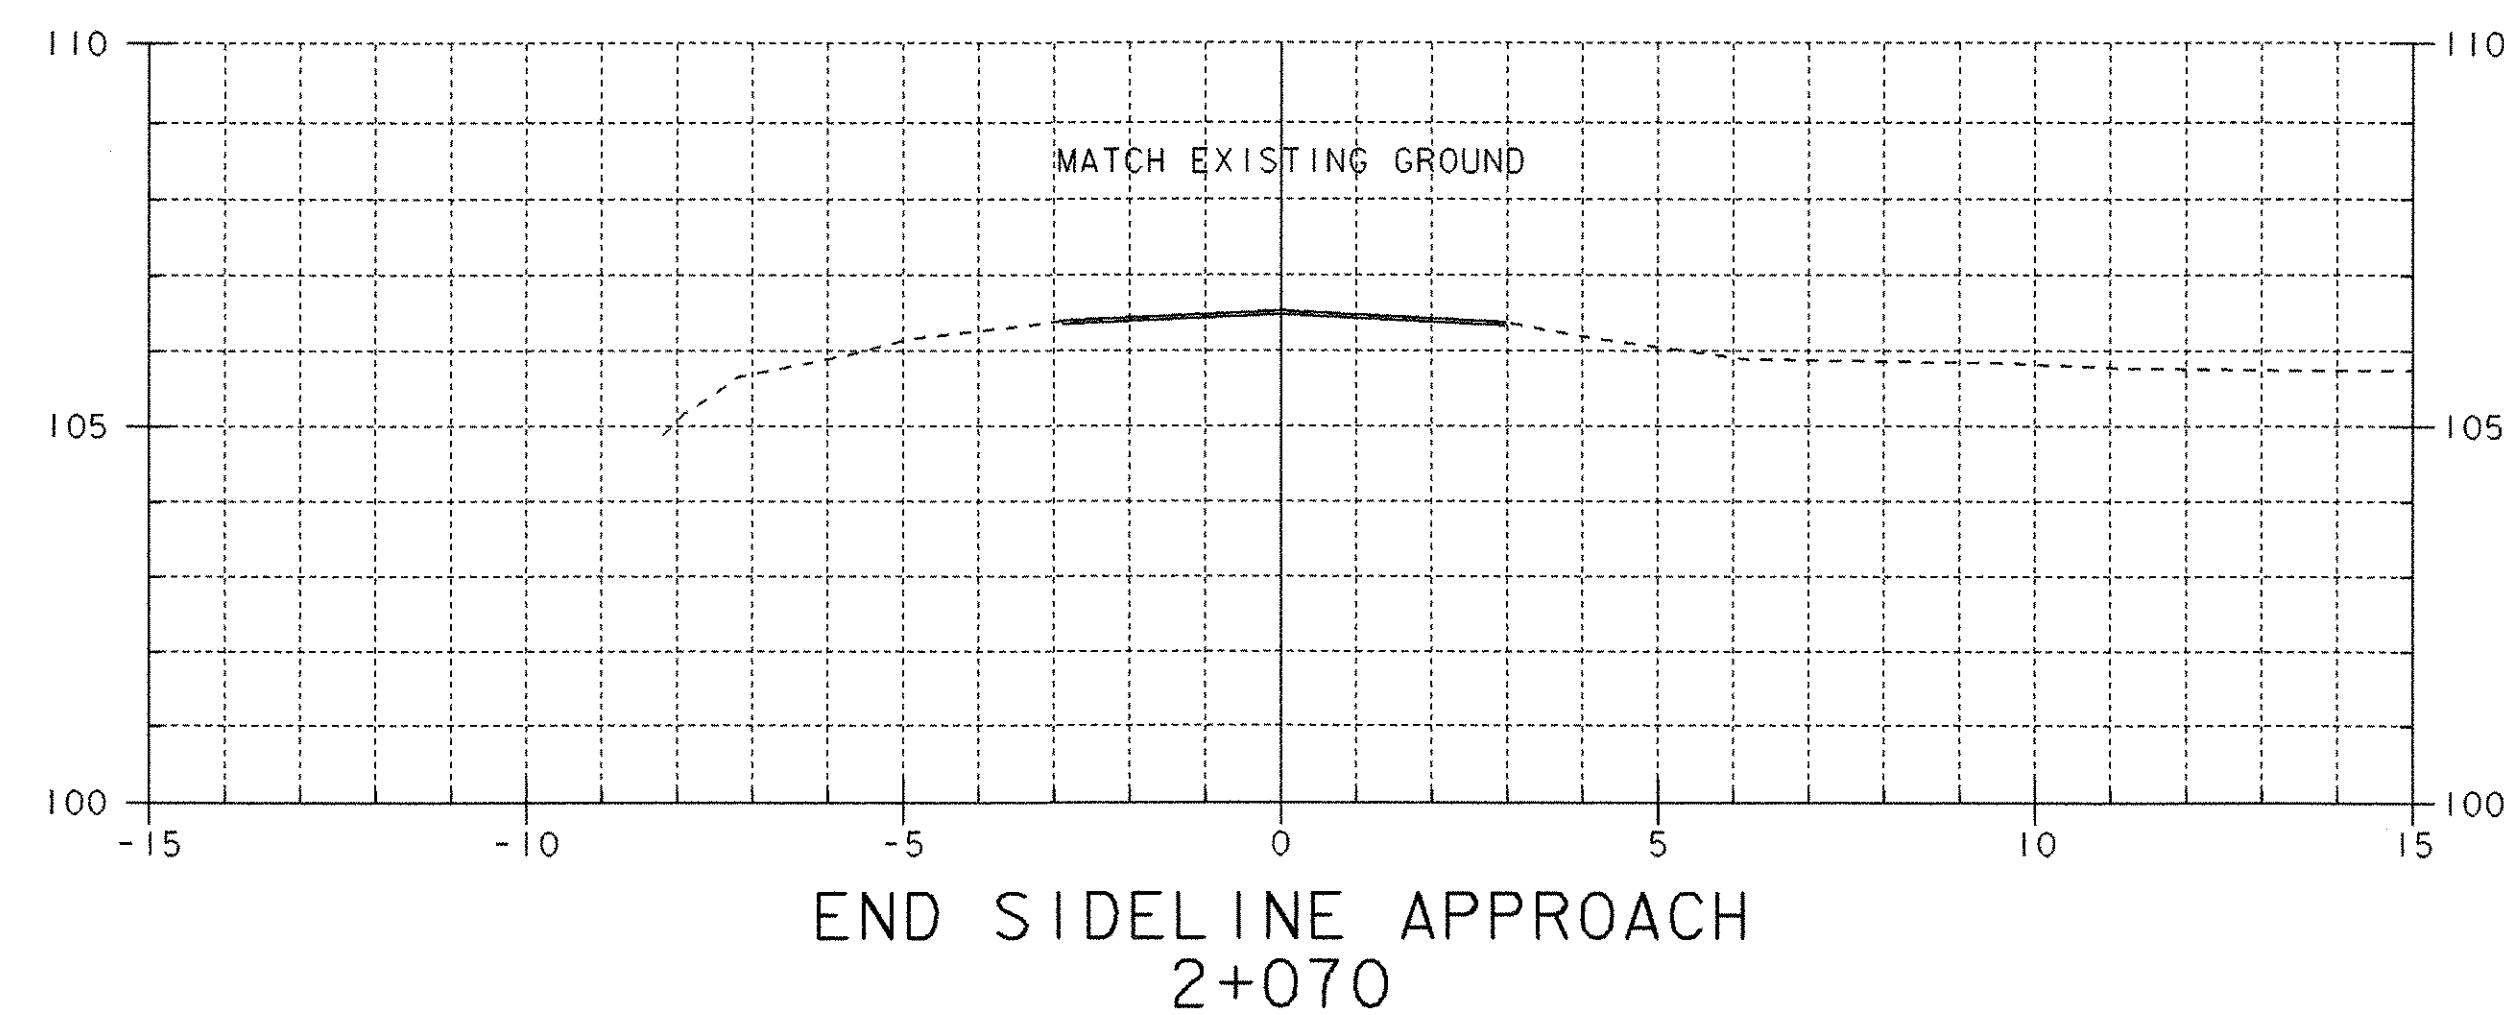
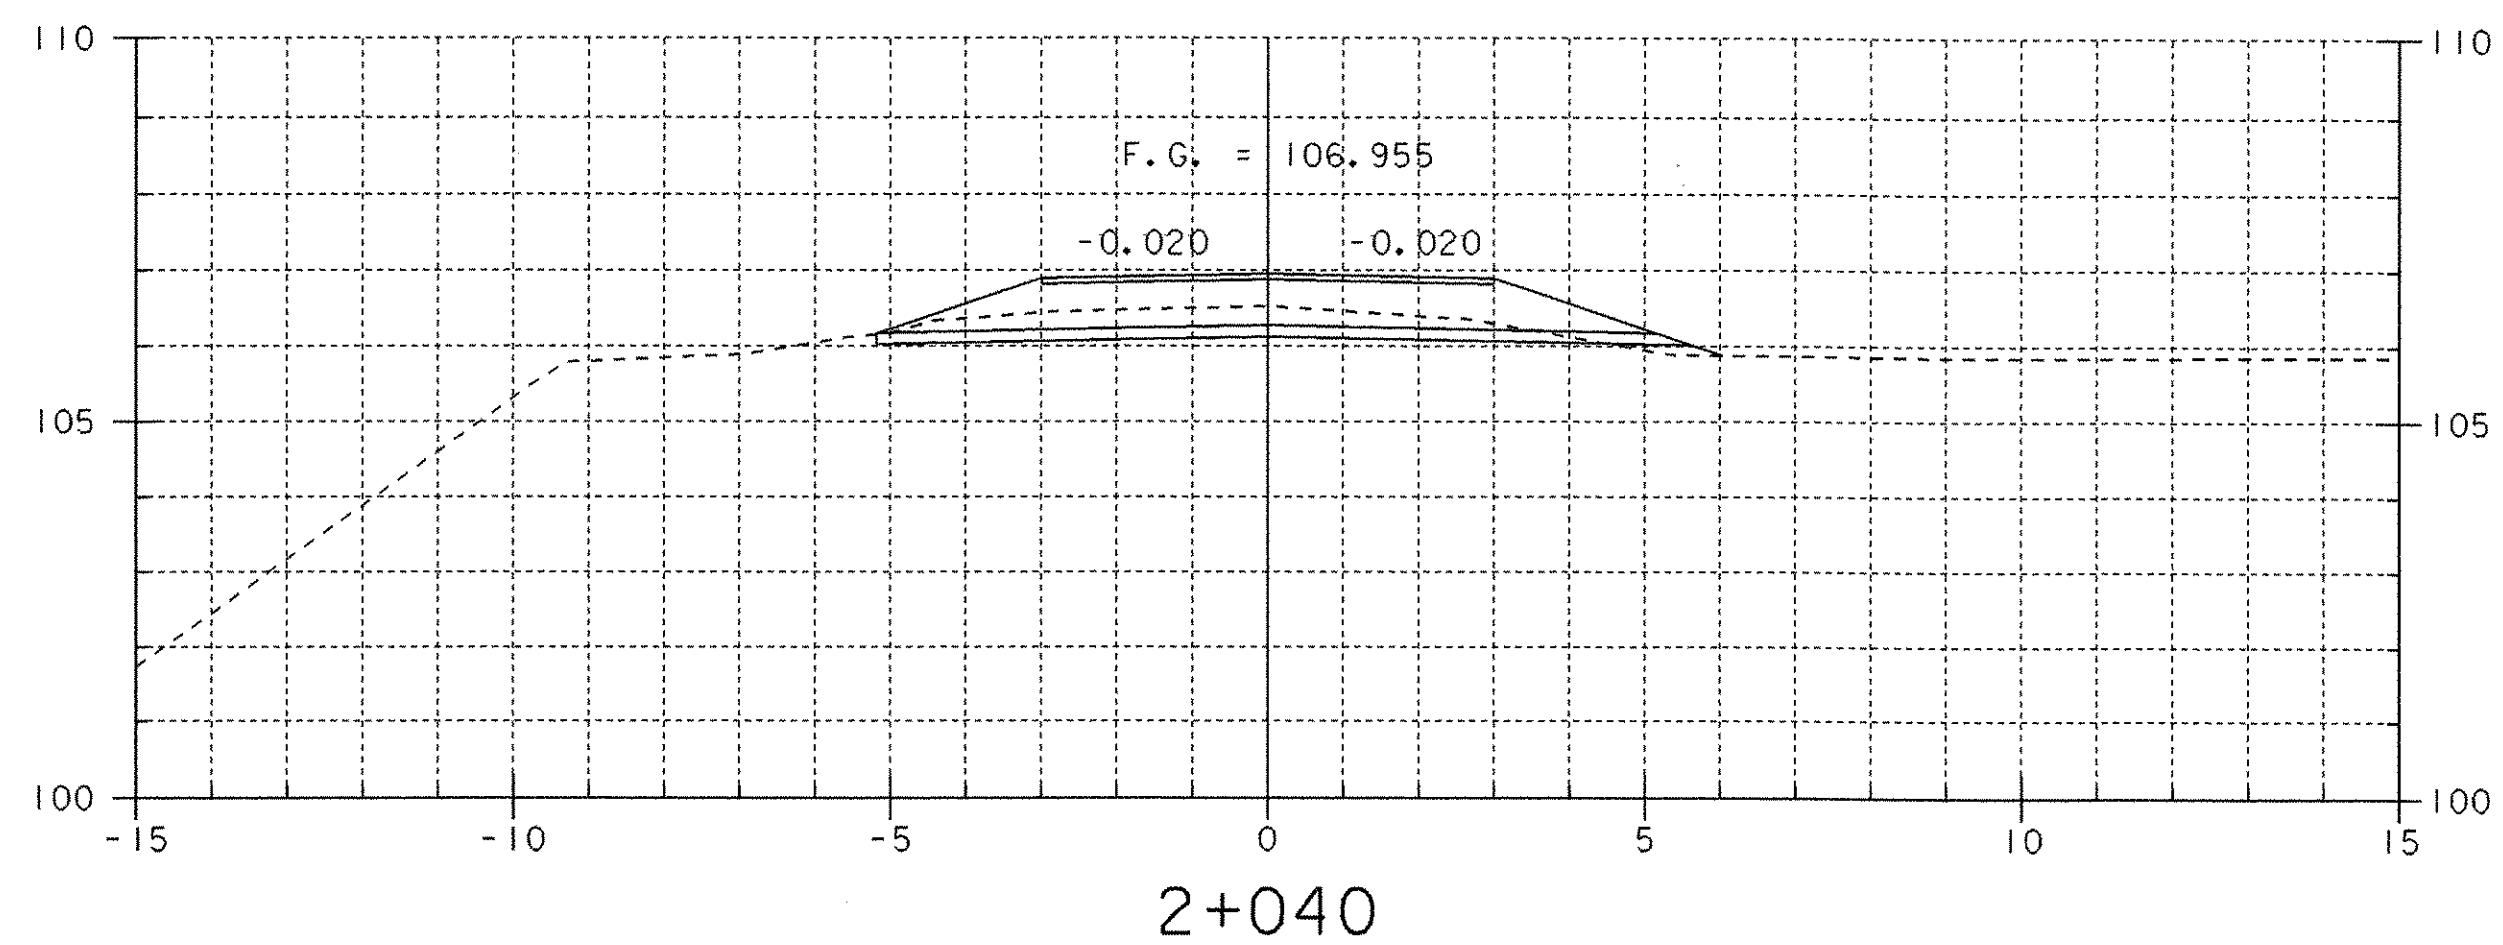


SHEET NAME: SIDELINE CROSS SECTIONS	
PROJECT NAME: LEICESTER	HIGHWAY NO.: FAS 0160
PROJECT NUMBER: BRF 0160(3)S	BRIDGE NO.: 6
	OVER: OTTER CREEK
FILE NAME: 95J288\Structures\sj288xsl.dgn	PLOT DATE: 17-AUG-2005
PROJECT MANAGER: R. R. WHITCOMB	DRAWN BY: J. GILMORE
DESIGNED BY: C. CARLSON	IPARM NAME: sj088sx3.1
	SHEET 82 OF 90

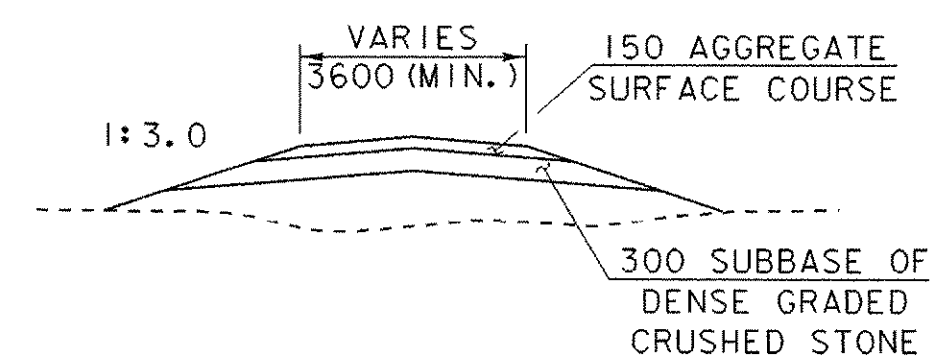


DRIVE TYPICAL
N. T. S.

STA 9+023.500
END FIELD DRIVE
MATCH EXISTING

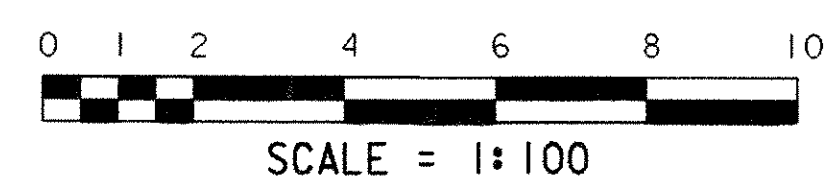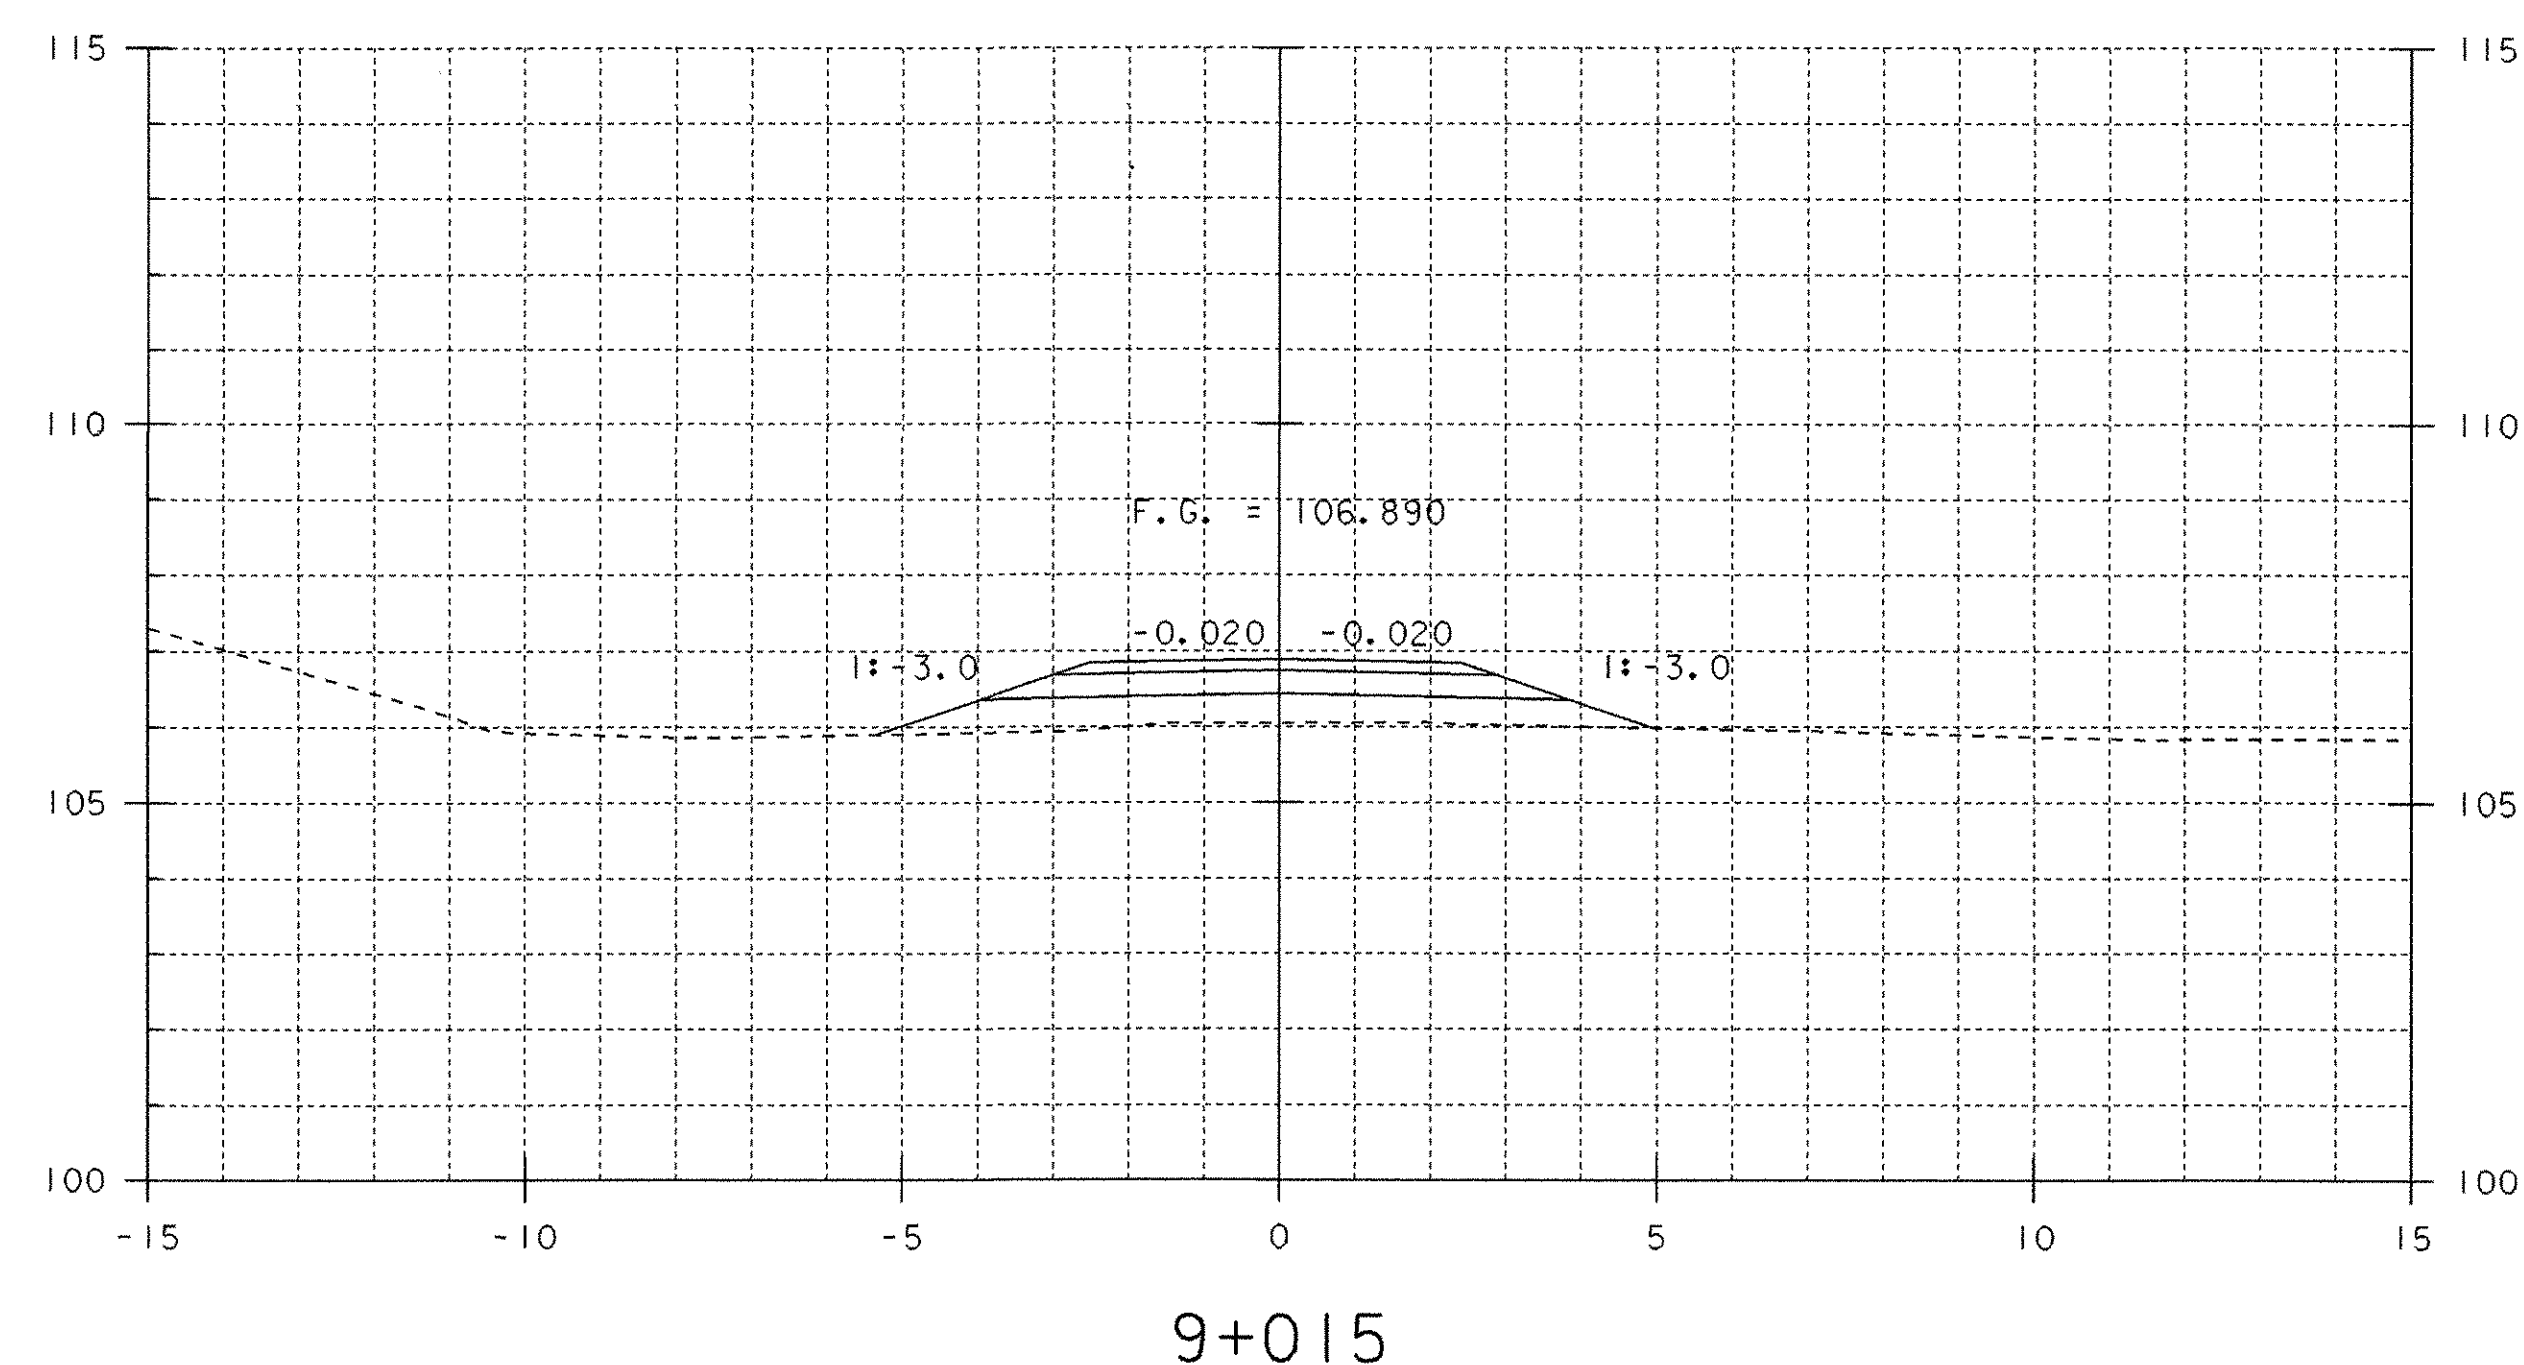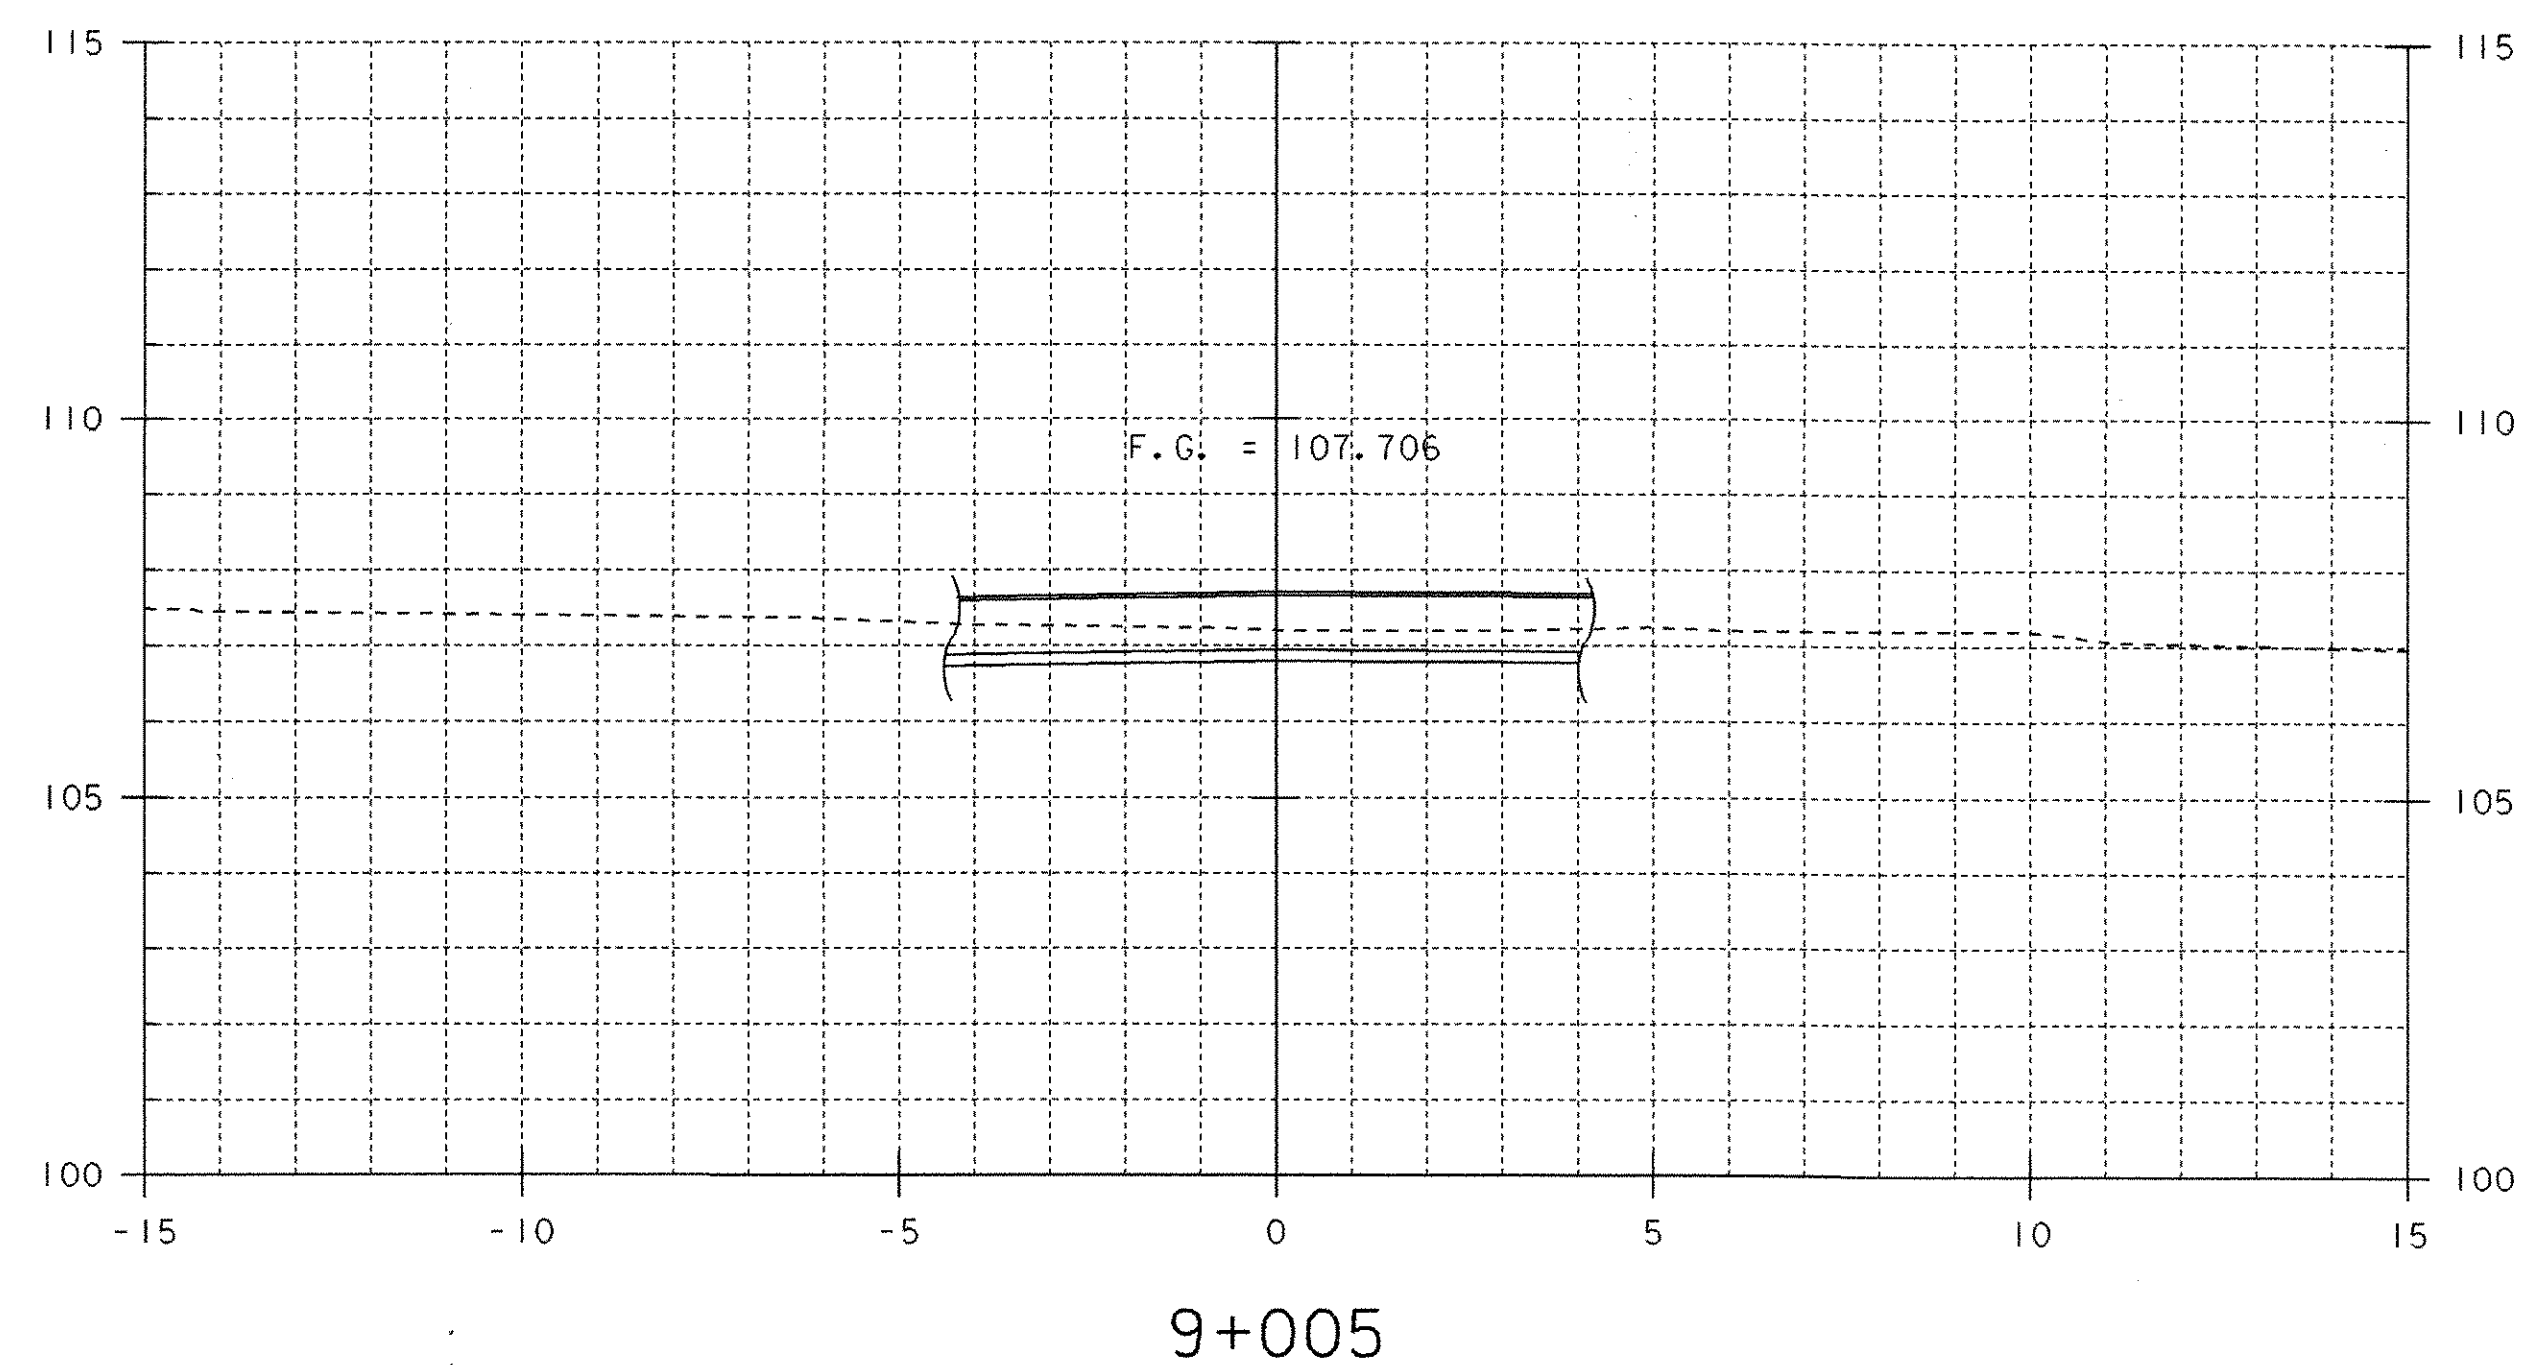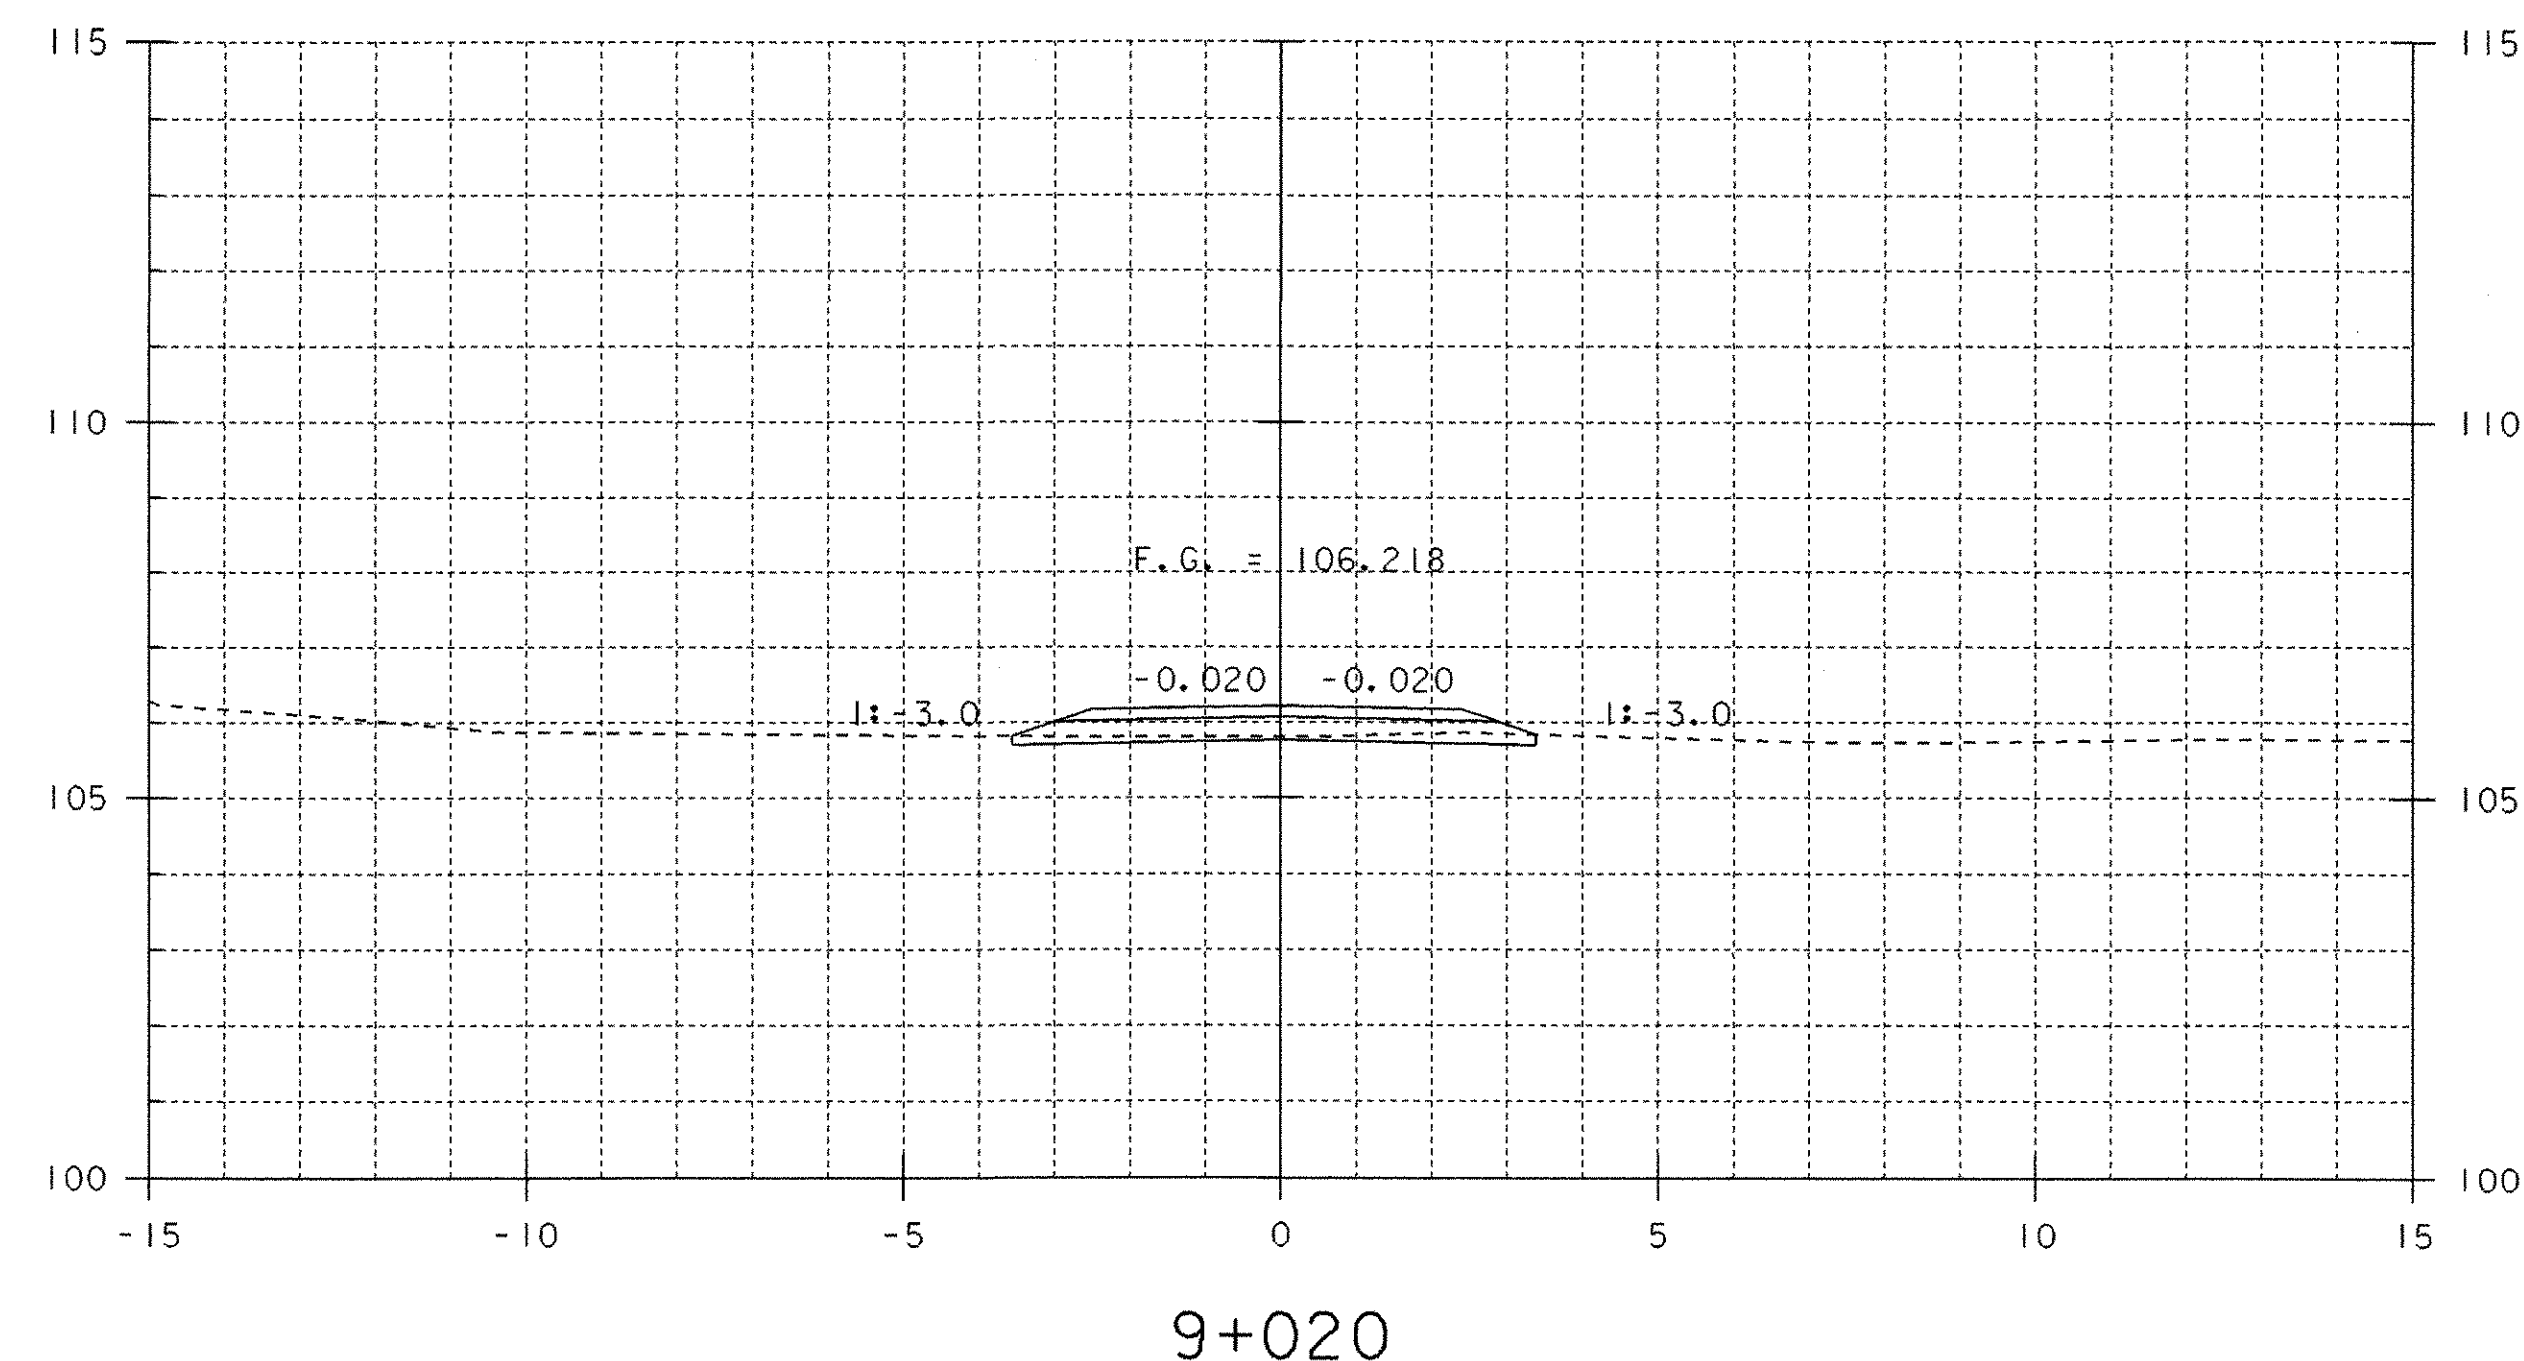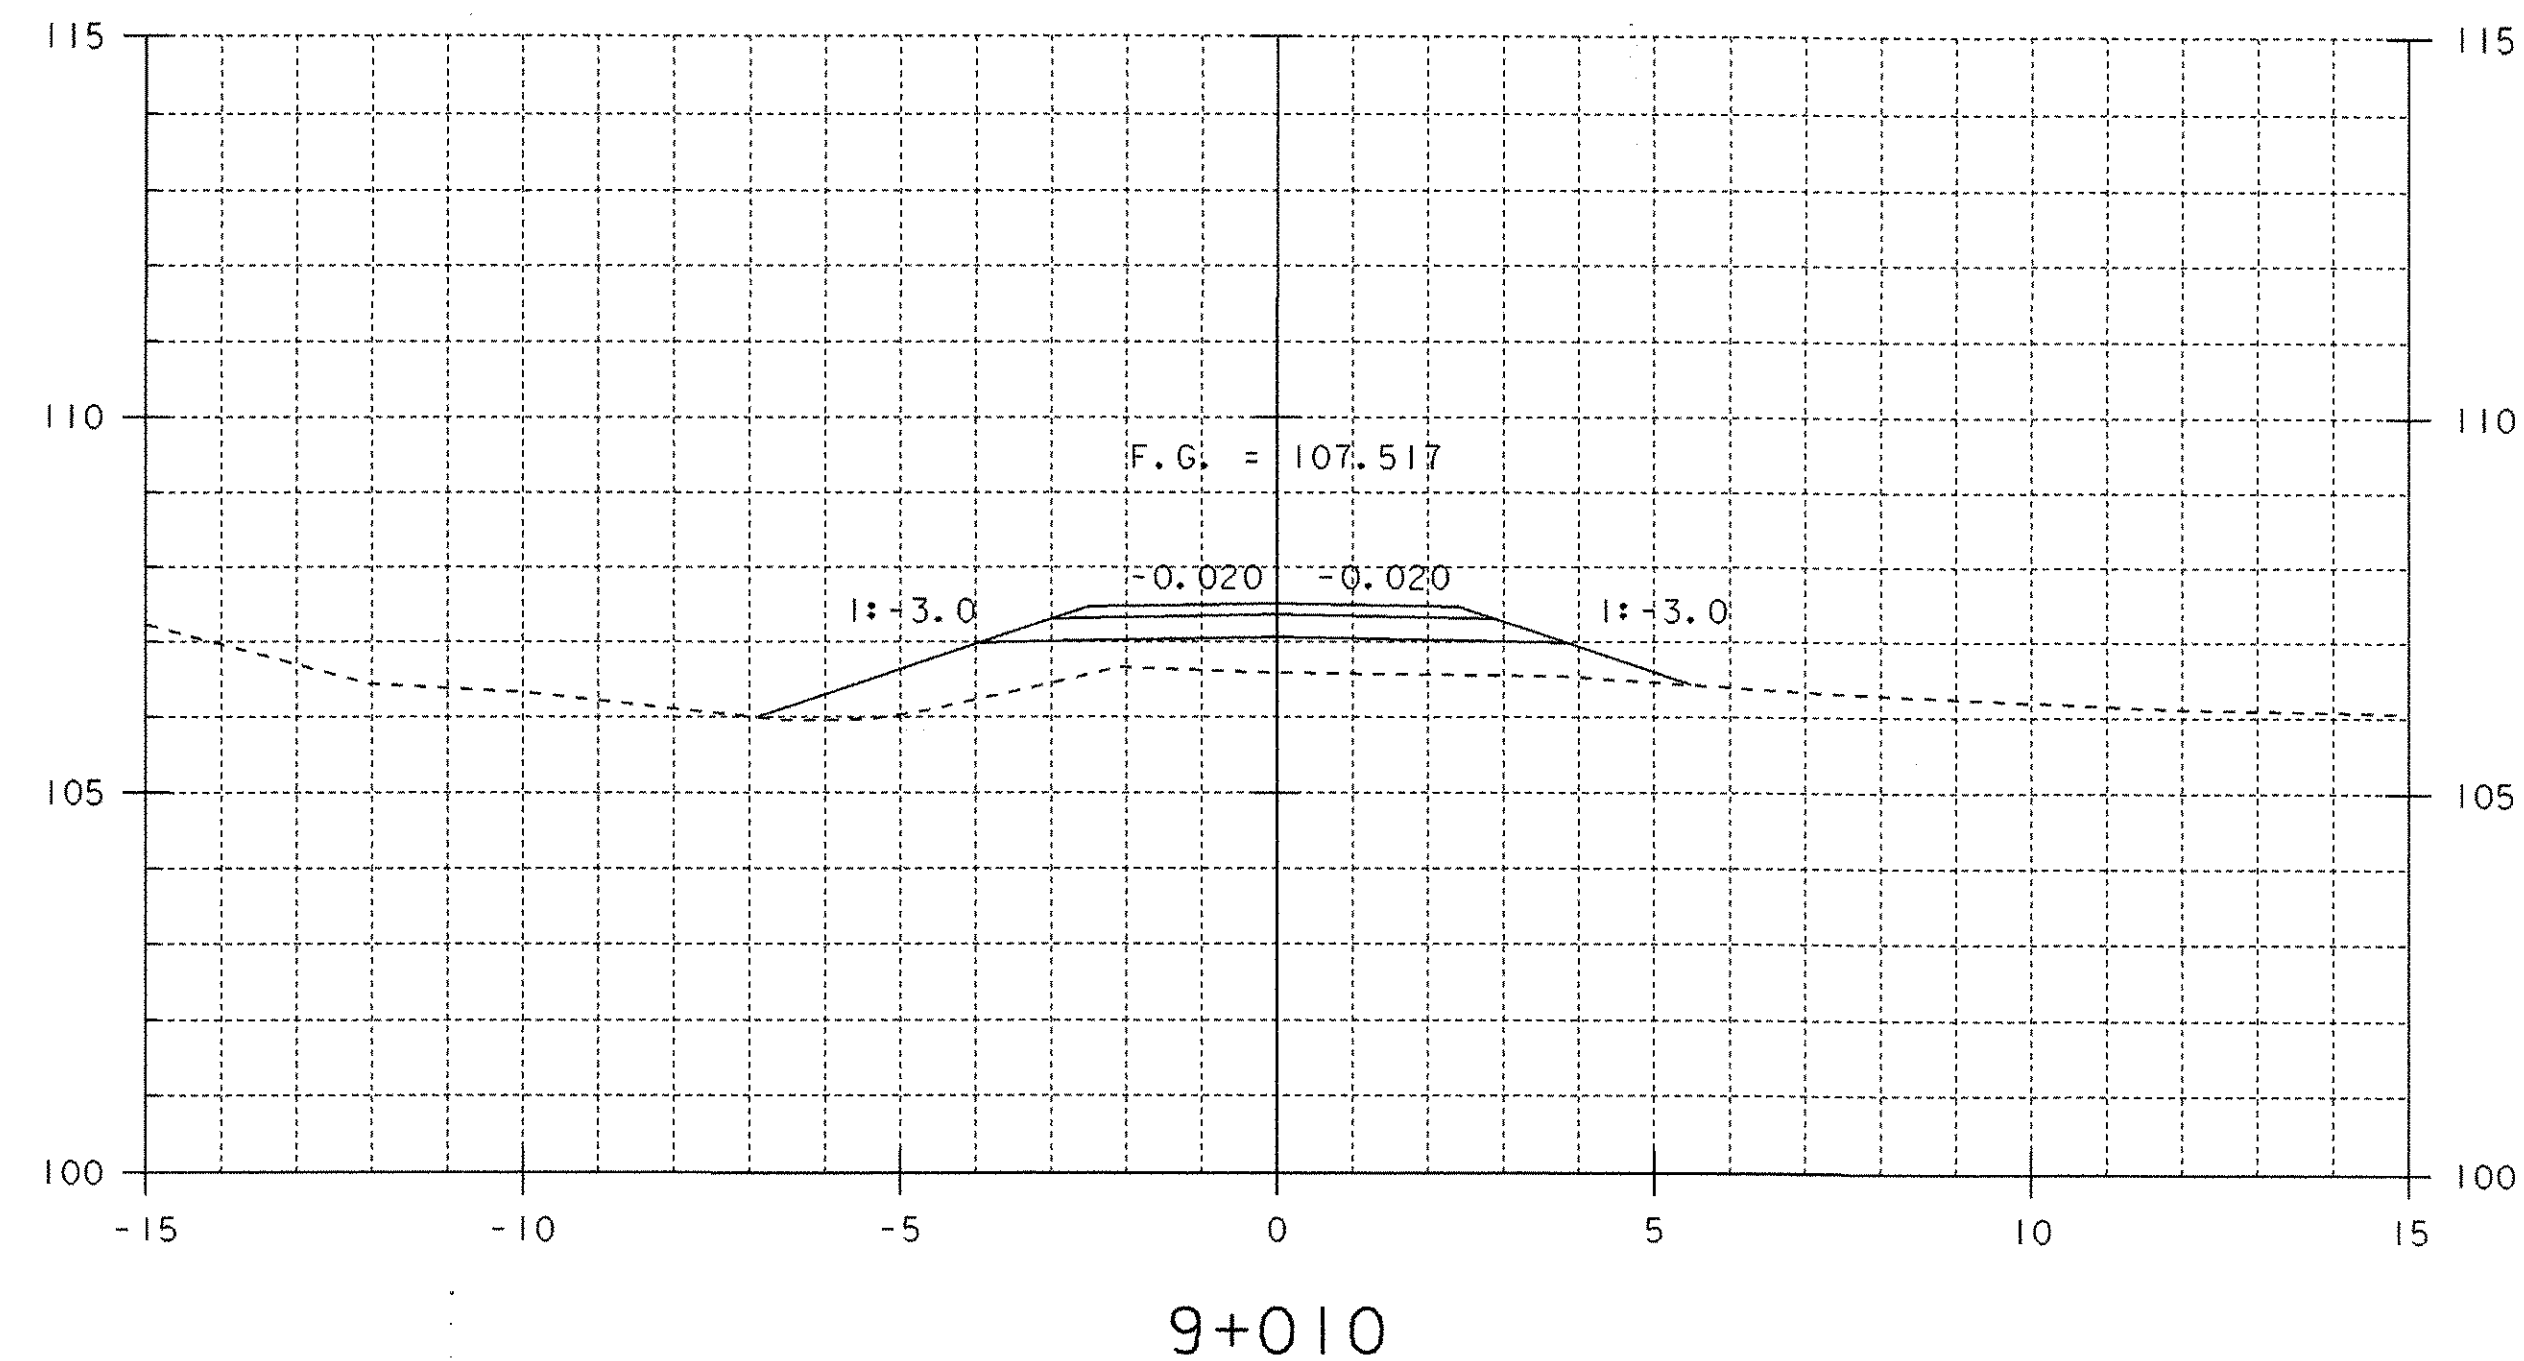


SHEET NAME: FIELD DRIVE CROSS SECTIONS	
PROJECT NAME: LEICESTER	HIGHWAY NO.: FAS 0160
PROJECT NUMBER: BRF 0160(3)S	BRIDGE NO.: 6
	OVER: OTTER CREEK
FILE NAME: 95j288\Structures\sj288xsl.dgn	PLOT DATE: 17-AUG-2005
PROJECT MANAGER: R. R. WHITCOMB	DRAWN BY: J. GILMORE
DESIGNED BY: C. CARLSON	IPARM NAME: sj088fd4.1
	SHEET 83 OF 90

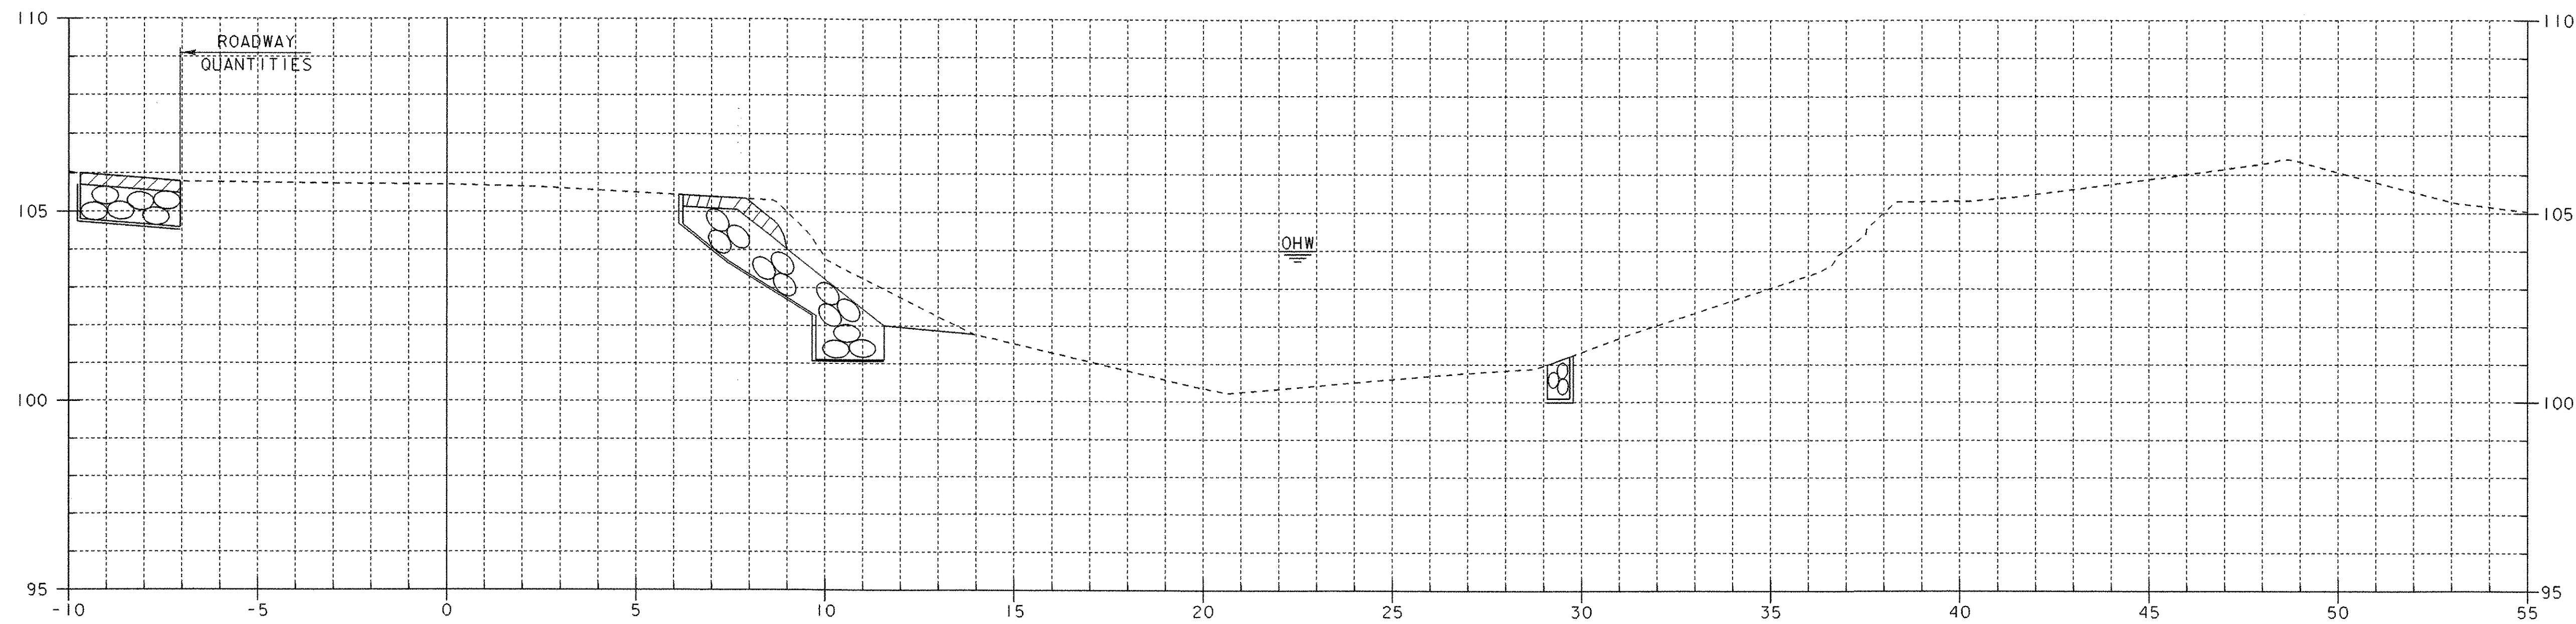


STA 5+019 RIGHT
 BEGIN UNCLASSIFIED CHANNEL EXCAVATION
 BEGIN GEOTEXTILE UNDER STONE FILL
 BEGIN STONE FILL, TYPE III
 BEGIN GRUBBING MATERIAL

STA 5+020 FAR RIGHT
 BEGIN UNCLASSIFIED CHANNEL EXCAVATION
 BEGIN GEOTEXTILE UNDER STONE FILL
 BEGIN STONE FILL, TYPE III



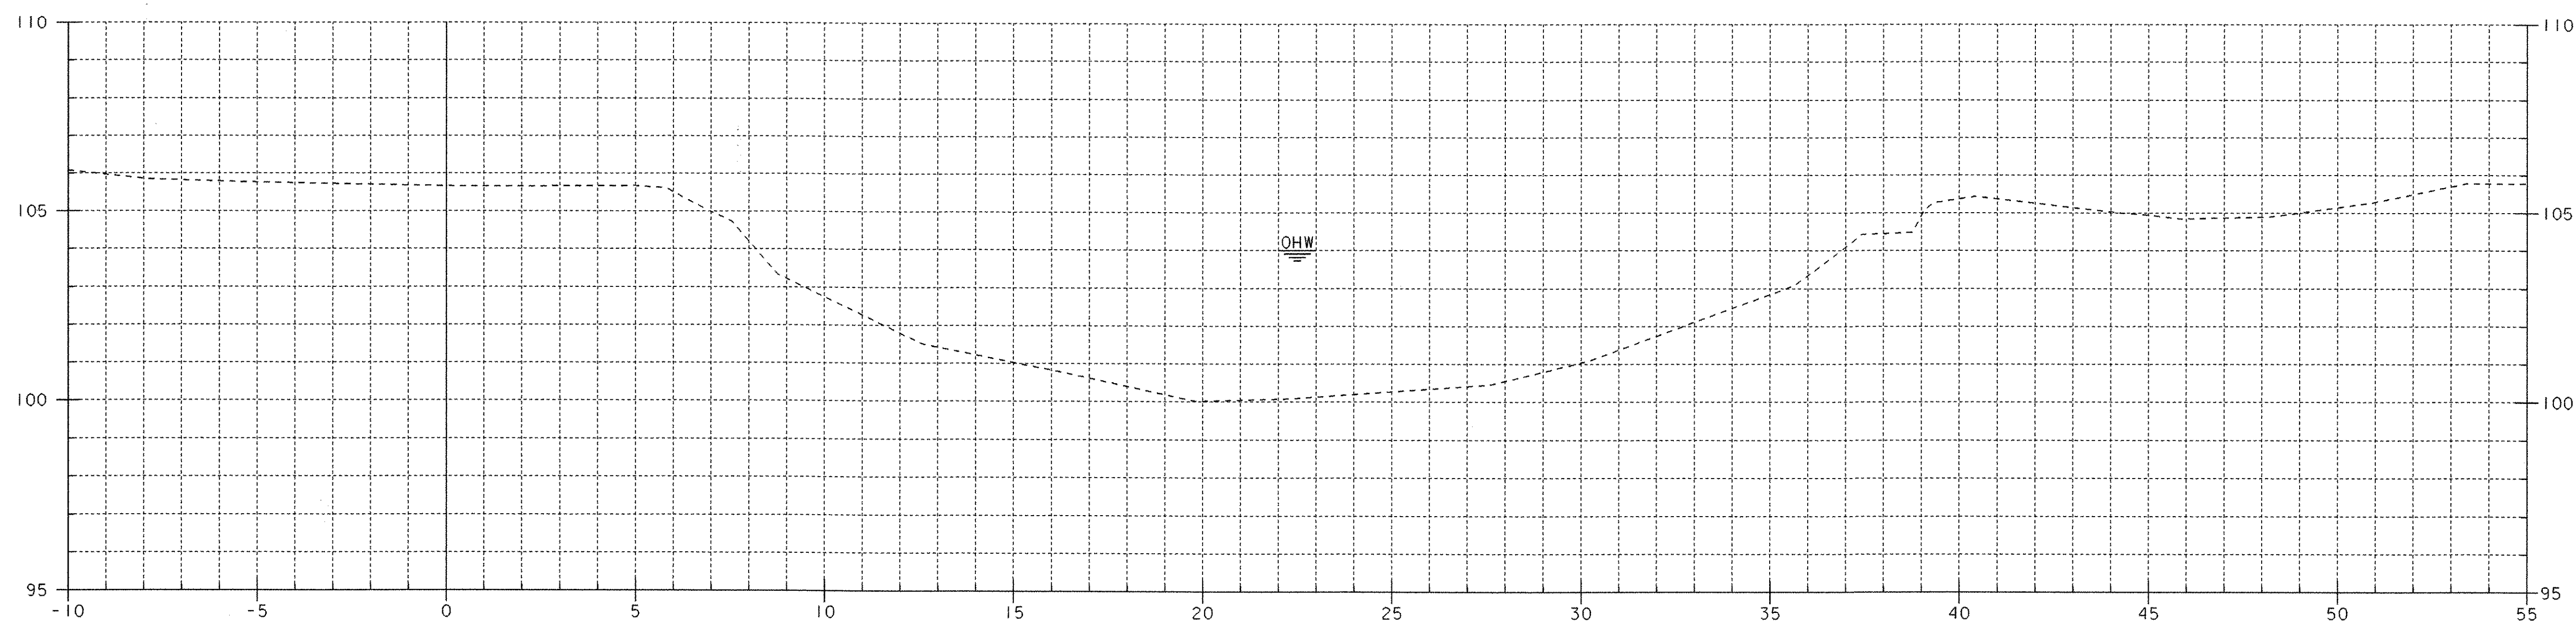


5+015

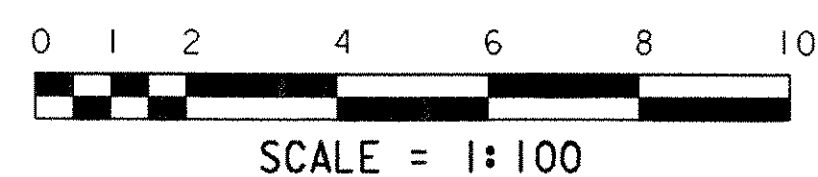

SHEET NAME: CHANNEL CROSS SECTIONS	
PROJECT NAME: LEICESTER	HIGHWAY NO.: FAS 0160
PROJECT NUMBER: BRF 0160(3)S	BRIDGE NO.: 6
	OVER: OTTER CREEK
FILE NAME: 95J288\Structures\sj288xsl.dgn	PLOT DATE: 17-AUG-2005
PROJECT MANAGER: R. R. WHITCOMB	DRAWN BY: J. GILMORE
DESIGNED BY: C. CARLSON	IPARM NAME: sj088cx3.1
	SHEET 84 OF 90




PIERS REMOVED TO NEAR STREAMBED ELEVATION
& FOOTINGS LEFT IN PLACE AS A STONE FILL "KEY"

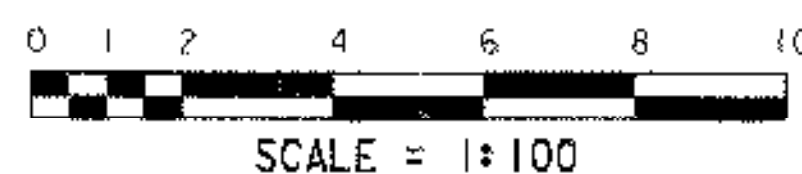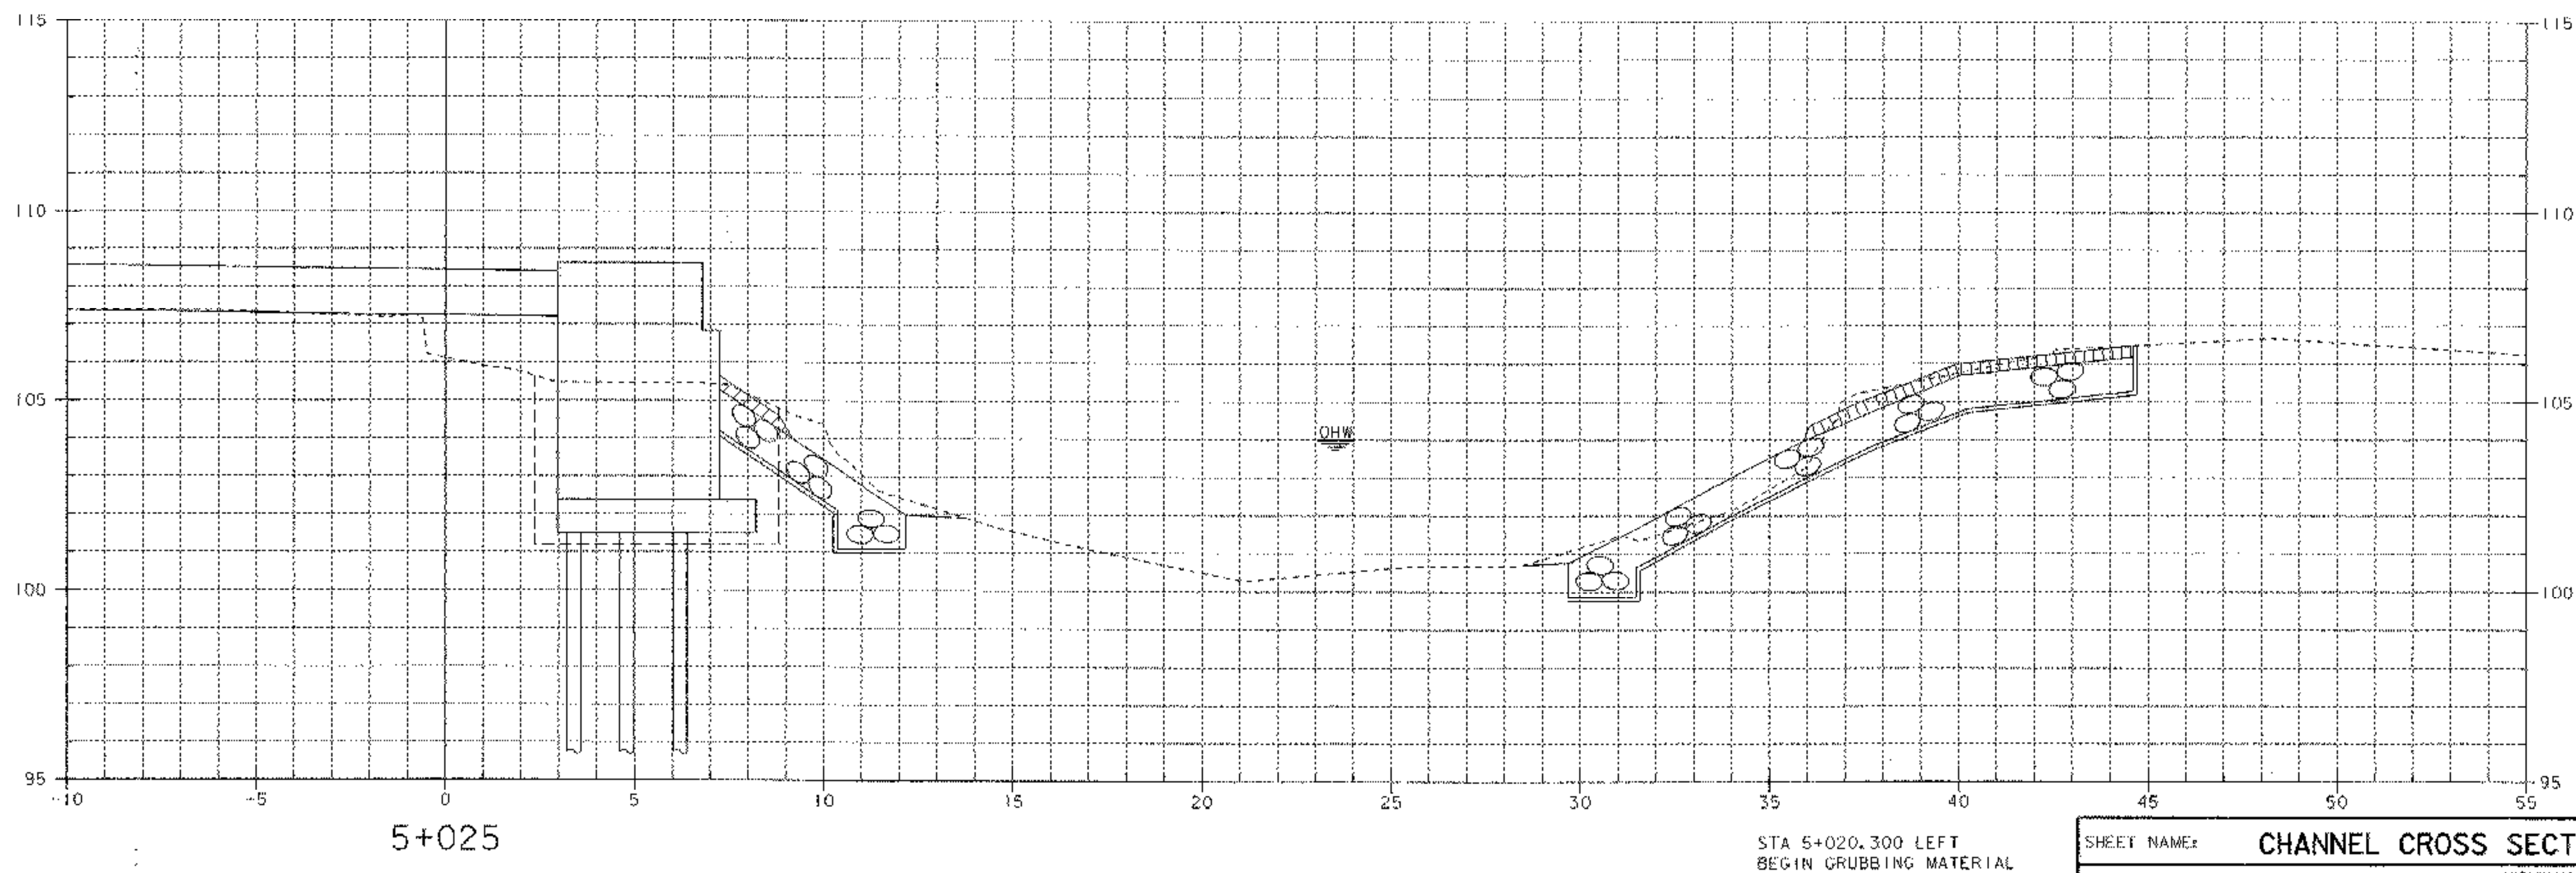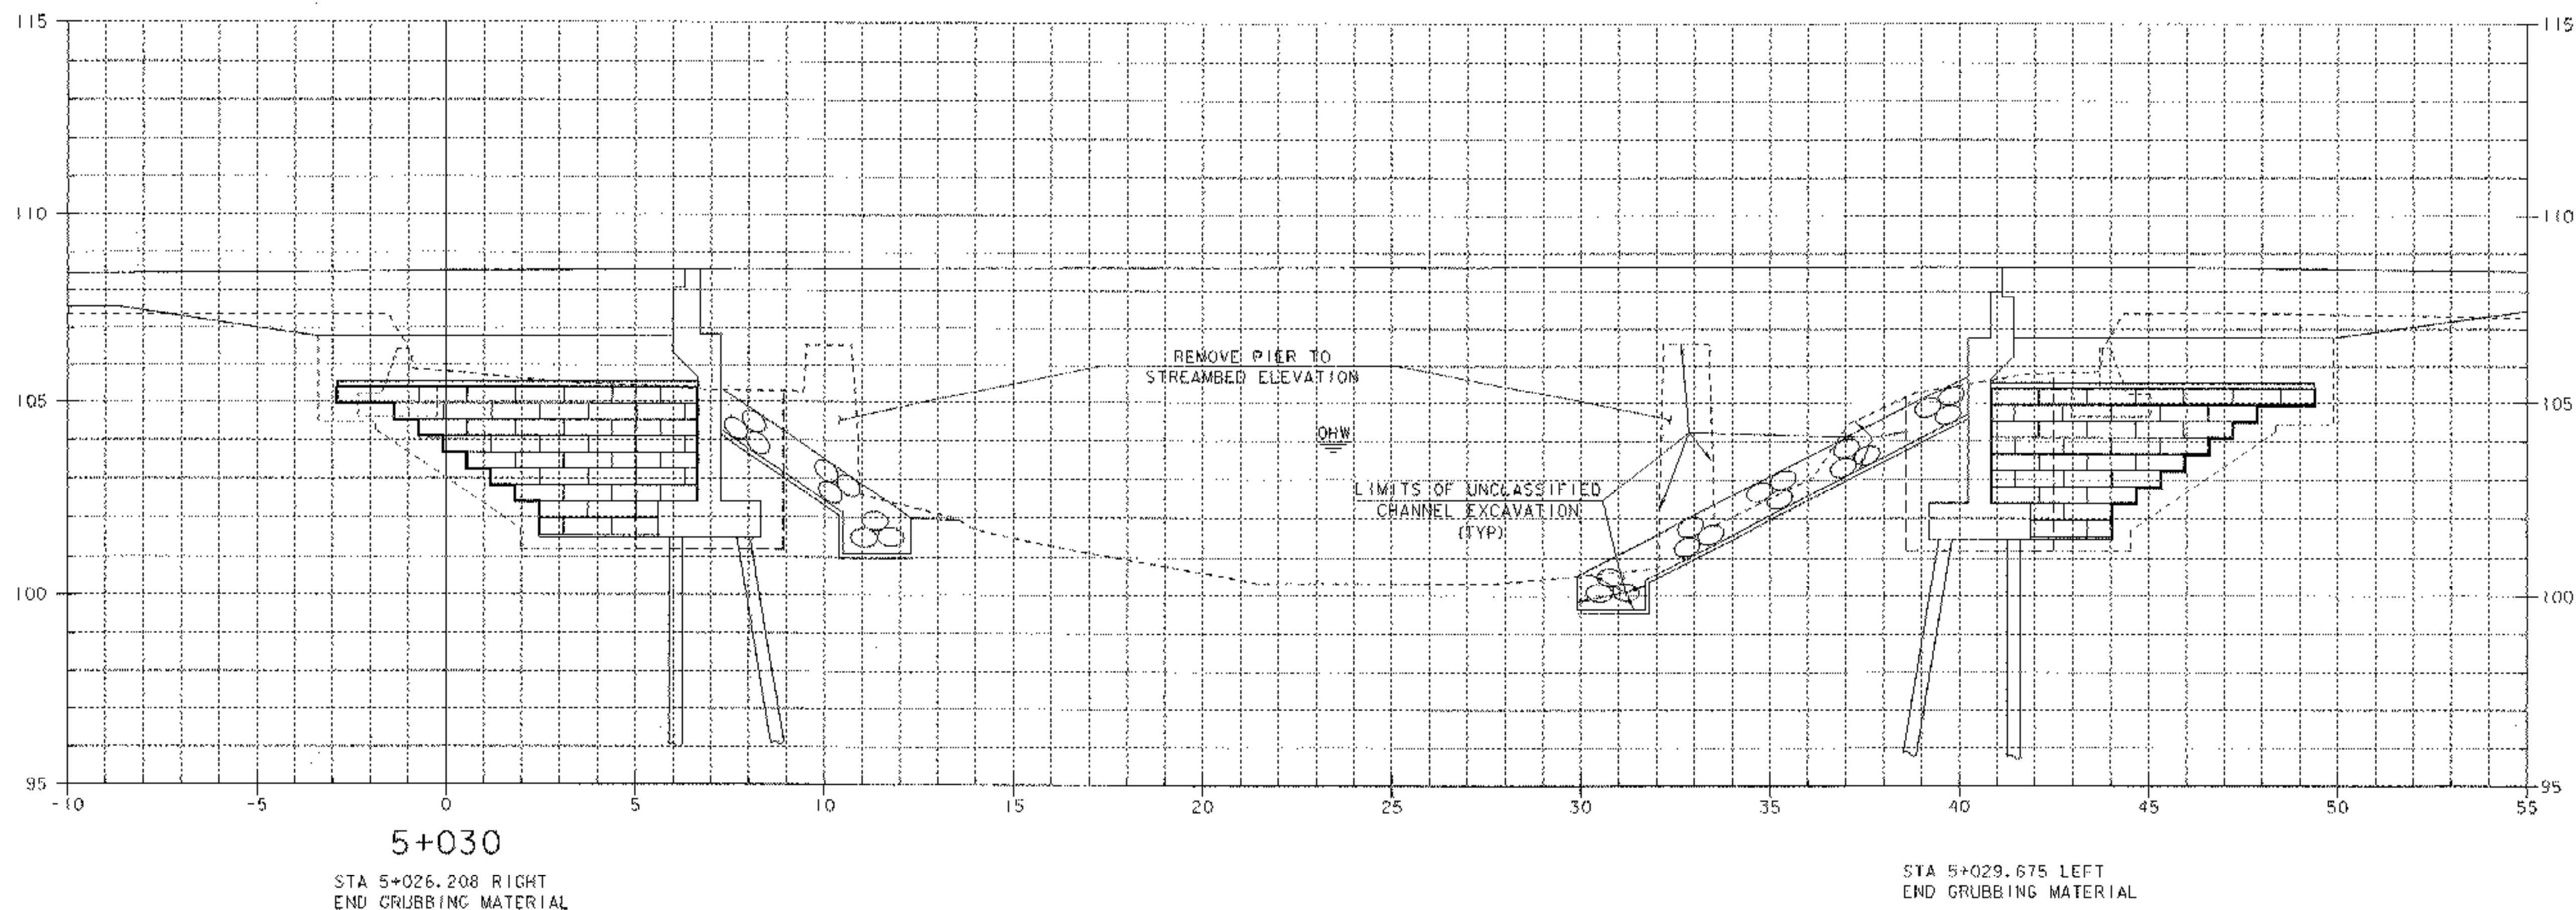




SHEET NAME: CHANNEL CROSS SECTIONS	
PROJECT NAME: LEICESTER	HIGHWAY NO.: FAS 0160
PROJECT NUMBER: BRF 0160(3)S	BRIDGE NO.: 6
	OVER: OTTER CREEK
FILE NAME: 95\208\Structures\sl\208xsl.dgn	PLOT DATE: 17-AUG-2005
PROJECT MANAGER: R. R. WHITCOMB	DRAWN BY: J. GILMORE
DESIGNED BY: C. CARLSON	IPARM NAME: s\088cx4.1
	SHEET 85 OF 90

STA 5+044.016 RIGHT
 END UNCLASSIFIED CHANNEL EXCAVATION
 END GEOTEXTILE UNDER STONE FILL
 END STONE FILL, TYPE III
 END GRUBBING MATERIAL




STA 5+043.763 FAR RIGHT (CHANNEL)
 END UNCLASSIFIED CHANNEL EXCAVATION
 END GEOTEXTILE UNDER STONE FILL
 END STONE FILL, TYPE III
 END GRUBBING MATERIAL

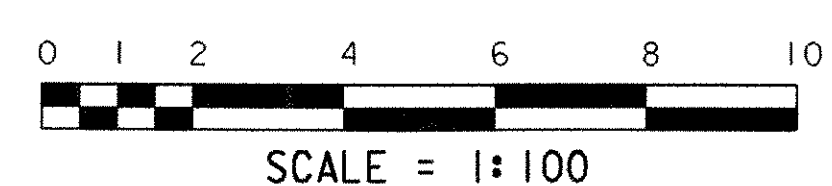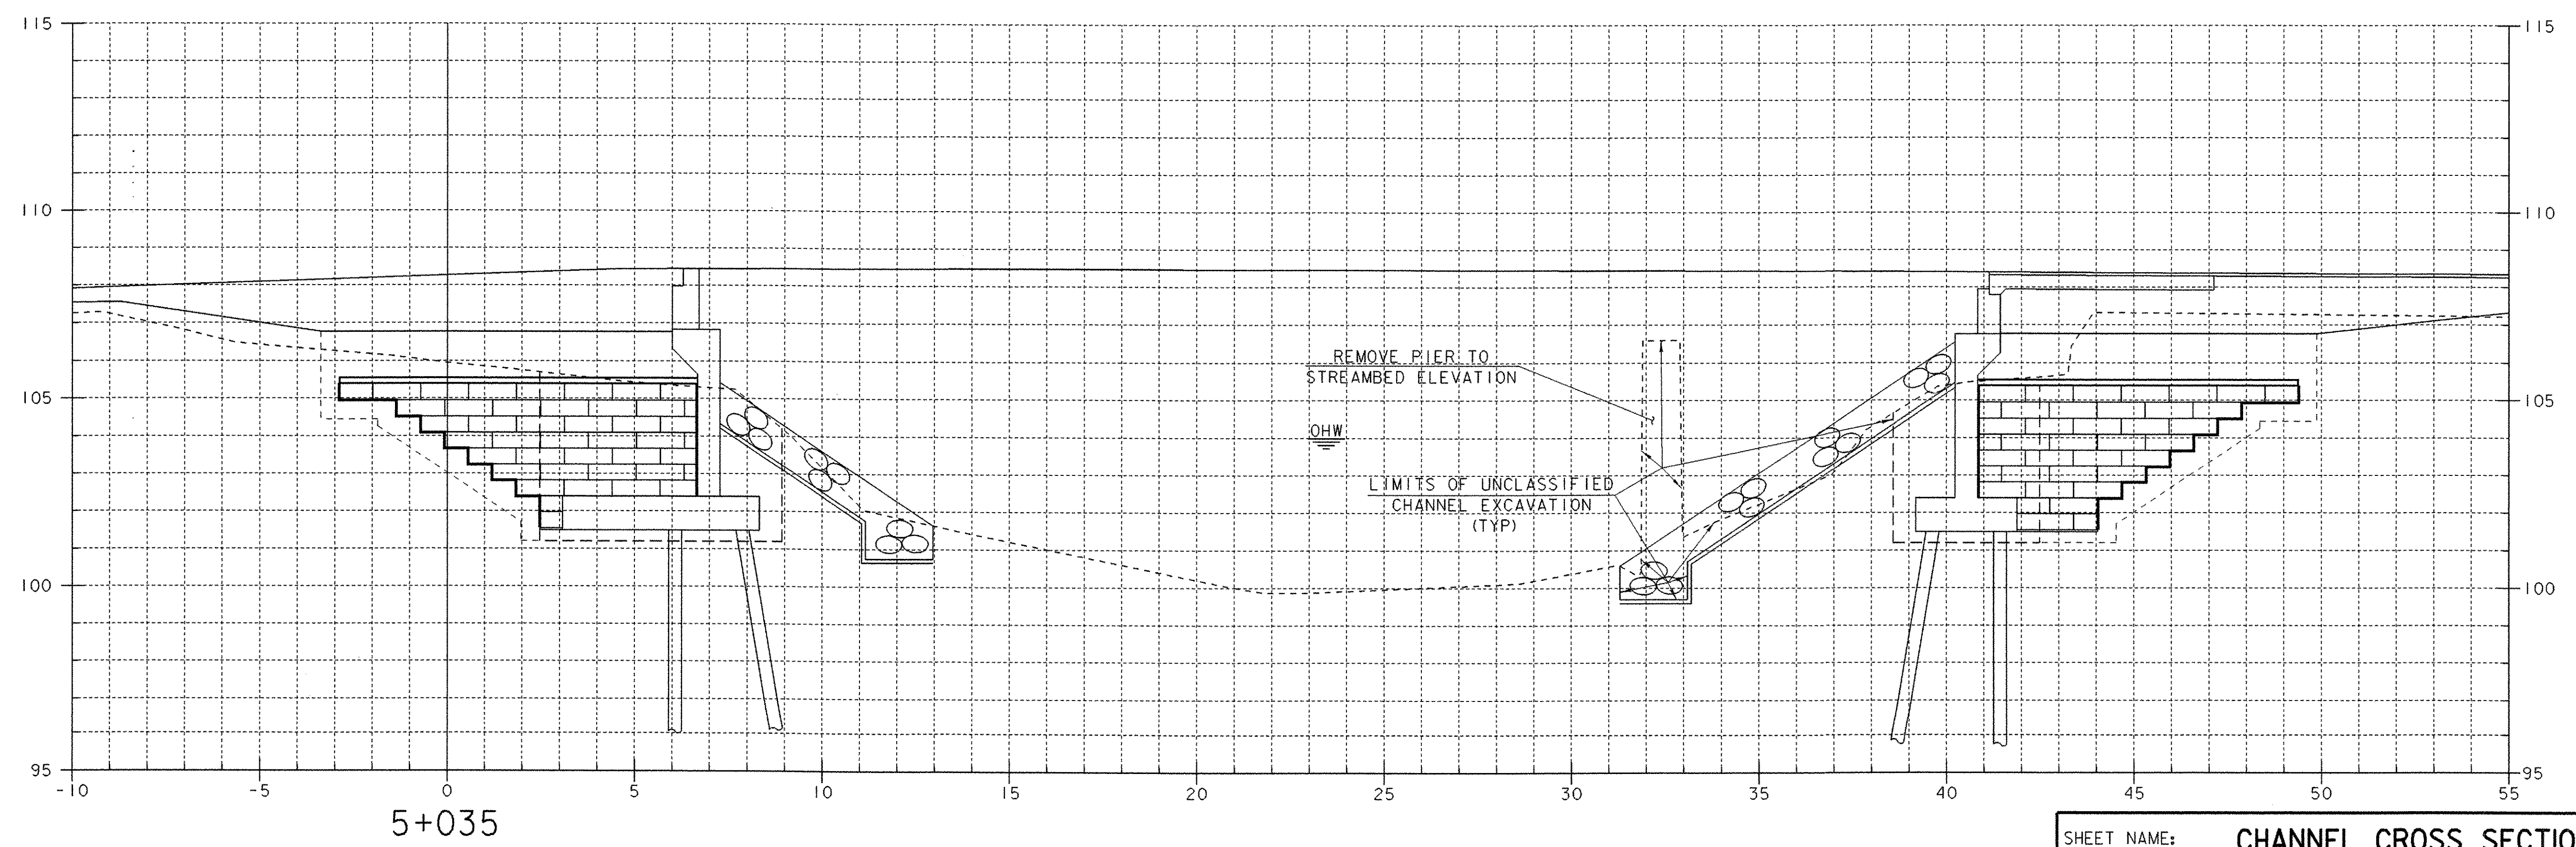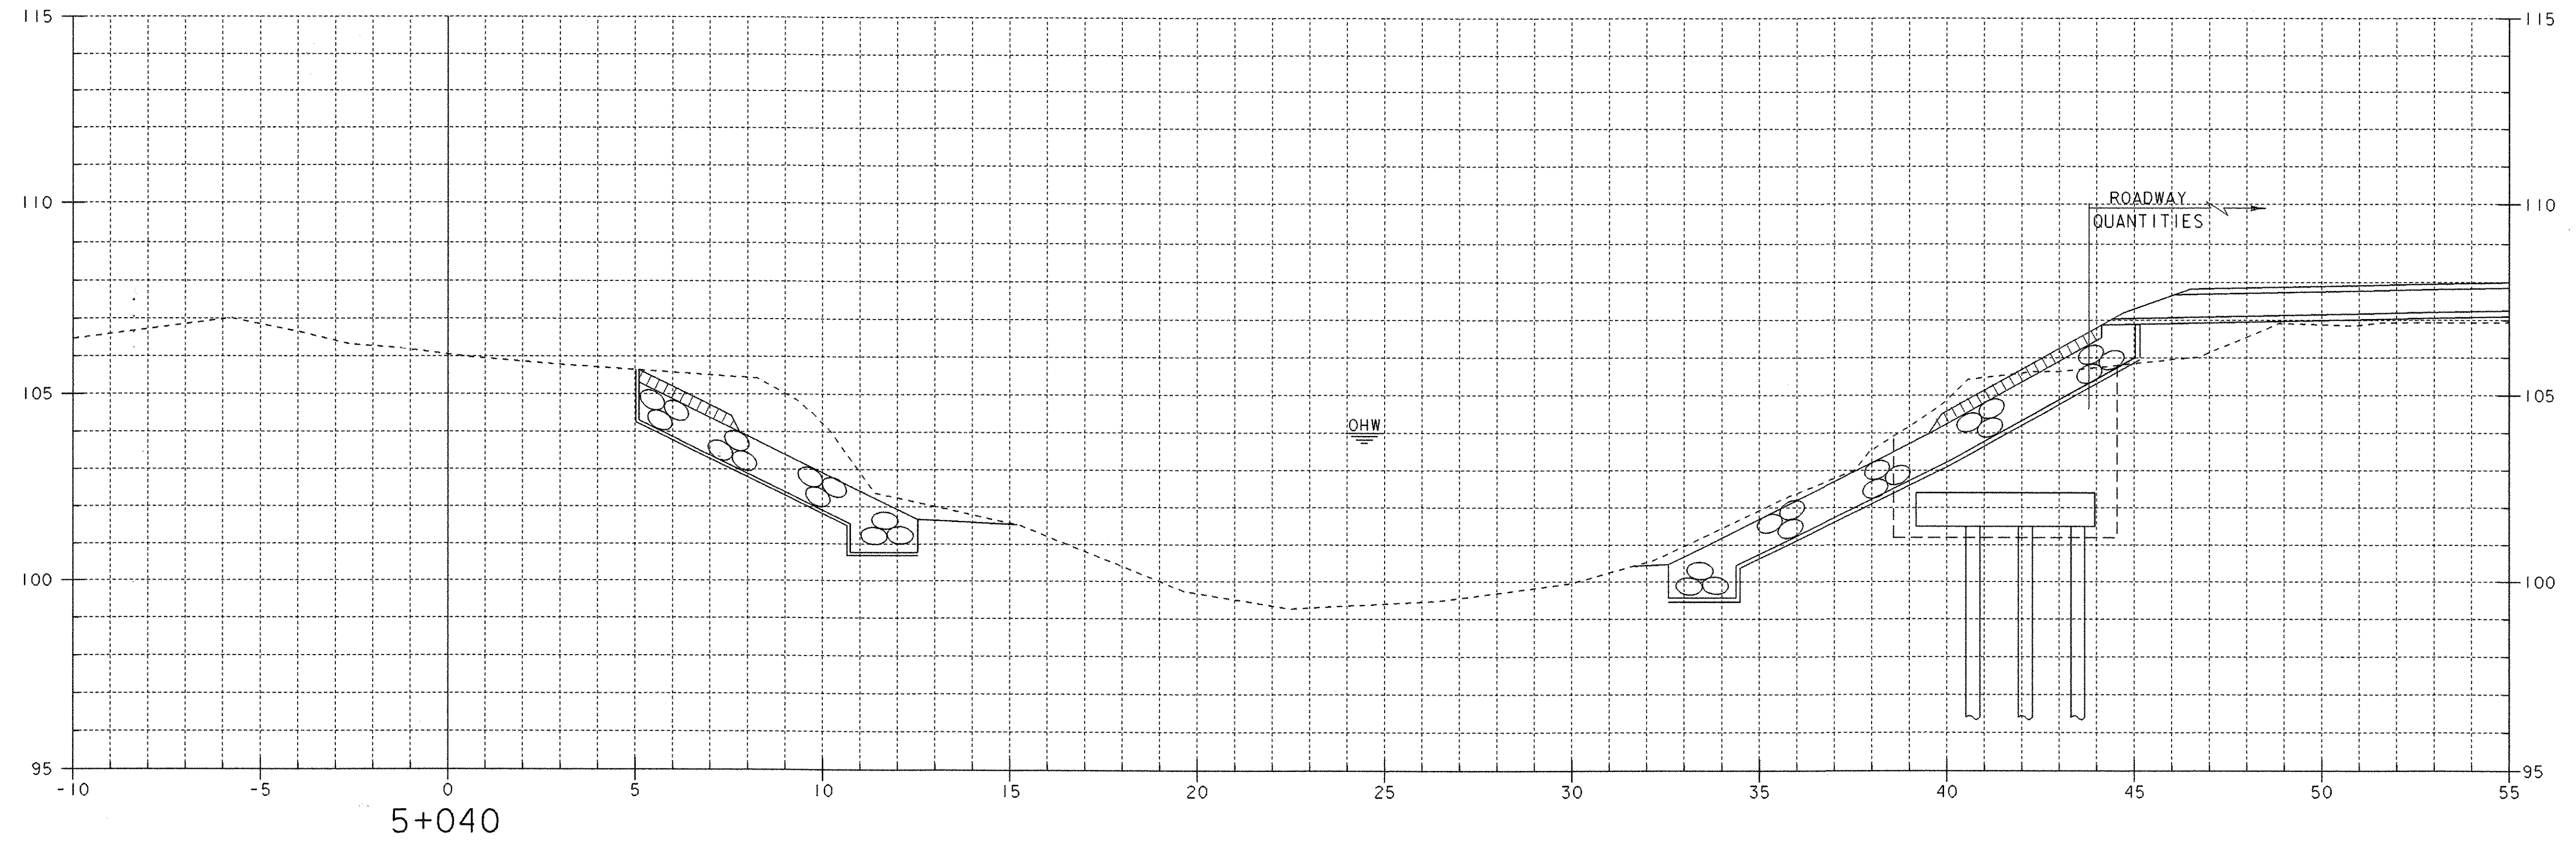


SHEET NAME: CHANNEL CROSS SECTIONS	
PROJECT NAME: LEICESTER	HIGHWAY NO.: FAS 0160
PROJECT NUMBER: BRF 0160(3)S	BRIDGE NO.: 6
	OVER: OTTER CREEK
FILE NAME: 95J288\Structures\sj288xsl.dgn	PLOT DATE: 17-AUG-2005
PROJECT MANAGER: R. R. WHITCOMB	DRAWN BY: J. GILMORE
DESIGNED BY: C. CARLSON	IPARM NAME: sj088cx5.1
	SHEET 86 OF 90

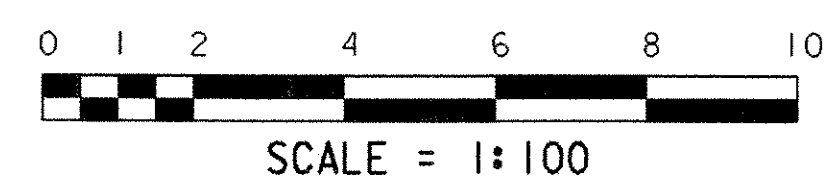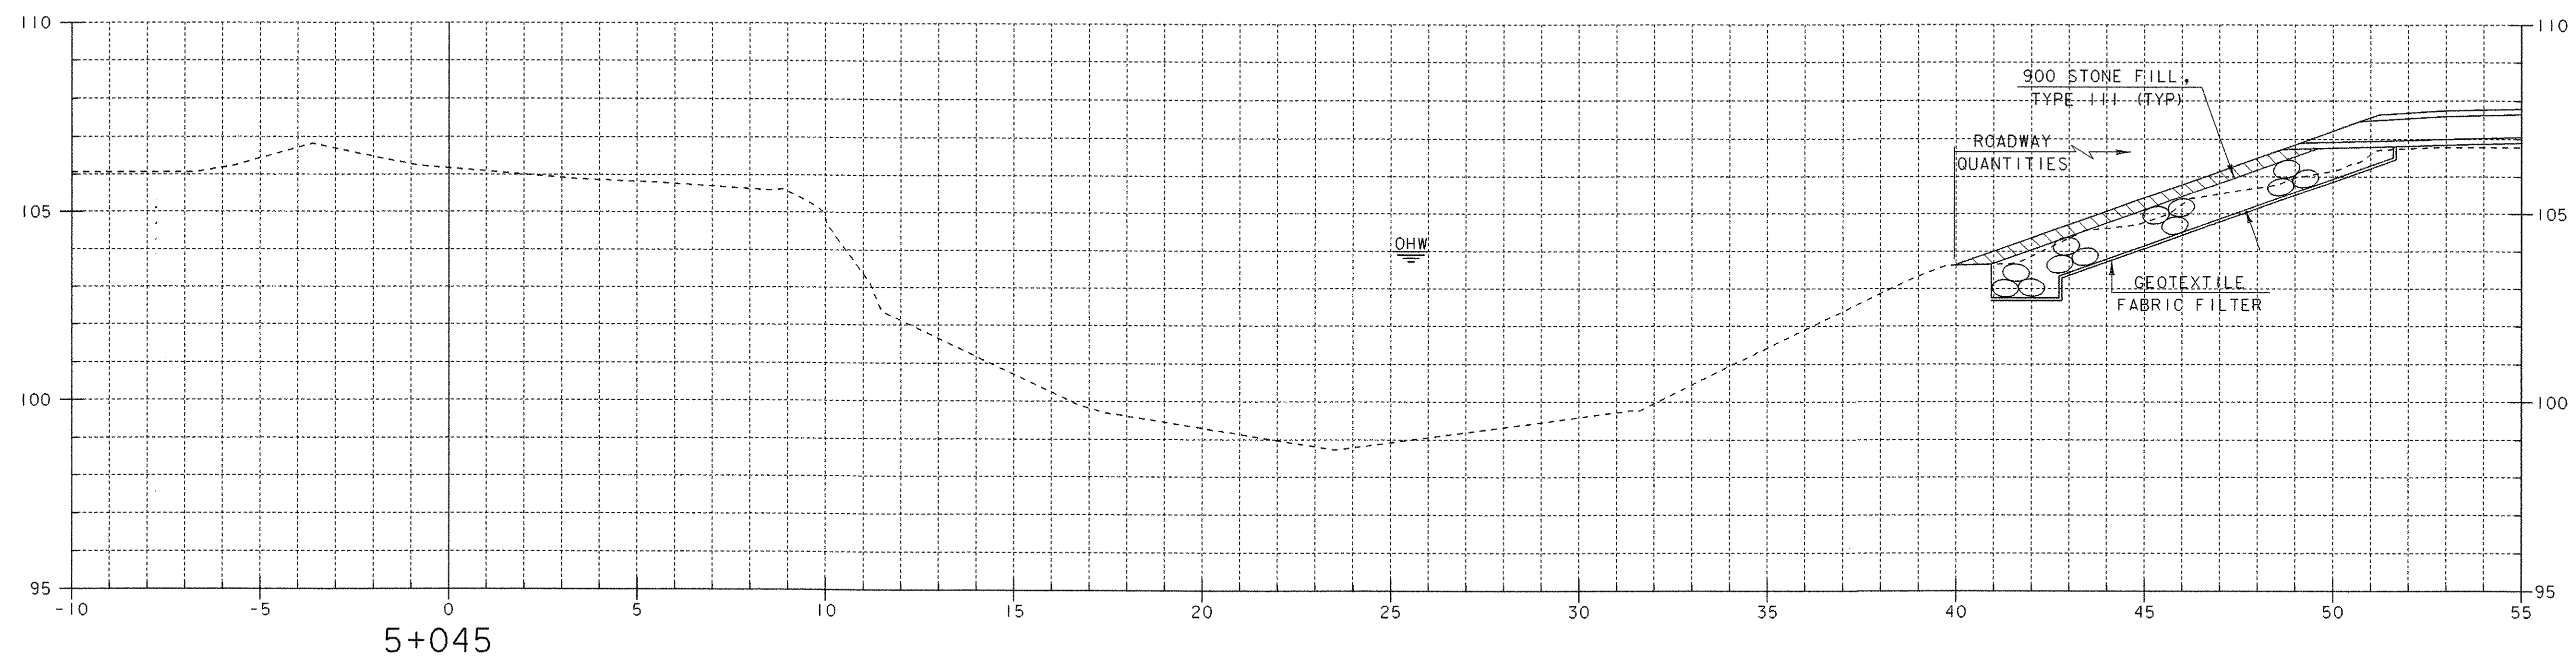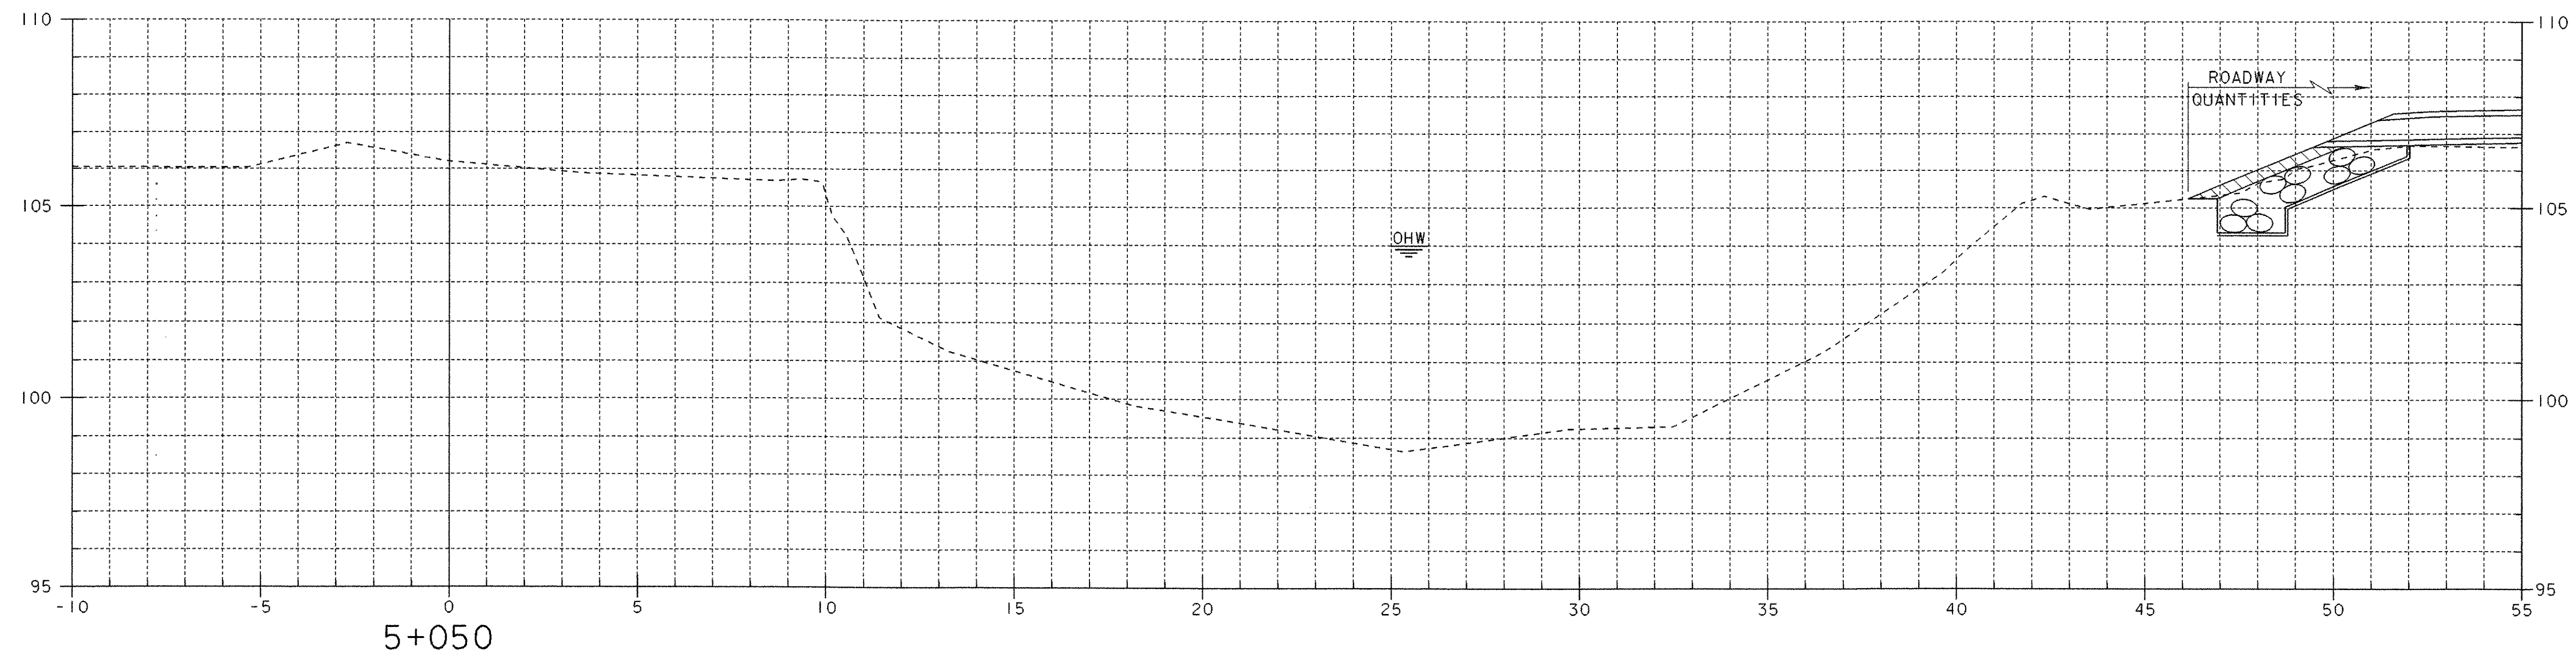

SHEET NAME: CHANNEL CROSS SECTIONS		
PROJECT NAME: LEICESTER	HIGHWAY NO.: FAS 0160	
PROJECT NUMBER: BRF 0160(3)S	BRIDGE NO.: 6	
	OVER: OTTER CREEK	
FILE NAME: 95j288\Structures\sj288xsl.dgn	PLOT DATE: 17-AUG-2005	
PROJECT MANAGER: R. R. WHITCOMB	DRAWN BY: J. GILMORE	
DESIGNED BY: C. CARLSON	IPARM NAME: sj088cx6.1	
	SHEET 87 OF 90	

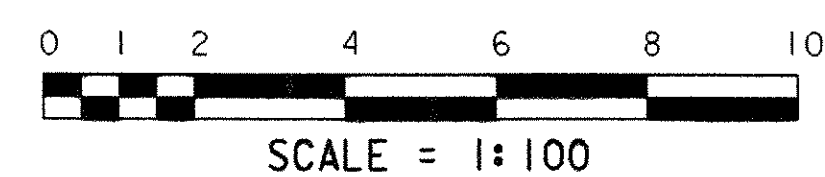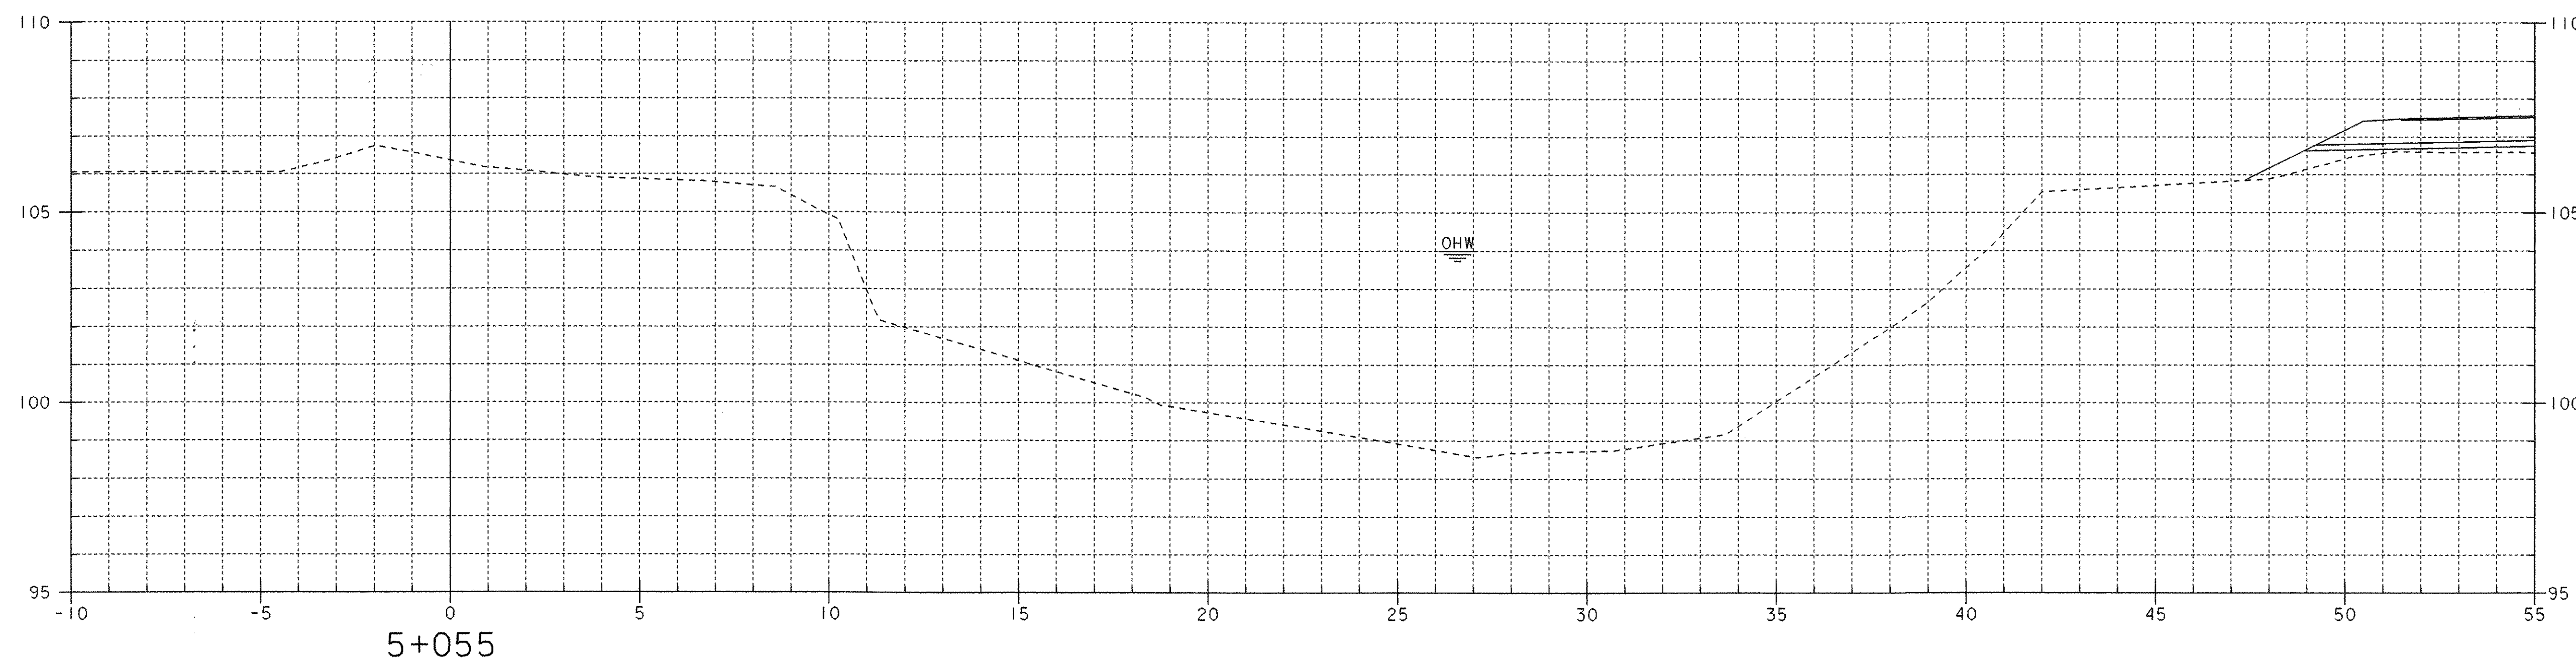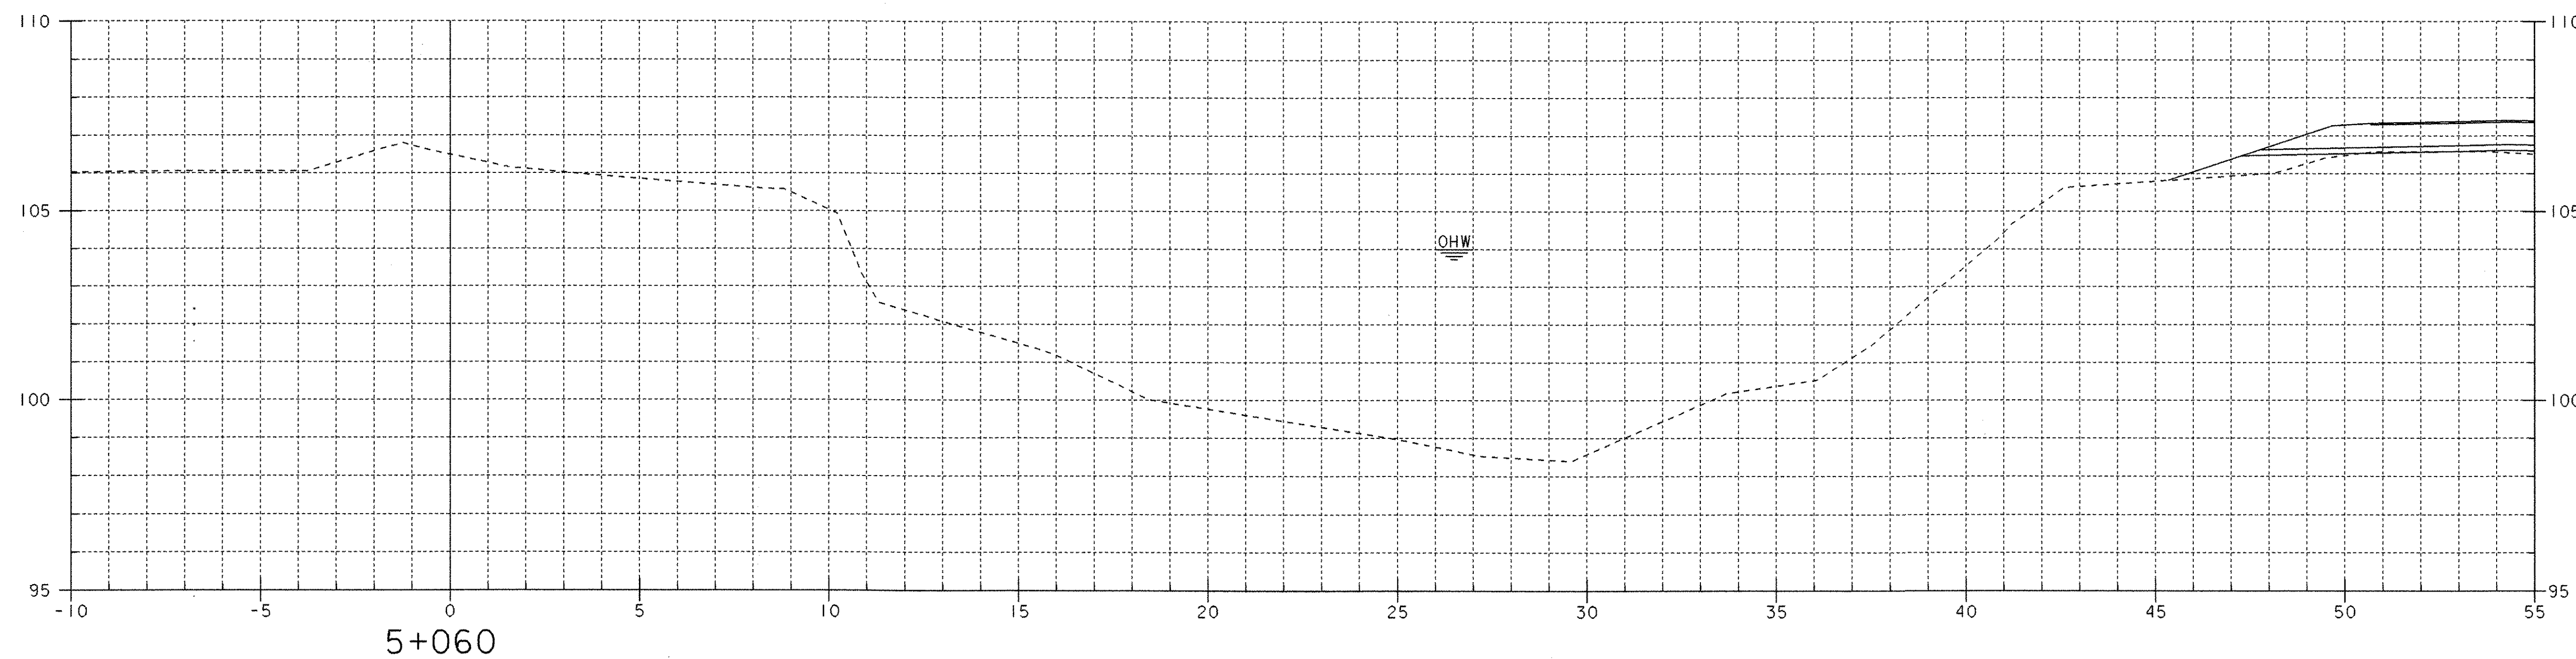

SHEET NAME: CHANNEL CROSS SECTIONS	
PROJECT NAME: LEICESTER	HIGHWAY NO.: FAS 0160
PROJECT NUMBER: BRF 0160(3)S	BRIDGE NO.: 6
	OVER: OTTER CREEK
FILE NAME: 95J288\Structures\sj288xsl.dgn	PLOT DATE: 17-AUG-2005
PROJECT MANAGER: R. R. WHITCOMB	DRAWN BY: J. GILMORE
DESIGNED BY: C. CARLSON	IPARM NAME: sj088cx7.1
	SHEET 88 OF 90

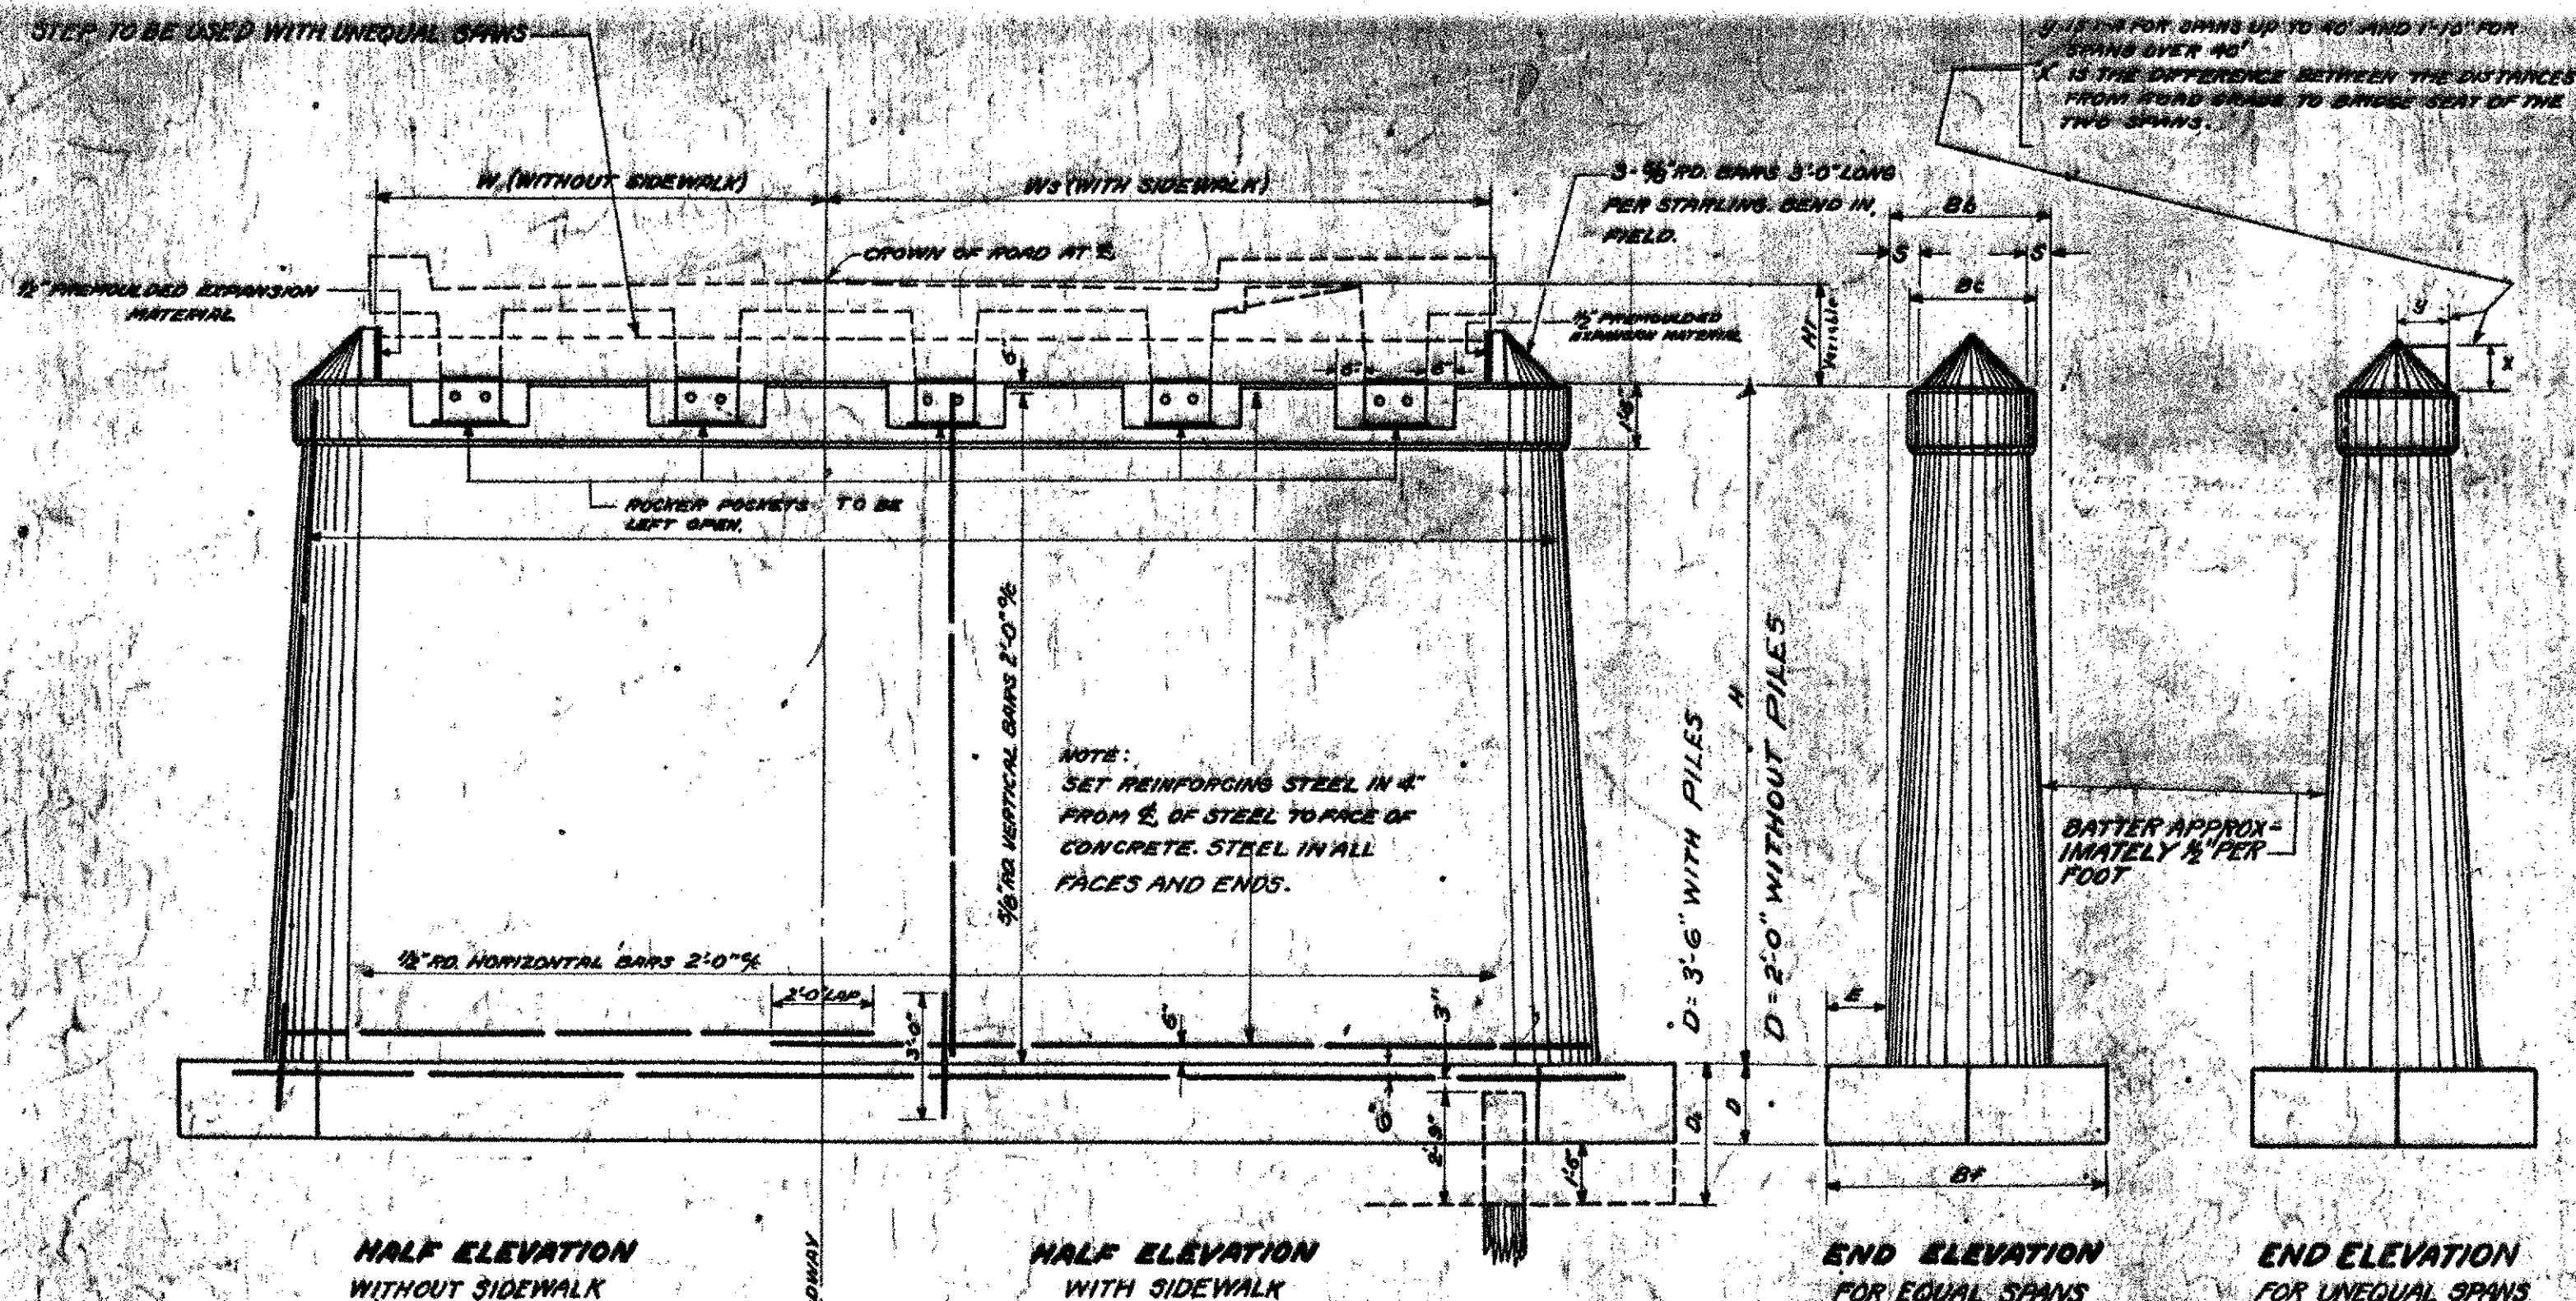


QUANTITIES FOR 20'-0" ROADWAY

DIFFERENCE IN QUANTITIES FOR 16', 18' & 22' ROADWAYS (From quantities given for 20' roadway)												QUANTITIES FOR 20'-0" ROADWAY											
WITH PILES						WITHOUT PILES						WITHOUT SIDEWALK						QUANTITIES ADDED PER SIDEWALK					
						DIMENSIONS																	
Span	Concrete	Reinforcing Steel	Formwork	Concrete	Reinforcing Steel	H	Span	B ₁	S	B ₂	L ₁	b ₁	b ₂	Without Piles	No. Piles for Tee Beam	No. Piles for I Beam	Quantity Added	Concrete	Rein. Steel in Stem	Piles	Concrete	Rein. Steel in Footing	
80	3	40	4	40	4	6	3	3	25'-0"	3'-6"	5"	6'-6"	12'-6"	1'-5"	3'-3"	45	640	10	9	120	5	12	130
80	11	40	6	40	6	10	3	5	45'-0"	4'-6"	5"	7'-6"	12'-6"	2'-3"	3'-3"	58	640	22	11	120	5	15	130
88	10	44	5	44	5	8	4	4	25'-0"	3'-8"	6"	6'-8"	12'-6"	1'-10"	3'-8"	52	730	11	11	140	5	13	130
88	12	44	6	44	6	10	5	5	45'-0"	4'-8"	6"	7'-8"	12'-6"	2'-4"	3'-10"	67	730	22	13	140	5	17	130
96	11	48	6	48	6	8	4	4	25'-0"	3'-10"	7"	6'-10"	12'-6"	1'-11"	3'-5"	63	860	11	12	160	5	15	130
96	14	48	7	48	7	12	6	6	45'-0"	4'-10"	7"	7'-10"	12'-6"	2'-8"	3'-11"	72	860	25	15	160	6	18	130
104	12	52	6	52	6	10	5	5	25'-0"	4'-0"	8"	7'-0"	12'-6"	2'-0"	3'-6"	68	970	11	14	180	5	17	130
104	15	52	8	52	8	12	6	6	45'-0"	5'-0"	8"	8'-0"	12'-6"	2'-6"	4'-0"	86	970	23	17	180	6	21	130
112	14	56	7	56	7	12	6	6	25'-0"	4'-2"	9"	7'-2"	12'-6"	2'-7"	3'-7"	76	1080	12	19	200	6	18	130
112	17	56	8	56	8	14	7	7	45'-0"	5'-2"	9"	8'-2"	12'-6"	2'-7"	4'-1"	97	1080	28	19	200	6	22	130
120	15	60	8	60	8	12	6	6	25'-0"	4'-4"	10"	7'-4"	12'-6"	2'-8"	3'-8"	84	1190	12	17	220	6	20	130
120	18	60	9	60	9	16	8	8	45'-0"	5'-4"	10"	8'-4"	12'-6"	2'-8"	4'-2"	108	1190	28	21	220	6	25	130
128	16	64	8	64	8	14	7	7	25'-0"	4'-6"	11"	7'-6"	12'-6"	2'-8"	3'-9"	93	1300	12	19	240	6	22	130
128	20	64	10	64	10	18	9	9	45'-0"	5'-6"	11"	8'-6"	12'-6"	2'-8"	4'-3"	118	1300	31	20	240	6	28	130
136	18	68	9	68	9	16	8	8	25'-0"	4'-8"	12"	7'-8"	12'-6"	2'-8"	4'-3"	102	1410	13	21	260	6	24	130
136	22	68	11	68	11	18	9	9	45'-0"	5'-8"	12"	8'-8"	12'-6"	2'-8"	4'-4"	130	1410	31	22	260	6	30	130

* STEEL QUANTITIES SAME AS THOSE WITH PILES QUANTITY DIFFERENCES GIVEN FOR STEMS ONLY FOR FOOTING STEEL SEE PILING DIAGRAM.

* COLUMN HEADINGS REFER TO EQUAL SPAN LENGTHS EACH SIDE OF PIER

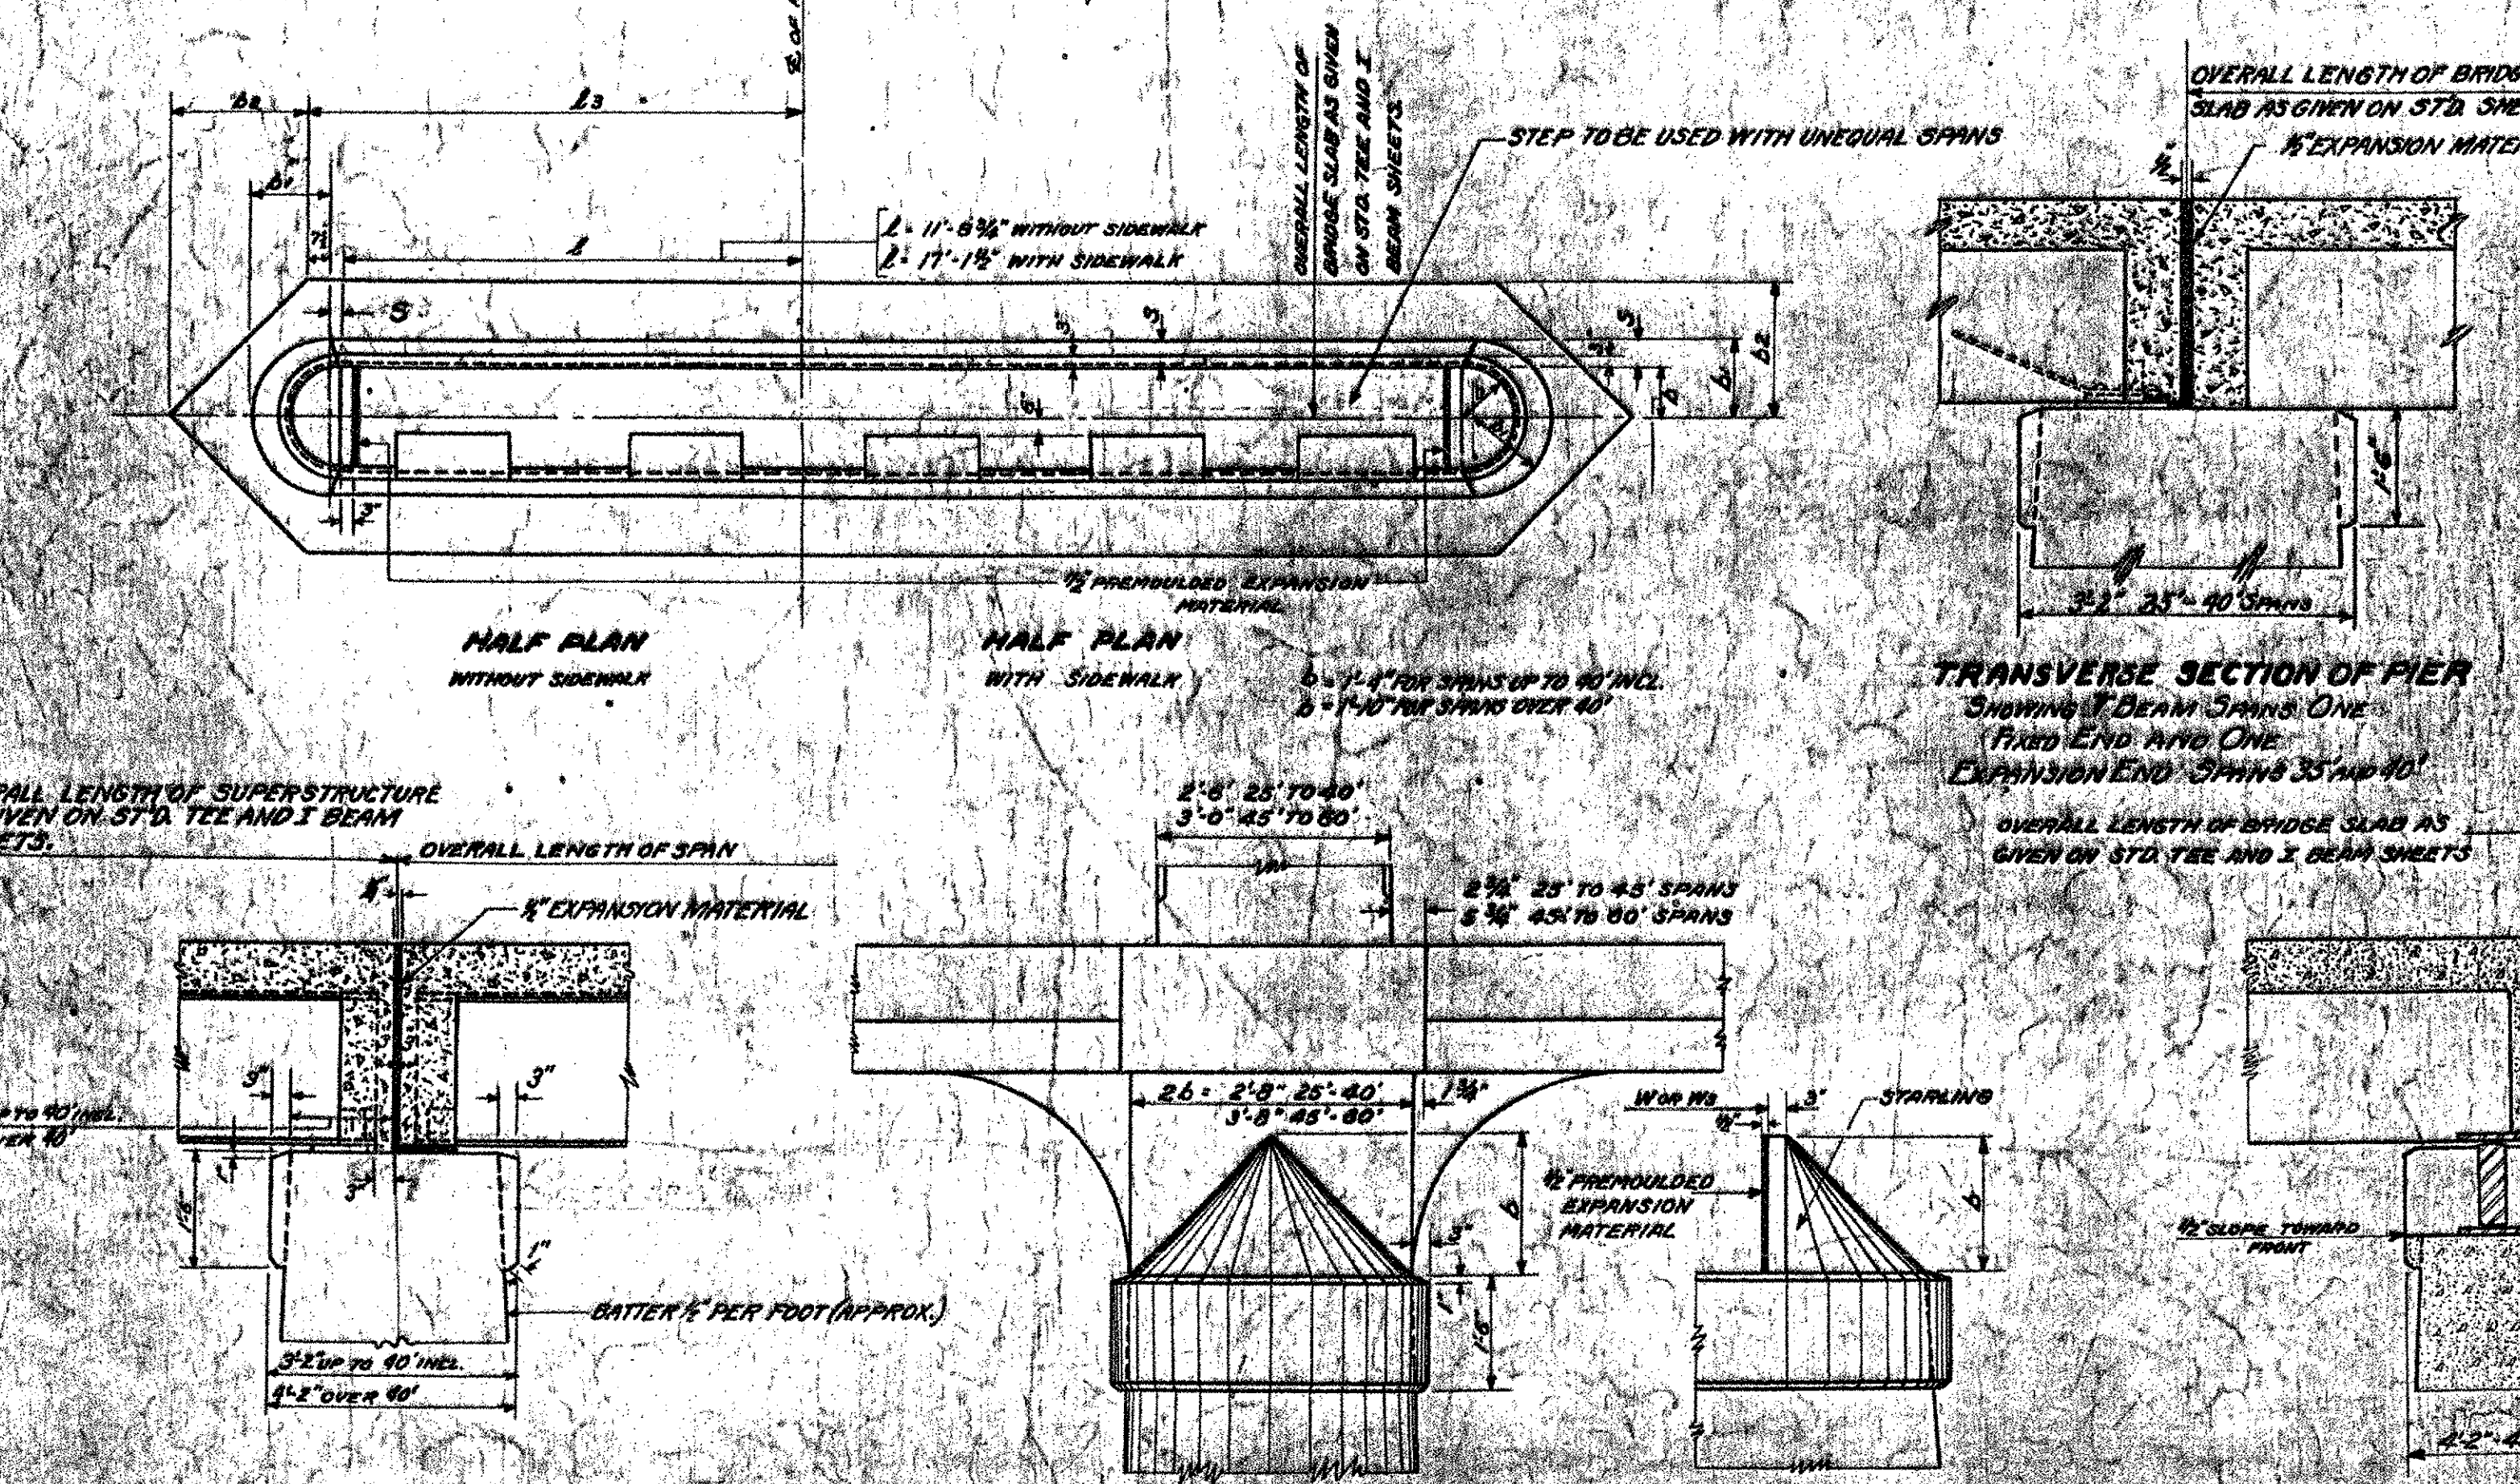

QUANTITIES FOR 20'-0" ROADWAY

NO. PILES	PILING DIAGRAM AND STEEL PLAN	DETAIL OF STEEL	STEEL QUANTITIES
34			710
24			650
31			650
23			620
28			620
20			580
25			580
18			520
22			520
16			440

USE ALL PILES FOR MAXIMUM NUMBER USE ONLY PILES MARKED ● FOR MINIMUM NUMBER

ADDITIONAL PILES PER SIDEWALK

NO. PILES	PILING DIAGRAM AND STEEL PLAN	DETAIL OF STEEL	STEEL QUANTITIES
6			130
5			130

USE ALL PILES FOR MAXIMUM NUMBER USE ONLY PILES MARKED ● FOR MINIMUM NUMBER

NOTES:

PILES TO BE SPACED NOT LESS THAN 2'-6" O.C. FOR H-DIMENSIONS SEE STANDARD TEE AND I BEAM SUPERSTRUCTURE SHEETS.

FOR GENERAL NOTES AND REFERENCES SEE S.B.2 ALL PIERS DESIGNED FOR 2 EQUAL SPANS AS NOTED IN COLUMN HEADINGS.

CLEAR WIDTH OF SIDEWALK IS 5'-0" ALL CONCRETE TO BE CLASS C.

ROUND NOSE STANDARD PIERS FOR SQUARE TEE AND I BEAM BRIDGES

CORRECT: *A. O. S. L.* BRIDGE ENGINEER

FOR 20' ROADWAY

W₁ = 11'-5 3/4" (Solid and Cable Rail) 11'-7 1/4" (Ballustrade Rail)

W₂ = 16'-1 1/4" (Solid Rail) 16'-1 1/4" (Ballustrade Rail)

H₁ = CROWN OF ROADWAY TO BRIDGE DECK (SEE SUPERSTRUCTURE)

E = 1'-0"

D = 3'-8" (WITH PILES)

O = 2'-0" (WITHOUT PILES)

L = 11'-8"

B₁ = 26'-0"


PILING PLAN FOR 16'-18' AND 22' ROADWAY

FOR 16' AND 22' ROADWAYS USE SAME NUMBER OF PILES AS SHOWN FOR 20' ROADWAY NOT MORE THAN 22 PILES SHALL BE USED FOR 18' ROADWAY SPANS 25' TO 40', NON 31 PILES FOR SPANS 45' TO 60'.


FOR 16' ROADWAYS USE PILING DIAGRAM SHOWING NEXT SMALLER NUMBER OF PILES TO THAT LISTED FOR 20' ROADWAY EXCEPT THAT WHEN 25 PILES ARE LISTED FOR 20' ROADWAY USE NOT LESS THAN 14 PILES SHALL BE USED FOR ANY PIER.

LEICESTER BRF 0160 (3)S REFERENCE SHEET 1 SHEET 89 OF 90

Drawn by: P. LANGRISH 3-1-1959
 Traced by: P. LANGRISH 3-3-1959
 Checked by: A. O. S. L. 3-6-1959
 Date: 3-7-1959

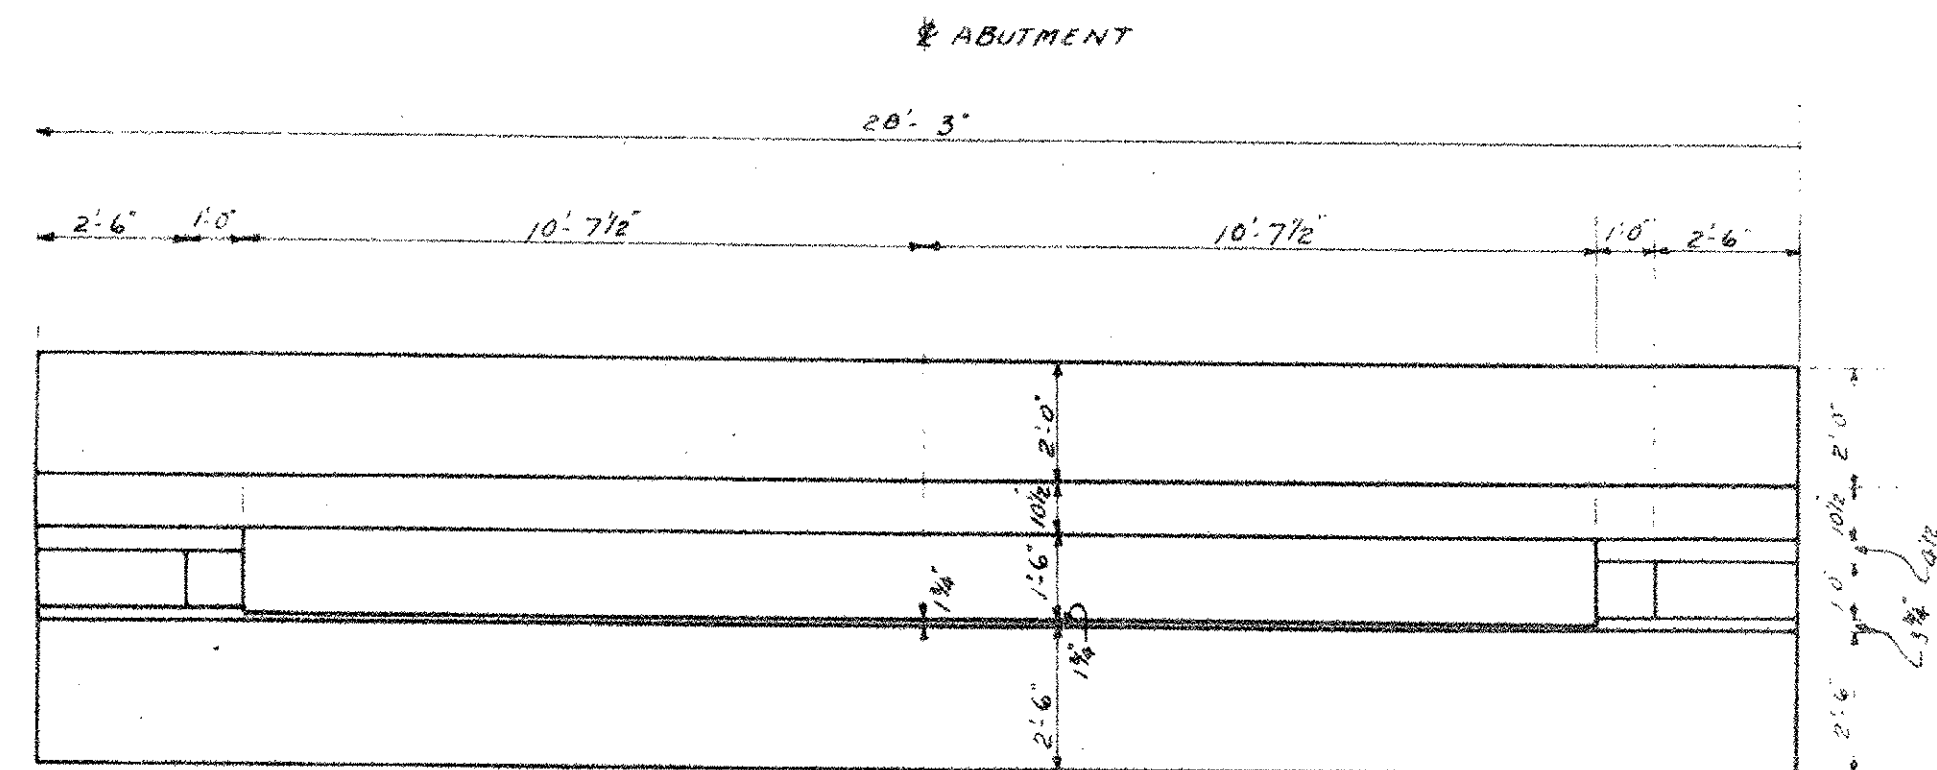


PLAN ABUT
CORING NOT SHOWN

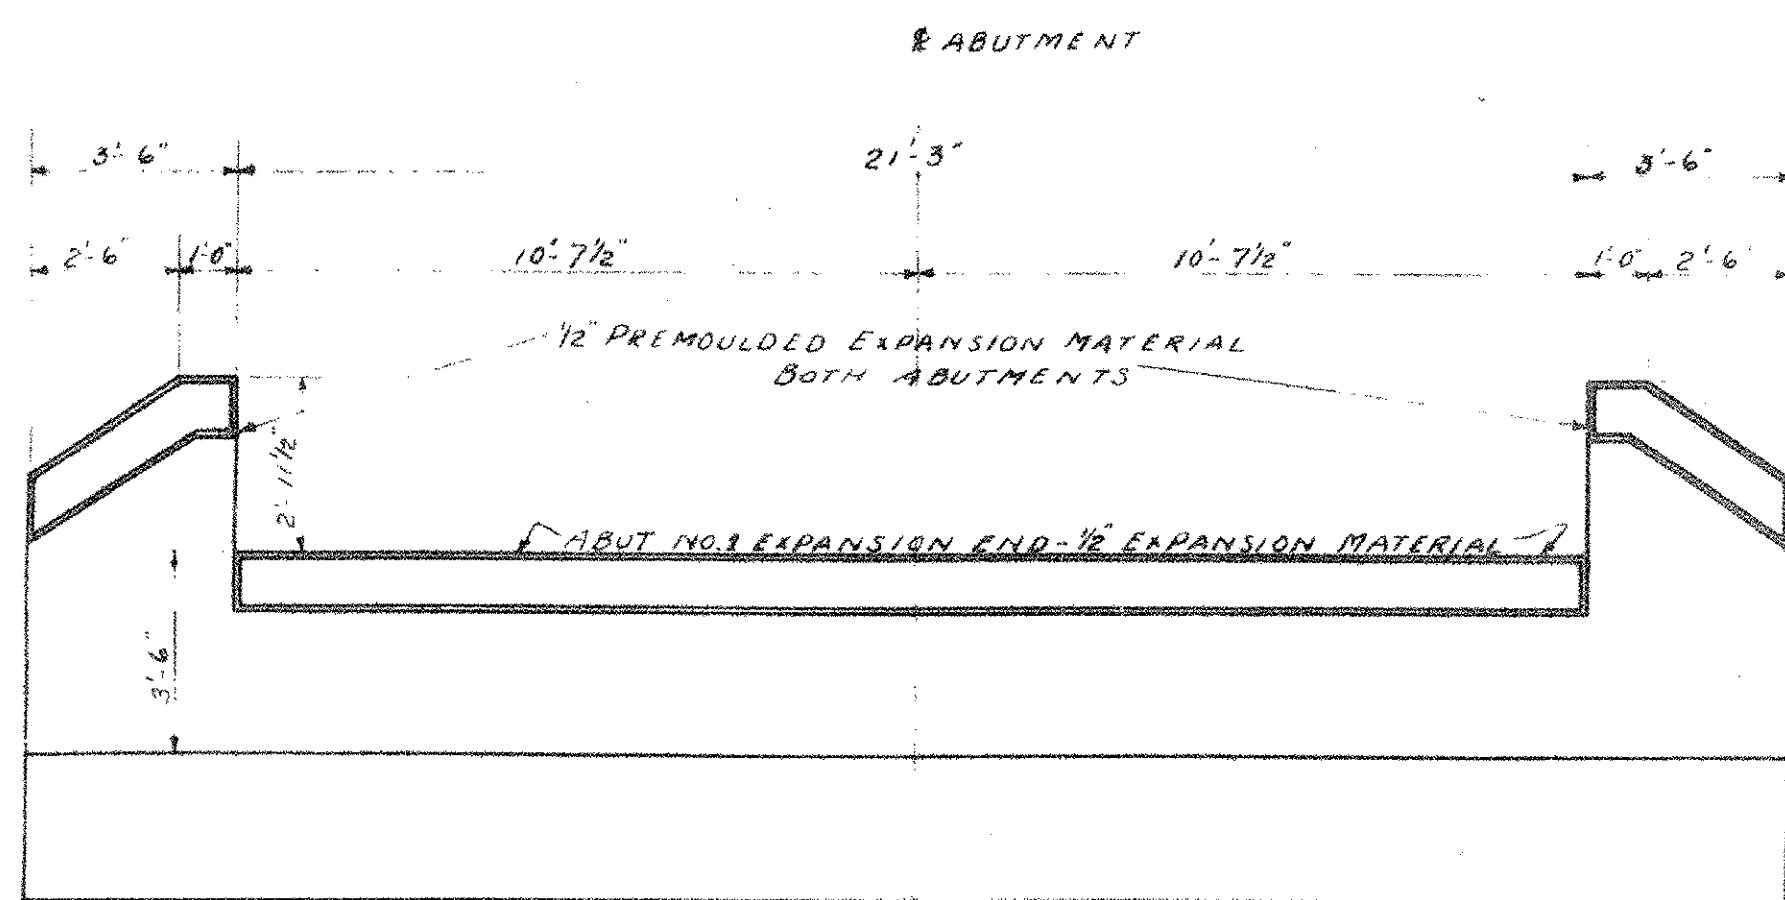

ELEV. ABUT
Scale 1/8" = 1'-0"
ABUTMENTS SIMILAR

RIP RAP FOR BANK PROTECTION
SLOPE 1 ON 1 1/2
CARRY TO LOW WATER EL. 89.5

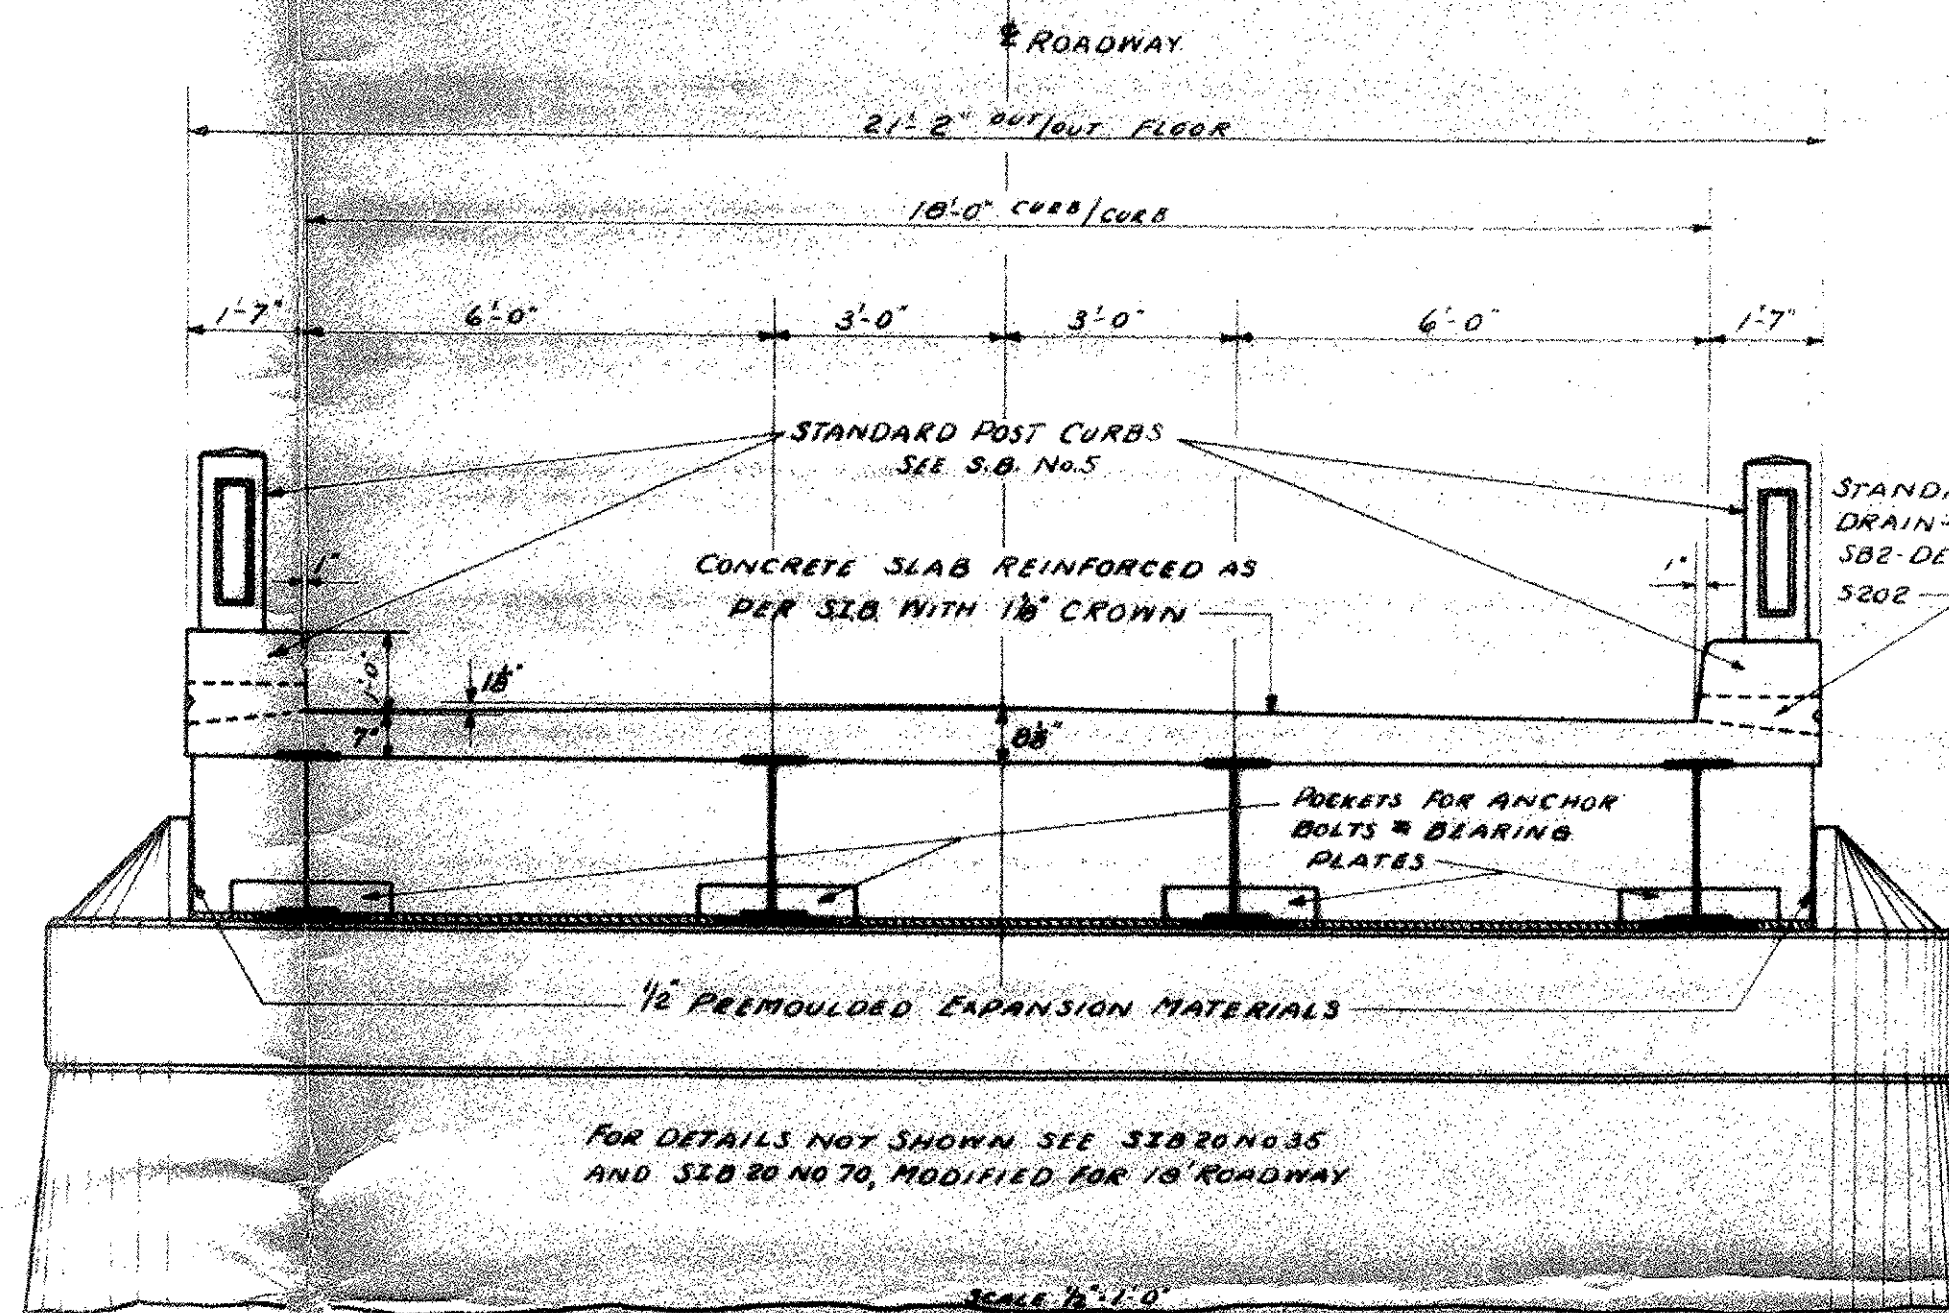

CROSS SECTION OF ROADWAY

FOR PIER DETAILS USE SERIES SP, NO. 3-MODIFIED FOR 18' RDWY.

USE: W-10'-6 1/2" - H-19'-6" - L-10'-9 1/2" - L-12'-2"

The correctness of this steel schedule is not guaranteed and no claim will be allowed for any inaccuracy therein. All steel to be reinforced bars, reinforcing steel shall conform to the Standard Specifications for Reinforcing Steel Concrete Reinforcement Bars, Intermediate or Structural Grade, of the American Society for Testing Materials, Serial Designation A 15-14.

All bar detail dimensions refer to E of steel. All work and materials shall conform to the State of Vermont Standard Road and Bridge Specifications 1930. Anchor bolts, bearing plates and tie angle assemblies shall be included in lump sum bid for Structural Steel.

SECTION @ E


REINFORCING STEEL SCHEDULE					SUPERSTRUCTURE - 35' SPAN - 2 REQ'D	
BAR	FOR	SIZE	REQ'D	DETAIL		
7	22'-0"	3/8"	39			
8	21'-0"	3/8"	39			
9	21'-9"	3/8"	43			
10	19'-6"	3/8"	16			
11	19'-6"	1/2"	34			
12	6'-3"	3/8"	3			
14	5'-6"	3/8"	6			
15	6'-0"	3/8"	12			
16	4'-6"	3/8"	4			
17	2'-9"	3/8"	0			
18	17'-9"	3/8"	12			
SUPERSTRUCTURE - 70' SPAN - 1 REQ'D						
7	22'-0"	3/8"	75			
8	21'-0"	3/8"	75			
9	21'-9"	3/8"	79			
10	38'-0"	1/2"	20			
11	38'-0"	1/2"	30			
12	6'-3"	3/8"	3			
14	6'-0"	3/8"	6			
15	5'-6"	3/8"	12			
16	4'-0"	3/8"	4			
17	3'-0"	3/8"	0			
18	9'-3"	3/8"	12			
SUBSTRUCTURE - PIER - 2 REQ'D						
PIER	19'-0"	5/8"	20			
HEAD	34'-0"	1/2"	22			
DOWN	3'-0"	3/8"	20			
P1	8'-3"	3/8"	36			
P2	17'-9"	3/8"	0			

LEICESTER
BRF 0160 (3)
REFERENCE SHEET 2
SHEET 90 OF 90

LEICESTER JCT. BRIDGE
OVER
OTTER CREEK
FOR 18' ROADWAY


ESTIMATED QUANTITIES									
SPANS	# 1	# 2	# 3	ABUTMENTS	# 1	# 2	PIERS	# 1	# 2
Conc. Class A	30 cu	55 cu	80 cu	Struct. Excav.	56 cu	87 cu	Struct. Excav.	95 cu	152 cu
Reinf. Steel	4791 lb	9171 lb	4791 lb	Conc. Class C	20 cu	28 cu	Conc. Class C	108 cu	164 cu
Struct.	12990 lb	59000 lb	12990 lb	RIP RAP Bank Prot.	76 cu	76 cu	Reinf. Steel	2314 lb	2314 lb
							Timber Piling	1085 lb	1085 lb

Surveyed by
Designed by
Drawn by
Traced by
Checked by
Series No. Filed
Sheet 24 of 16 Sheets

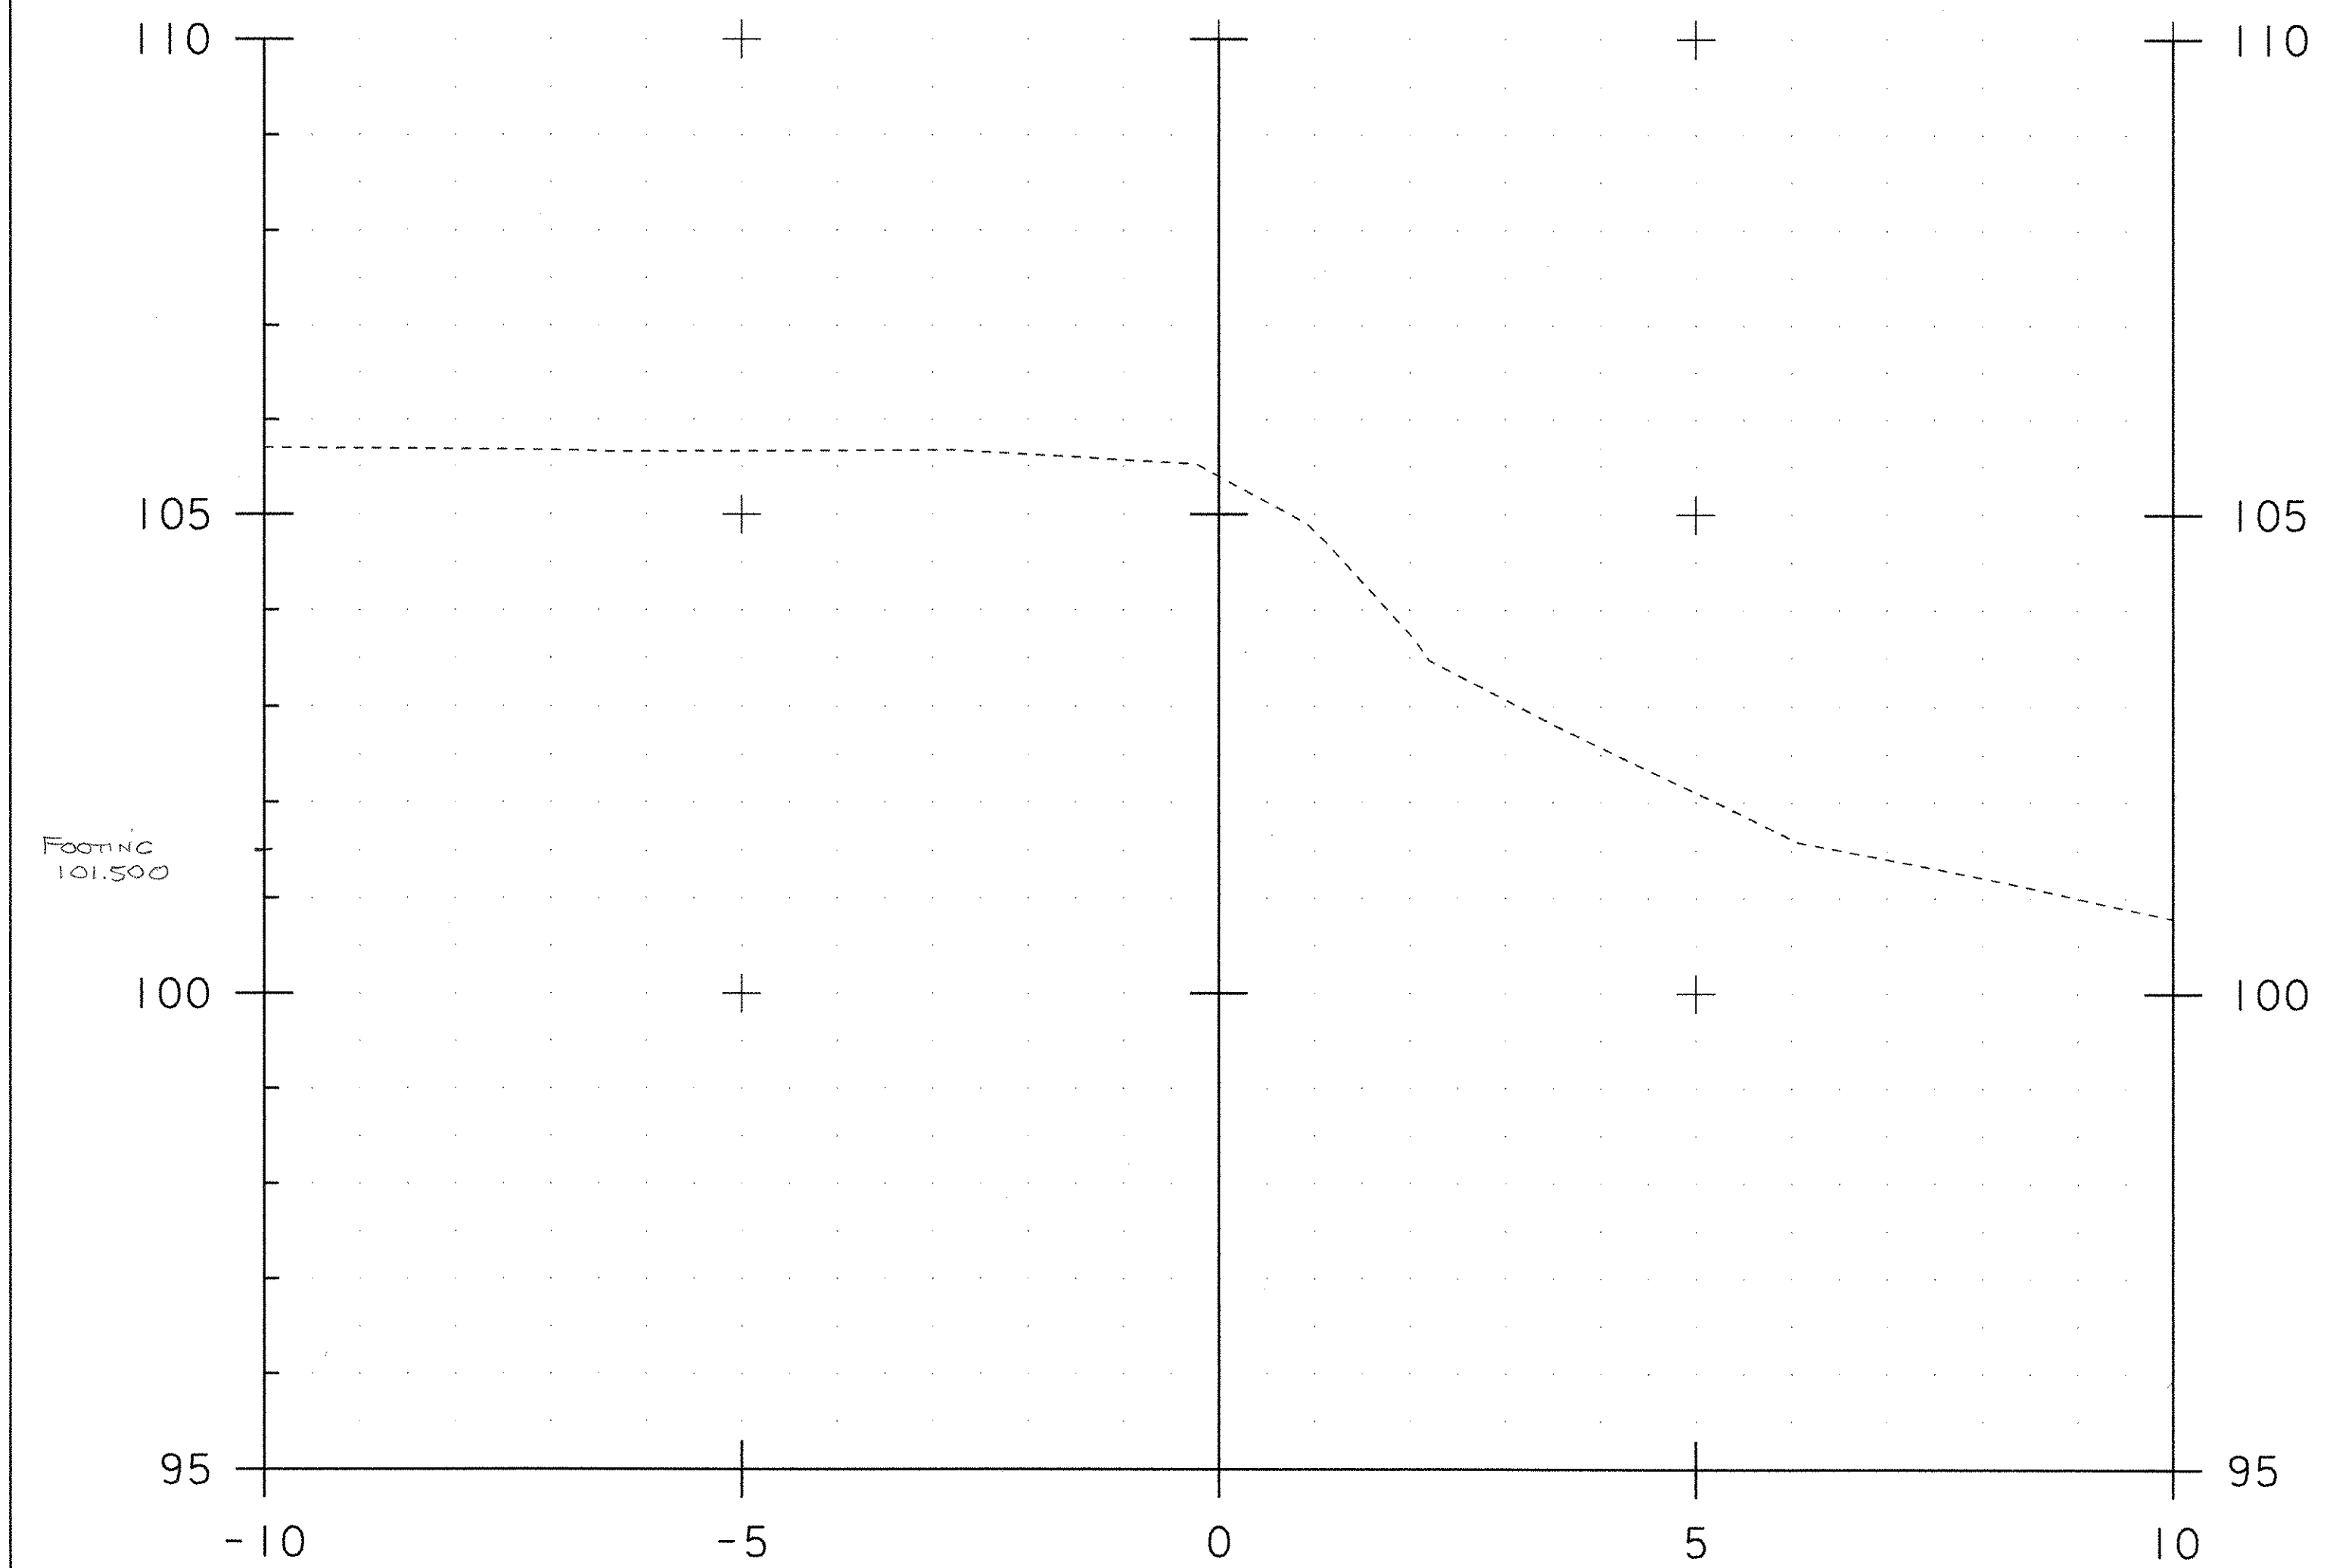

4+986.00


FOOTING
101.500

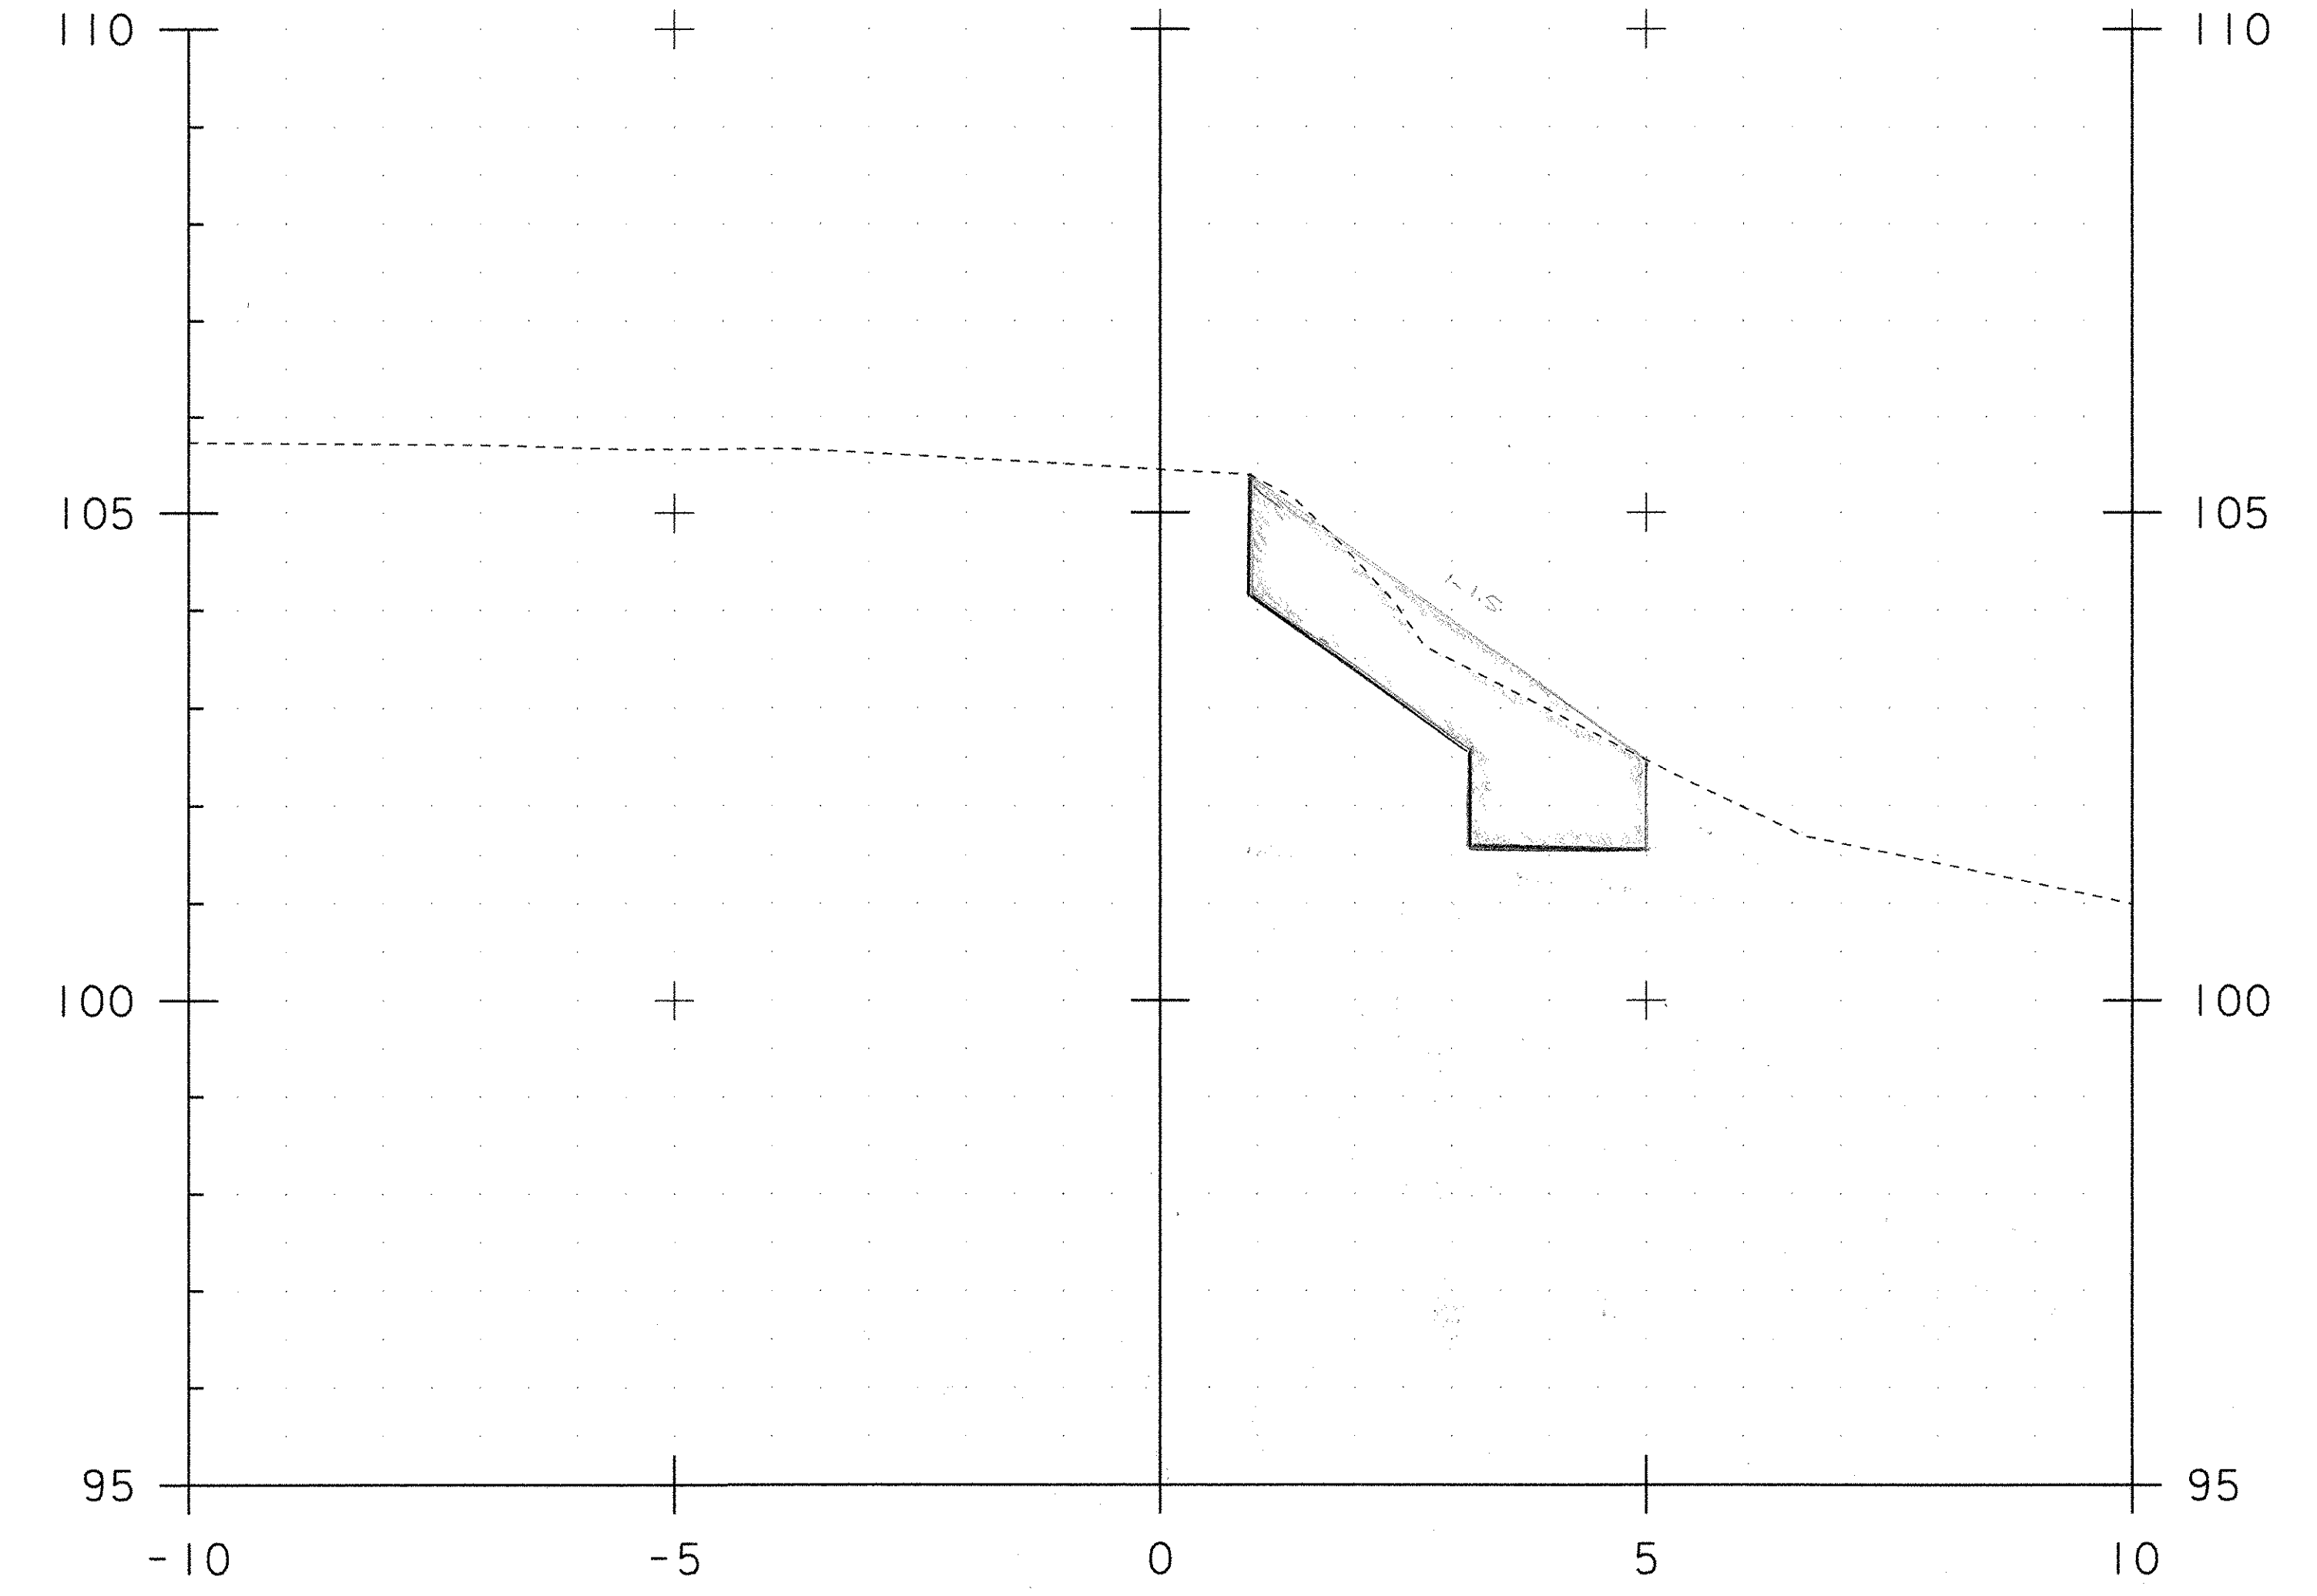

4+988.00

BEGIN UNCL. CHAN EXC (BUTT) = 4.67 m² ✓ PC 2-29-07
 BEGIN STONE FILL TYPE III (BUTT) = 5.34 m² ✓
 BEGIN GEO. UNDER STONE FILL (BUTT) = 6.7 M


PROJECT NAME:	Leicester	PLOT DATE:	01-NOV-2005
PROJECT NUMBER:	BRF 0160(3)S	DRAWN BY:	R. Bullock
FILE NAME:		CHECKED BY:	
PROJECT LEADER:		SHEET 1	OF 8
DESIGNED BY:	D91 AB1		

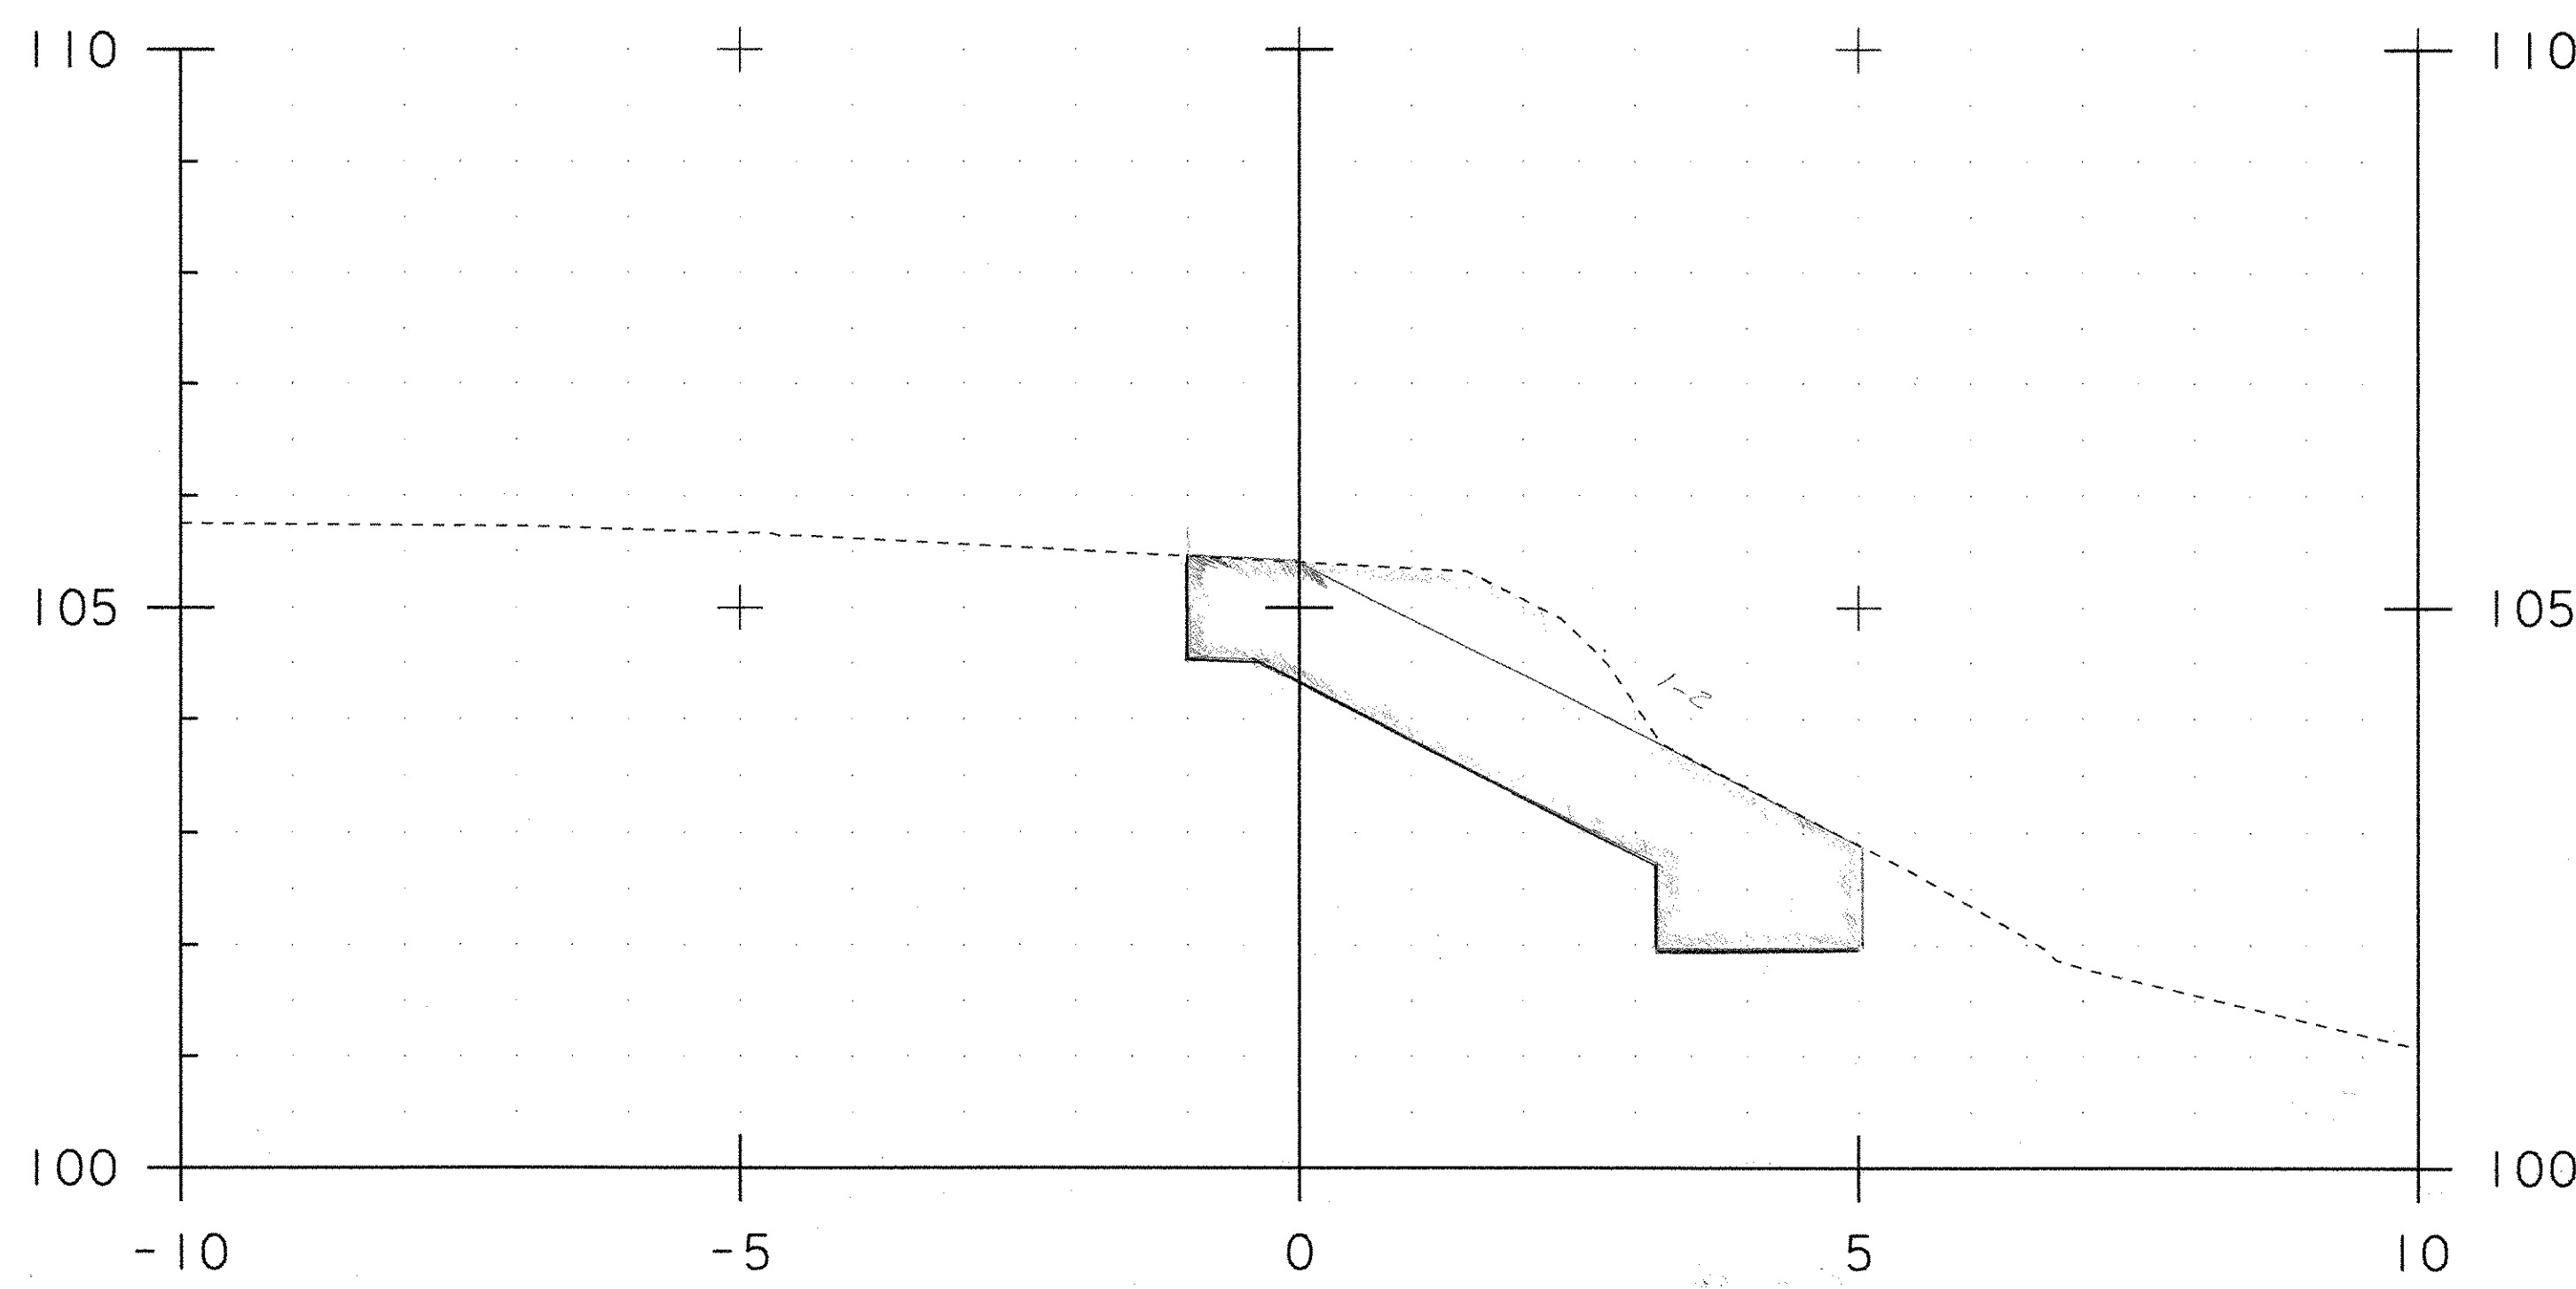

4+990.00

UNCL CHAN EXC - ~~8.40~~ 8.40 m²
 STONE FILL TYPE III - ~~7.25~~ 6.77 m²
 GEO UNDER STONE FILL - 8.1 M

DC
3-5-07

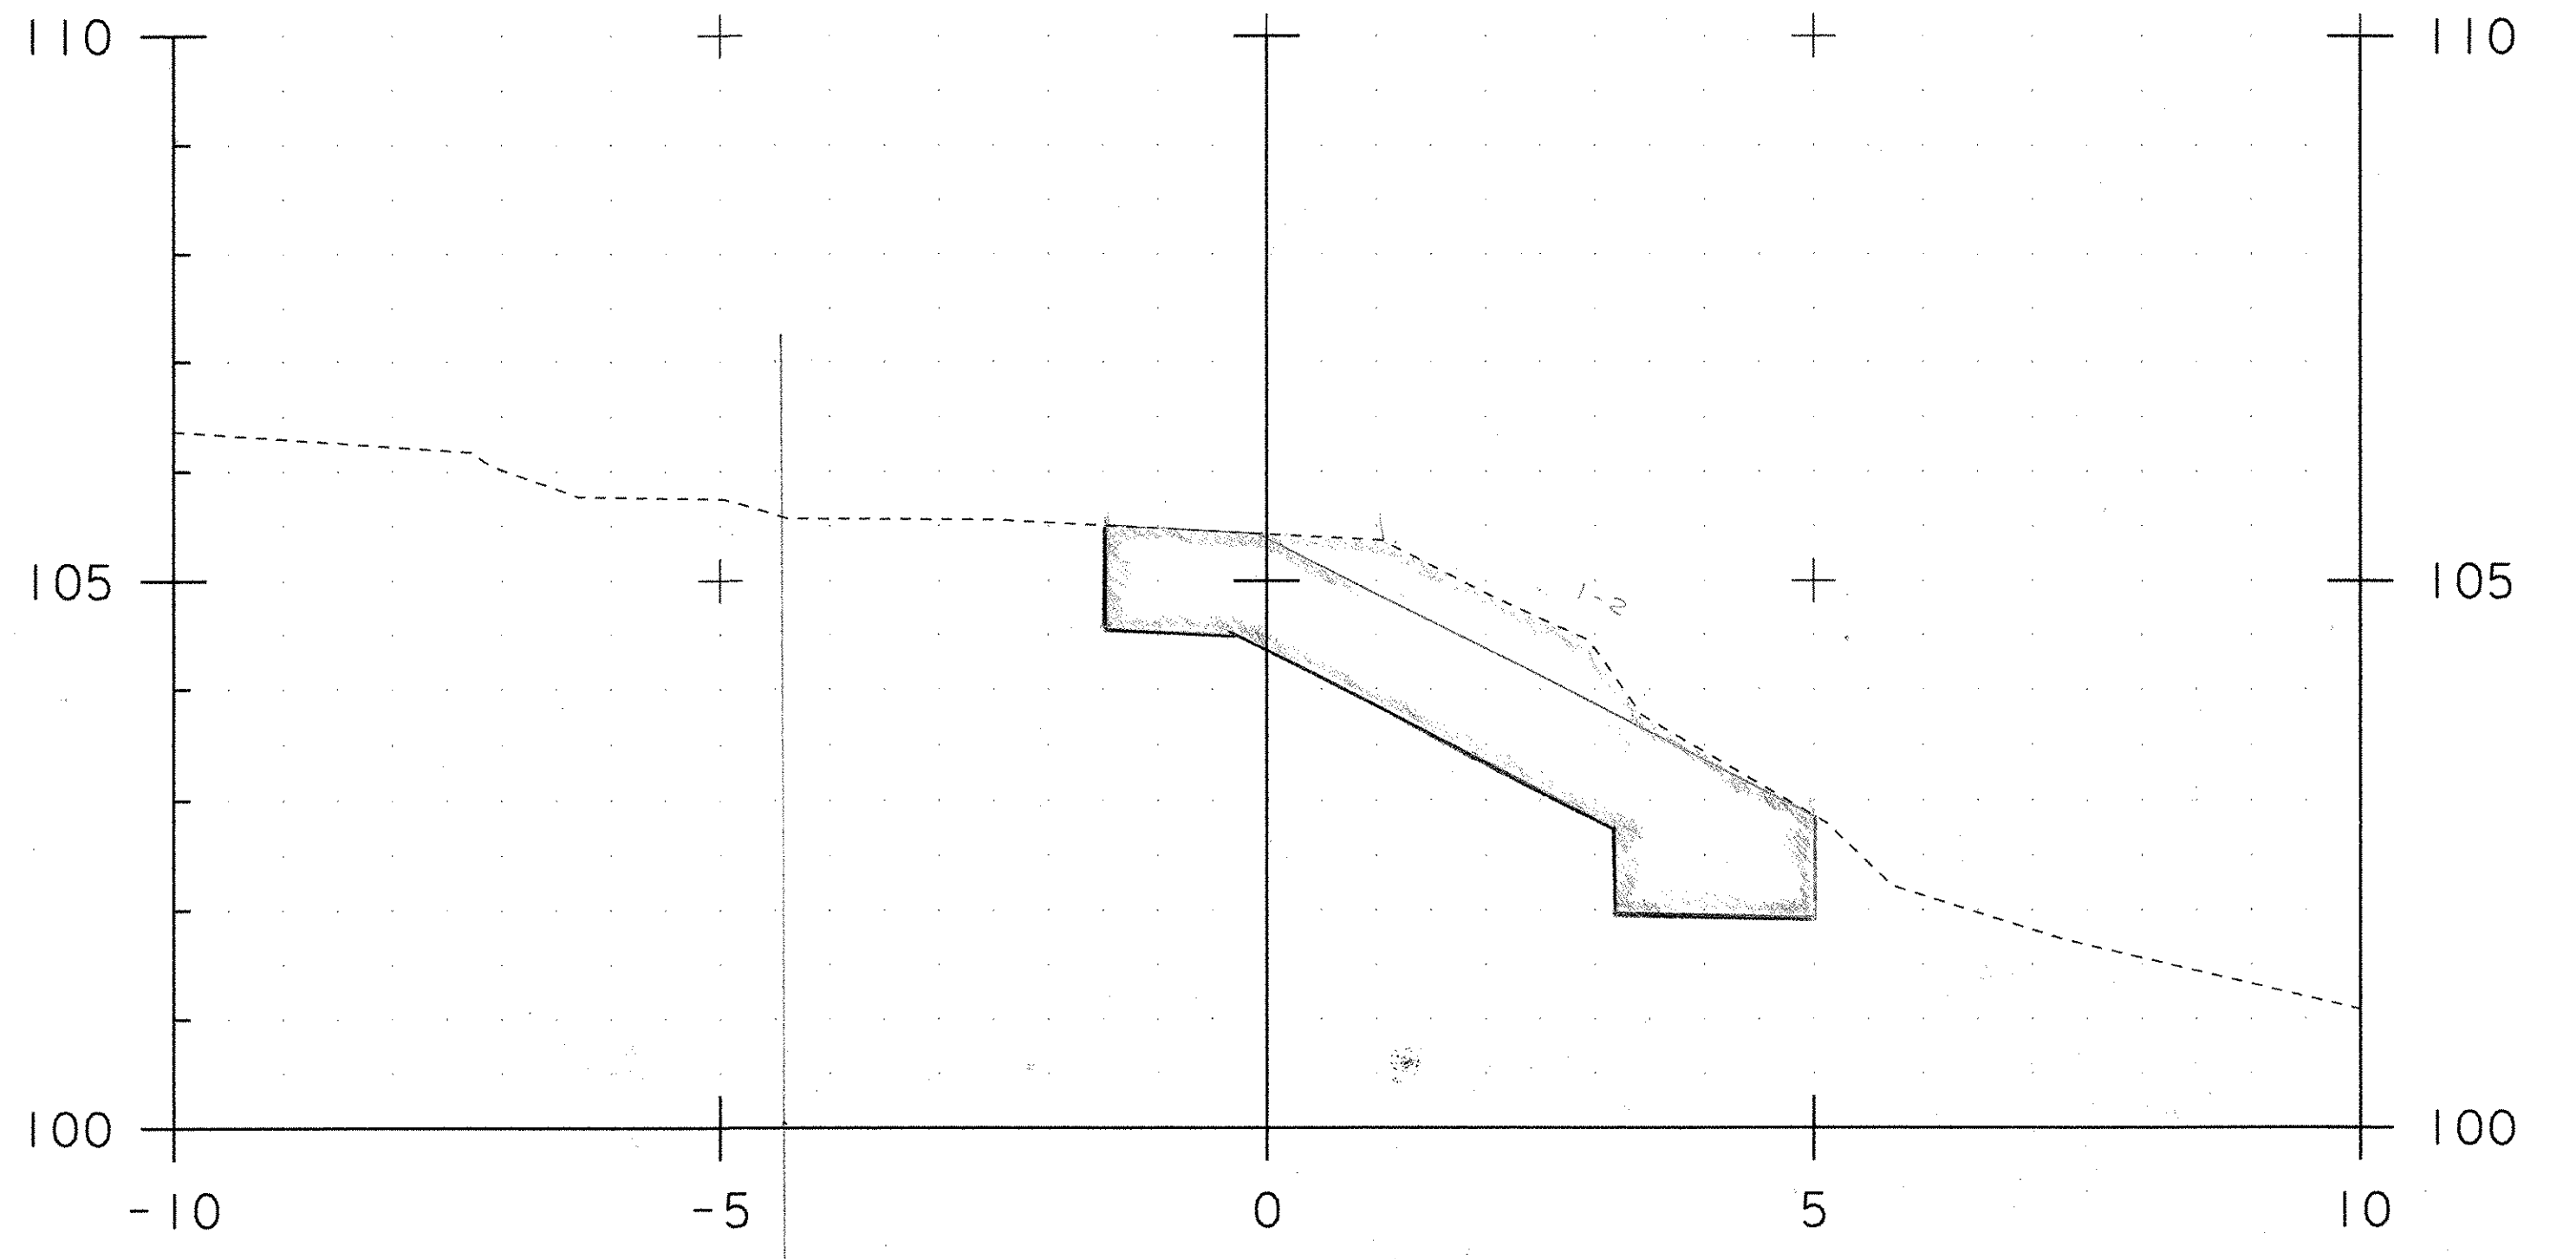


4+992.00

UNCL CHAN EXC - 8.51 m²
 STONE FILL TYPE III - ~~7.25~~ 7.0 m²
 GEO UNDER STONE FILL - 8.5 M

DC
2-27-07

PROJECT NAME:	Leicester	FILE NAME:	PLOT DATE: 01-NOV-2005
PROJECT NUMBER:	BRF 0160(3)S	PROJECT LEADER:	DRAWN BY: R. Bullock
DESIGNED BY:		C92AB1	CHECKED BY:
			SHEET 2 OF 8

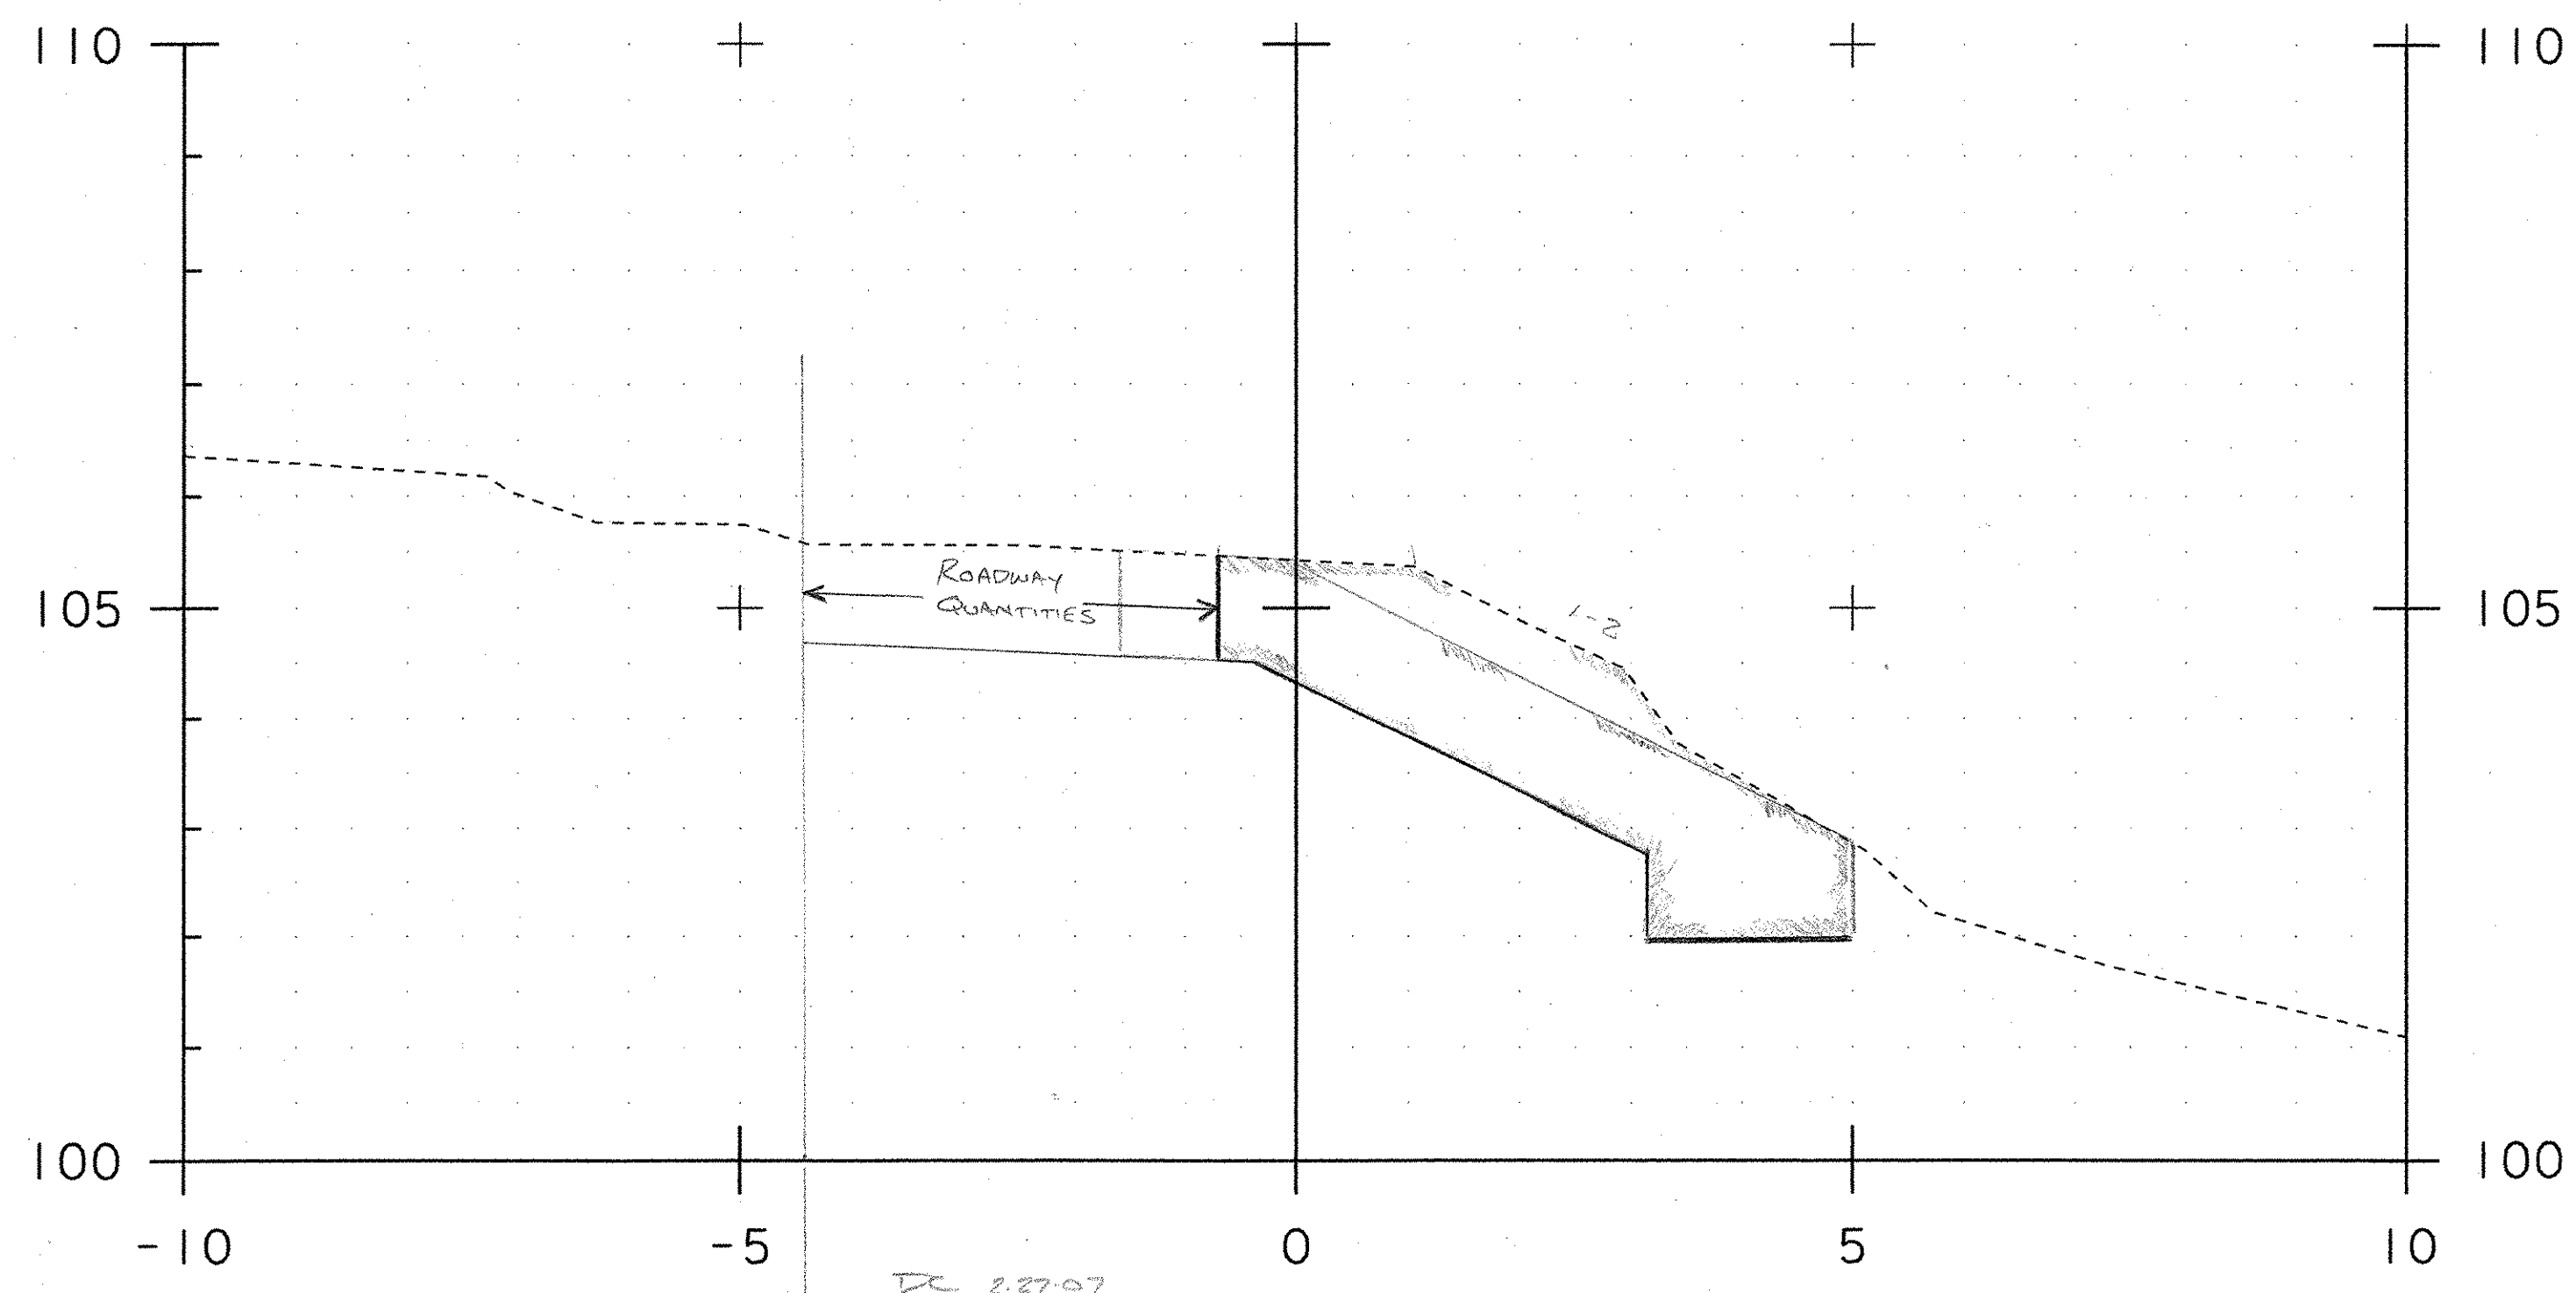

UNCL CHAN EXC - 7.95 m² ✓
 STONE FILL TYPE III - 6.48 m² ✓
 GEO UNDER STONE FILL - 8.7 M

DL 227-07


4+992.10

4+992.40 - UNCL CHAN EXC
 STONE FILL TYPE III
 GEO UNDER S.F.

ZERO COFFERDAM EXC. ✓
 ZERO GRANULAR BACKFILL

093 AB1

[Handwritten signature]

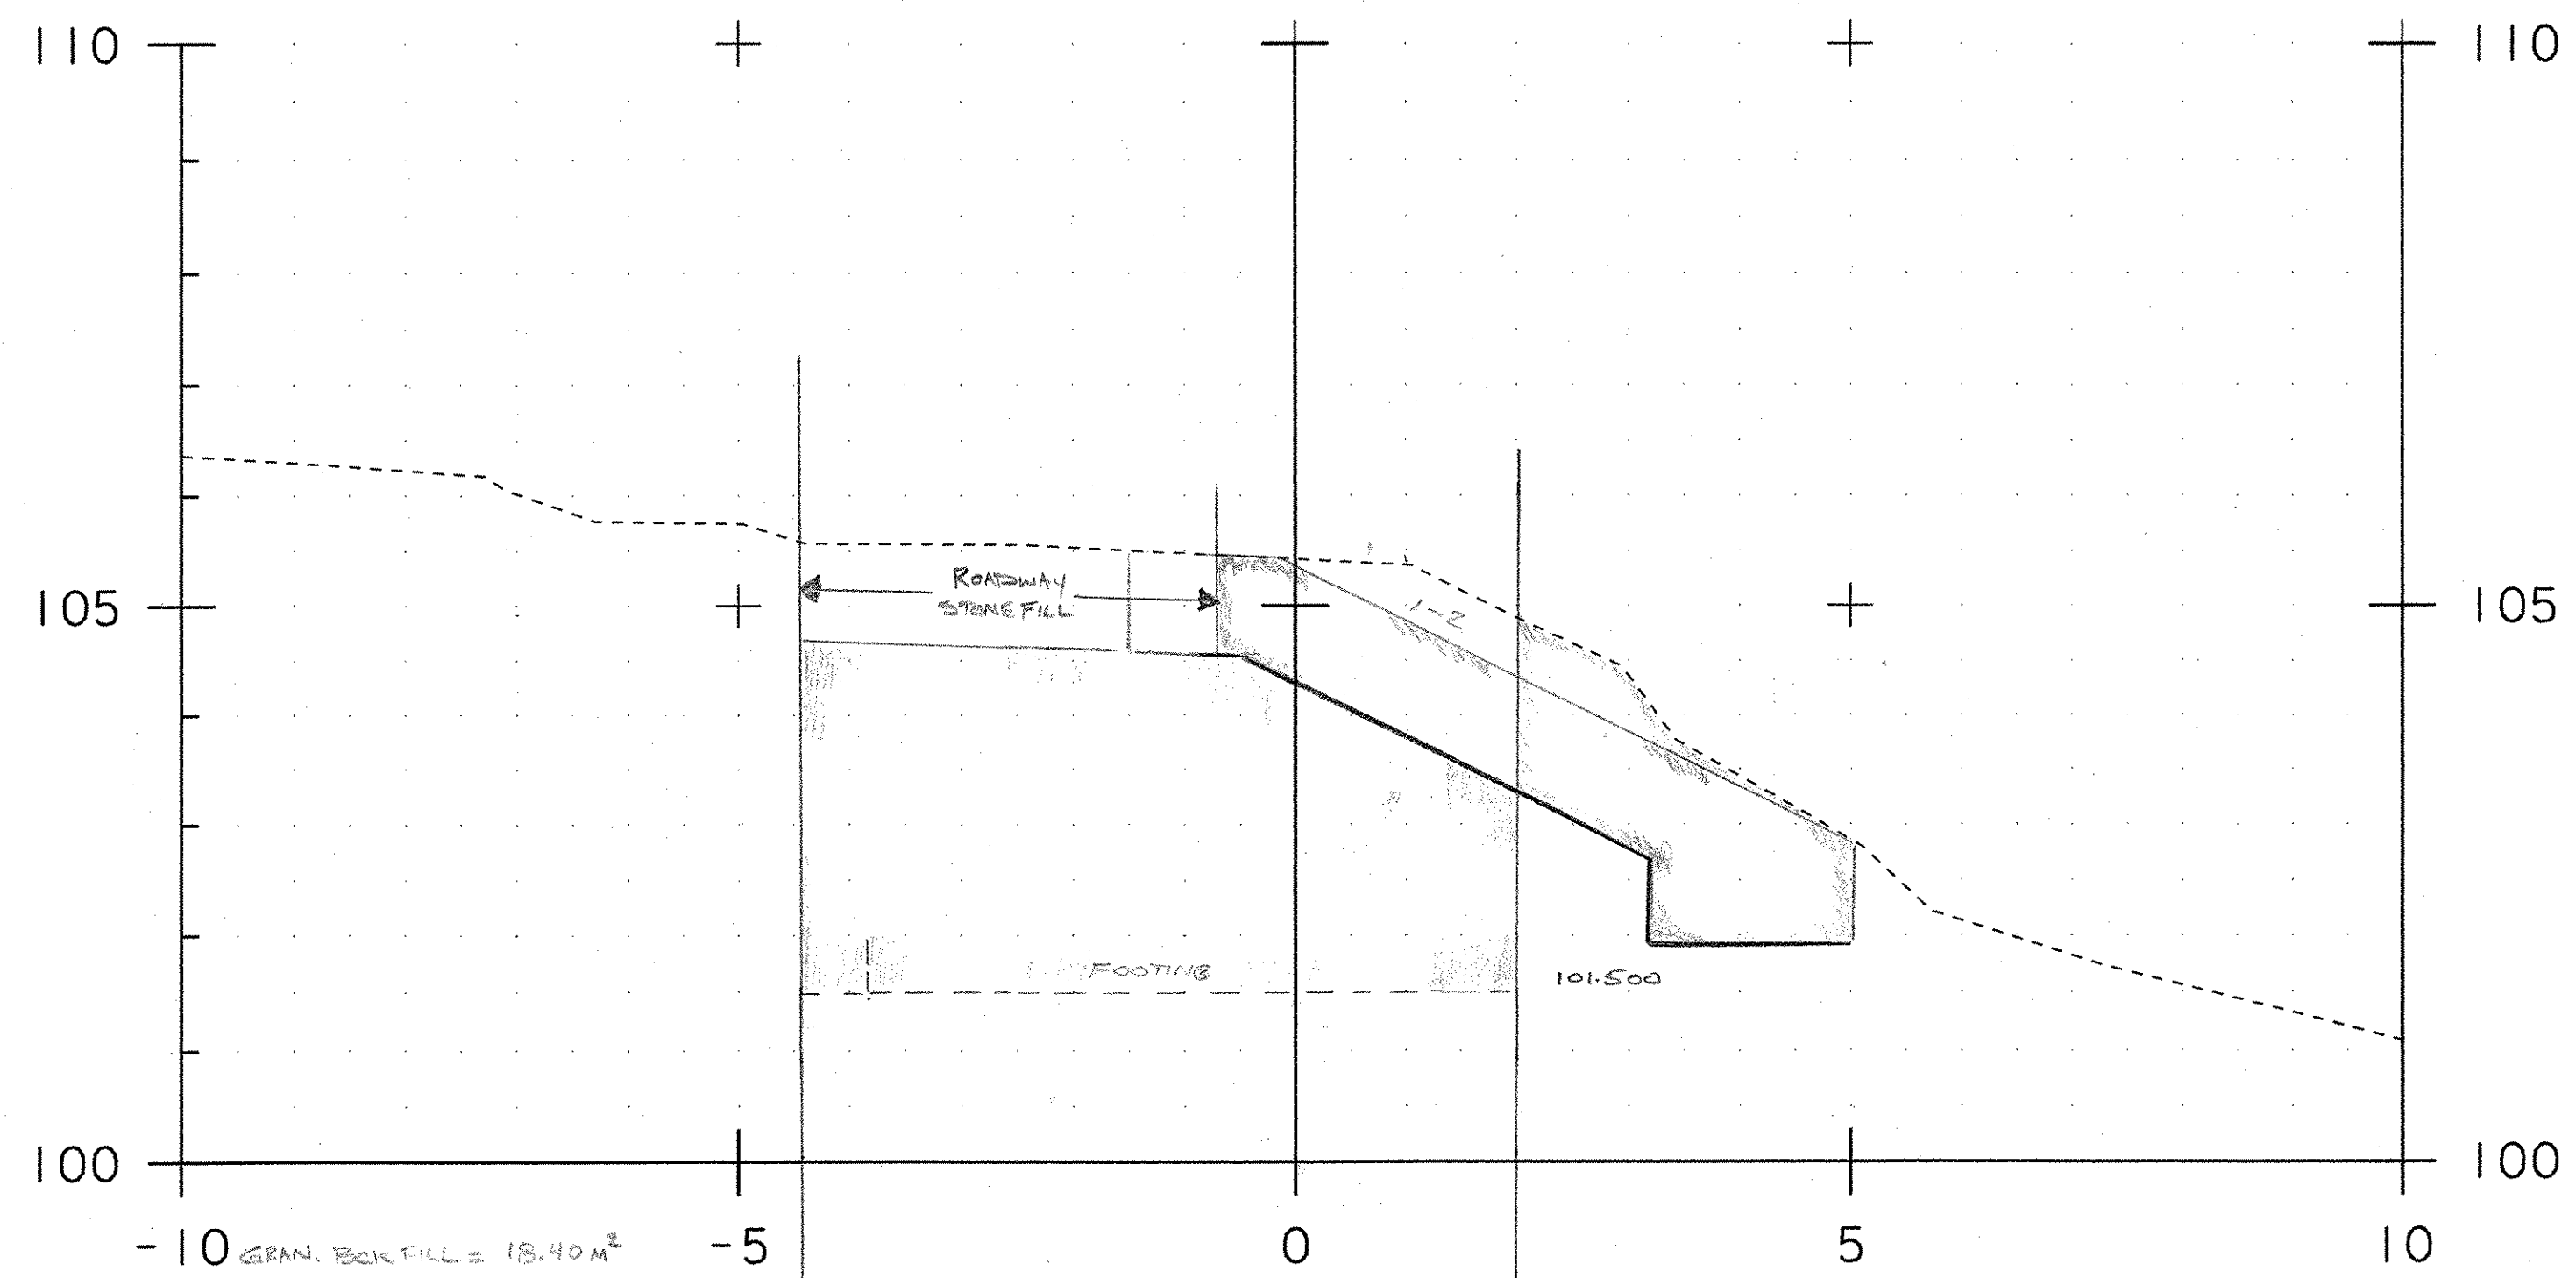


-10 GRAN. BOLT FILL = 18.40 m²
 EXC - E & R = 25.85 m²
 CHAN EXC - 4.52 m²
 STONE FILL TYPE III - 6.29 m²
 GEO UNDER STONE FILL - 6.9 m

4+992.60

COFFEDAM FULL WIDTH
 CONCRETE FOOTING WING WALL #2


094 AB1

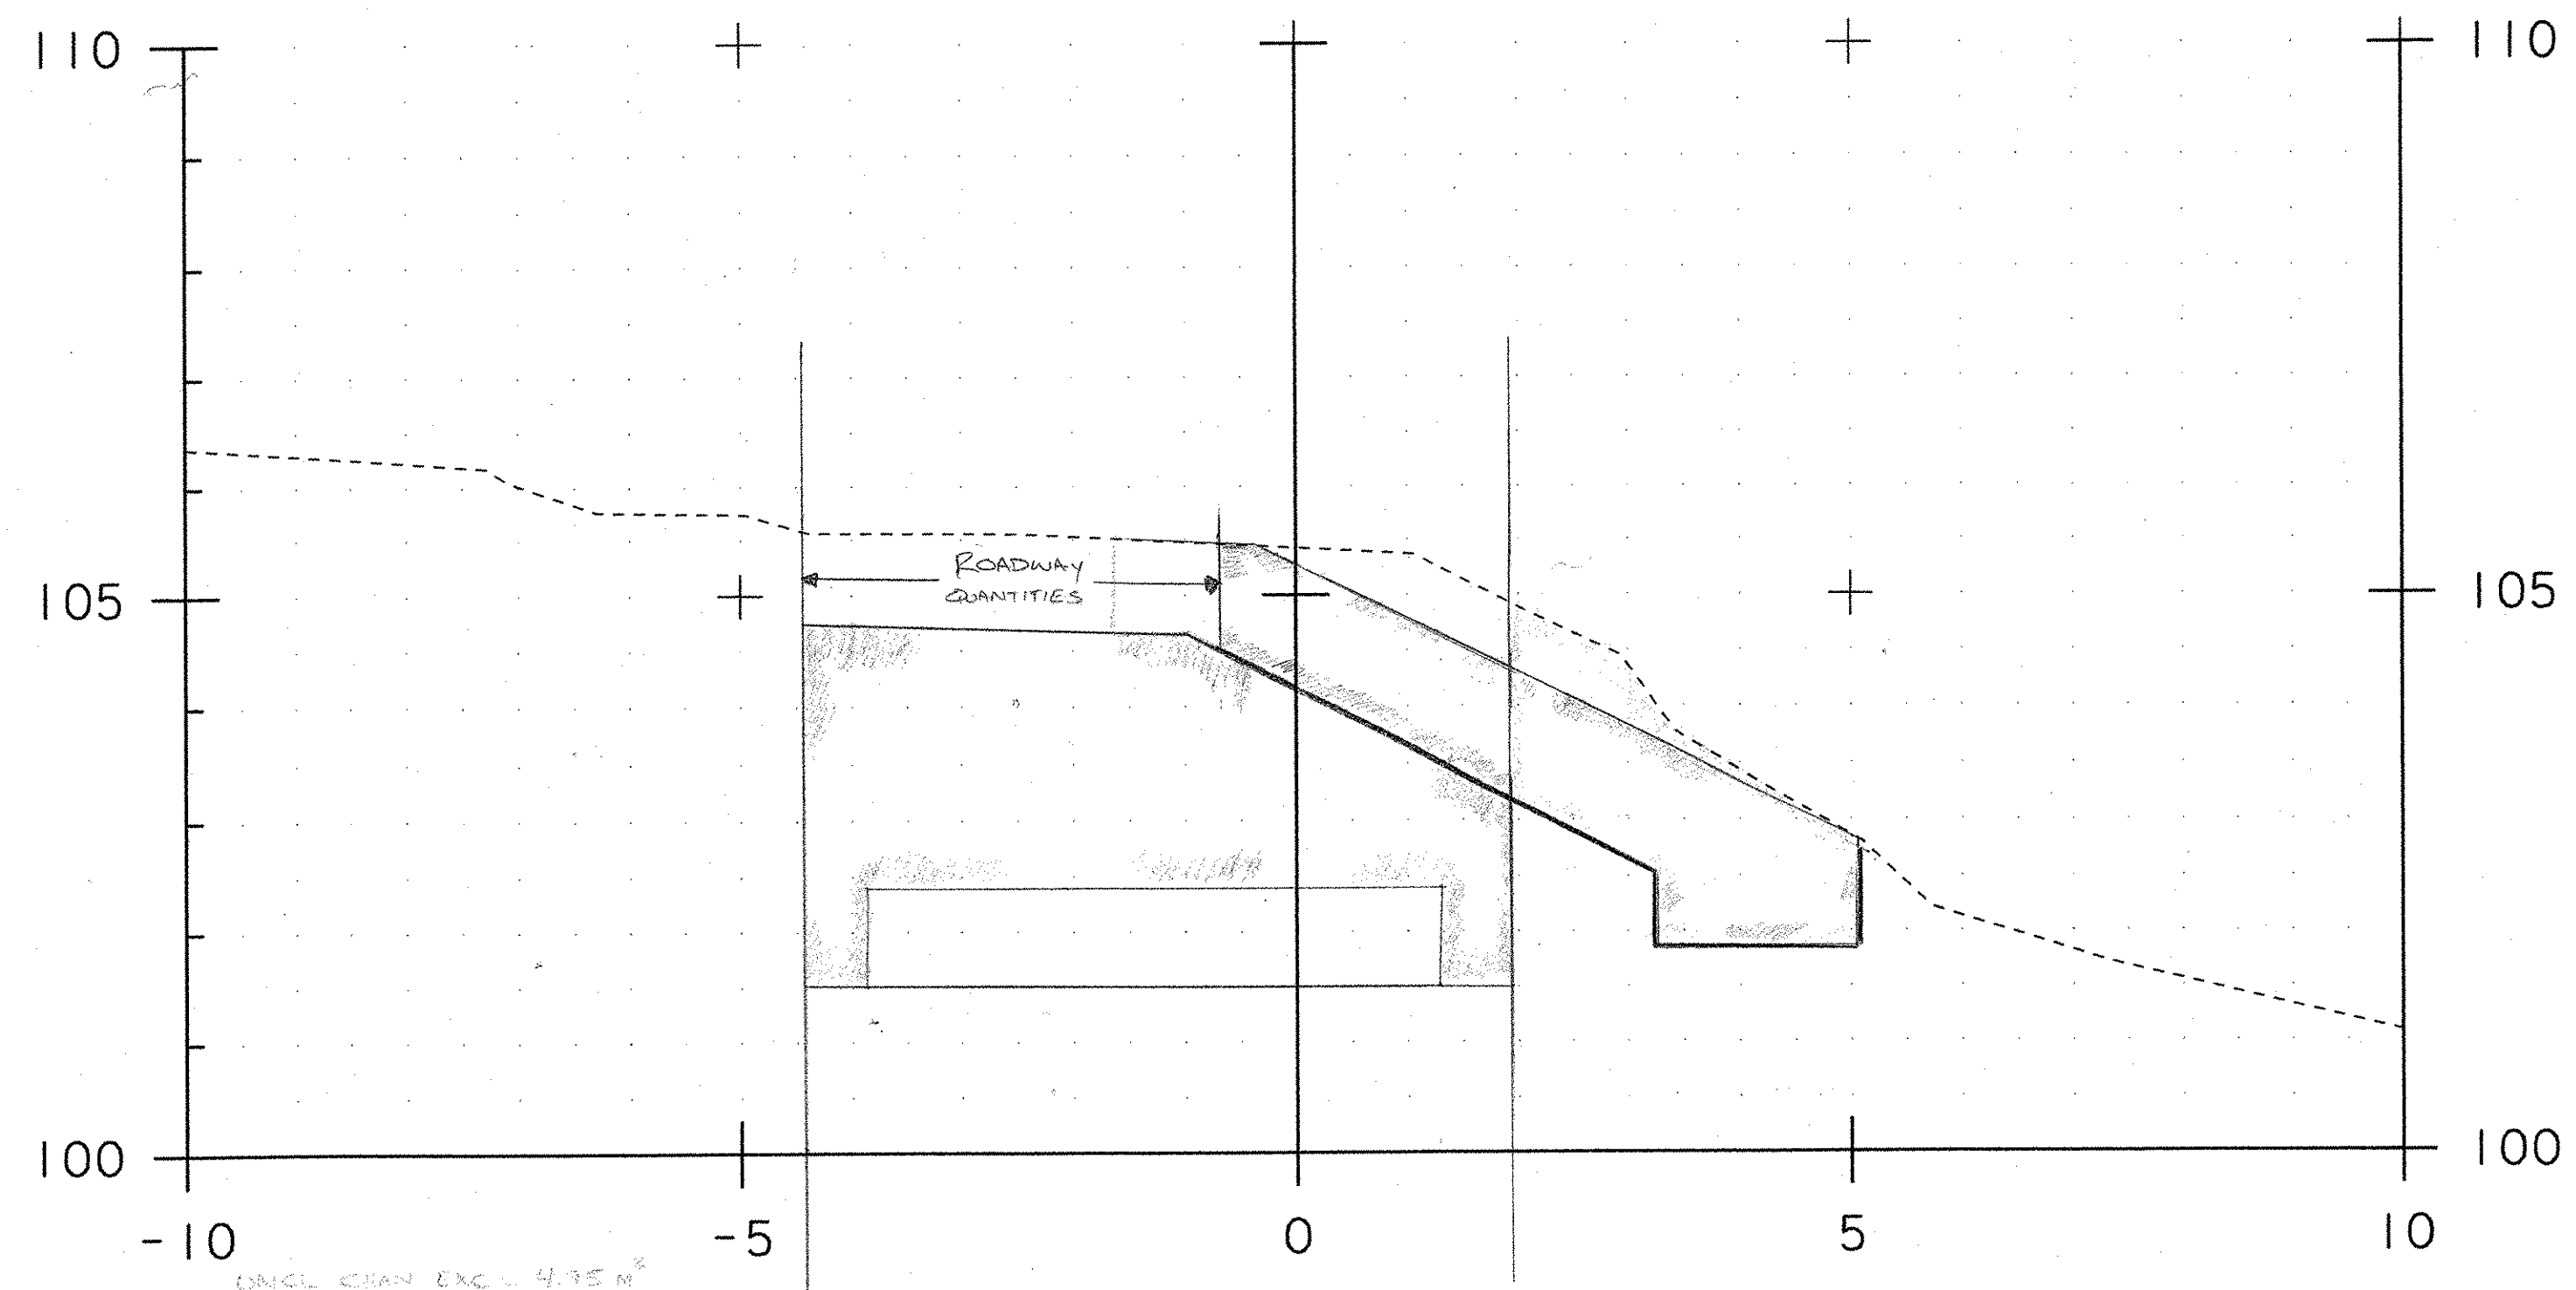


UNCL. CHAN EXCL. 4.35 M²
 STONE FILL TYPE III = 6.76 M²
 GPPS BACK FILL = 18.27 M²
 GEO UNDER S.F. = 6.90 M

4+992.90



095AB1

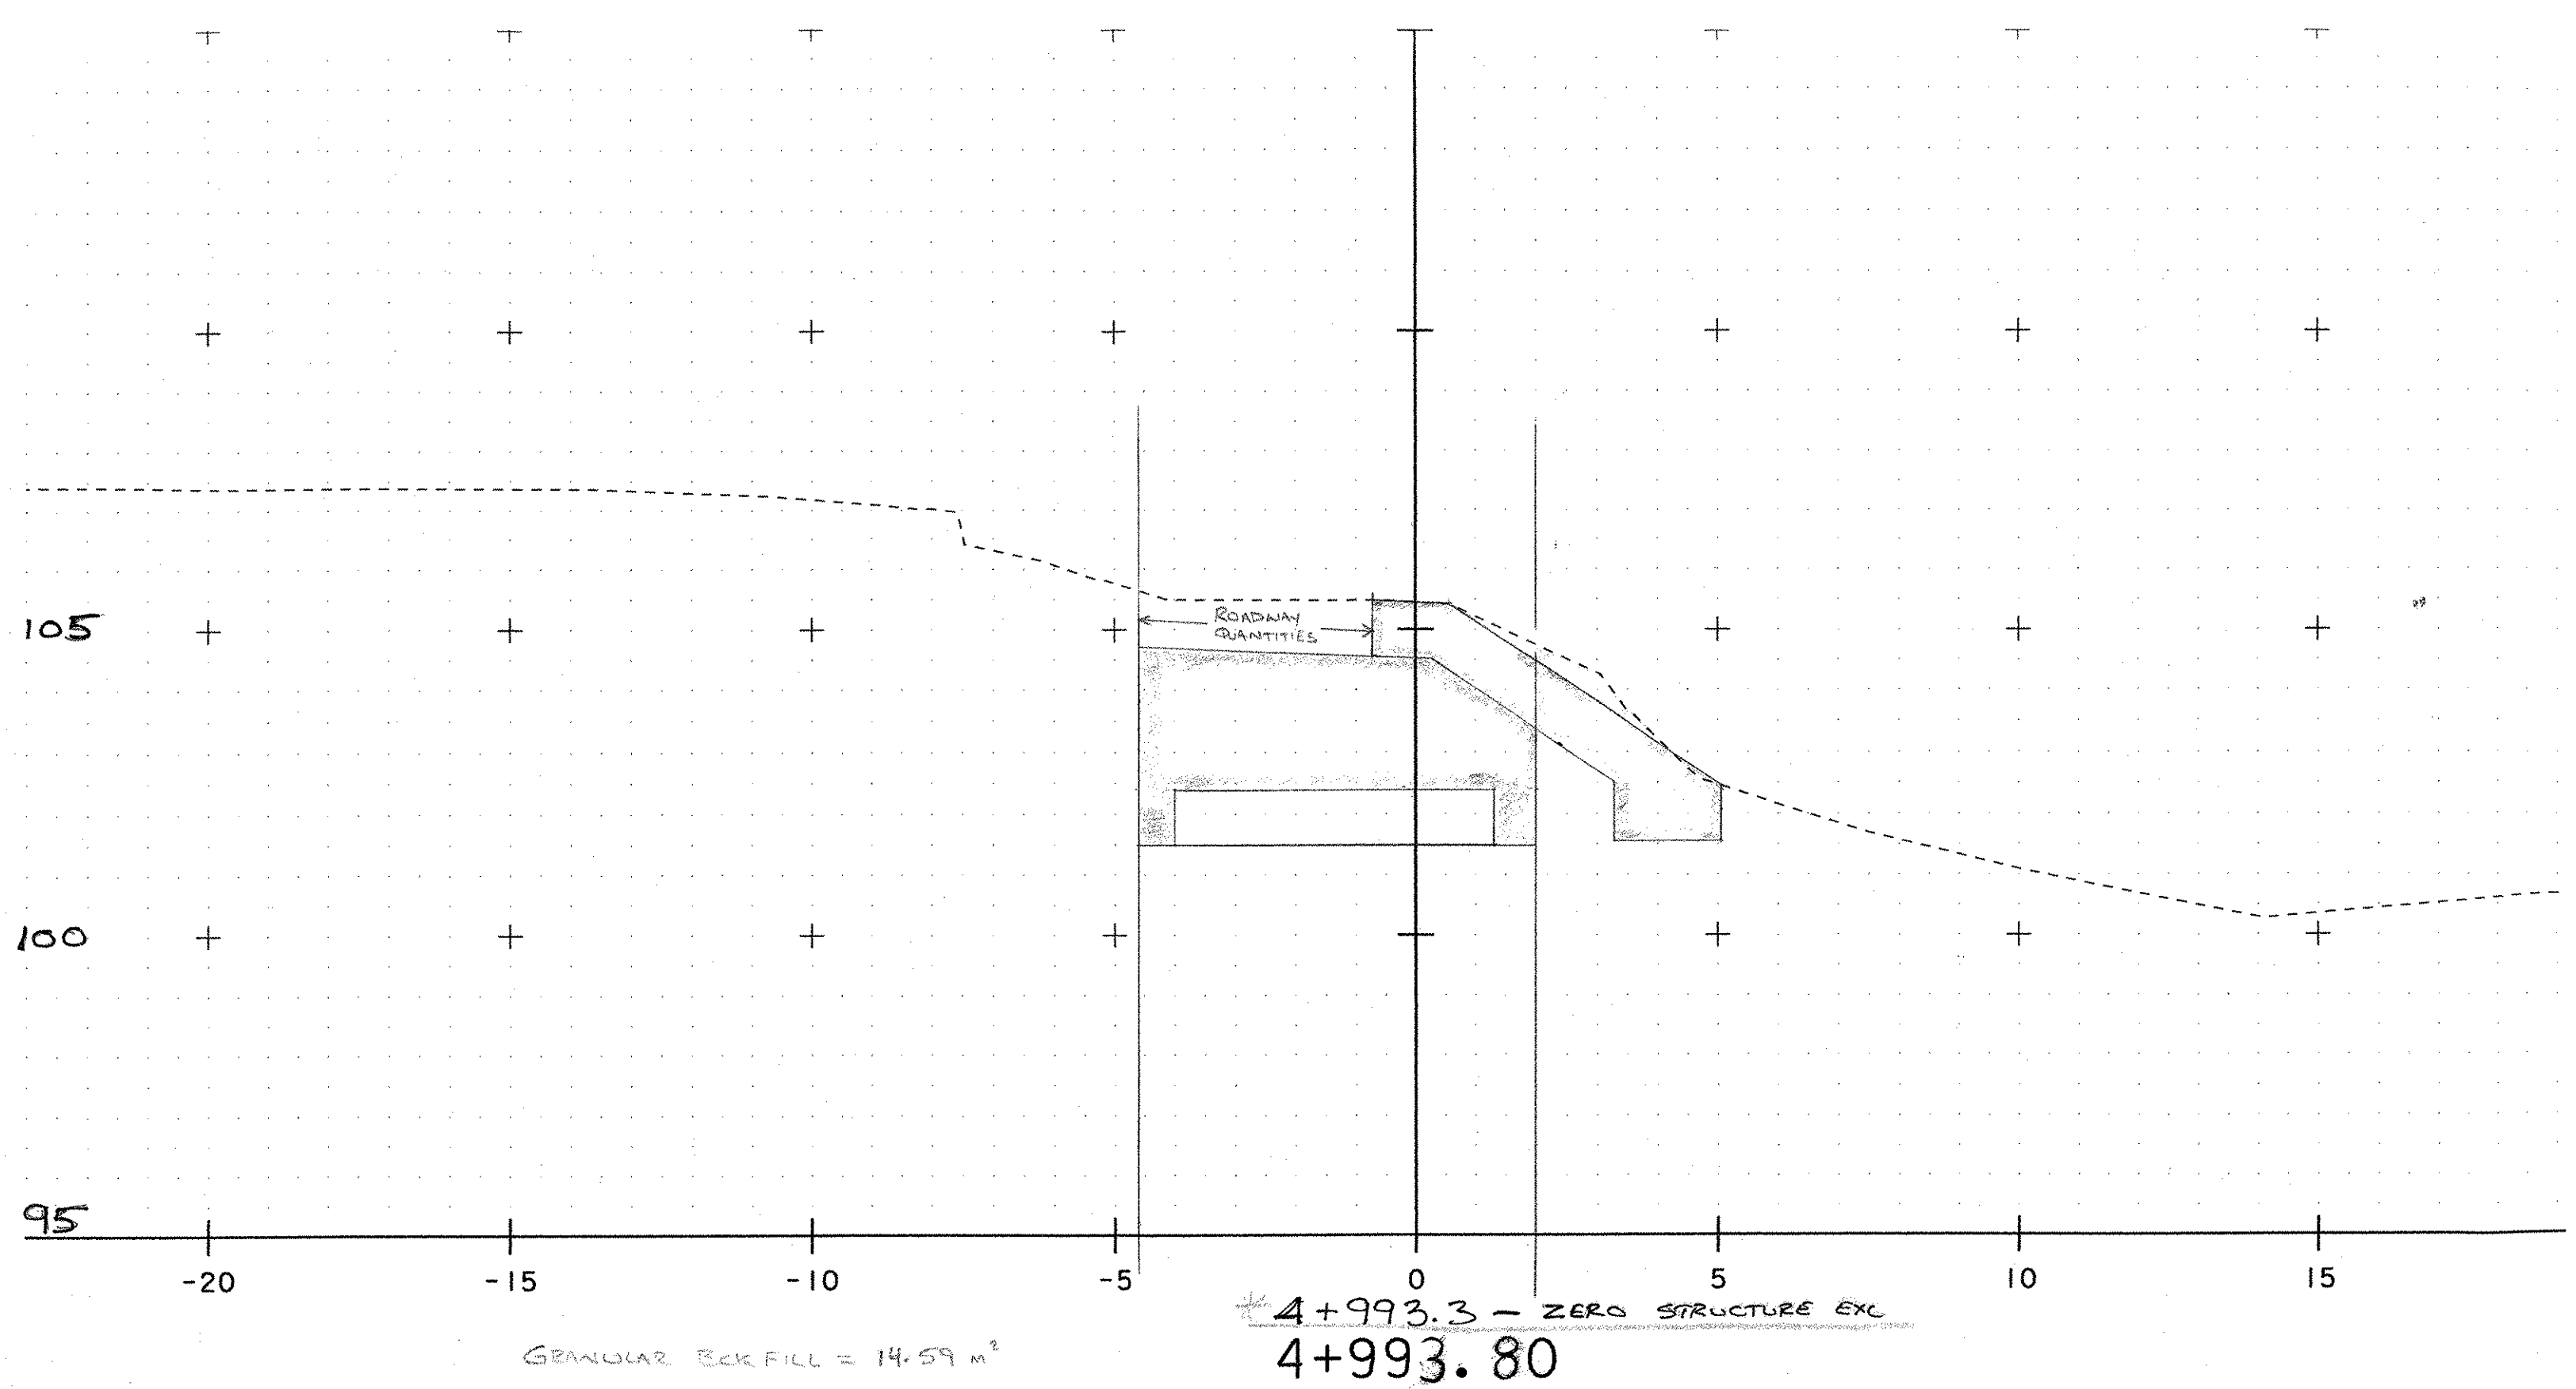


OUTSIDE CORNER LW# 2

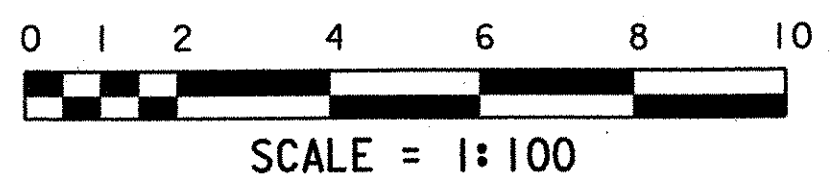


096AB1

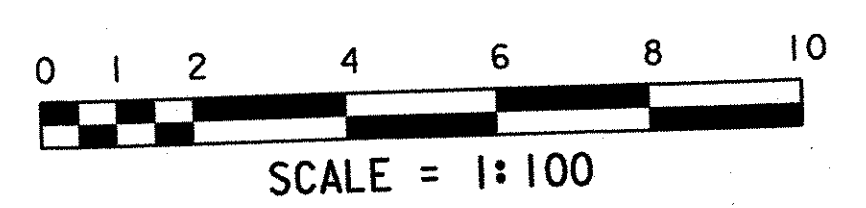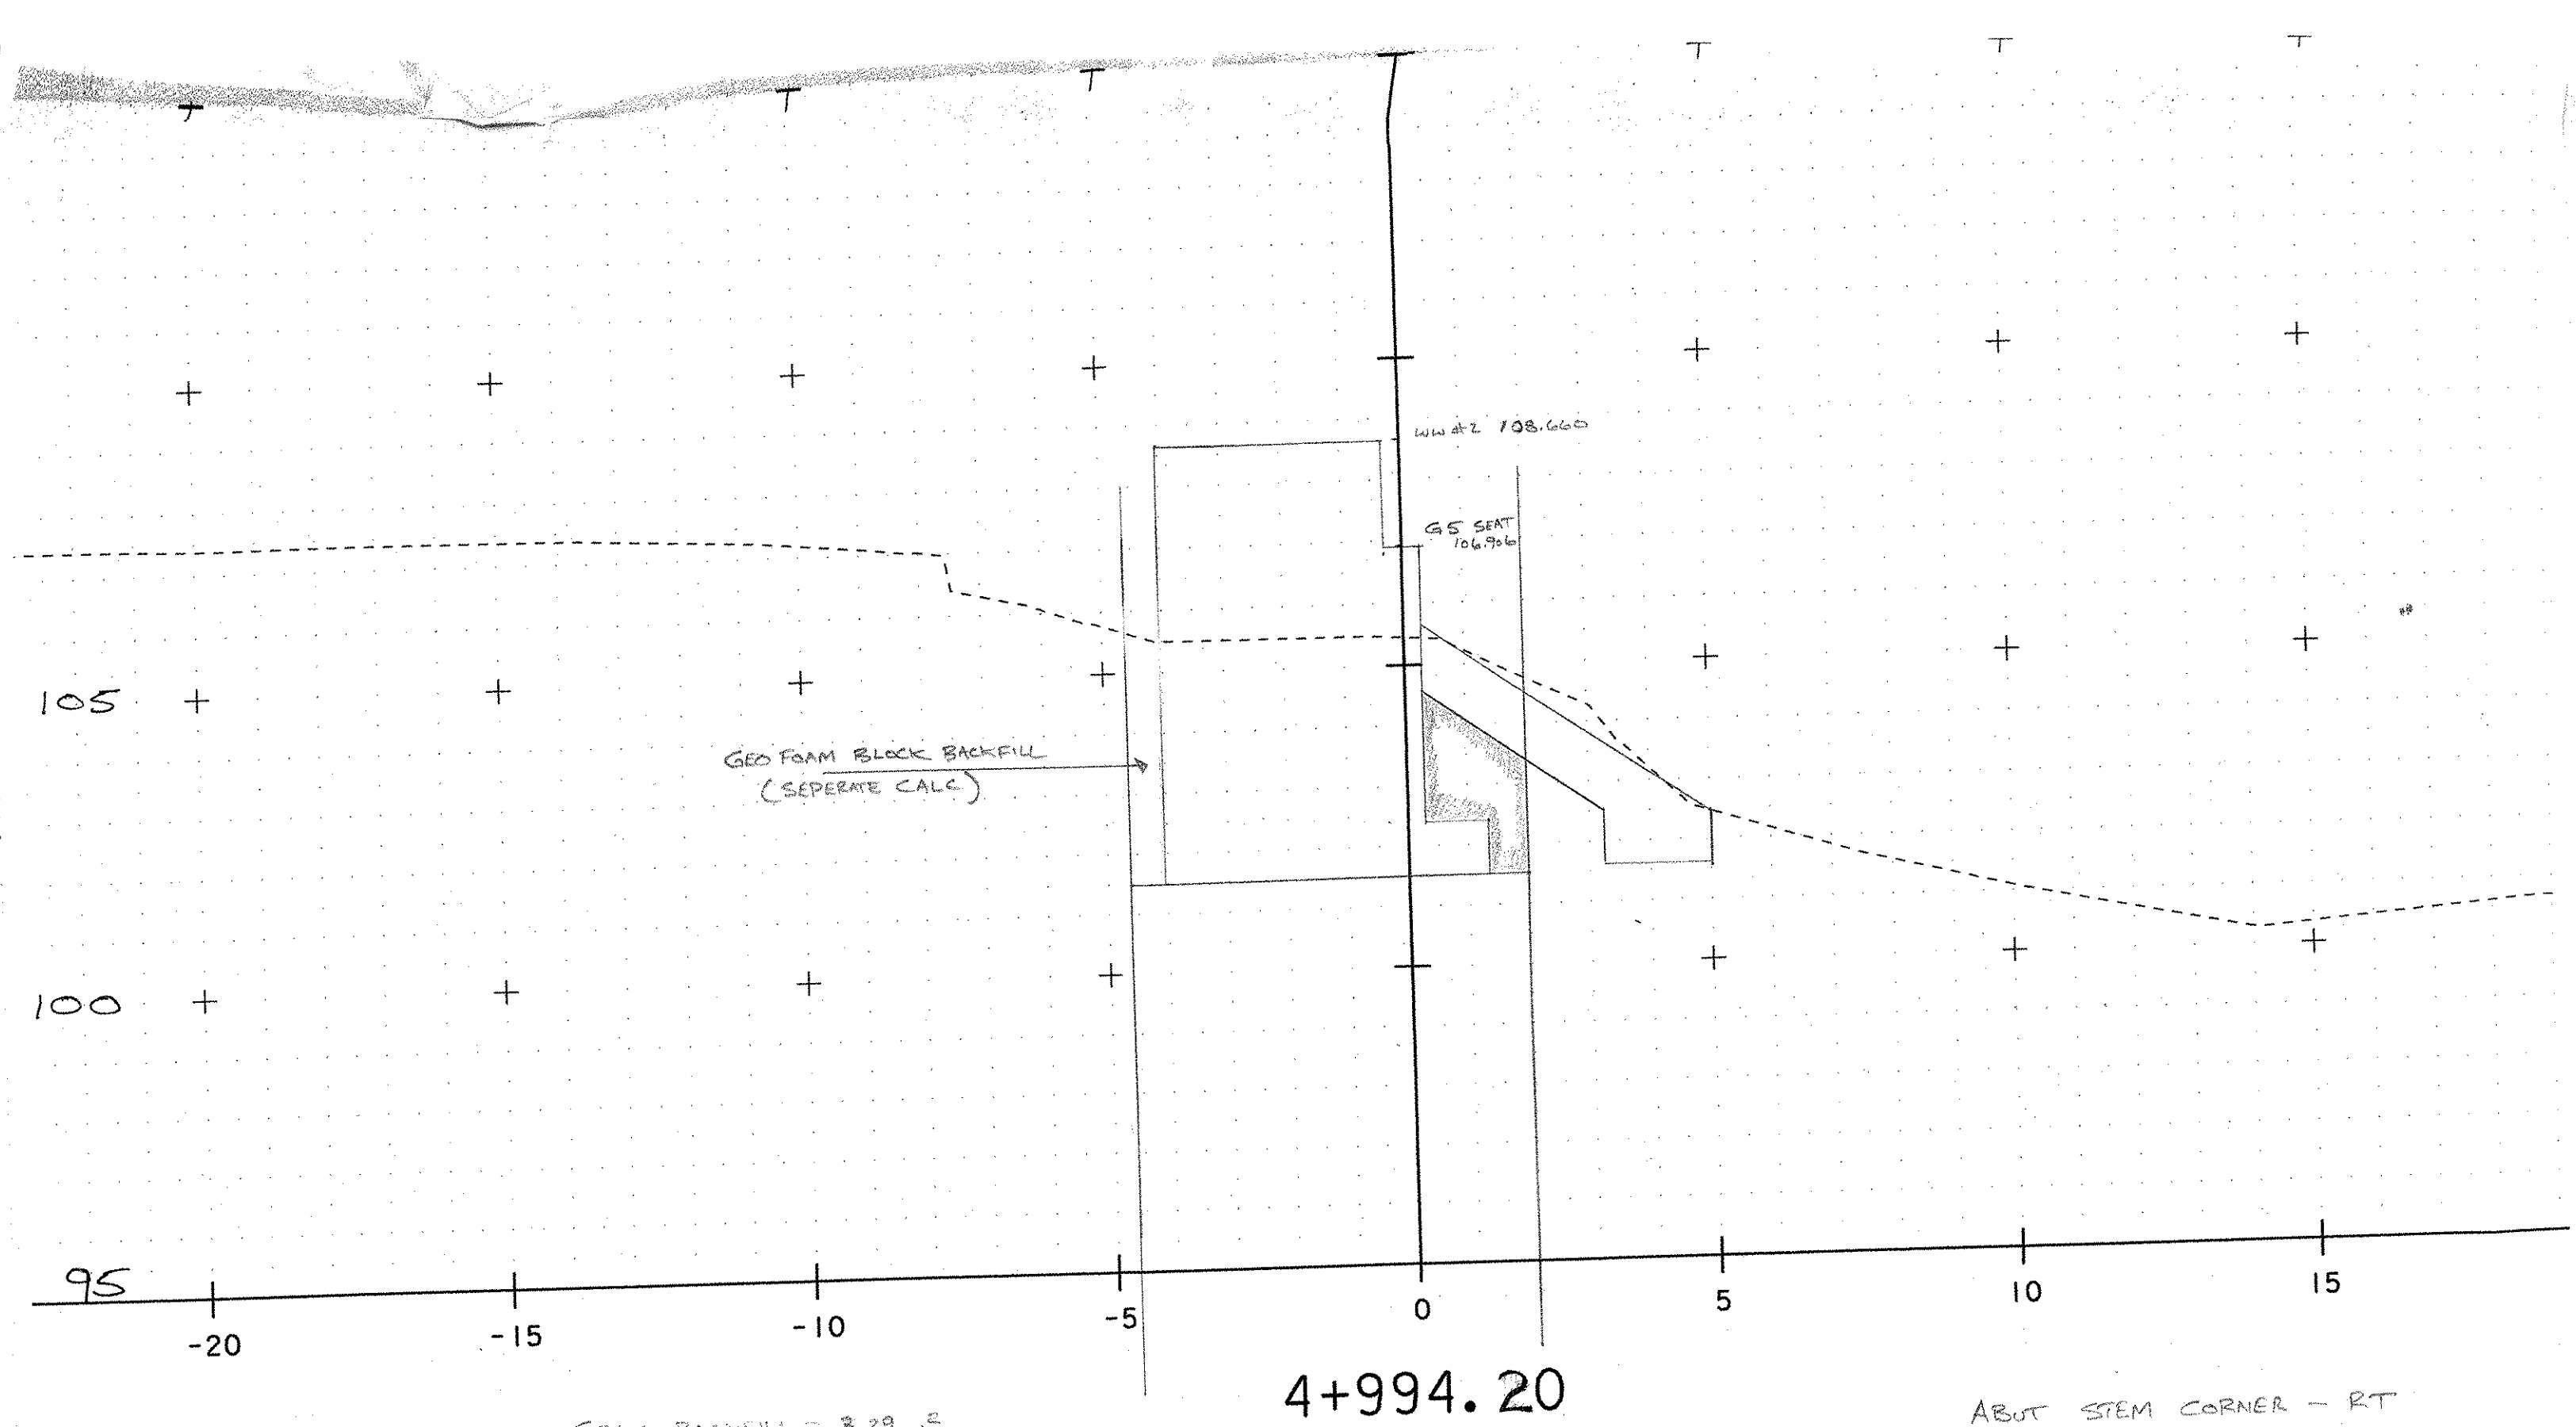

09B AB1

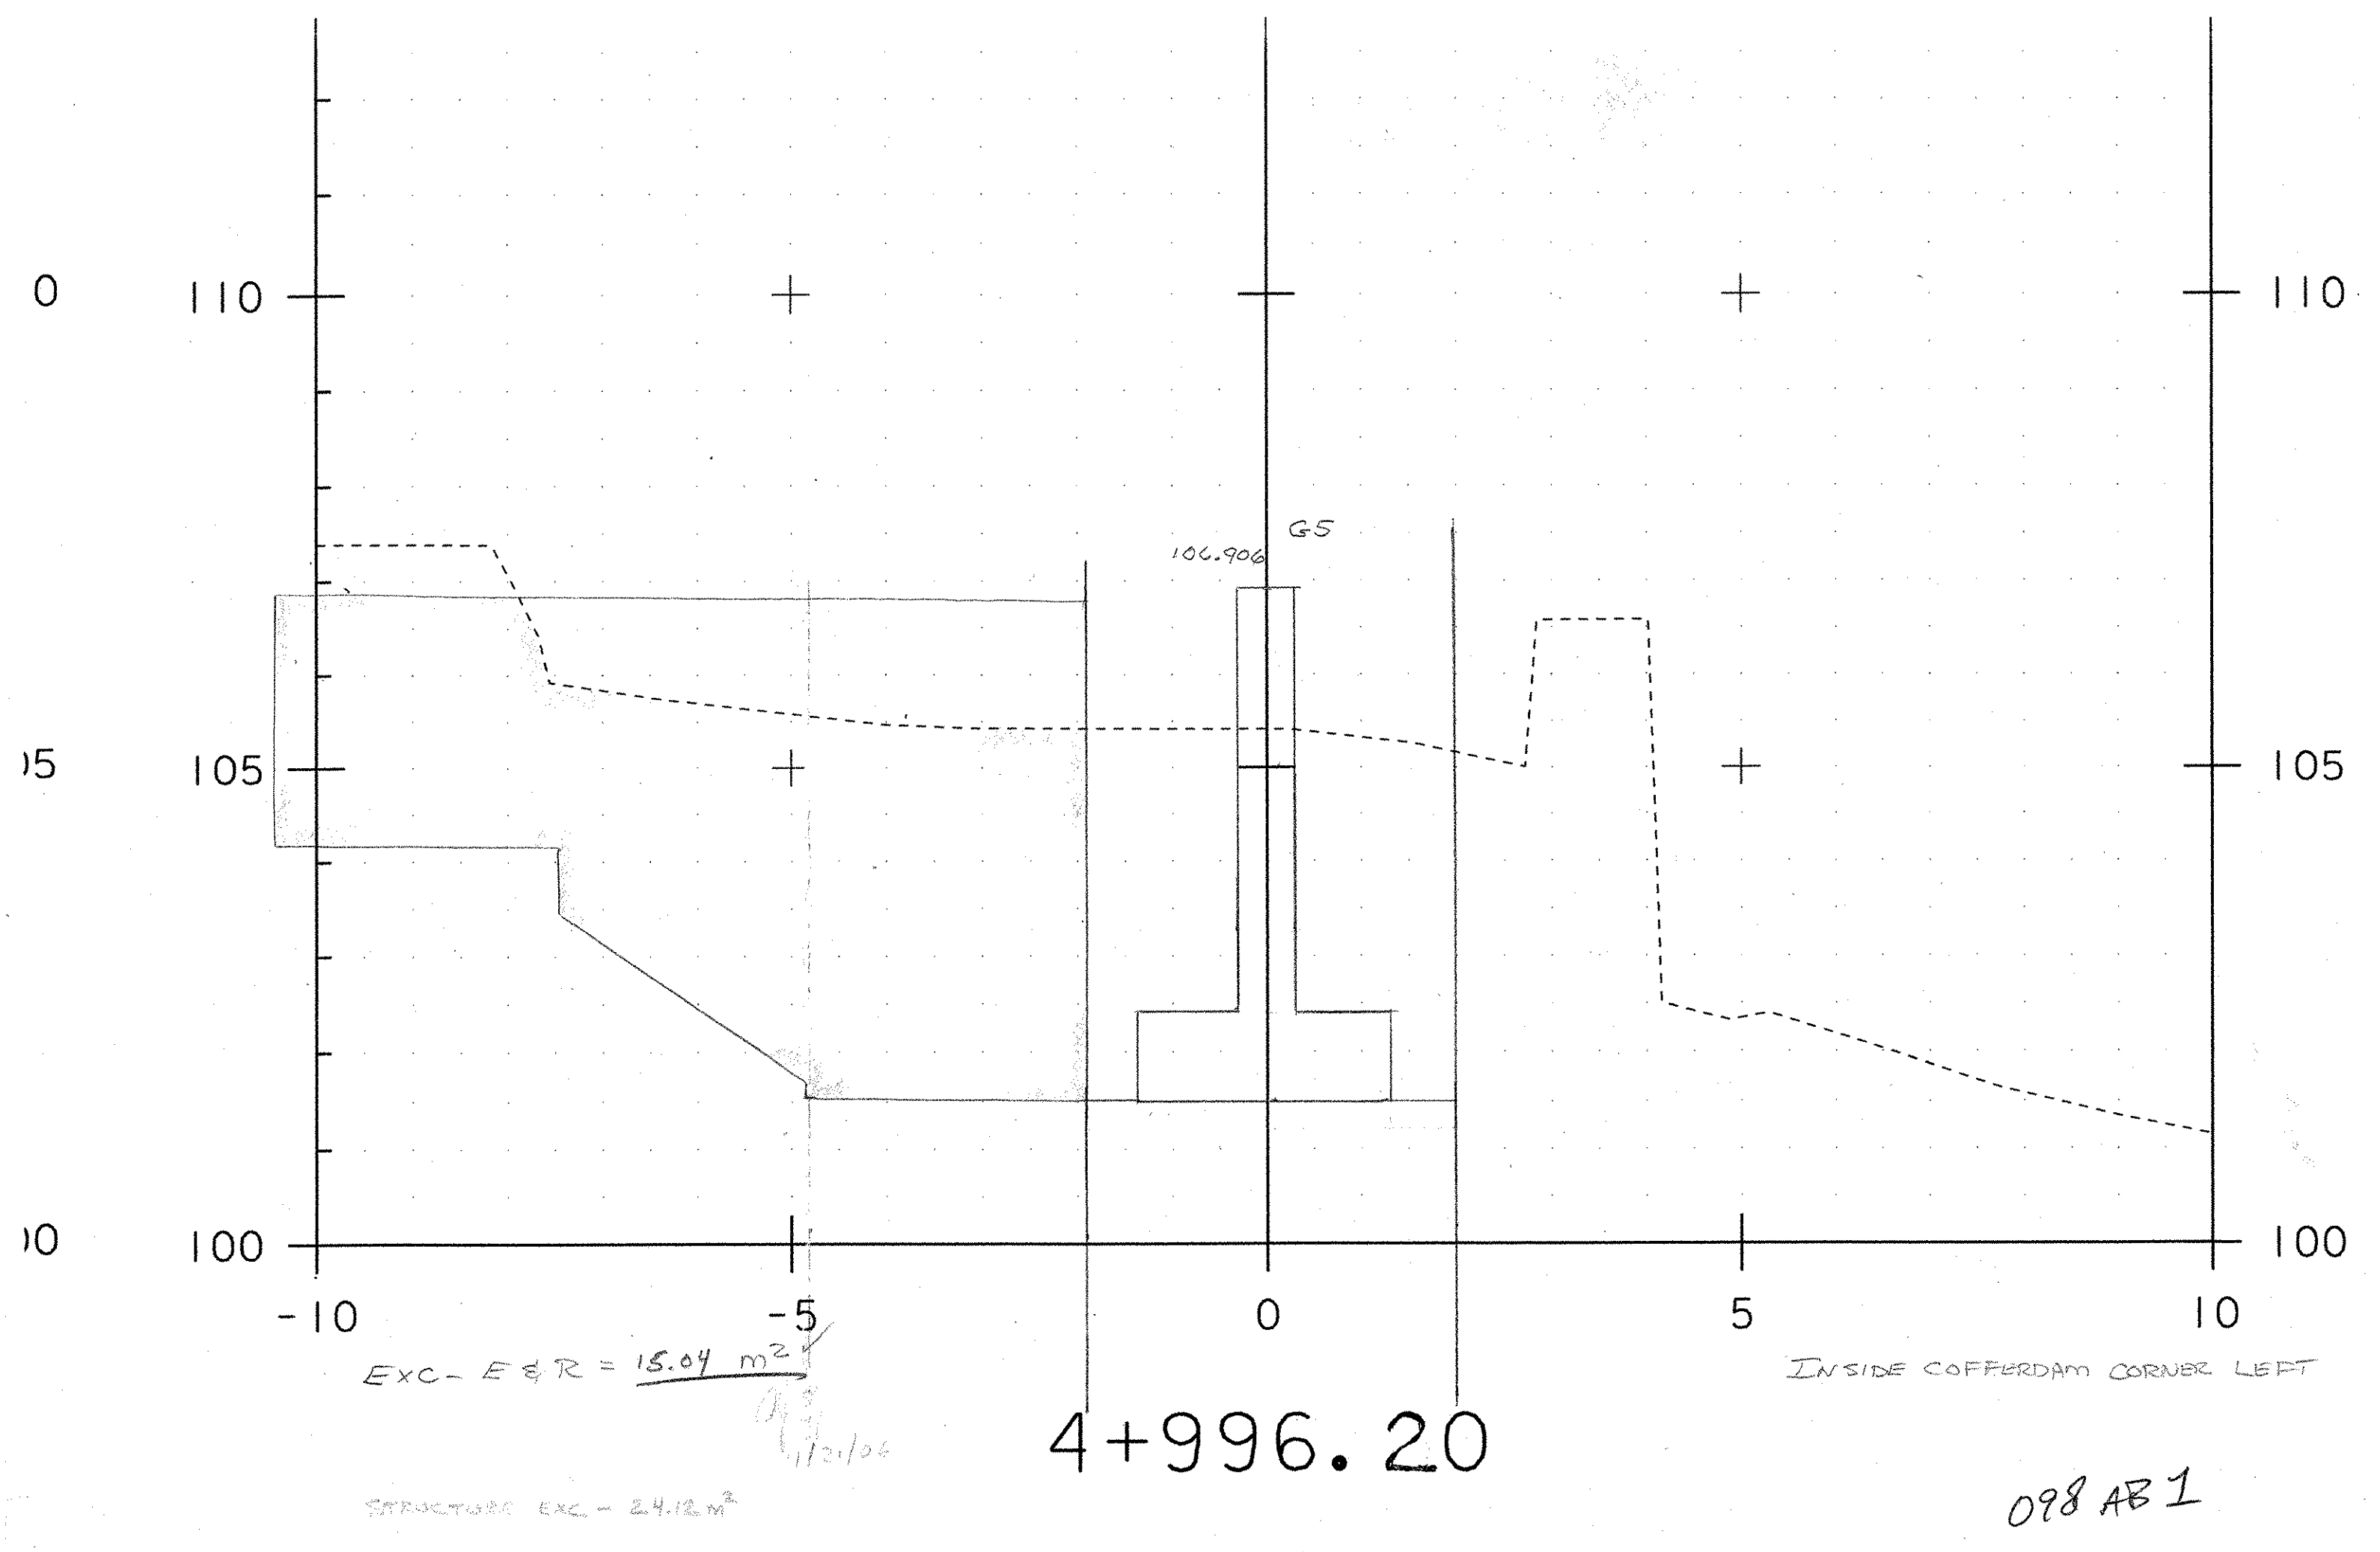


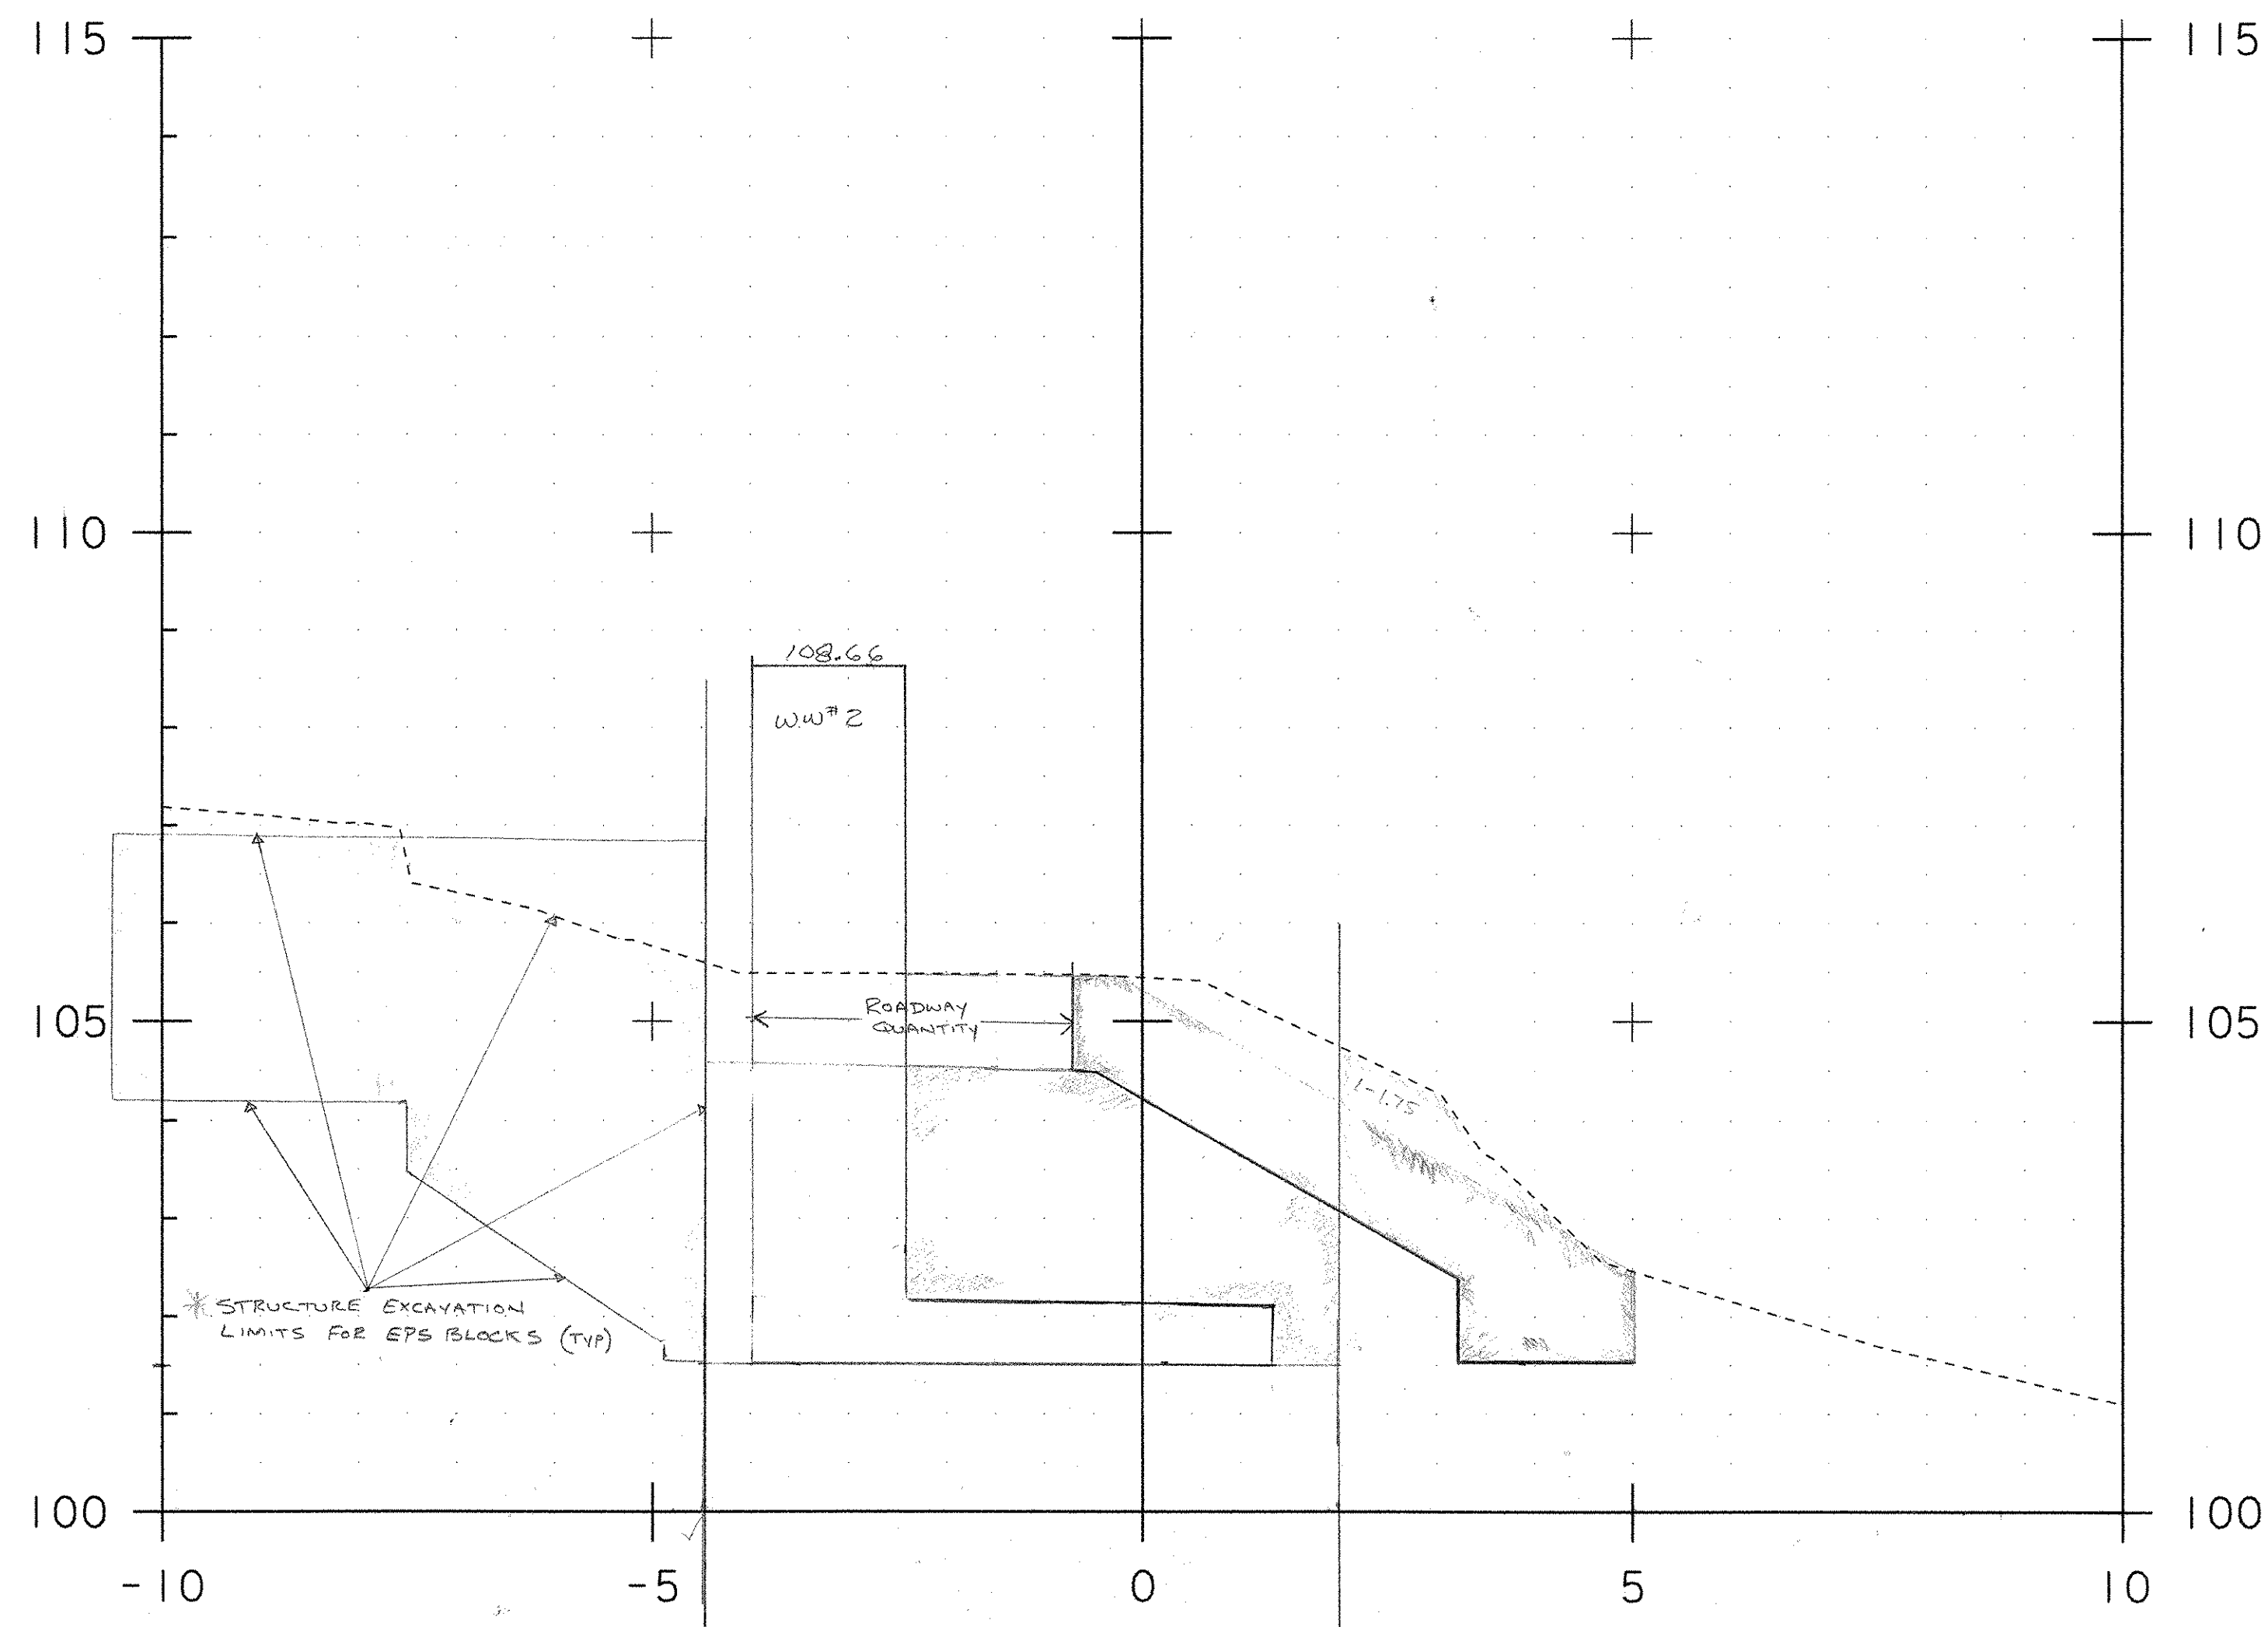

4+994.00

Exc - E & R = 25.15 m² ✓

UNCL GRAN EXC = ~~4.84~~ 4.84 m³ DC 3-5-07
 STONE FILL TYPE III = 6.62 m³
 GRAN BACKFILL = 8.85 m³
 GEO UNDER S.F = 7.1M
 STRUCTURE EXC = 18.79 m²

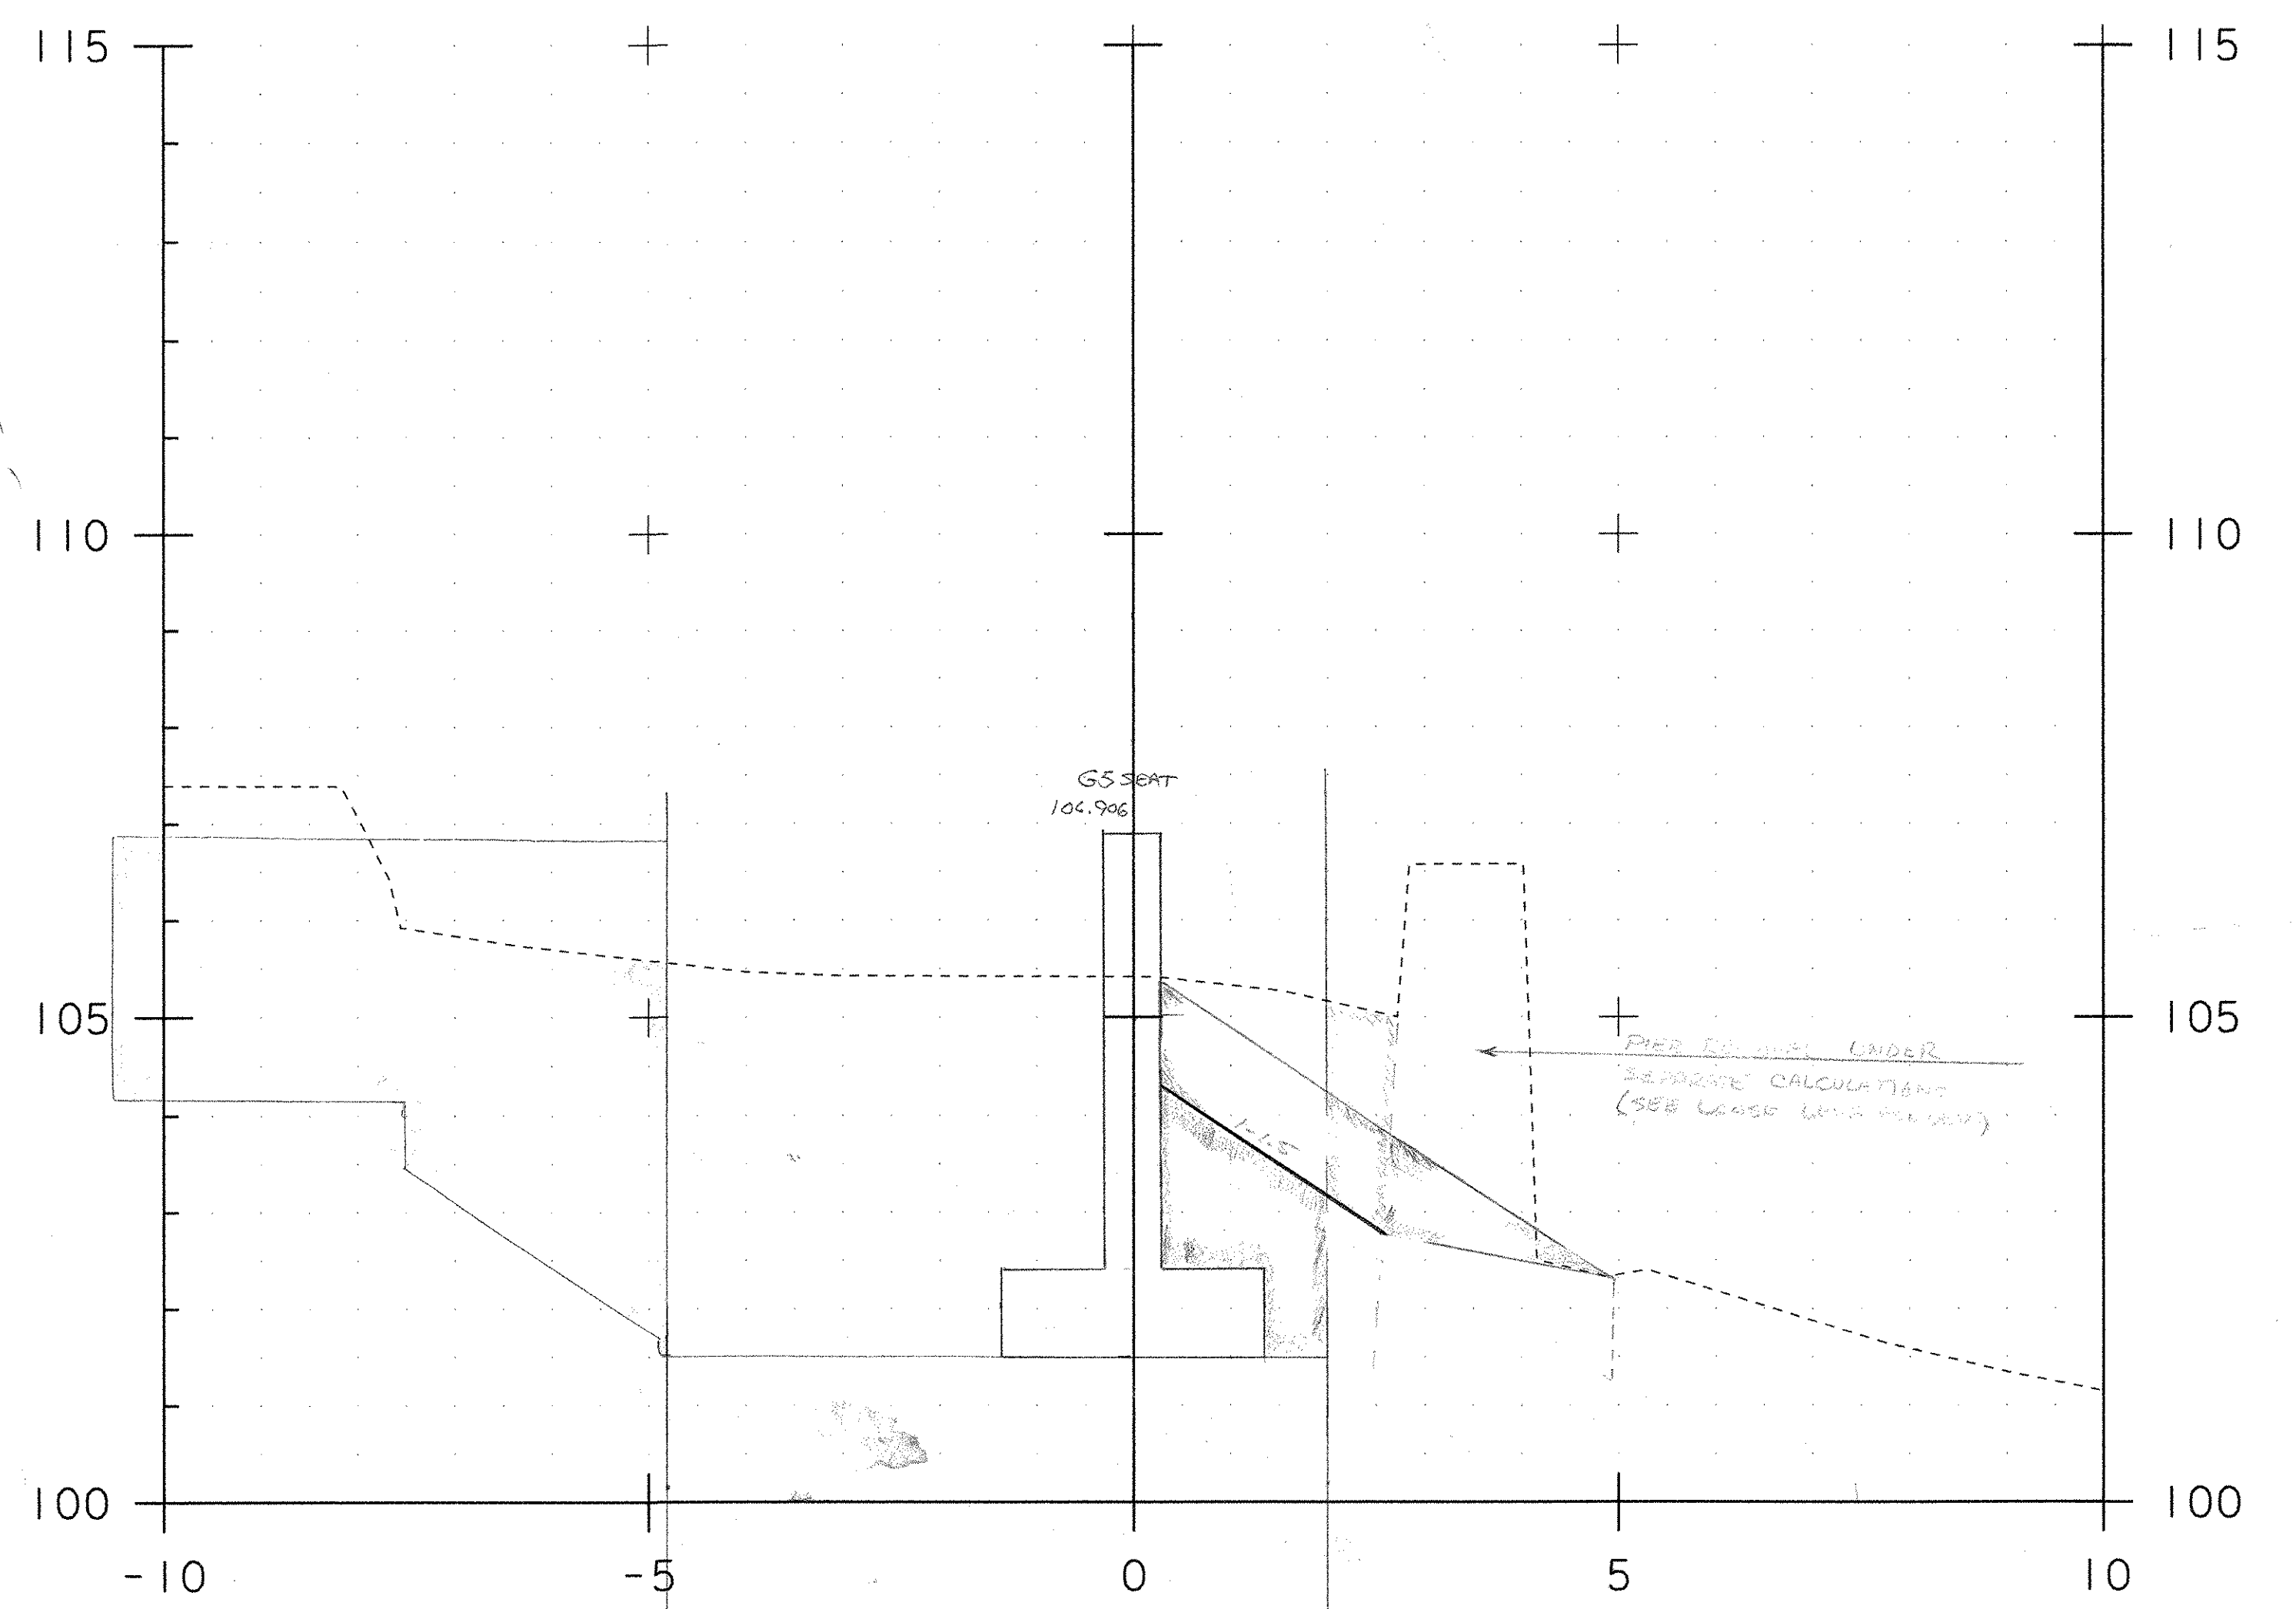


4+996.00

Exc - E & R = 26.50 m² ✓

UNCL GRAN EXC = 1.86 m³ DC 3-5-07
 STONE FILL TYPE III = 3.68 m³
 GRAN BACKFILL = 2.82 m³
 GEO UNDER S.F = 2.7M
 STRUCTURE EXC = 16.22 m²


PROJECT NAME: Leicester	
PROJECT NUMBER: BRF 0160(3)S	
FILE NAME:	PLOT DATE: 01-NOV-2005
PROJECT LEADER:	DRAWN BY: R. Bullock
DESIGNED BY:	CHECKED BY:
094 099 AB1	SHEET 3 OF 8

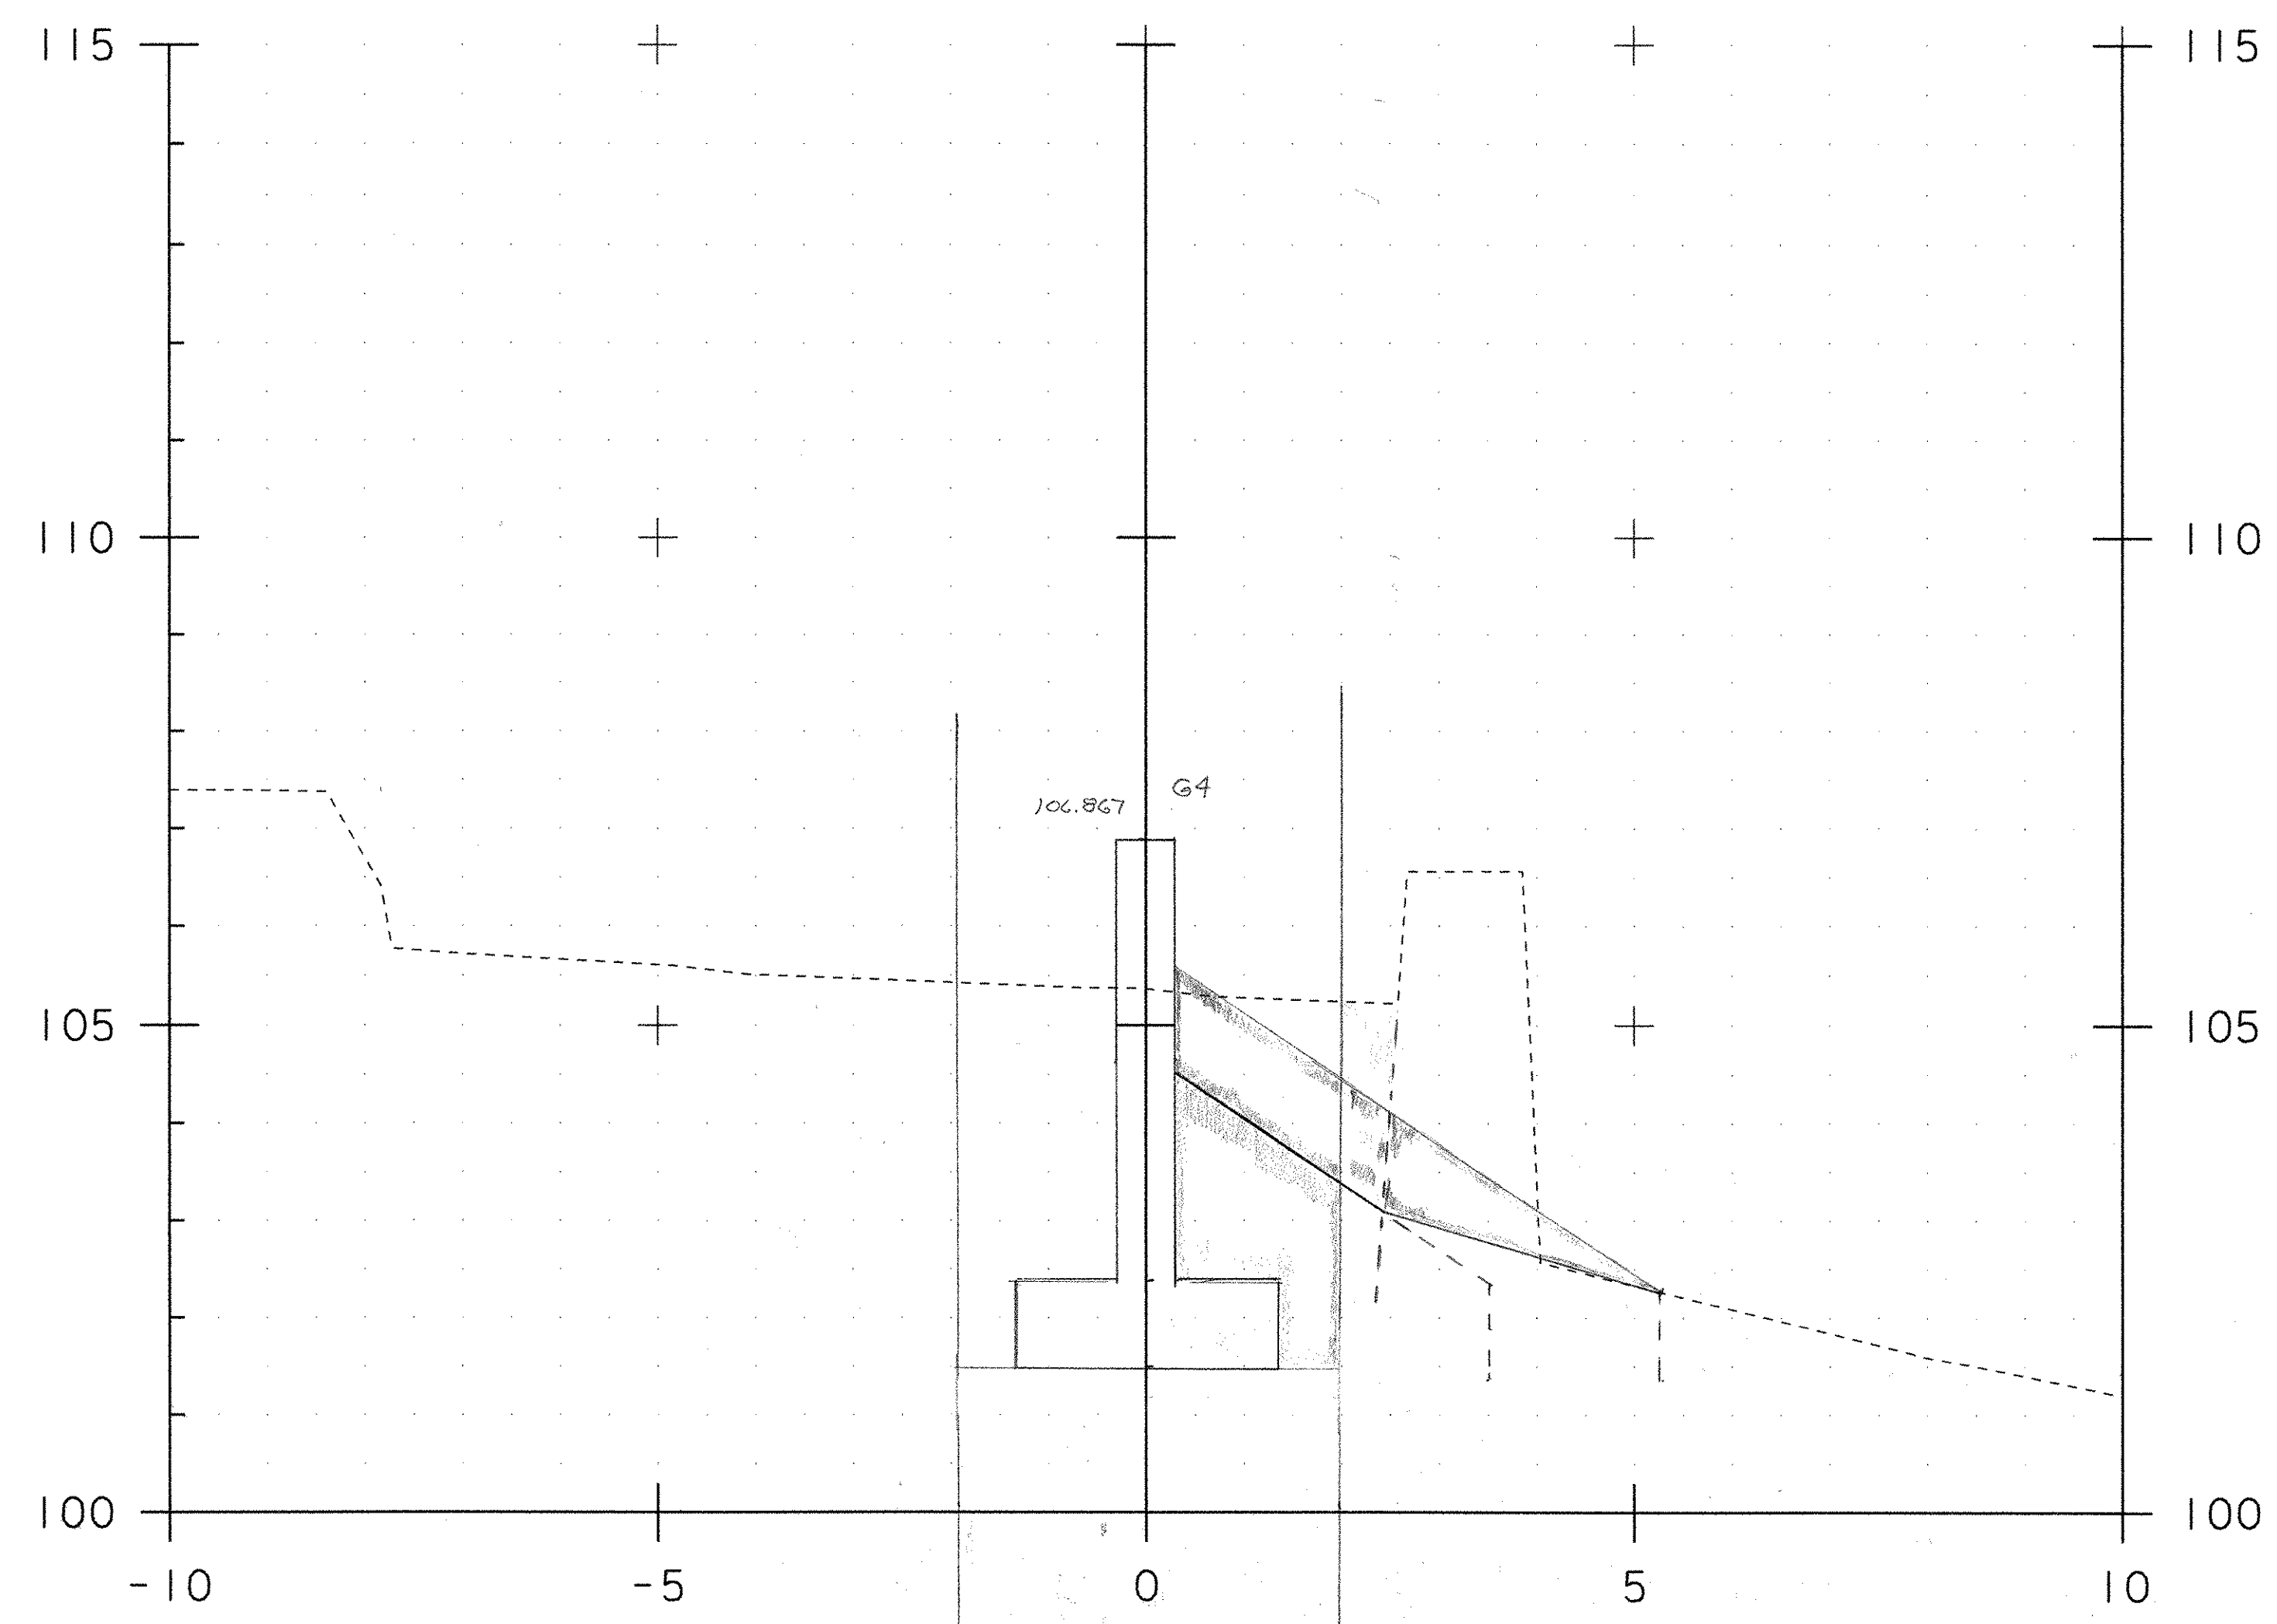

4+998.00

Exc - E & R = 1521 m²

- ONE CHAN. EXC - 0.97 m²
- GRAIN BACKFILL - 3.23 m²
- GEO UNDER S.F - 2.6 m
- STONE FILL TYPE III - 3.73 m²

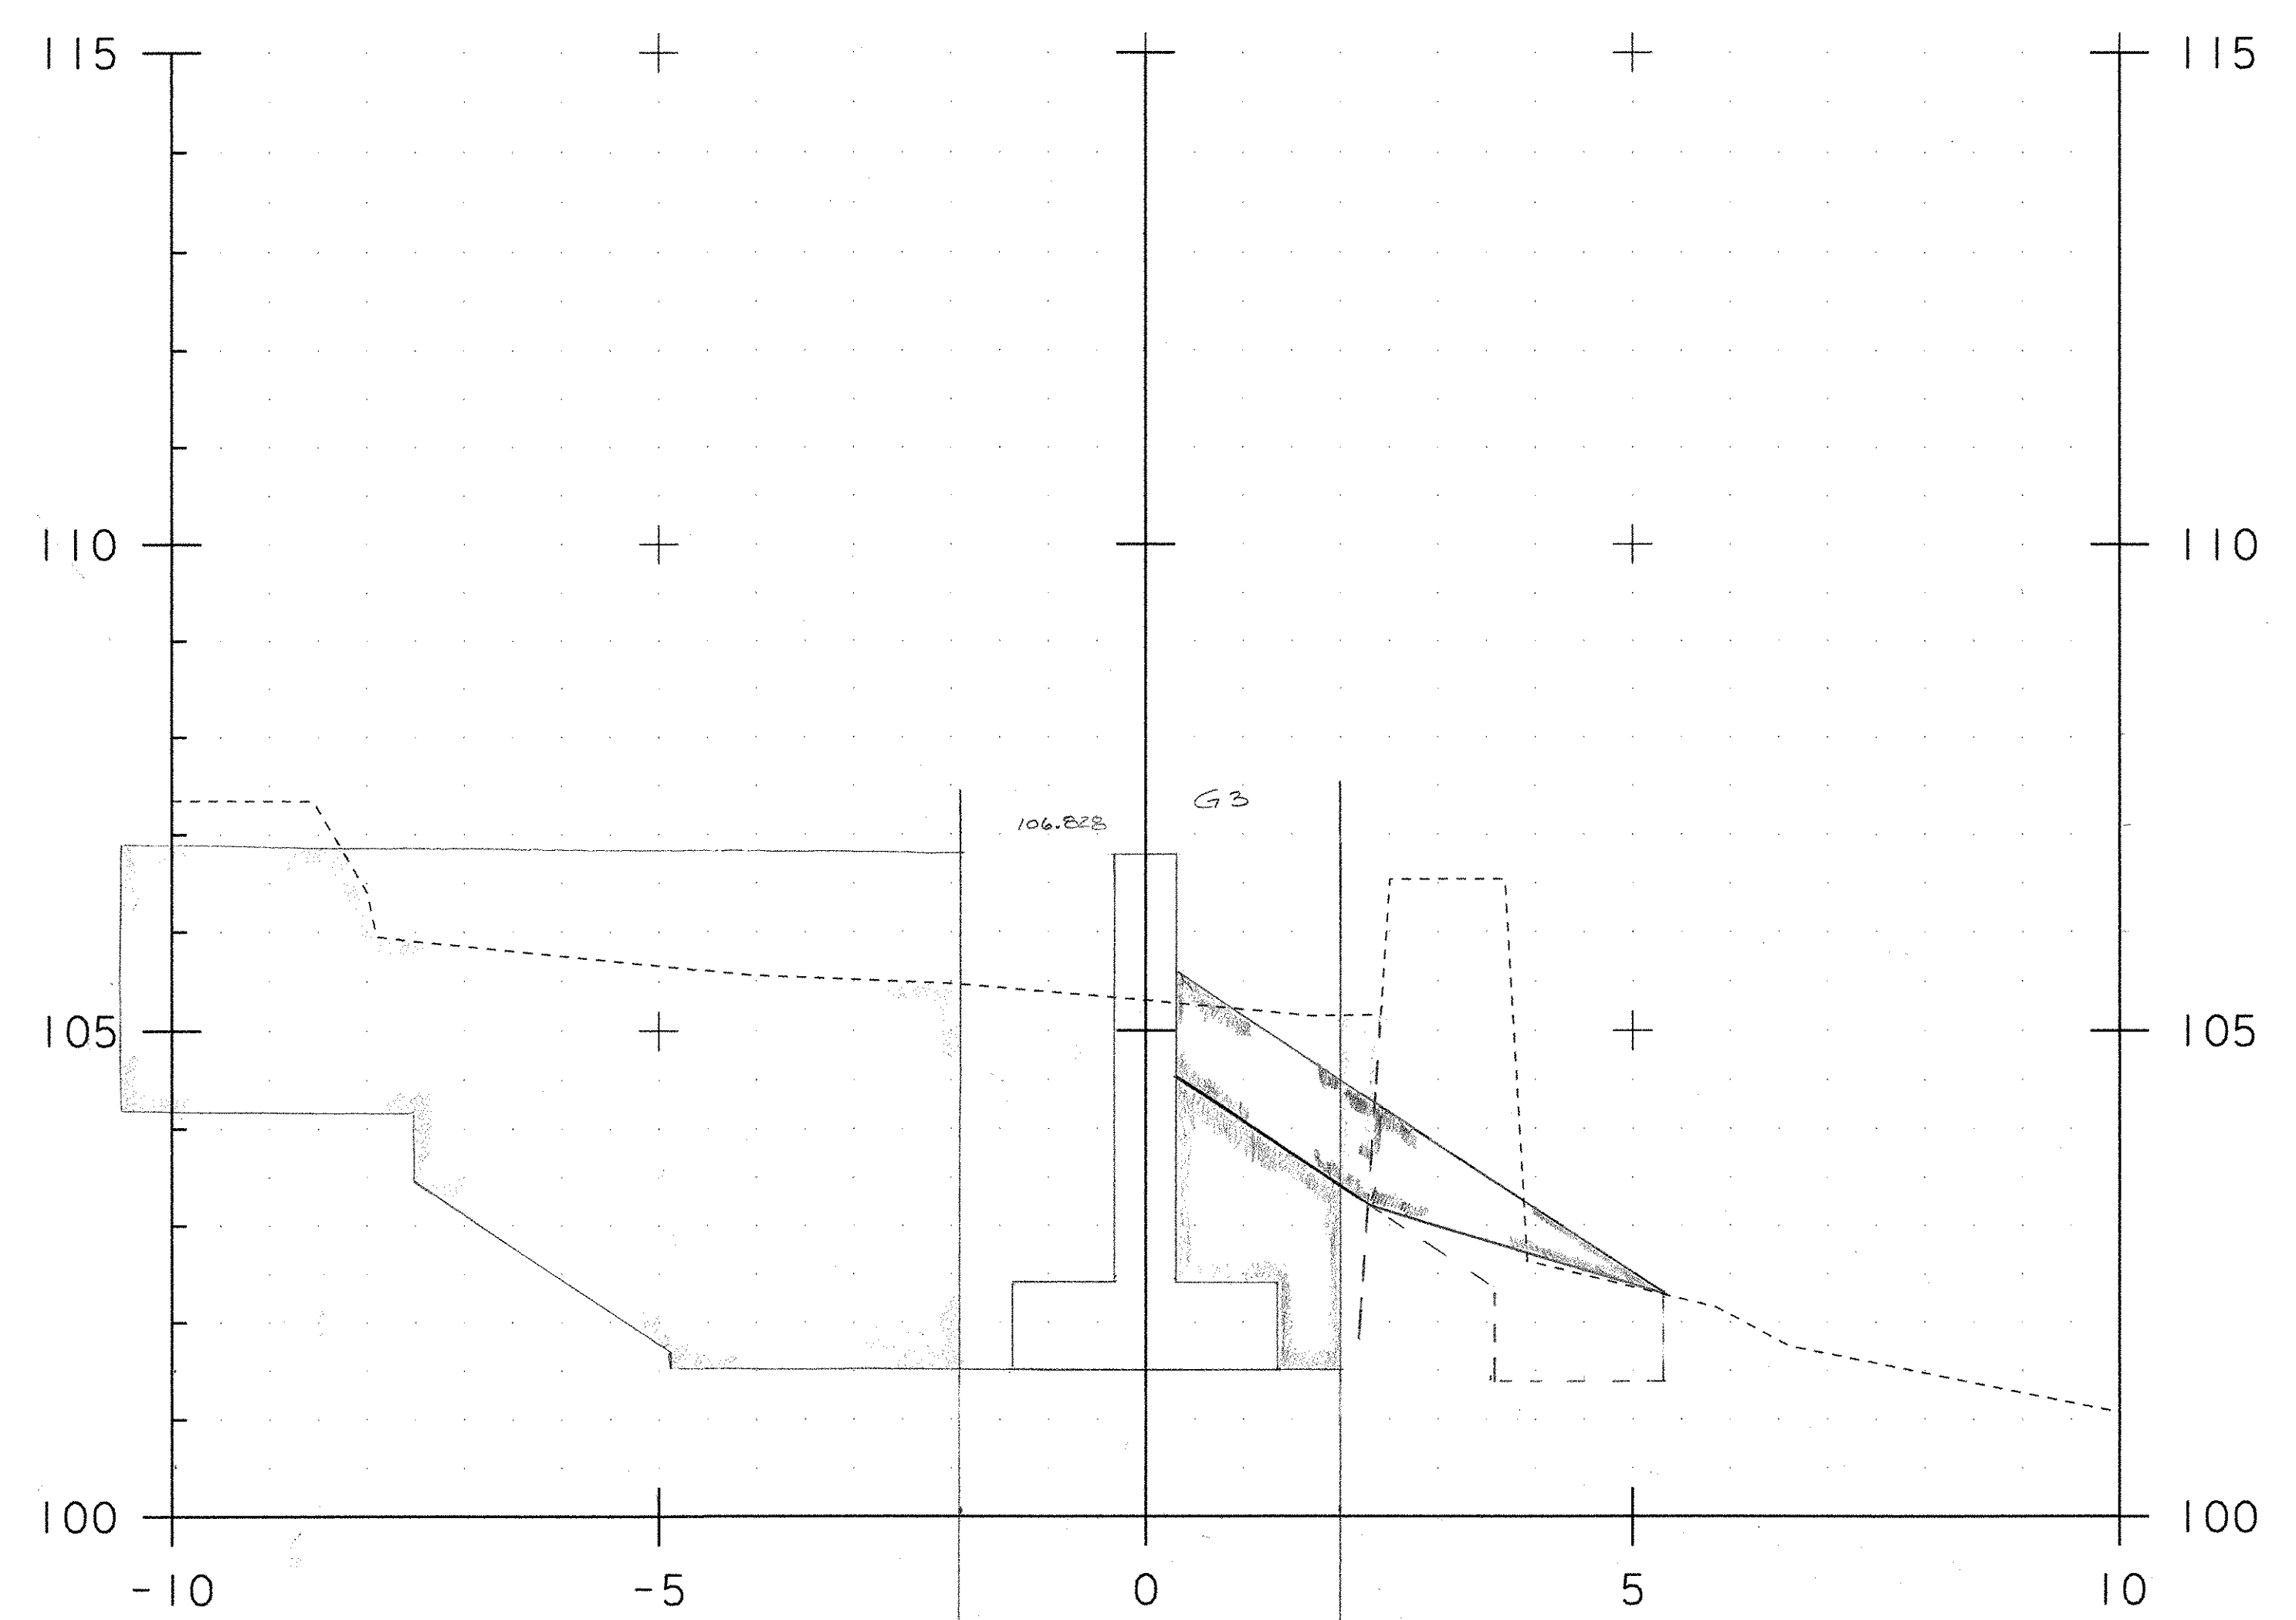


5+000.00

Exc - E & R = 14.82 m²

- ONE CHAN. EXC - 0.89 m²
- GRAIN BACKFILL - 3.12 m²
- GEO UNDER S.F - 2.35 m
- STONE FILL TYPE III - 3.8 m²
- STRUCTURE EXC - 28.76 m²

PROJECT NAME:	Liecester		
PROJECT NUMBER:	BRF 0160(3)S		
FILE NAME:		PLOT DATE:	01-NOV-2005
PROJECT LEADER:		DRAWN BY:	R. Bullock
DESIGNED BY:		CHECKED BY:	
	100 AB1	SHEET 4	OF 8

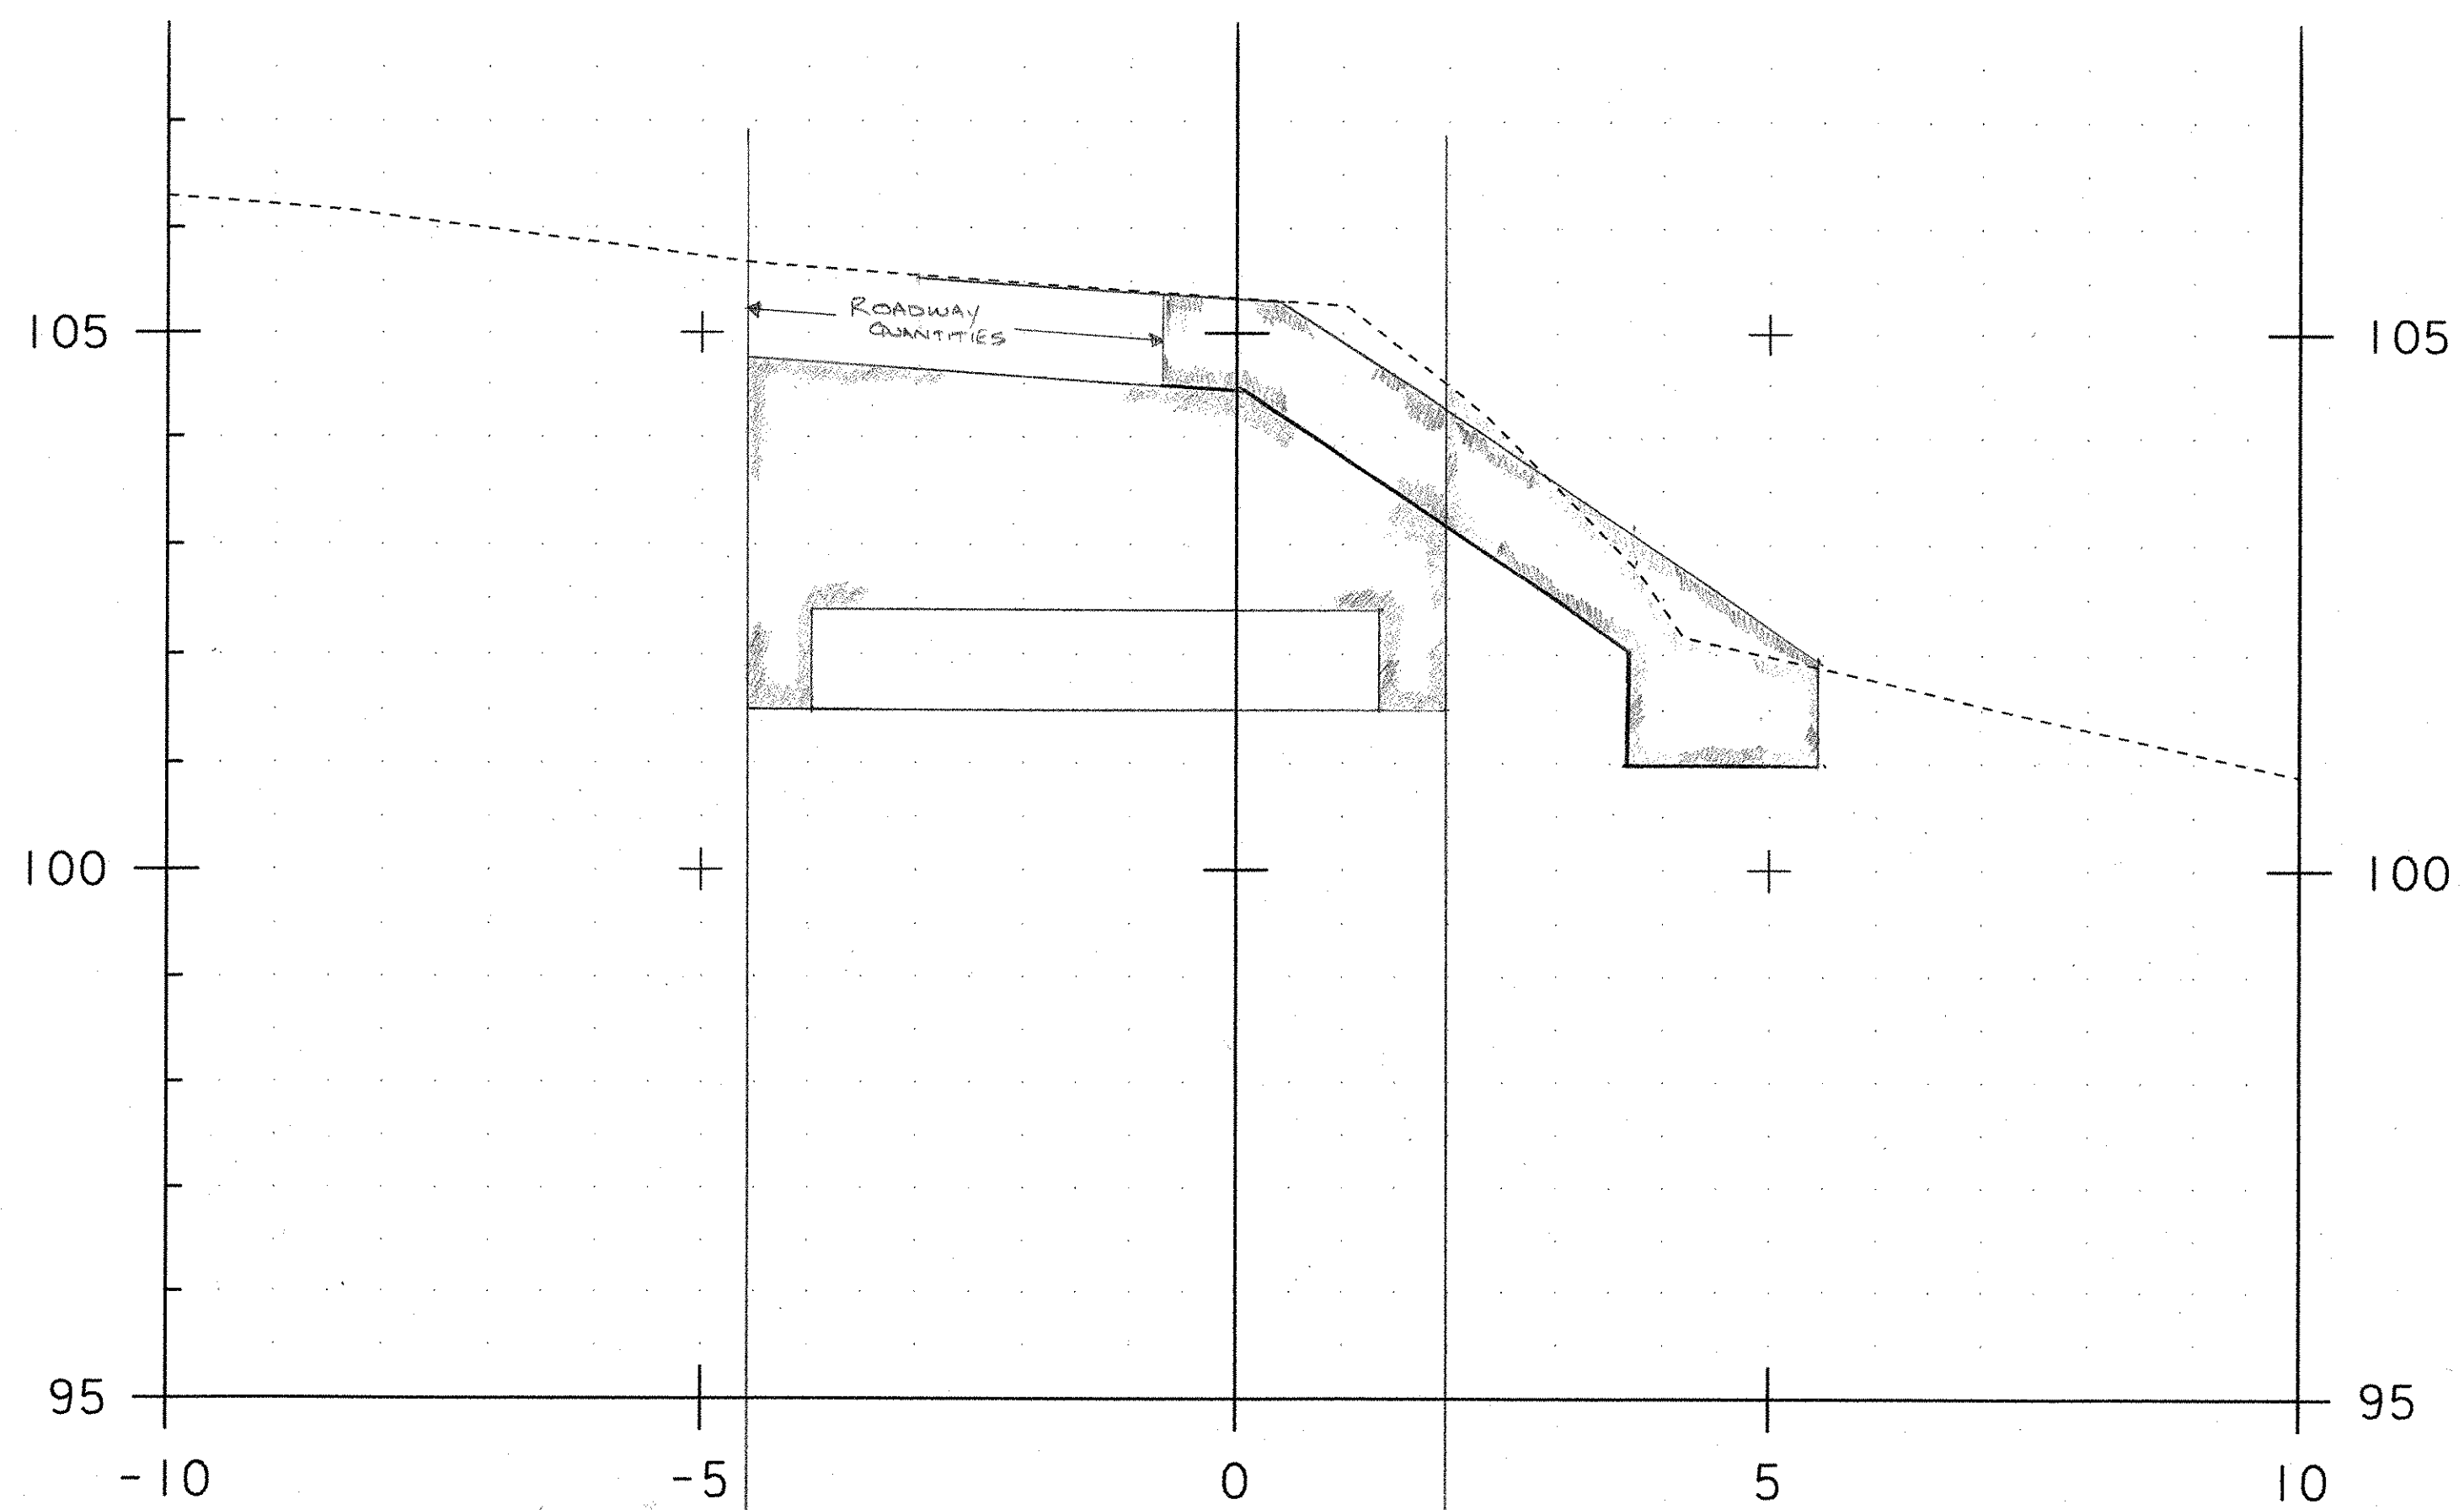

CONCRETE CURB - 6.03 M³

GRAN. BACKFILL - 13.93 M³

STONE FILL TYPE III - 7.52 M³


GEO UNDER S.F - 7.9 M

5+005.80

WW#1 / ABUT STEM CORNER

101 AB1

3

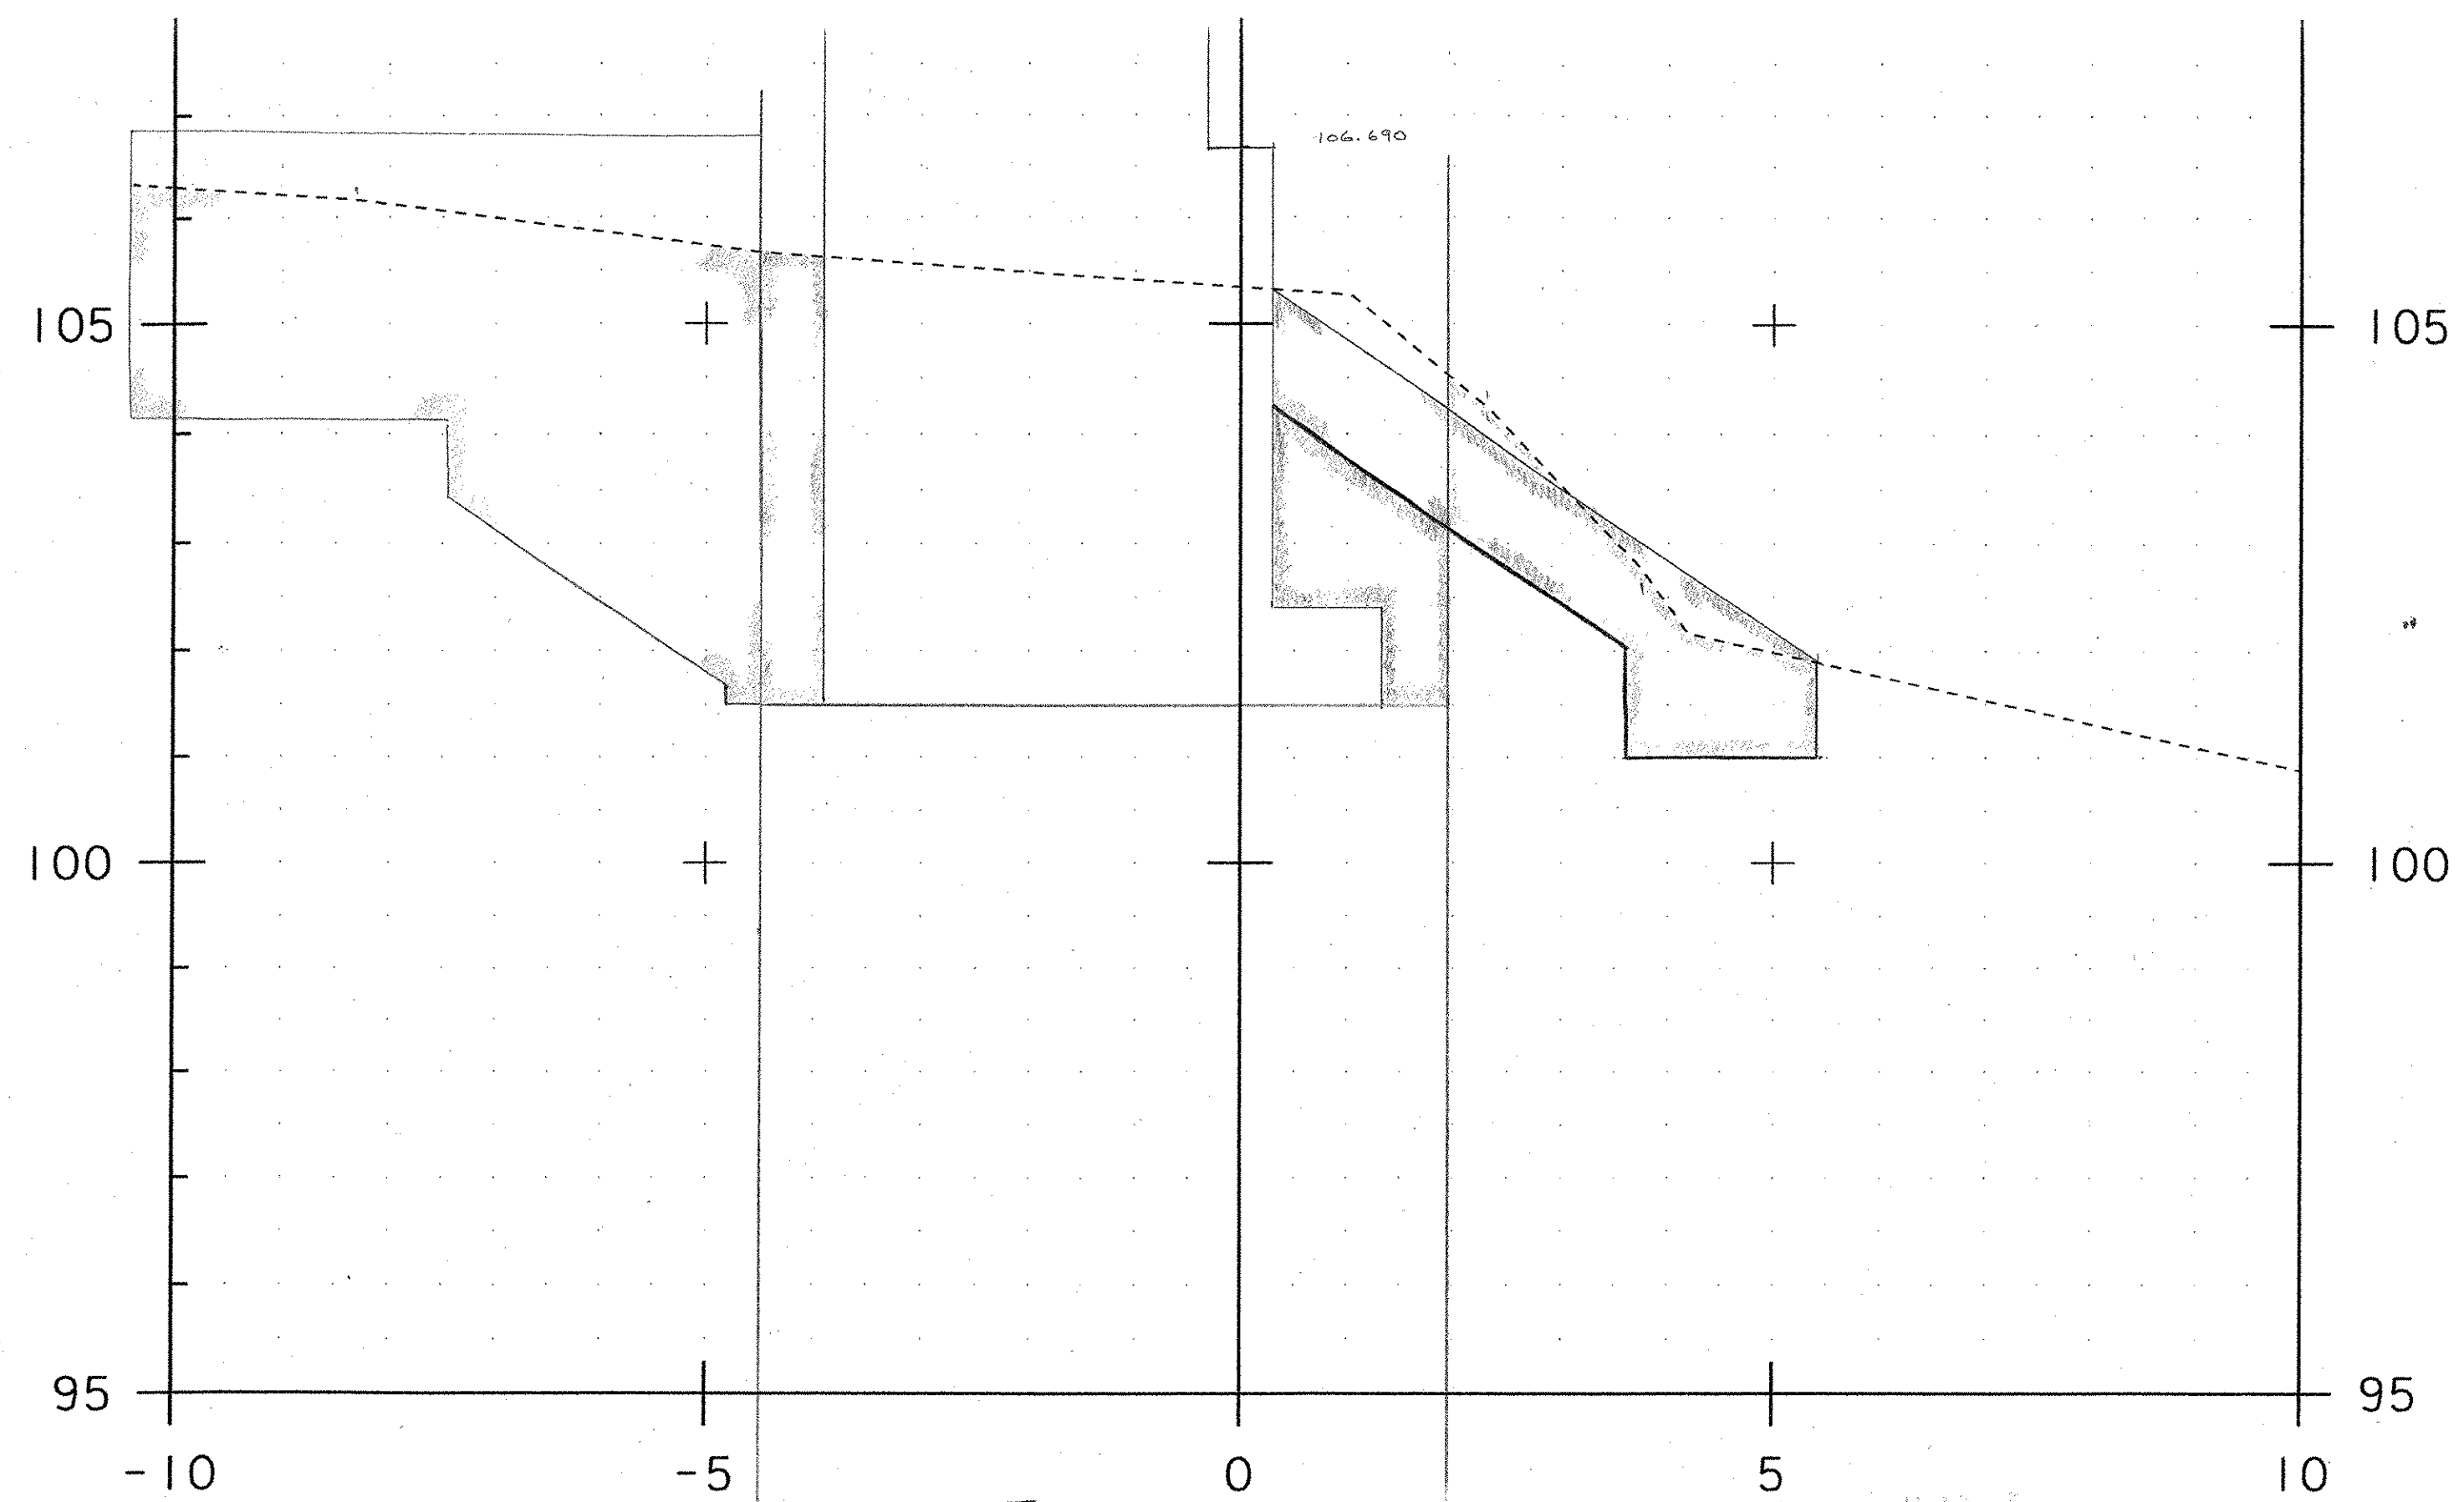


STA 5+005.0 - STRUCTURE EXC -


* 5+005.0 - STRUCTURE EXC ONLY


5+005.40

UND CHAN EXC - 4.13 M²
 GRAM BACKFILL - 5.23 M²
 STONE FILL TYPE III - 6.55 M²
 GEO UNDER S.F - 6.8 M
 STRUCTURE EXC - ZERO
 WW# 1 CORNER

102 AB1

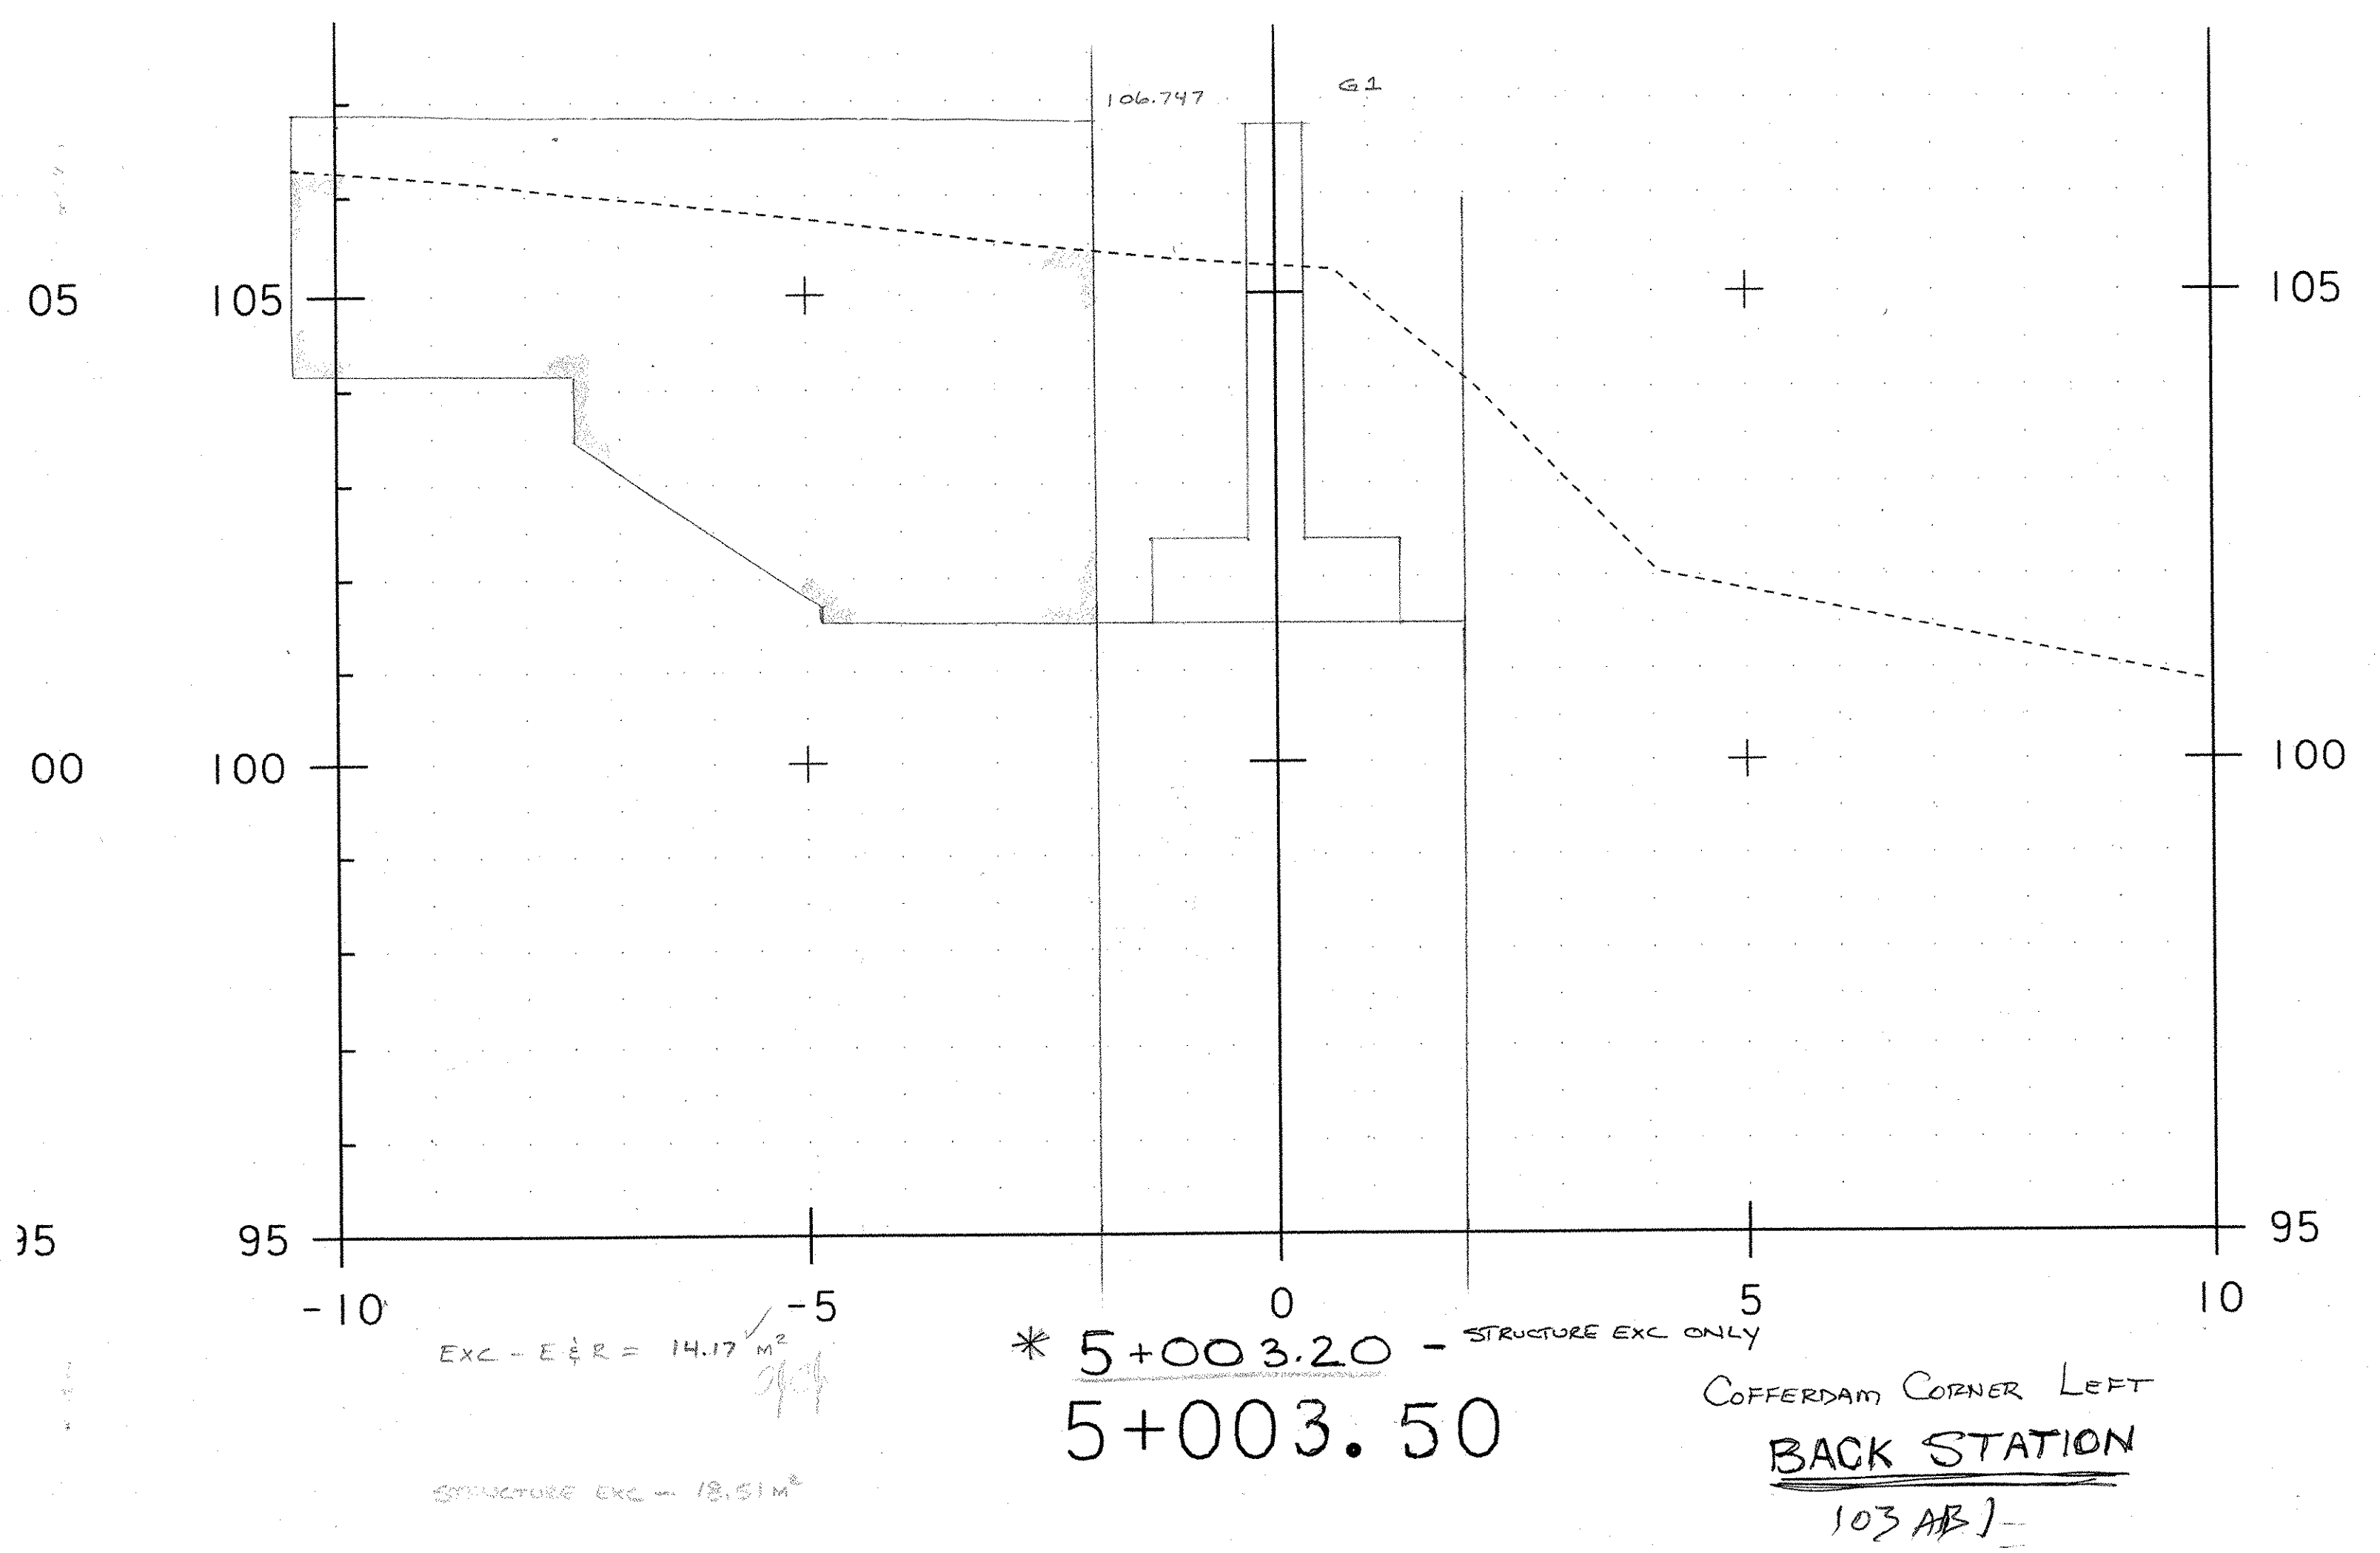


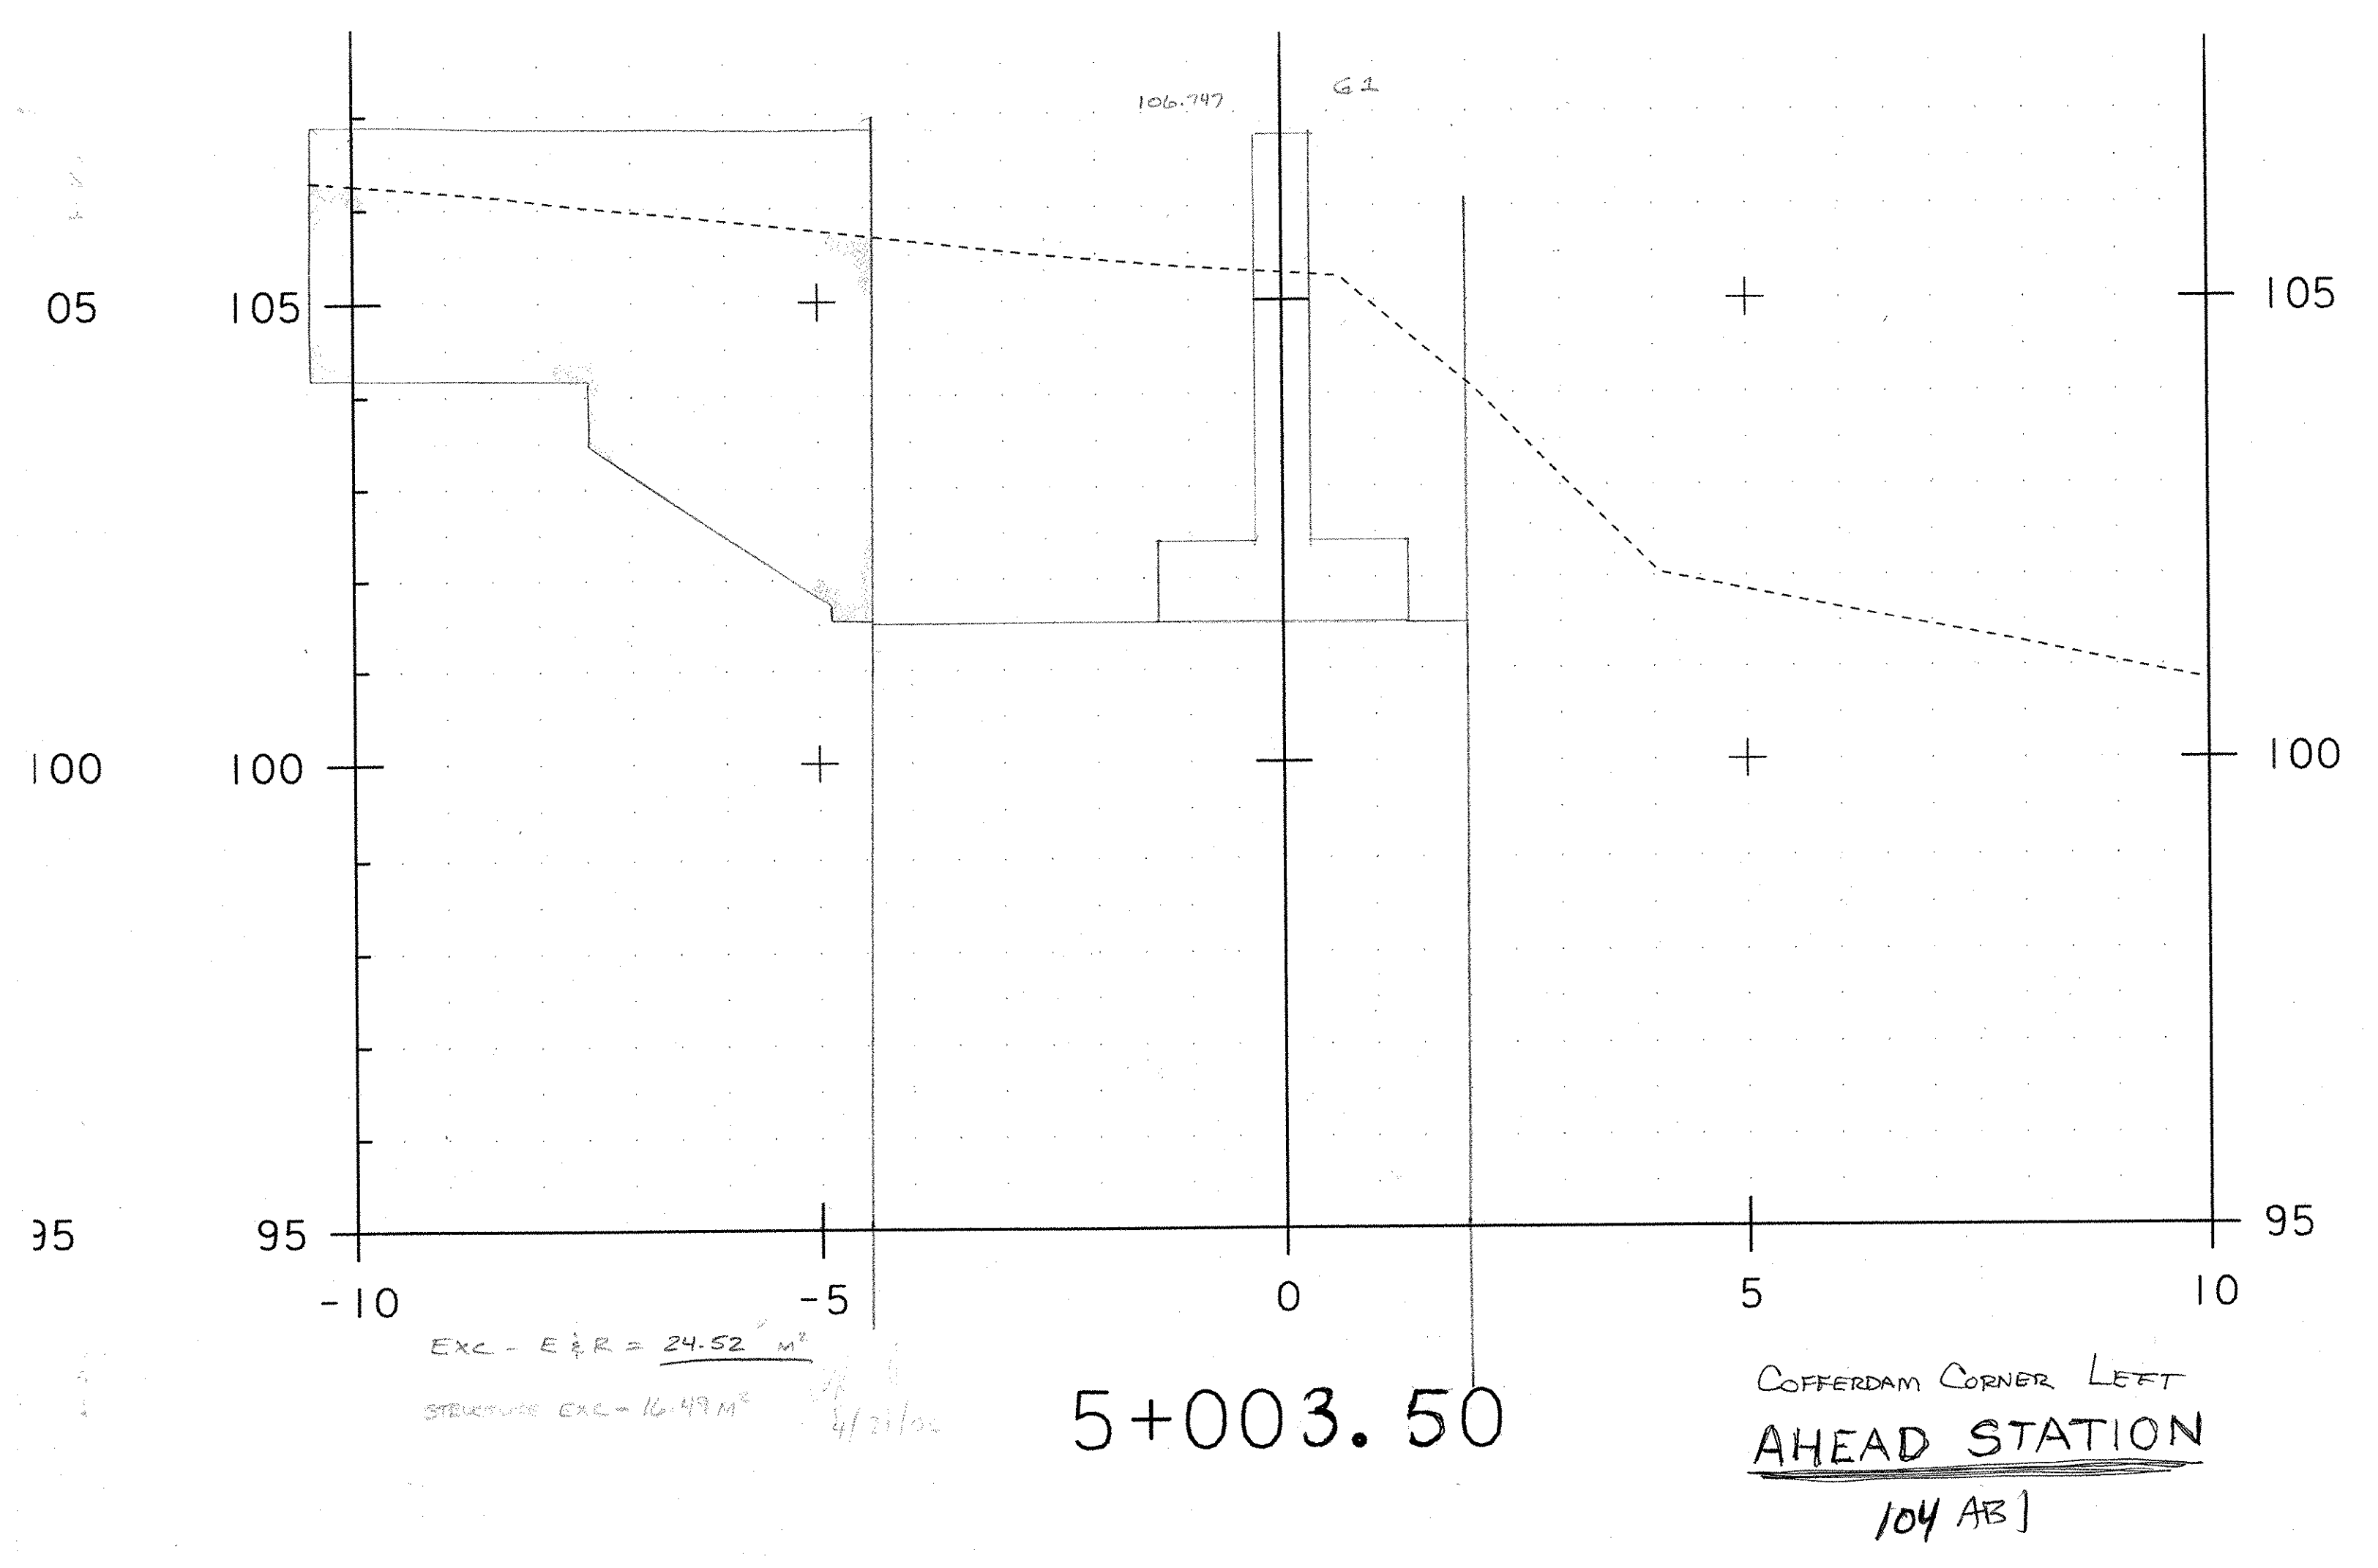

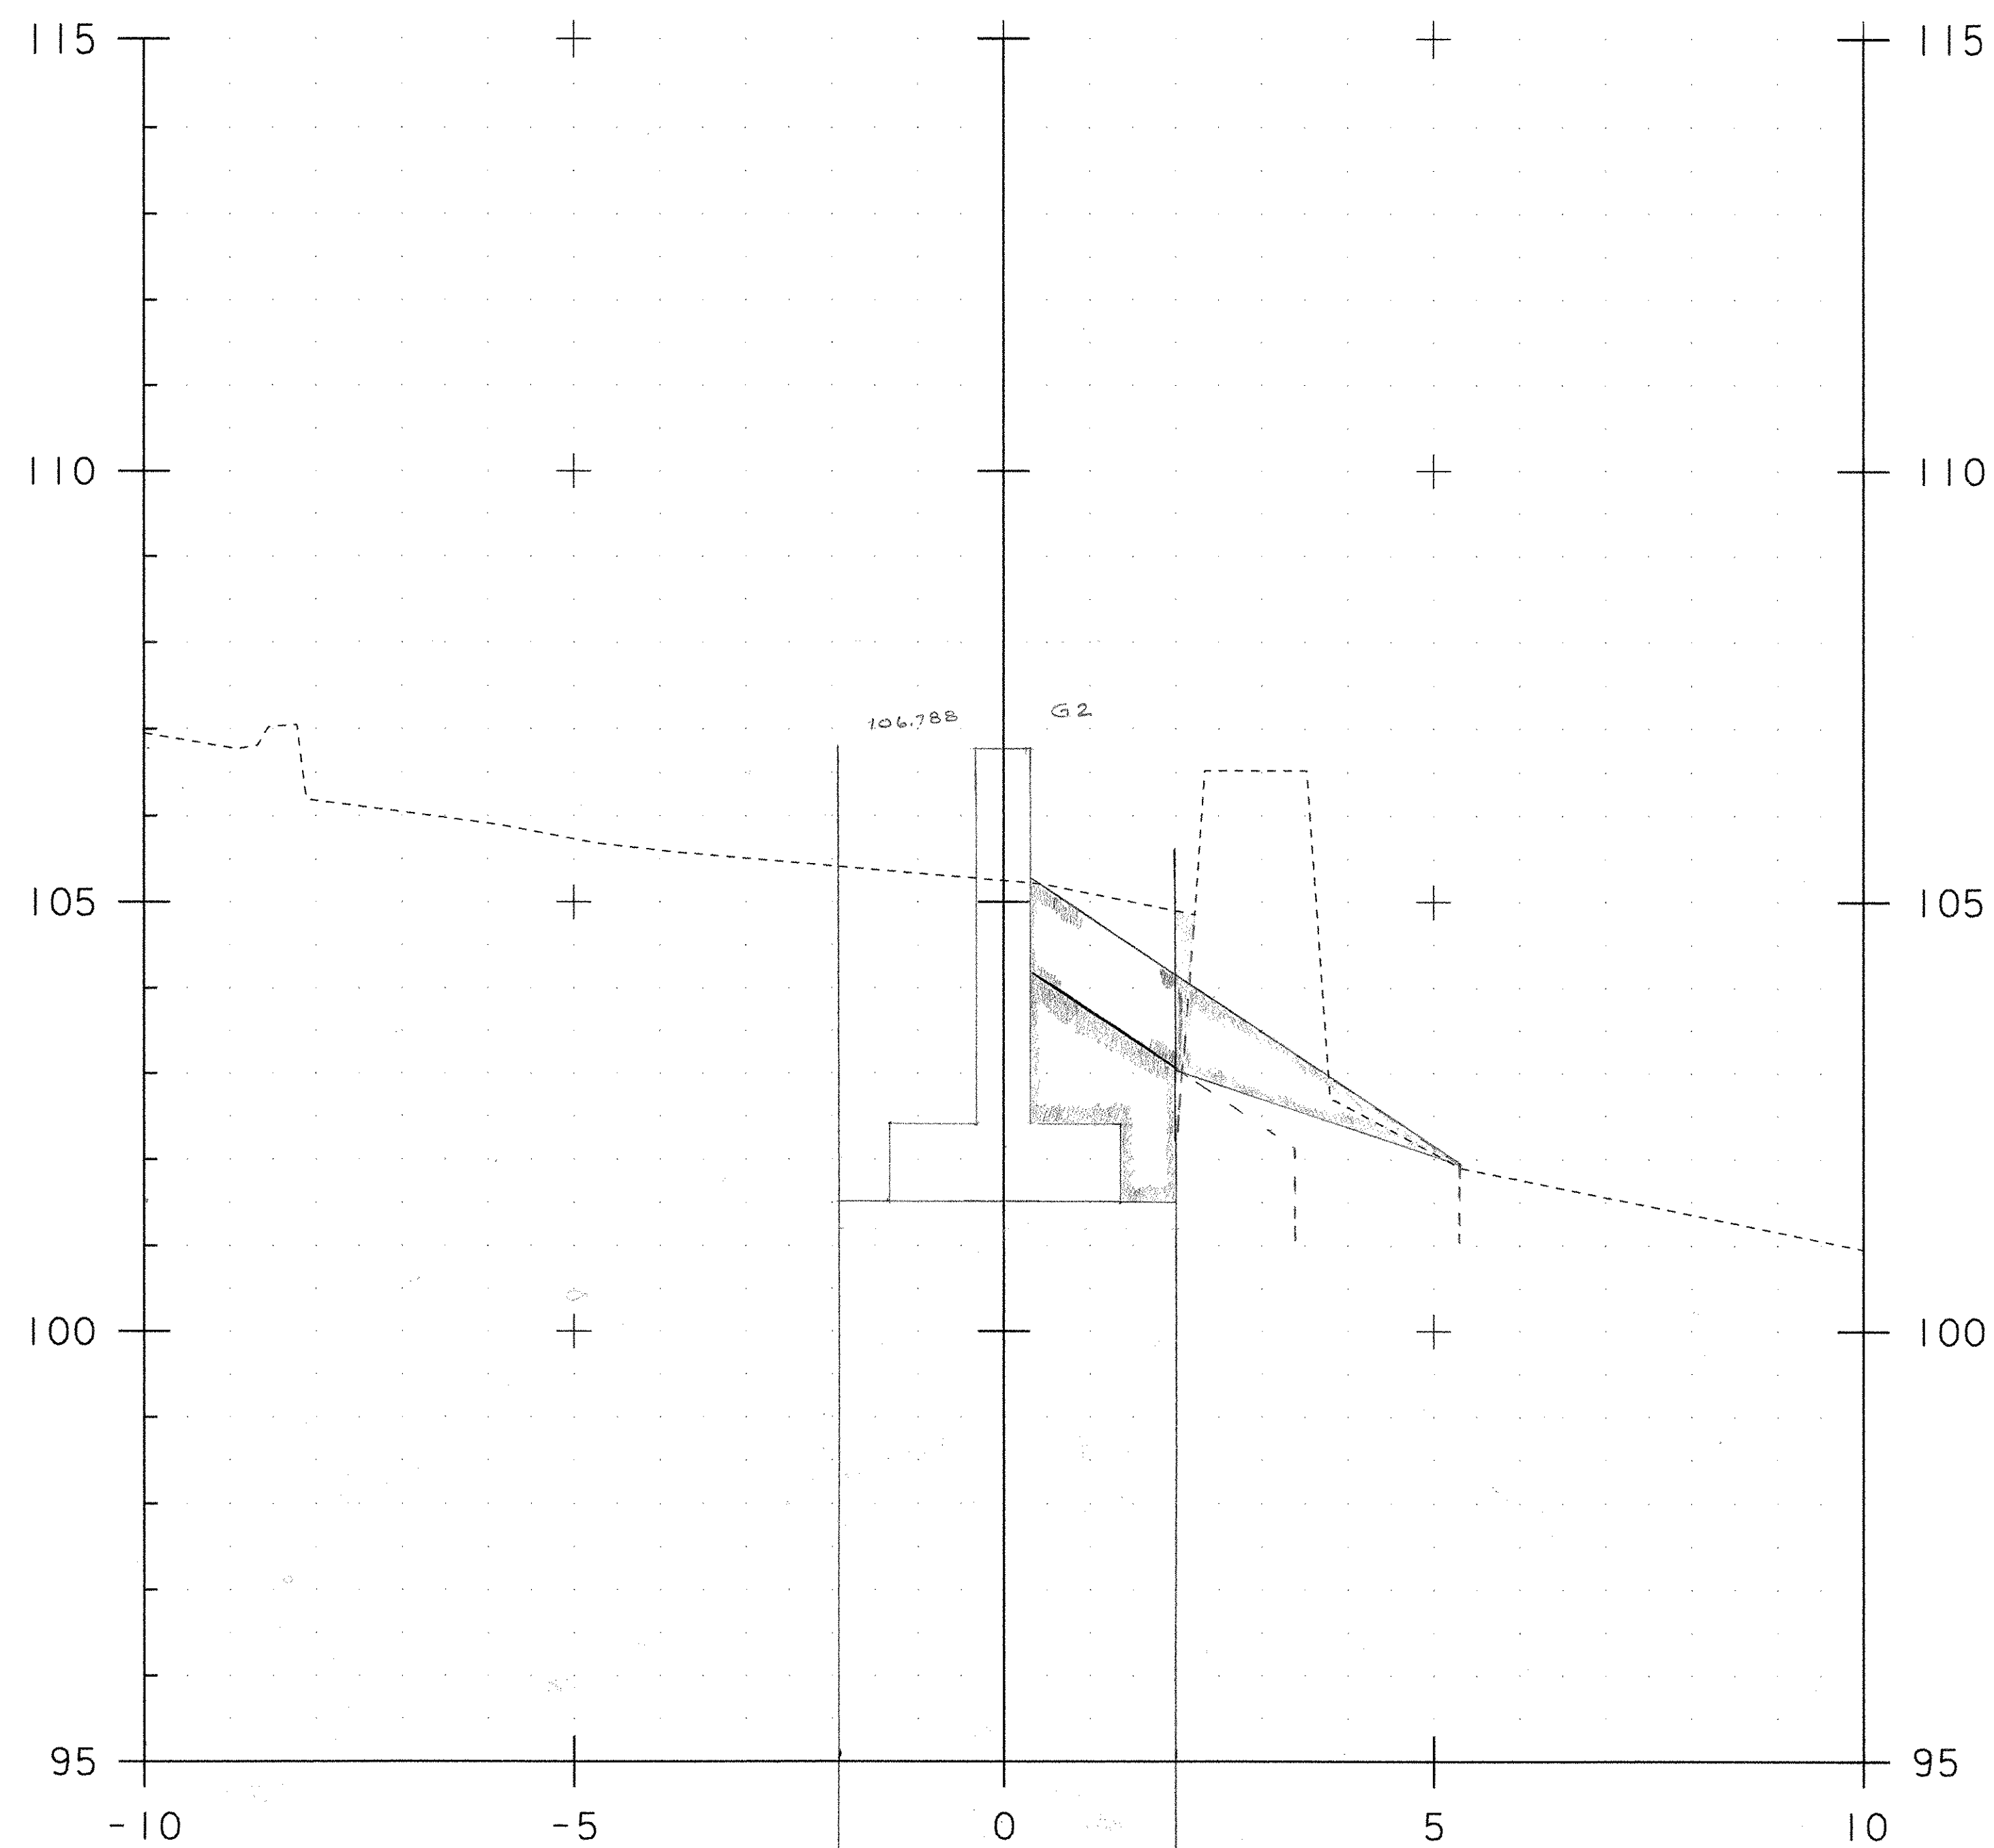

5+002.00

Exc - E.P.R = $\frac{14.62}{41.12} m^2$
 CONC EXHA EXC - 0.000
 GRANULAR BACKFILL - $2.67 m^2$
 STONE FILL TYPE III - $3.70 m^2$
 GEO UNDER S.F - 2.0M

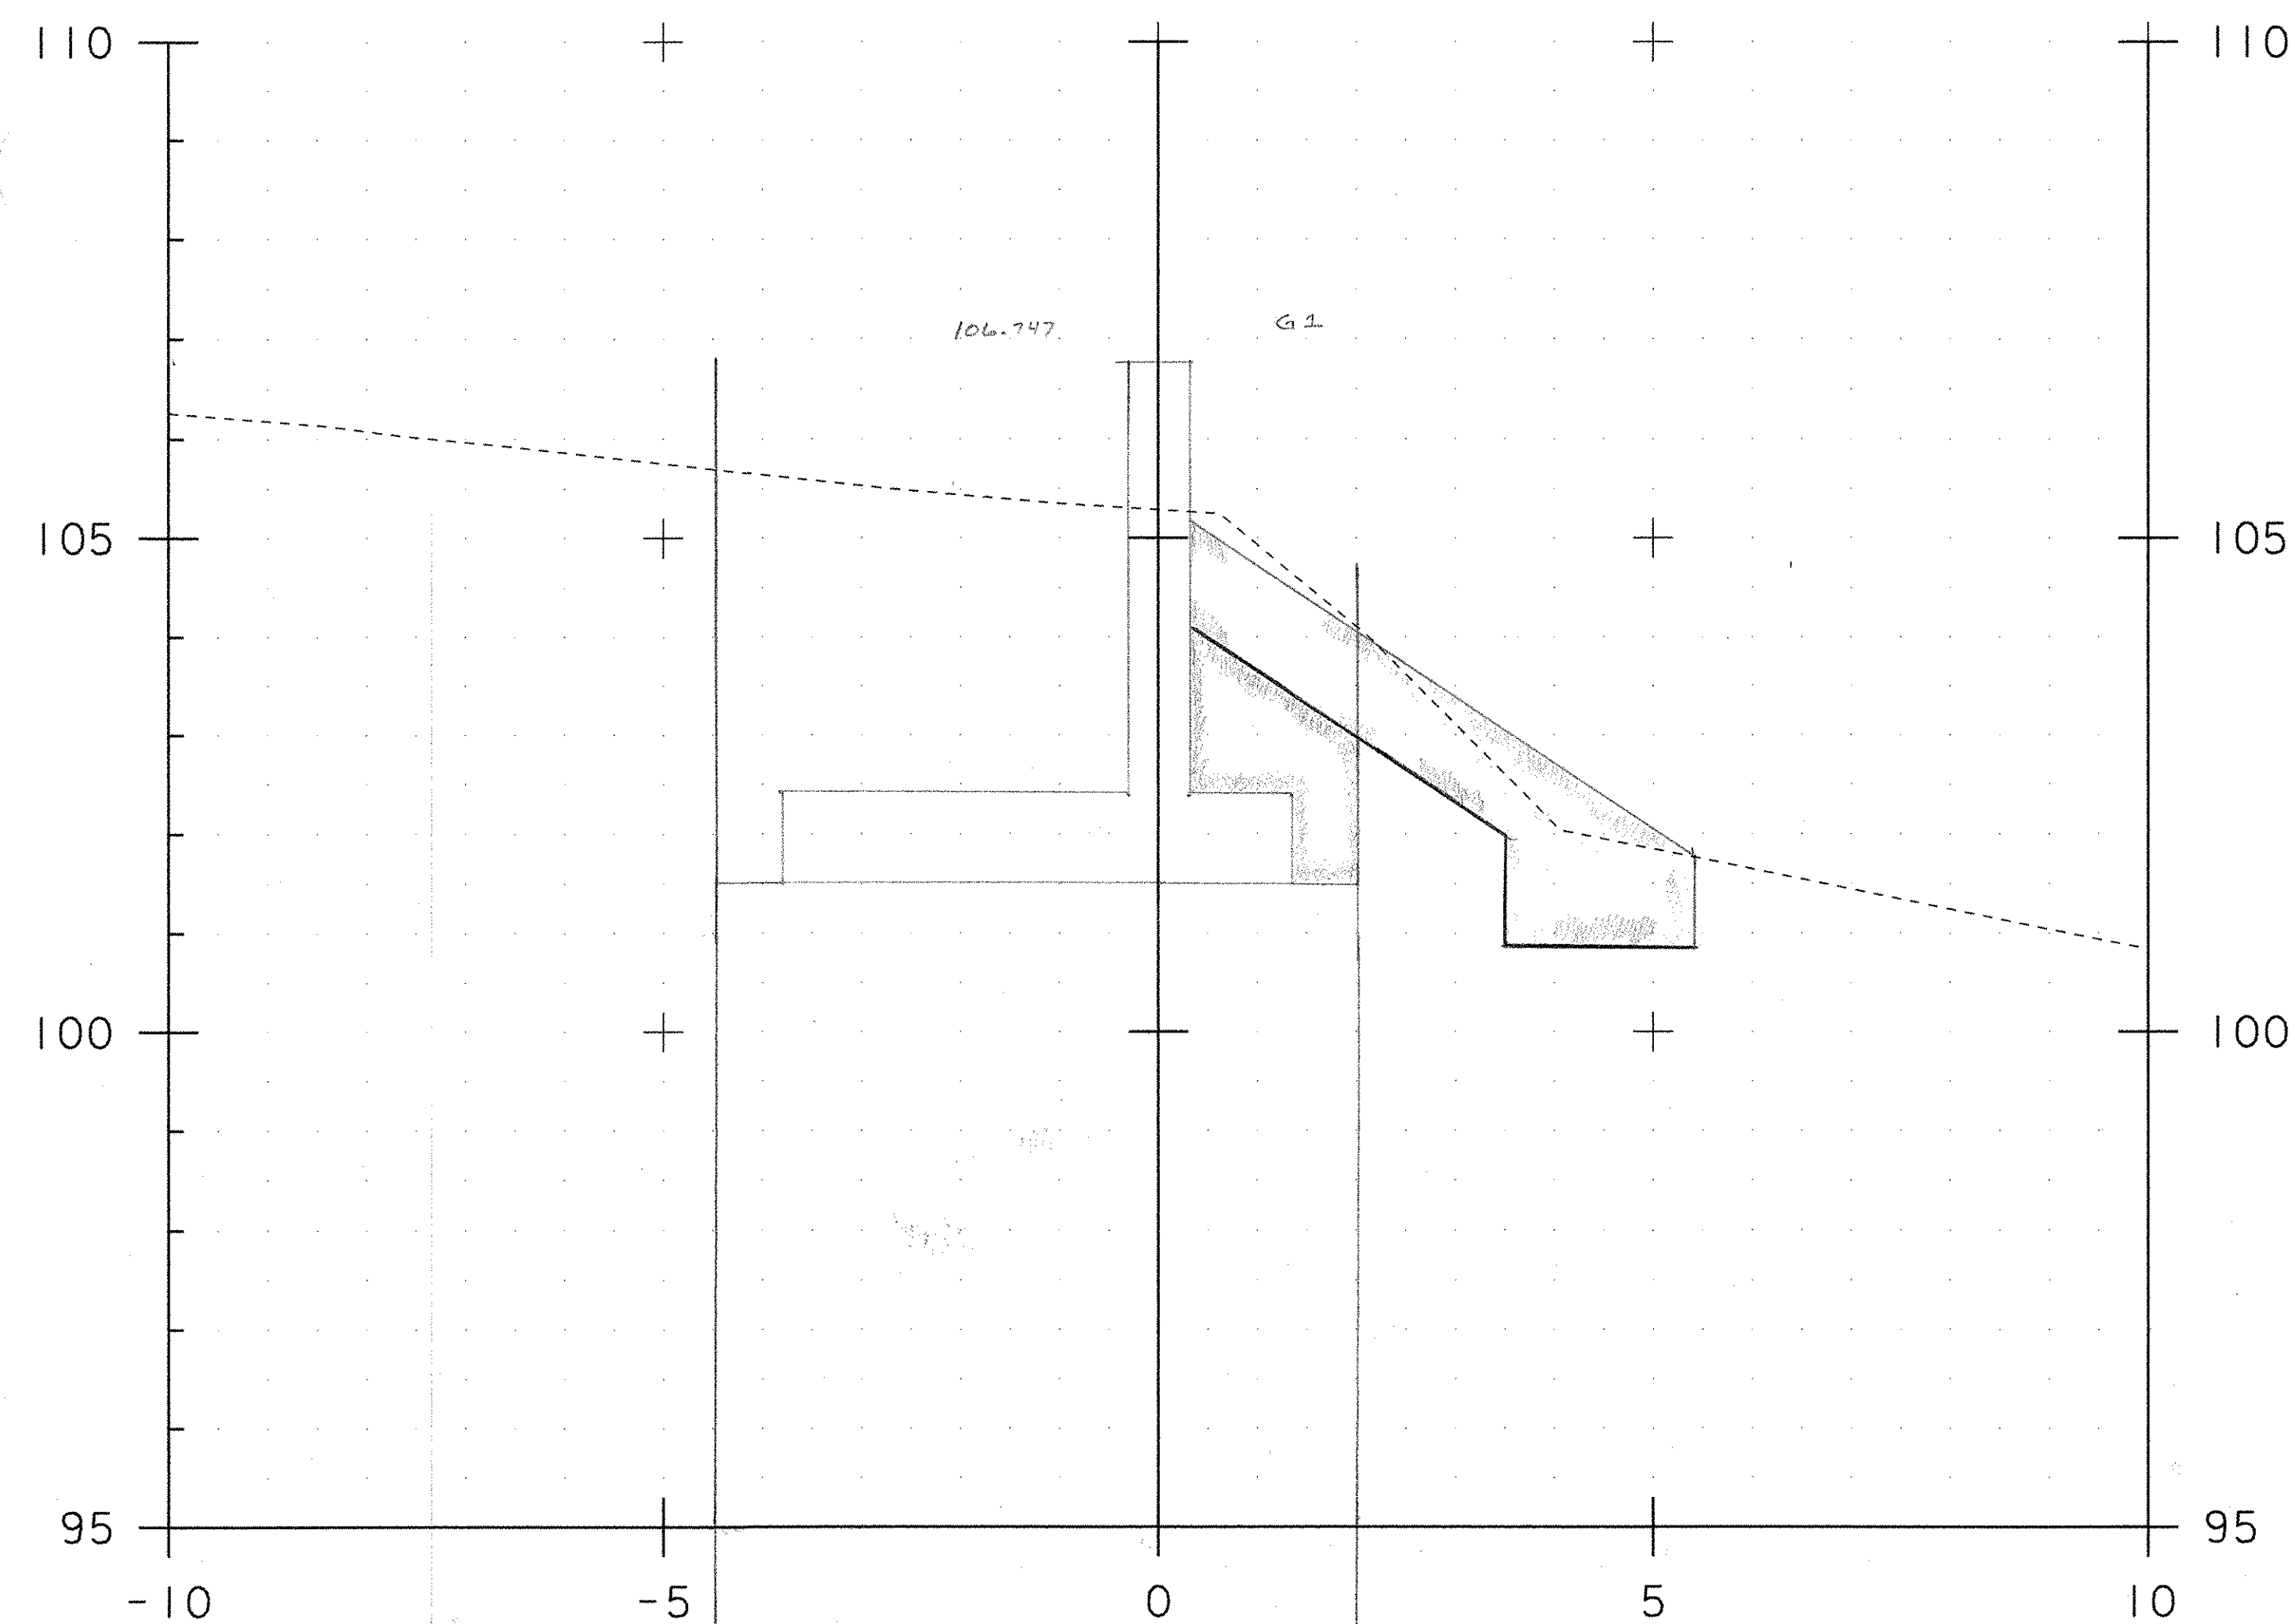

5+004.00


Exc - E.P.R = $\frac{24.58}{41.12} m^2$
 CONC EXHA EXC - 0.000
 GRAN BACKFILL - $2.50 m^2$
 STONE FILL TYPE III - $6.23 m^2$
 GEO UNDER S.F - 6.7M

PROJECT NAME: Leicester
 PROJECT NUMBER: BRF 0160(3)S

FILE NAME:
 PROJECT LEADER:
 DESIGNED BY:


PLOT DATE: 01-NOV-2005
 DRAWN BY: R. Bullock
 CHECKED BY:
 SHEET 5 OF 8


105AB1

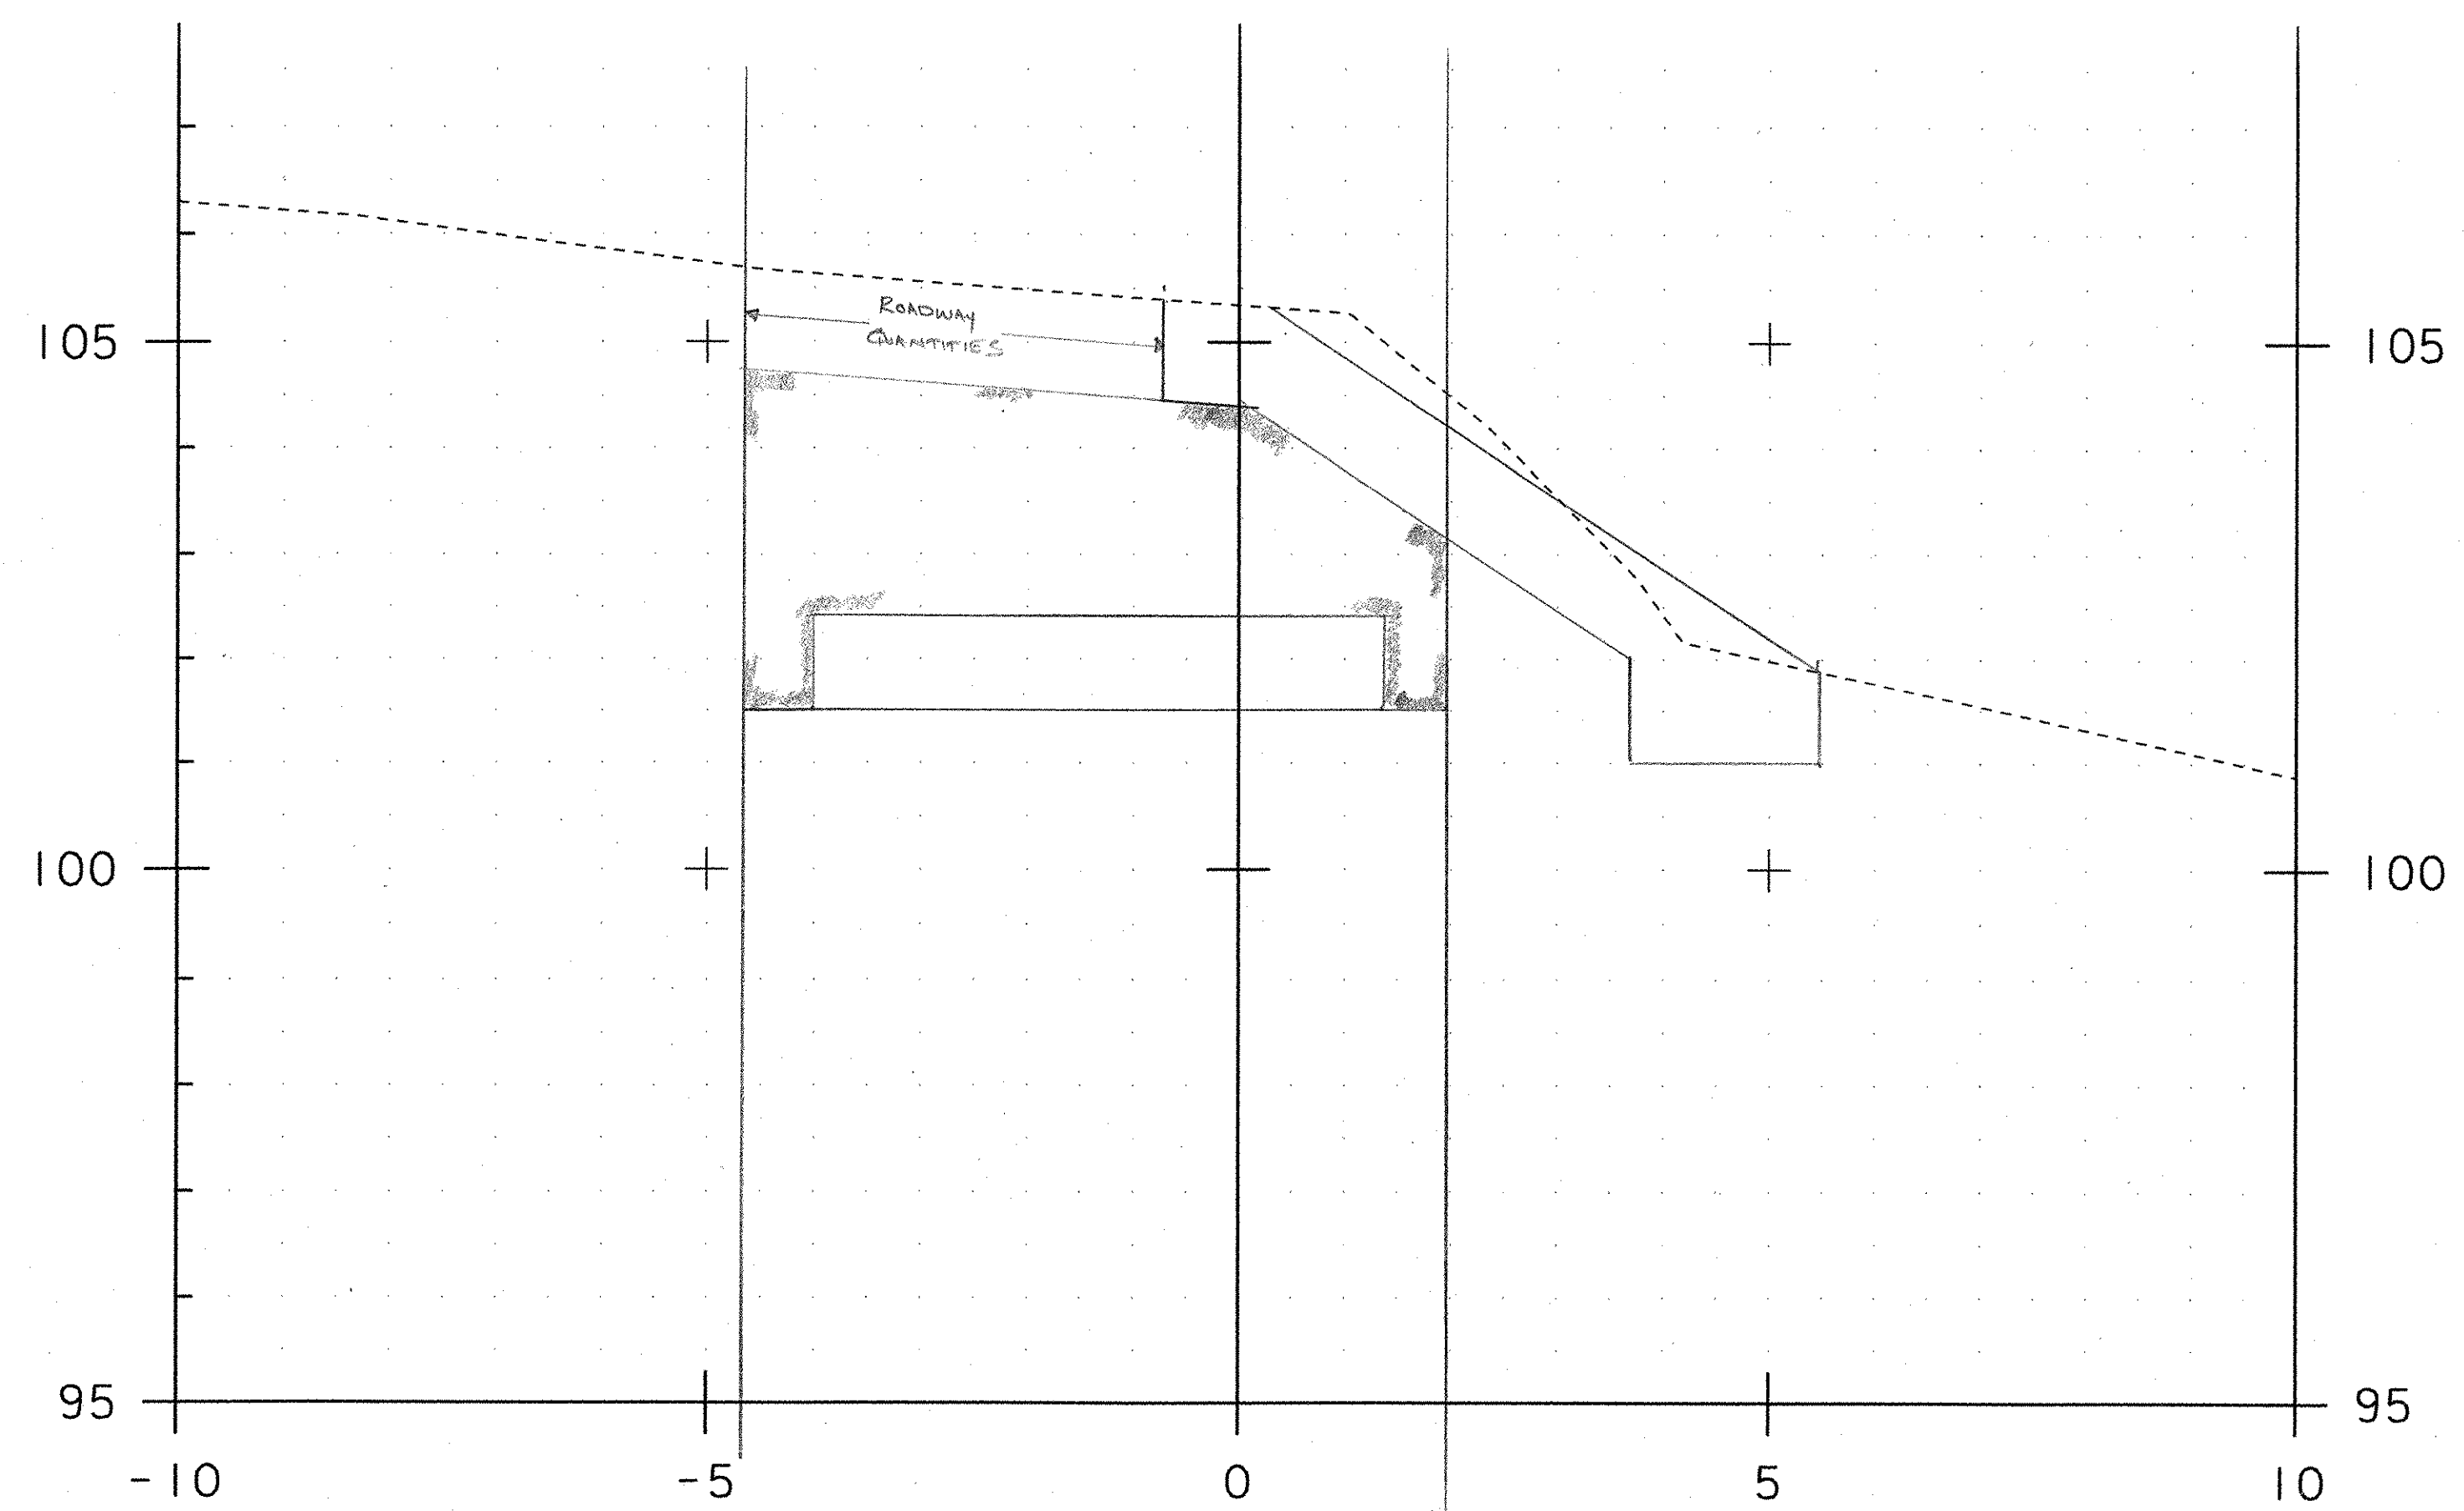

5+006.50

FOOTING CORNER
106A/1

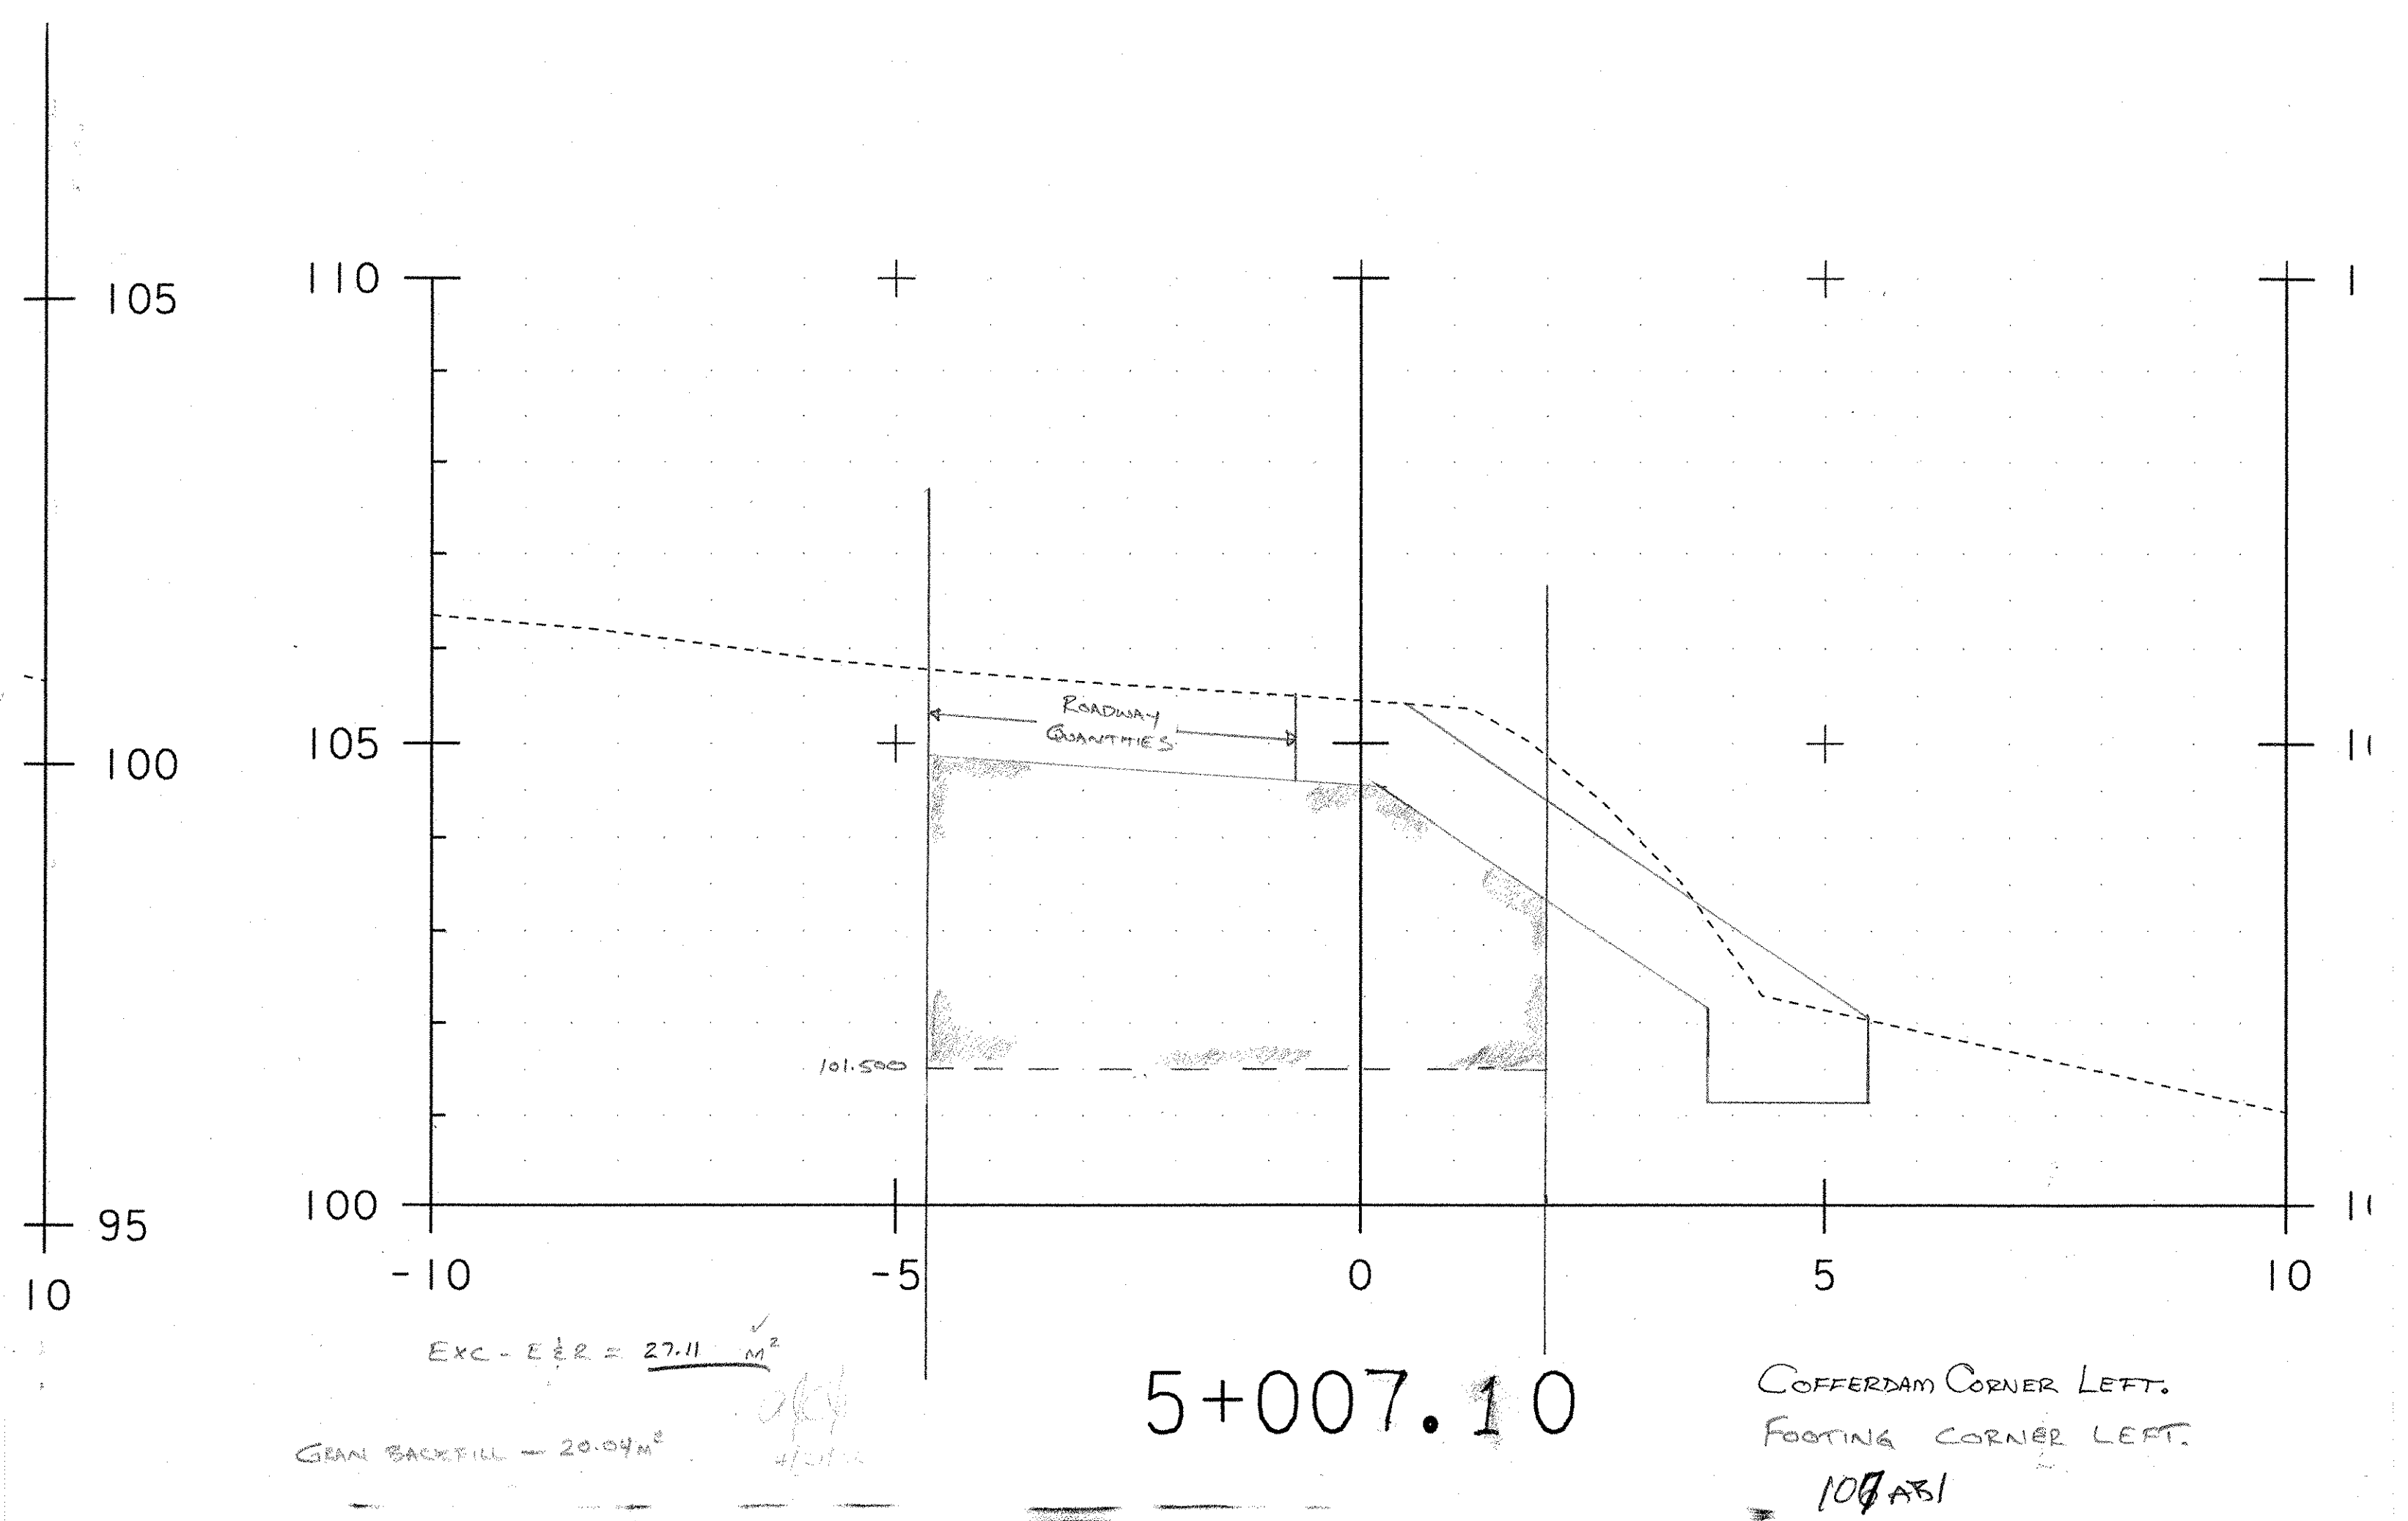


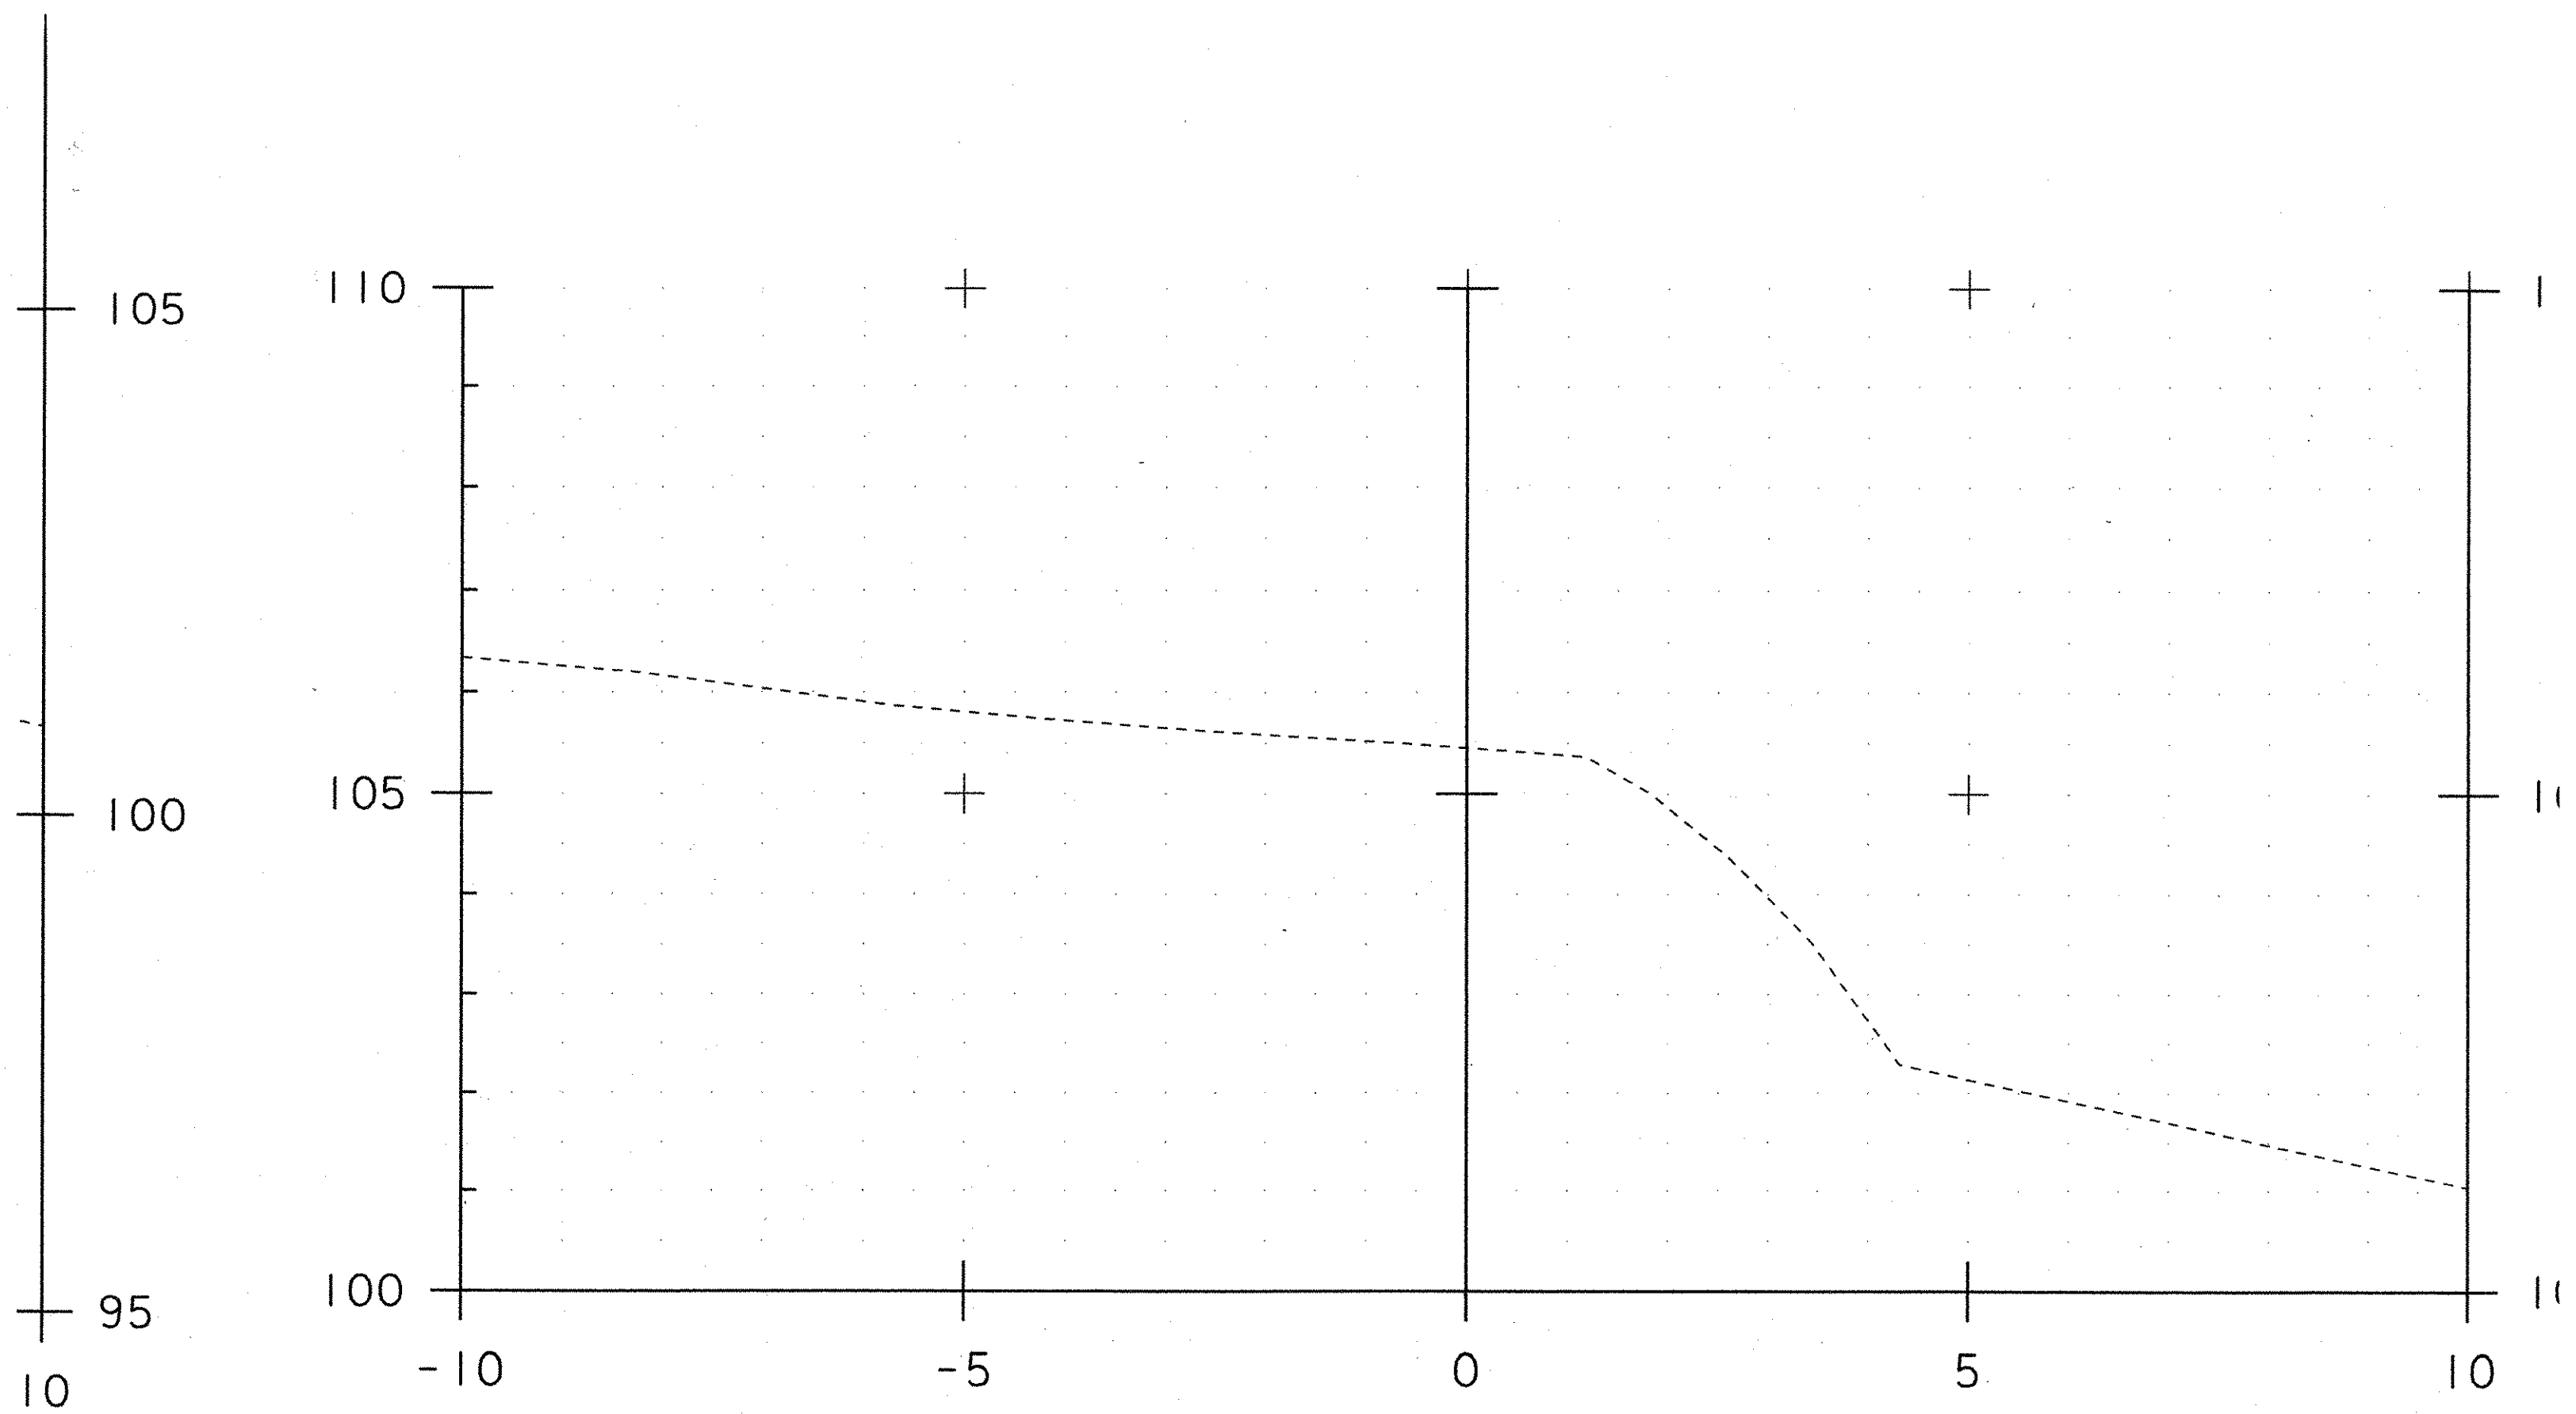

Exc. 5% R = ZERO
 ZERO GRAN BACKFILL


5+007.60

ZERO COFFERDAM
 (08 AB)

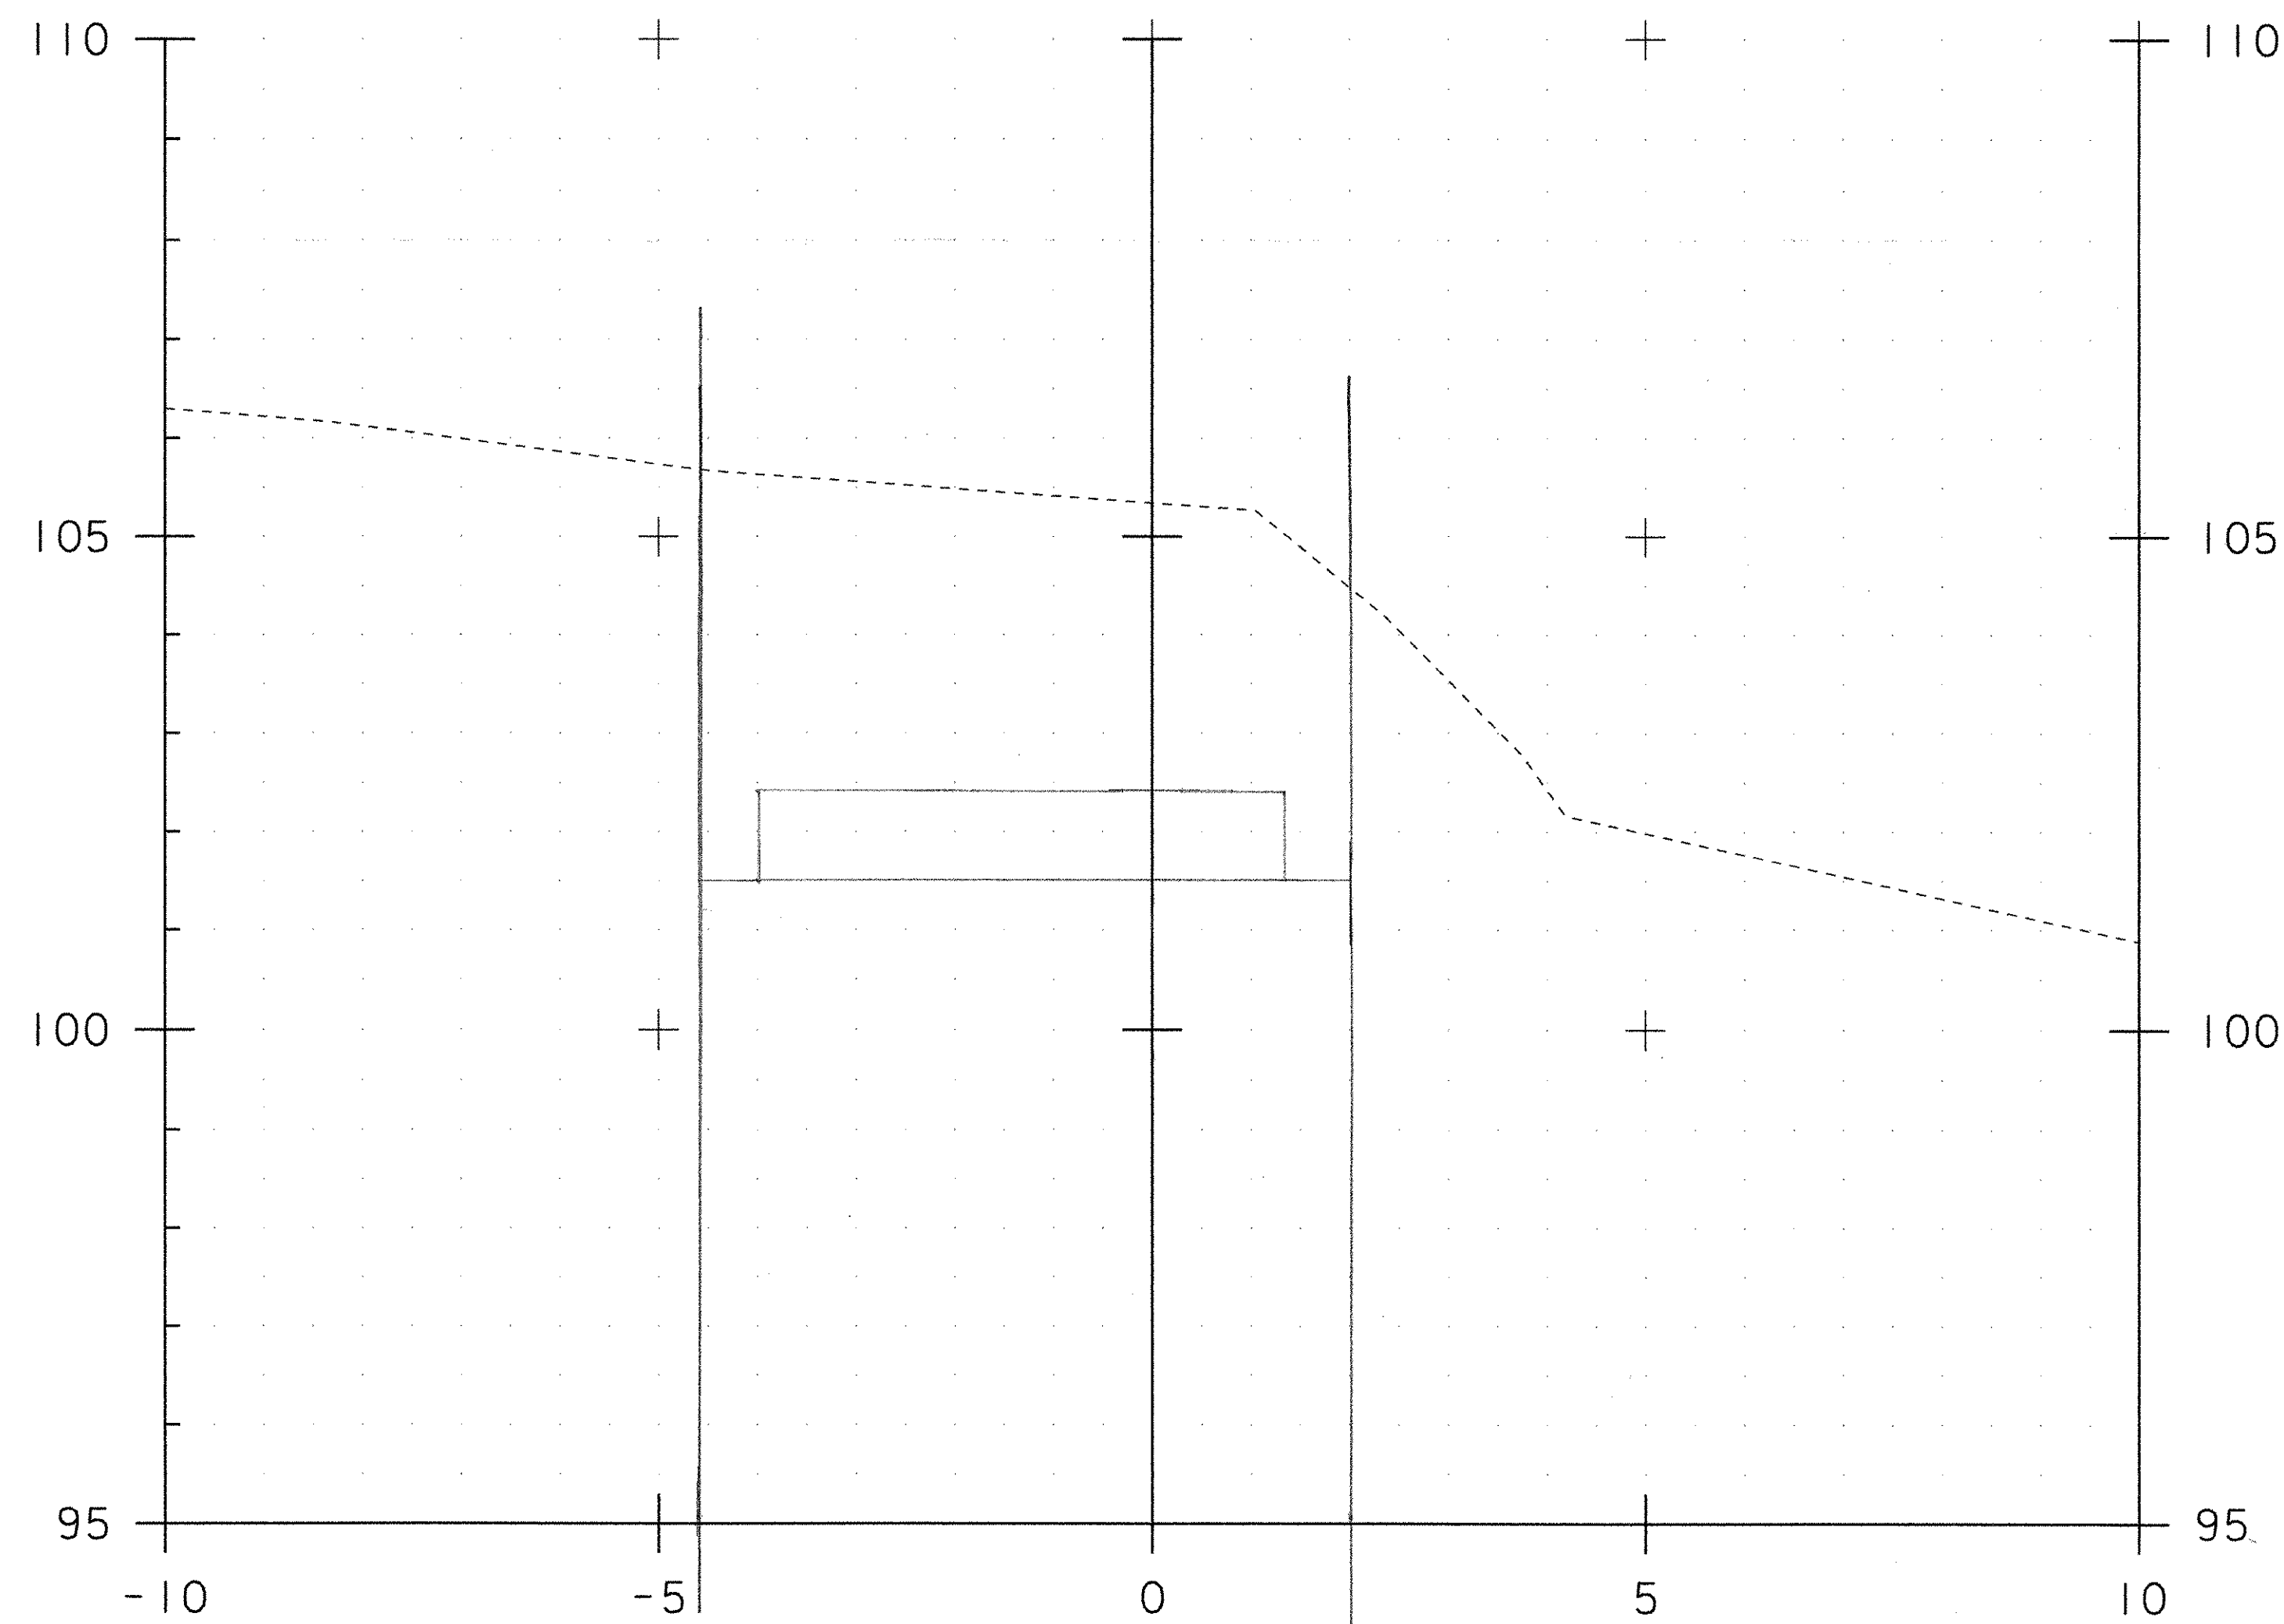


Exc - EIR = 25.64 m²
 5+006.00
 SAME AS ST00S.80
 FROM ST00S.80 (BUTT) GEO UNDER S.F (BRIDGE) = 7.90 M
 " " (BUTT) UNC CHAN C (BRIDGE) = 6.10 M²
 * SEE W.O # 10

(QUANTITY FROM 5+005.80) - STONE FILL TYPE III = 7.82 m²

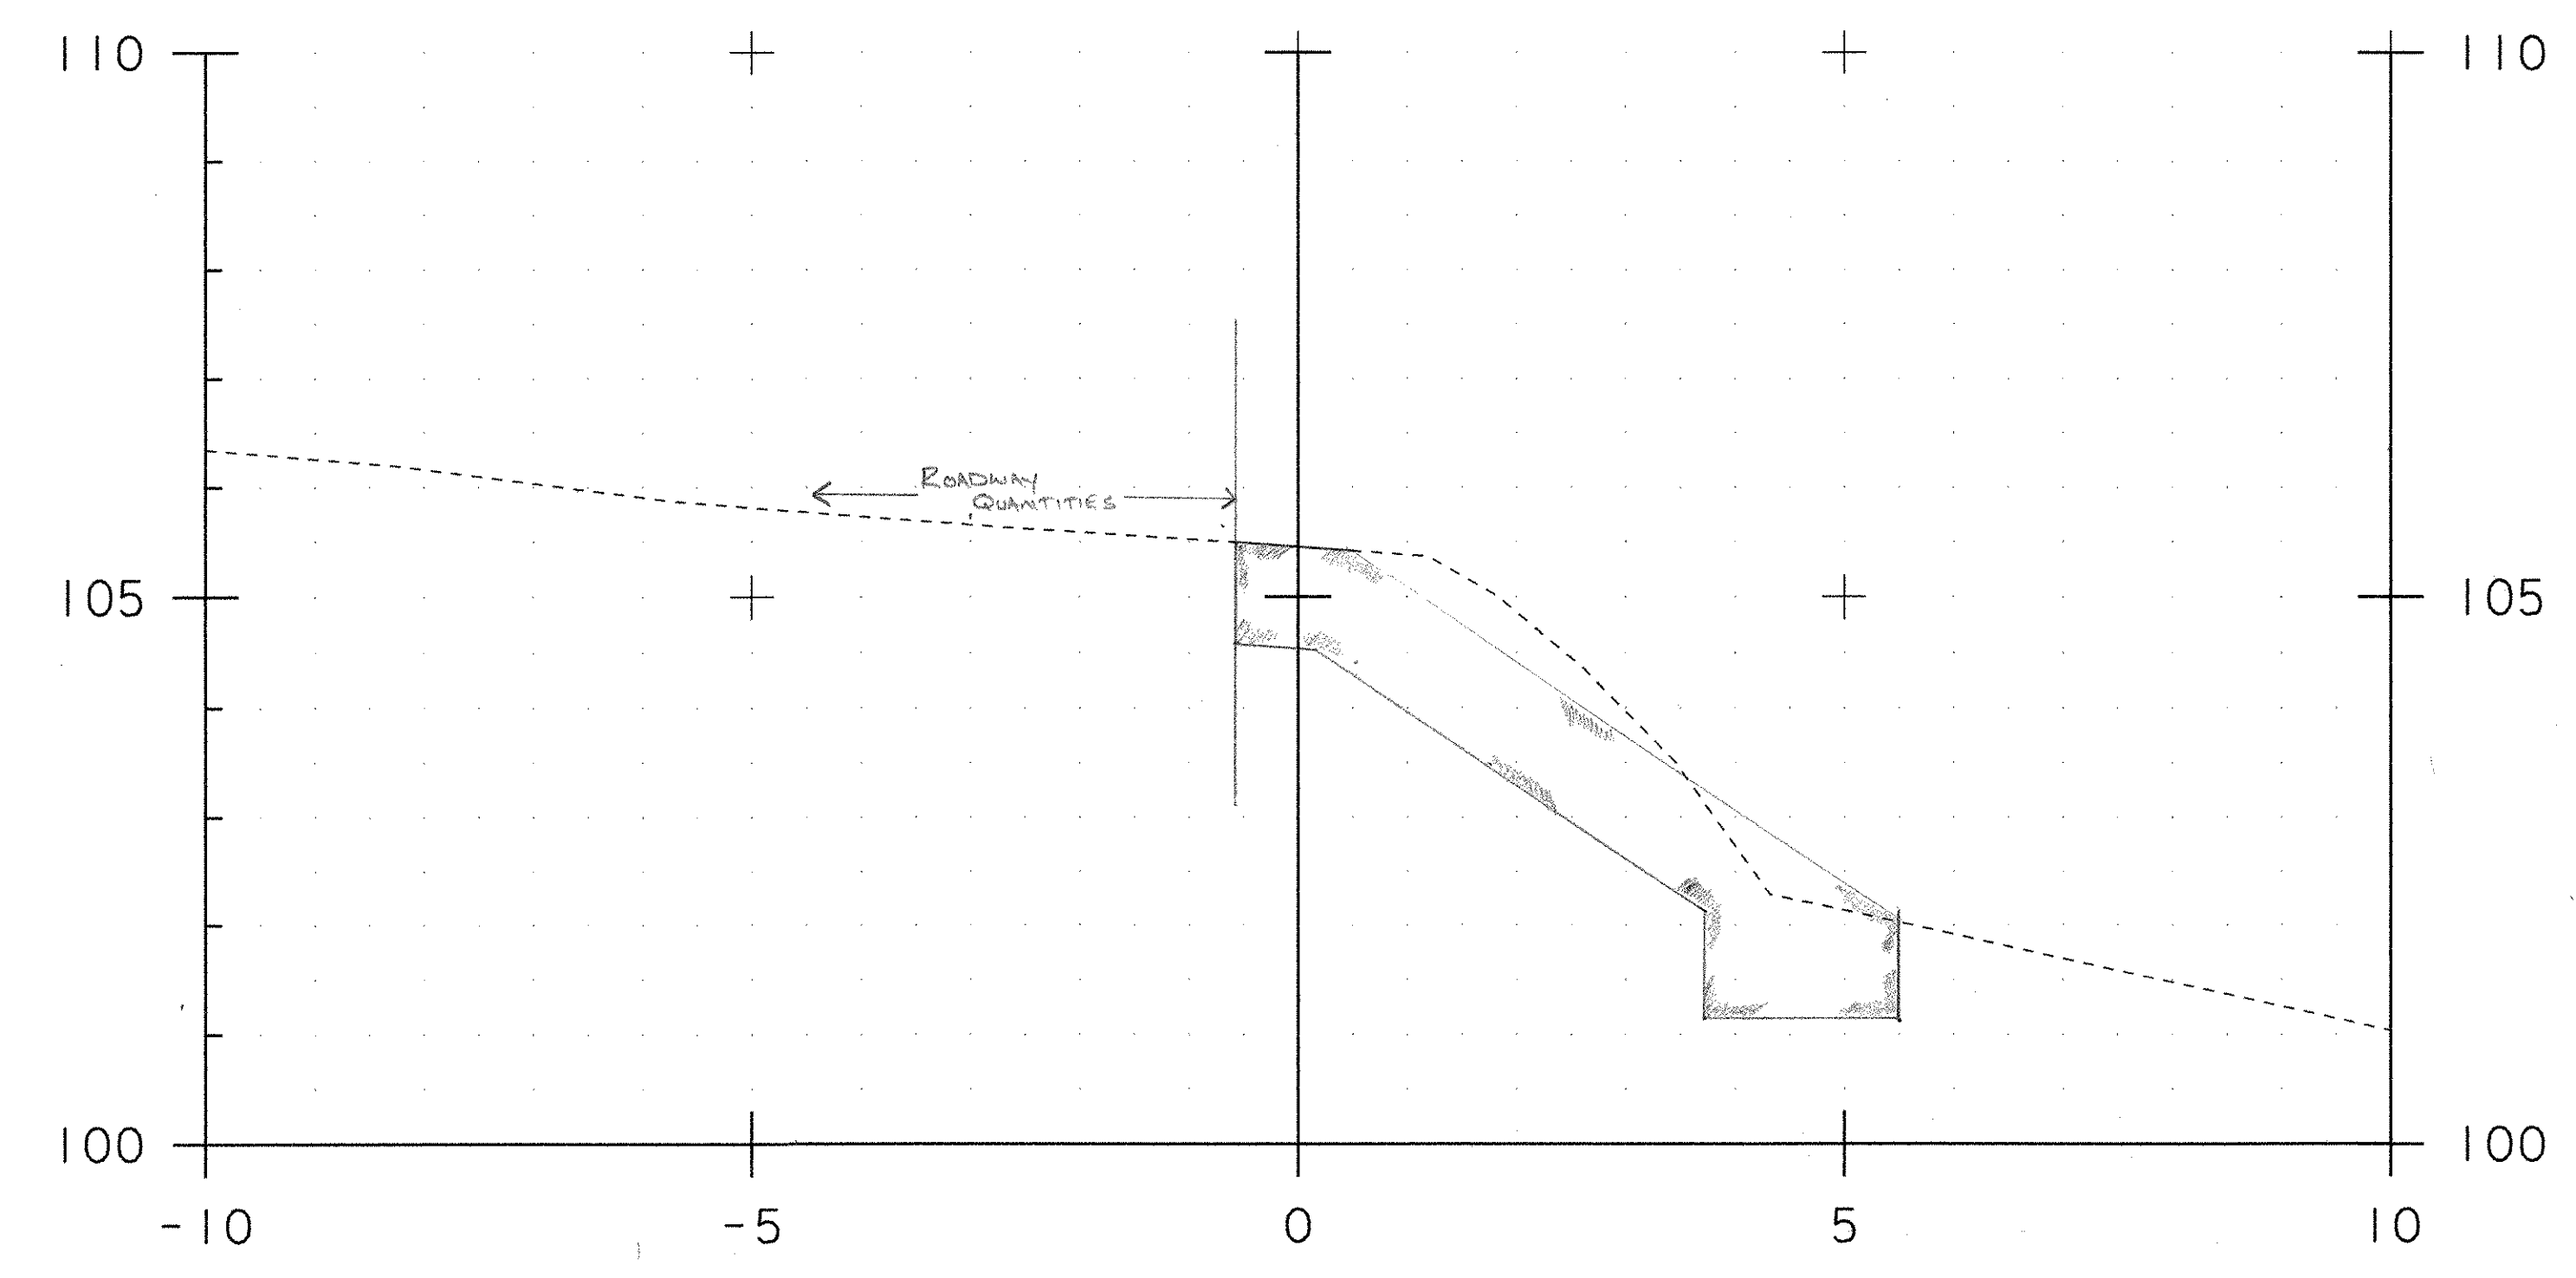


5+008.00
 STONE FILL TYPE III = 7.19 m²

PROJECT NAME:	Leicester	PLOT DATE:	01-NOV-2005
PROJECT NUMBER:	BRF 0160(3)S	DRAWN BY:	R. Bullock
FILE NAME:		CHECKED BY:	
PROJECT LEADER:		DESIGNED BY:	
DESIGNED BY:	109 RAB1	SHEET 6	OF 8

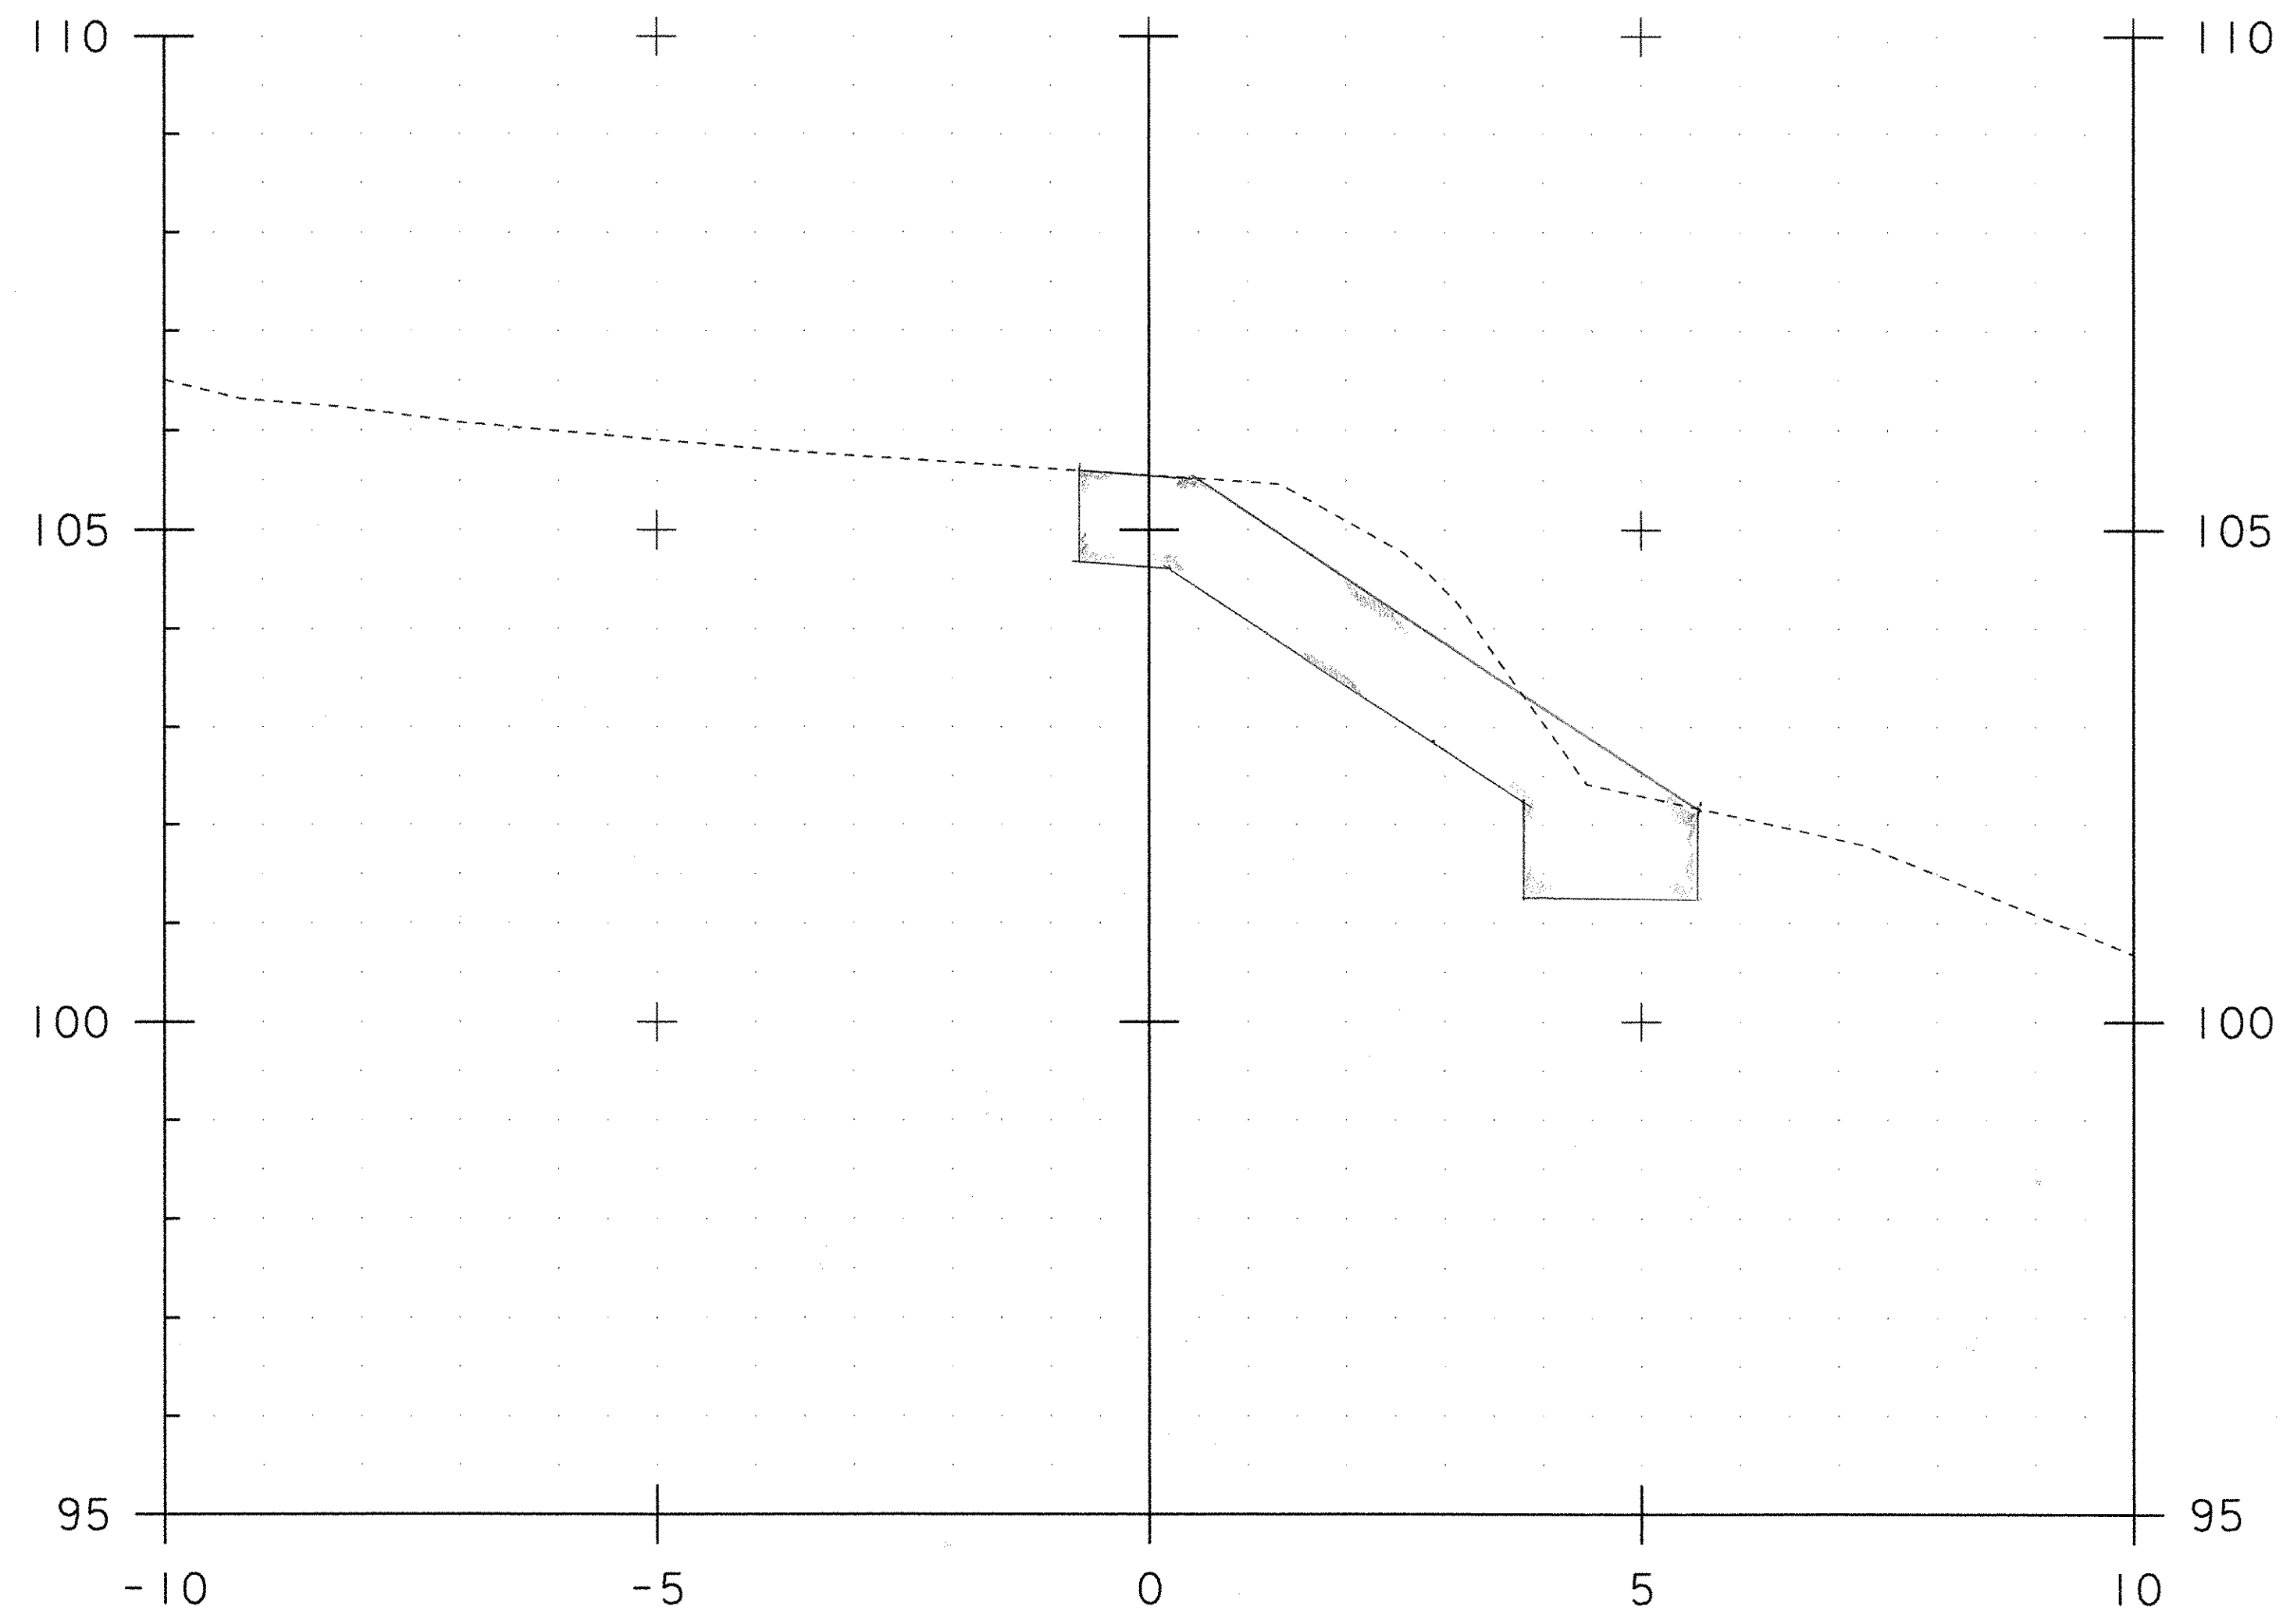

5+011.00


STONE FILL TYPE III - 7.36 m²

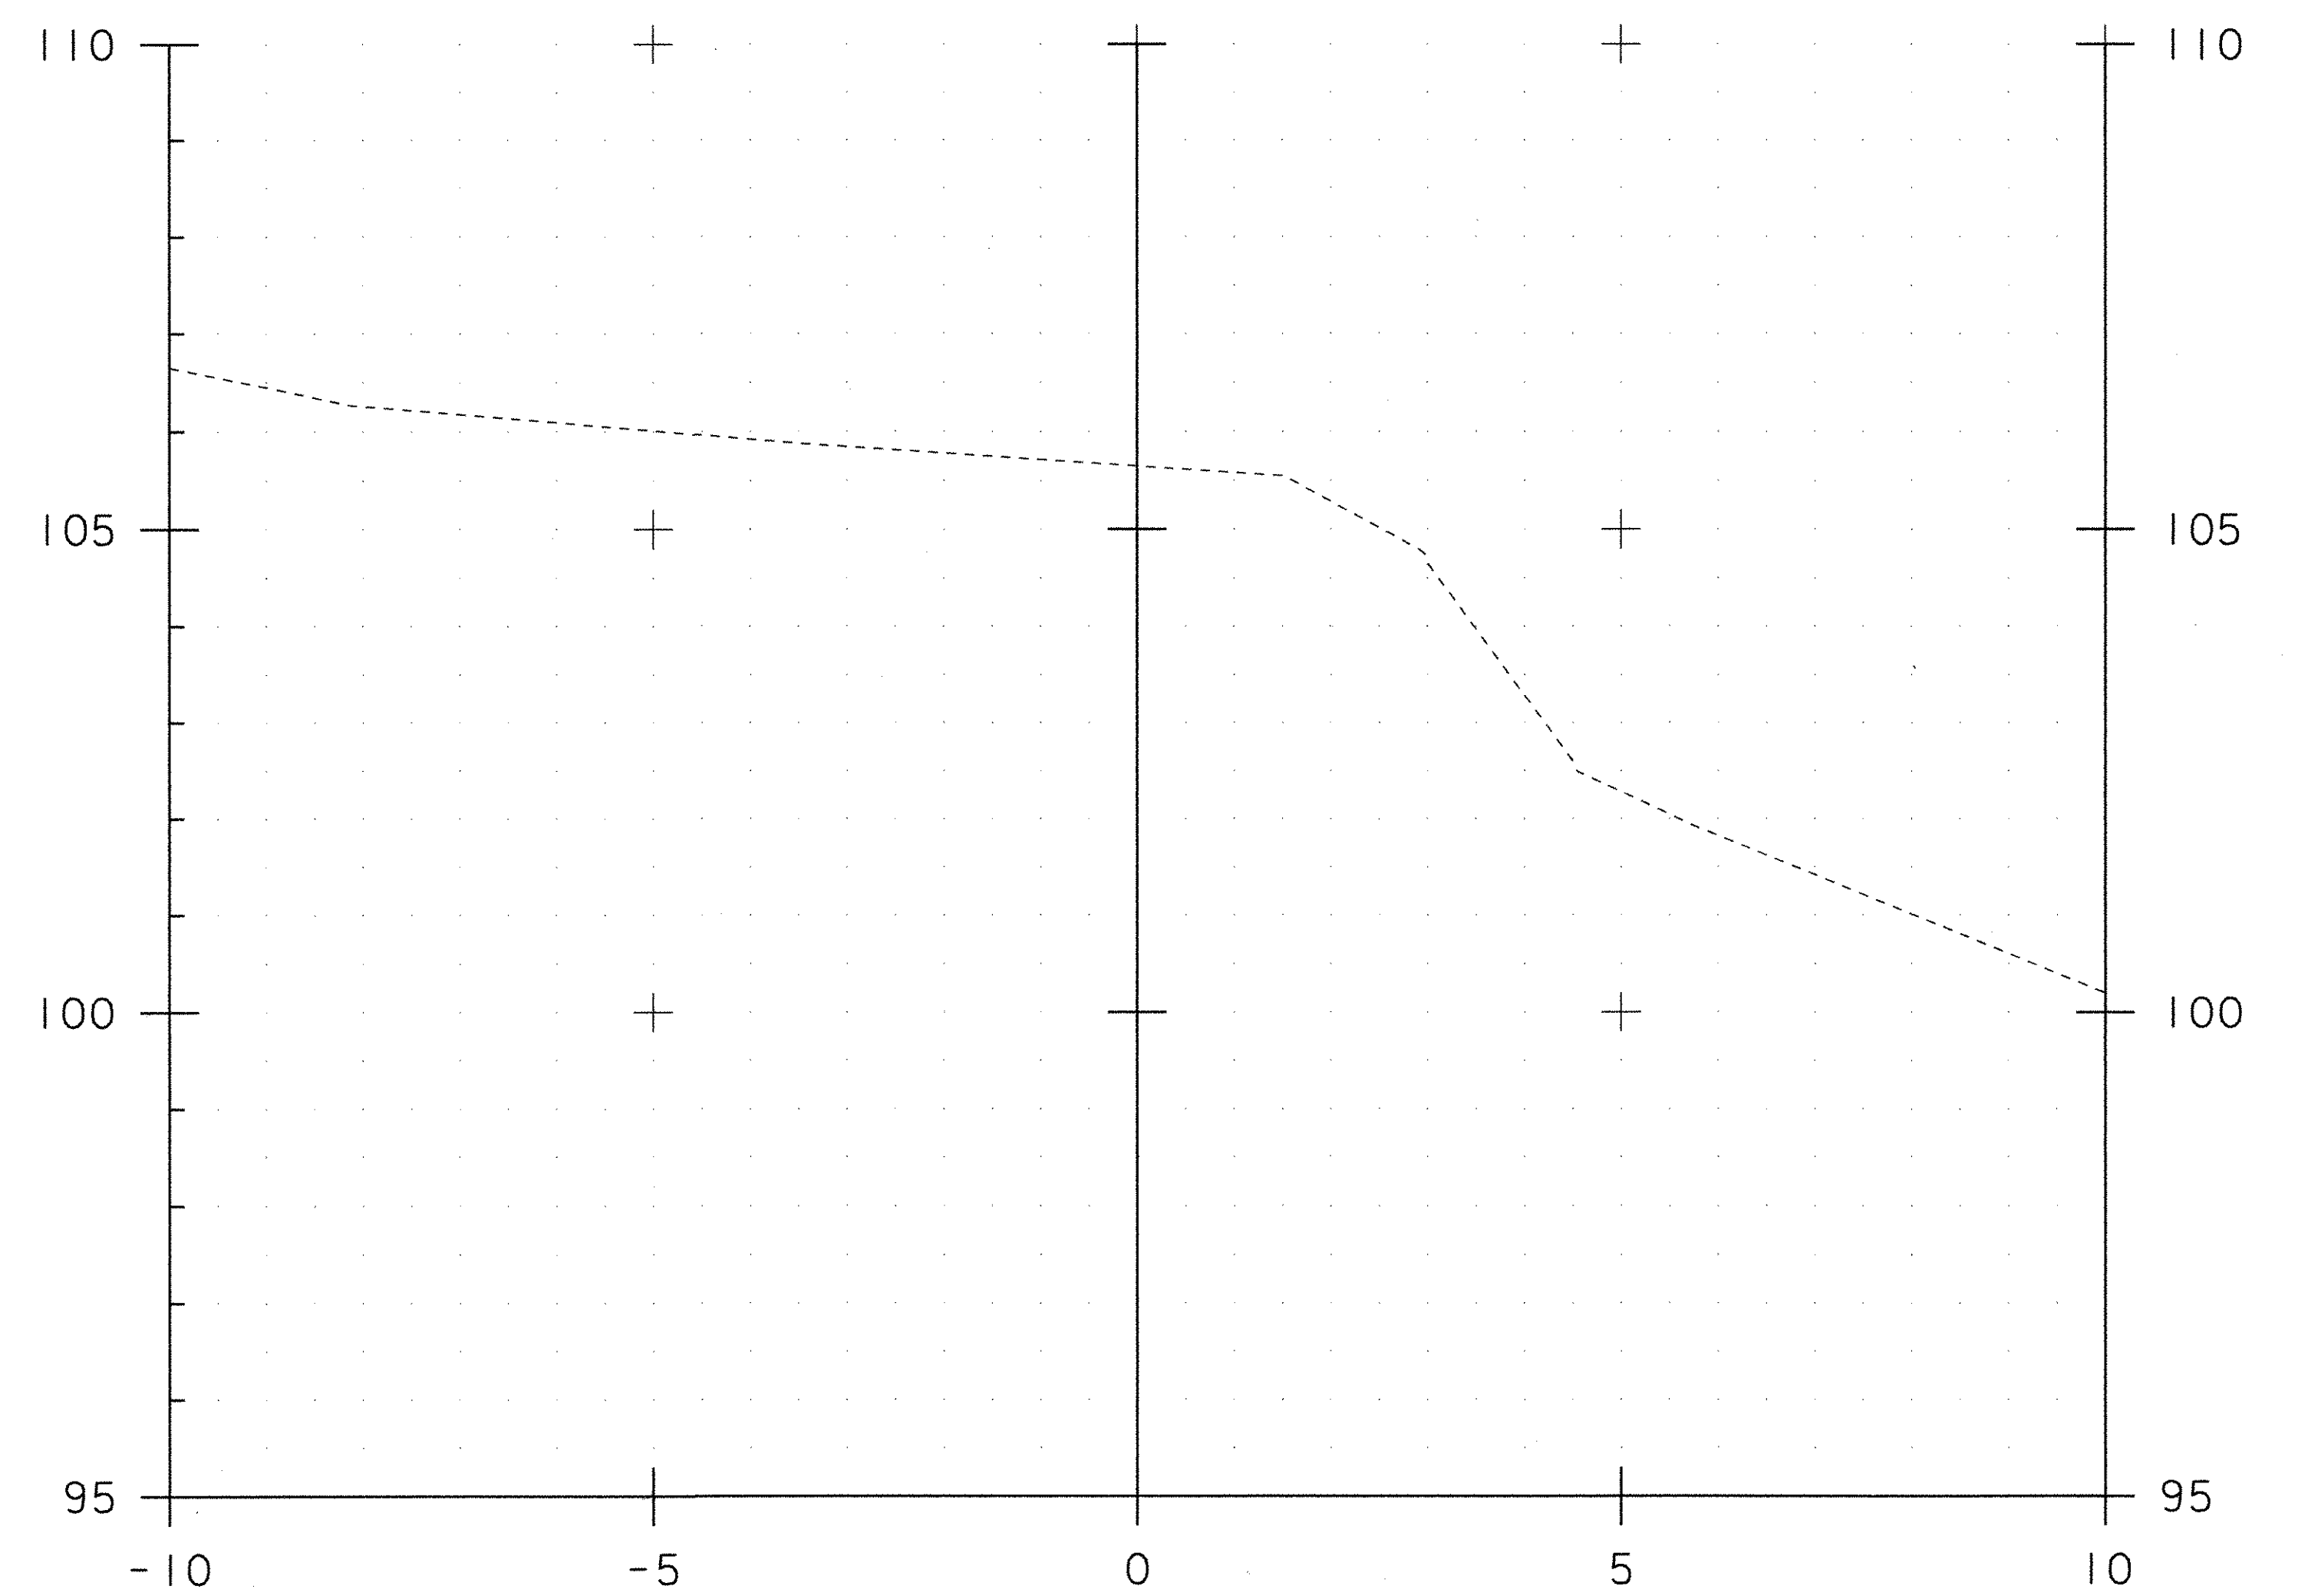

5+014.00


ZERO STONE FILL TYPE III

PROJECT NAME:	Leicester	PLOT DATE:	01-NOV-2005
PROJECT NUMBER:	BRF 0160(3)S	DRAWN BY:	R. Bullock
FILE NAME:		CHECKED BY:	
PROJECT LEADER:		SHEET 7	OF 8
DESIGNED BY:	<i>110</i> <i>AB1</i>		

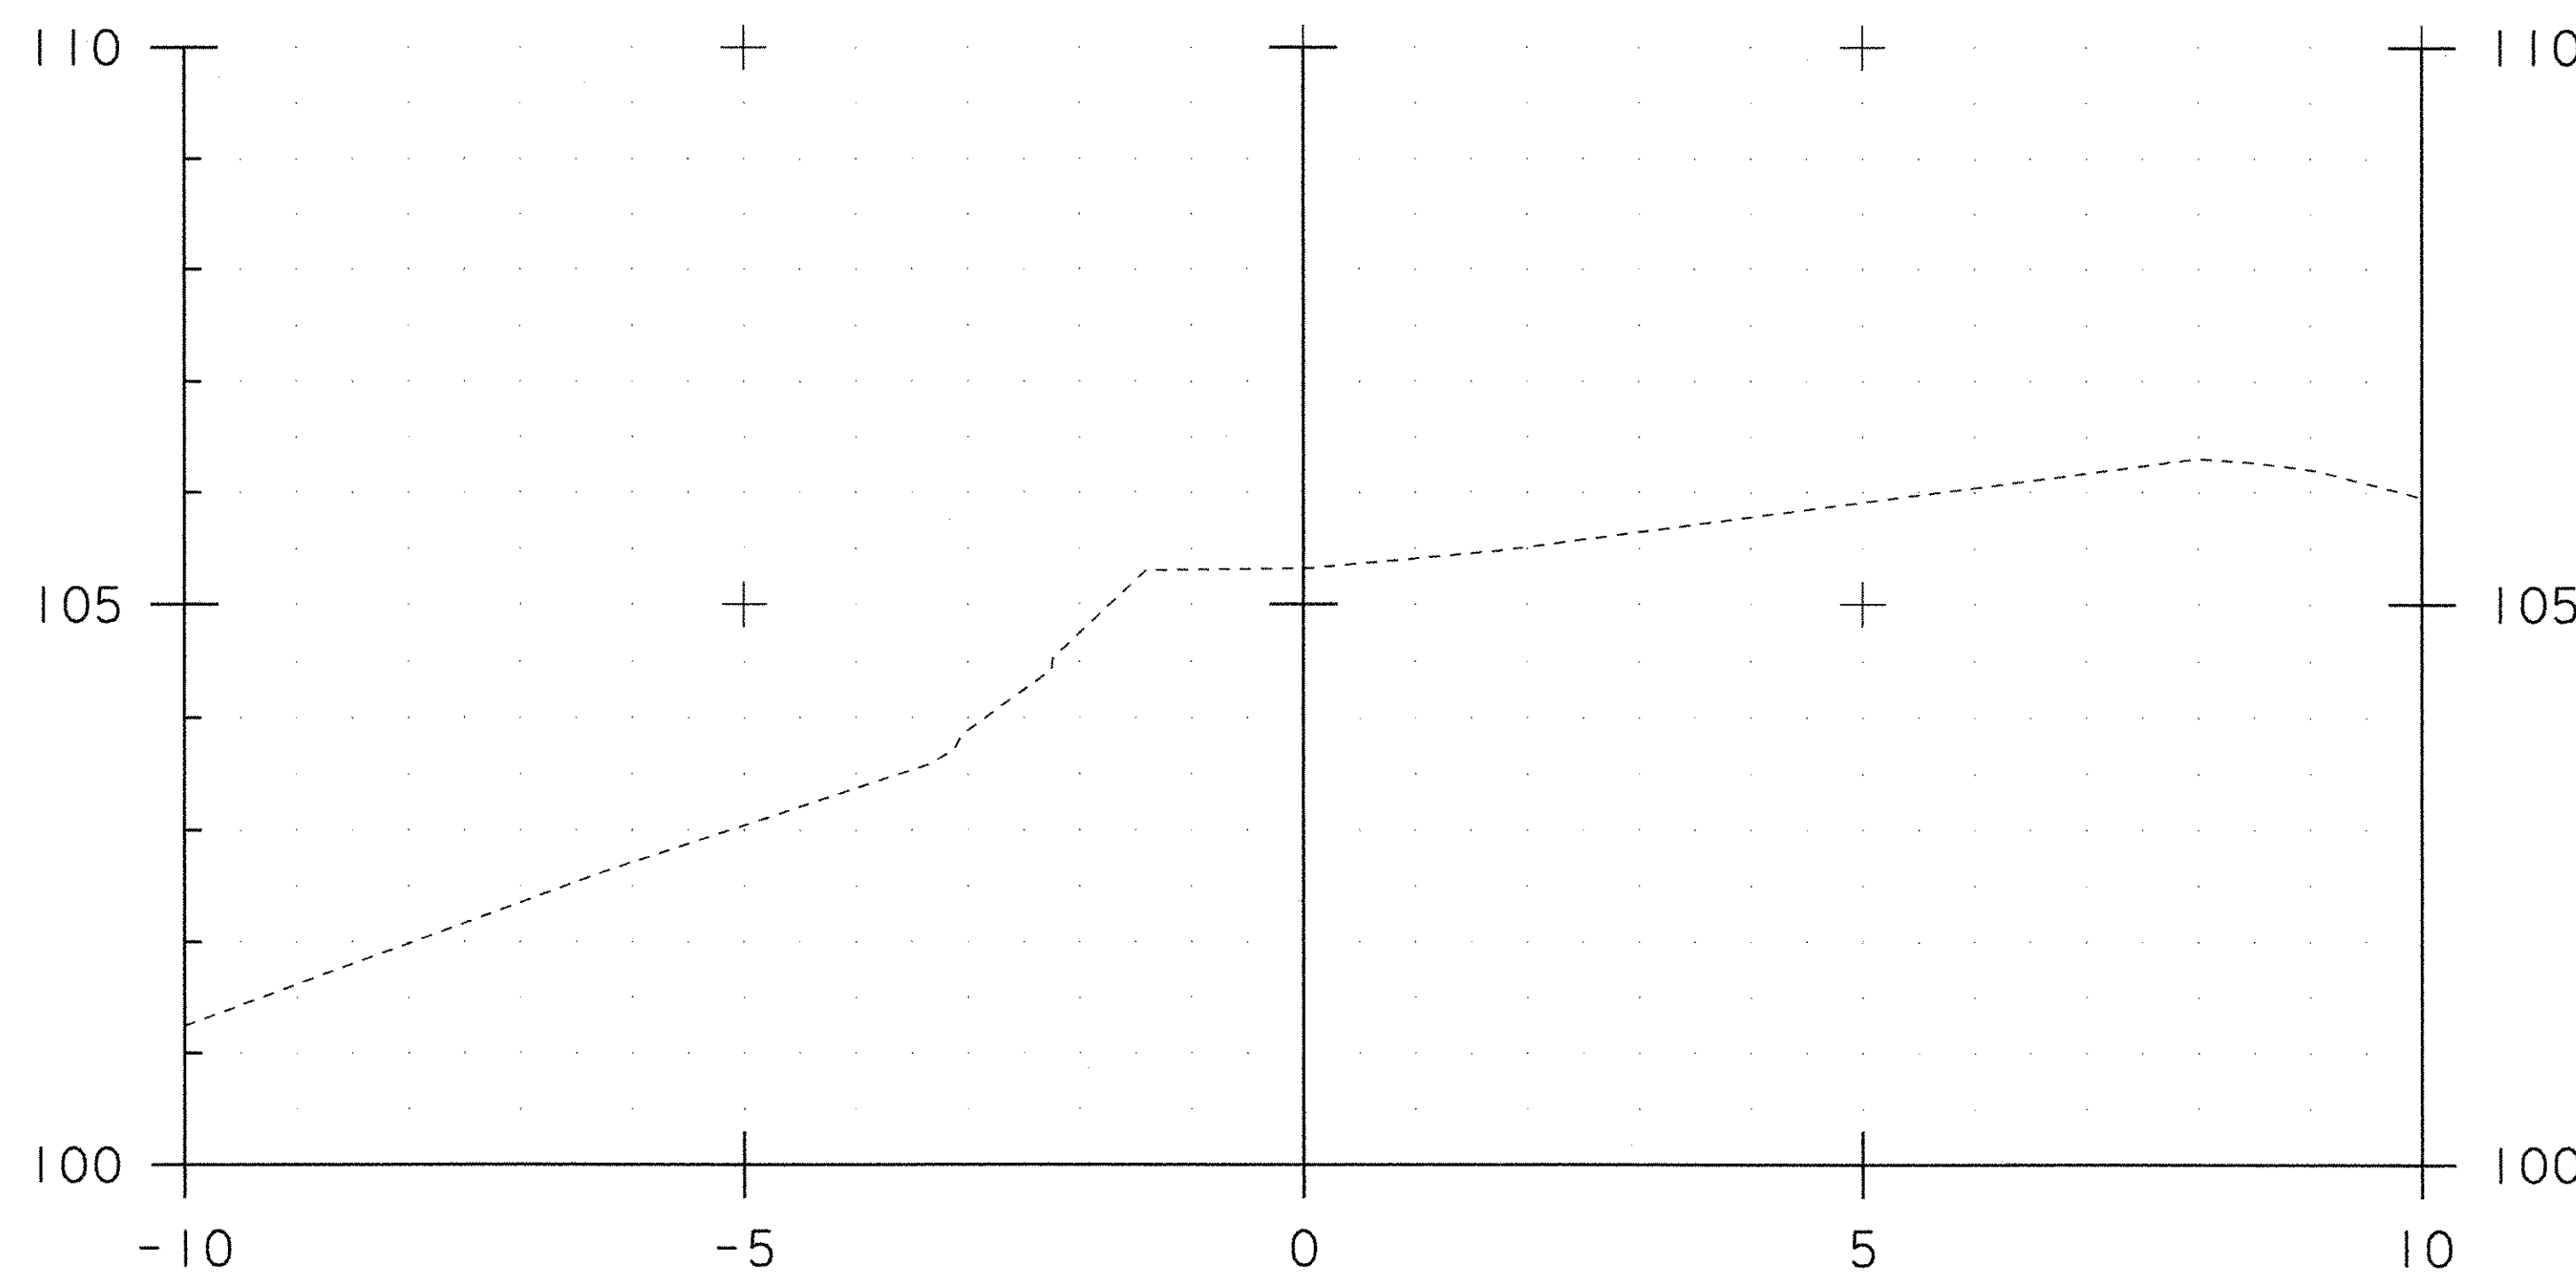

9+986.50


ZERO STONE FILL TYPE III
 ZERO UNCLASSIFIED CHAN EXC
 ZERO GEOTEXTILE UNDER STONE FILL

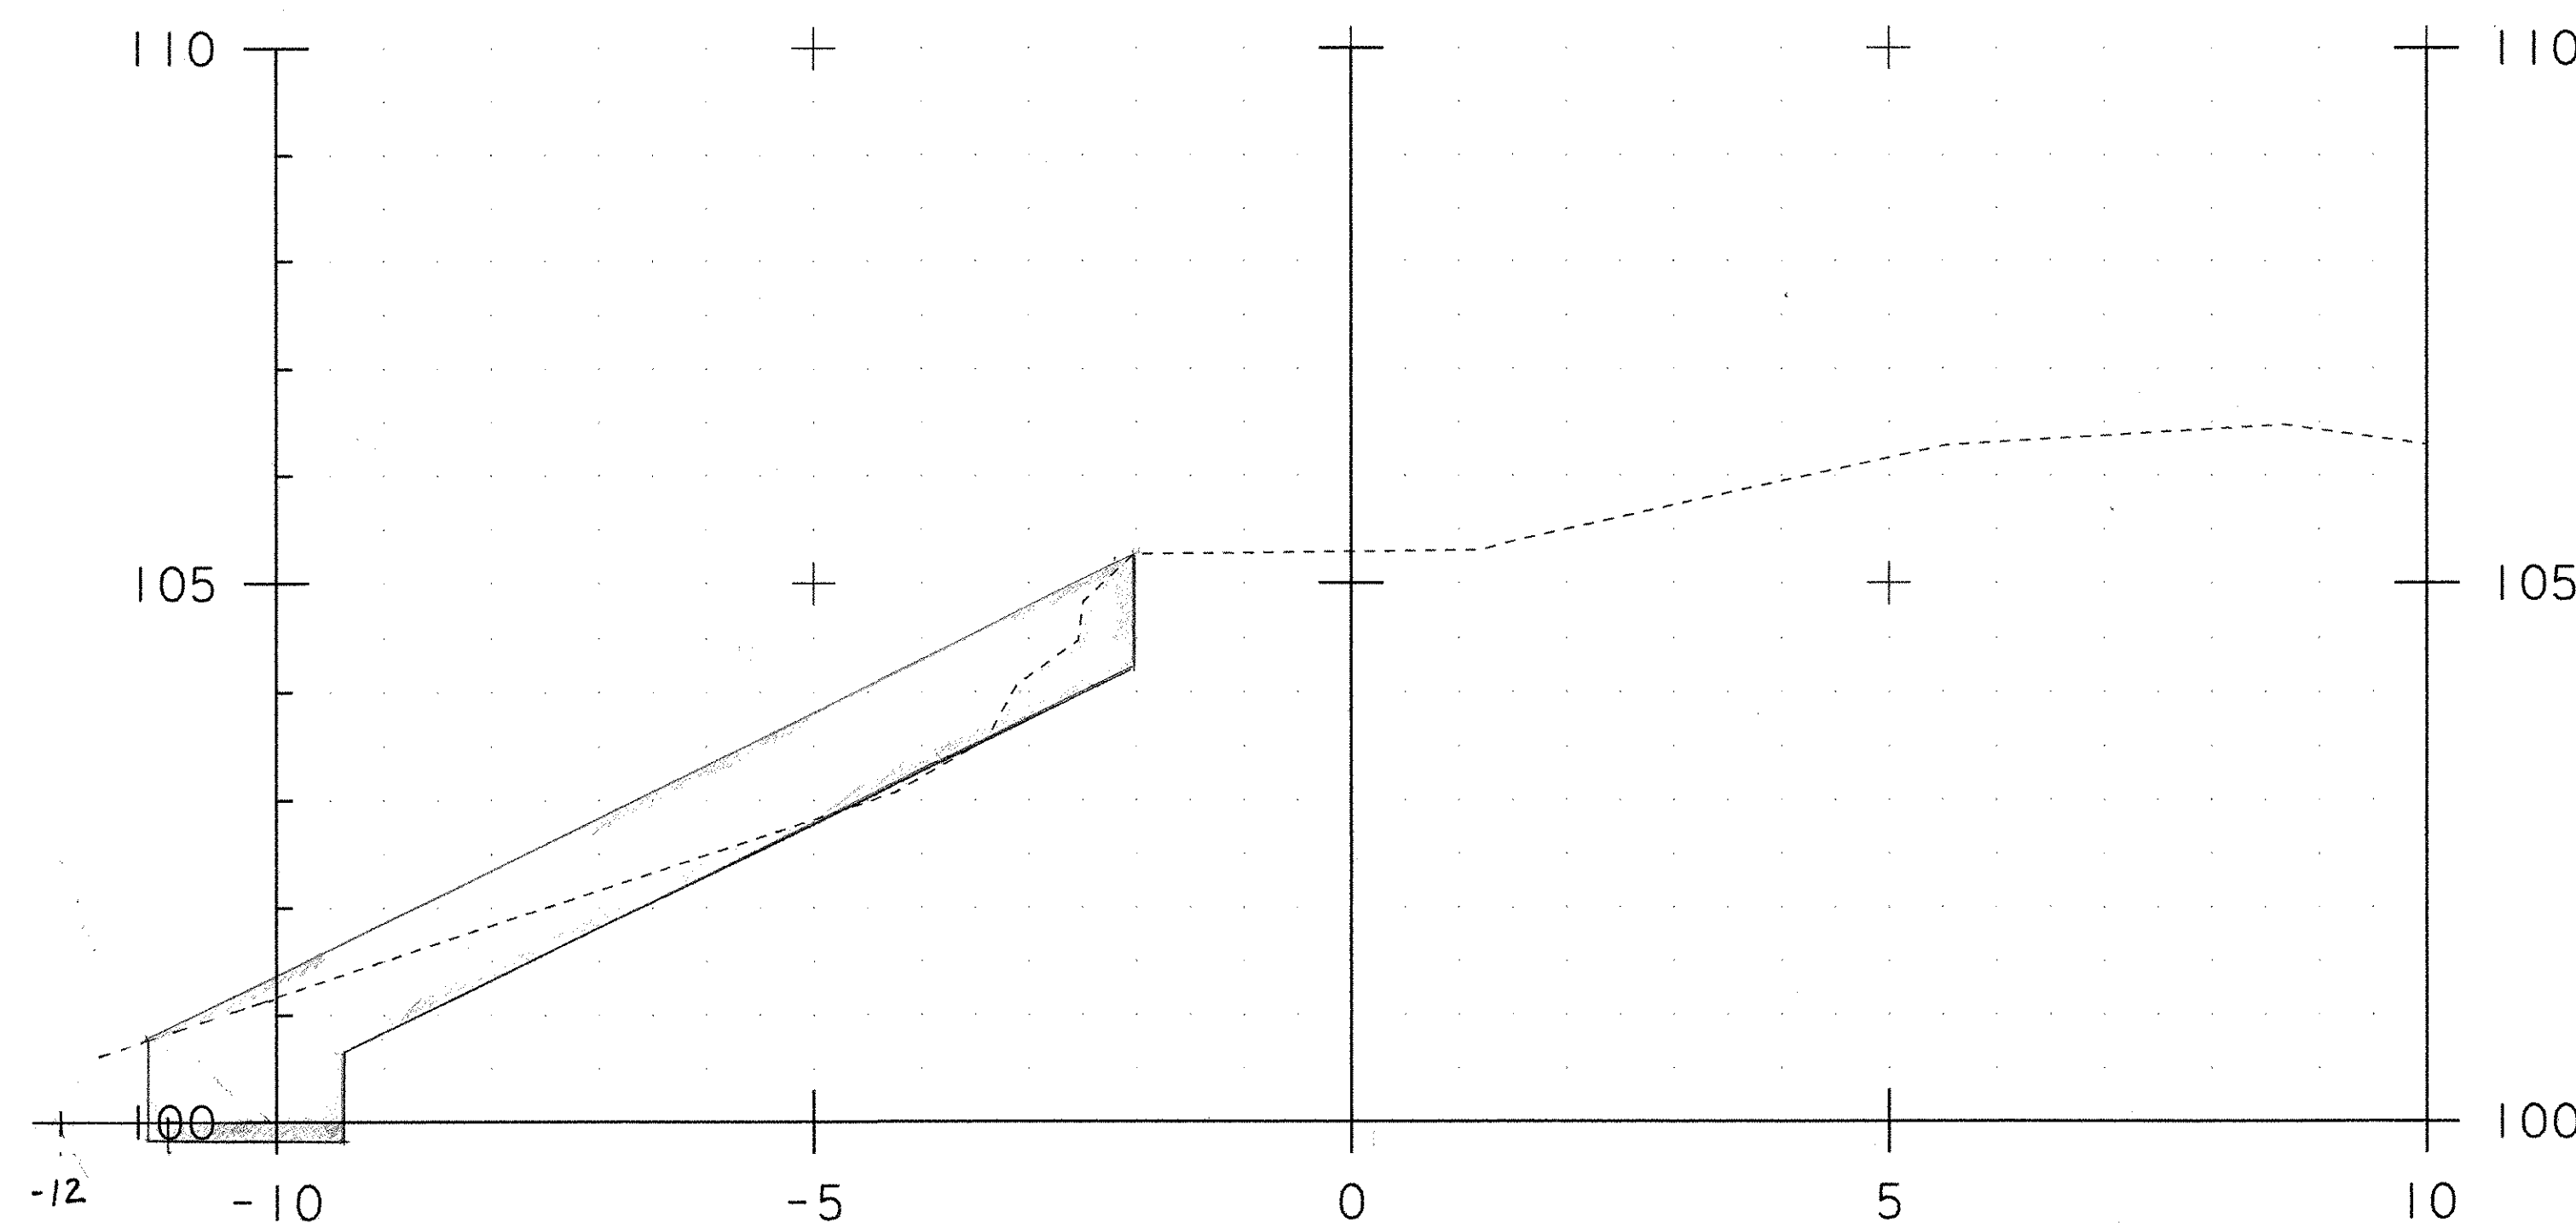

9+988.00


STONE FILL TYPE III - 9.83m³
 LINC CHAN EXC - 4.51m³
 GEO UNDER STONE FILL - 11.8m

PROJECT NAME:	Leicester	PLOT DATE:	01-NOV-2005
PROJECT NUMBER:	BRF 0160(3)S	DRAWN BY:	R. Bullock
FILE NAME:		CHECKED BY:	
PROJECT LEADER:		SHEET 1	OF 7
DESIGNED BY:	<i>ARB</i>		

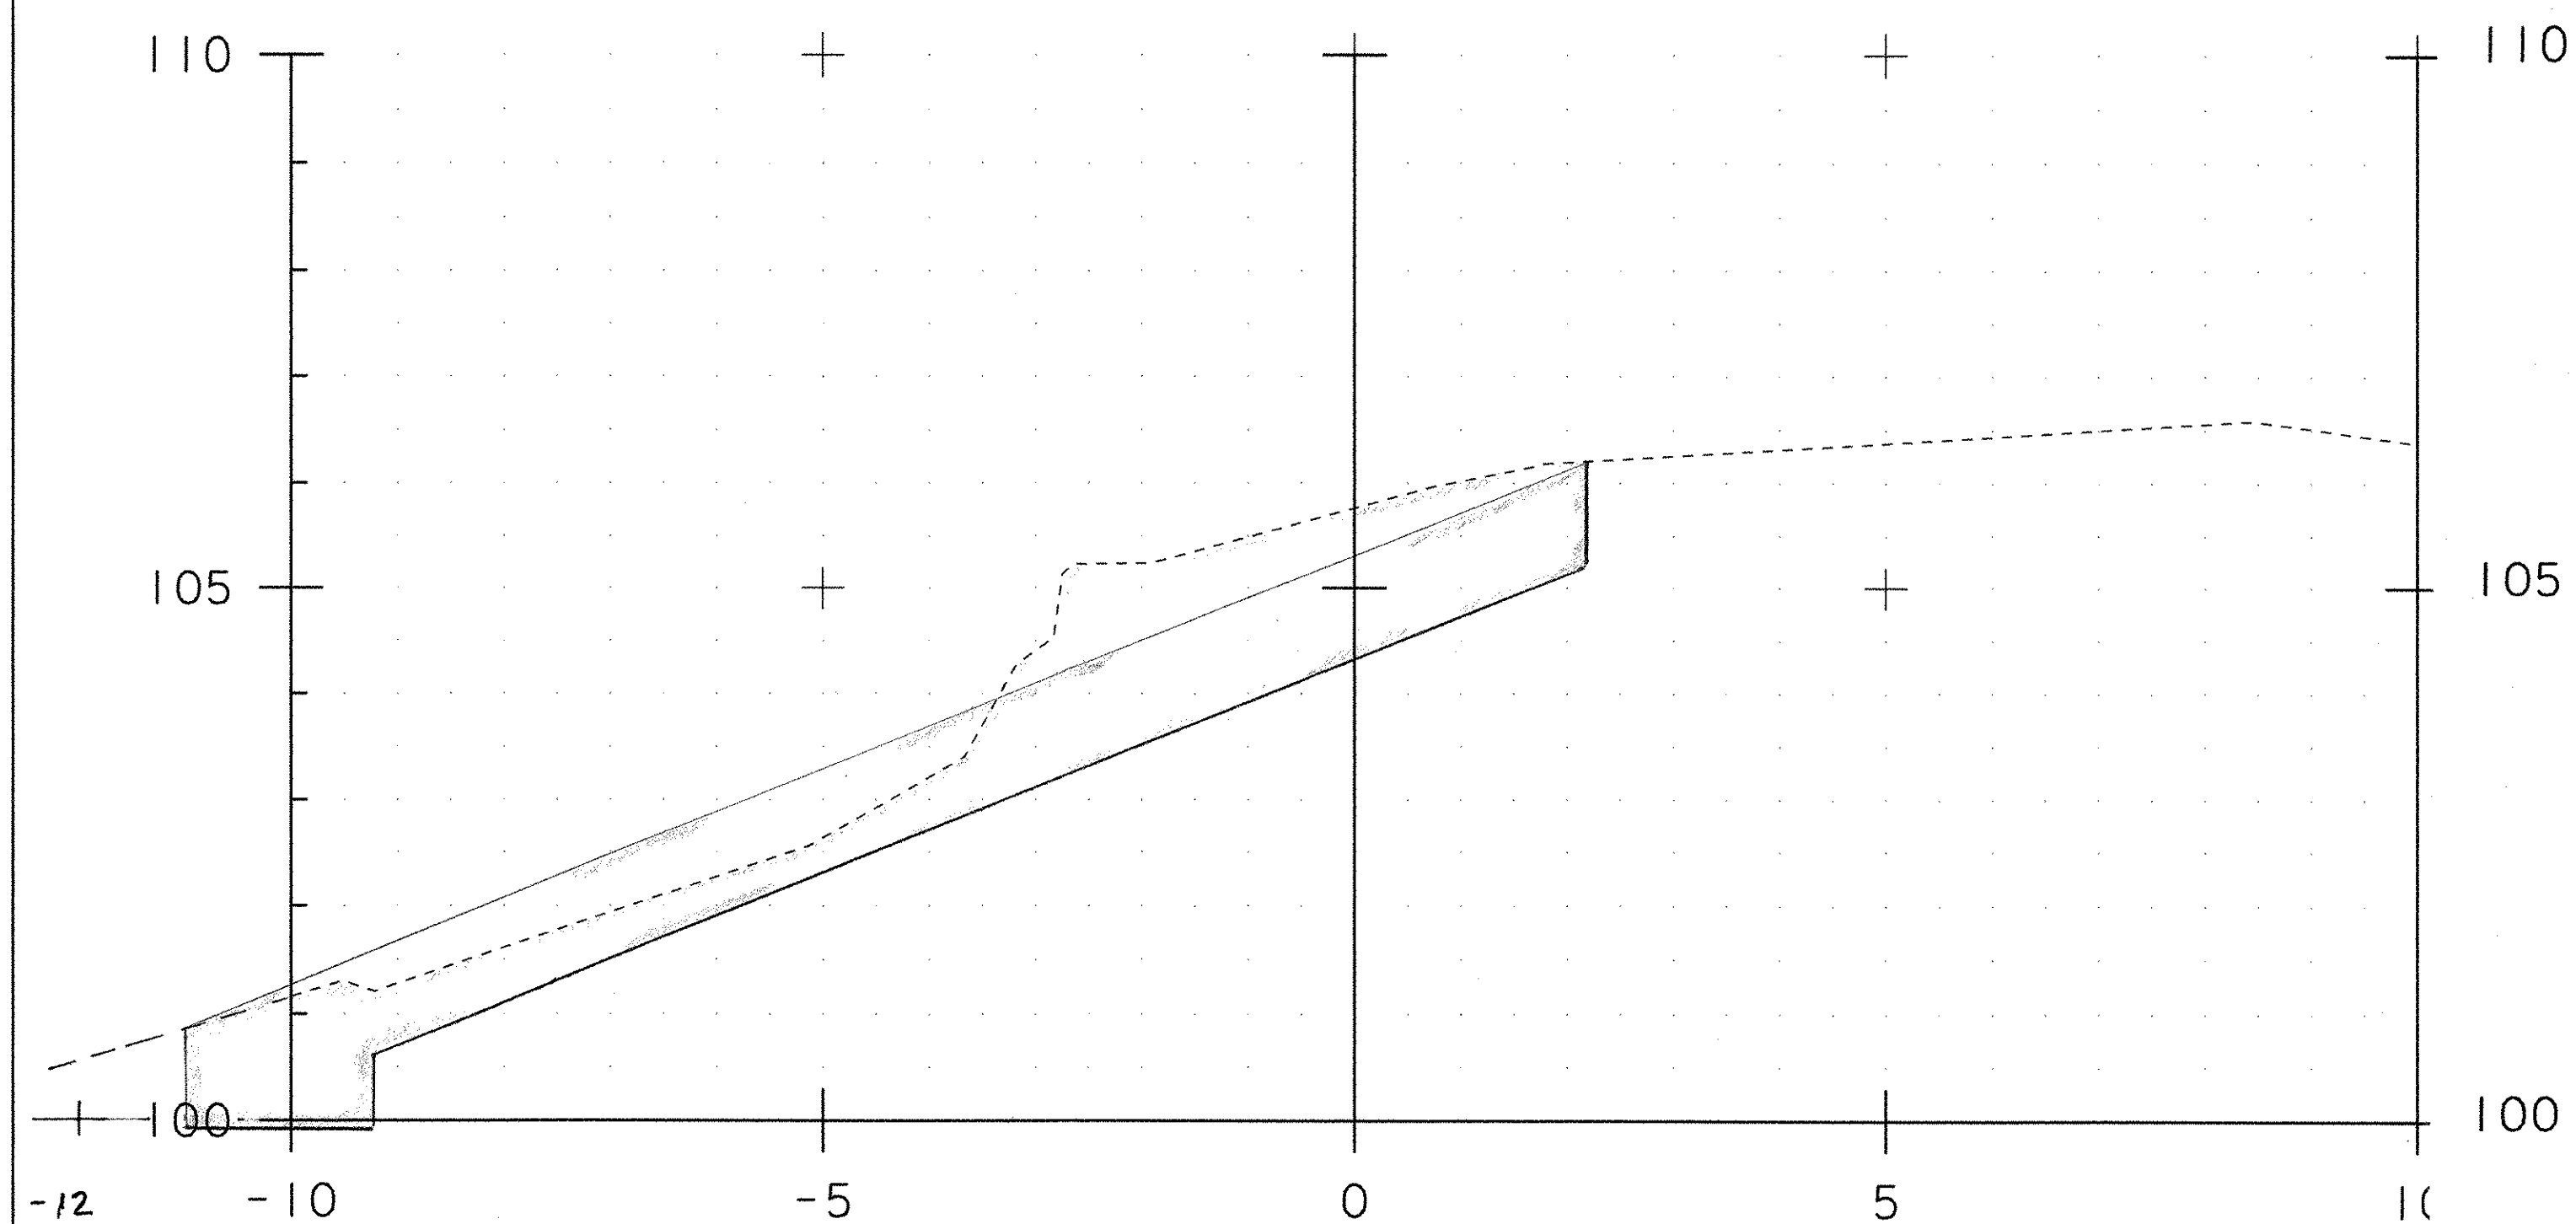

9+990.00

STONE FILL TYPE III - 13.37m²
 ONE COFFERDAM - 12.93m²
 GEO UNDER S.F - 16.05M

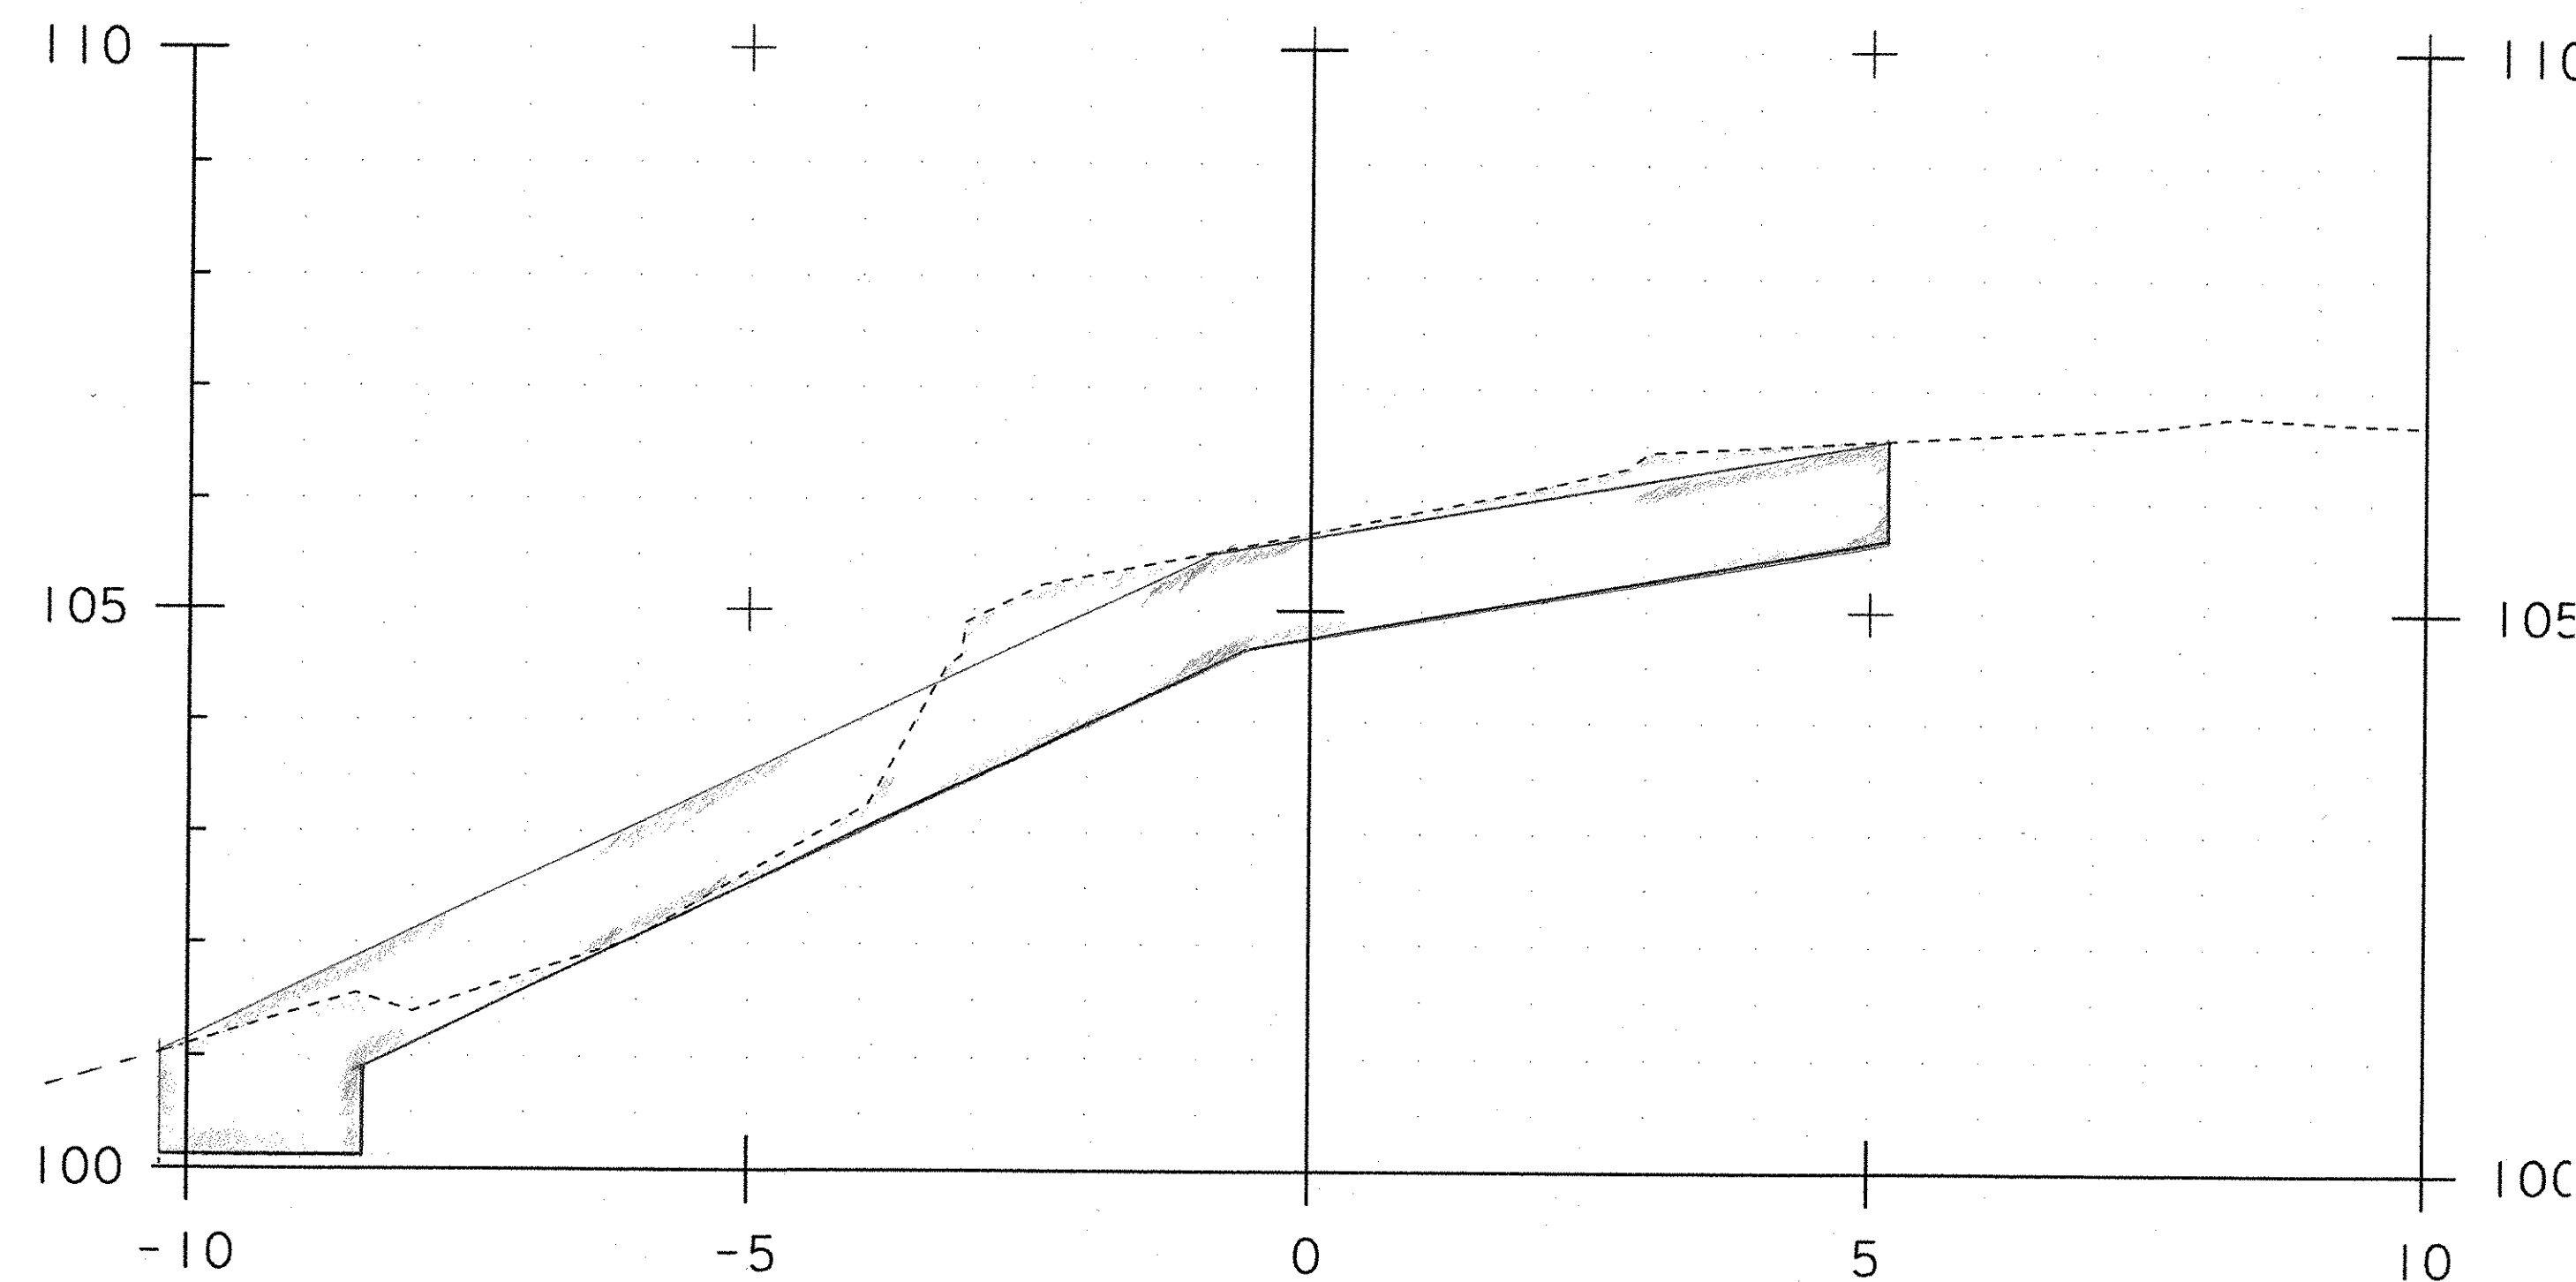


9+992.30

STONE FILL TYPE III - 15.93m²
 ONE COFFERDAM - 12.93m²
 GEO UNDER S.F - 18.3M

ZERO COFFERDAM
 ZERO GRAN. BACKFILL

~~HASE~~

PROJECT NAME:	Leicester	PLOT DATE:	01-NOV-2005
PROJECT NUMBER:	BRF 0160(3)S	DRAWN BY:	R. Bullock
FILE NAME:		CHECKED BY:	
PROJECT LEADER:		SHEET 2	OF 7
DESIGNED BY:	112121		

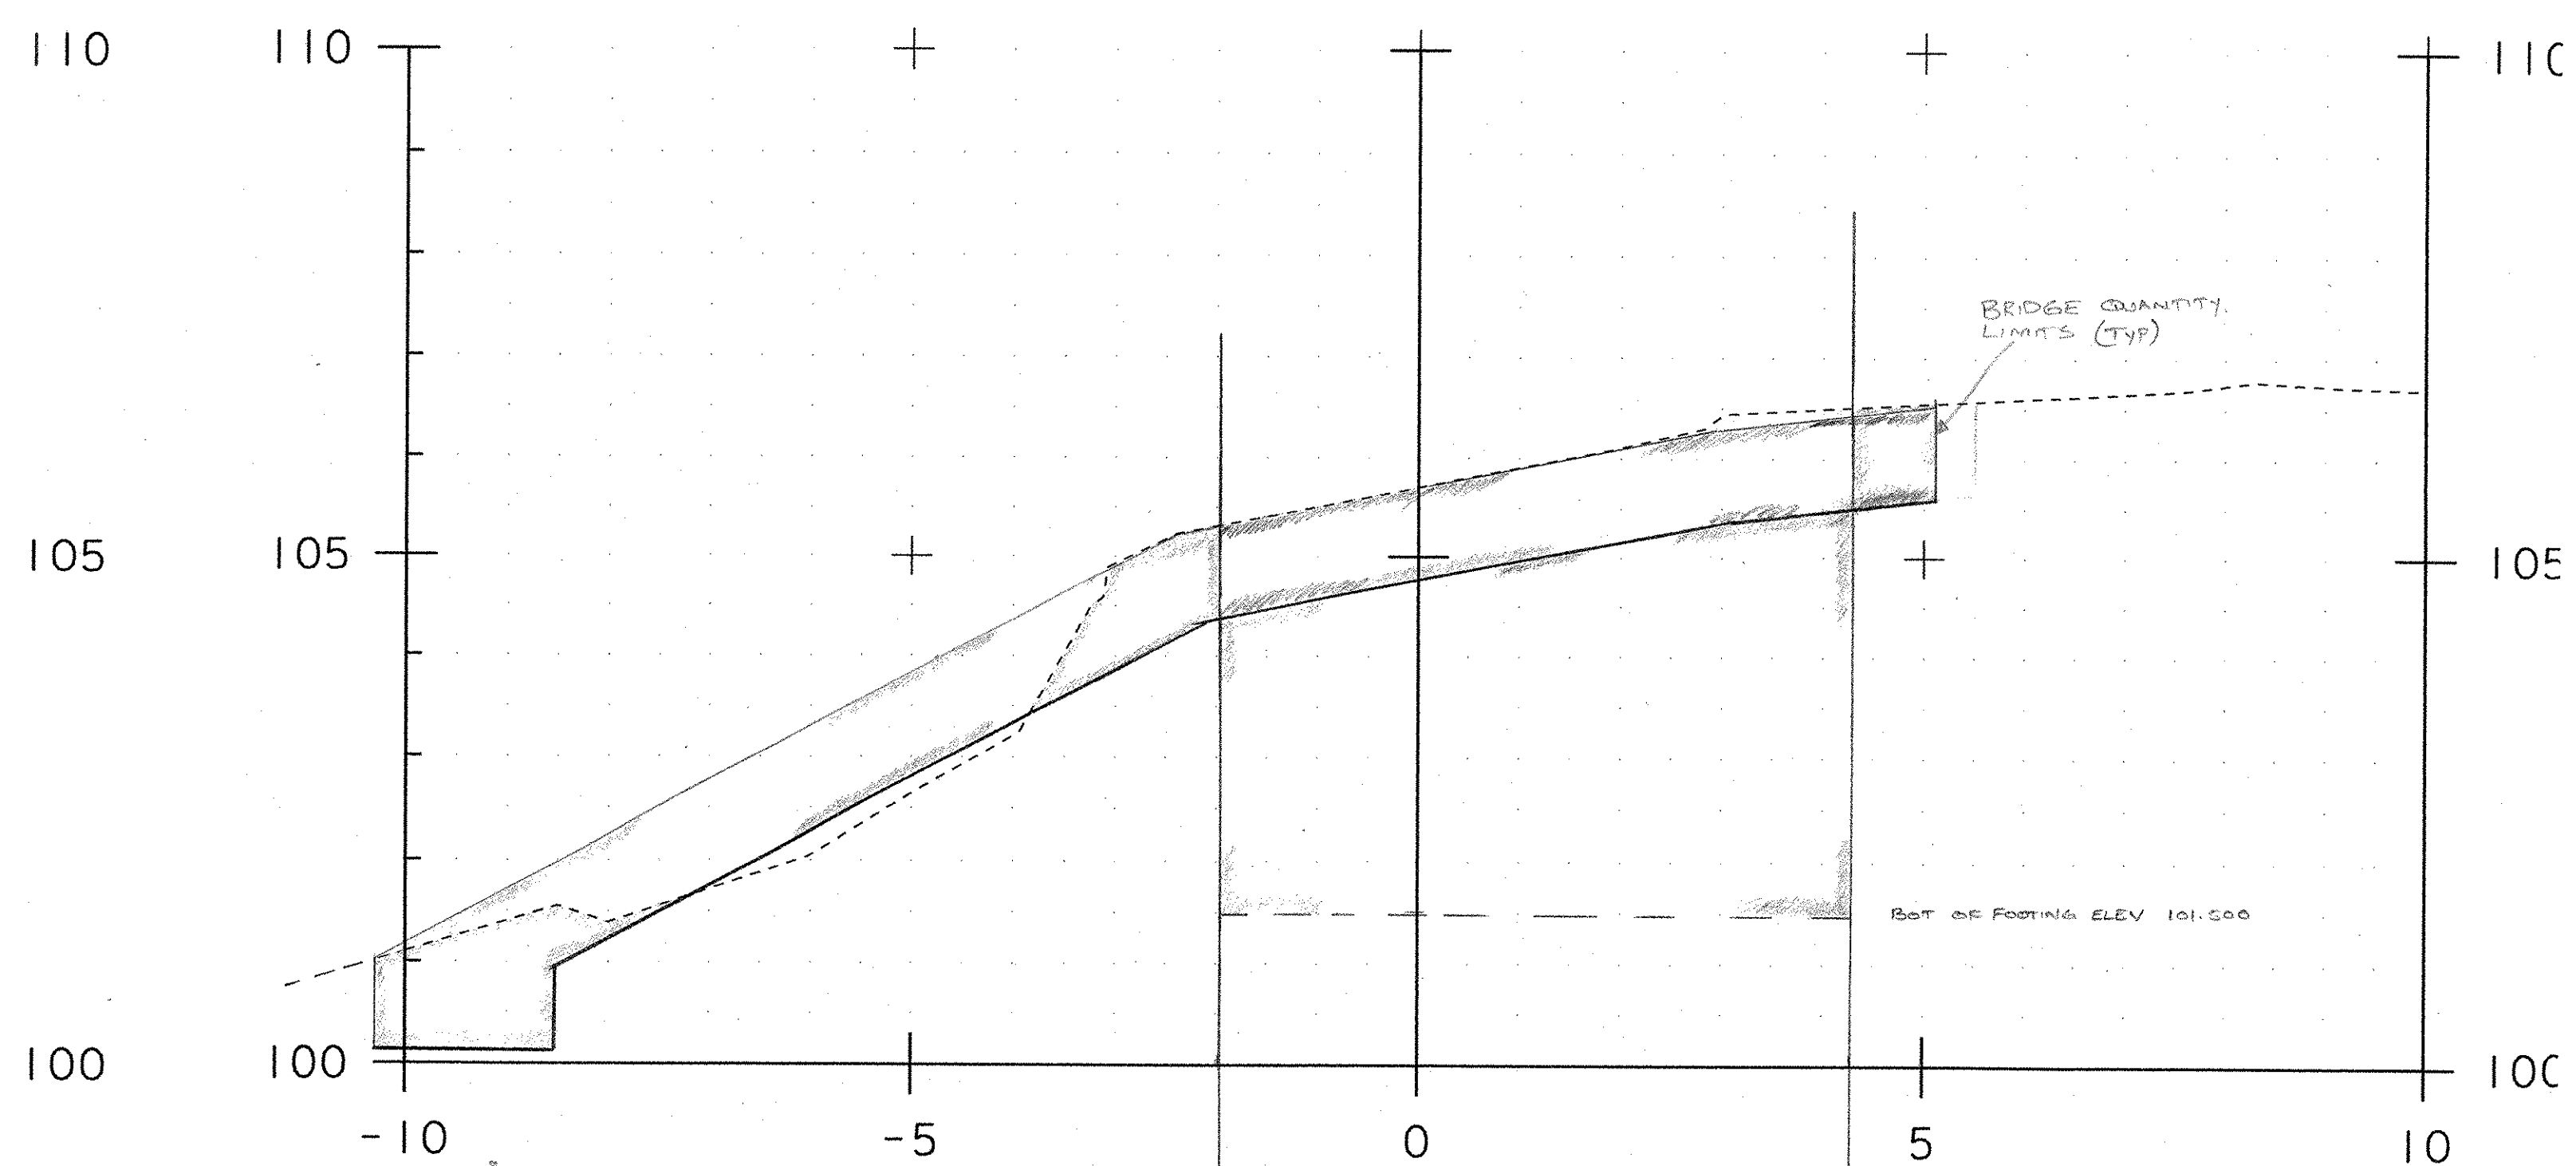


STONE FILL TYPE III - 16.09 m²
 UNCL. CHAN. EXC - 5.04 m²
 GEO UNDER S.F. - 18.3 m²
 GRAN. BACKFILL - 23.32 m²

EXC - E + R = $\frac{28.4}{1.41}$ m²

9+992.80

FULL WIDTH COFFERDAM

11B ABZ

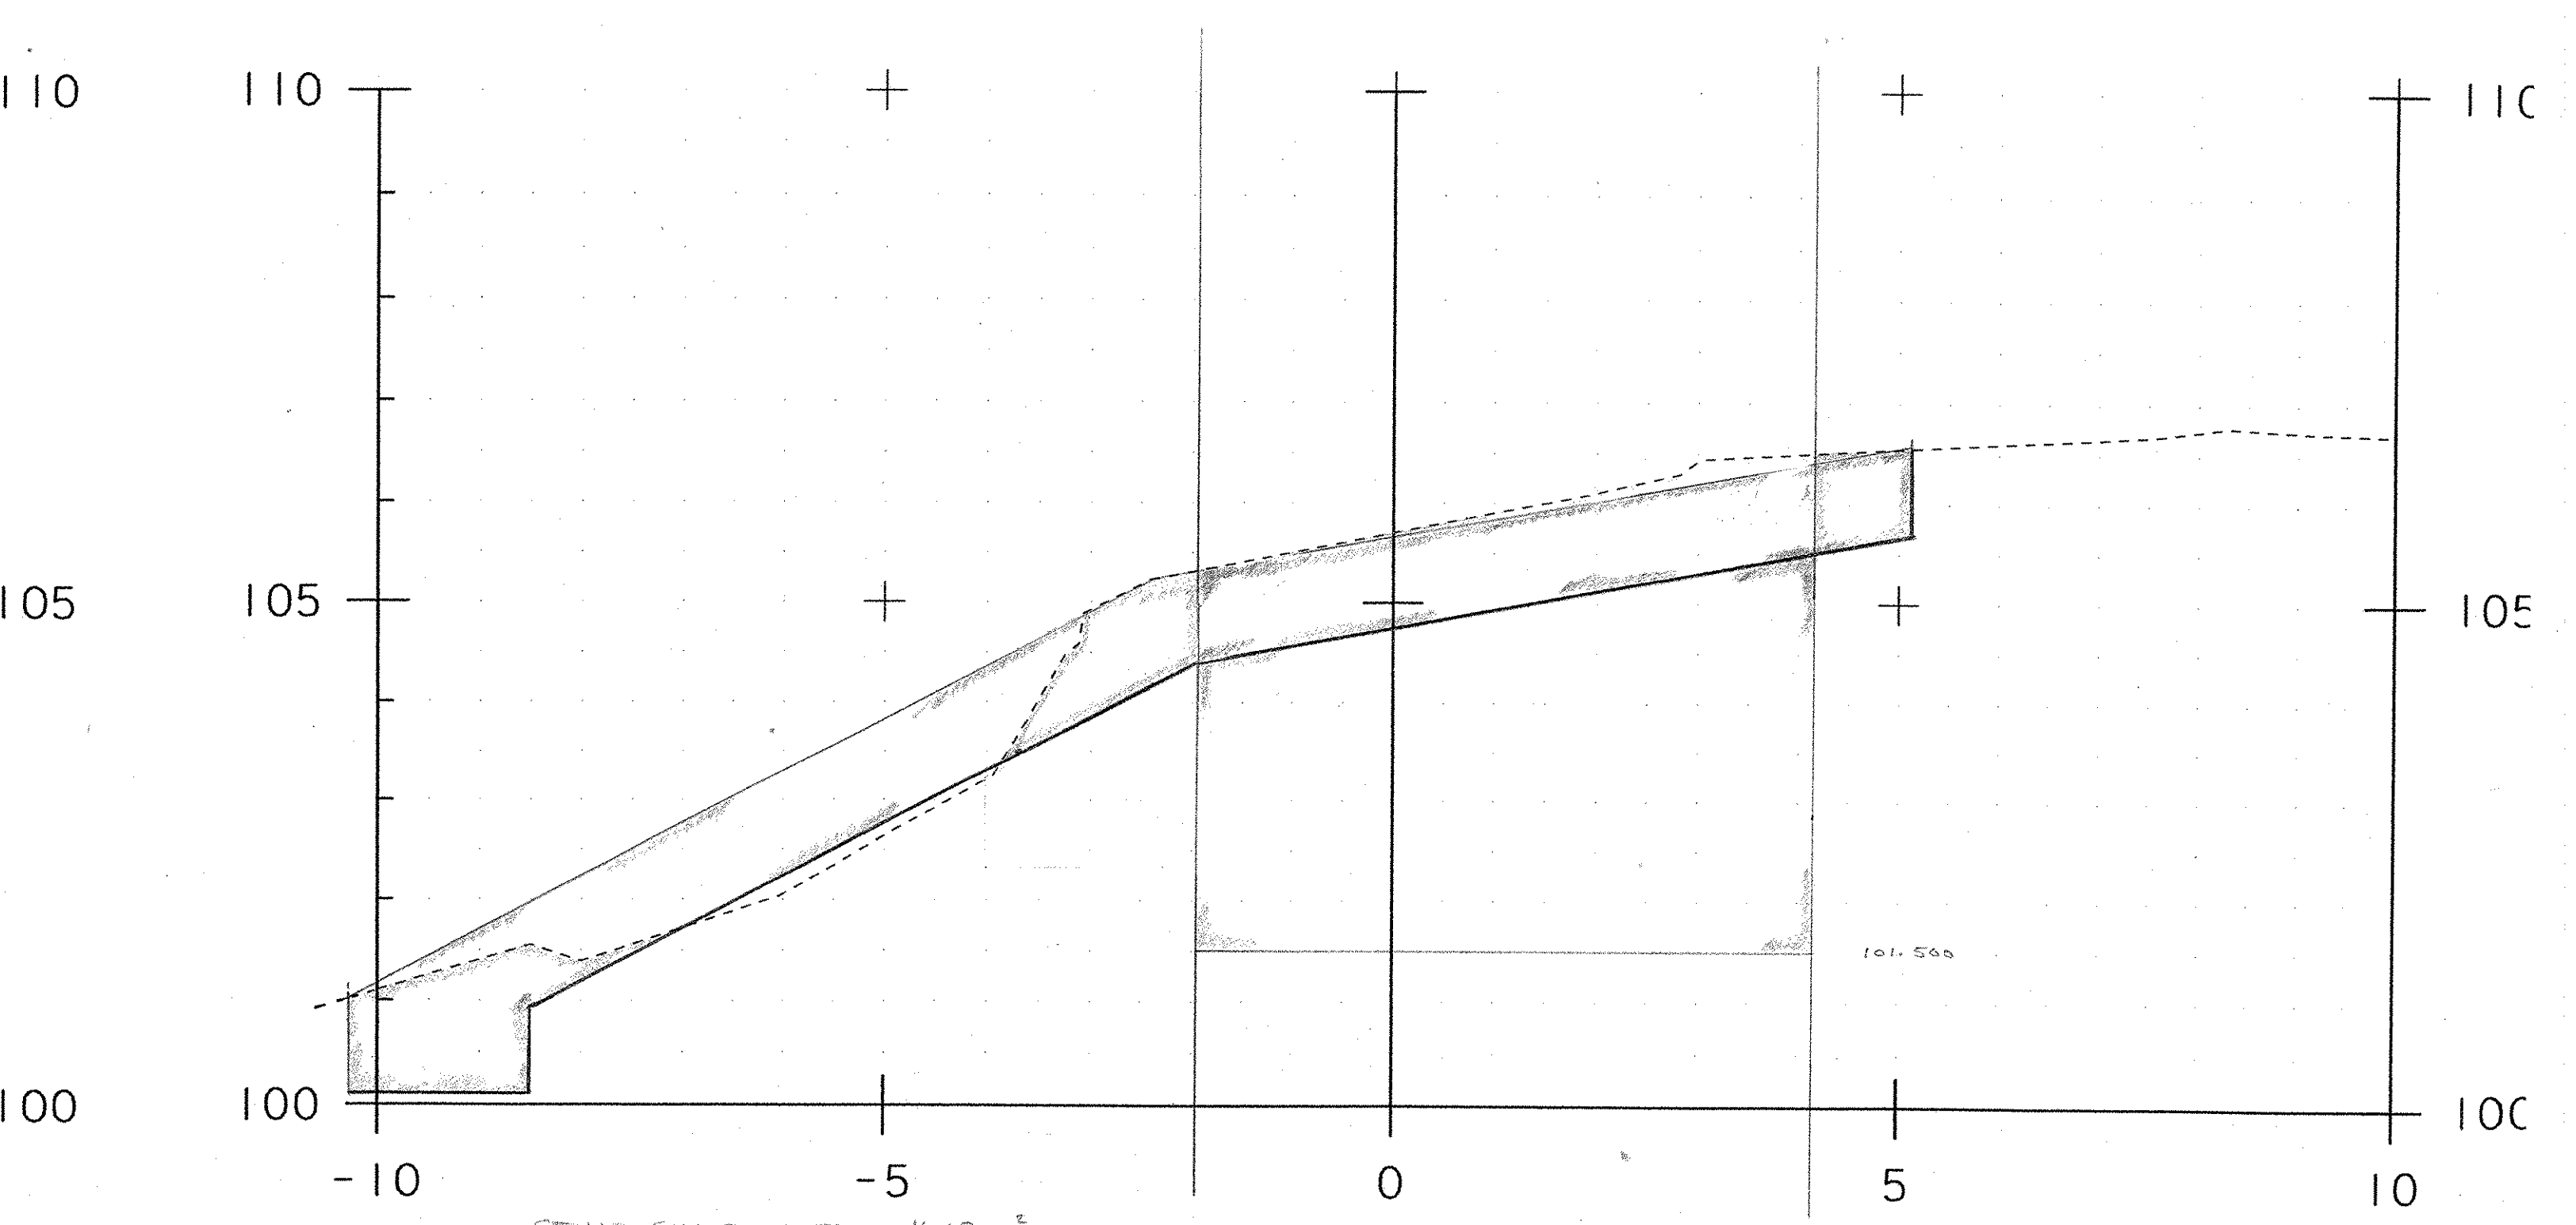


STONE FILL TYPE III - 16.09 m³
 UNC CLAM EXC - 5.04 m³
 GEO UNDER S.F - 18.3 M
 GRAN BACKFILL - 28.32


9+993.00

FOOTING CORNER

11/4 ABZ

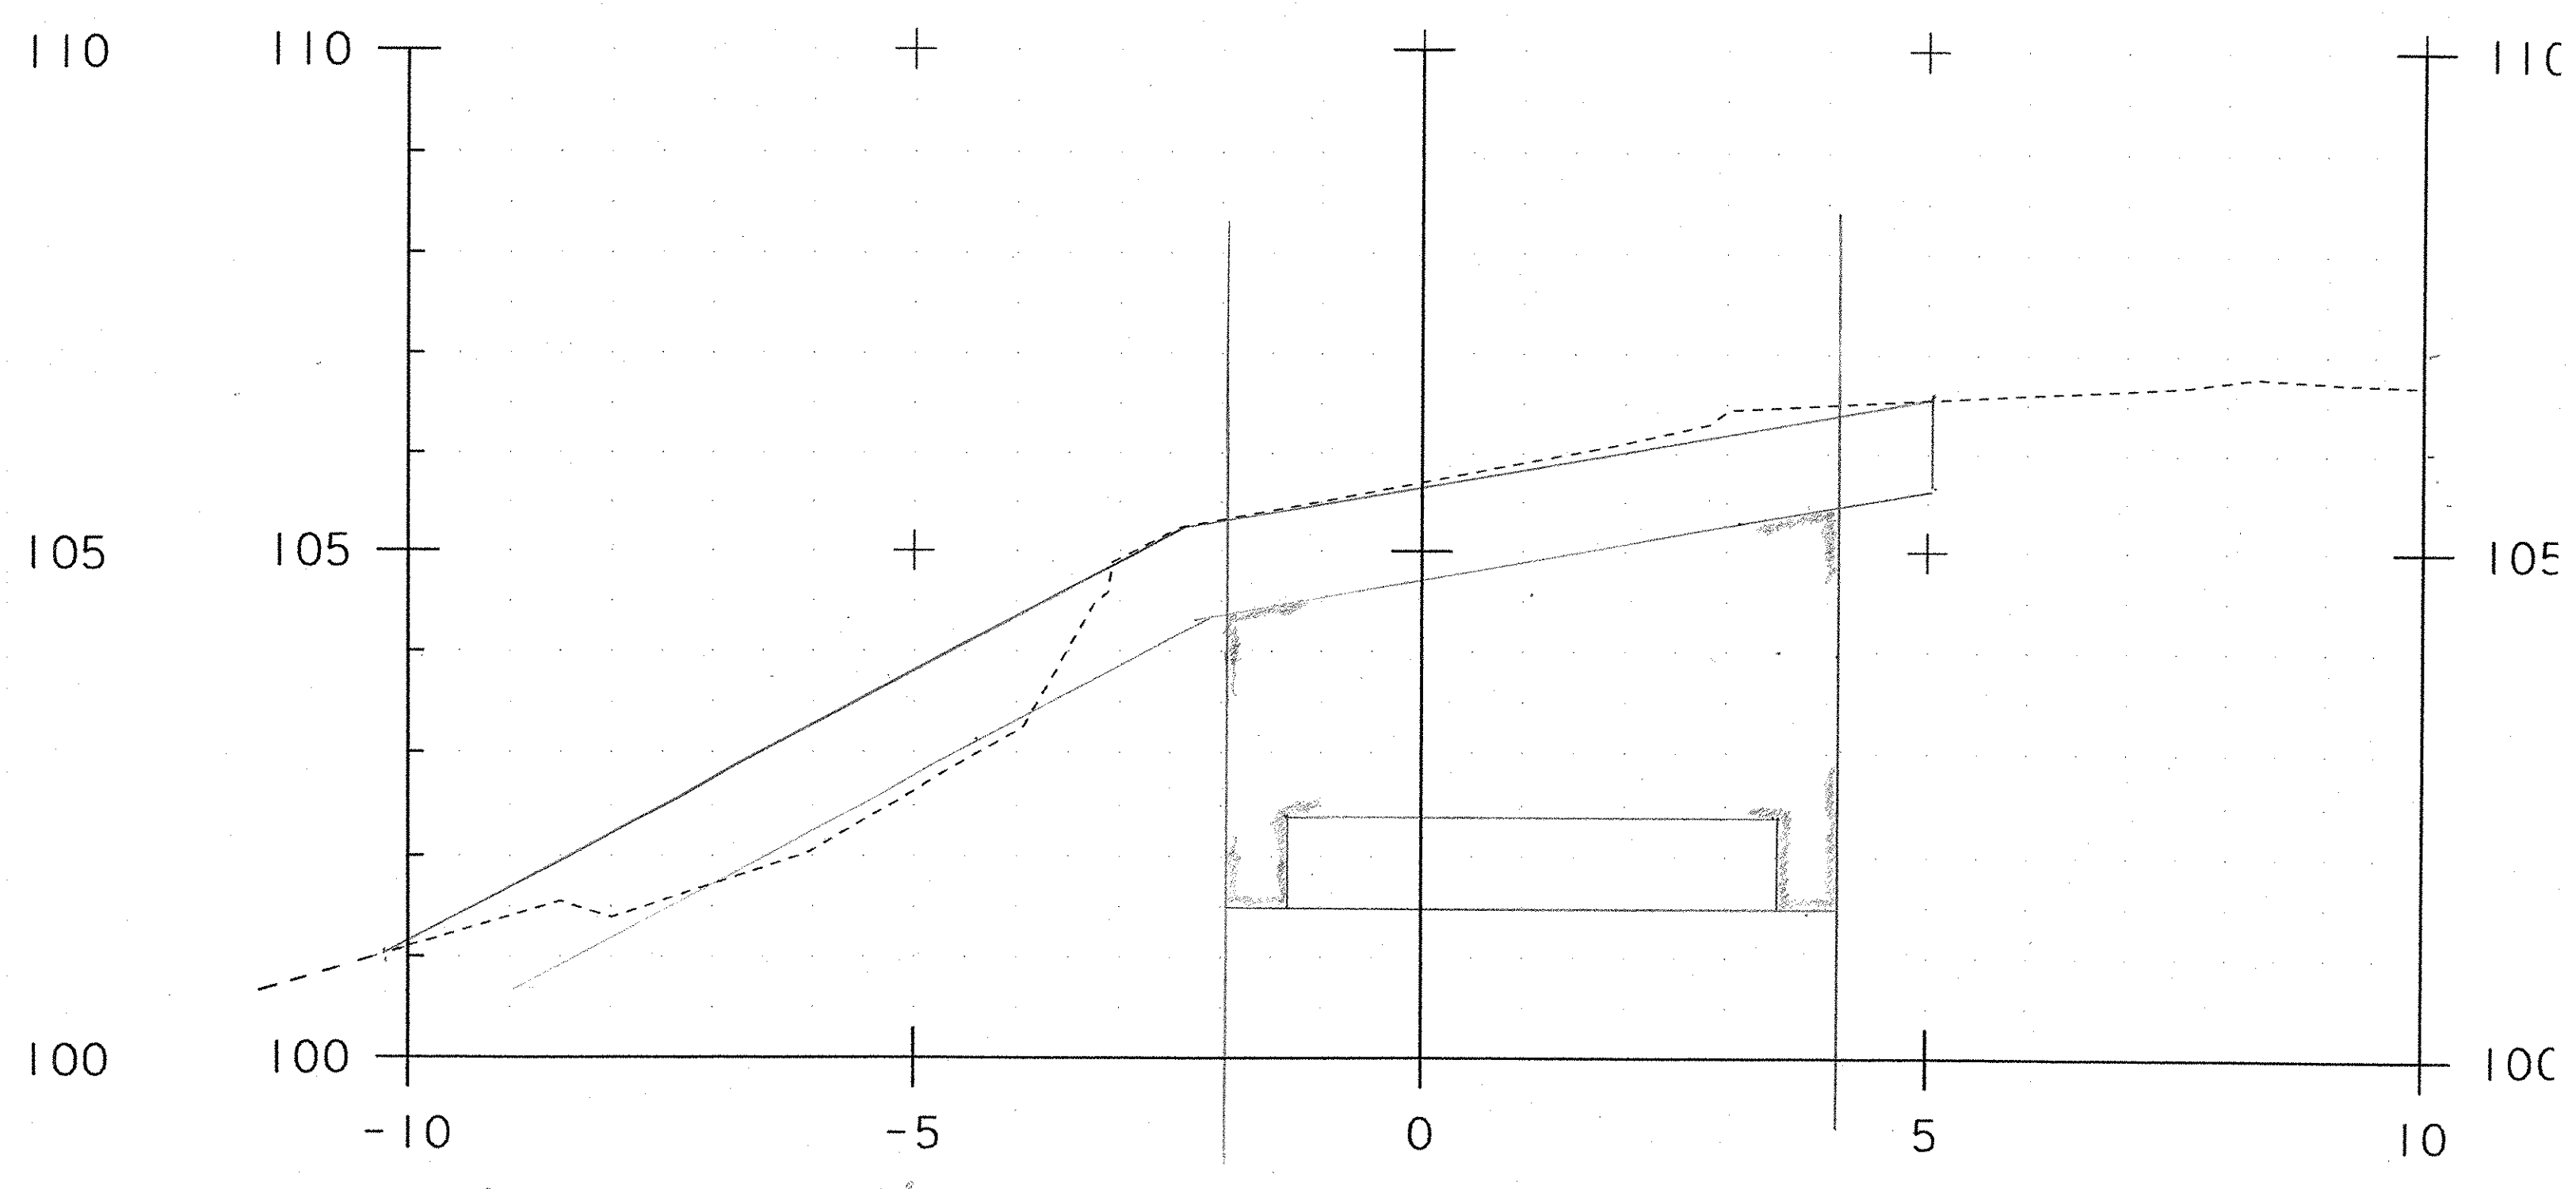


9+993.40 FOOTING CORNER 115
 9+994.20 ABUT STEM CORNER 114 AB

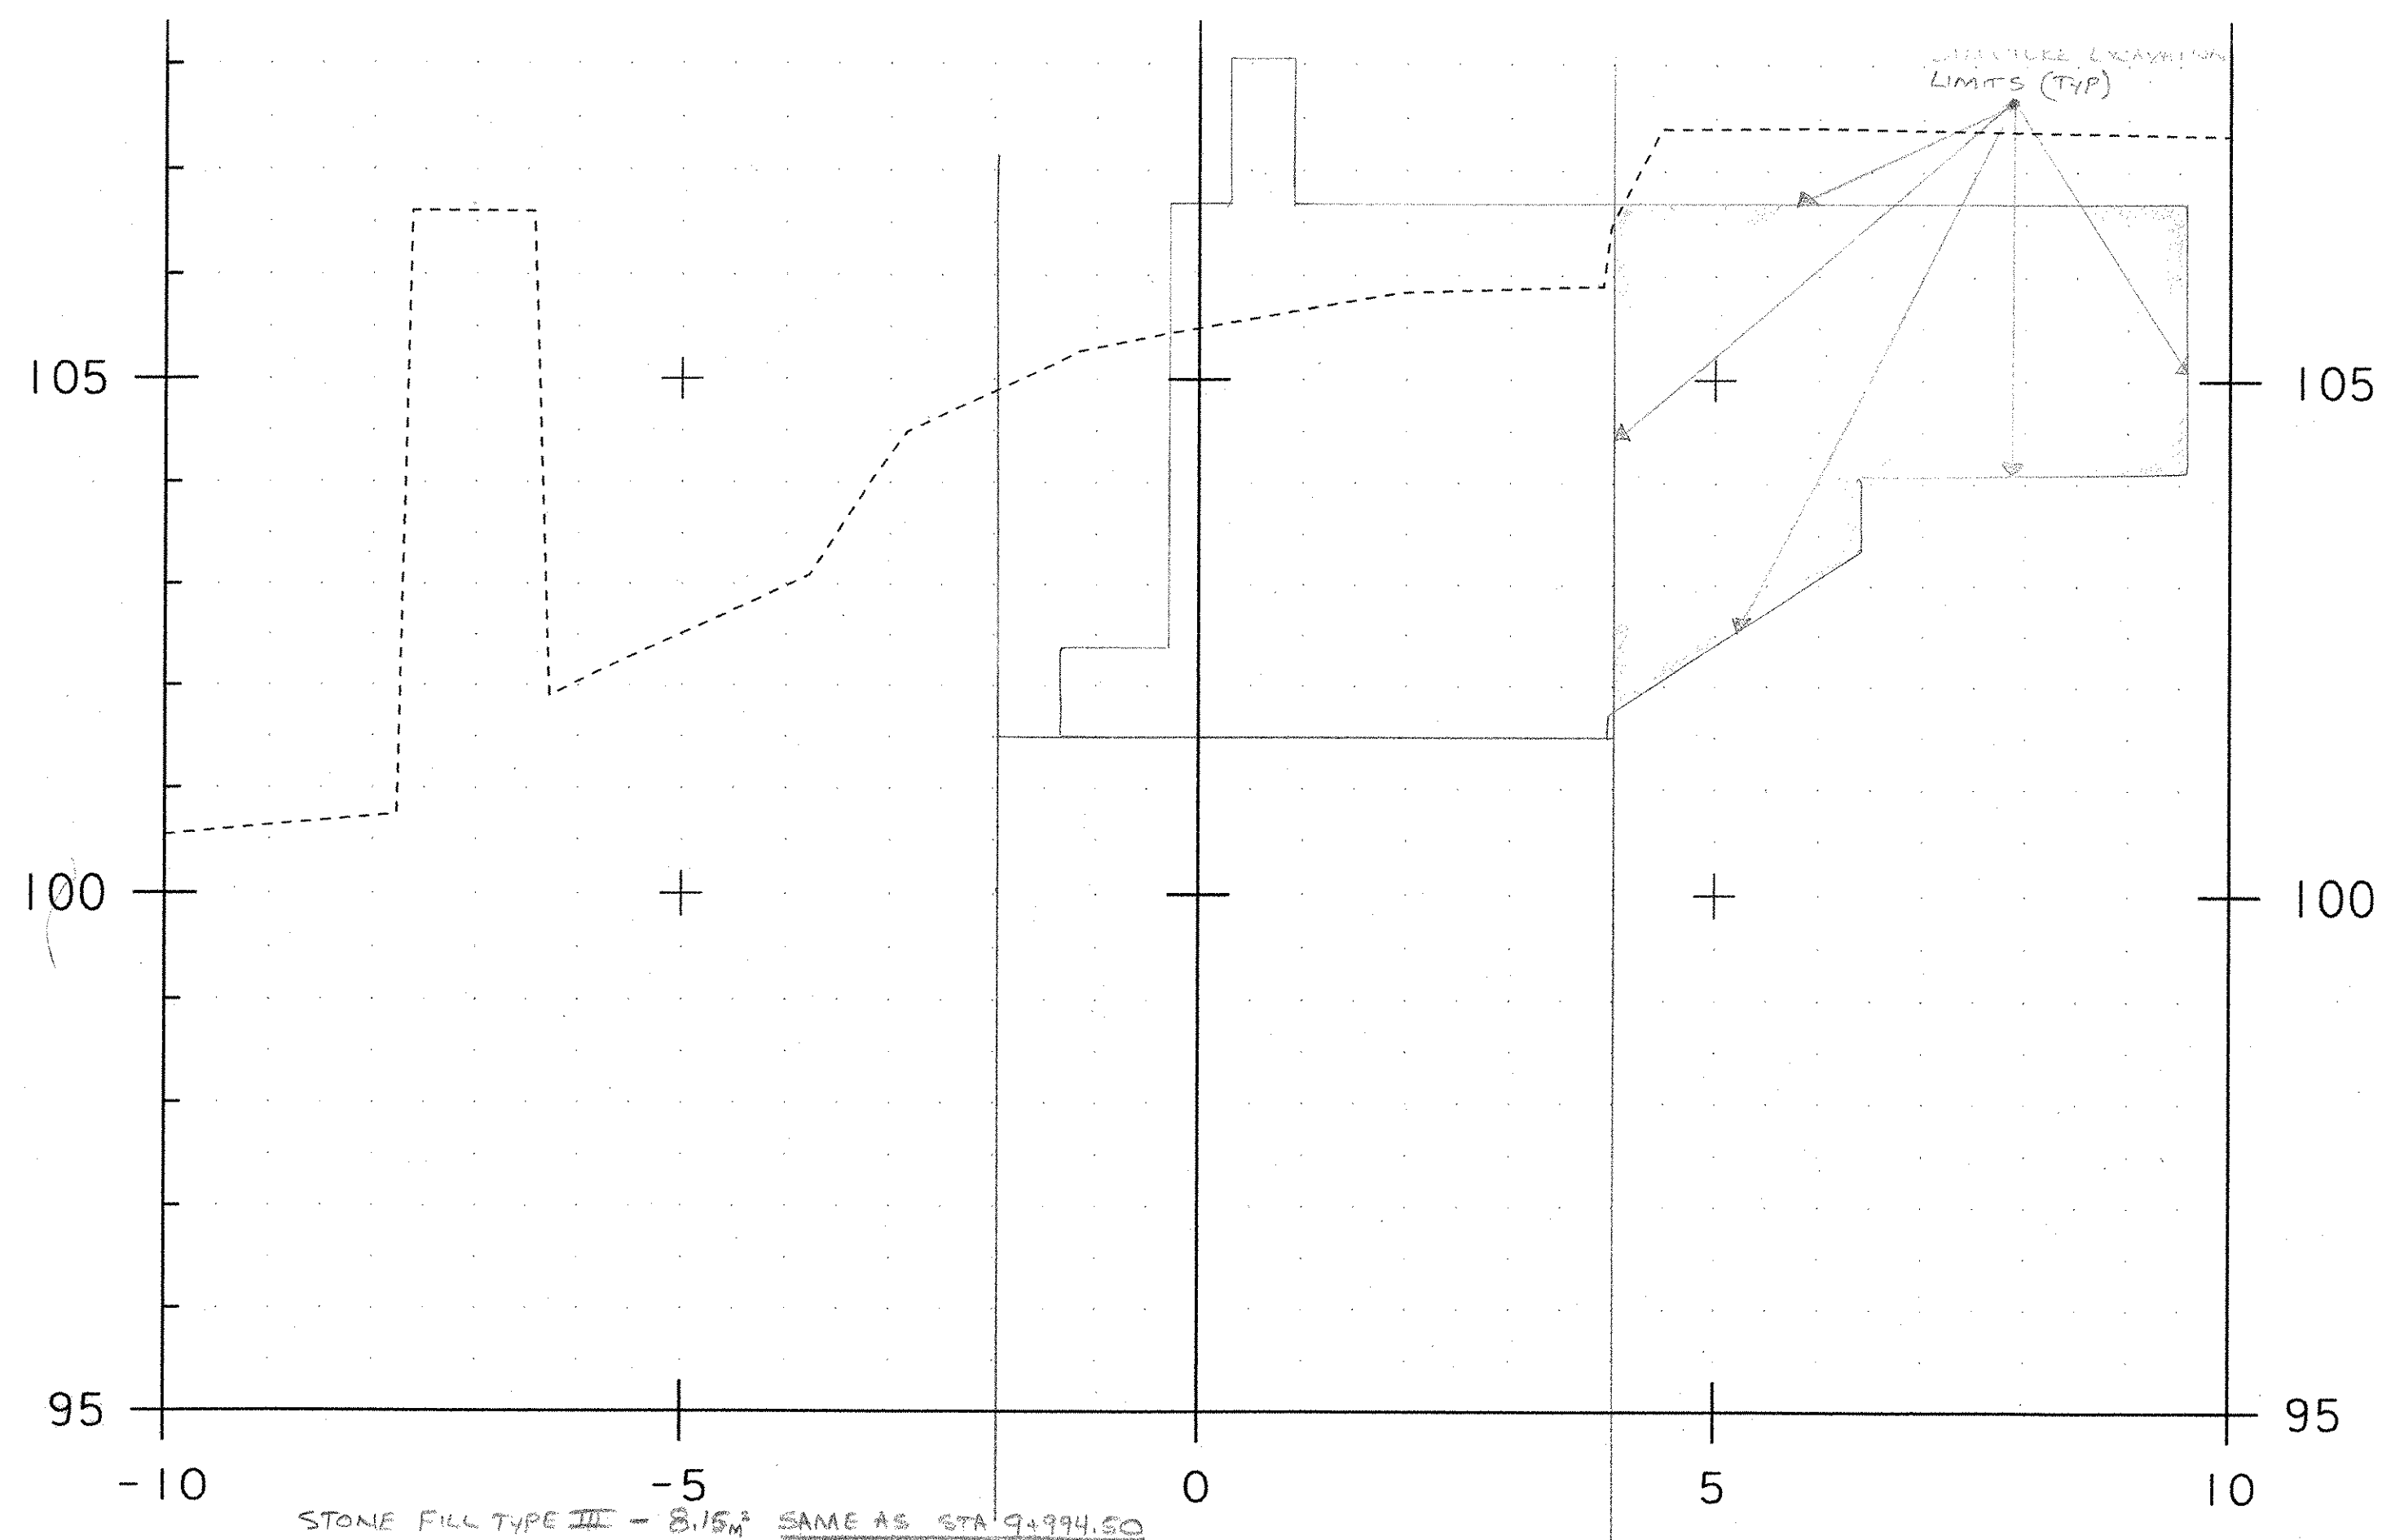


9+995.10

116
~~116~~ ABZ

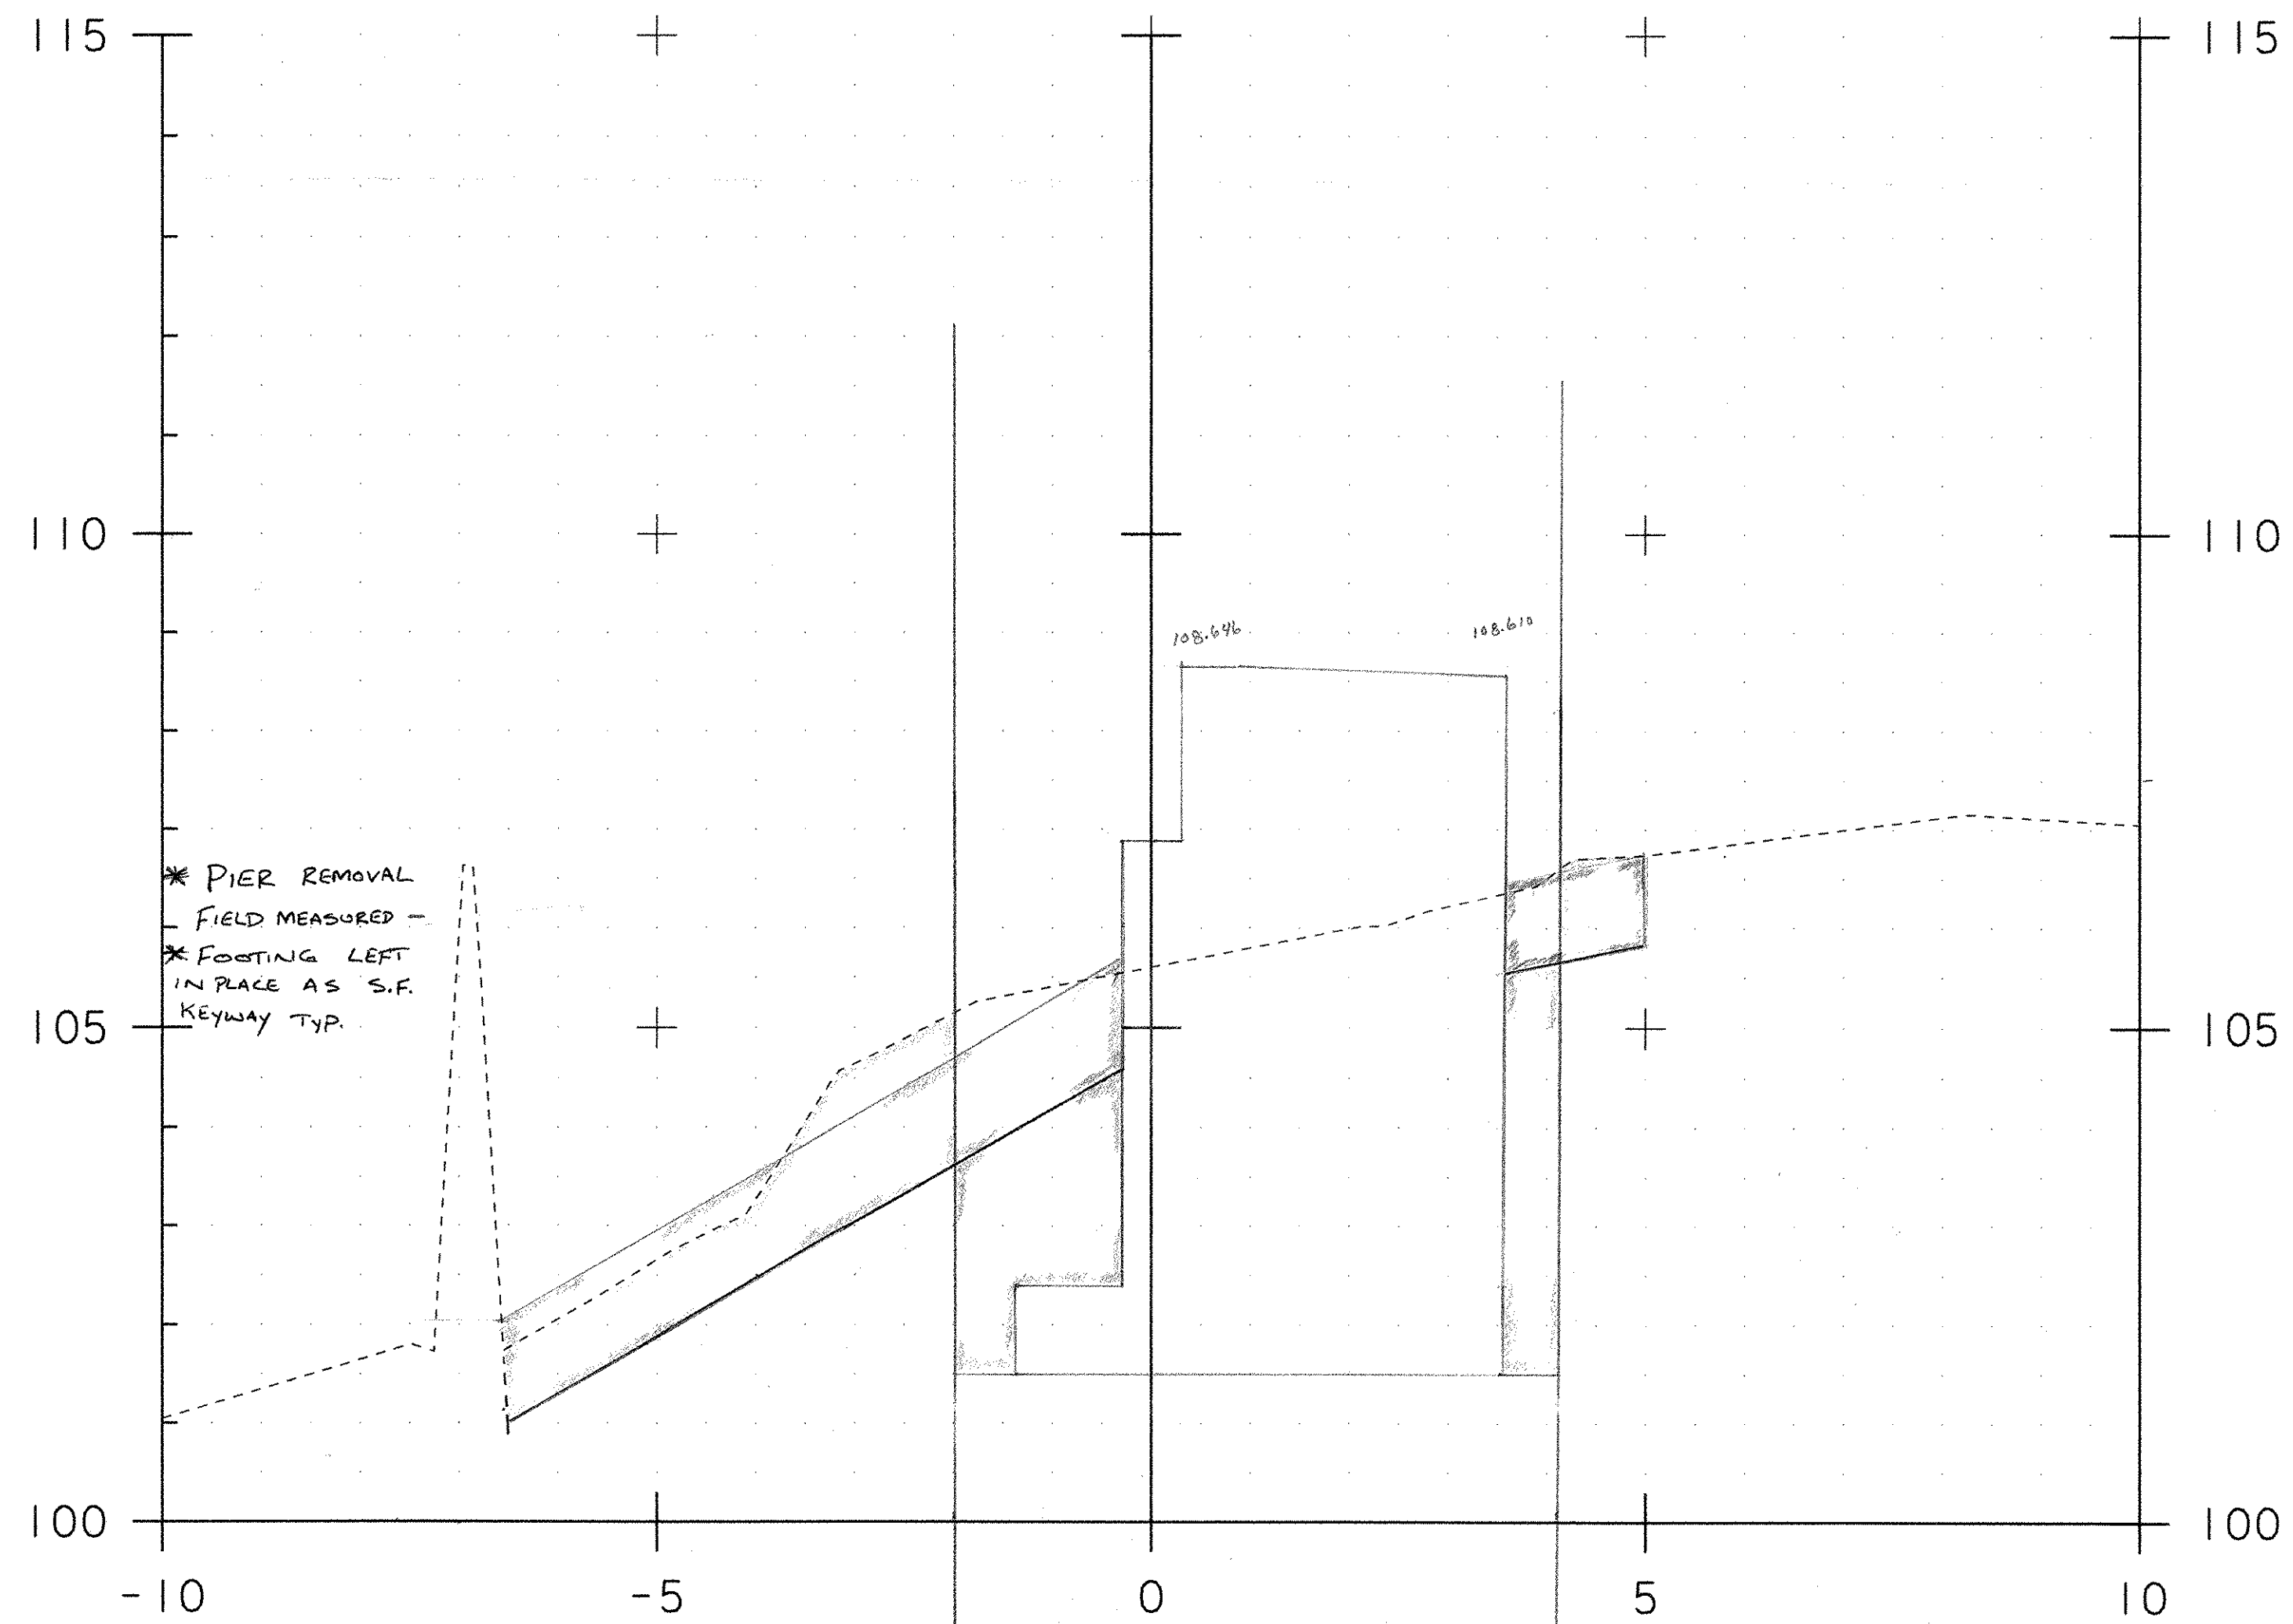


EXC- E+R = 26.46 m^2
 STONE FILL TYPE III - 8.15 m^3
 GRANULAR BACKFILL - 5.67 m^3
 GEO UNDER S.F - 8.5 M

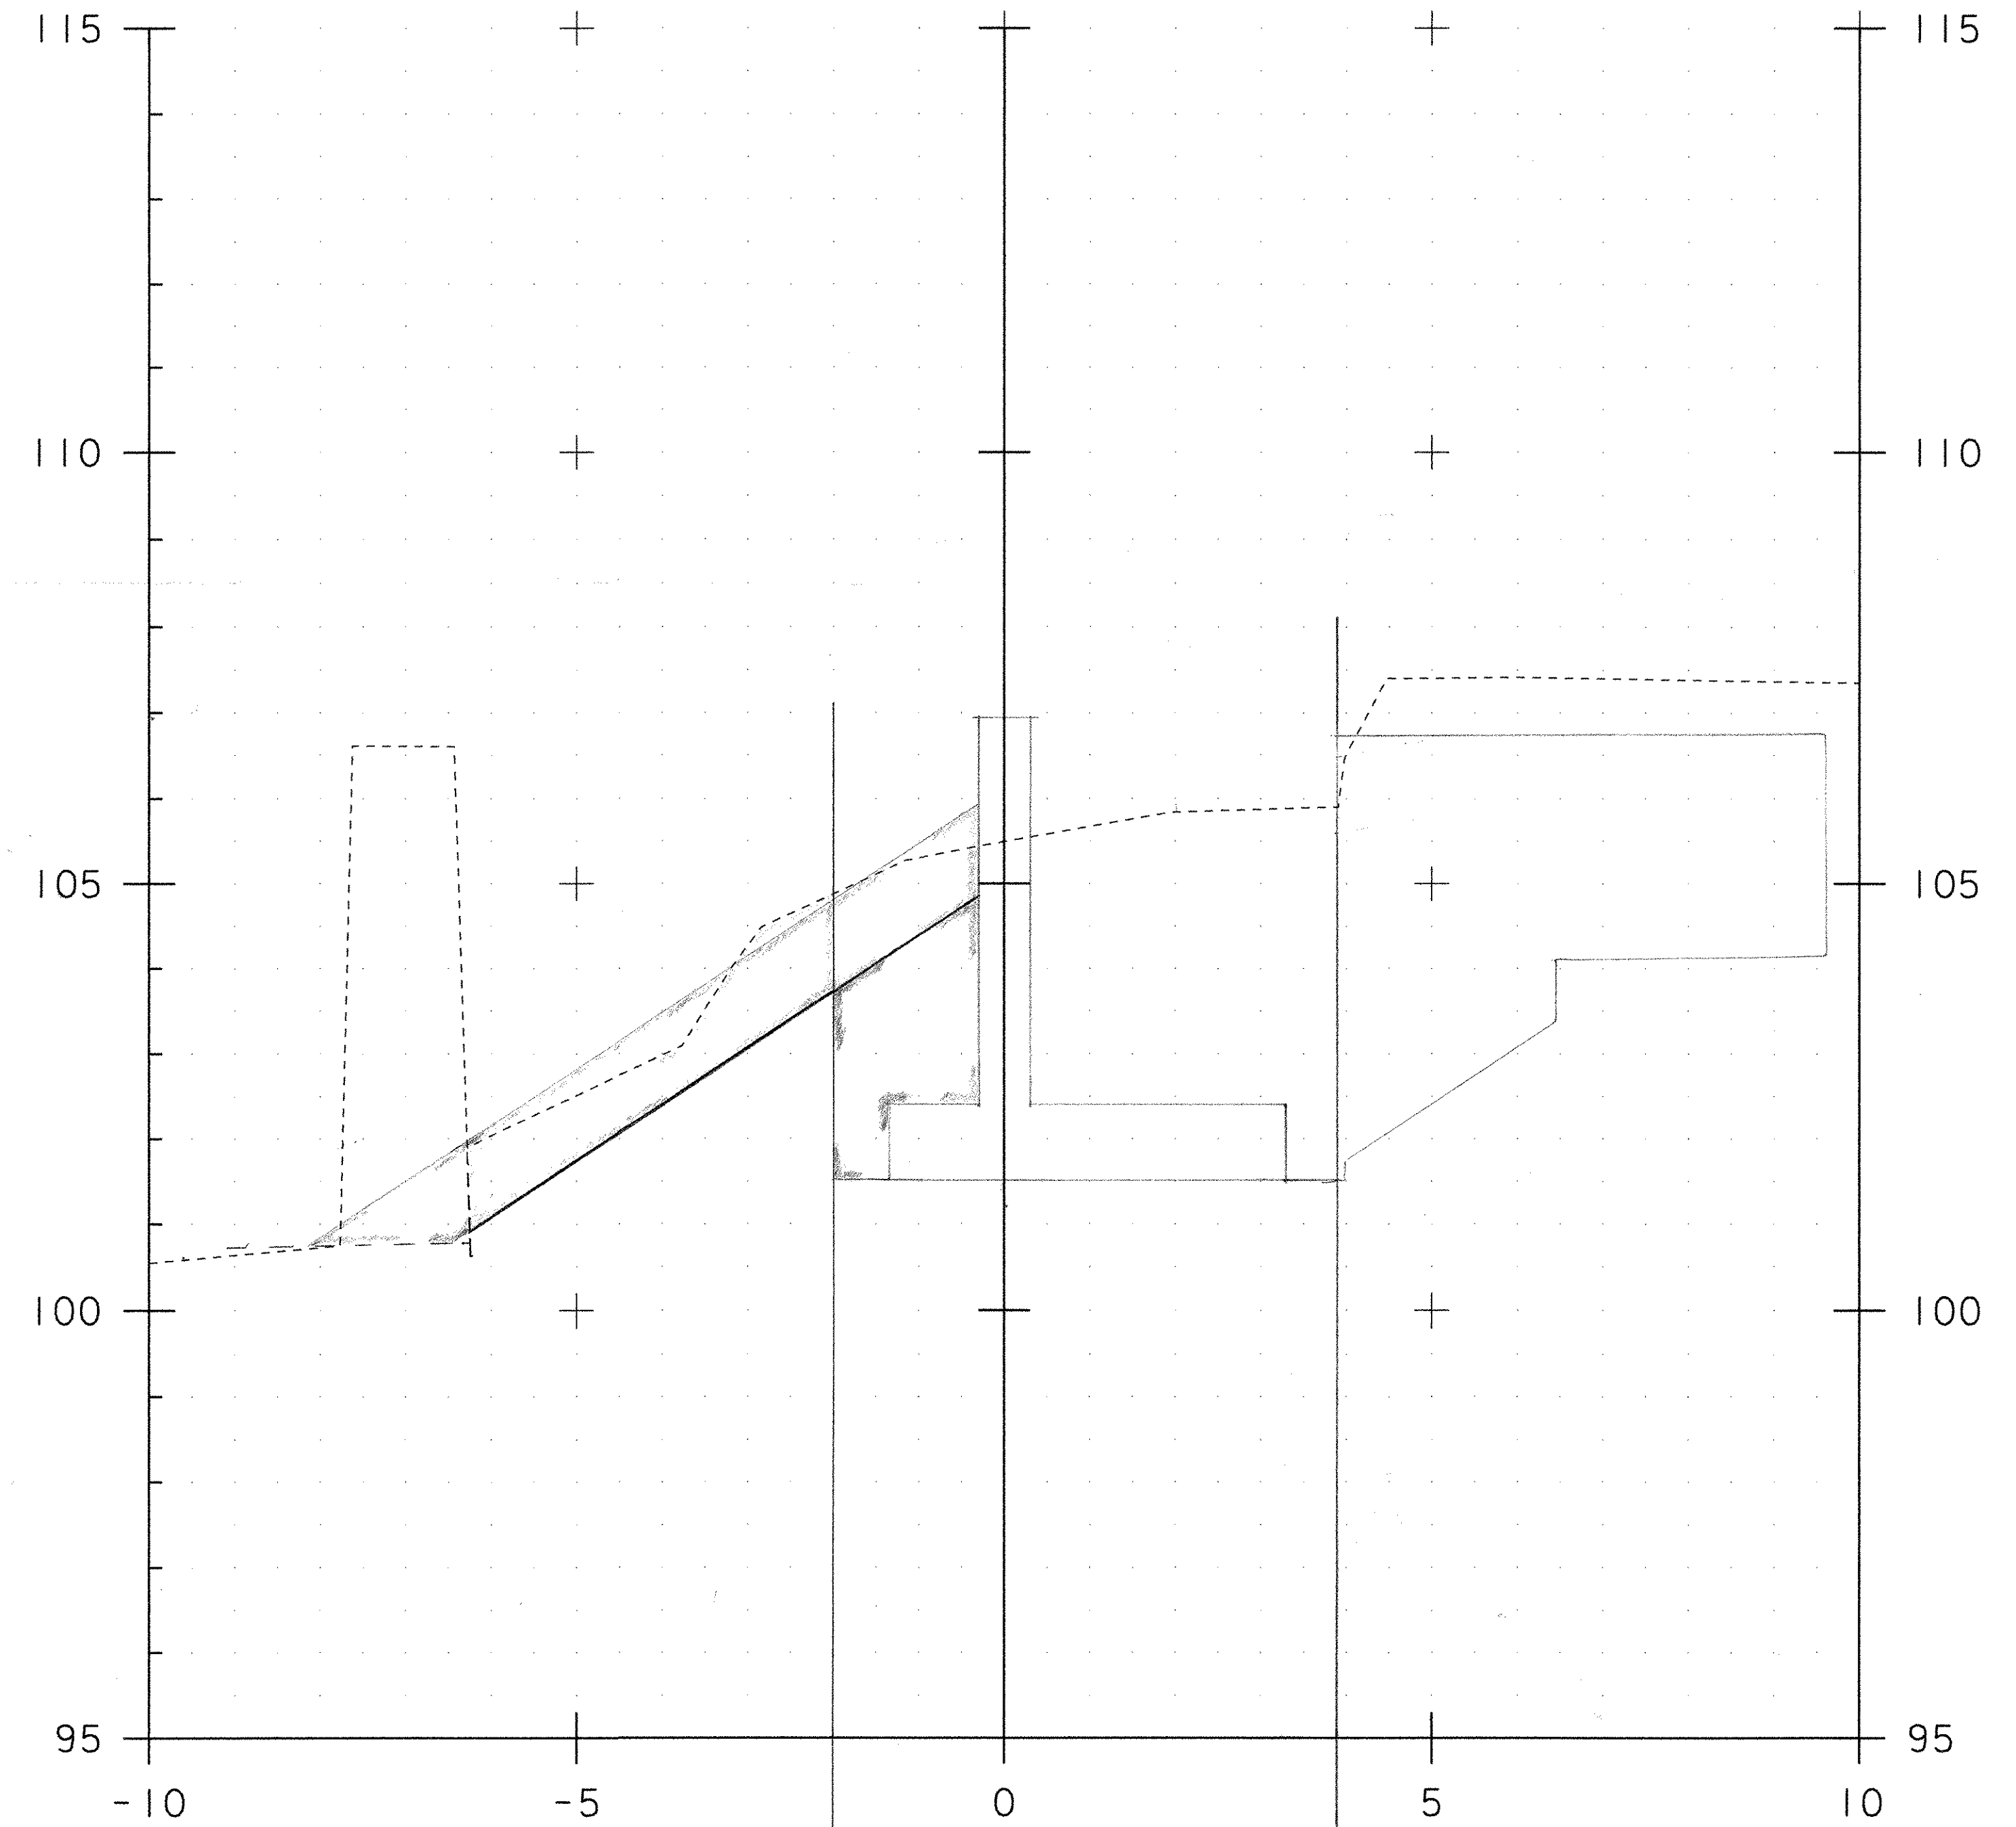

EXC- E+R = 24.11 m^2
 STONE FILL TYPE III - 7.45 m^3
 GRANULAR BACKFILL - 3.76 m^3
 GEO UNDER S.F - 7.1 M

PROJECT NAME:	Leicester	PLOT DATE:	01-NOV-2005
PROJECT NUMBER:	BRF 0160(3)S	DRAWN BY:	R. Bullock
FILE NAME:		CHECKED BY:	
PROJECT LEADER:		SHEET 3	OF 7
DESIGNED BY:			


117
 ABZ

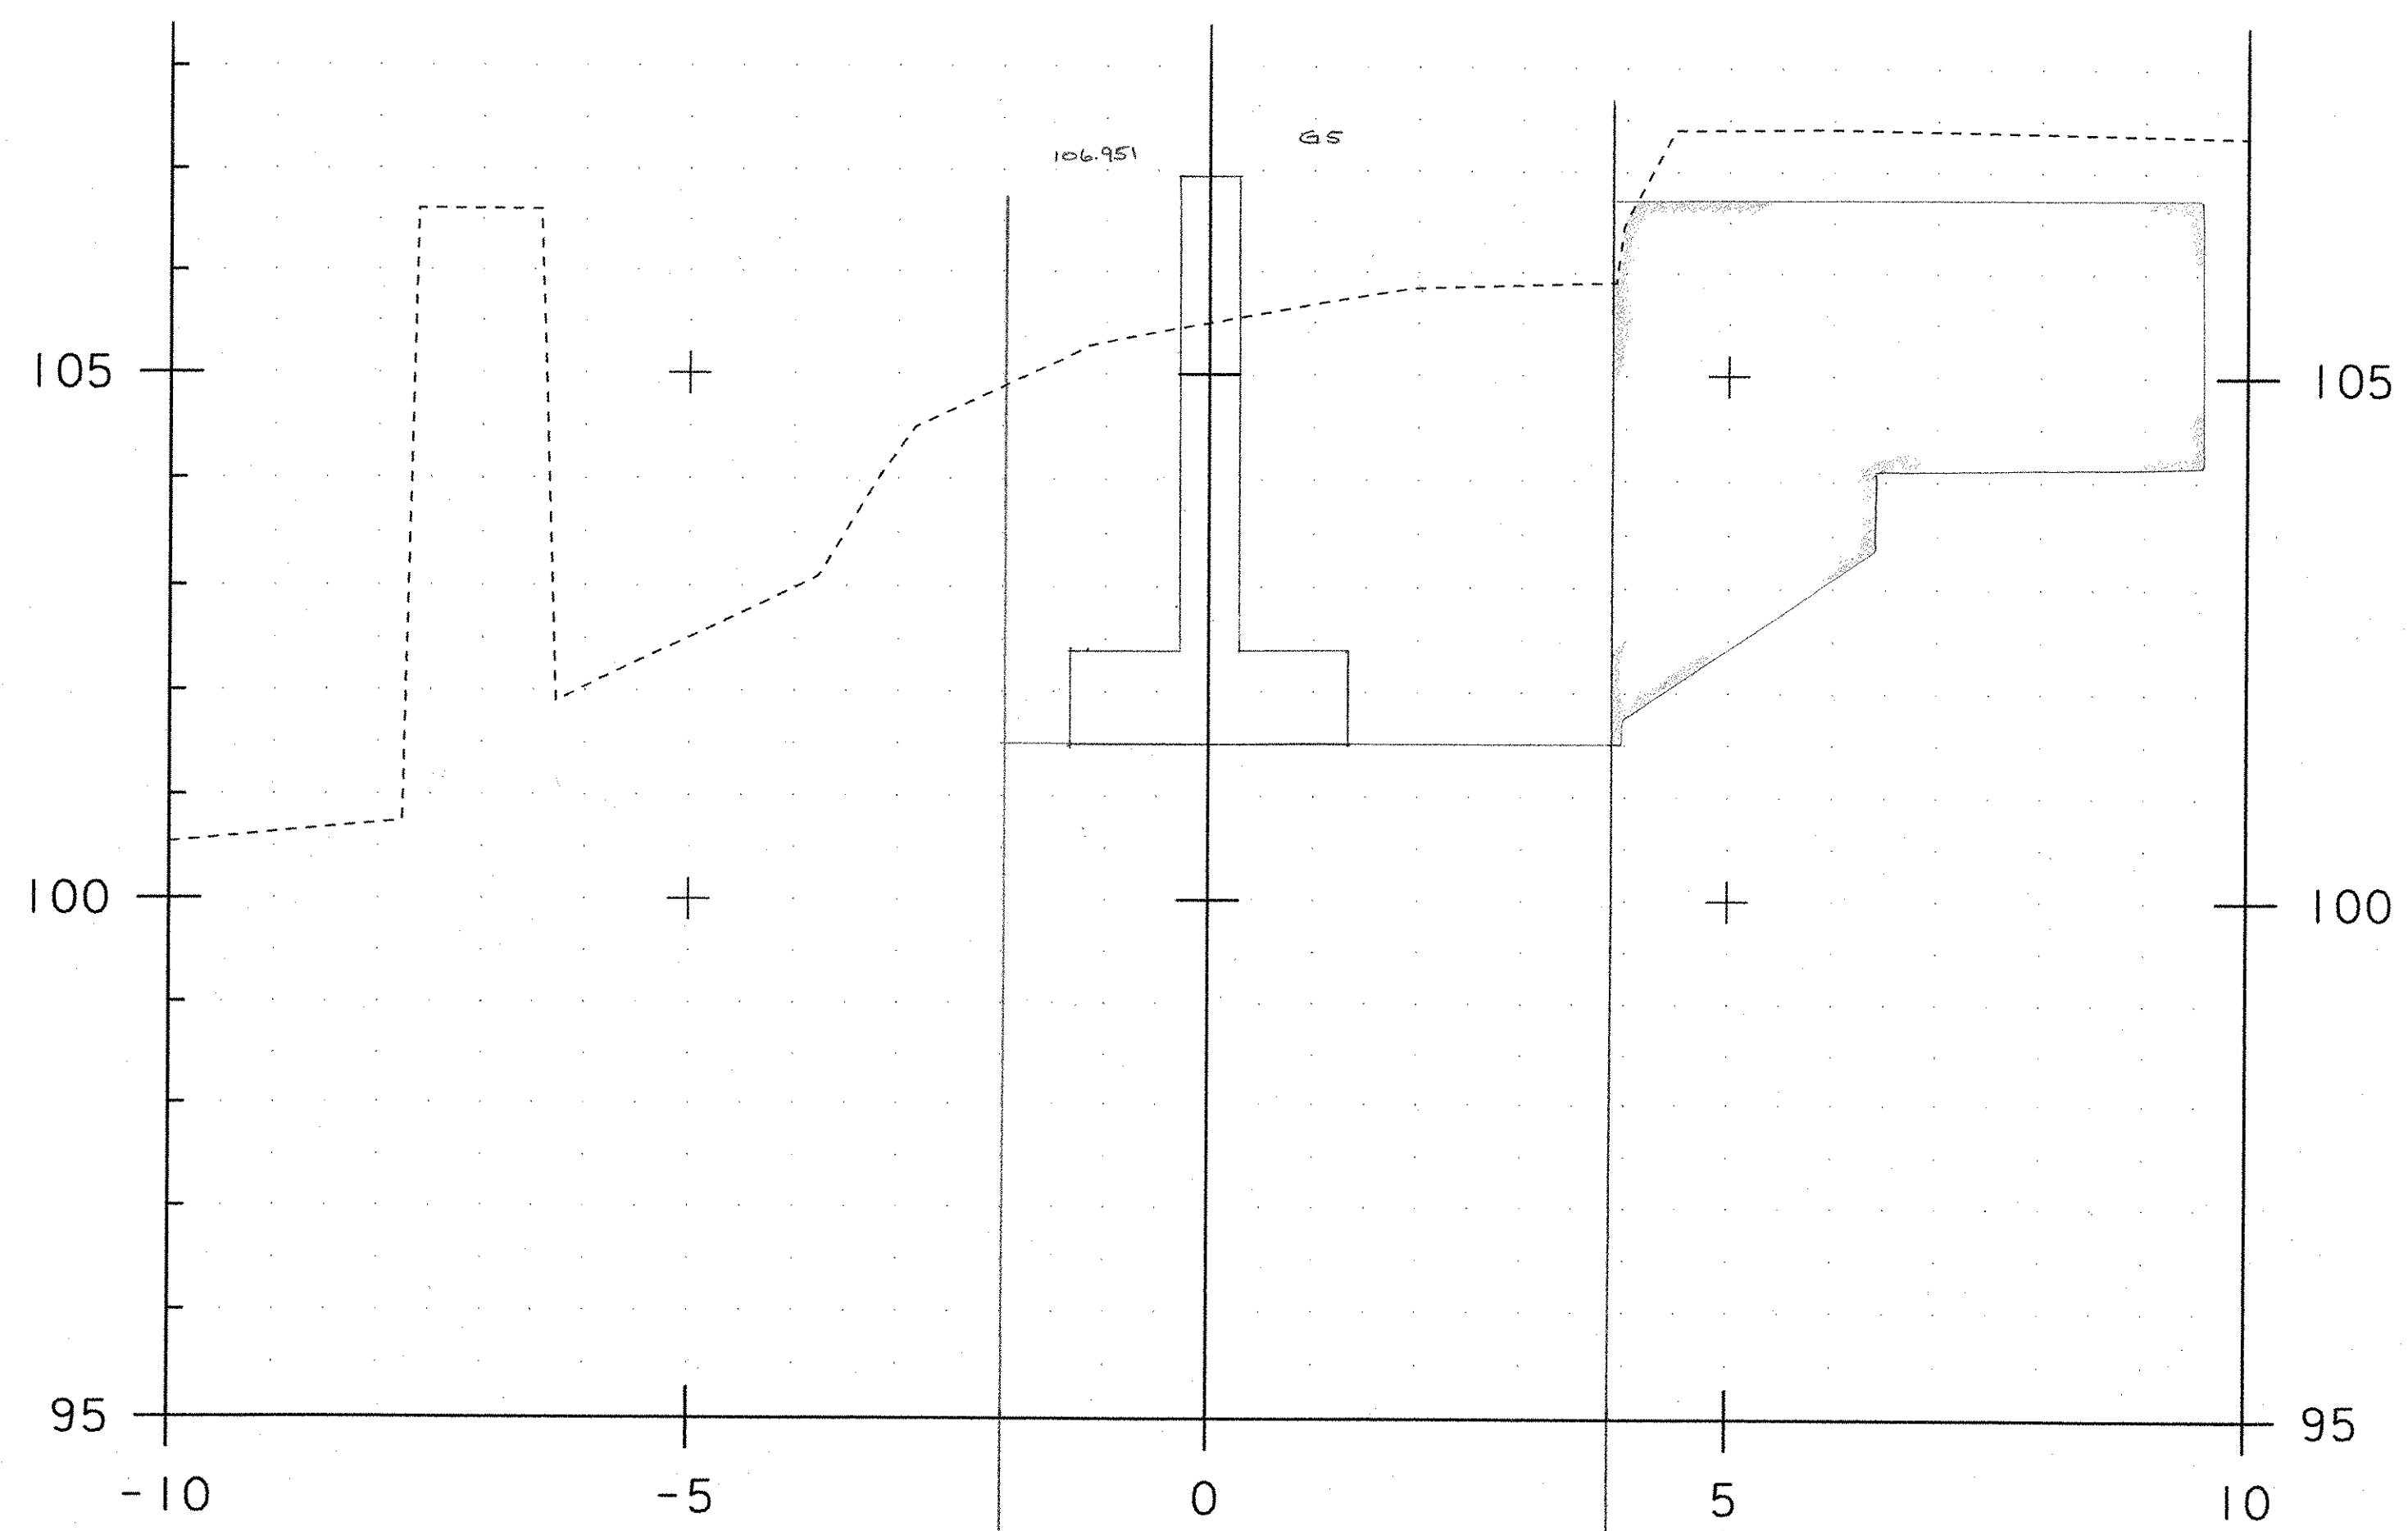


$Exc - E + R = 24.01 m^2$
 (Exc) Structure Exc. = 12.72 m²
 9/24
 4/11/02

9+996.60

COFFERDAM FULL WIDTH 11B/32
 BACK STATION & STRUCTURE EXC.

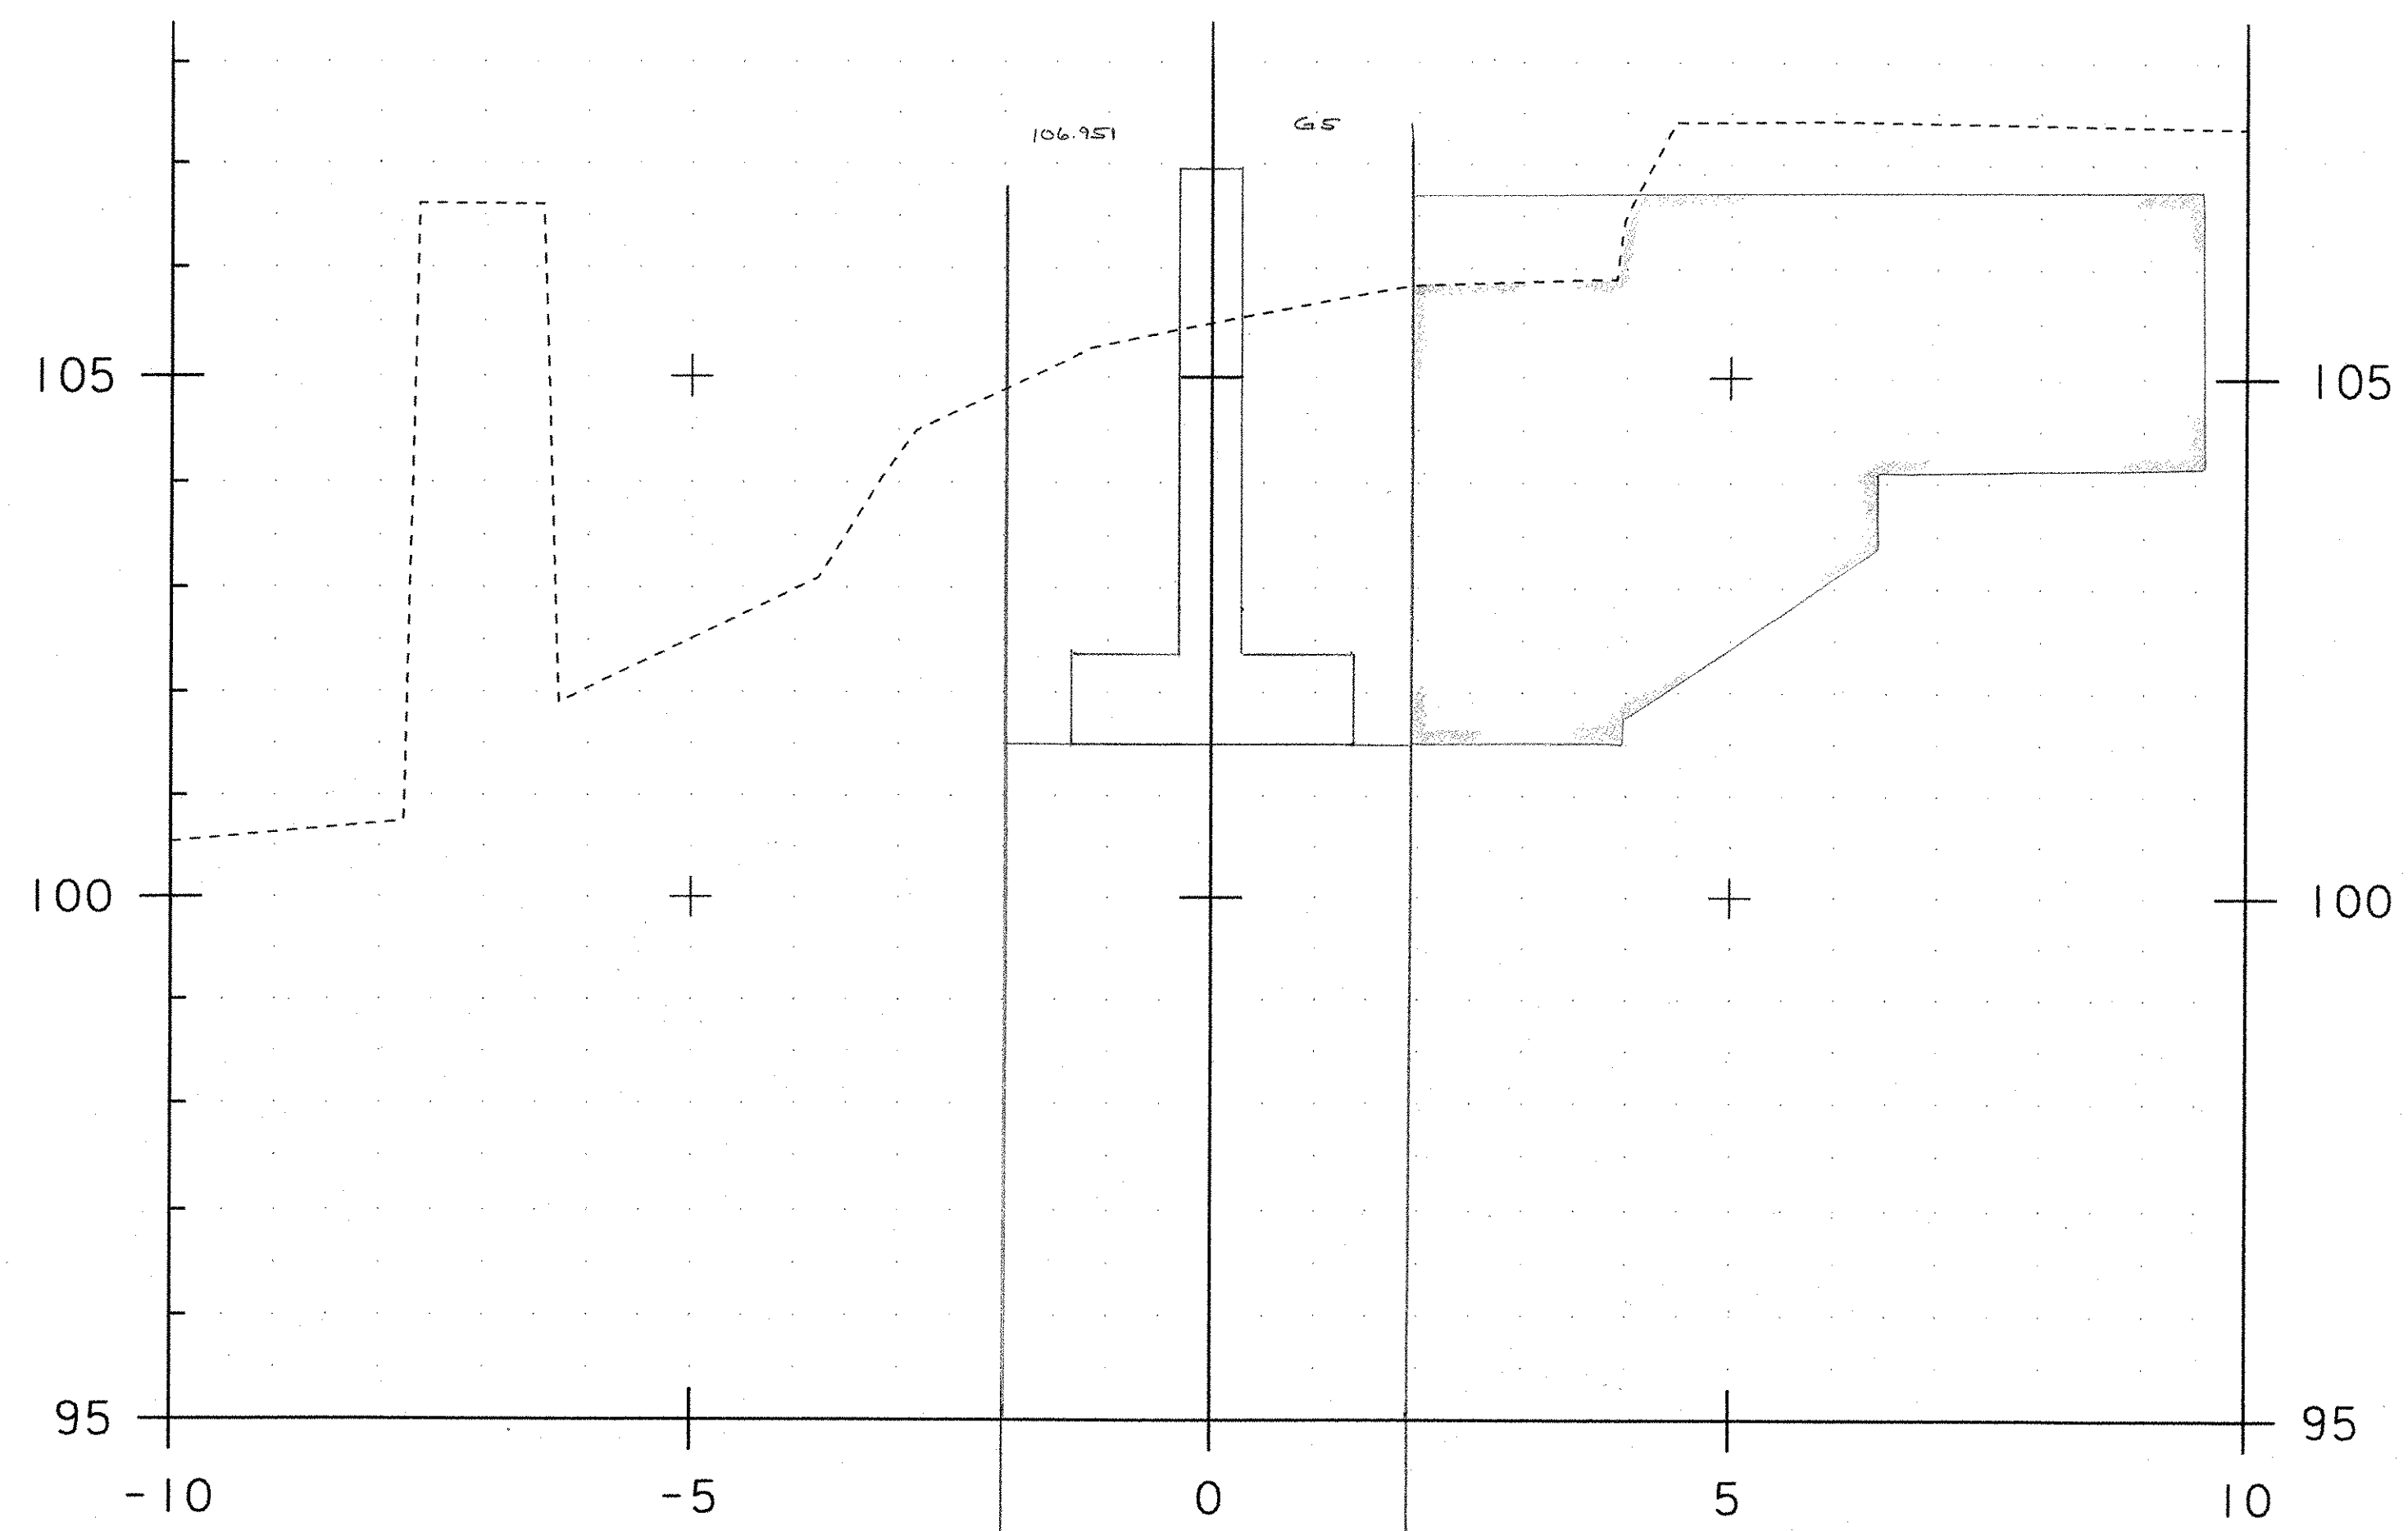


EXC - E+R = $\frac{15.67m^2}{9109}$
 STRUCTURE EXC = 23.51m²
 9+996.60
 COFFERDAM - ABUT ONLY
 FORWARD STATION
 STRUCTURE EXC.
 119ABZ

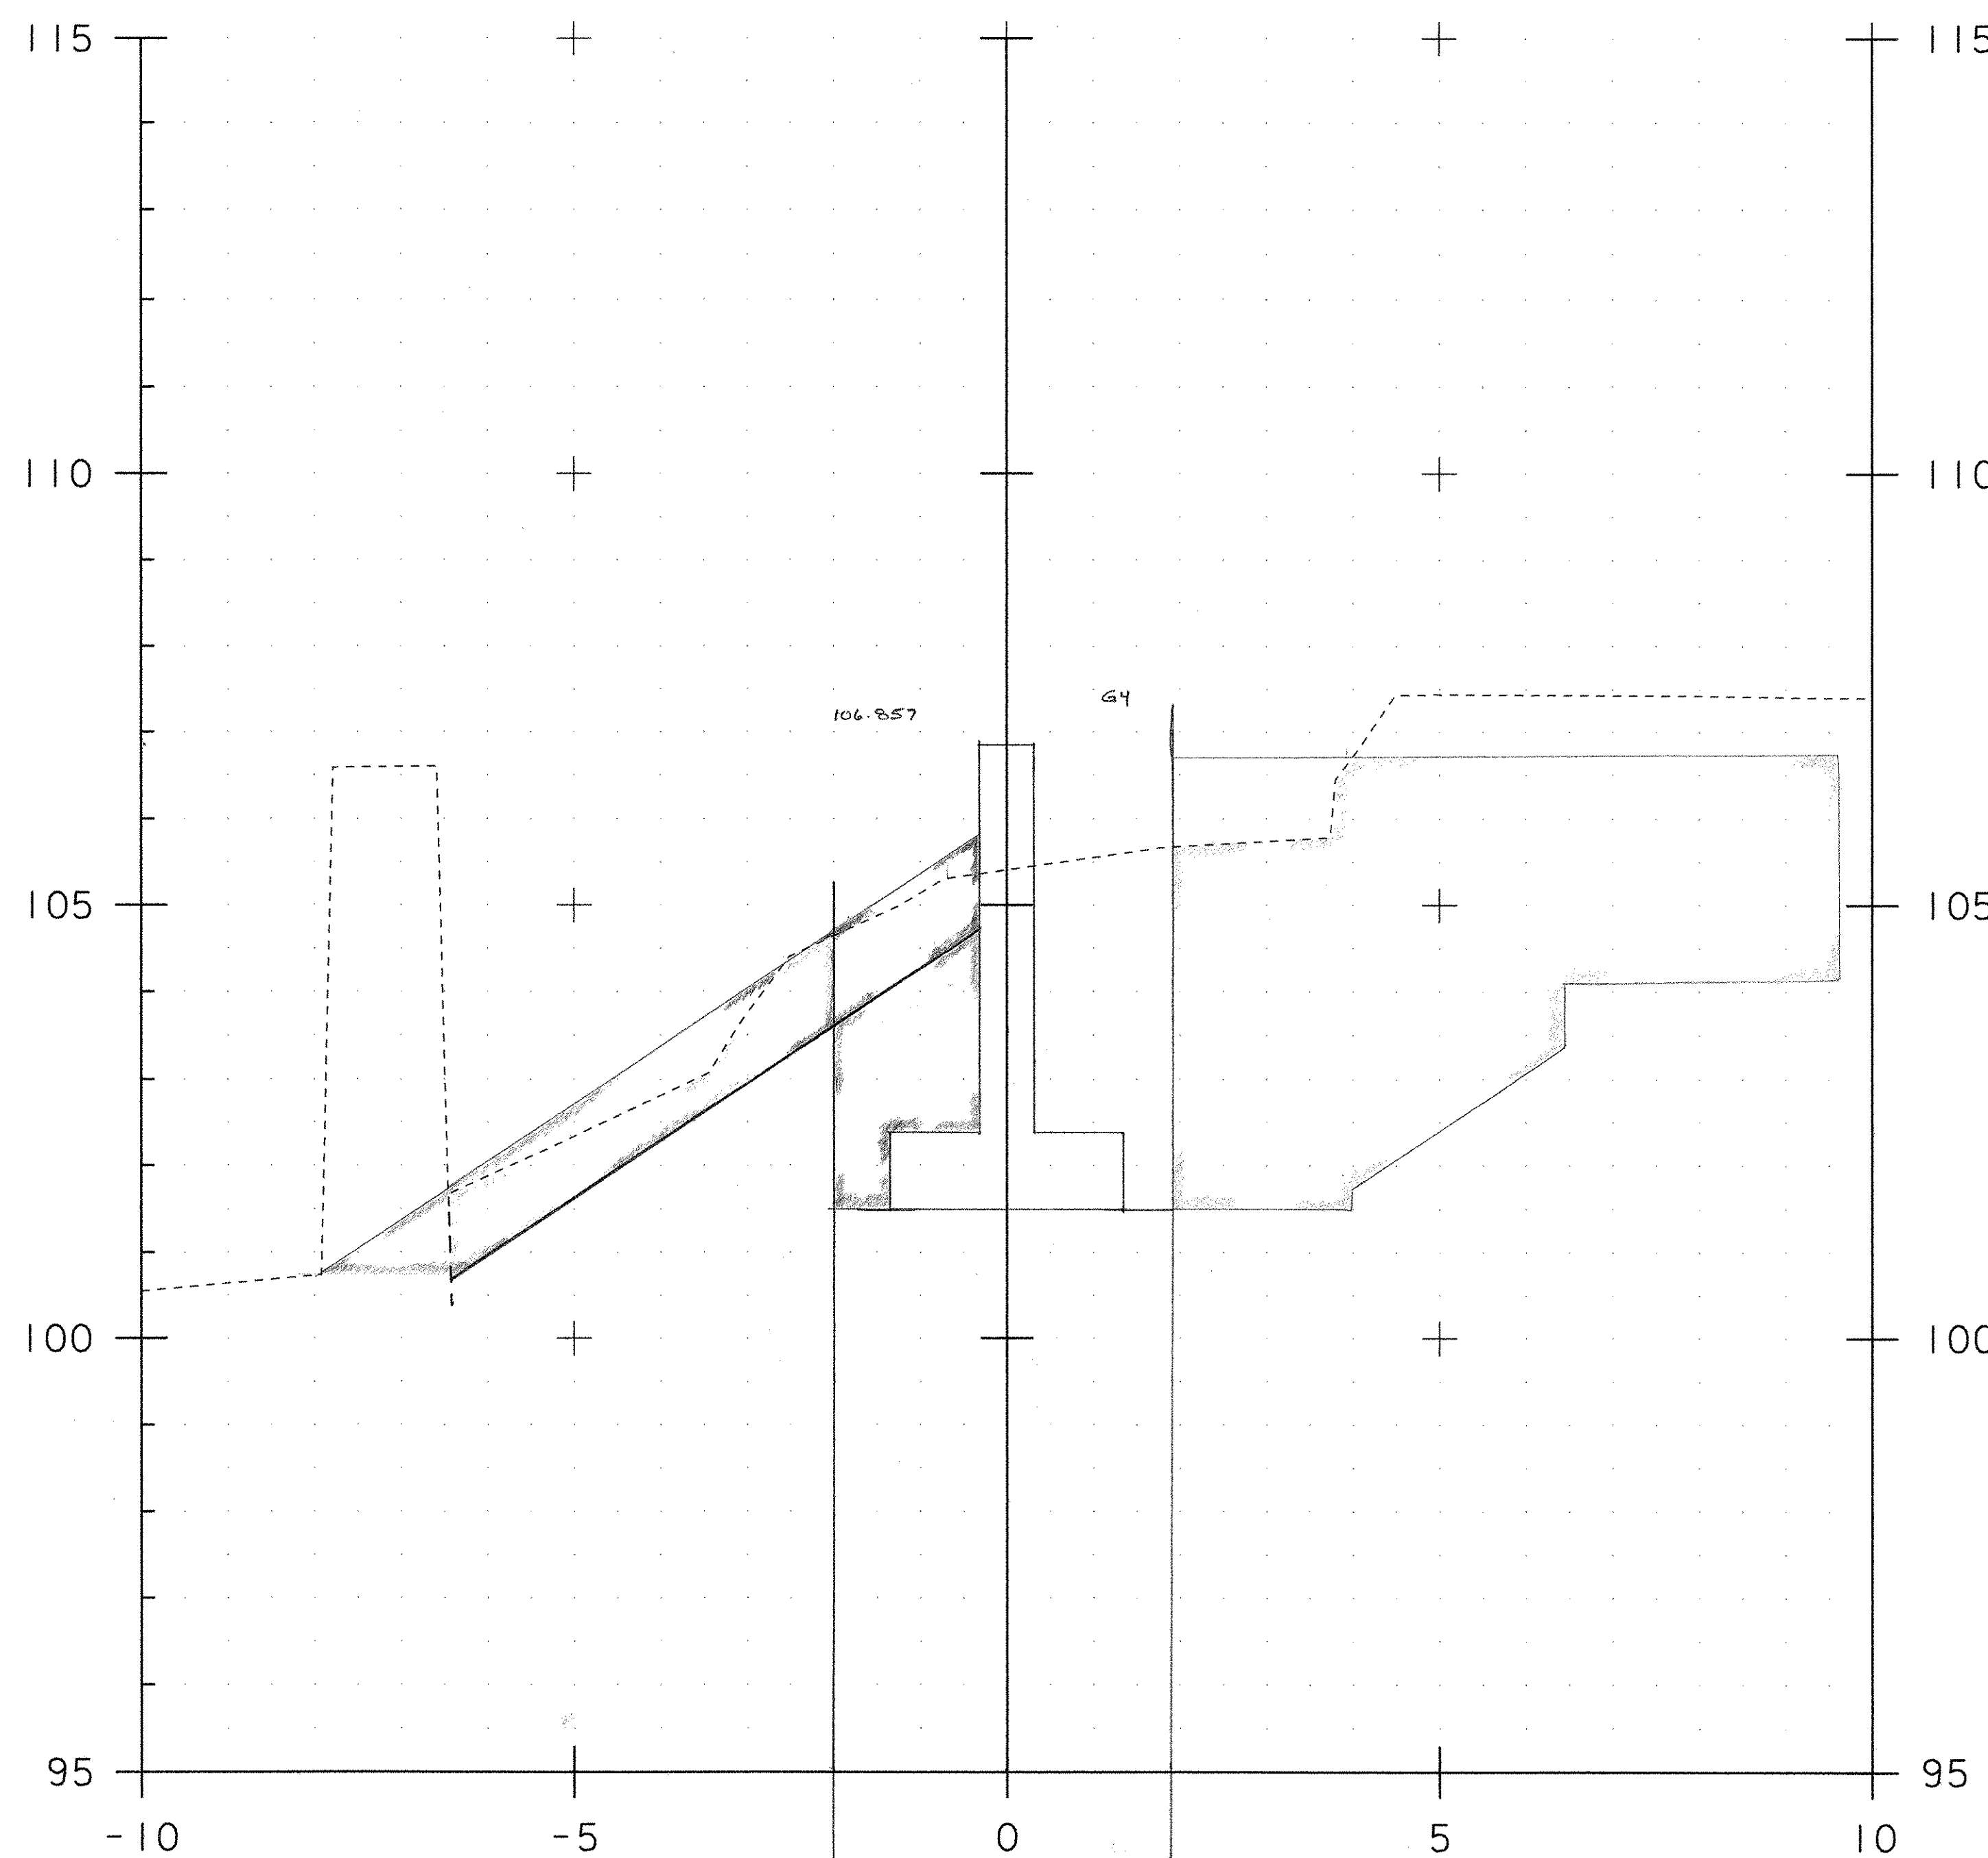

EXC - E+R = 15.12 m² *2/1/05* *1/2/05*
 9+998.00


STONE FILL TYPE III - 7.16 m³
 LIME STONE FILL - 3.97 m³
 GRANULAR BACKFILL - 3.58 m³
 GEO UNDER S.F - 7.3 M
 STRUCTURE EXC - 27.26 m³

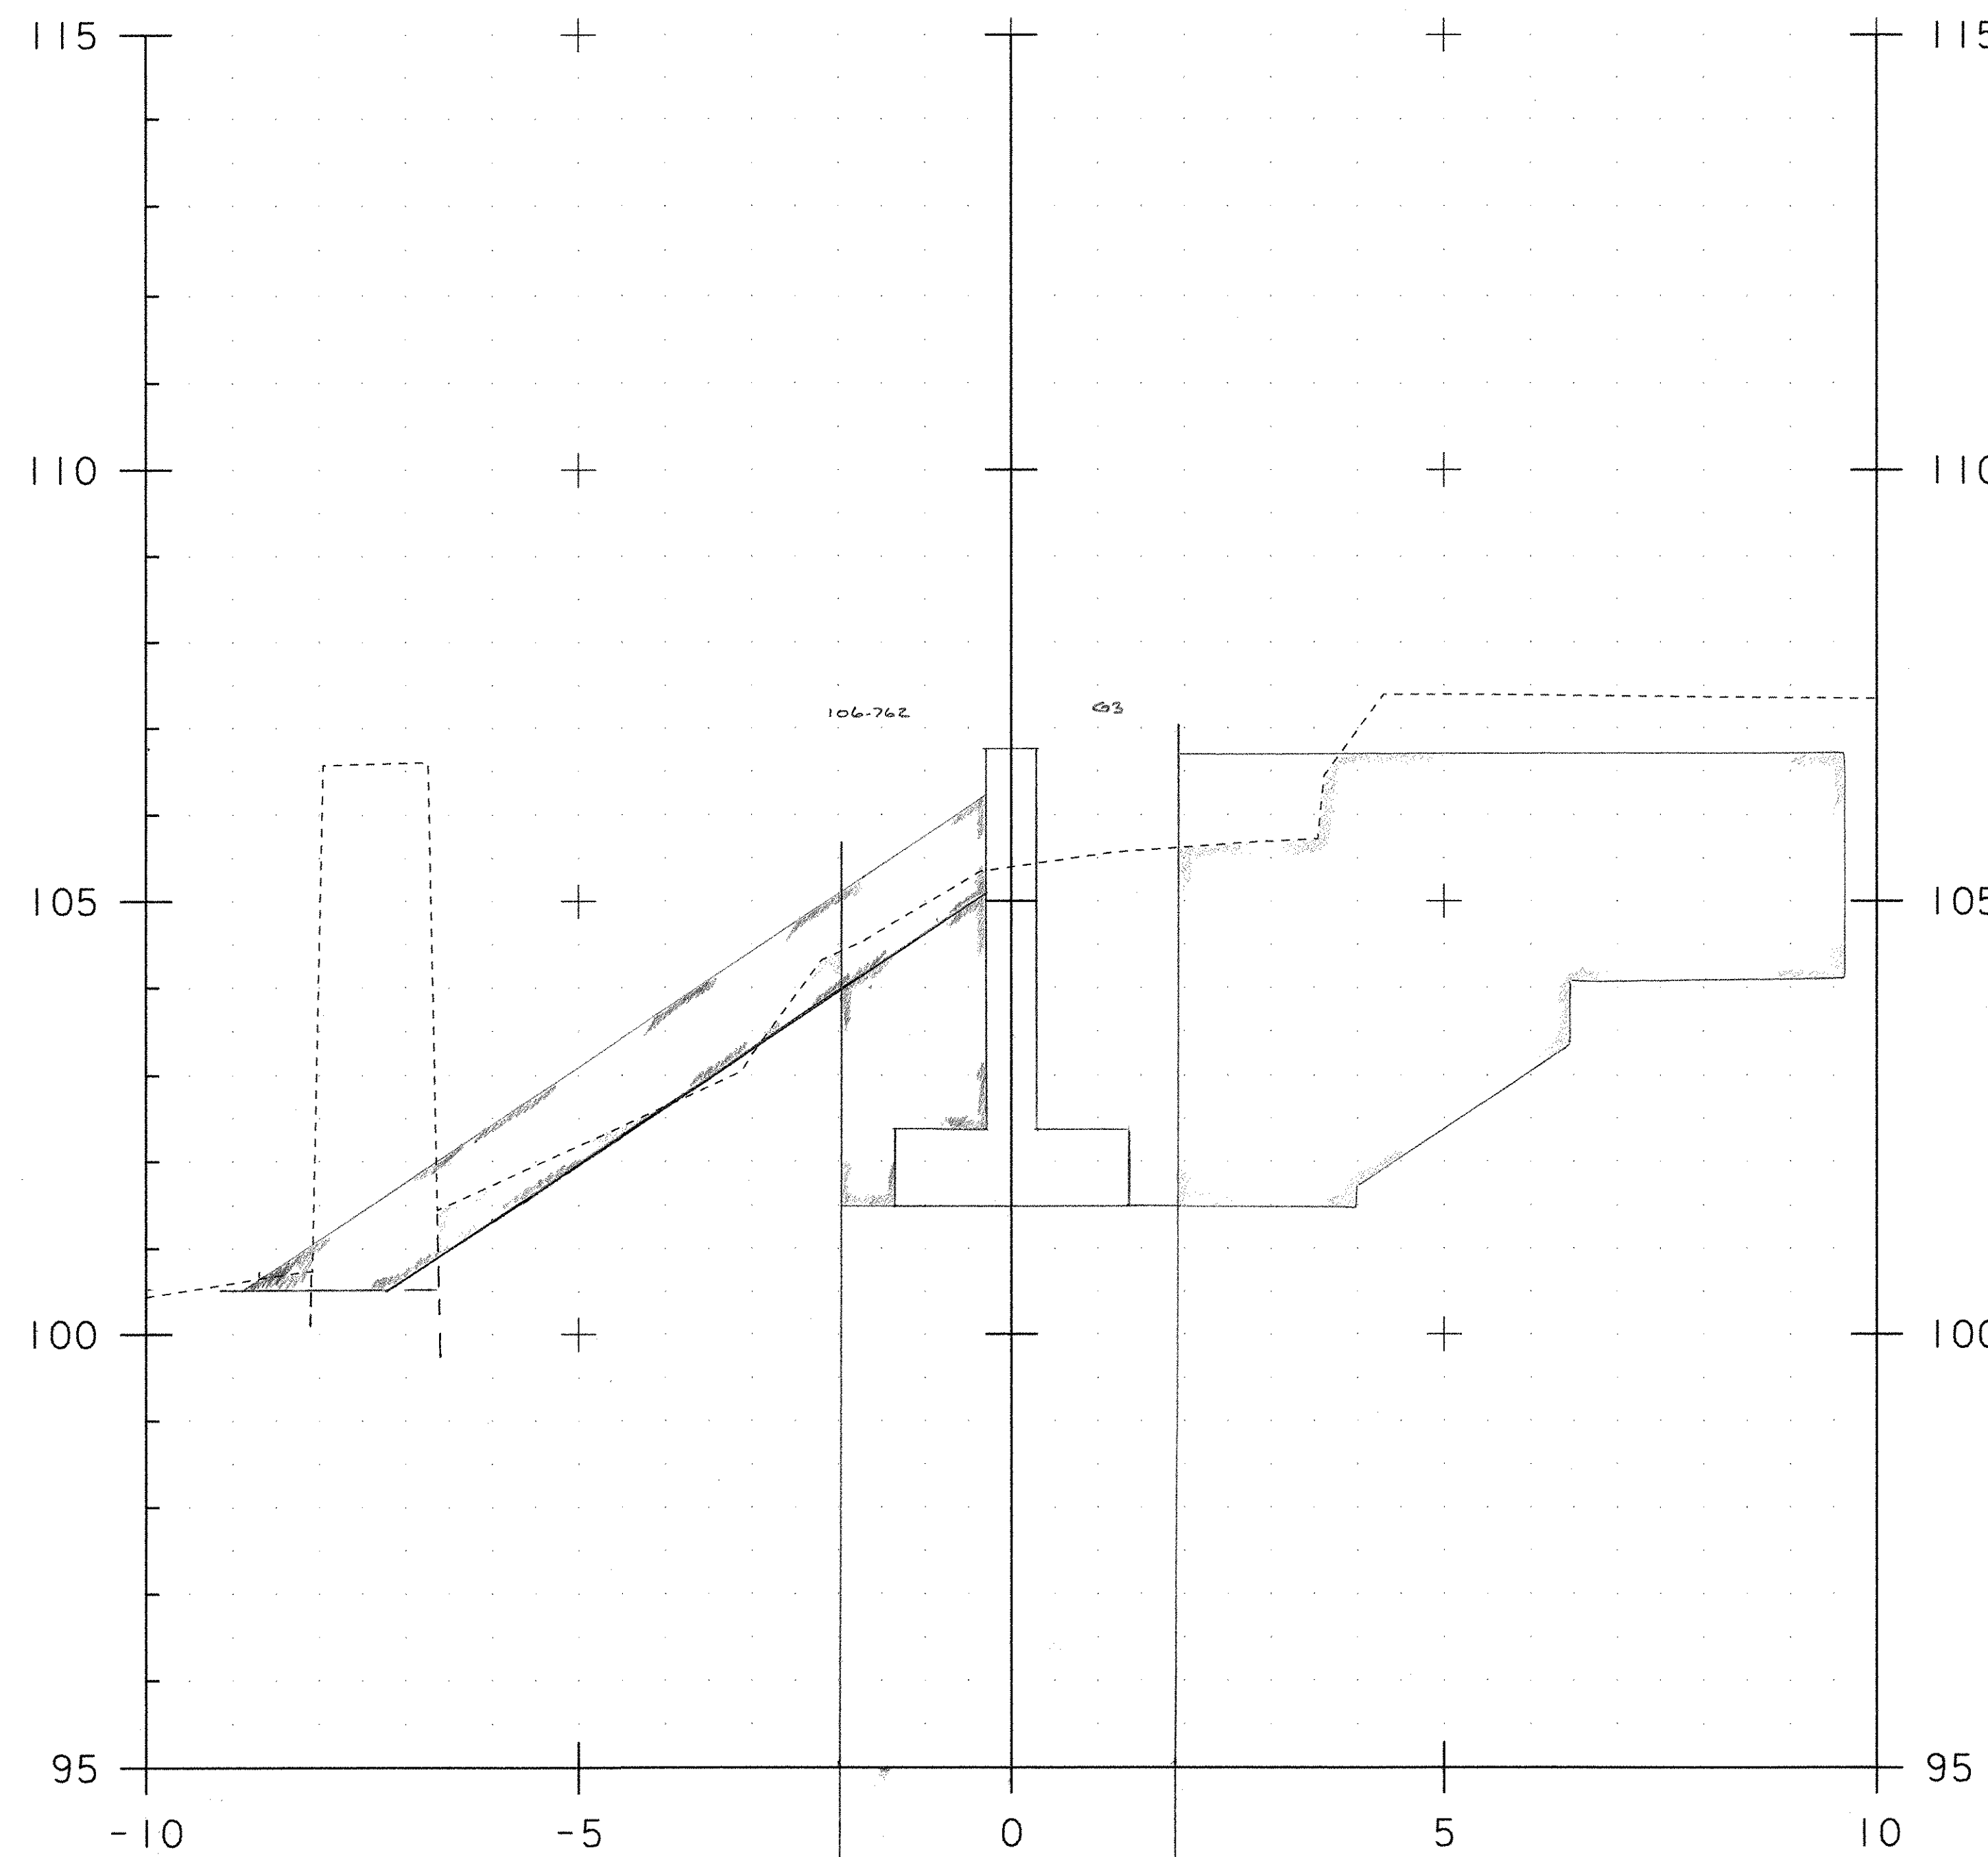

EXC - E+R = 14.64 m² *2/1/05* *1/2/05*
 10+000.00

STONE FILL TYPE III - 8.64 m³
 LIME STONE FILL - 4.0 m³
 GRANULAR BACKFILL - 4.09 m³
 GEO UNDER S.F - 8.3 M
 STRUCTURE EXC - 27.51 m³

PROJECT NAME:	Leicester	PLOT DATE:	01-NOV-2005
PROJECT NUMBER:	BRF 0160(3)S	DRAWN BY:	R. Bullock
FILE NAME:		CHECKED BY:	
PROJECT LEADER:		SHEET 4	OF 7
DESIGNED BY:	<i>120 ABZ</i>		

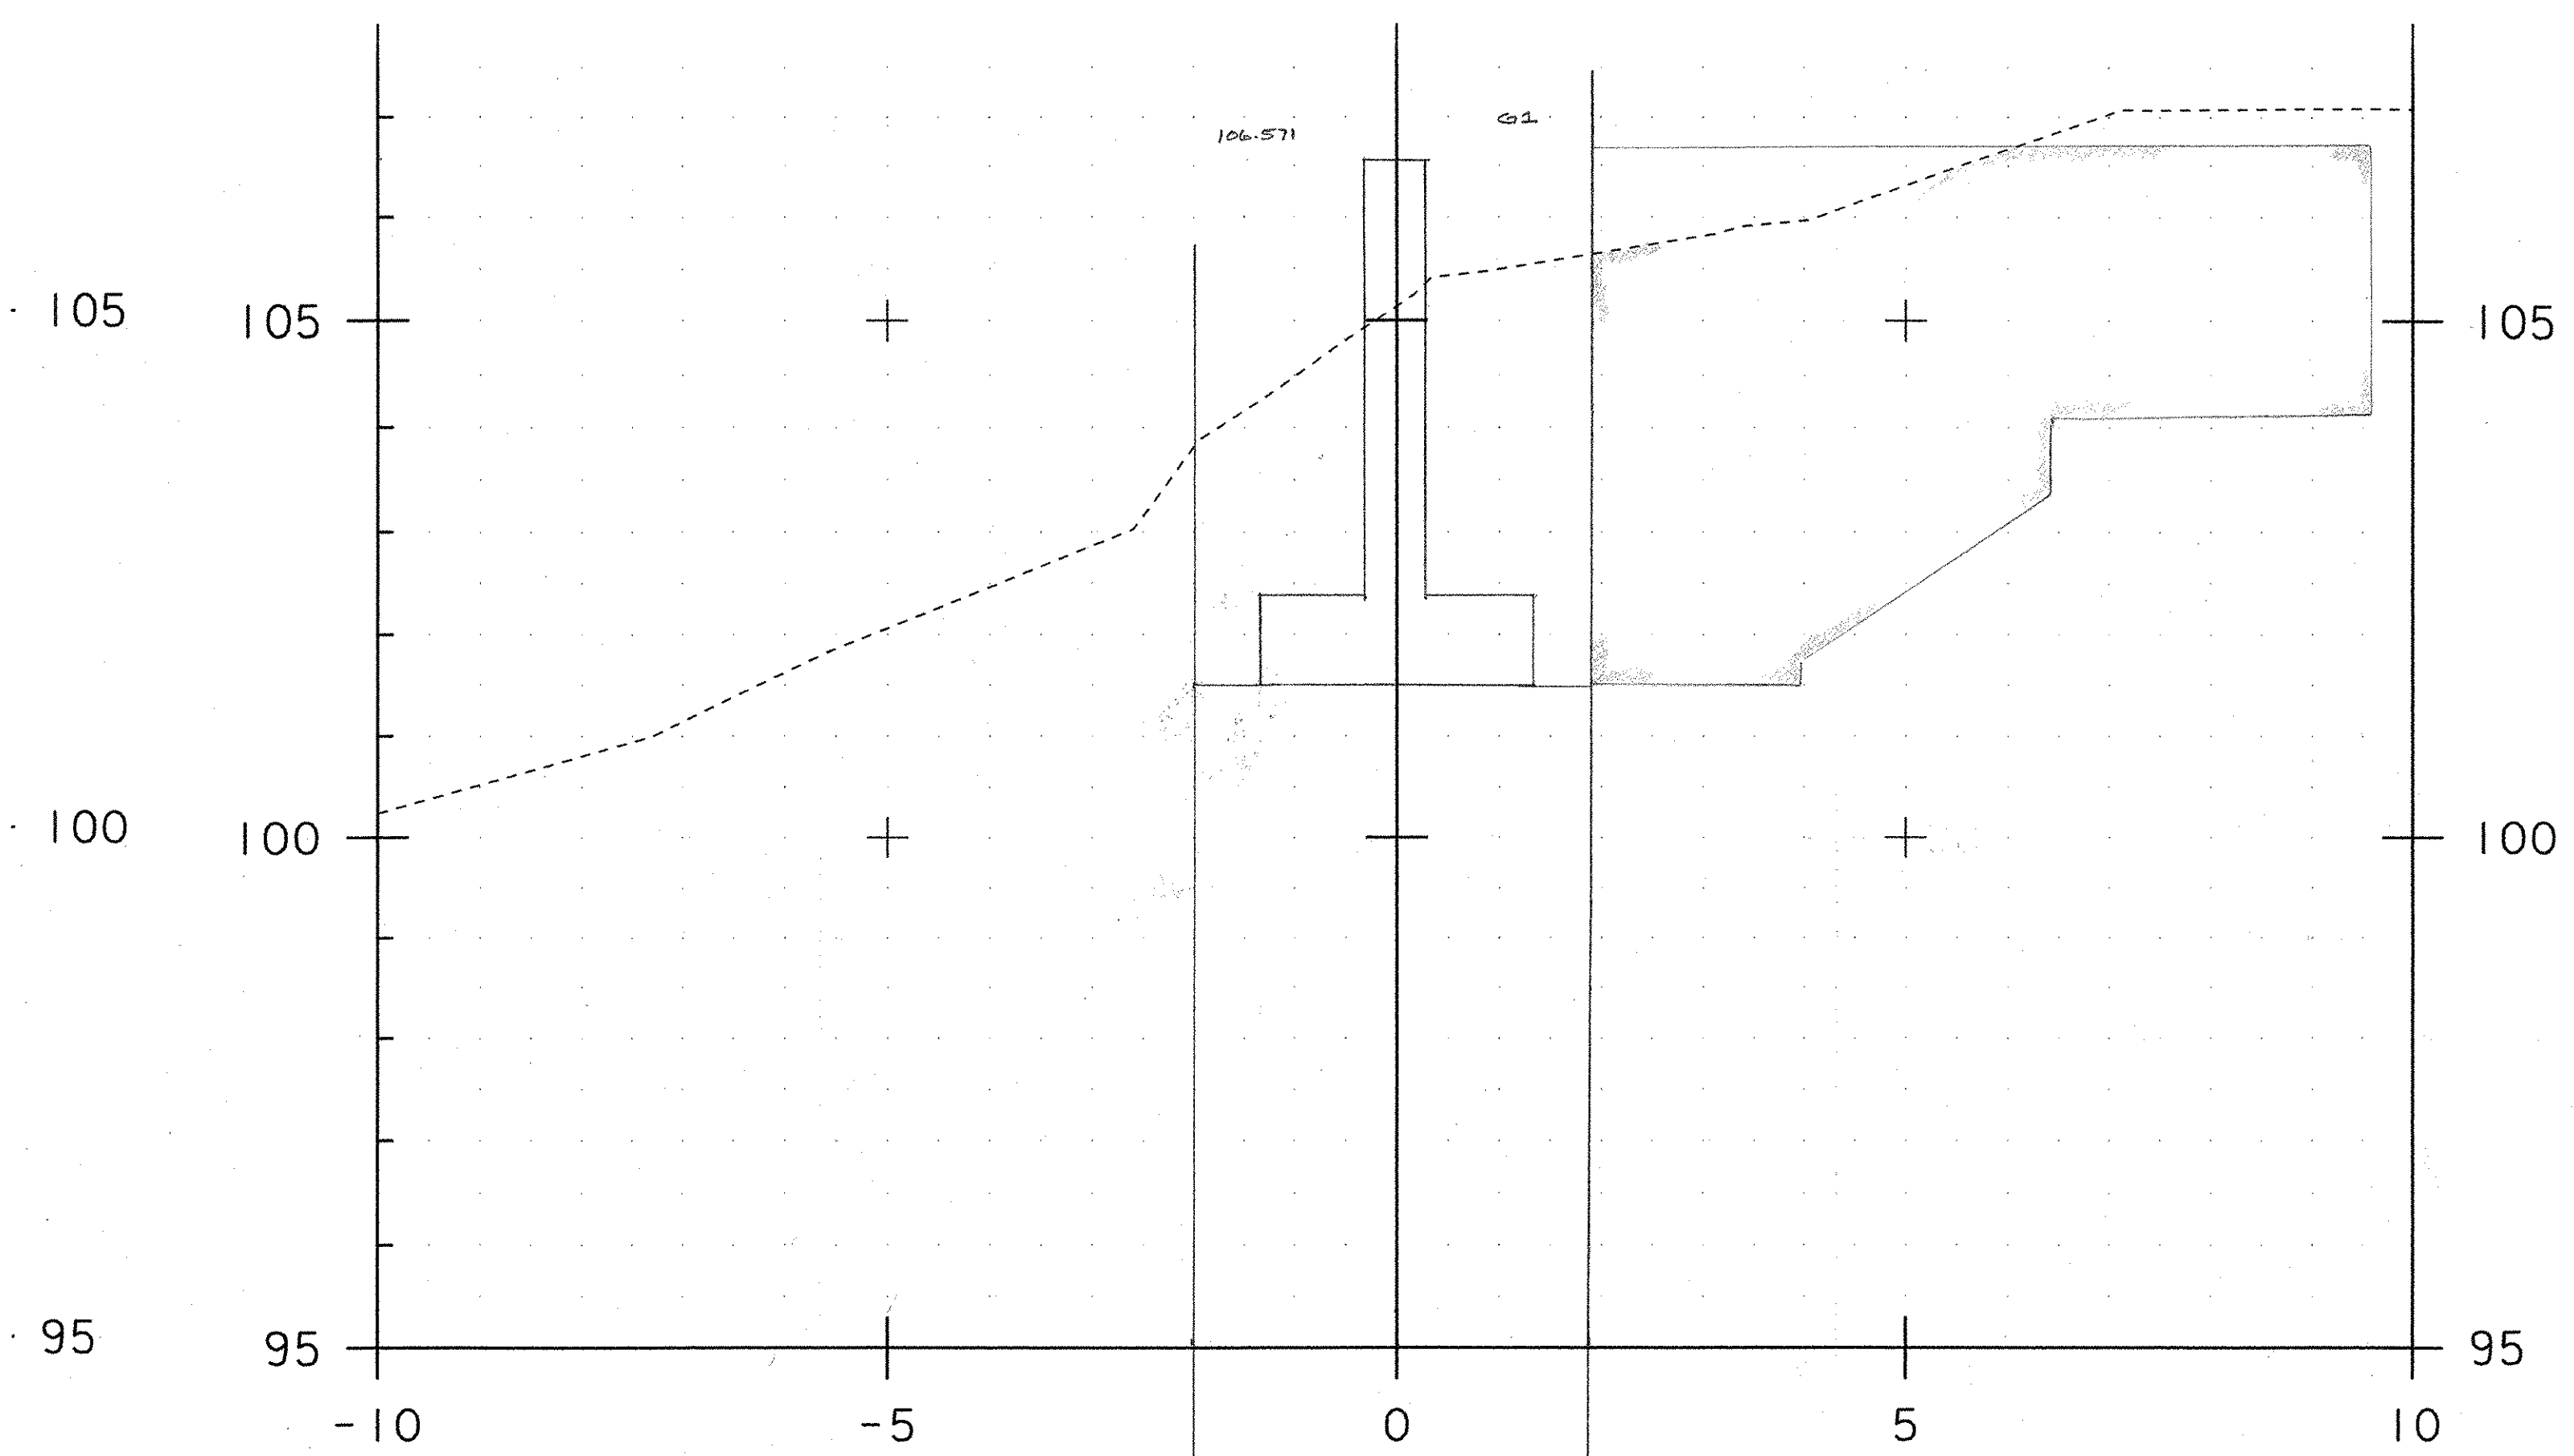


Exc - E+R = 13.78 m²

STRUCTURE Exc = 26.66 m²

10+003.70


LAST ABUTMENT WIDTH (ABUT ONLY) & STRUCTURE EXC.

121A62

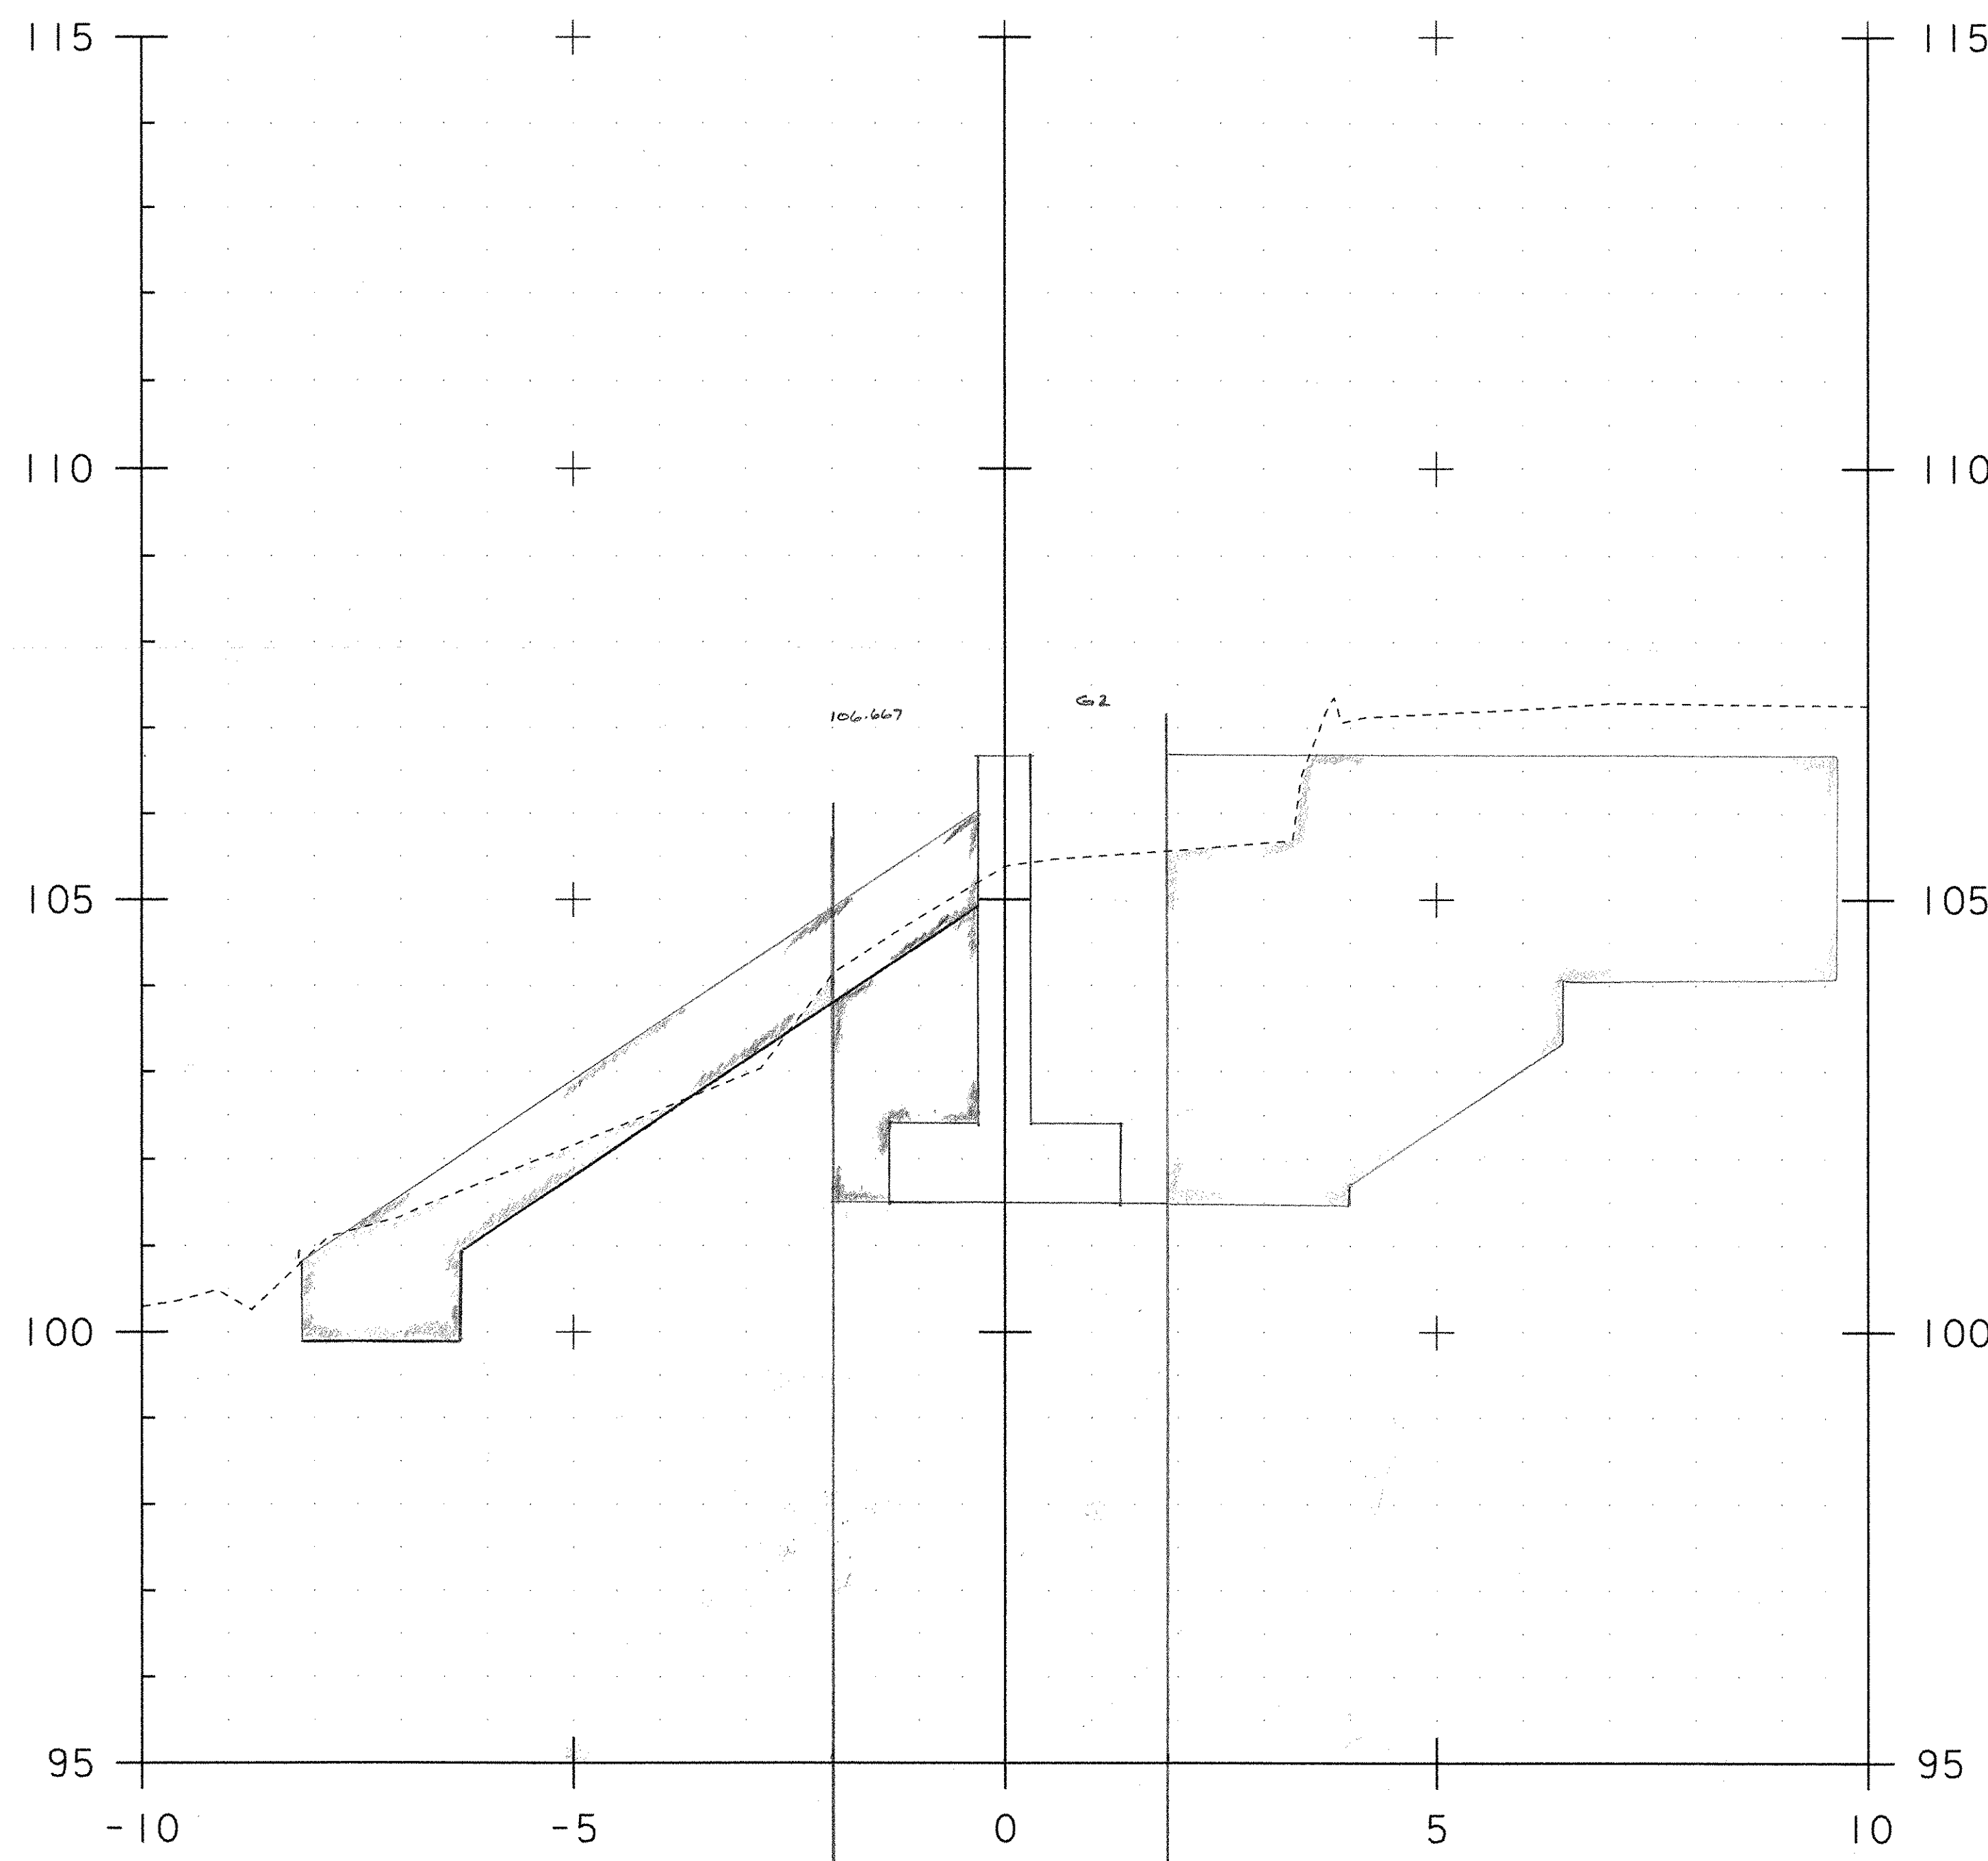

Exc - E+R = 14.05 m^2 *old*
 STONE FILL TYPE III = 7.39 m^2
 SAND BACKFILL = 3.73 m^2
 GEO UNDER S.F = 10.0 m
 STRUCTURE EX = 27.59 m^2

10+002.00

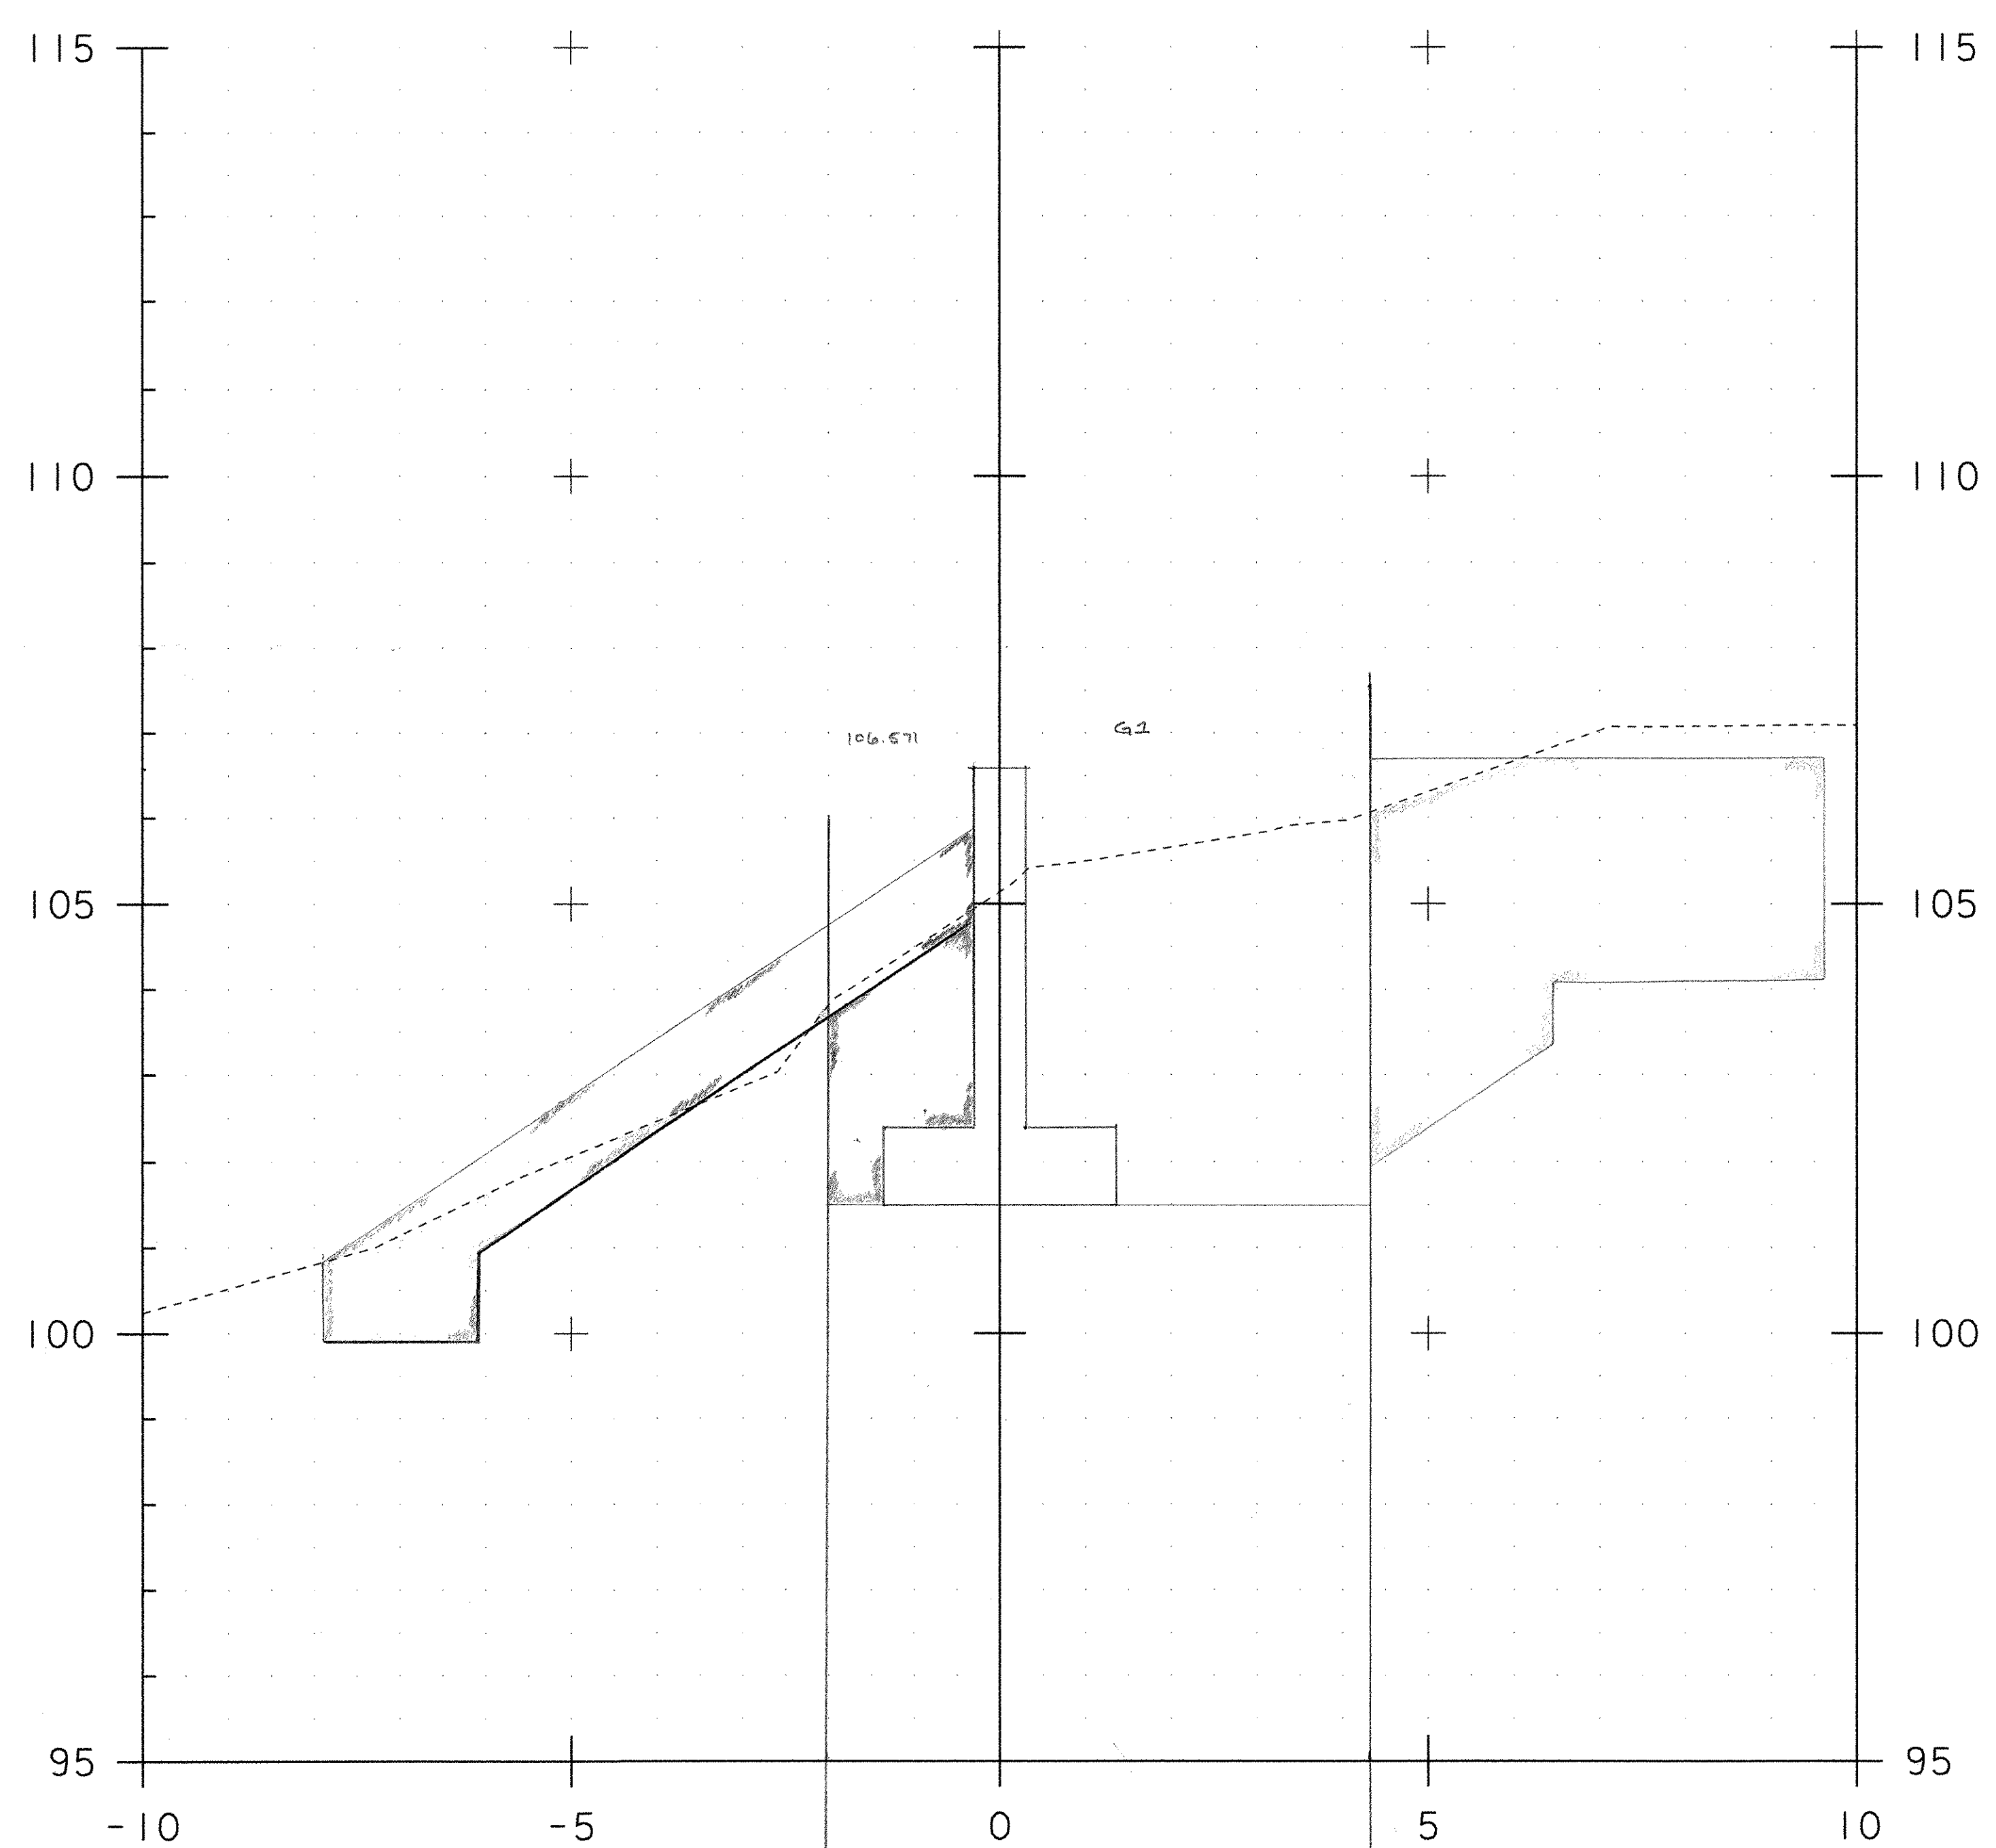


Exc - E+R = 24.03 m^2 *old*
 STONE FILL TYPE III = 8.08 m^2
 SAND BACKFILL = 6.66 m^2
 GEO UNDER S.F = 9.7 m
 STRUCTURE EX = 19.8 m^2

10+004.00

COFFERDAM Full width (+ wing)

PROJECT NAME:	Leicester	PLOT DATE:	01-NOV-2005
PROJECT NUMBER:	BRF 0160(3)S	DRAWN BY:	R. Bullock
FILE NAME:		CHECKED BY:	
PROJECT LEADER:		SHEET 5	OF 7
DESIGNED BY:			


128A42

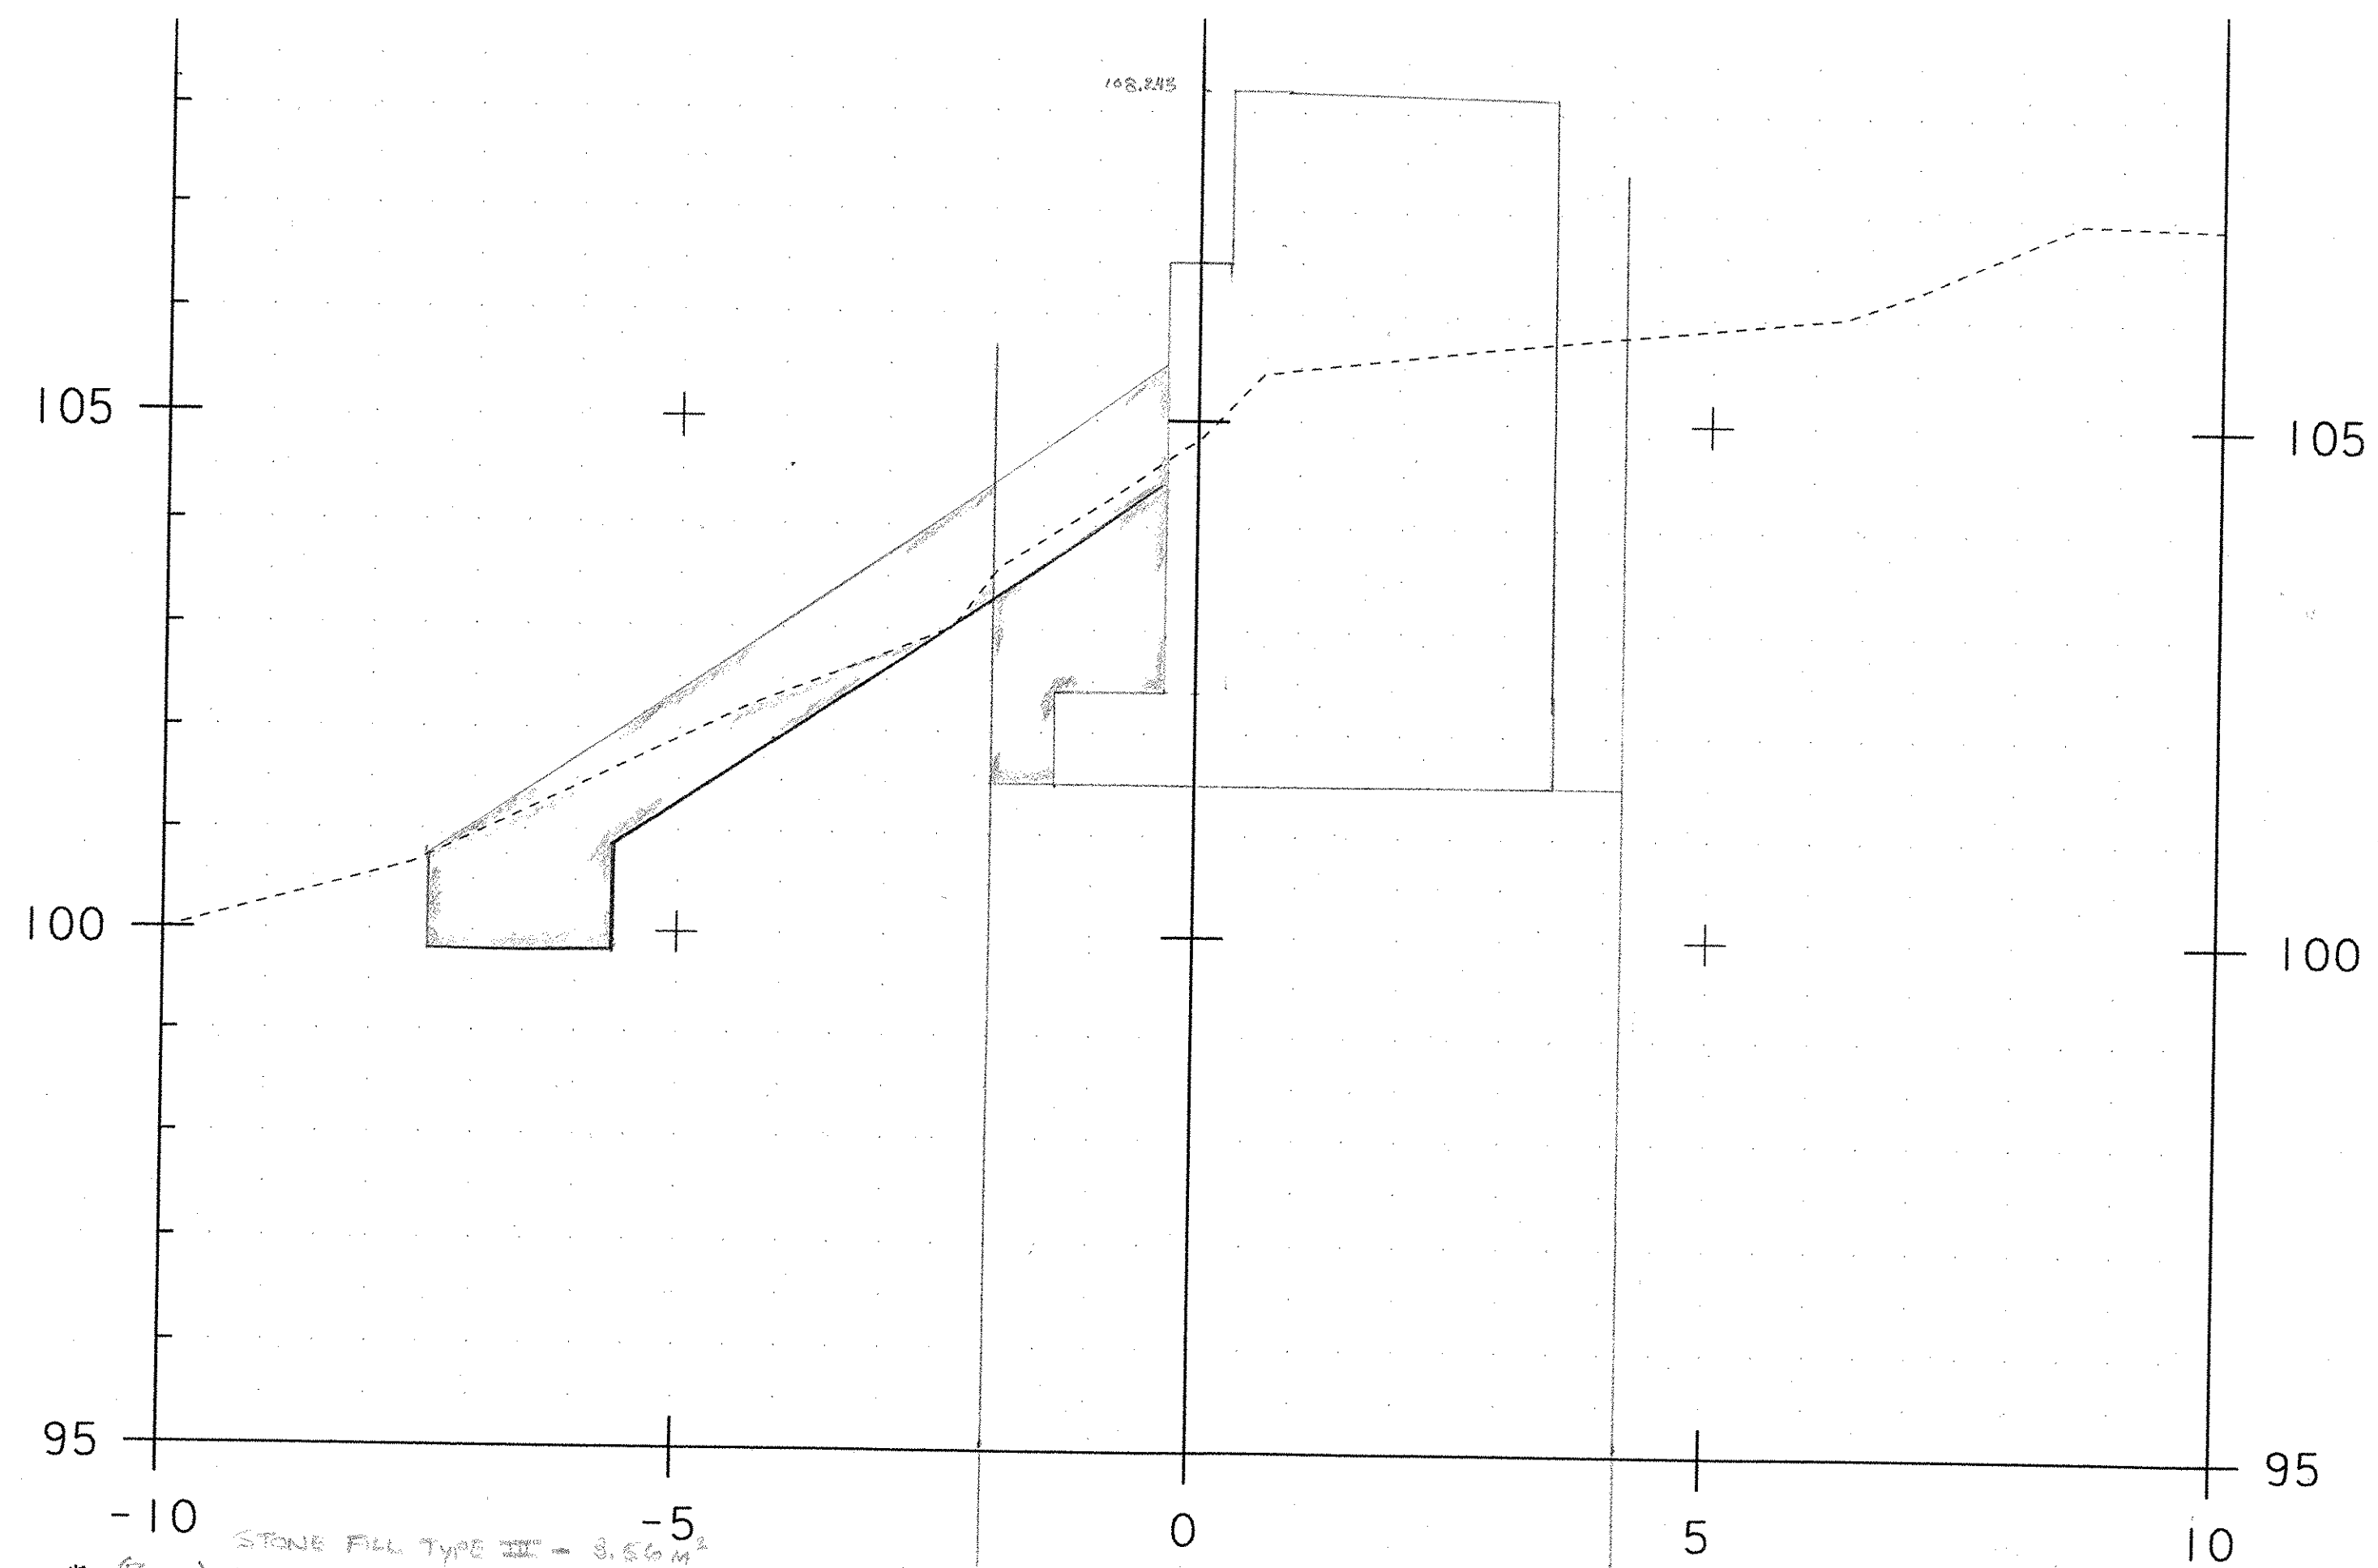



* (Butt) STONE FILL TYPE III - 8.50 M²
 * (Butt) CONC. CHAS. EXC. - 3.49 M²
 * (Butt) GRAV. SAND CRUSHED - 2.79 M²
 * (Butt) GEO. UNDER S.F. - 9.2 M


10+005.80


ABUTMENT / W/W #3 CORNER
 1/20 ABZ

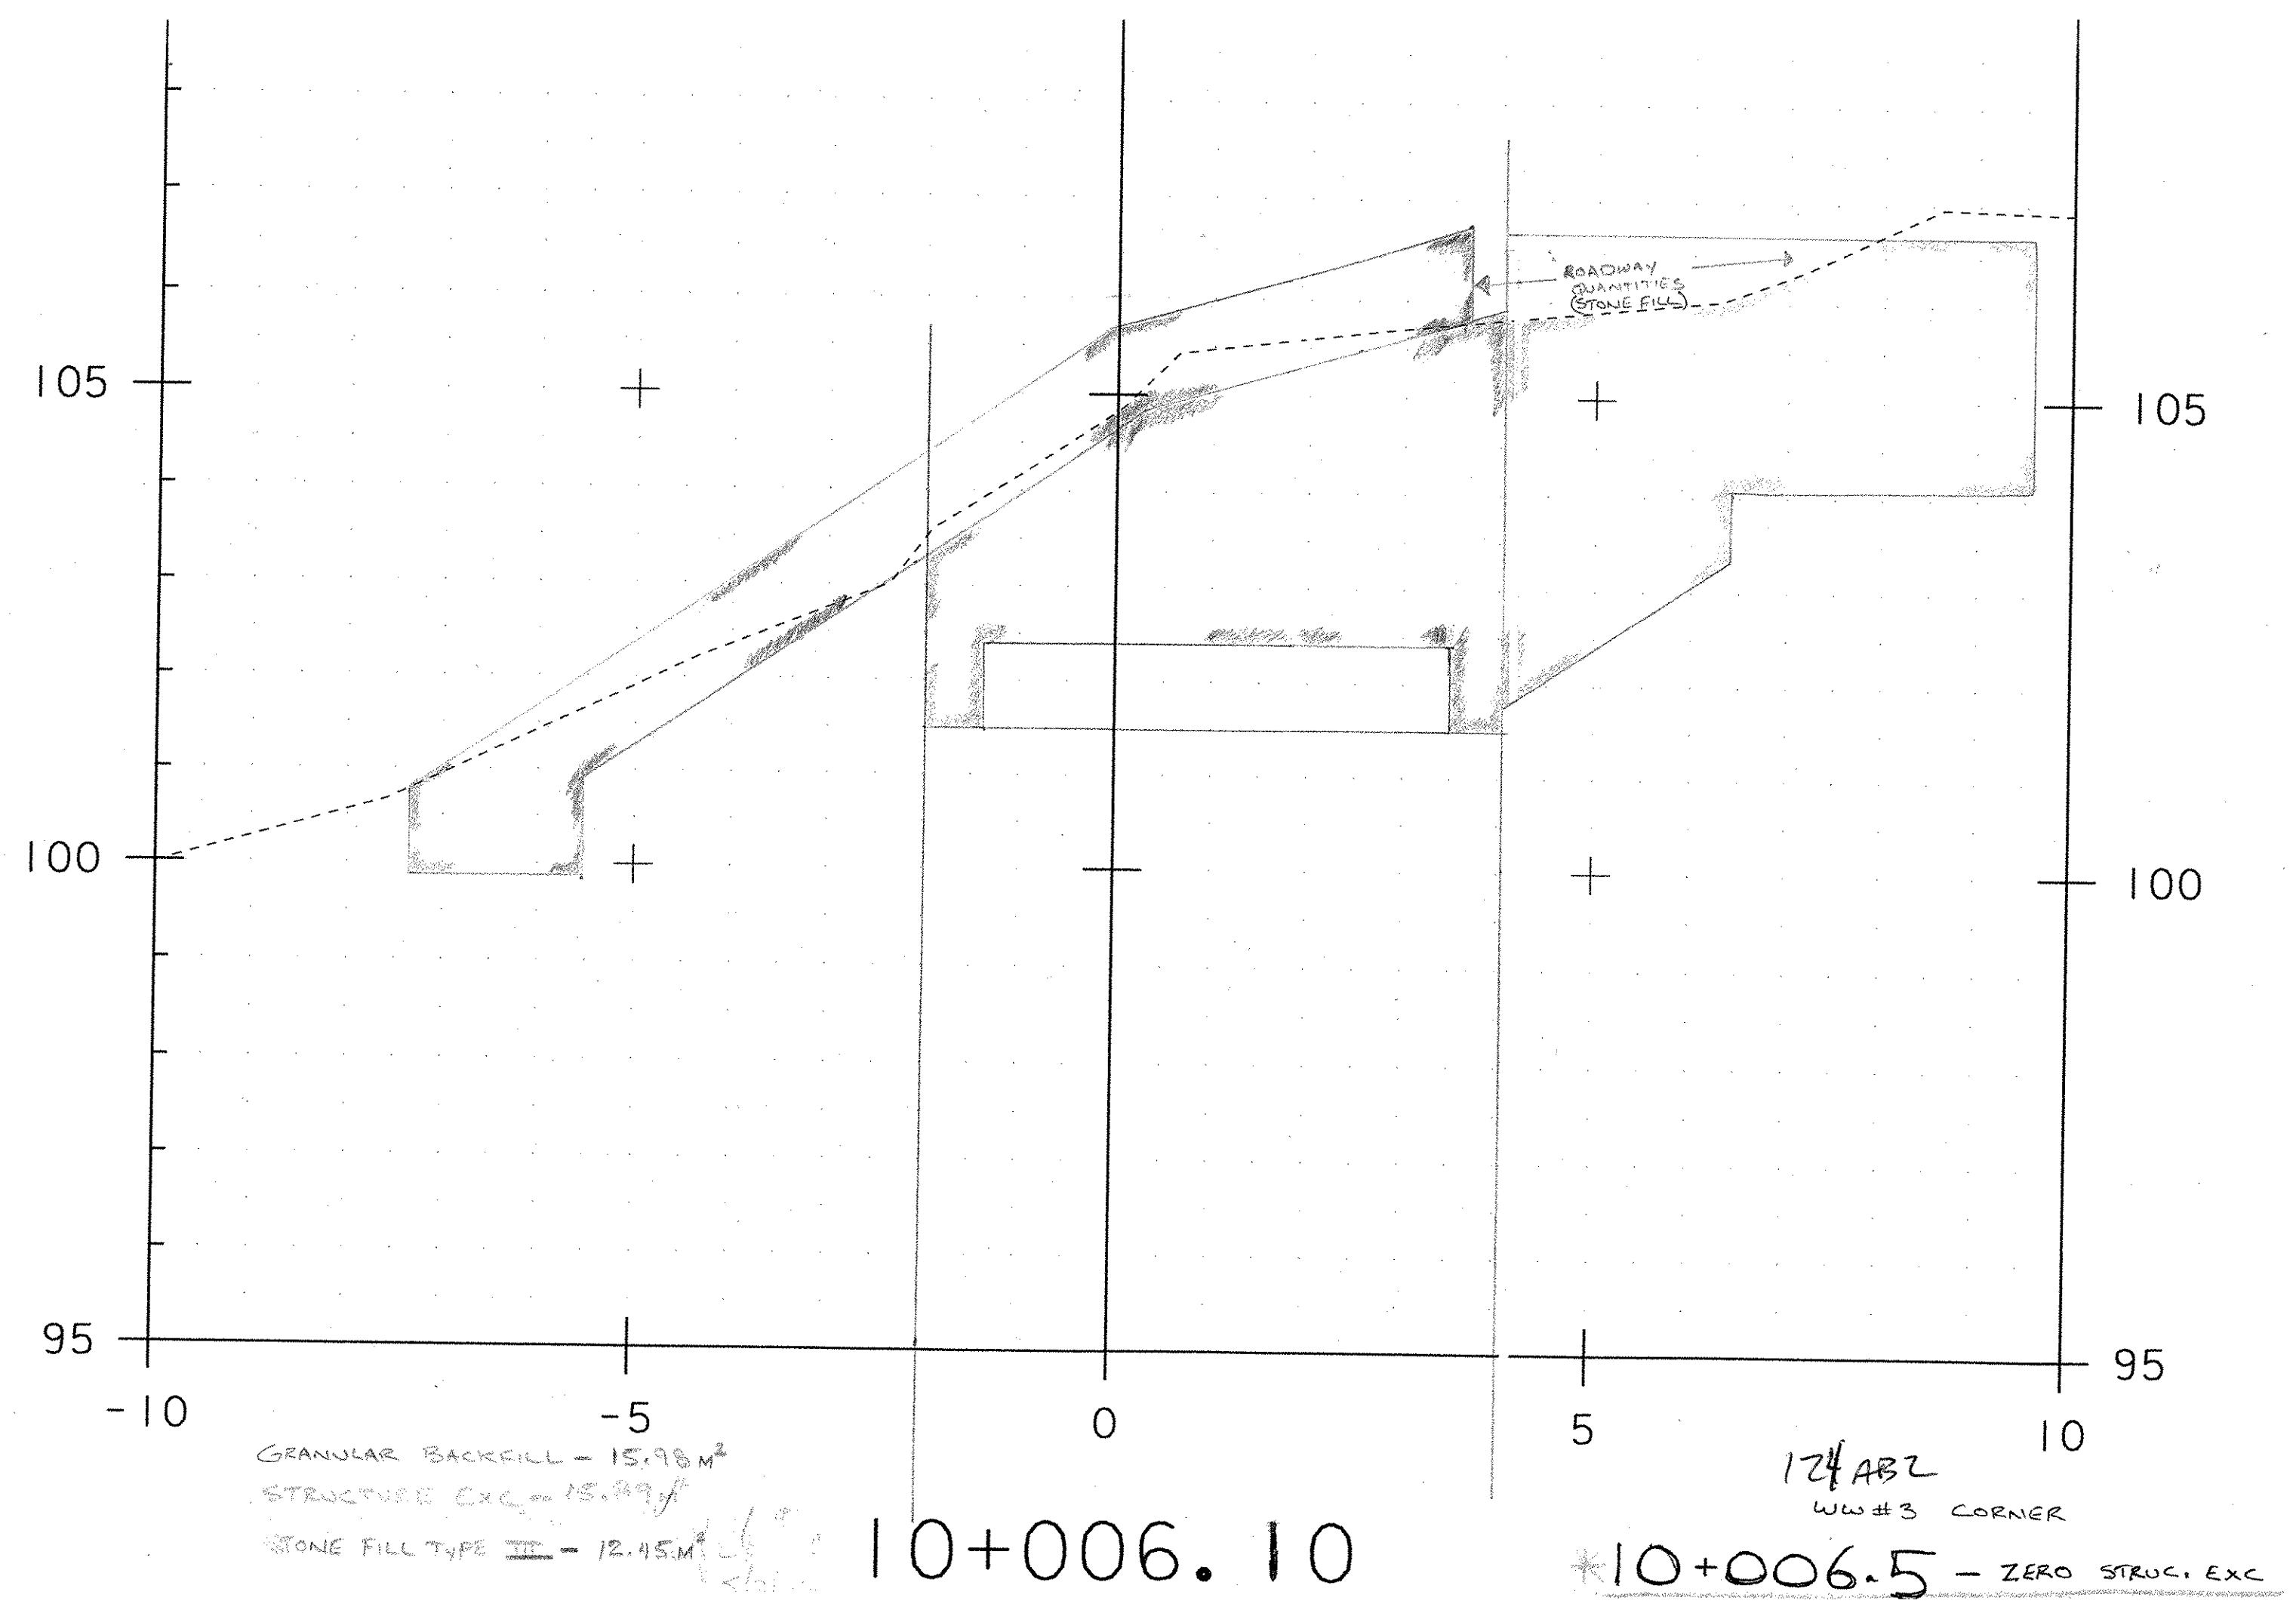

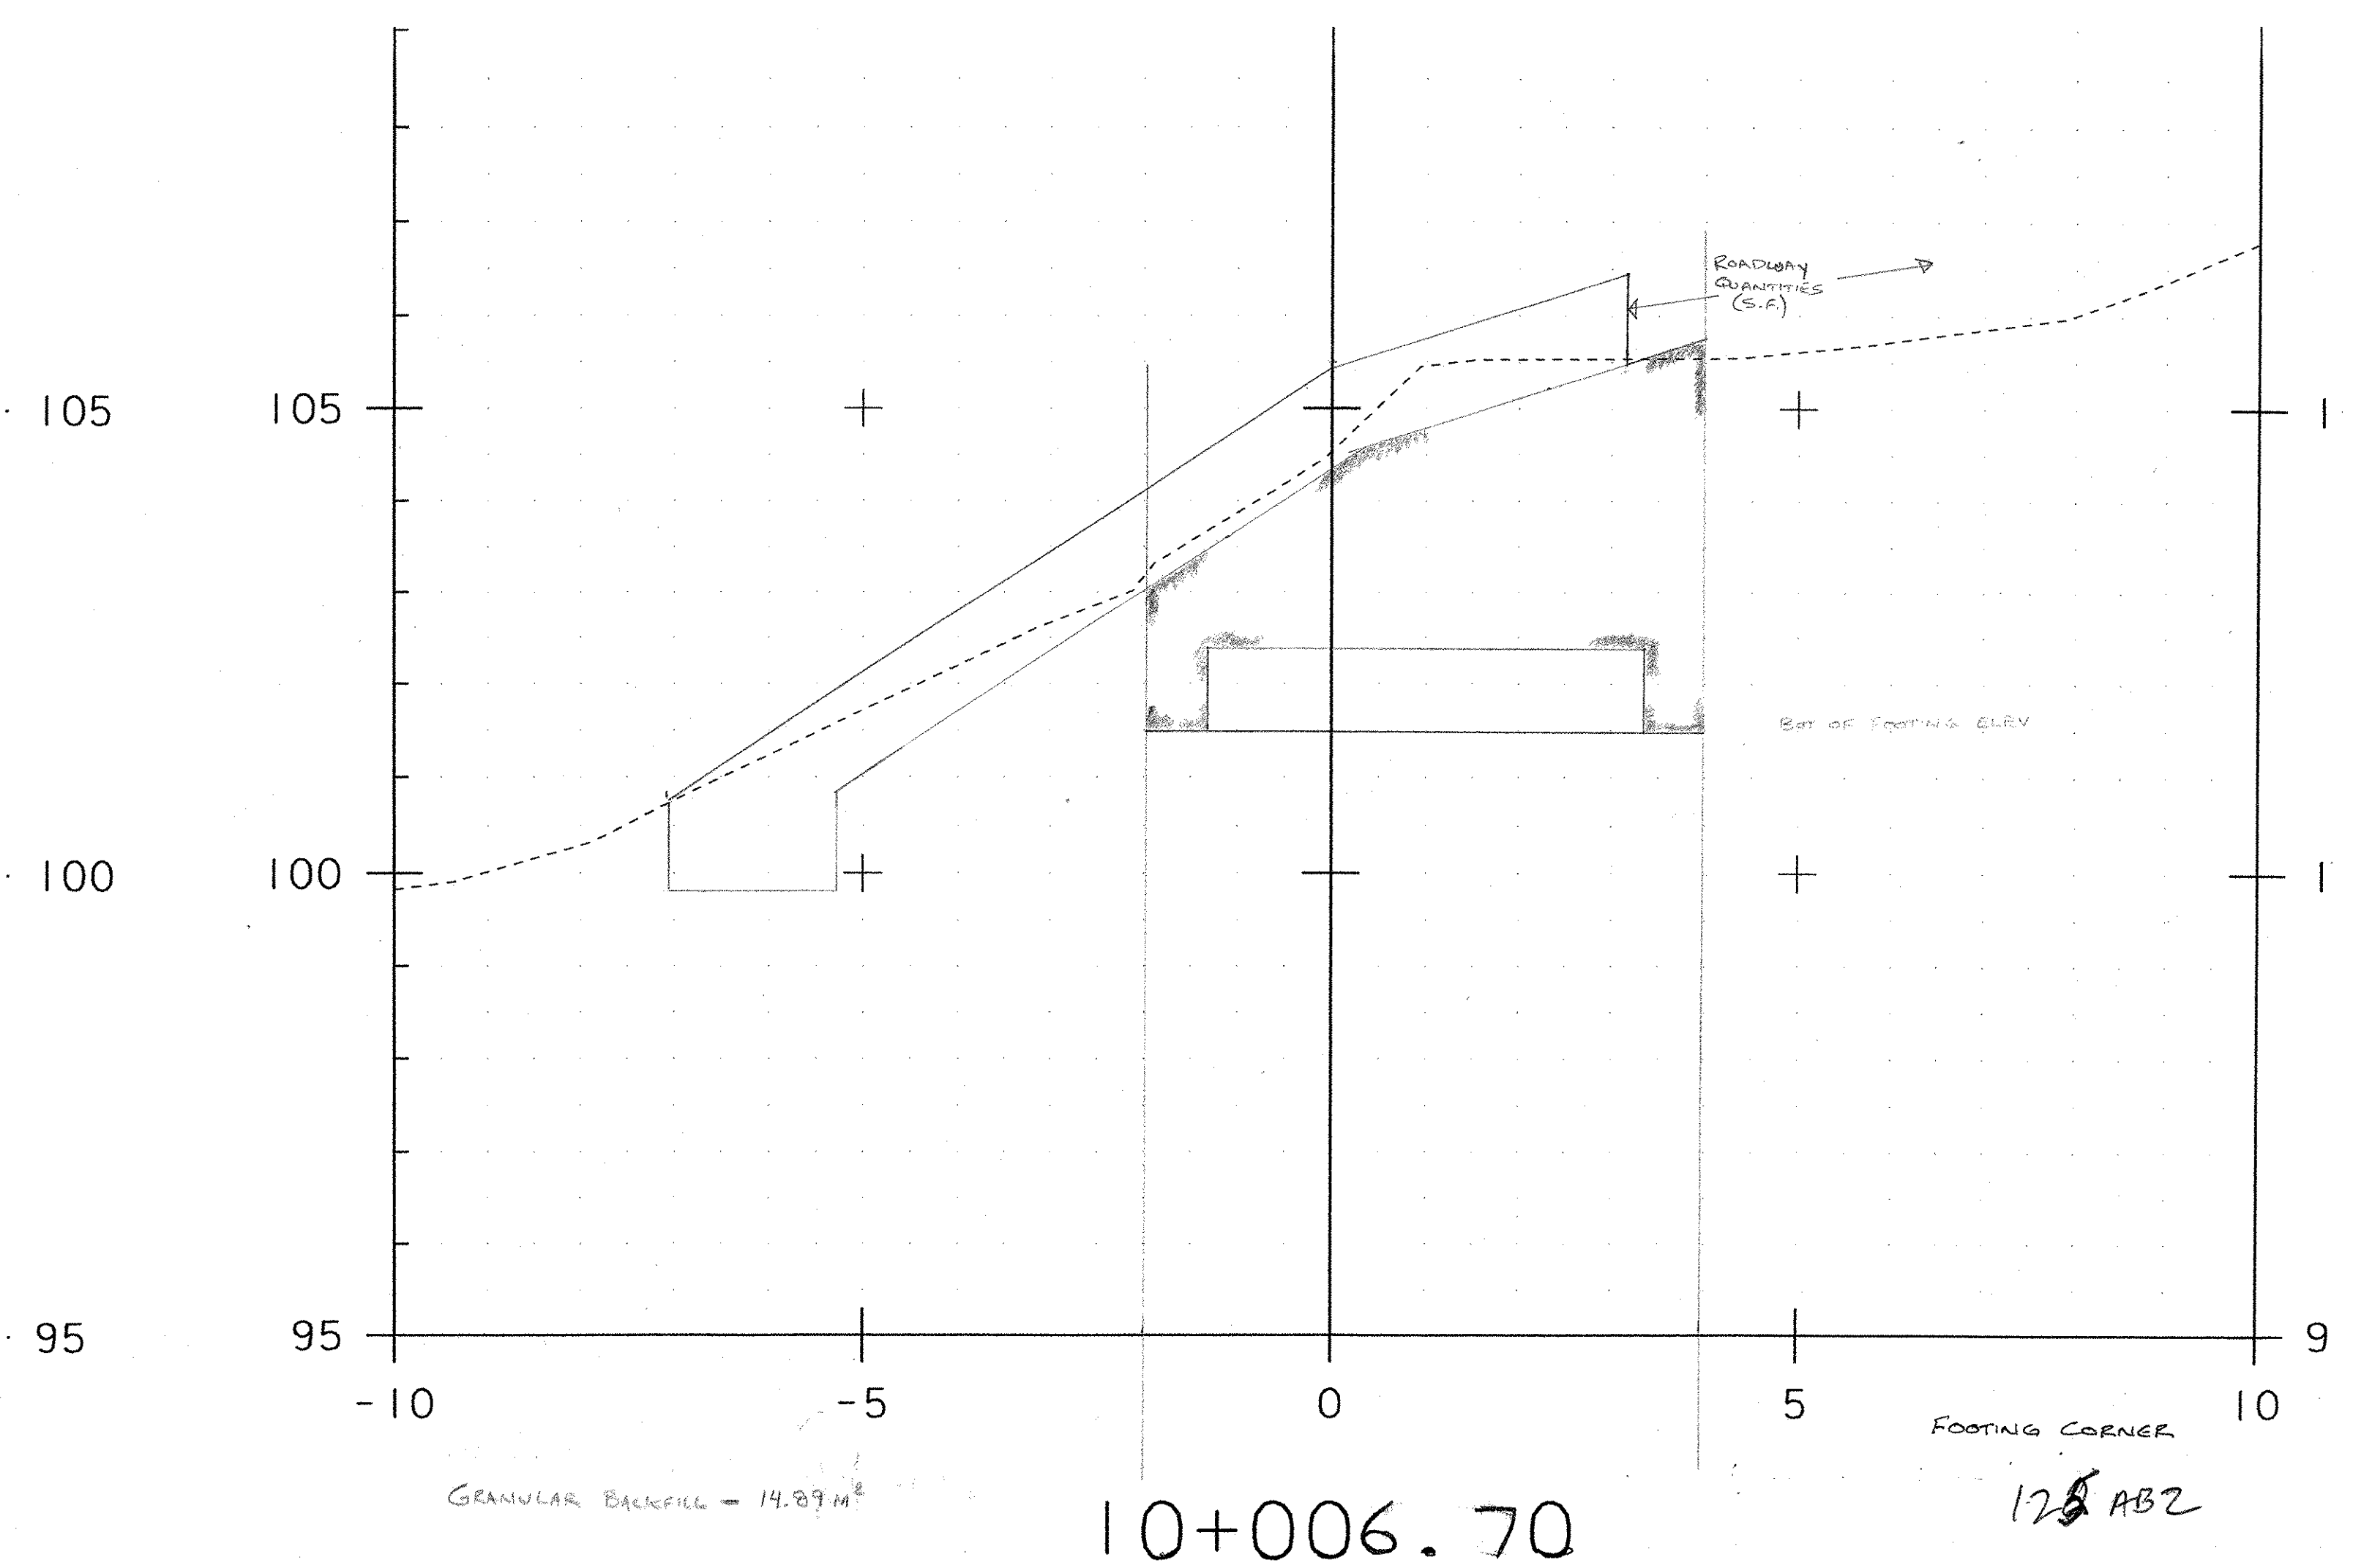

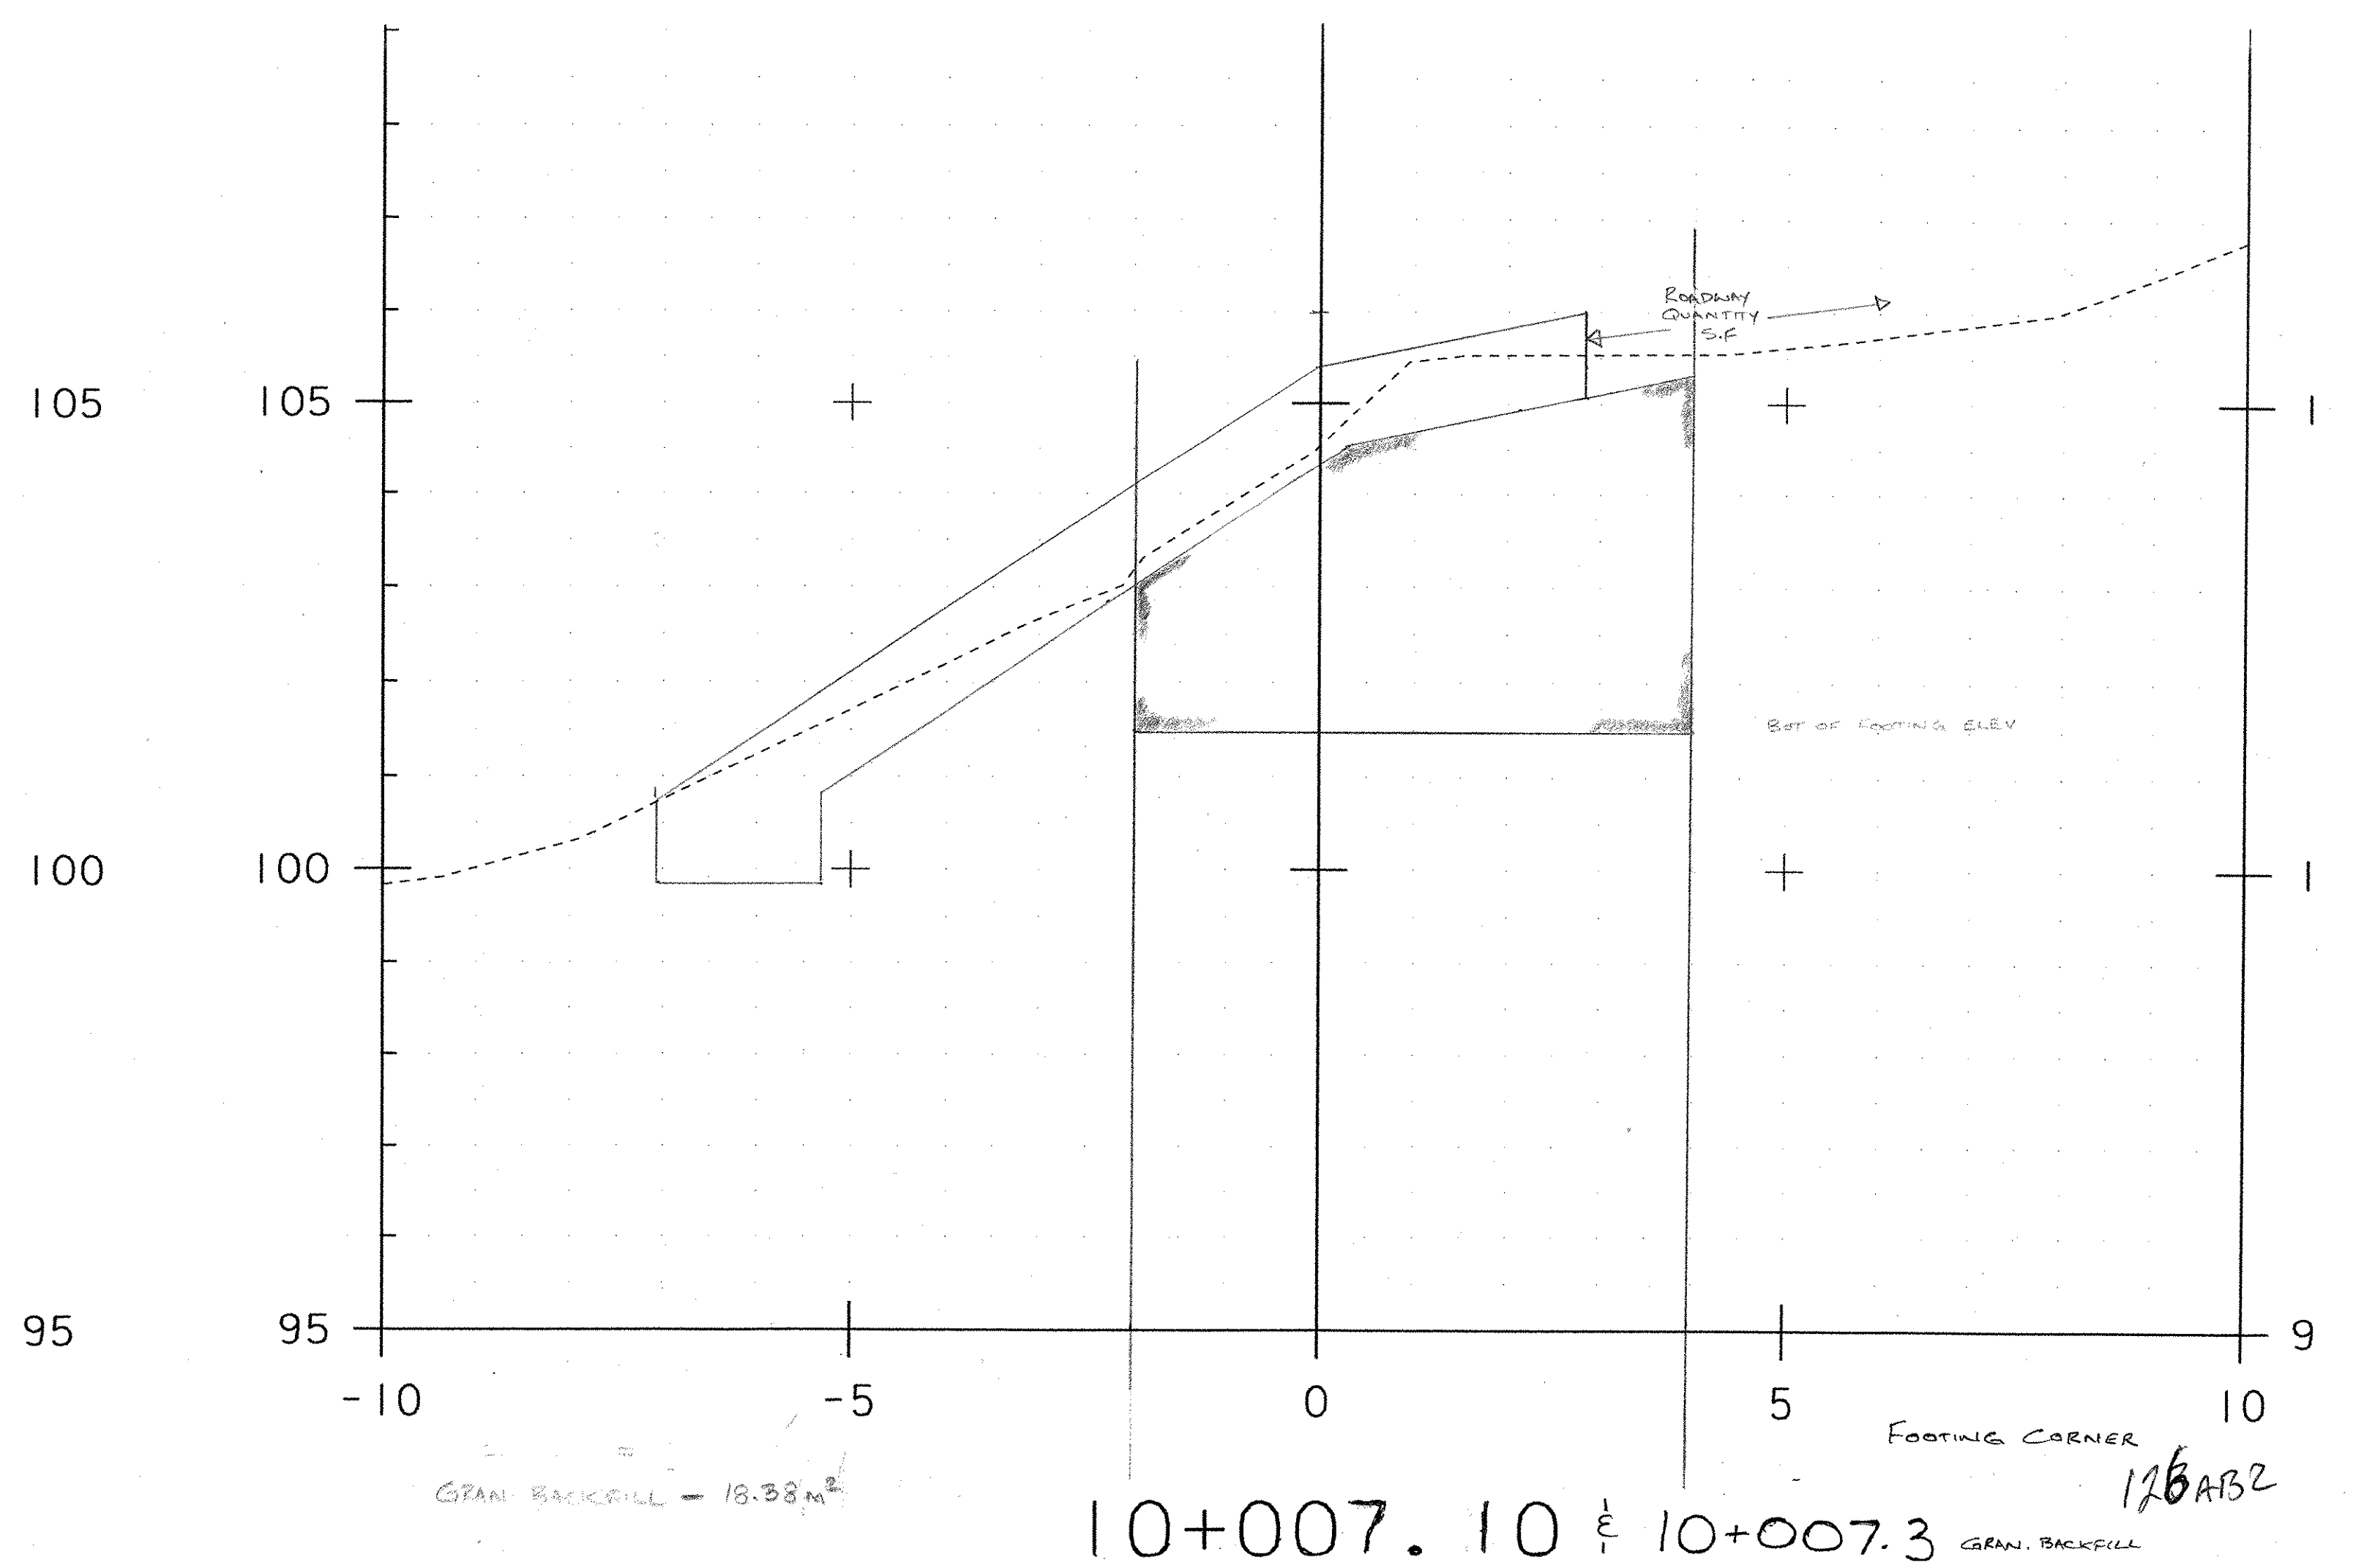


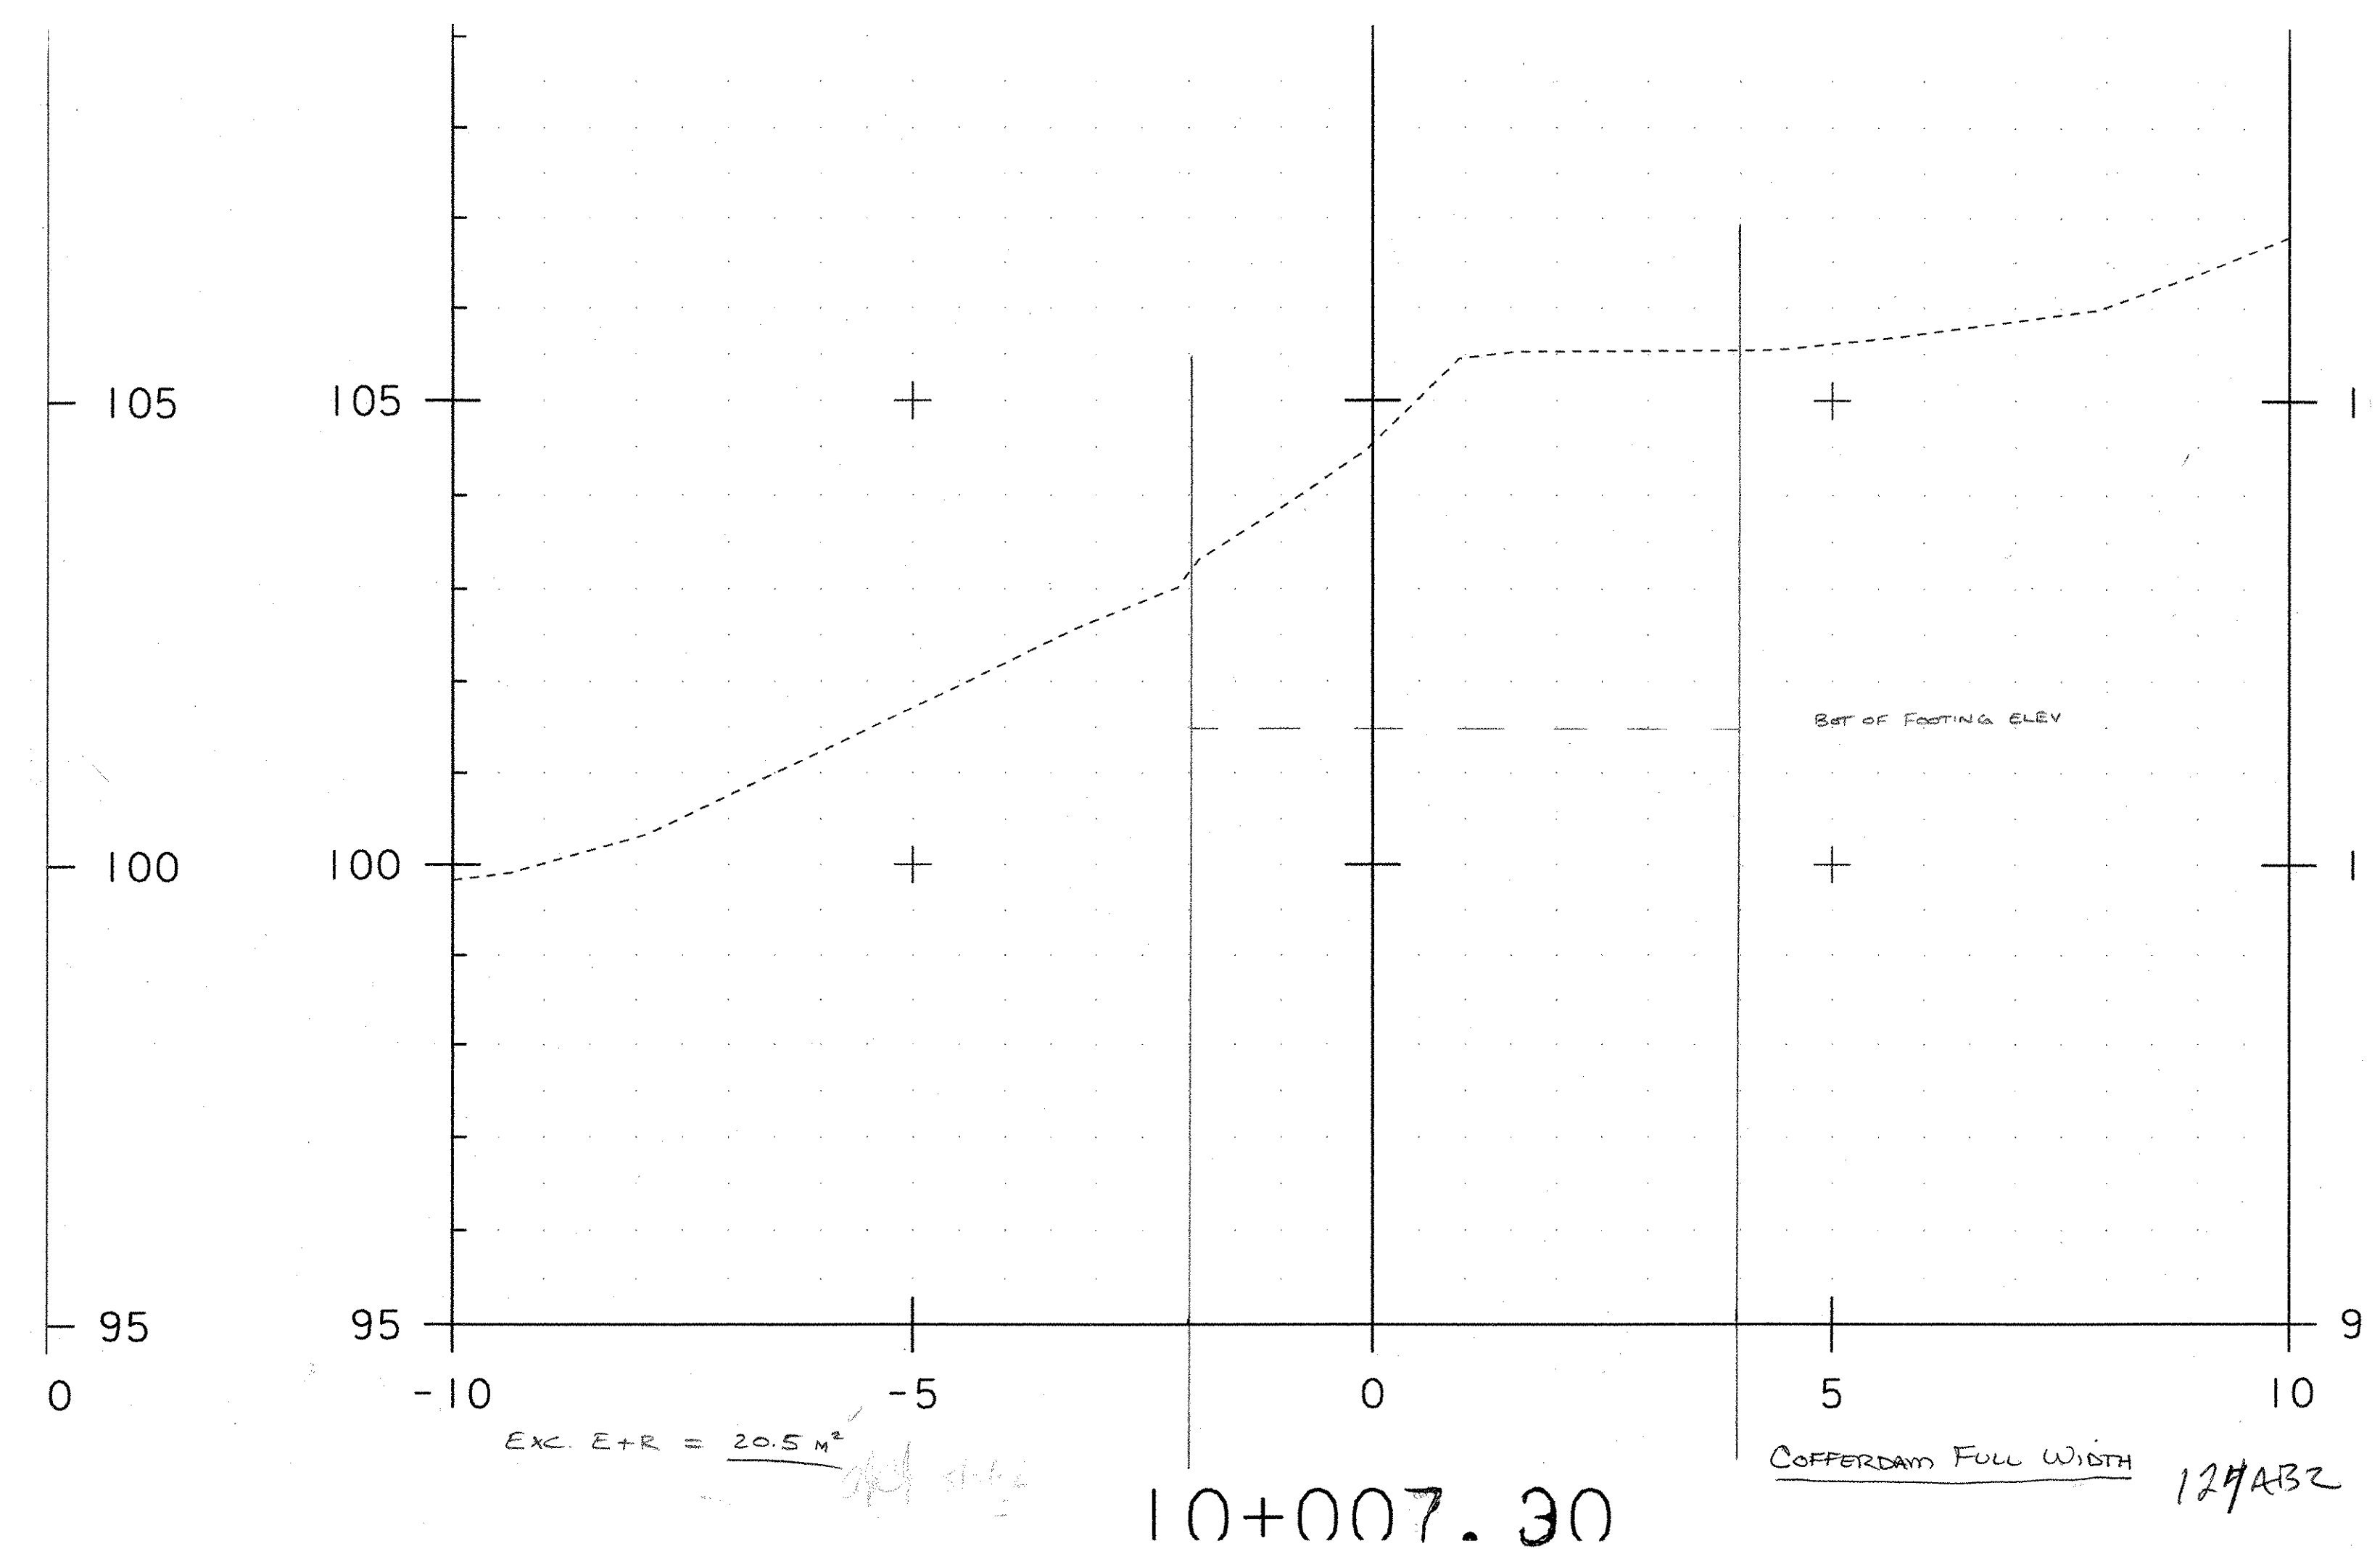

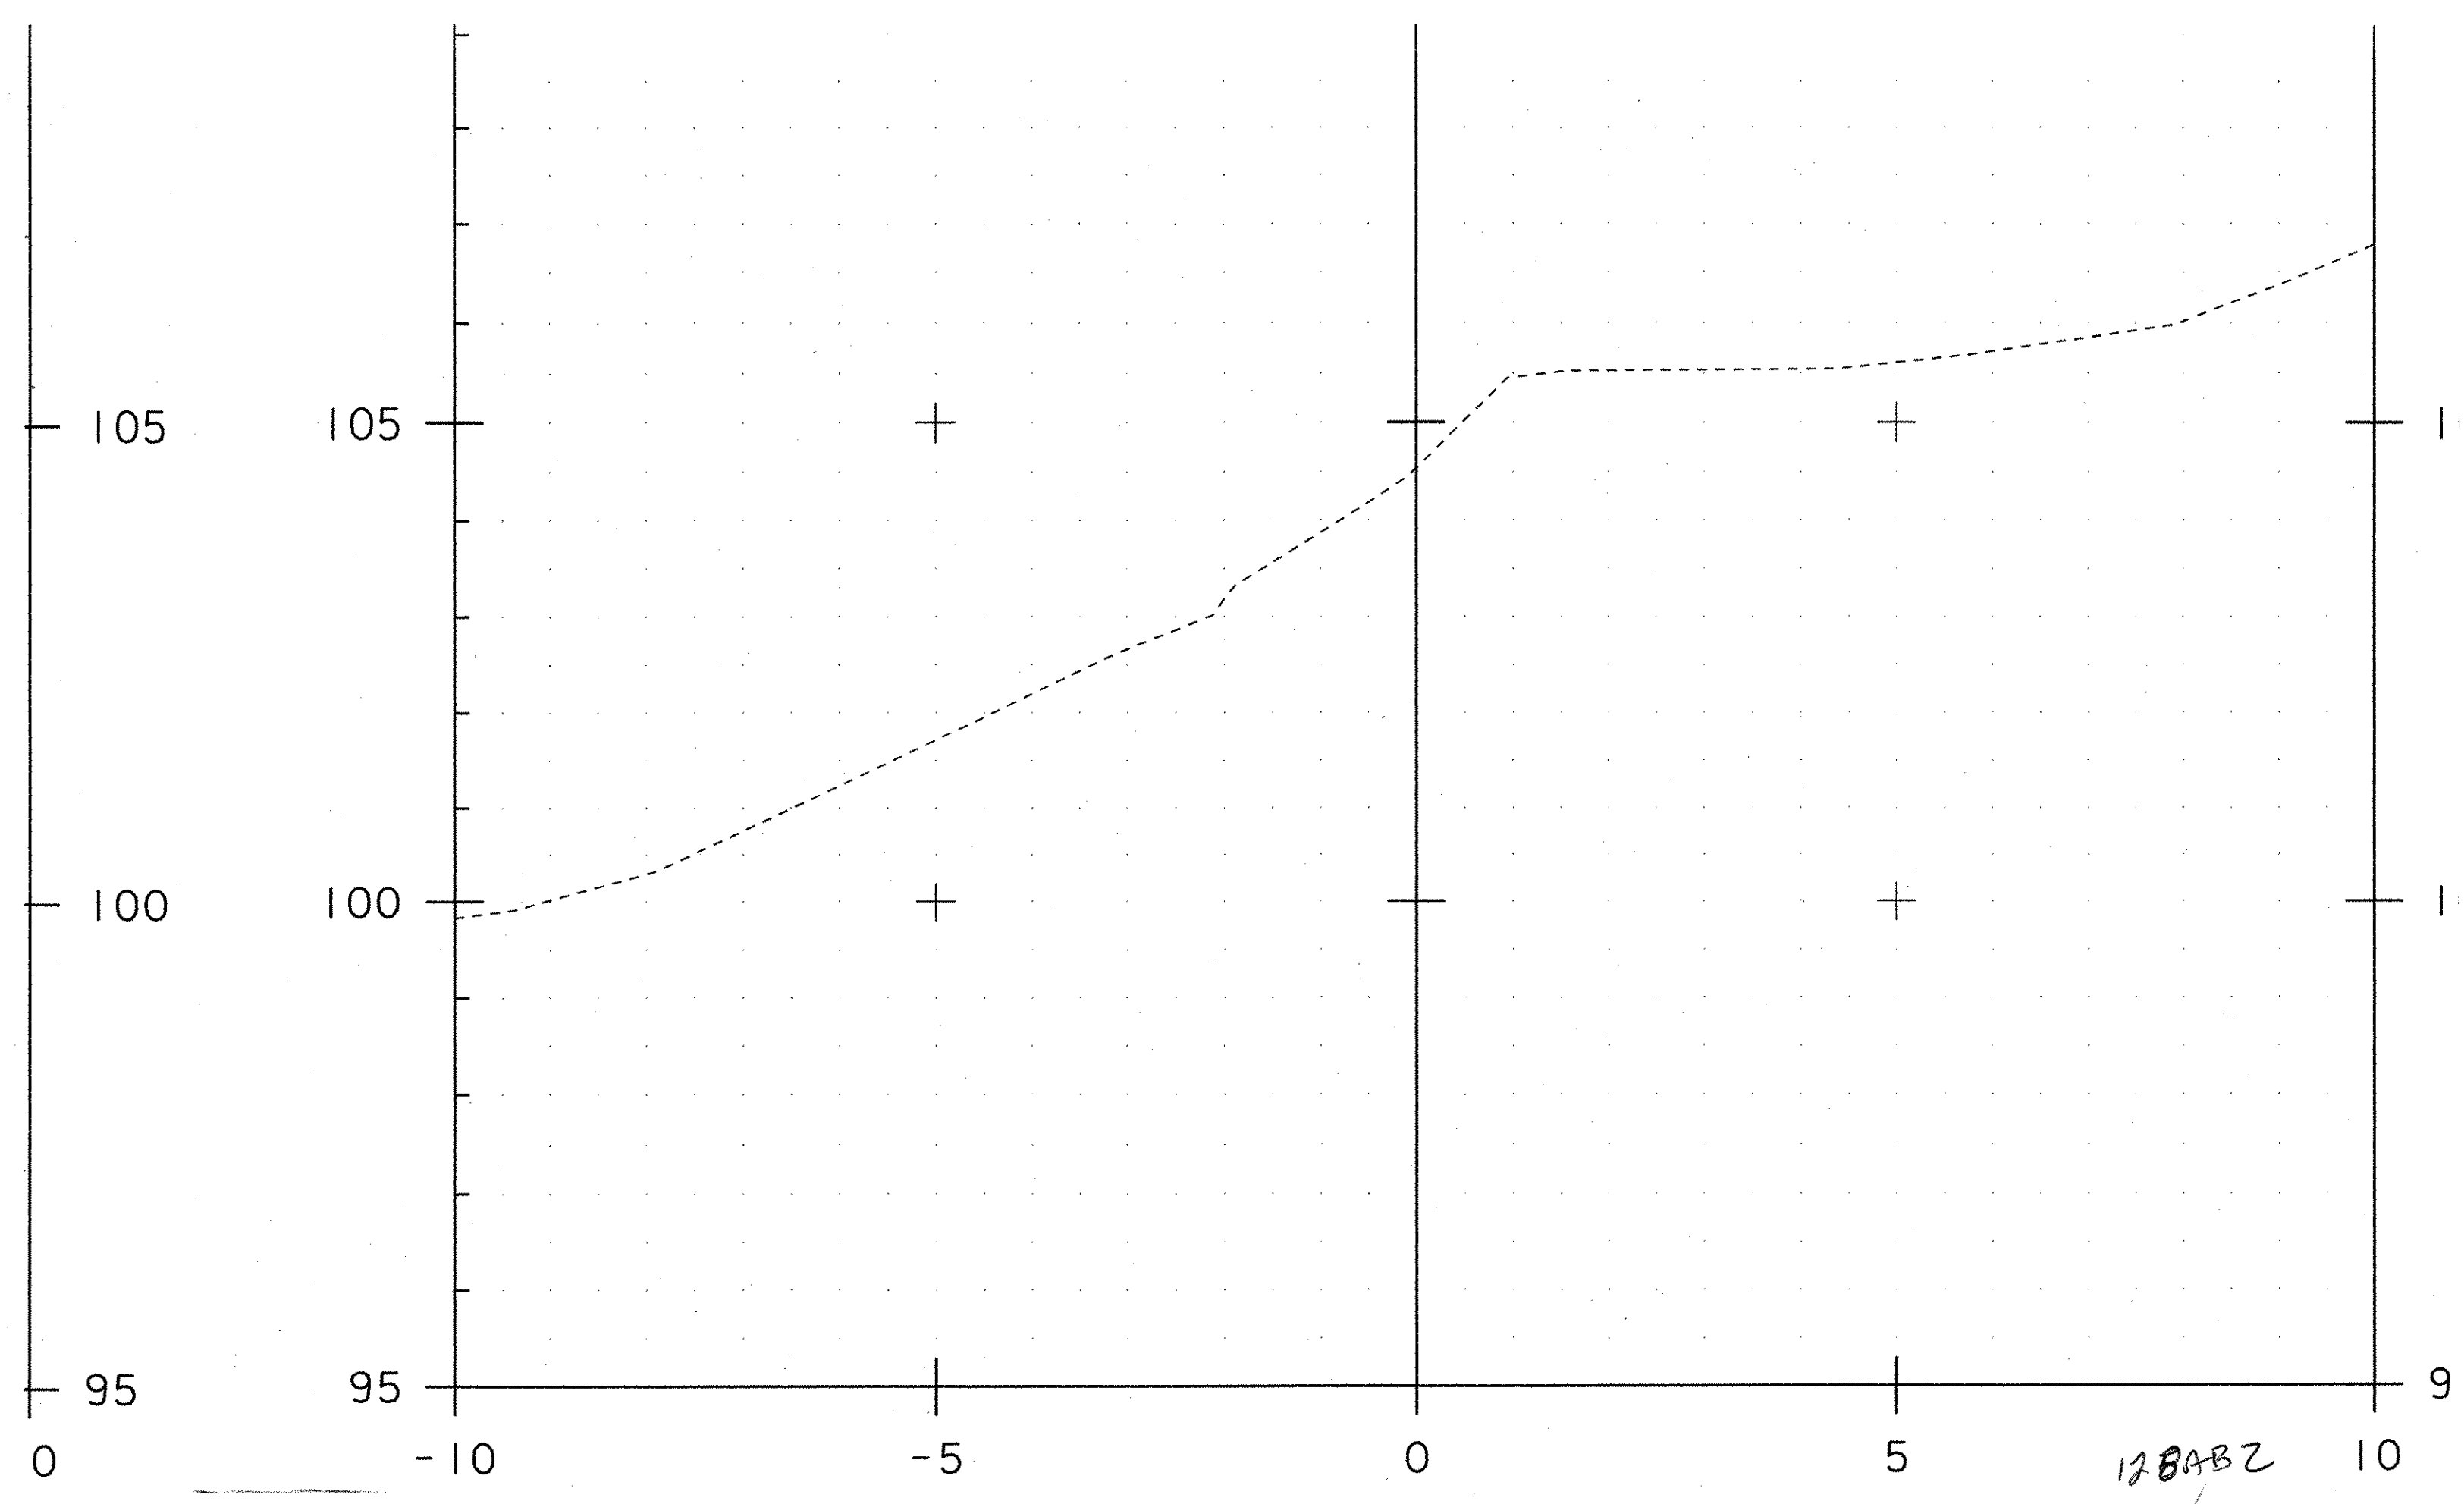


10+007.80

128ABZ
 ZERO COFFERDAM
 ZERO GRAN. BACKFILL

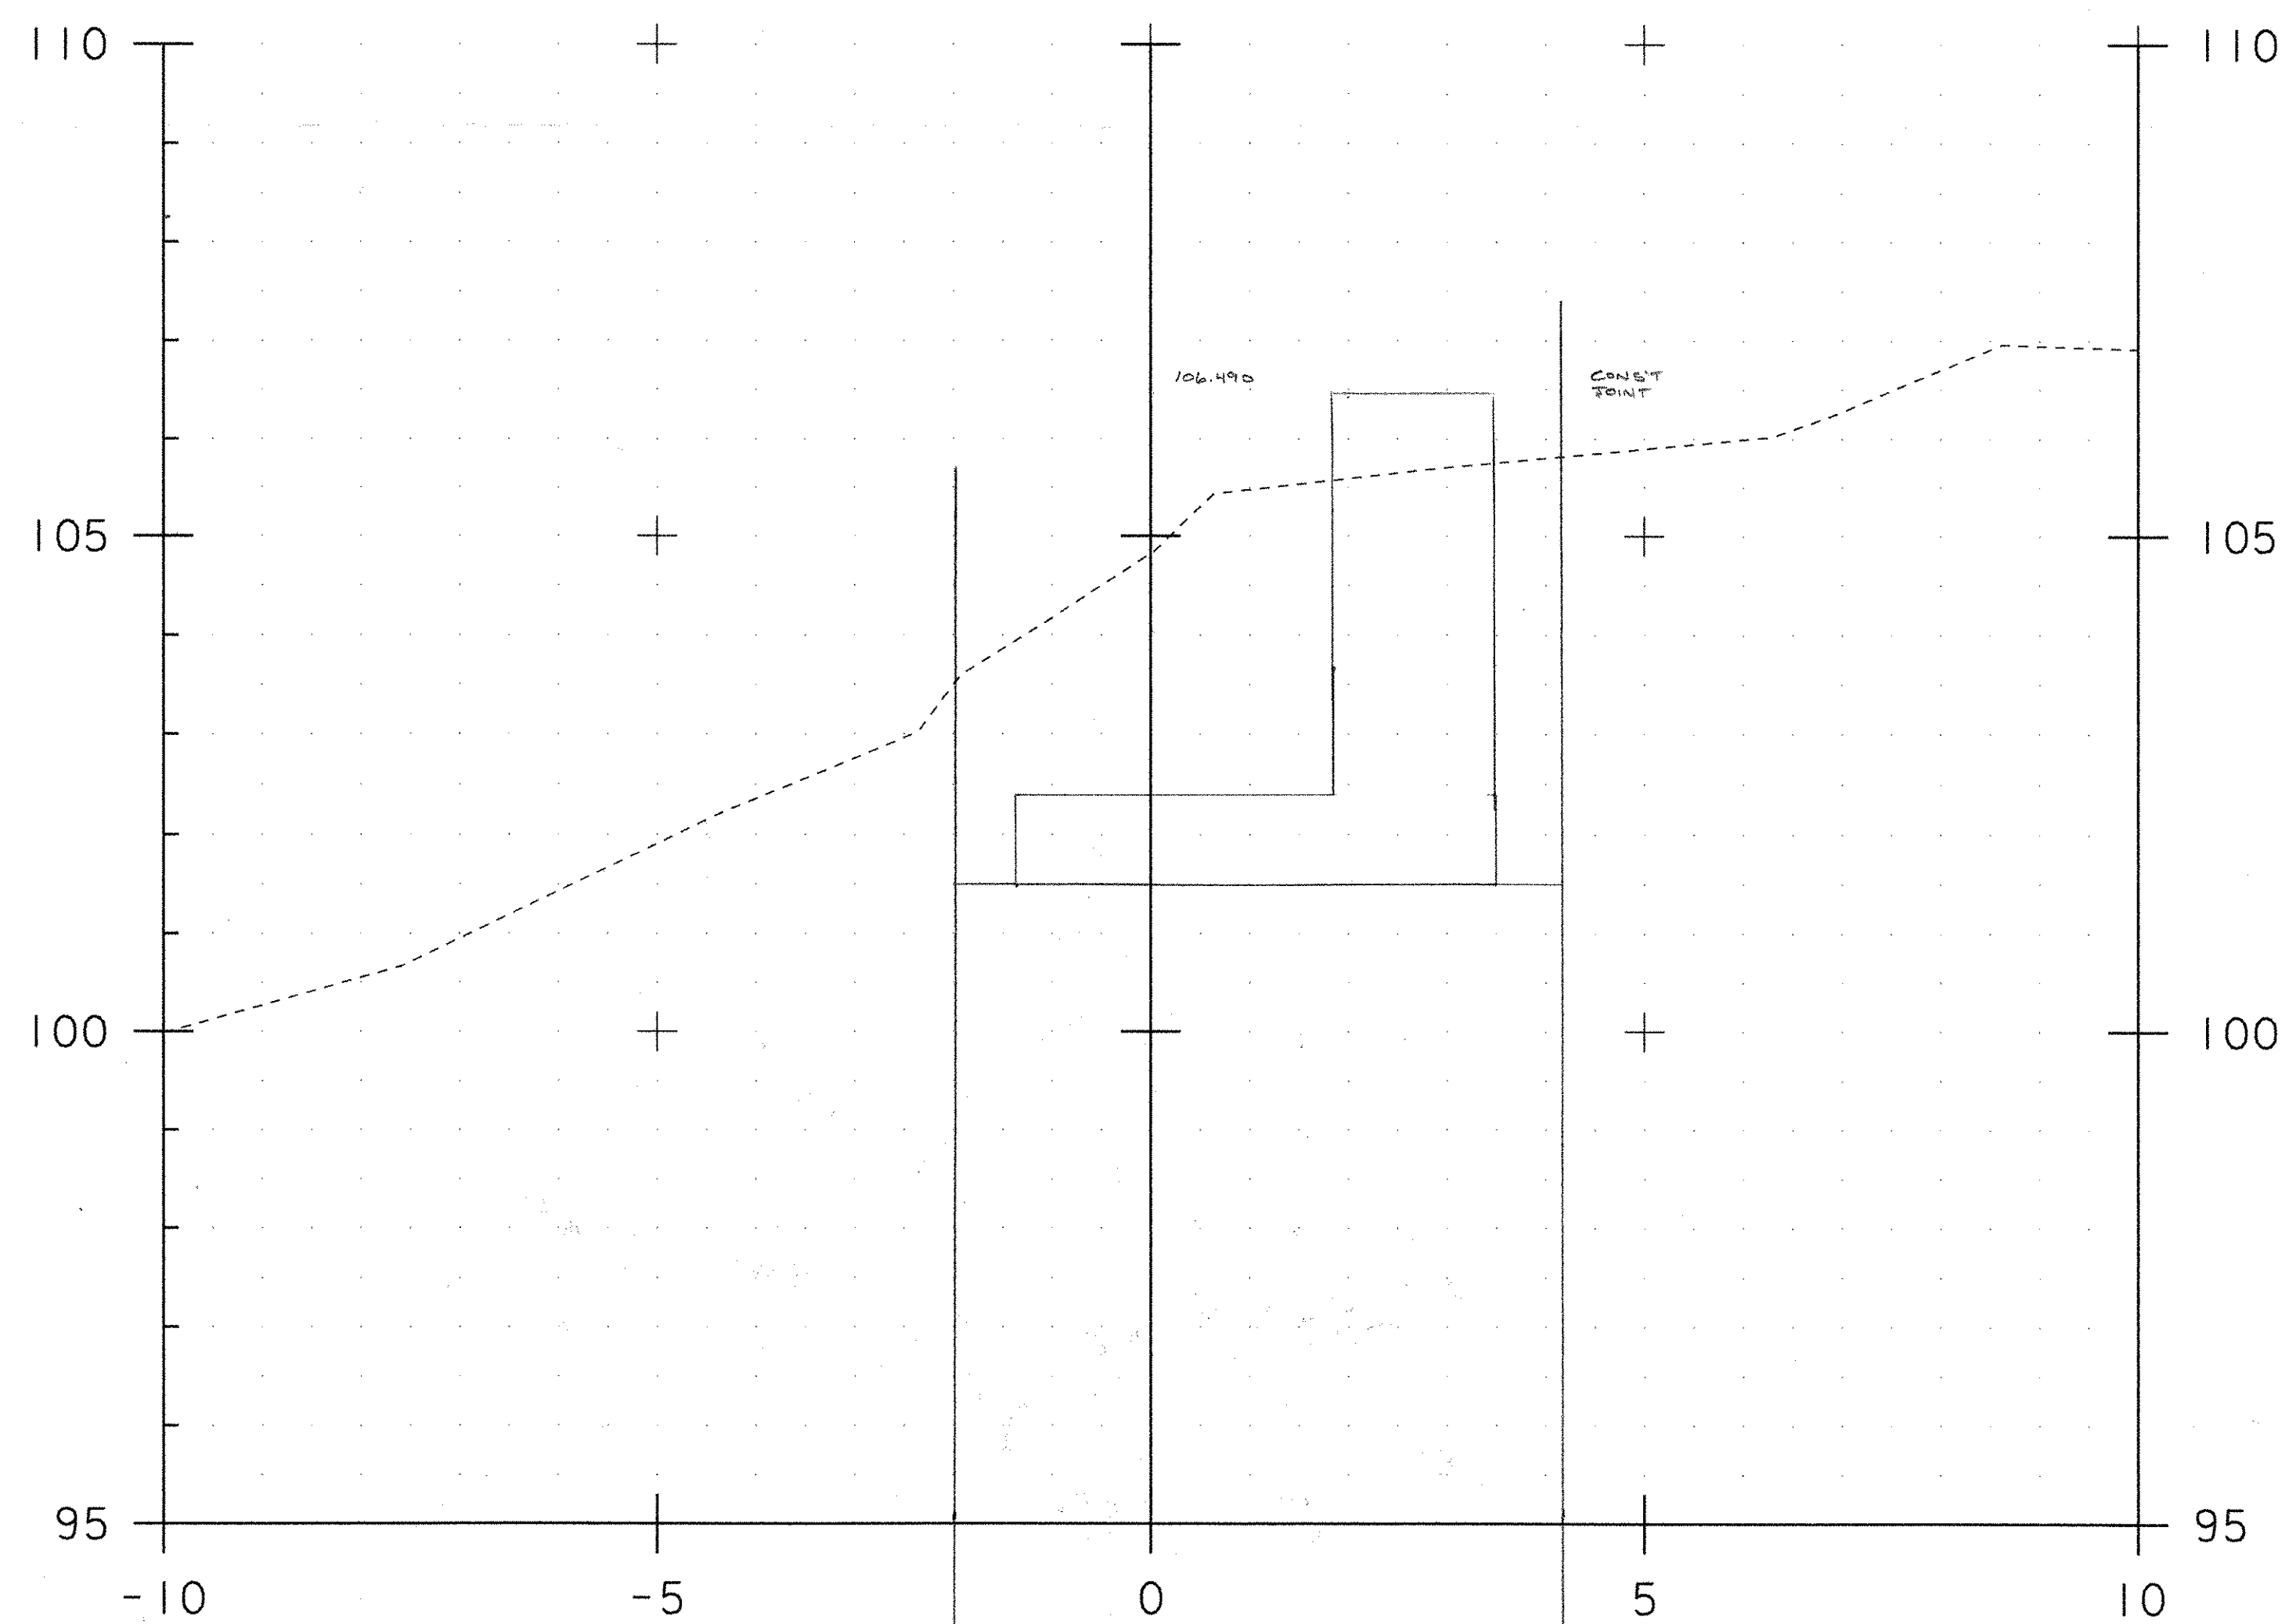


Exc - E+R = 22.12 m^2 *JL* *10/11/05* 10+006.00 *COFFERDAM EXC ONLY

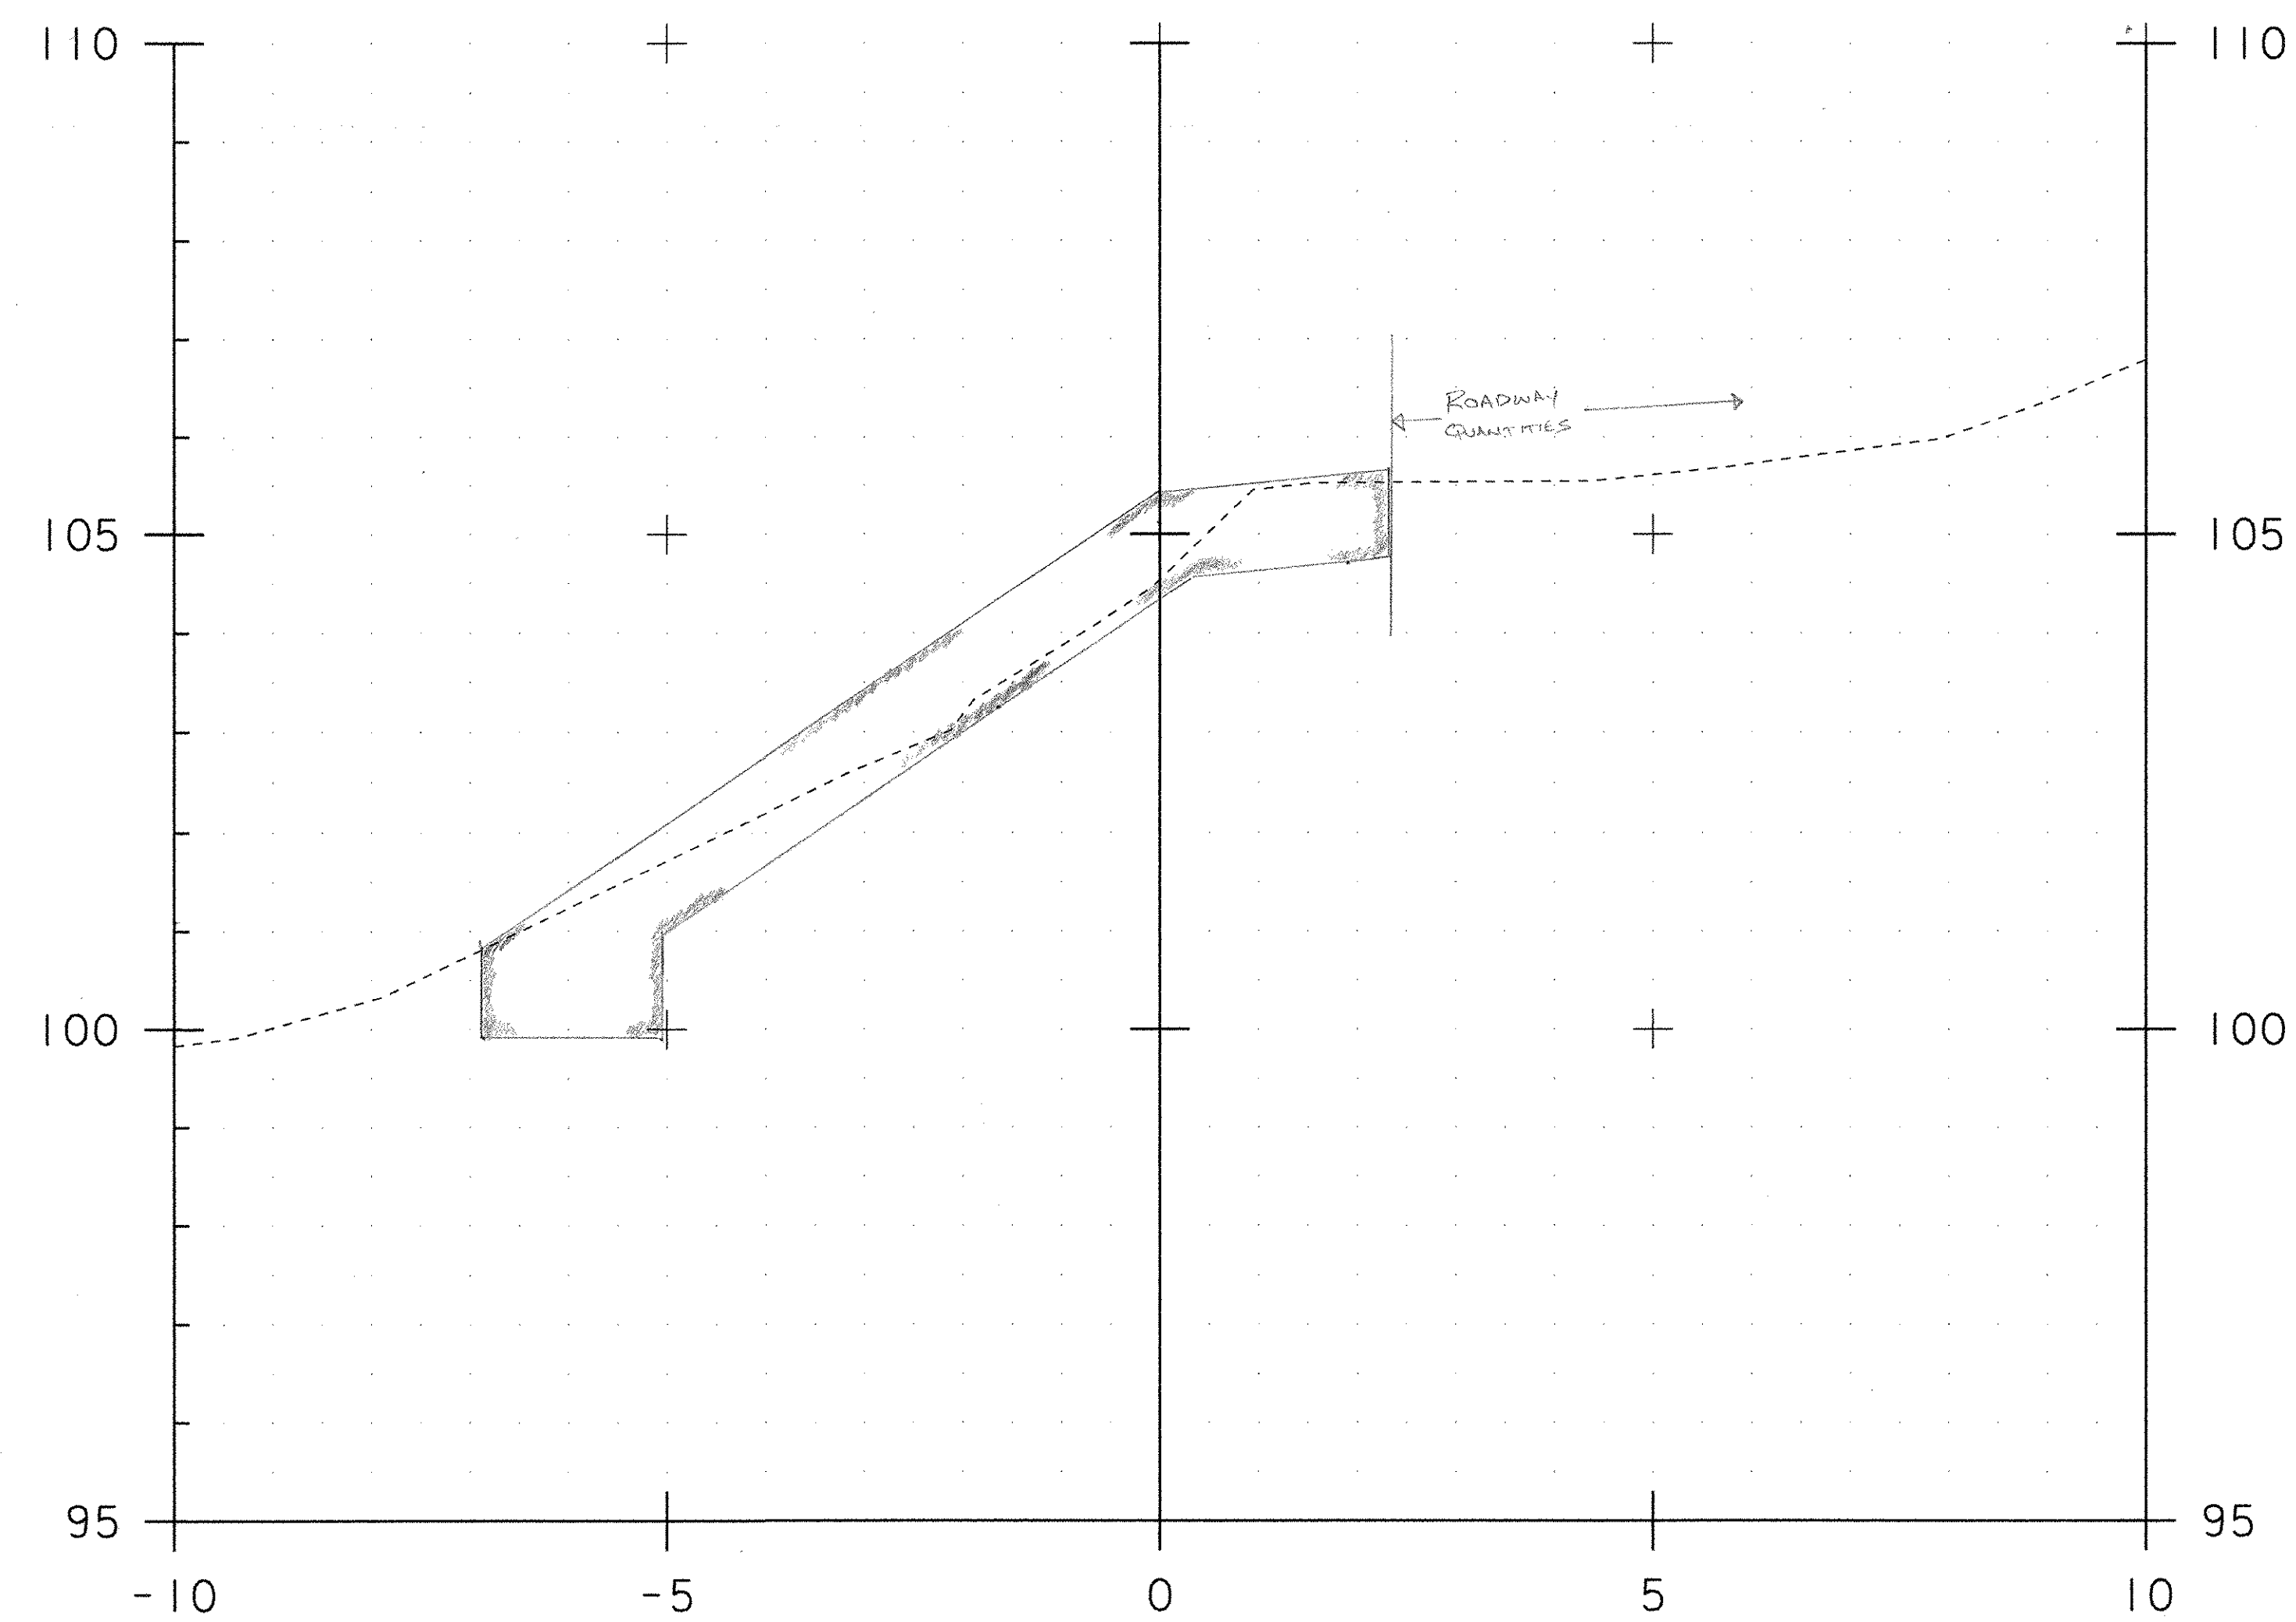


STONE FILL TYPE III - 10.28 m^2 10+008.00

PROJECT NAME:	Leicester	PLOT DATE:	01-NOV-2005
PROJECT NUMBER:	BRF 0160(3)S	DRAWN BY:	R. Bullock
FILE NAME:		CHECKED BY:	
PROJECT LEADER:		DESIGNED BY:	
		SHEET	6 OF 7


12/11/05

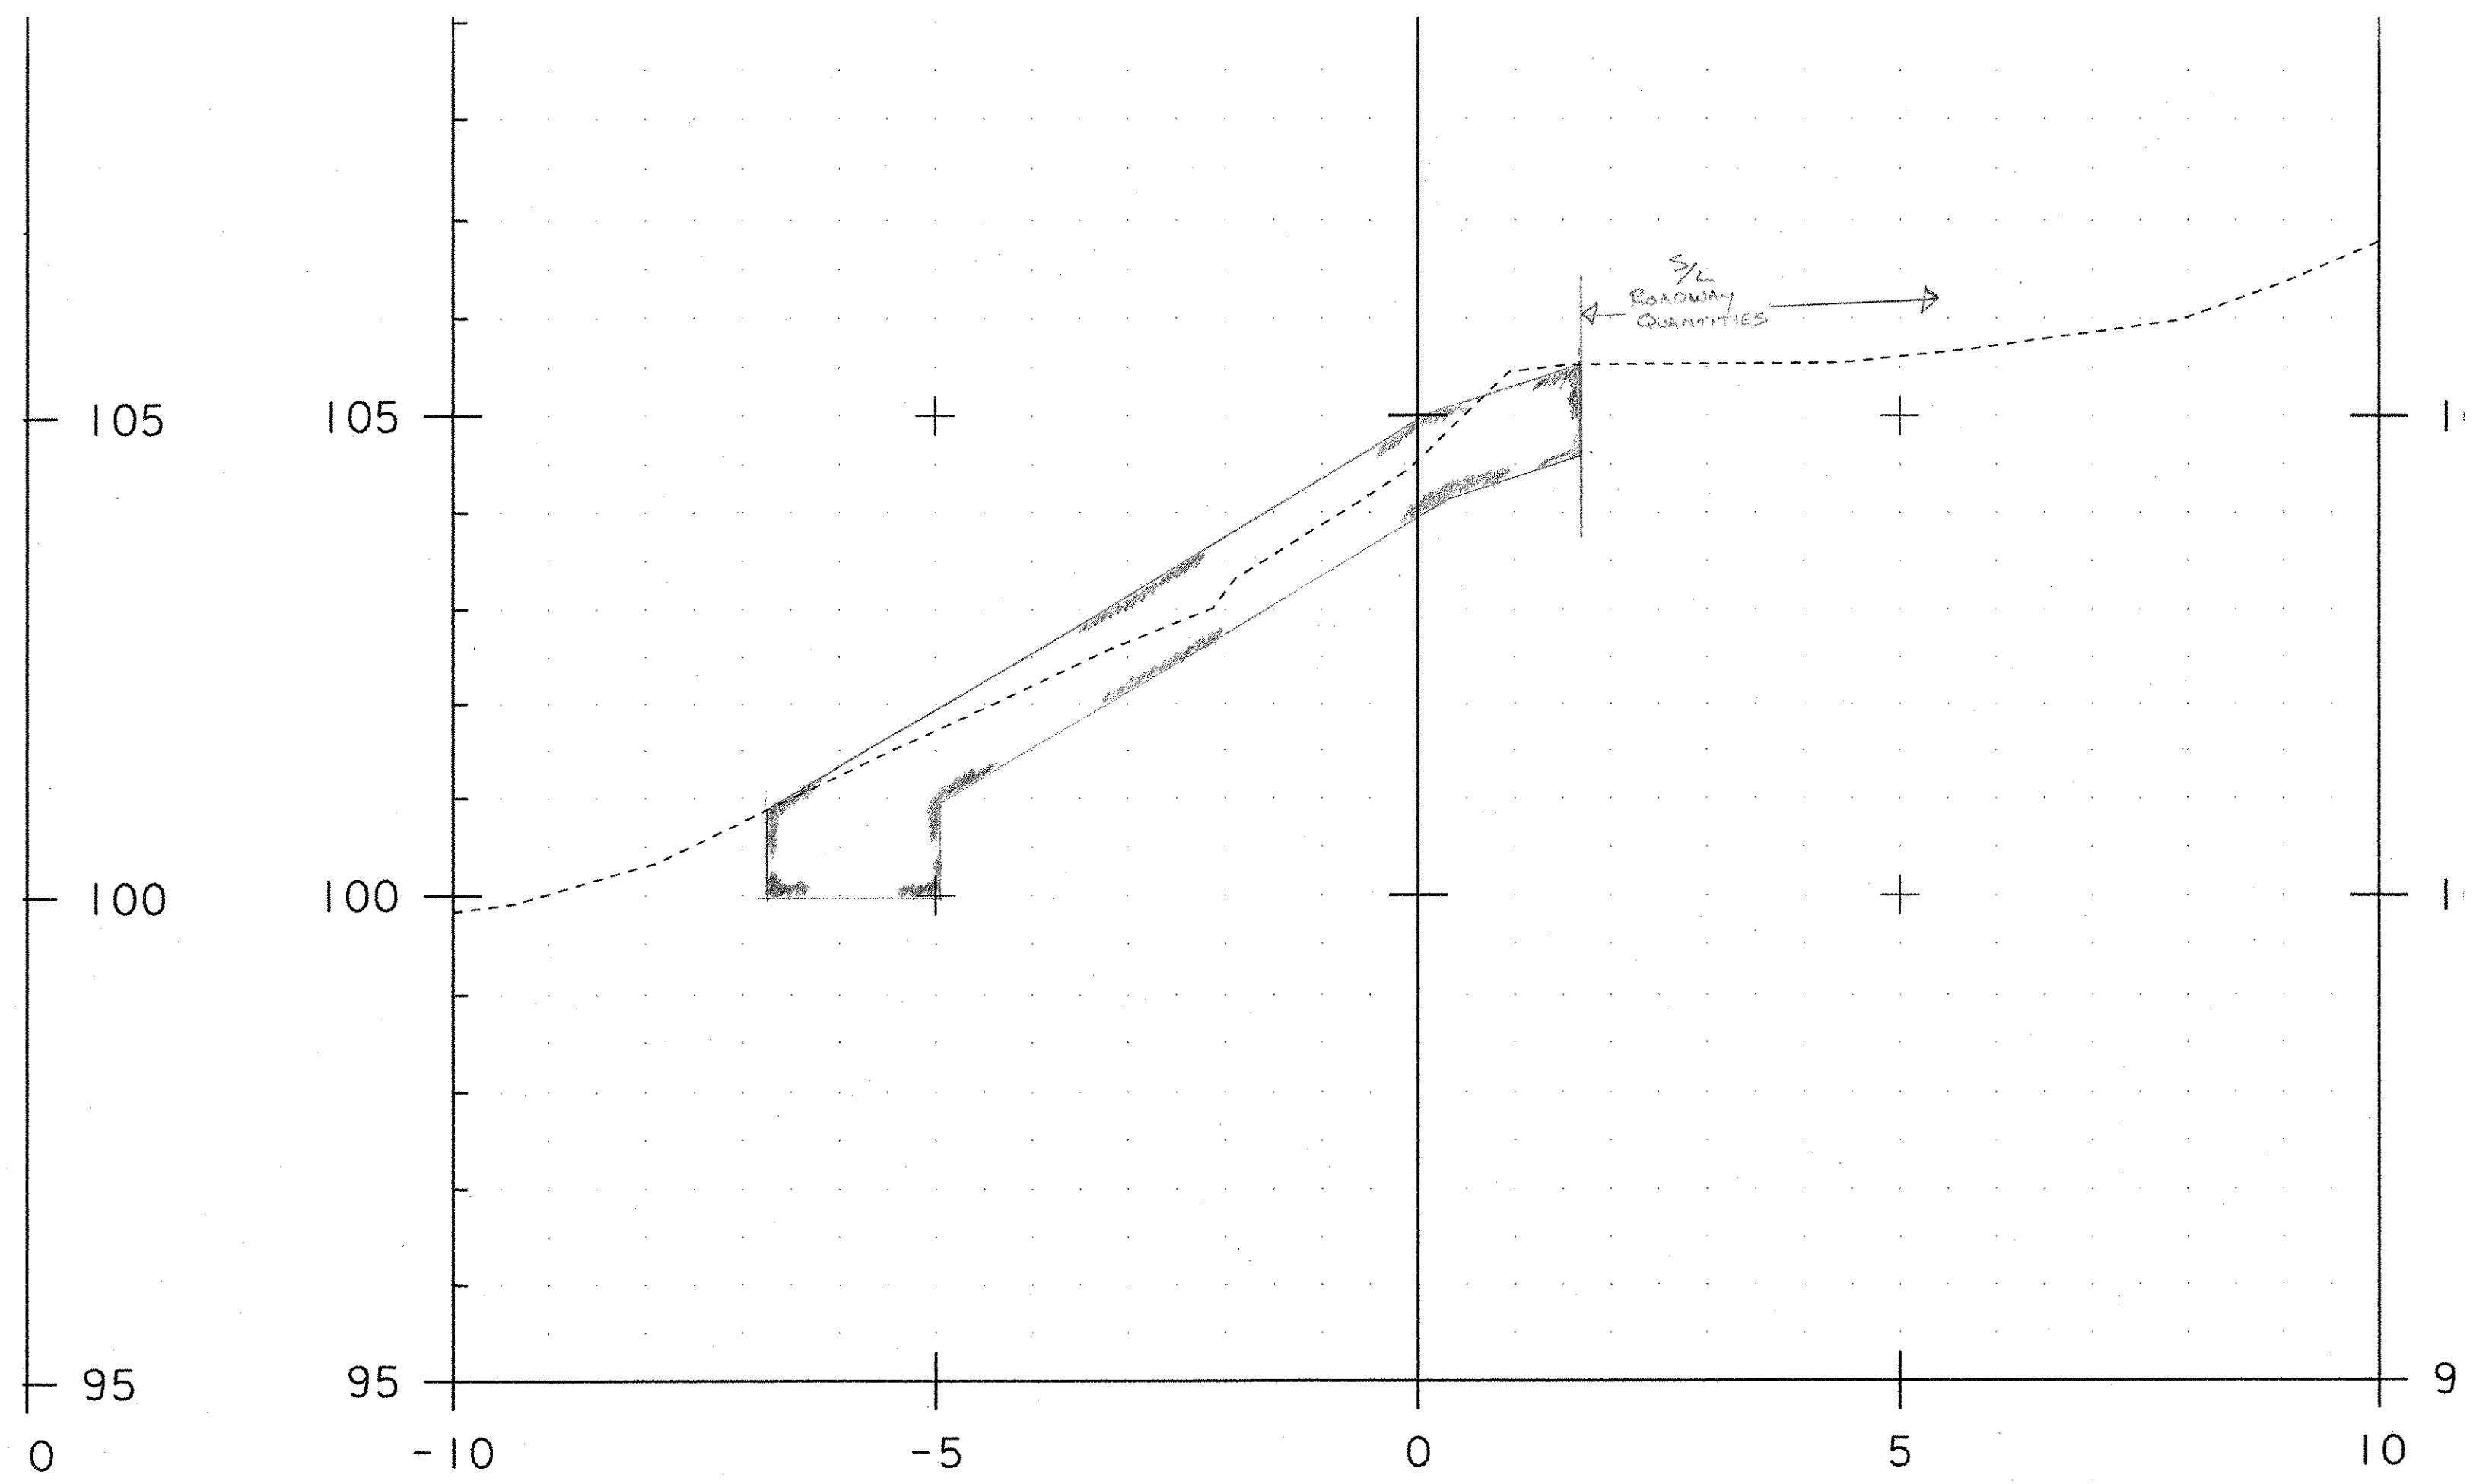

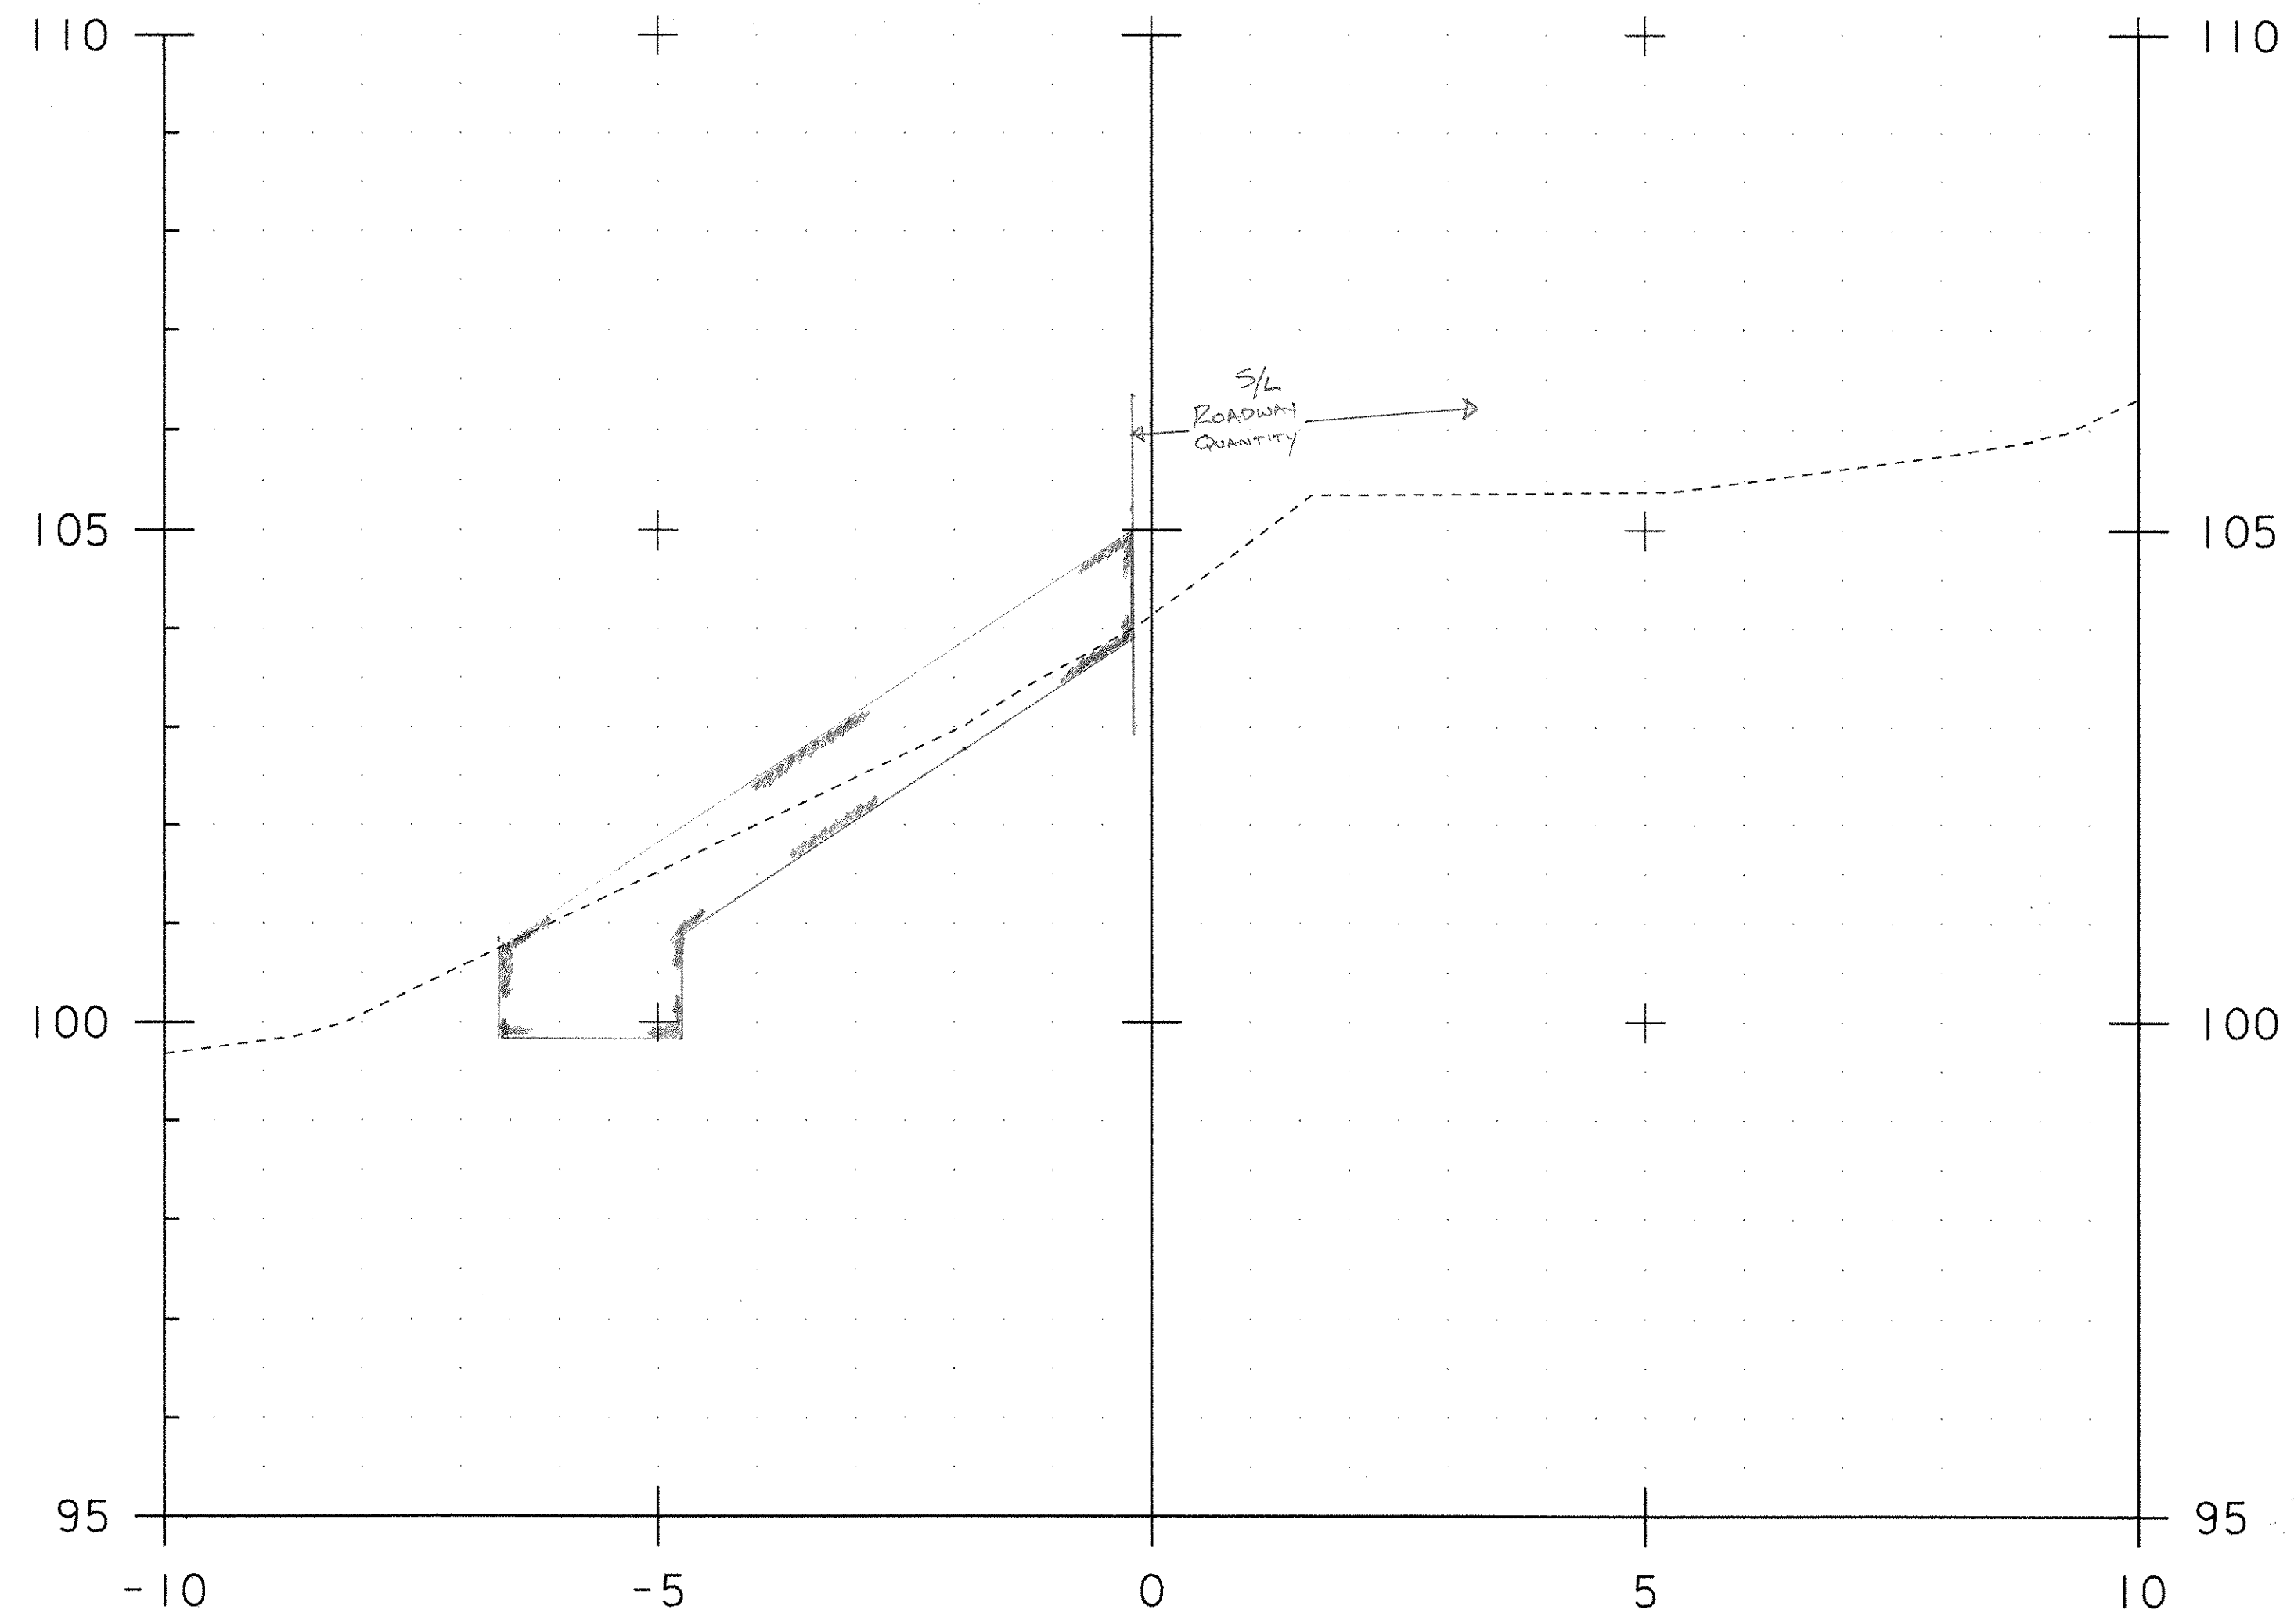

10+010.00

(BUTT) STONE FILL TYPE III - 7.81M²

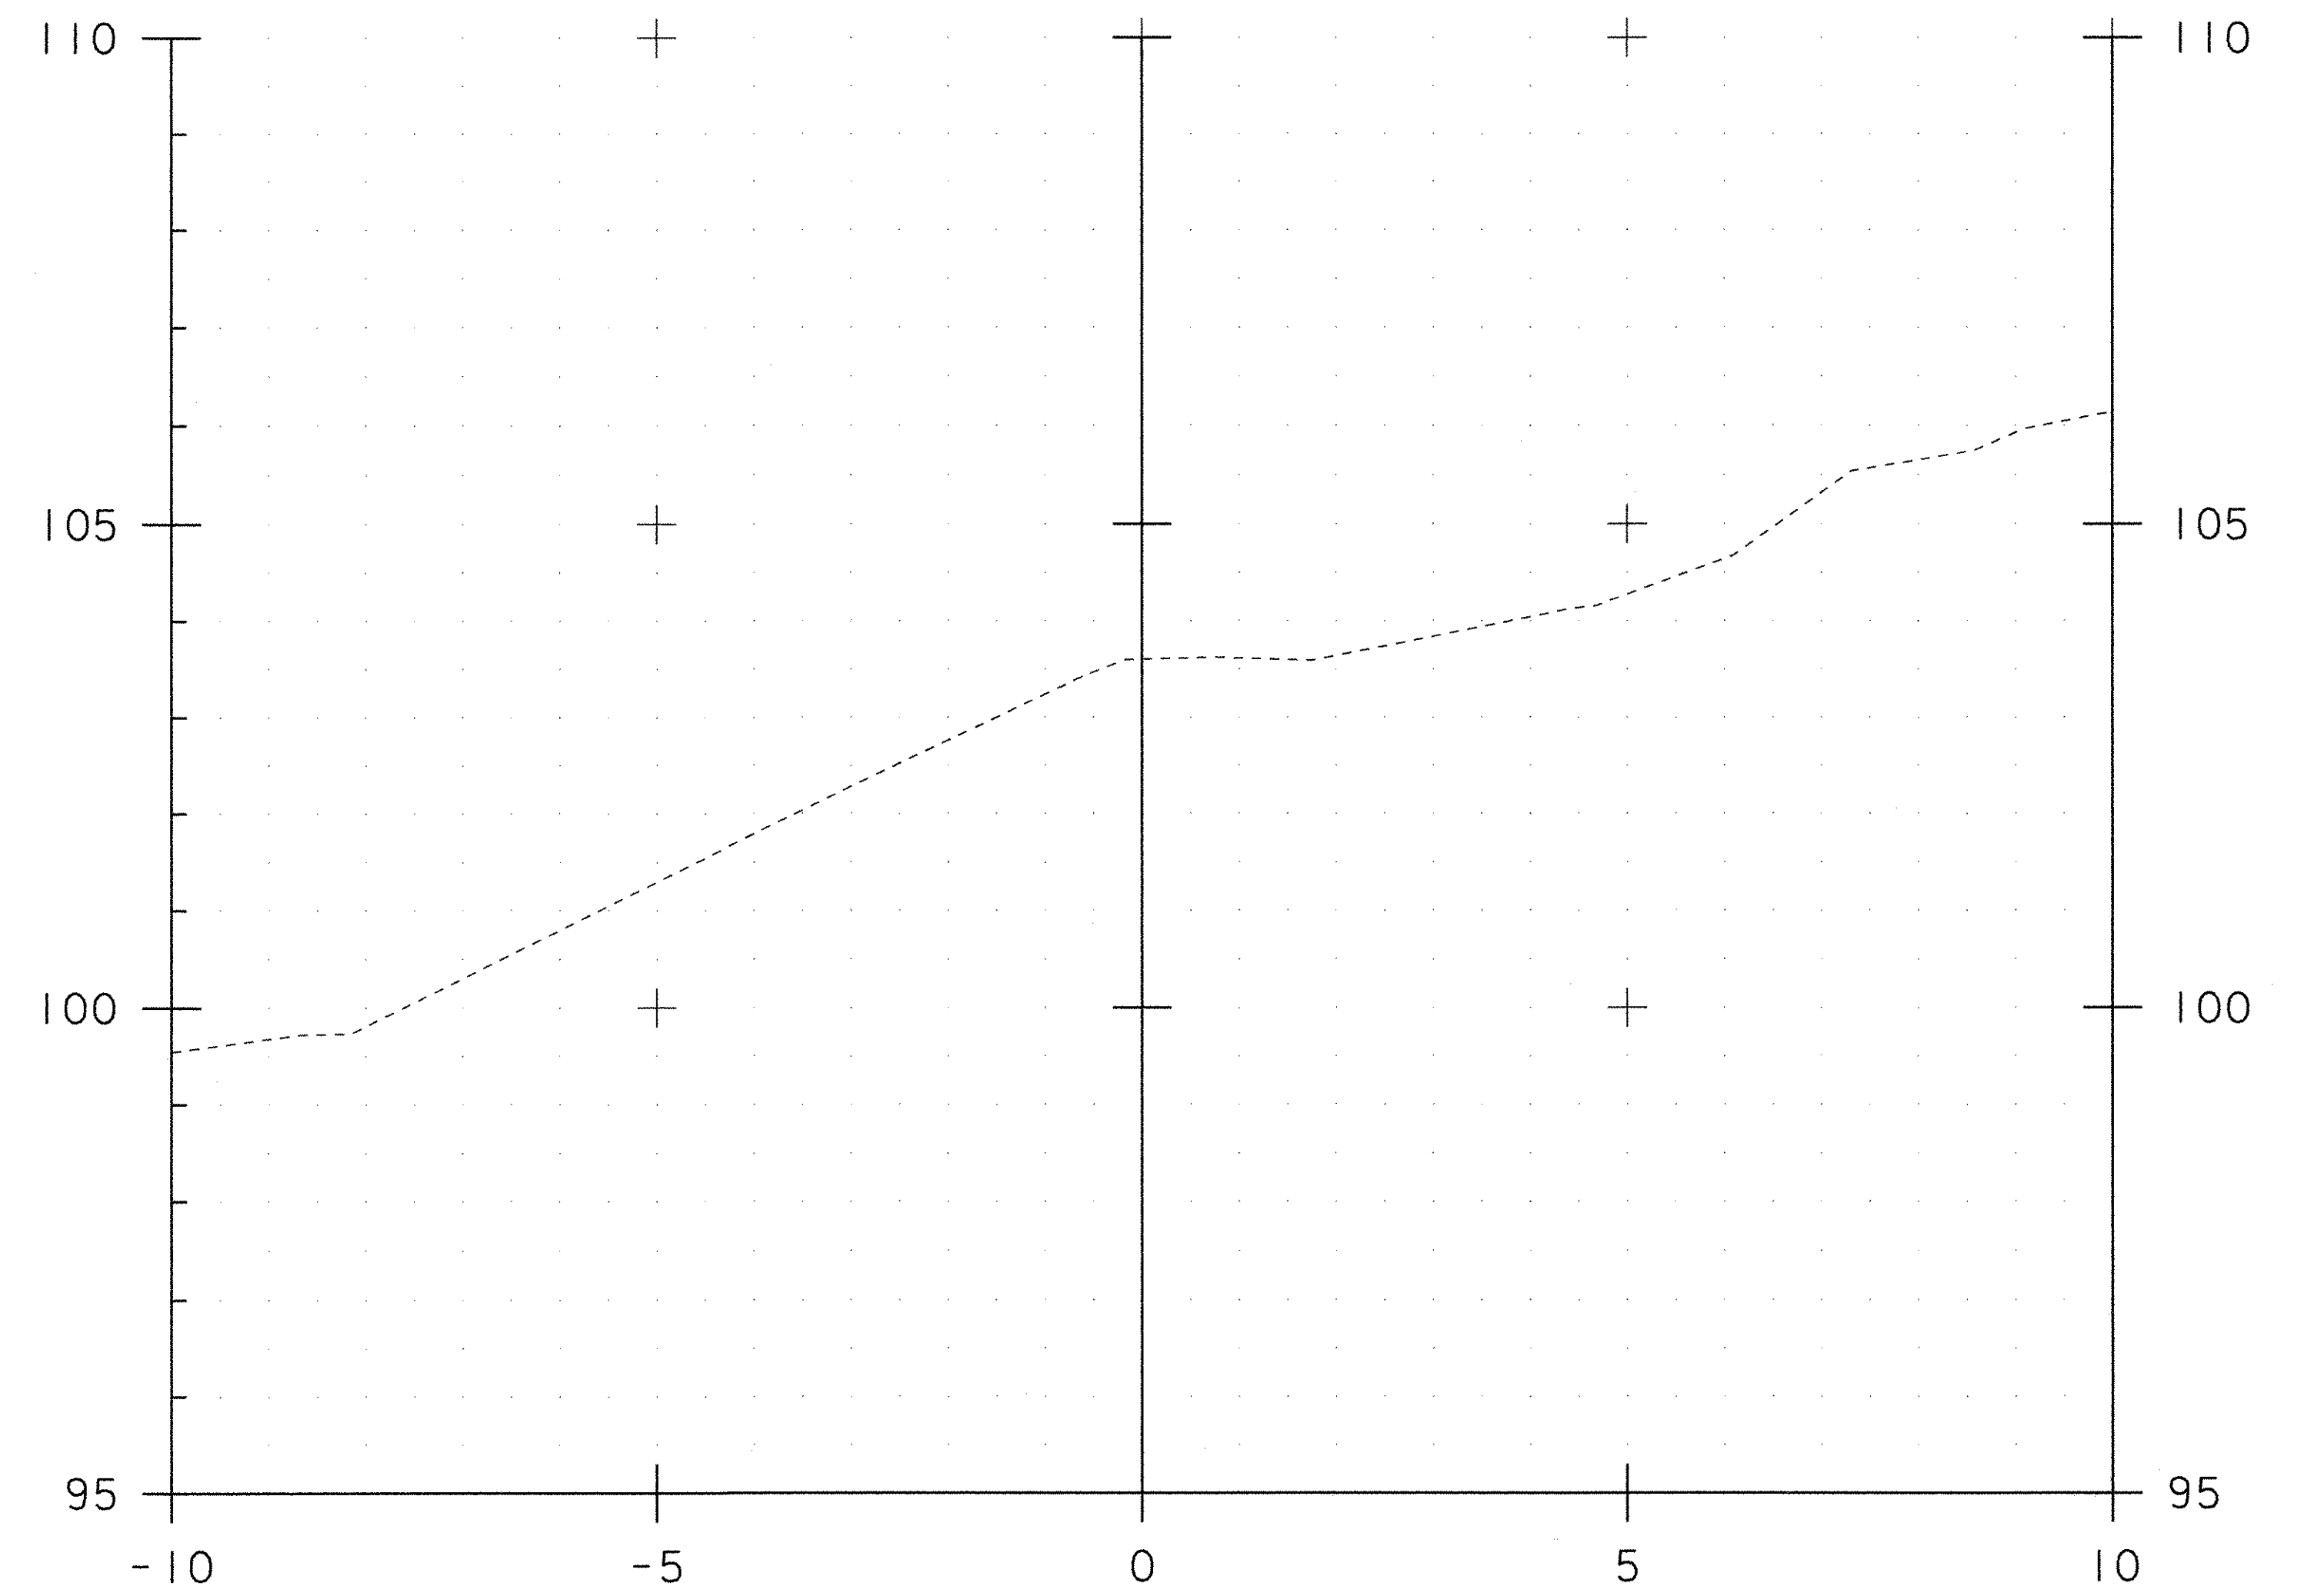

10+012.00

PROJECT NAME:	Leicester	PLOT DATE:	01-NOV-2005
PROJECT NUMBER:	BRF 0160(3)S	DRAWN BY:	R. Bullock
FILE NAME:		CHECKED BY:	
PROJECT LEADER:		SHEET 8	OF 8
DESIGNED BY:			

13
AB2

STATE OF VERMONT
AGENCY OF TRANSPORTATION
AC BRF 0160 (3)S
LEICESTER, VT.

COSMEC, INC.
70 SOUTH STREET
WALPOLE, MA 02081
PH# 508-668-6600
FAX# 508-660-1022

EMS-QC-110 VAO
RECEIVED
OK'D BY _____ OK'D BY JWC
JAN 0 6 2006
RESUBMIT _____ APPROVED V
BY REW DATE 02-06-06

ENGINEERING AND MANUFACTURING STANDARD
PTFE FACING AND STEEL
OR PREFORMED FABRIC SUBSTRATE
SURFACE PREPARATION AND ADHESIVE PROCEDURE

The PTFE facing shall be prepared for bonding to a substrate material by chemically etching the face to be bonded using the sodium ammonia process.

The mating surface of the substrate shall be prepared for bonding using a three-step process as follows:

1. preliminary degrease using methyl ethyl ketone.
2. mechanically roughen to approx. 125 RMS and thoroughly brush and clean for final degreasing.
3. final degrease using methyl ethyl ketone

The PTFE and substrate mating surfaces shall be clean and dry with final degreasing performed within 30 minutes of bonding. Adhesive shall consist of a two-part epoxy adhesive system conforming to Military Specification MMM-A-134

The adhesive shall be applied to the full area of the contact surface in an even manner so as to establish a glue line not less than .002 inch nor more than .010 inch thick. Surfaces being bonded are to be assembled immediately with open assembly time not to exceed 20 minutes.

The PTFE material shall be greater in width and length than the substrate material by at least 1/4 inch when bonded. The PTFE shall be applied with contact starting at one edge and with contact progressing across entire bonded surface to eliminate air entrapment. The PTFE is to be in full contact with the steel or preformed fabric substrate. Curing of the bond shall be done under pressure of approx. 2-100 psi for 10-12 hours at approx. 70°F or other schedules as established by the manufacturer of the adhesive.

The PTFE shall be carefully trimmed to the same size as the substrate after bond curing and all bonds shall be visually inspected for bond retention.

132
B.B.

STATE OF VERMONT
AGENCY OF TRANSPORTATION
AC BRF 0160 (3)S
LEICESTER, VT.

COSMEC INC.

WELDING PROCEDURE SPECIFICATION

SPECIFICATIONS AND CODE: D1.8 (D1.3)
MATERIAL SPECIFICATION ASTM A240 TYPE 304 TO ASTM A709 GR 50W
WELDING PROCESS-----GTAW
MANUAL OR MACHINE-----MANUAL
POSITION OF WELDING-----1F & 2F
FILLER METAL SPECIFICATION ER309L CLASSIFICATION: A5.9
MANUFACTURER: HARRIS WELCO TRADENAME:
FLUX-----INTERNAL FLOW RATE 45 CFH
SHIELDING GAS-----ARGON
SINGLE OR MULTIPLE PASSES SINGLE
SINGLE OR MULTIPLE ARC SINGLE
WELDING CURRENT-----DC
POLARITY: REVERSE (EN)
WELDING PROGRESSION-----
ROOT TREATMENT-----CLEANED & PREPARED BRIGHT METAL
PREHEAT AND INTERPASS TEMPERATURE-----SEE BELOW
POSTHEAT TEMPERATURE N/A
HEAT INPUT MIN-----MAX-----

WELDING PROCEDURE

PASS NO.	ELECTRODE SIZE	WELDING CURRENT AMPERES	TRAVEL SPEED VOLTS	JOINT DETAIL
ALL	3/32"	130-155	14-17	LAP JOINT
		18 GA THRU 10 GA BM THICKNESS		

PREHEAT TEMPS.
THICKNESS
UP TO 3/4" 100 DEG.
OVER 3/4" TO 1 1/2" 100 DEG.
OVER 1 1/2" TO 2 1/2" 100 DEG.
OVER 2 1/2" 100 DEG.

***PREHEAT UNTIL NO MOSITURE PRESENT
OK'D BY _____ OK'D BY *Jwe*
JAN 06 2006
RESUBMIT _____ APPROVED ✓
BY *RW* DATE *02-06-06*

THIS PROCEDURE MAY VARY DUE TO FABRICATION SEQUENCE, FIT-UP, PASS SIZE, ETC.
WITHIN THE LIMITATION OF VARIABLES GIVEN IN SECTION 5.



SUPPORTING PQR: GTAW-WF-05
PROCEDURE NO. GTAW-WF

CONTRACTOR: COSMEC INC.
AUTHORIZED BY: DONALD VOSE
CW#:01100651 *Donald Vose*

REVISION NO. 1

DATE: 2/1/2005





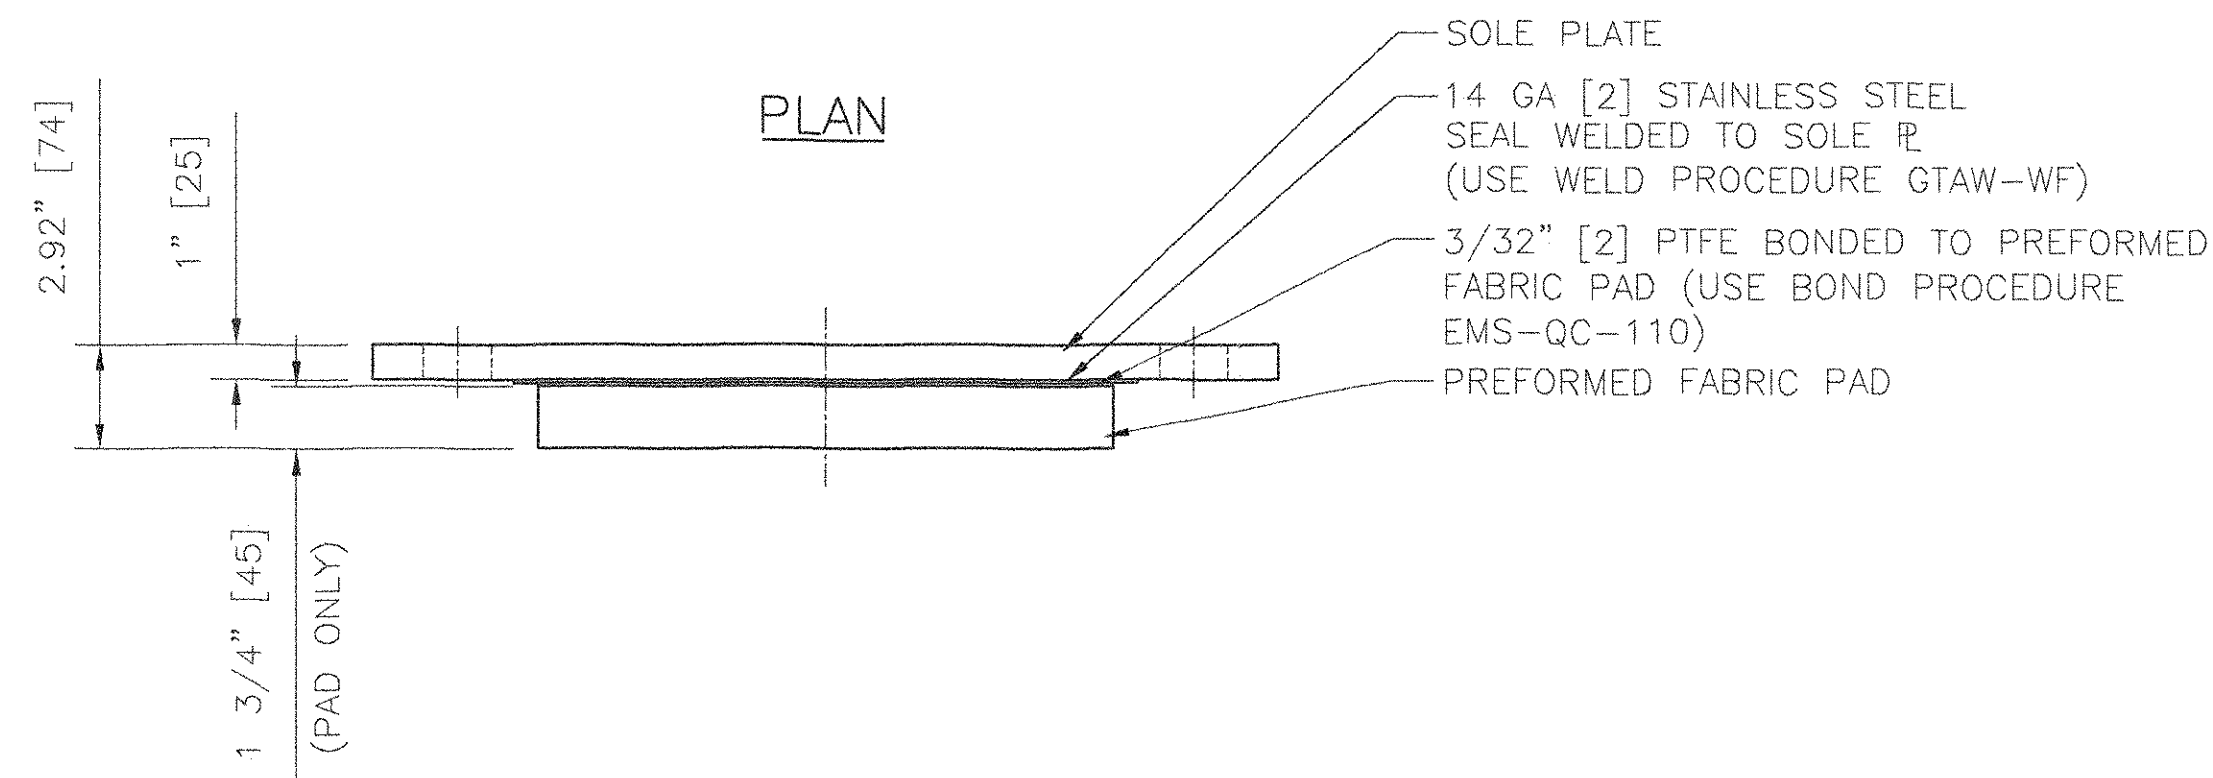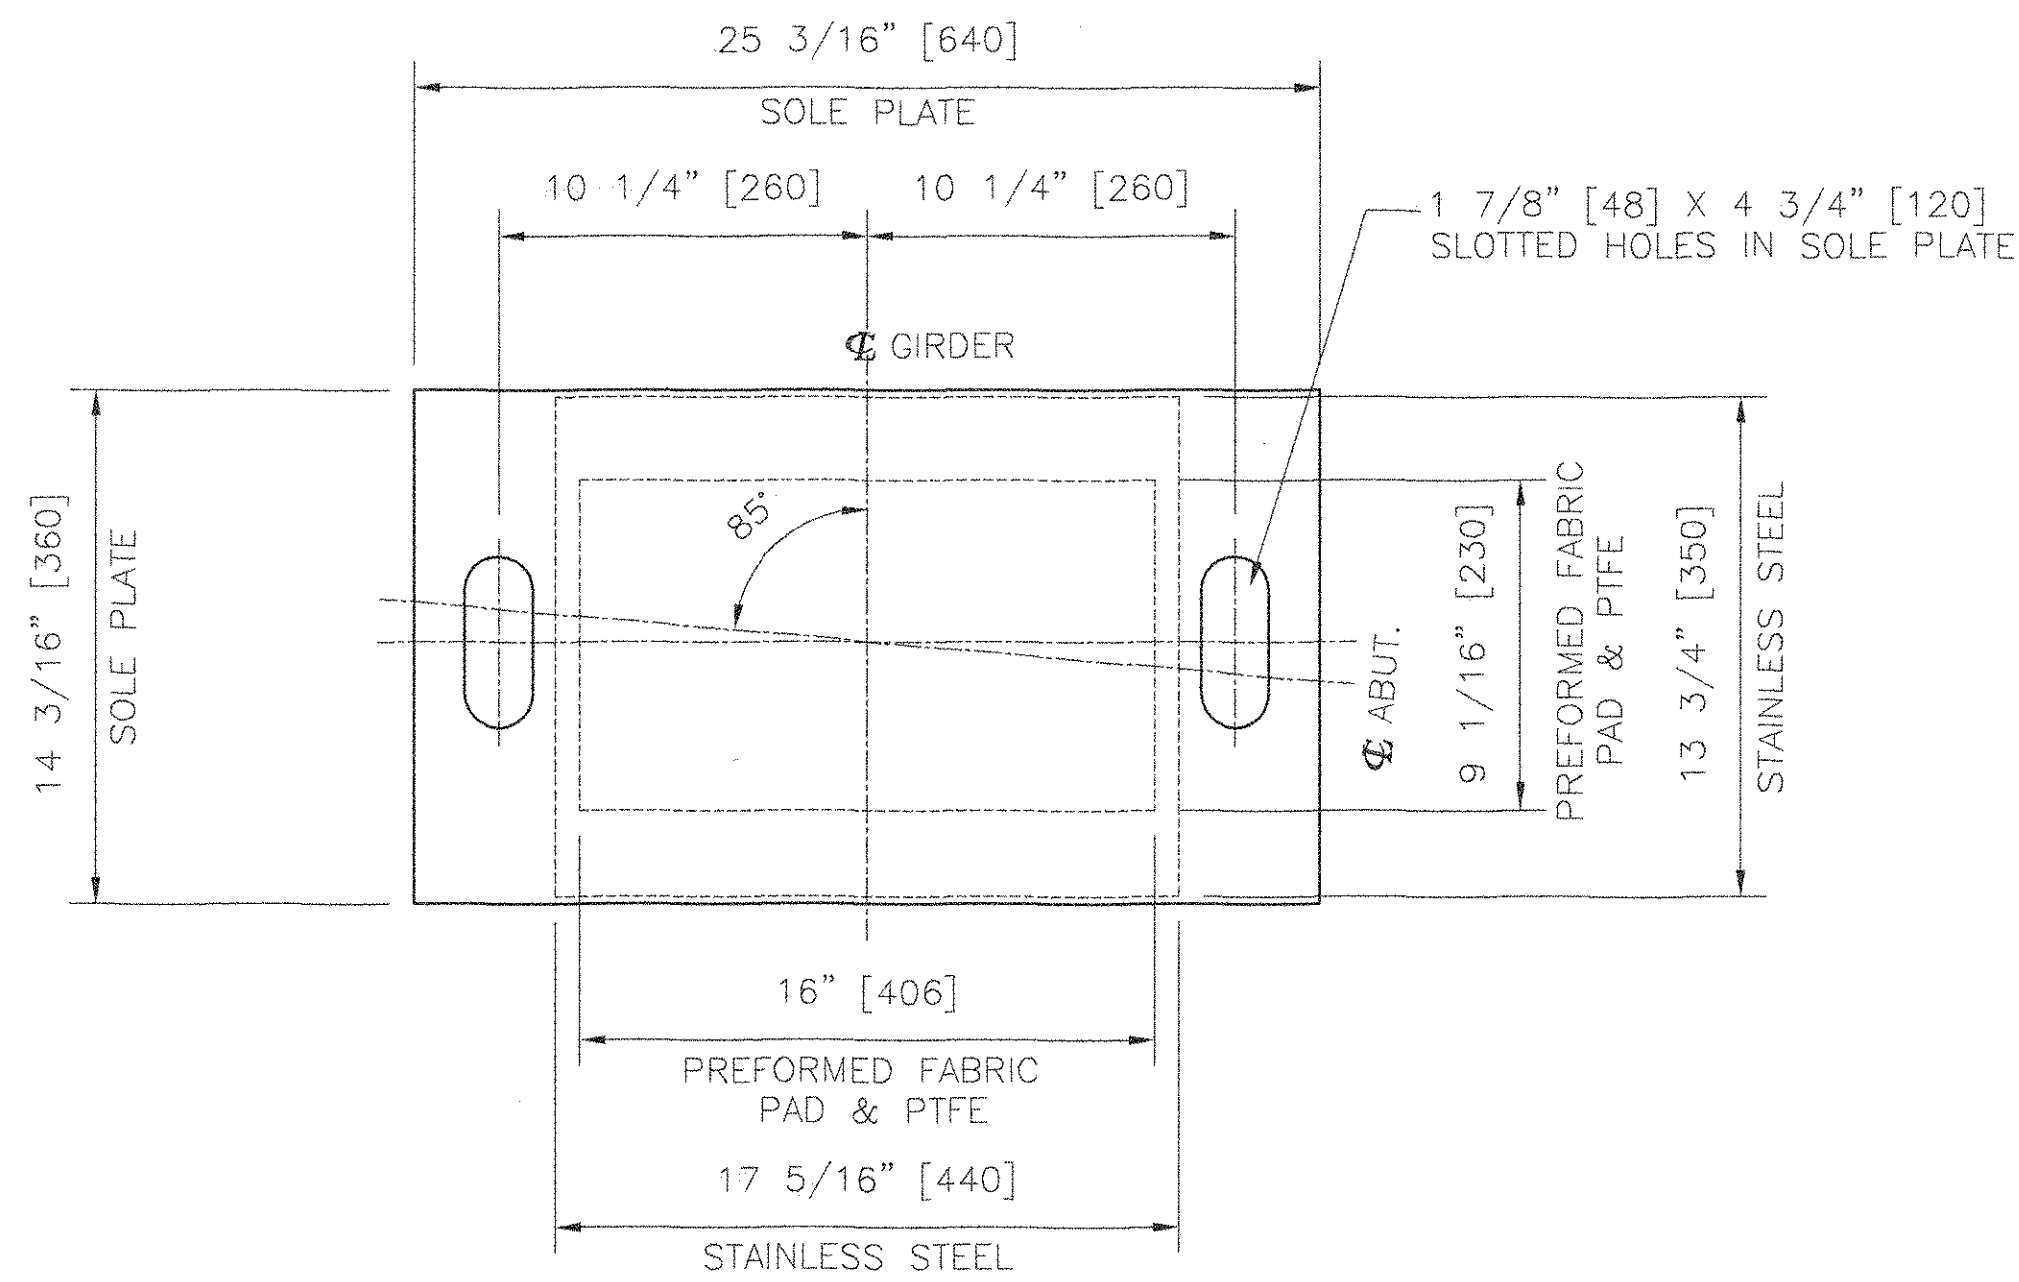

FRONT ELEVATION

**COSMEC EXPANSION
FABRIC PAD BEARING**


LOCATION: ABUTMENT NO.1
QUANTITY: 5

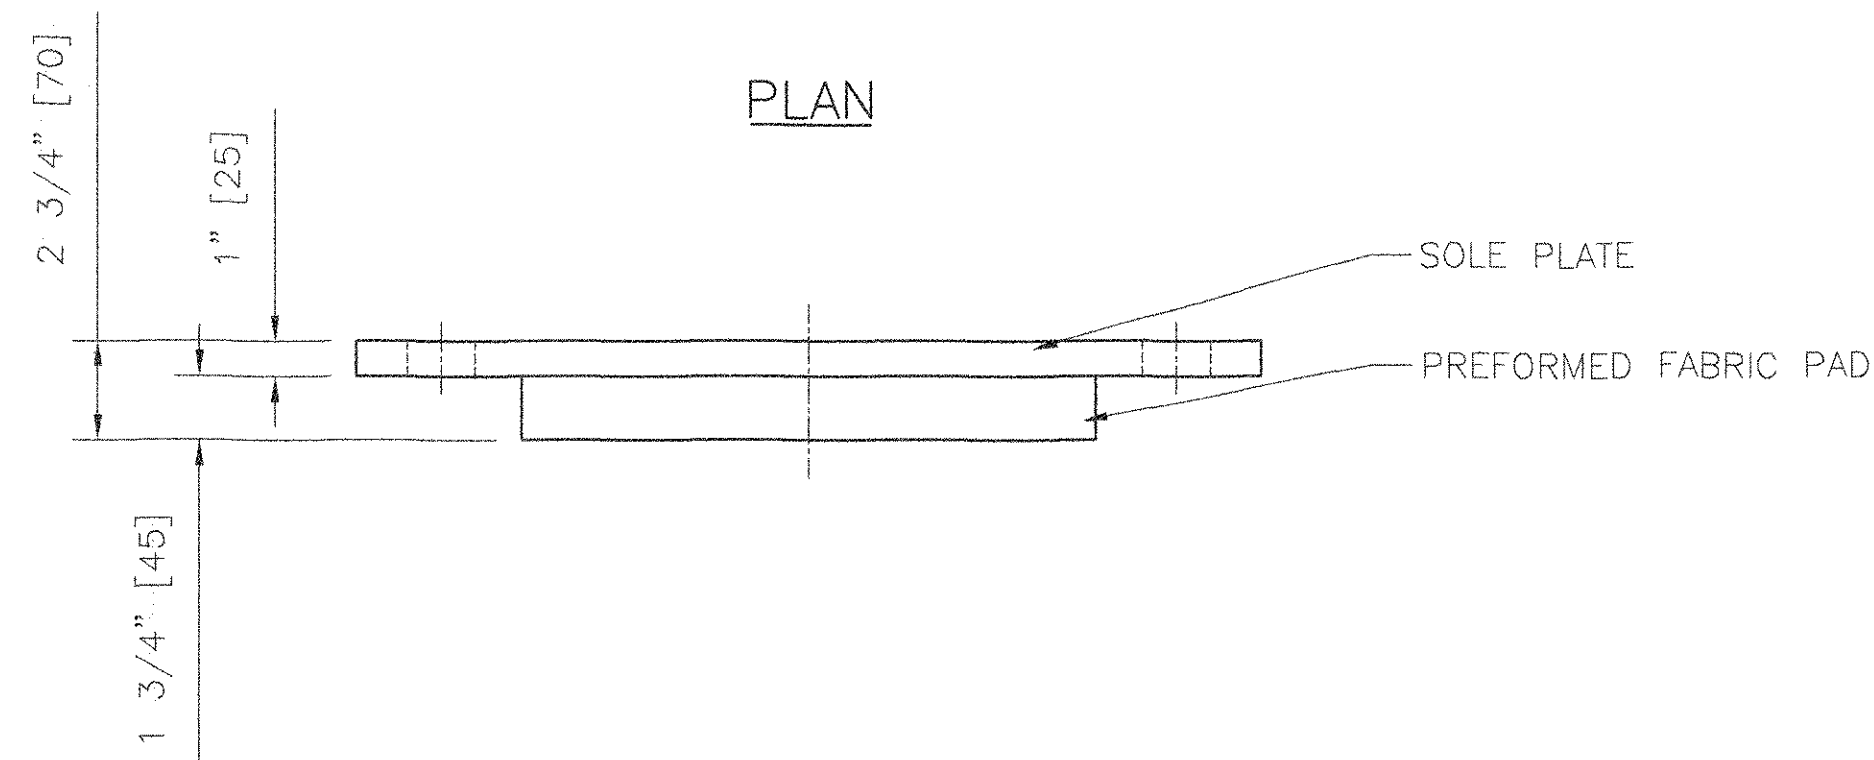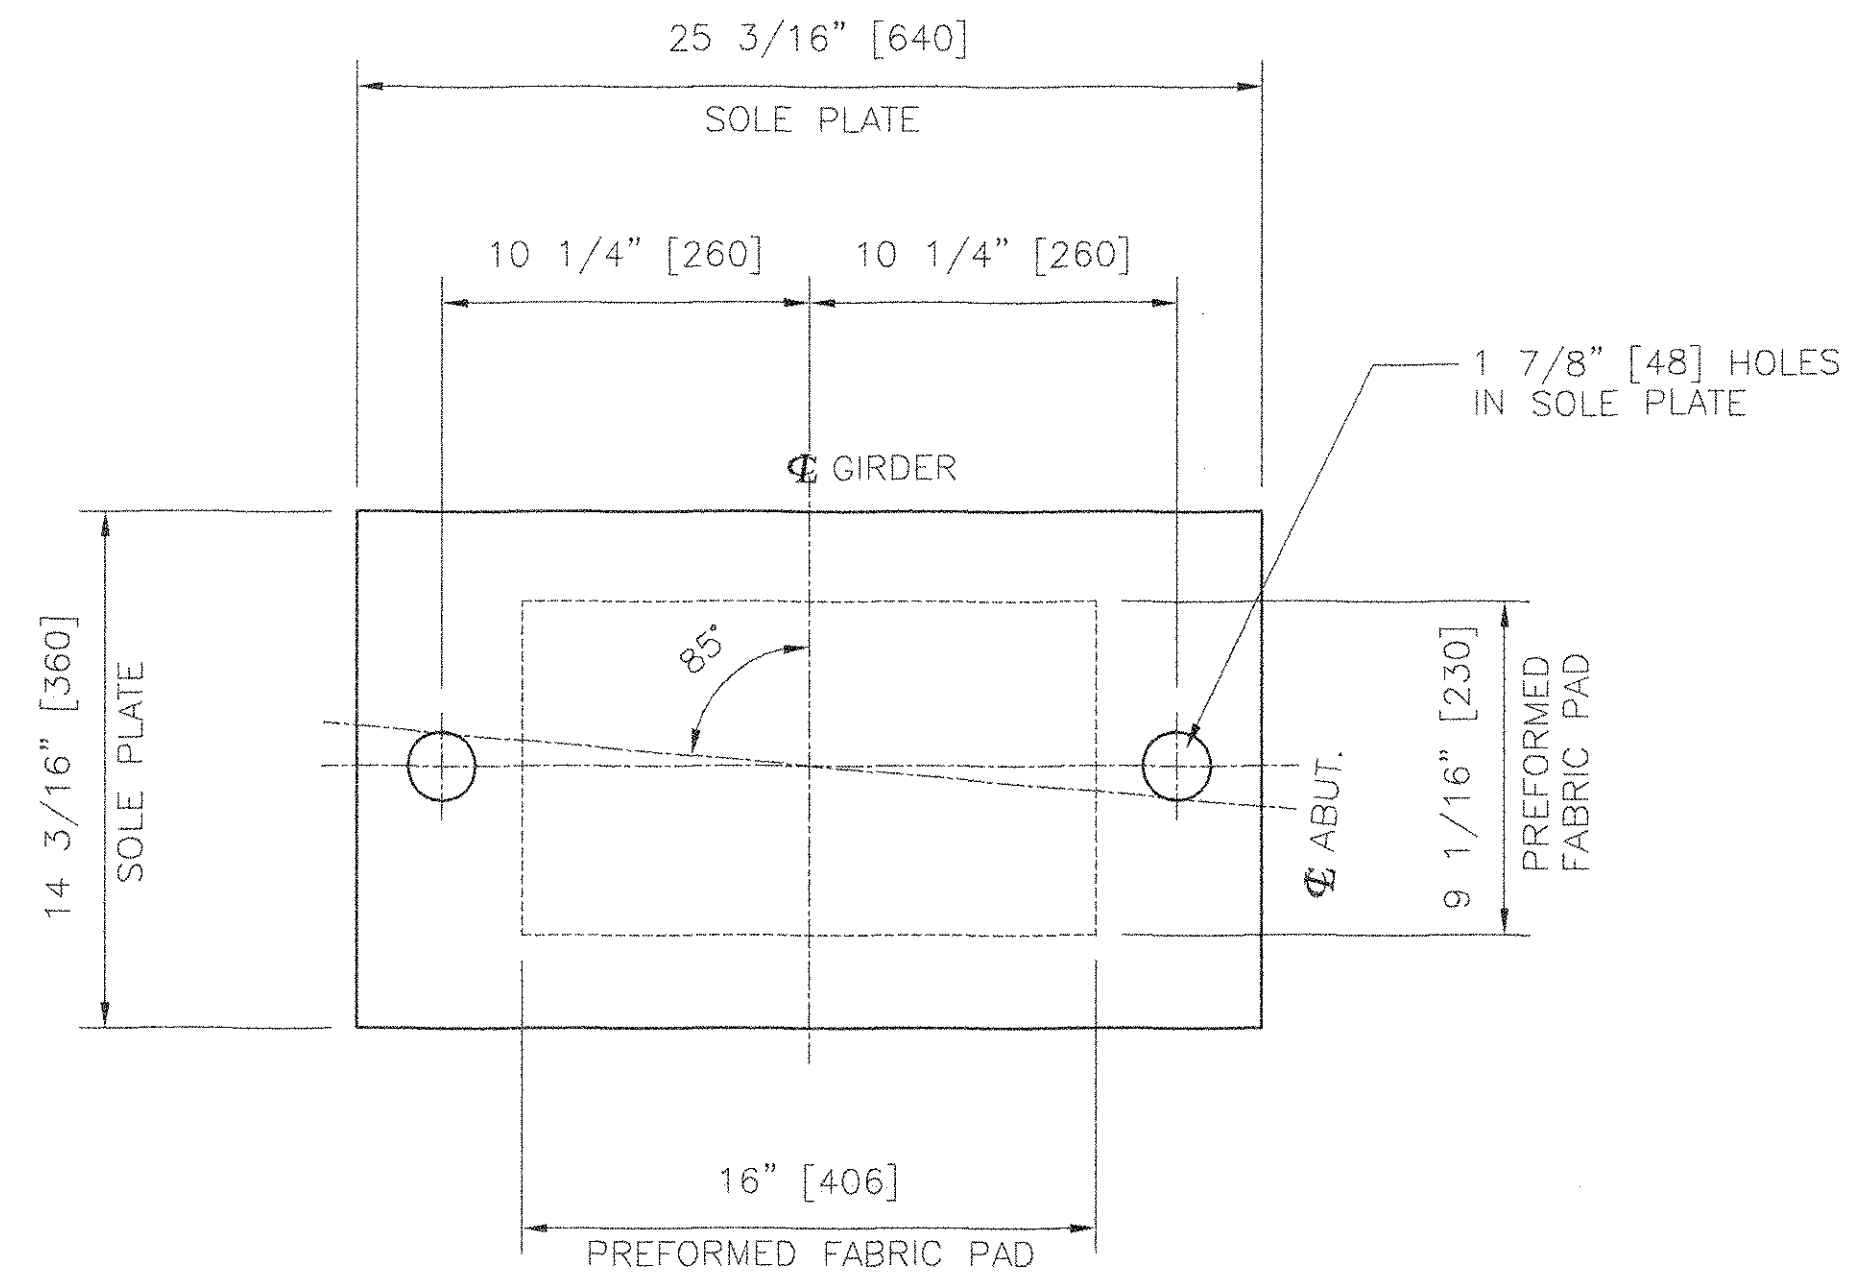

FRONT ELEVATION

**COSMEC FIXED
FABRIC PAD BEARING**

LOCATION: ABUTMENT NO.2
QUANTITY: 5

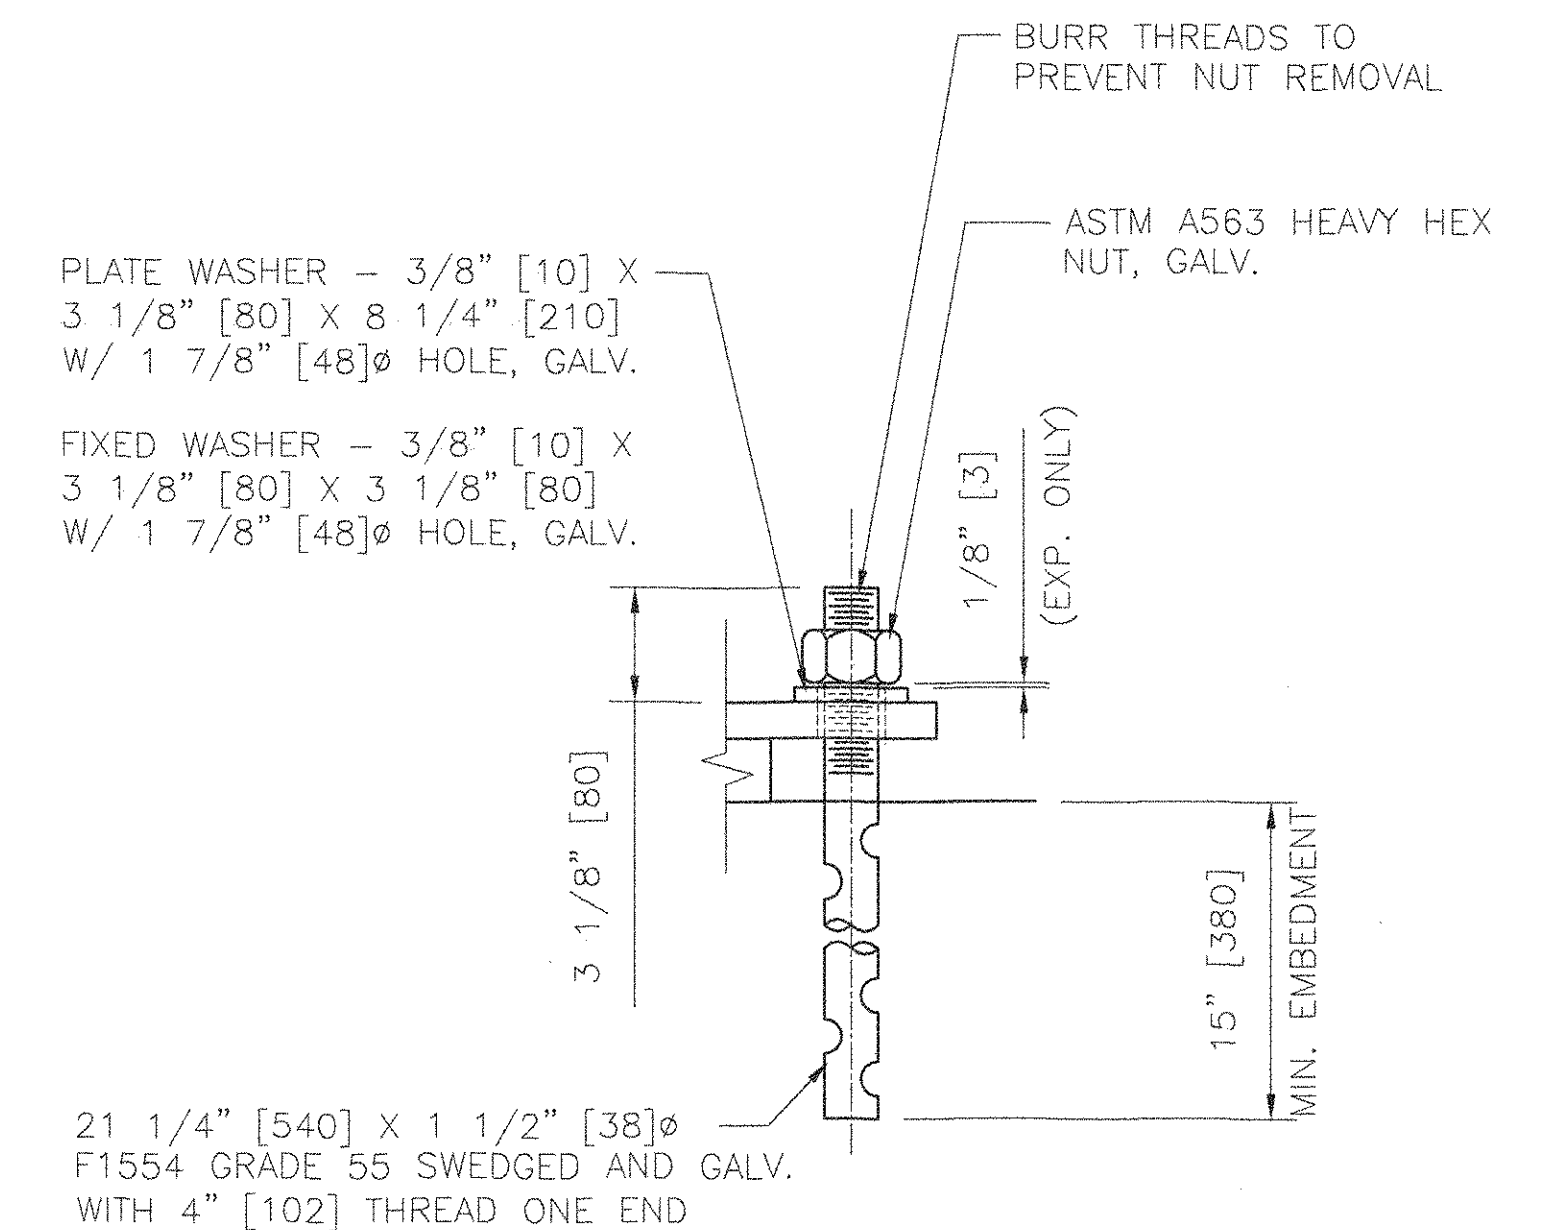

ANCHOR BOLT DETAIL

BEARING NOTES:

- ALL MATERIALS USED IN THE FABRICATION OF THESE BEARINGS SHALL BE MADE IN THE U.S.A.
- BEARINGS ARE TO BE SHIPPED AS COMPLETE UNITS, STEEL BANDED, AND SHALL BE WRAPPED TO PROTECT FROM MOISTURE AND DIRT DURING TRANSIT AND STORAGE.
- LOCATION OF FABRICATION PLANT - 70 SOUTH STREET WALPOLE, MA 02081
- COSMEC, INC. REPRESENTATIVE - MR. MATT McANDREWS (508) 668-6600
- BEARINGS SHALL BE STORED IN A CLEAN, DRY, LEVEL UPRIGHT POSITION.

MATERIALS:

STEEL - ASTM A709, GR. 36 ZINC METALLIZED & SEALED
 1/16 INCH RADIUS ON ALL EDGES
 STAINLESS STEEL - A240, TYPE 304 MIRROR FINISH OF LESS THAN
 10 MICRO INCHES RMS
 PTFE - ASTM D4894
 PREFORMED FABRIC BEARING PAD - AASHTO 18.4.9.1
 ANCHOR BOLTS - SEE DETAIL

VAOT
RECEIVED
OK'D BY MKH OK'D BY *all*
JAN 06 2006
RESUBMIT APPROVED AS NOTED
BY *RLW* DATE 2/7/06

Structures Eqy

STATE OF VERMONT
AGENCY OF TRANSPORTATION
AC BRF 0160 (3)S
LEICESTER, VT.

COSMEC, INC. 70 SOUTH STREET WALPOLE, MA 02081

SCALE: 3/16"=1" DRAWN BY: MRR CHECKED BY: MCM
DATE: 12-21-05 DATE: 12-30-05

COSMEC FABRIC PAD BEARINGS

REV.	BY	DATE	OK'D	DATE	S.D. NUMBER	DRAWING NUMBER	REV.
					CUSTOMER	BLOW & COTE, INC.	
					60452	4567	

PLS B.B.

Casco Bay Steel Structures, Inc.

75 Spring Hill Road
Saco, Maine 04072

Phone: (207) 282-7360


Fax: (207) 282-1179

WELDING PROCEDURE SPECIFICATION

Welding procedure specification ASTM A5.1 G28-50-50W (250-345-345W)
 welding process Submerged Arc Welding - Auto (SAW)
 manual or machine Machine
 position of welding Flat (H) Horizontal (H)
 filler metal specification AWS A5.17, AWS A5.23
 filler metal classification E80A-E81H-M11 Lincoln
 flux 960 Flux-Lincoln Weld - LA-75 Electrode
 in shielding gas Ar Flow rate N/A
 single or multiple pass Single
 single or multiple arc Single
 welding current Direct
 polarity Reverse Electrode Positive
 welding progression Meet AWS Specification
 root treatment Meet AWS Specification
 preheat and interpass temperature 30(19) to 40(40) 2/2(9) 1/2(8) 20(60) 1/4(6) 1/8(3) 1/16(2)
 postheat temperature A
 heat input Min 41.65 Max 65.45 PQR # 1-59.5 Vermont AGT
 Leicester, B#6
 Proj # BRF0160325
 CBSS 285

WELDING PROCEDURE


Pass no.	Electrode size	Welding current		Travel speed	Joint detail
		Amps	Volts		
5/32	605 544.5 TO 665.5	29.5	18.5	AWS D1.5 1F	Filet
		27.4	15.3		
		31.56	20.7		
3-9	Metric 605 544.5 TO 665.5	29.5	459.2	AWS D1.5 2F	Filet
		27.4	389.6		
		31.56	529.8		

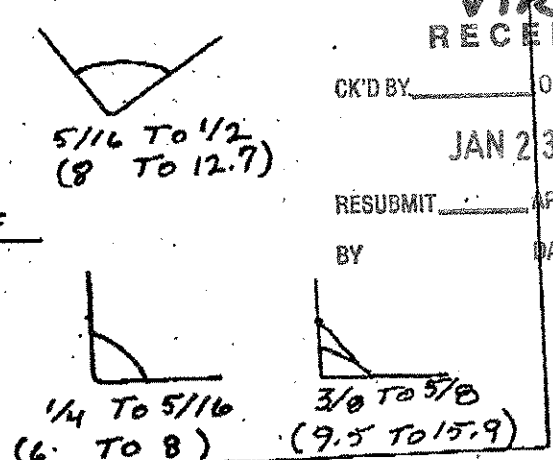

VTRANS RECEIVED
 OK'D BY: [Signature] OK'D BY: [Signature]
 JAN 23 2006
 RESUBMIT APPROVED BY: [Signature]
 DATE 02-06-06

This procedure may vary due to fabrication sequence, fit-up, pass size, etc., within the limitation of variables given in applicable A.W.S. codes or contract specifications

Procedure no. 201 Contractor Casco Bay Steel
 Revision no. 1 Authorized By P. E. Doolittle
 Date 3/2/00

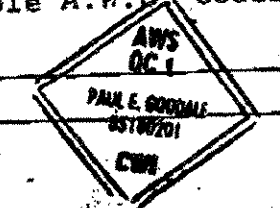

Casco Bay Steel Structures, Inc.

75 Spring Hill Road
Saco, Maine 04072

Phone: (207) 282-7360

Fax: (207) 282-1179

WELDING PROCEDURE SPECIFICATION

Material specification ASTM A36 (280-345-345W)
 Welding process Submerged Arc Welding - Auto (SAW)
 Manual or machine Auto
 Position of welding Flat (10)
 Filler metal specification AWS A5-23 OK'D BY _____ OK'D BY JWC
 Filler metal classification E70T1-Ni Linear
 Flux 960 Flux - Lincoln Flow rate As A JAN 23 2008
 Shielding gas As A REGRUBMIT _____ APPROVED _____
 Single or multiple pass Single BY _____ DATE 01-06-
 Polarity Reverse Electrode Positive
 Welding progression _____
 Root treatment As per AWS Specification
 Preheat and interpass temperature As per AWS Specification
 Postheat temperature As per AWS Specification
 Heat input Min 41.65 Max 65.45 PAR 1-59.5 VERMONT A.C.T. LEICESTER 01*6
 Proj # BRF 0160305
 C.B.S.S. 285

WELDING PROCEDURE

Pass no.	Electrode size	Welding current		Travel speed	Joint detail
		Amperes	Volts		
5/32	605	29.5	18.5	18.5 15.3 20.7	
	544.5	27.4	15.3		
	665.5	31.56	20.7		
3/9	605	29.5	45.72	45.72 388.6 525.8	
	544.5	27.4	388.6		
	665.5	31.56	525.8		

This procedure may vary due to fabrication sequence, fit-up, pass size, etc., within the limits of variables given in applicable A.W.S. codes or contract specifications.

Procedure no. 202

Revision no. _____

Form III-2

Contractor Casco Bay Steel
 Authorized By Tom R. Chandler
 Date 3/2/00

13655

Casco Bay Steel Structures, Inc.

75 Spring Hill Road
Saco, Maine 04072

Phone: (207) 282-7360

Fax: (207) 282-1179


WELDING PROCEDURE SPECIFICATION

Material specification ASTM A572 Gr 50-50w (250-345-345w)
 Welding process Submerged Arc welding - AUTO (SAW)
 Manual or machine Machine
 Position of welding Flat (i.s.a.)
 Filler metal specification AWS A5-17 AWS A5-23 Lincoln
 Filler metal classification E702-E7018-011 Electrode
 Flux 66 Flux Lincoln Weld - LA-75 Electrode
 Shielding gas None
 Single or multiple pass both
 Single or multiple arc single
 Welding current Direct
 Polarity Reverse Electrode Positive
 Welding progression Direct AWS Specification
 Root treatment None
 Preheat and interpass temperature To 419°C (785°F) 3/4" (19mm) - 90°C (200°F)
 Postheat temperature None
 Heat input Min 41.65 Max 65.45 PAR 1-59.5
 VERMONT AGT
 LEICESTER-076
 Proj #BRF016005
 CBSS 285

RECEIVED
 JAN 23 2006
 APPROVED
 DATE 02-06-06

WELDING PROCEDURE

(Metric)

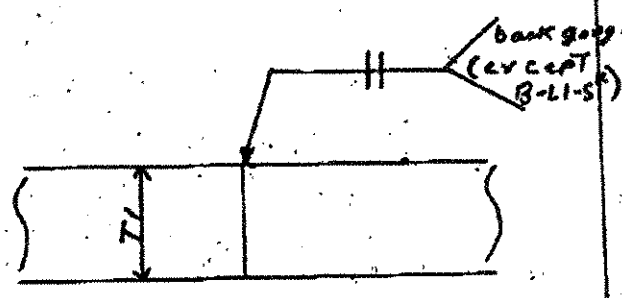Pass no.	Electrode size	Welding current		Travel speed
		Amps	Volts	
5/32	605	29.5	18	AWS D1.5 Joint detail B-11.5, B-11a-5 
	544.5	27.4	15.3	
	665.5	31.56	20.7	
3/8	605	29.5	457.2	T1 = 3/8 (9.5) B-11.5 T1 = 5/8 (15.875) B-11a-5 *Evidence of C.U.P. is req.
	544.5	27.4	388.6	
	665.5	31.56	525.8	

This procedure may vary due to fabrication sequence, fit-up, pass size, etc., within the limitation of variables given in applicable A.W.I. codes or contract specifications.

Procedure no. 203
 Revision no. _____
 Form 11-2
 Contractor Casco Bay Steel
 Authorized By Paul E. Wendle
 Date 3/2/00

CASCO BAY STEEL STRUCTURES, INC.


75 Spring Hill Road
Saco, Maine 04072

Phone: (207) 282-7360

Fax: (207) 282-1179

WELDING PROCEDURE SPECIFICATION


Material specification ASTM-A709/A709M - Gr 36 (250), 50 (345), 50W (345W)
 Welding process Shielded Arc Welding
 Manual or machine Manual
 Position of welding Horizontal (2F)
 Filler metal specification AWS A5-23
 Filler metal classification E6010-E6011 Lincoln
 Flux Lincoln 96 Flux with LA-75 Electrode
 Shielding gas Argon Flow rate 4A
 Single or multiple pass Single - Electrode Ex. 1.284 (25.4 ± 1.1)
 Single or multiple arc Single
 Welding current DC
 Polarity DCEN
 Welding progression See Joint Detail
 Root treatment 50% wire brush - grind - Blast Clean area
 Preheat and interpass temperature 30 (19) to 50 (10) to 100 (38) to 200 (150) to 225 (150)
 Postheat temperature NA
 Heat input Min 3.0 kJ/in (1.2 kJ/mm) Max 47.1 kJ/in (1.9 kJ/mm) PQR # 4-428 KJ/in (1.7 kJ/mm) Vermont Agt. Leicester-0506
 Proj # BRF0160325
 C.B.S.S. 285

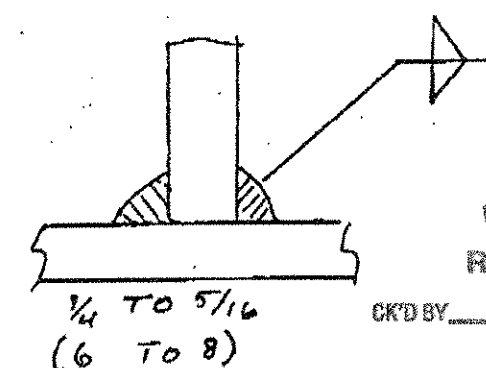Pass no.	Electrode size	Welding current		Travel speed	Fillet
		Amps	Volts		
1	3/32	299	31	12 IPM	AWS D1-5 Joint detail
		269	29	11	
		329	33	15	
2-4	Metric	299	31	320 mm	
		269	29	299	
		329	33	381	

VTRANS RECEIVED
 CRD BY: [Signature] OK'D BY: JWC
 JAN 23 2006
 RESUBMIT: [] APPROVED: [X]
 DATE 02-06-06

This procedure may vary due to fabrication sequence, fit-up, pass size, etc., within the limitation of variables given in applicable A.W.S. codes or contract specifications

Procedure no. 250 Contractor Casco Bay Steel
 Revision no. 01 Authorized By Paul E Gadele
 Form B-2 Date 6-13-00

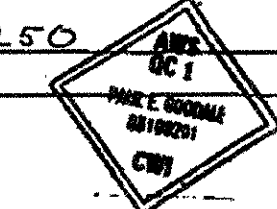

Casco Bay Steel Structures, Inc.

5 Industry Road
South Portland, Maine 04106

Phone: (207) 772-2533

Fax: (207) 772-0580

WELDING PROCEDURE SPECIFICATION

Welding specification: ASTM A109 Gr 36-50-60W (250-345-345W)
 Welding process: Shielded Metal Arc Welding (SMAW)
 Manual or machine: Manual
 Position of welding: Flat (F), Horizontal (HF)
 Filler metal specification: ANSI/AWS A5.1 - E7018
 Filler metal classification: E7018 - R018 5/16 - 7/8
 Shielding gas: NA Flow rate: NA
 Single or multiple pass: Single and multiple
 Single or multiple arc: single
 Welding current: AC/DC
 Polarity: STRAIGHT / Reverse
 Welding progression: SEE AWS SPECIFICATION
 Root treatment: SEE AWS SPECIFICATION
 Preheat and interpass temperature: 34(92.50) to 34(92.50) to 1/4(60) to 1/4(60) to 1/2(101.3) to 1/2(101.3) to 1/2(101.3)
 Postheat temperature: NA
 Heat input: Min NA Max NA

APPROVED BY: JWC
 DATE: 02-06-06

WELDING PROCEDURE

Pass no.	Electrode size	Welding current		Travel speed	AWS D1.5	Joint detail	Fillet
		Amps	Volts				
A5	7/16	70-170	22-26	AS	1F	1/2 to 5/8	11 to 16
	5/32	120-225	22-26				
	3/16	170-300	24-27				
REQ	7/16	90-160	22-26	RFQ	2F	3/8 to 1/2	10 to 13
	5/32	120-225	22-26				
	3/16	180-290	24-27				
REQ	7/16	170-270	22-26	RFQ	3/16 to 1/2	3/8	7/16 to 5/8
	5/32	120-225	22-26				
	3/16	180-290	24-27				

This procedure may vary due to location, sequence, fit-up, pass size, etc., within the limitation of variables given in applicable codes or contract specifications.

Procedure no. 401 Contractor Casco Bay Steel
 Revision no. 0 Authorized By Paul E. Hoodale
 Form W-2 Date 3/2/00

Casco Bay Steel Structures, Inc.

75 Spring Hill Road
Saco, Maine 04072

Phone: (207) 282-7360

Fax: (207) 282-1170

WELDING PROCEDURE SPECIFICATION

Material specification ASTM A572 Gr. 36-50-50w (250-345-345w)
 Welding process Shielded Metal Arc welding (SMAW)
 Manual or machine Manual
 Position of welding Vertical up (3F)
 Filler metal specification AWS A5.1 - A5.5
 Filler metal classification E7018 - R018 4/5
 Flux NA
 Shielding gas NA Flow rate NA
 Single or multiple pass Single - multiple
 Single or multiple arc Single
 Welding current AC
 Polarity positive
 Welding progression see detail
 Root treatment Area to be free of loose scale, slag, rust or moisture
 Preheat and interpass temperature to 34 (19) 50 (60), 39 (9) 70 (30) 70 (60) 120 (80)
 Postheat temperature NA
 Heat input Min NA Max NA

TRANS RECEIVED

BY JWE

JAN 23 2006

RESUBMIT APPROVED

DATE 02-06-06

VERMONT A.S.T.
LEICESTER BR #6
Proj #BRF0160305
C.B.S.S 285

WELDING PROCEDURE

(Metric)

Pass no.	Electrode size	Welding current		Travel speed	AWS D1.5 Joint detail
		Amps	Volts		
7018					
1/8 (3.2)	70-170	22-26			
5/32 (3.9)	120-190	22-26			
8018					
1/8 (3.2)	90-160	22-26			
5/32 (3.9)	130-200	22-26			

This procedure may vary due to fabrication sequence, fit-up, pass size, etc., within the limitation of variables given in applicable A.W.S. codes or contract specifications

Procedure no. 403 Contractor Casco Bay Steel
 Revision no. 1 Authorized By Paul F. Babilal
 Form 11-2 Date 4-24-05

Casco Bay Steel Structures, Inc.

75 Spring Hill Road
Saco, Maine 04072


Phone: (207) 282-7360

Fax: (207) 282-1170

WELDING PROCEDURE SPECIFICATION


Material specification ASTM A36-Gr 36-50-SDW (200-345-345W)
 Welding process Shielded Metal Arc welding (SMAW)
 Manual or machine Manual
 Position of welding Overhead (4F)
 Filler metal specification AWS/A5.1-A5.5
 Filler metal classification E7018-8018-263
 Flux NA
 Shielding gas NA Flow rate NA
 Single or multiple pass Single - multiple
 Single or multiple arc Single
 Welding current D.C.
 Polarity Positive
 Welding progression See Detail
 Root treatment Area 12A - Free of loose scale - slag - rust or moisture
 Preheat and interpass temperature 36(9) to 34(9) to 14(9B) 70(20) to 14(9B)
 Postheat temperature NA 70-24(63) - 150(65°)
 Heat Input Min NA Max NA
 Vermont A.G.T.
 Leicester, VT #6
 Proj # BRF016025
 C.B.S.S 285

(Metric) WELDING PROCEDURE


Pass no.	Electrode size	Welding current		Travel speed
		Amperes	Volts	
7018	1/8 (3.2)	95-160	22-26	AWS D1.5 Joint detail <u>Fillet</u>  VTRANS RECEIVED OK'D BY _____ OK'D BY <u>JWC</u> JAN 23 2006 RESUBMIT _____ APPROVED <input checked="" type="checkbox"/> BY _____ DATE <u>02-06-06</u>
5/32 (3.9)	120-190	22-26		
8018	1/8 (3.2)	110-150	22-26	
5/32 (3.9)	130-190	22-26		

This procedure may vary due to fabrication sequence, fit-up, pass size, etc., within the limitation of variations given in applicable A.W.S. codes or contract specifications.

Procedure no. 2104 Contractor Casco Bay Steel Structures, Inc.
 Revision no. _____ Authorized By [Signature]
 Form 11-2 Date 6-3-04

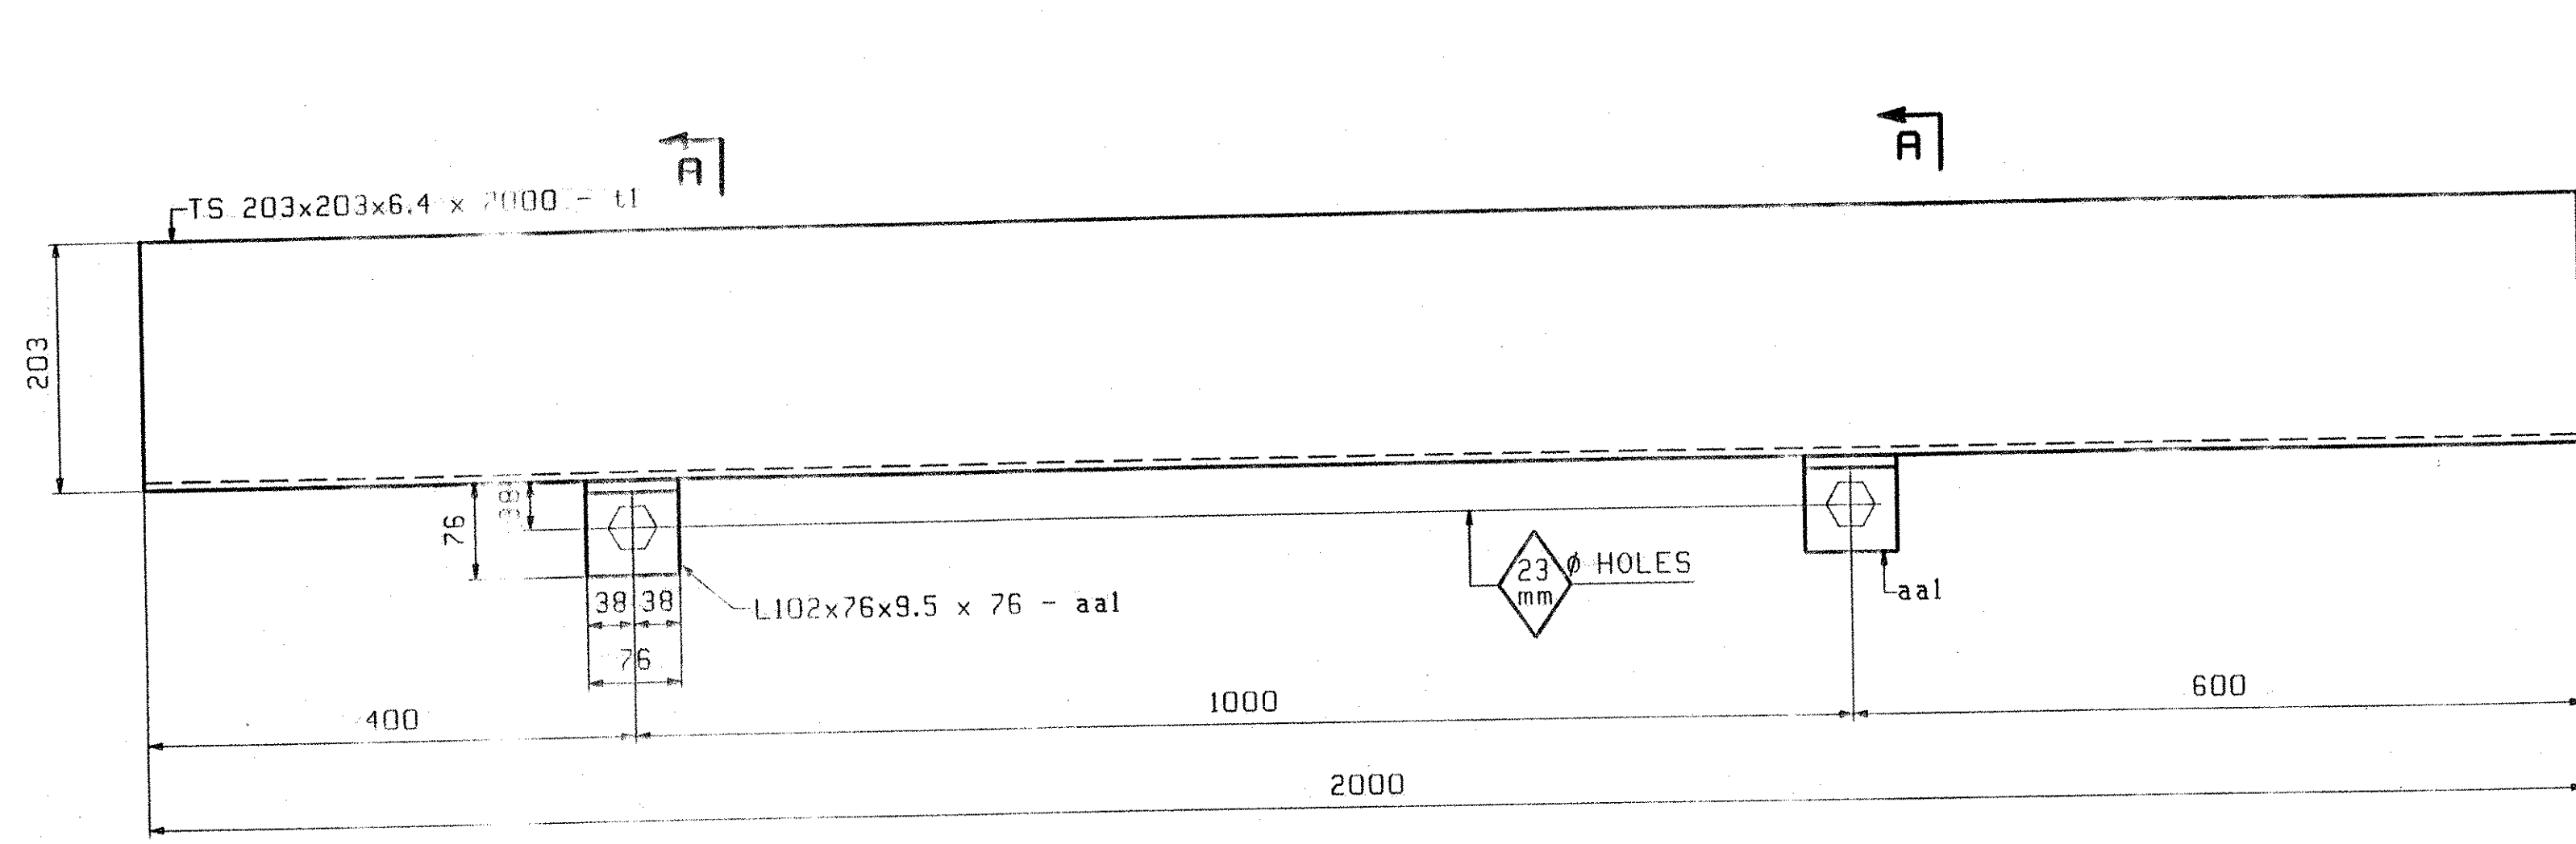

ONE ~ DOWNSPOUT - D1
AT ABUTMENT 1

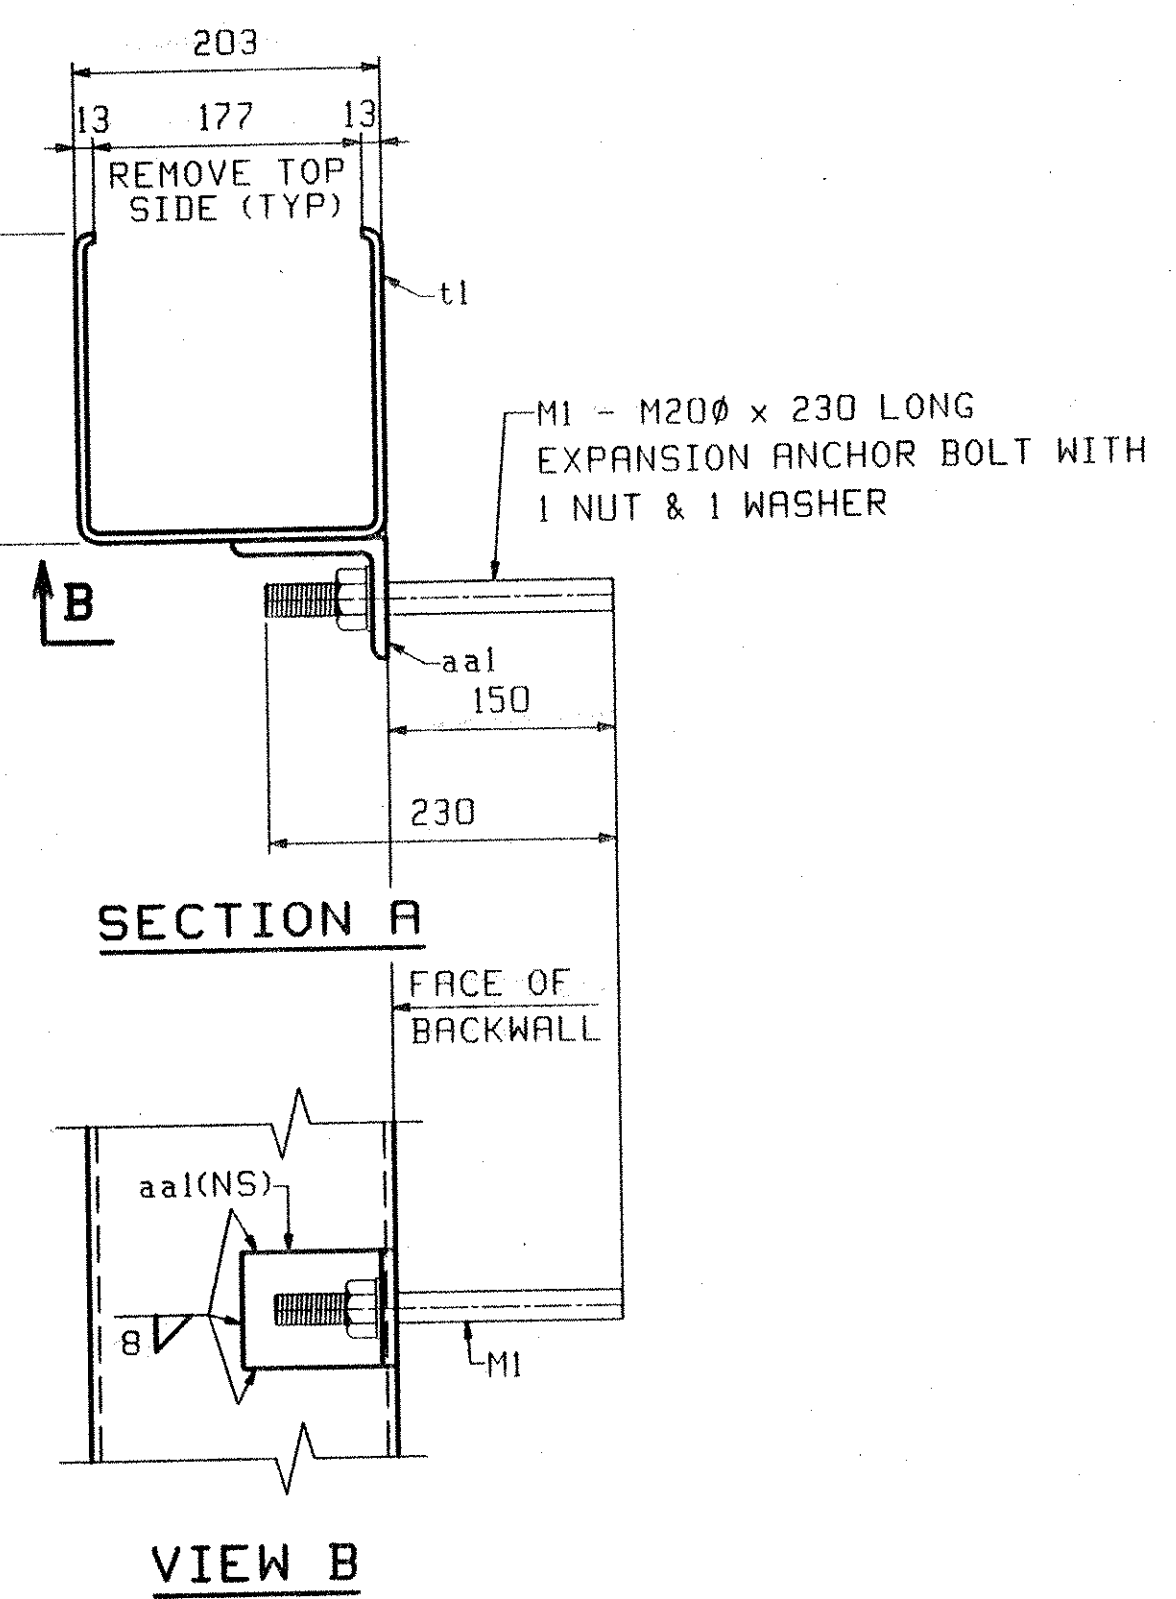

BILL OF MATERIAL		JOB NO.	DRAWING NO.	REV.					
		285	D1						
PAGE	LINE	MARK	QTY	MARK	MATERIAL	LENGTH	REMARKS	MT	PROCUREMENT NOTES
						m			
						mm			
		D1	1		DOWNSPOUT				79 kg 174 lbs
3	B		1	t1	TS203x203x6.4	2 000	(AS004-B)		
3	C		2	aal	L 102x76x9.5	0 076			
		M1	2		EXPANSION ANCHOR BOLTS				1 kg 2 lbs
3	F		2		ROD 20 #	D 230	W/1 NUT		
3	G		2		HSW		(F436) (GALV)		

OUT FOR APPROVAL	<i>J. C. O.</i>										
ISSUED TO SHOP											
FIELD & OFFICE											
REV.	REMARKS	DATE	DWN	CHK	APP	Q.A.	NO.	DIA.	LGT	TYPE	WASHER
MATERIAL:	ELECTRODES:	HOLES:	SHOP BOLTS:								
M270M-250		AS NOTED	AS NOTED								
SURFACE PREP. & PAINT:											
GALVANIZED AFTER FABRICATION											
DESCRIPTION:	DOWNSPOUT								DRAWN BY	DATE	
JOB:	TH 1 (FAS 160) OVER OTTER CREEK								JTB	07/25	
	BRIDGE NO. 6								CHKD BY		
	TOWN OF LEICESTER, VERMONT								PCP	07/31	
	COUNTY OF ADDISON								APPROV BY		
	CONTRACTOR: BLOW & COTE								SUPERVISOR	W. J. GATTI	
PROJ NO.	BRF 0160(3)S								Q.A.		
CUSTOMER: VT AOT											
CASCO BAY STEEL STRUCTURES, INC.										JOB NO.	DRG. NO.
75 SPRING HILL ROAD					SACO, MAINE 04072					285	D1
PHONE (207) 282-7360					FAX. (207) 282-1179					REV.	△

PCP Tue Aug 1 09:13:15 EDT 2006 /usr/local/bin/ps2pdf -D1 -r600

VITRAN'S
 RECEIVED
 OK'D BY *E. Roy* 8/14/06
 OK'D BY *JWG* 8/15/06
 AUG 11 2006
 RESUBMIT _____ APPROVED *AS NOTED*
 BY *PCP* DATE *8/17/06*
 148 SS

GENERAL NOTES

CONSTRUCTION SPECIFICATIONS

- 1). ALL MATERIAL AND WORKMANSHIP TO BE IN ACCORDANCE WITH THE STATE OF VERMONT AGENCY OF TRANSPORTATION STANDARD SPECIFICATIONS FOR CONSTRUCTION DATED 2001 WITH LATEST REVISIONS.

DESIGN SPECIFICATIONS

- 1). AMERICAN ASSOCIATION OF STATE HIGHWAY AND TRANSPORTATION OFFICIALS (A.A.S.H.T.O) STANDARD SPECIFICATIONS FOR HIGHWAY BRIDGES, 2002 EDITION WITH LATEST REVISIONS.

MATERIAL SPECIFICATIONS

- 1). UNLESS NOTED, ALL STEEL TO BE AASHTO M270M GRADE 345W.
- 2). HIGH STRENGTH BOLTS: AASHTO M164 (ASTM A325 TYPE 3) (7/8") DIA IN UNPAINTED AREAS. AASHTO M164 (ASTM A325 TYPE 1) (7/8") DIA IN PAINTED AREAS. ALL TYPE I BOLTS SHALL BE GALVANIZED PER AASHTO M232.
- 3). GIRDER WEB & BOTTOM FLANGES SHALL BE CHARPY V NOTCH TESTED IN ACCORDANCE WITH THE REQUIREMENTS OF VERMONT STANDARD SPECIFICATIONS. DRAWINGS SHALL CALL OUT "H2-3" FOR EACH APPLICABLE ITEM IN THE BILLS OF MATERIAL.

FABRICATION

- 1). ALL HOLES SHALL BE PUNCHED OR DRILLED FULL SIZE (UN).
- 2). STUDS ARE FURNISHED AND FIELD APPLIED BY OTHERS.

WELDING

- 1). THE CONFIGURATION OF THE WELD JOINTS AND ALL WELDING PROCEDURES SHALL BE IN ACCORDANCE WITH AASHTO/AWS D1.5 BRIDGE WELDING CODE AND IN ADDITION TO SPECIFICATIONS SHOWN ABOVE. ALL WELDING WILL BE DETAILED TO PRE-QUALIFIED JOINTS, UNLESS PROHIBITED BY THE DESIGNER.
- 2). WELDING OF MAIN LOAD CARRYING MEMBERS AND ATTACHMENTS SHALL BE PERFORMED USING THE AUTOMATIC SUBMERGED ARC & SHIELDED METAL ARC PROCESSES. ALL WELDS ARE CONTINUOUS U.N.
- 3). NON DESTRUCTIVE TESTING OF WELDS SHALL BE IN ACCORDANCE WITH THE REFERENCED SPECIFICATION.

CLEANING:


- 1). ALL STEEL SHALL BE BLAST CLEANED AS PER SSPC SP-10 PER SPEC. 506.14(a)

PAINTING


- 1). THE EXPANSION END OF THE GIRDERS & ABUT 1 DIAPHRAGMS SHALL BE PAINTED AND GREASED PER SUPPLEMENTAL SPECIFICATION 513.06(d). SEE SKETCH "P1"
- 2). THE FINAL COAT OF THE PAINT SHALL BE BROWN AND SHALL CONFORM WITH FEDERAL STANDARD NUMBER 595, COLOR CHIP NUMBER 20059.
- 3). PAINT TO BE USED AS FOLLOWS (CARBOLINE COMPANY PRODUCT SYSTEM):
 PRIMER - CARBOLINE 859 ZR EPOXY PRIMER (ORGANIC) (3.0-6.0 mils DFT)
 INTERMEDIATE - CARBOLINE 888 EPOXY (3.0-10.0 mils DFT)
 TOP COAT - CARBOLINE 133 HB ALIPHATIC POLYURETHANE (3.0-5.0 mils DFT)

FIELD CONNECTIONS

- 1). ALL FIELD CONNECTIONS SHALL BE MADE WITH (7/8") DIAMETER HIGH STRENGTH A-325 BOLTS, INSTALLED PER SECTION 506.19(c).
- 2). BOLTS SHALL HAVE HEAVY HEX NUT, HEX HEAD, & ONE FLAT WASHER EACH (WASHER TO BE PLACED UNDER TURNED ELEMENT).
- 3). PIECE MARKS WILL BE LOCATED AS SHOWN ON ERECTION DRAWINGS.

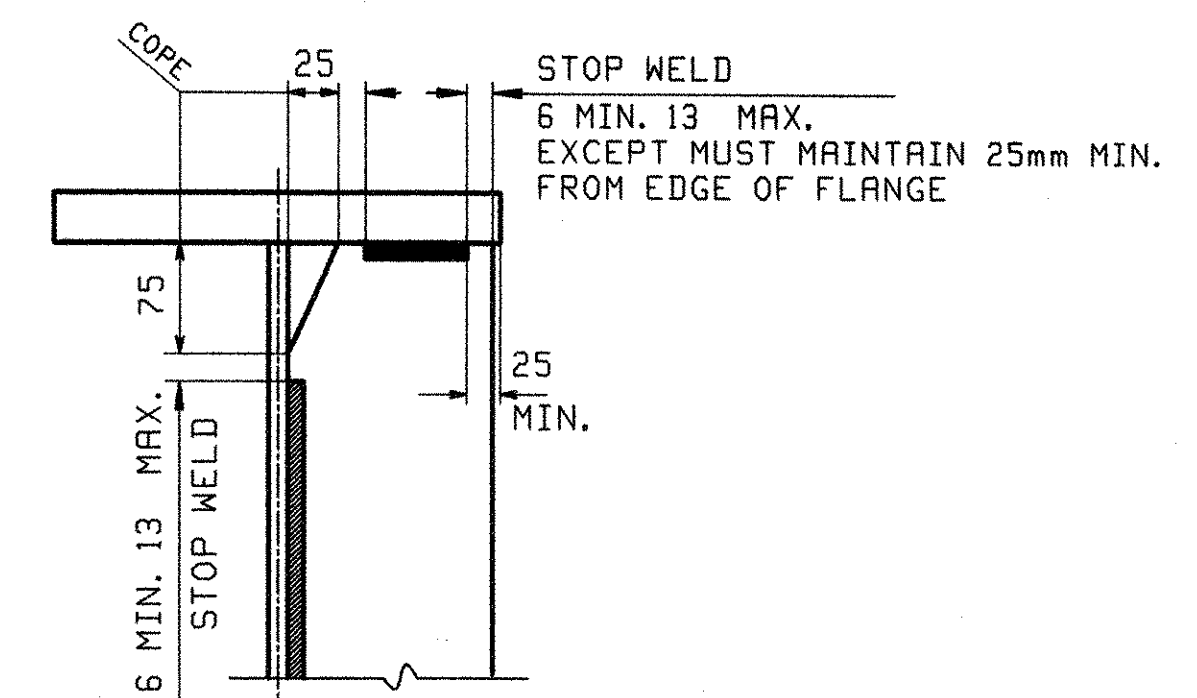

DETAIL "WS1"

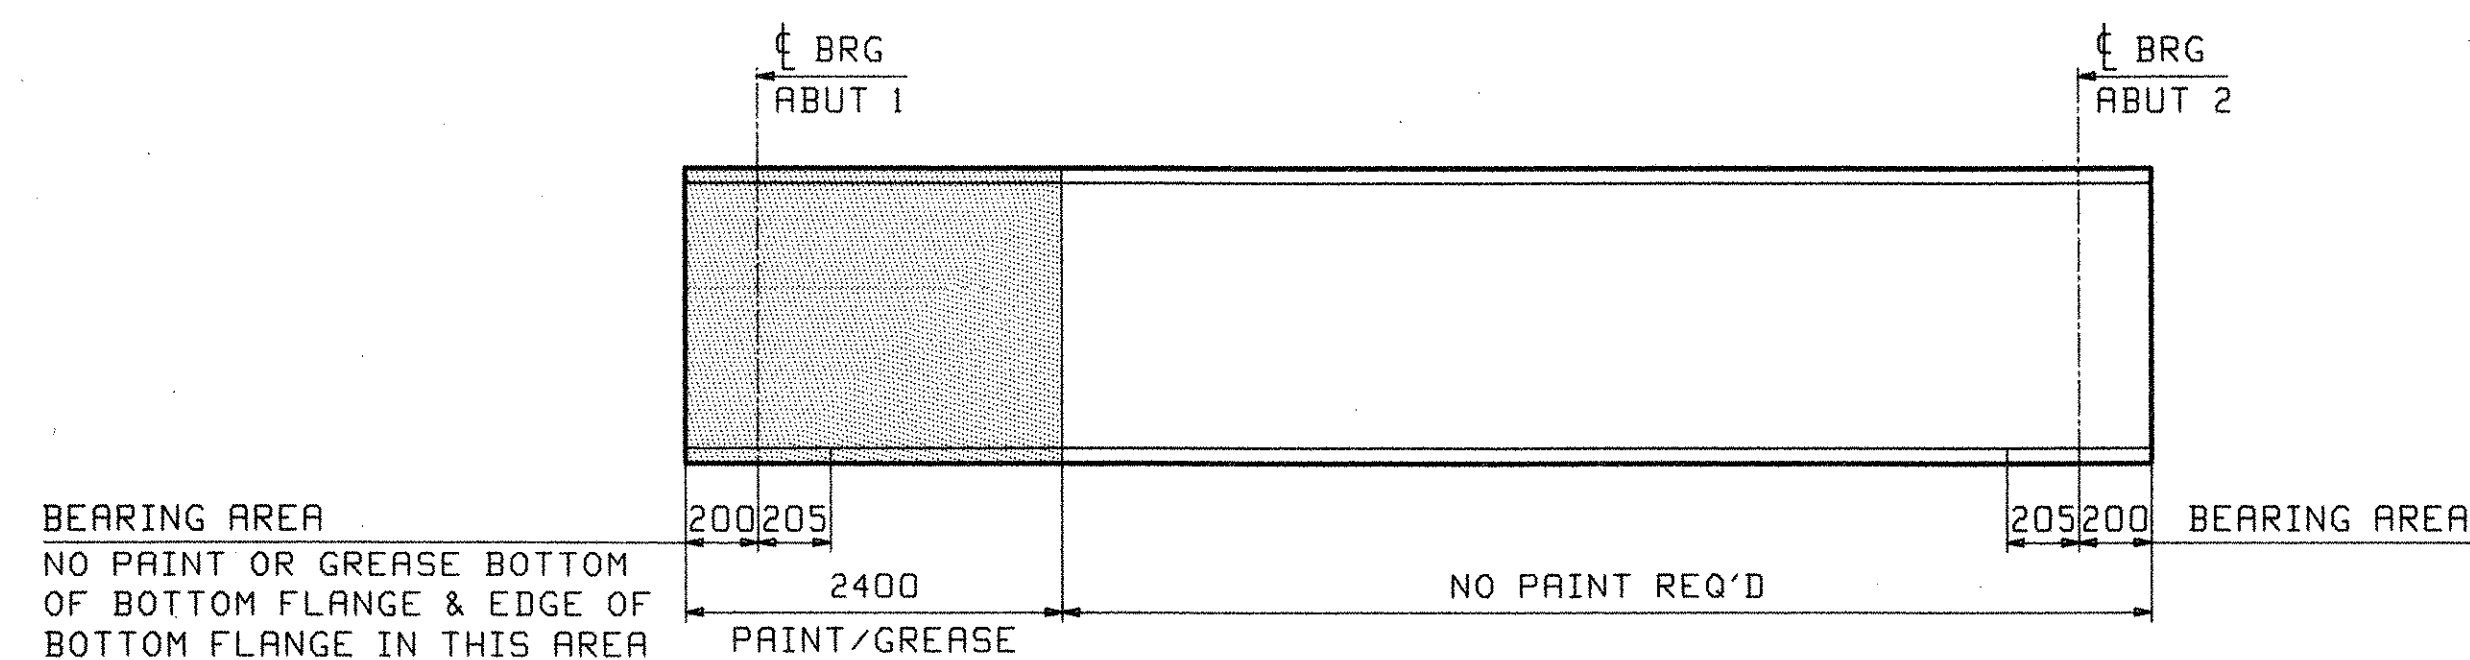

SKETCH "P1"

NOTE TO ENGINEER:
 THESE NOTES ARE NOT INTENDED TO BE ALL INCLUSIVE AND COMPLIANCE WITH RELEVANT SPECIFICATIONS REMAIN UNCHANGED.


OUT FOR APPROVAL	12/28/05																		
OUT FOR APPROVAL	2/27/06																		
ISSUED TO SHOP																			
FIELD & OFFICE																			
APPROVAL COMMENTS	2/21	JTB	ELC																
REV.	REMARKS	DATE	DWN	CHK	APP	Q.A.	NO.	DIA.	LGT	TYPE	WASHER								
MATERIAL:	ELECTRODES:	HOLES:		SHOP BOLTS:															

SURFACE PREP. & PAINT:

DESCRIPTION:	GENERAL NOTES	DRAWN BY	DATE
JOB:	TH 1 (FAS 160) OVER OTTER CREEK	JTB	11/08
	BRIDGE NO. 6	CHKD BY	
	TOWN OF LEICESTER, VERMONT	ELC	12/06
	COUNTY OF ADDISON	APPROV BY	
	CONTRACTOR: BLOW & COTE	SUPERVISOR	M. J. GATTI
PROJ NO.	BRF 0160(3)S	Q.A.	
CUSTOMER:	VT ROT		
CASCO BAY STEEL STRUCTURES, INC.		JOB NO.	DRG. NO.
75 SPRING HILL ROAD SACO, MAINE 04072		285	GN1
PHONE (207) 282-7360 FAX. (207) 282-1179		REV.	1

STR 3
 COPY

RECEIVED
 CK'D BY JWP OK'D BY
 MAR 03 2006
 RESUBMIT APPROVED
 BY RW DATE 3/16/06

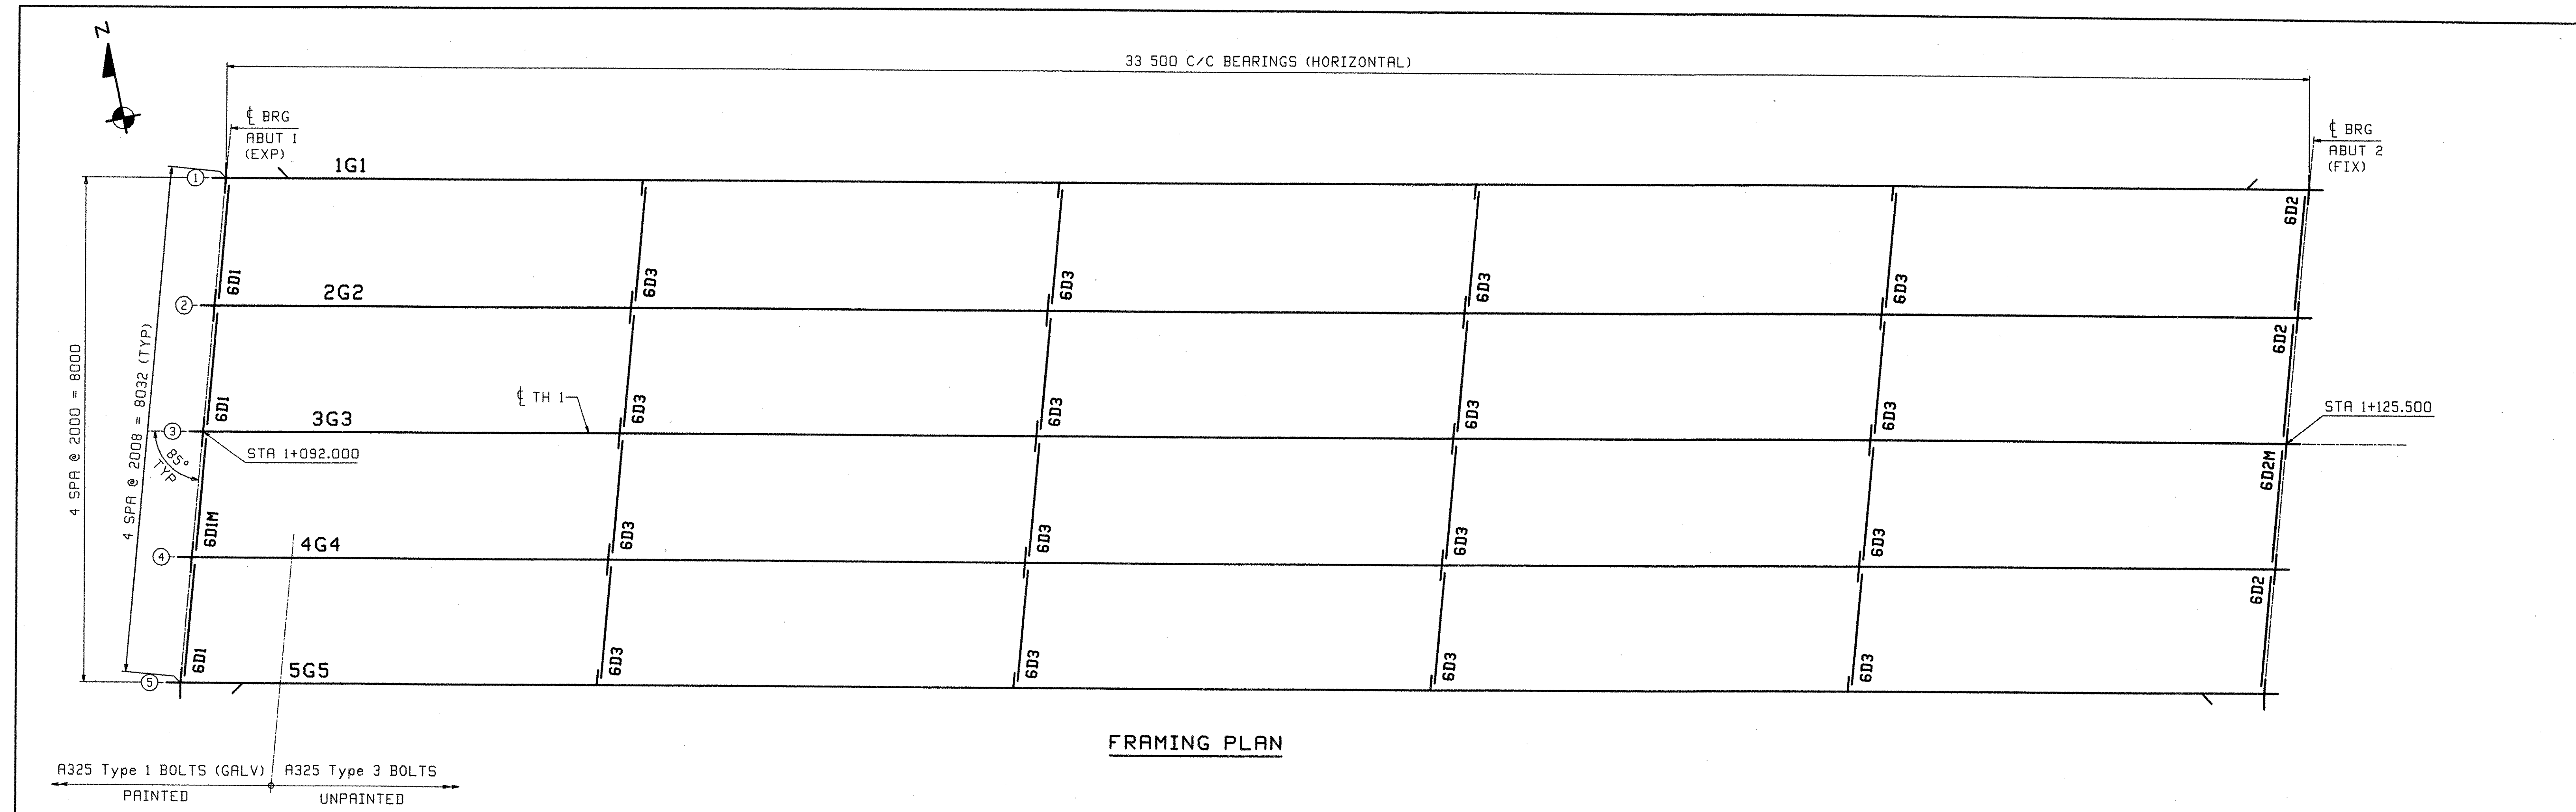

FIELD BOLT LIST										A325 Type 3 BOLTS										
LINE	NO.	REQ'D.	BOLT DIAM.	BOLT LEN.	BOLTS / CONN.	# OF CONN.	GRIP	THICKNESS OF PCS. CONNECTED		WASH CODE	PIECES CONNECTED AND REMARKS									
1											INT DIAPHRAGMS - 6D3									
2	288		7/8	2 1/2	9	32	25	12	13		1	DIAPHRAGM WEB TO CONNECTION PLATE								
3																				
4											ABUT 2 DIAPHRAGMS - 6D2 & 6D2M									
5	144		7/8	2 3/4	18	8	34	12	22		1	DIAPHRAGM WEB TO BRG STIFFENER								

1: 1 Hard Flat Washer

WASHER CODES

FIELD BOLT LIST										A325 Type 1 BOLTS (GALV)										
LINE	NO.	REQ'D.	BOLT DIAM.	BOLT LEN.	BOLTS / CONN.	# OF CONN.	GRIP	THICKNESS OF PCS. CONNECTED		WASH CODE	PIECES CONNECTED AND REMARKS									
6											ABUT 1 DIAPHRAGMS - 6D1 & 6D1M									
7	144		7/8	2 3/4	18	8	34	12	22		1	DIAPHRAGM WEB TO BRG STIFFENER								

1: 1 Hard Flat Washer

WASHER CODES

- All bolt diameters and lengths are shown in inches (english unit of measurement).
- All grip values are shown in metric units.

FIELD BOLT SUMMARY						2% ADDED, MIN. 2 EXTRA	
LINE	NO. OF BOLTS	BOLT DIAM.	TYPE	BOLT LEN	ACTUAL COUNT	REMARKS	
1	294	7/8	A325 Type 3	2 1/2	288		
2	147	7/8	A325 Type 3	2 3/4	144	AT ABUT 2 DIAPHRAGMS	
3	441	Hard Flat Washers for 7/8 Ø BOLT				TYPE 436W	
4							
5							
6	147	7/8	A325 Type 1	2 3/4	144	(GALV) AT ABUT 1 DIAPHRAGMS	
7	147	Hard Flat Washers for 7/8 Ø BOLT				(GALV) TYPE 436	
8							

OUT FOR APPROVAL	2-28-05																		
OUT FOR APPROVAL	2-27-06																		
ISSUED TO SHOP																			
FIELD & OFFICE																			

REV.	REMARKS	DATE	DWN	CHK	APP	Q.A.	NO.	DIA.	LGT	TYPE	WASHER

SURFACE PREP. & PAINT:

DESCRIPTION: FRAMING PLAN & FIELD BOLTS		DRAWN BY	DATE
JOB:	TH 1 (FAS 160) OVER OTTER CREEK	JTB	11/08
	BRIDGE NO. 6	CHKD BY	
	TOWN OF LEICESTER, VERMONT	ELC	12/06
	COUNTY OF ADDISON	APPROV BY	
	CONTRACTOR: BLOW & COTE	SUPERVISOR	W. J. GATTI
PROJ NO.	BRF 0160(3)S	Q.A.	
CUSTOMER:	VT ROT		
CASCO BAY STEEL STRUCTURES, INC.		JOB NO.	DRG. NO.
75 SPRING HILL ROAD		285	E1
PHONE (207) 282-7360			
SACO, MAINE 04072			
FAX. (207) 282-1179			
		REV.	△


RECEIVED

CHK'D BY: *[Signature]* OK'D BY: _____

MAR 03 2006

RESUBMIT: _____ APPROVED: *[Signature]*

BY: *[Signature]* DATE: 3/1/06

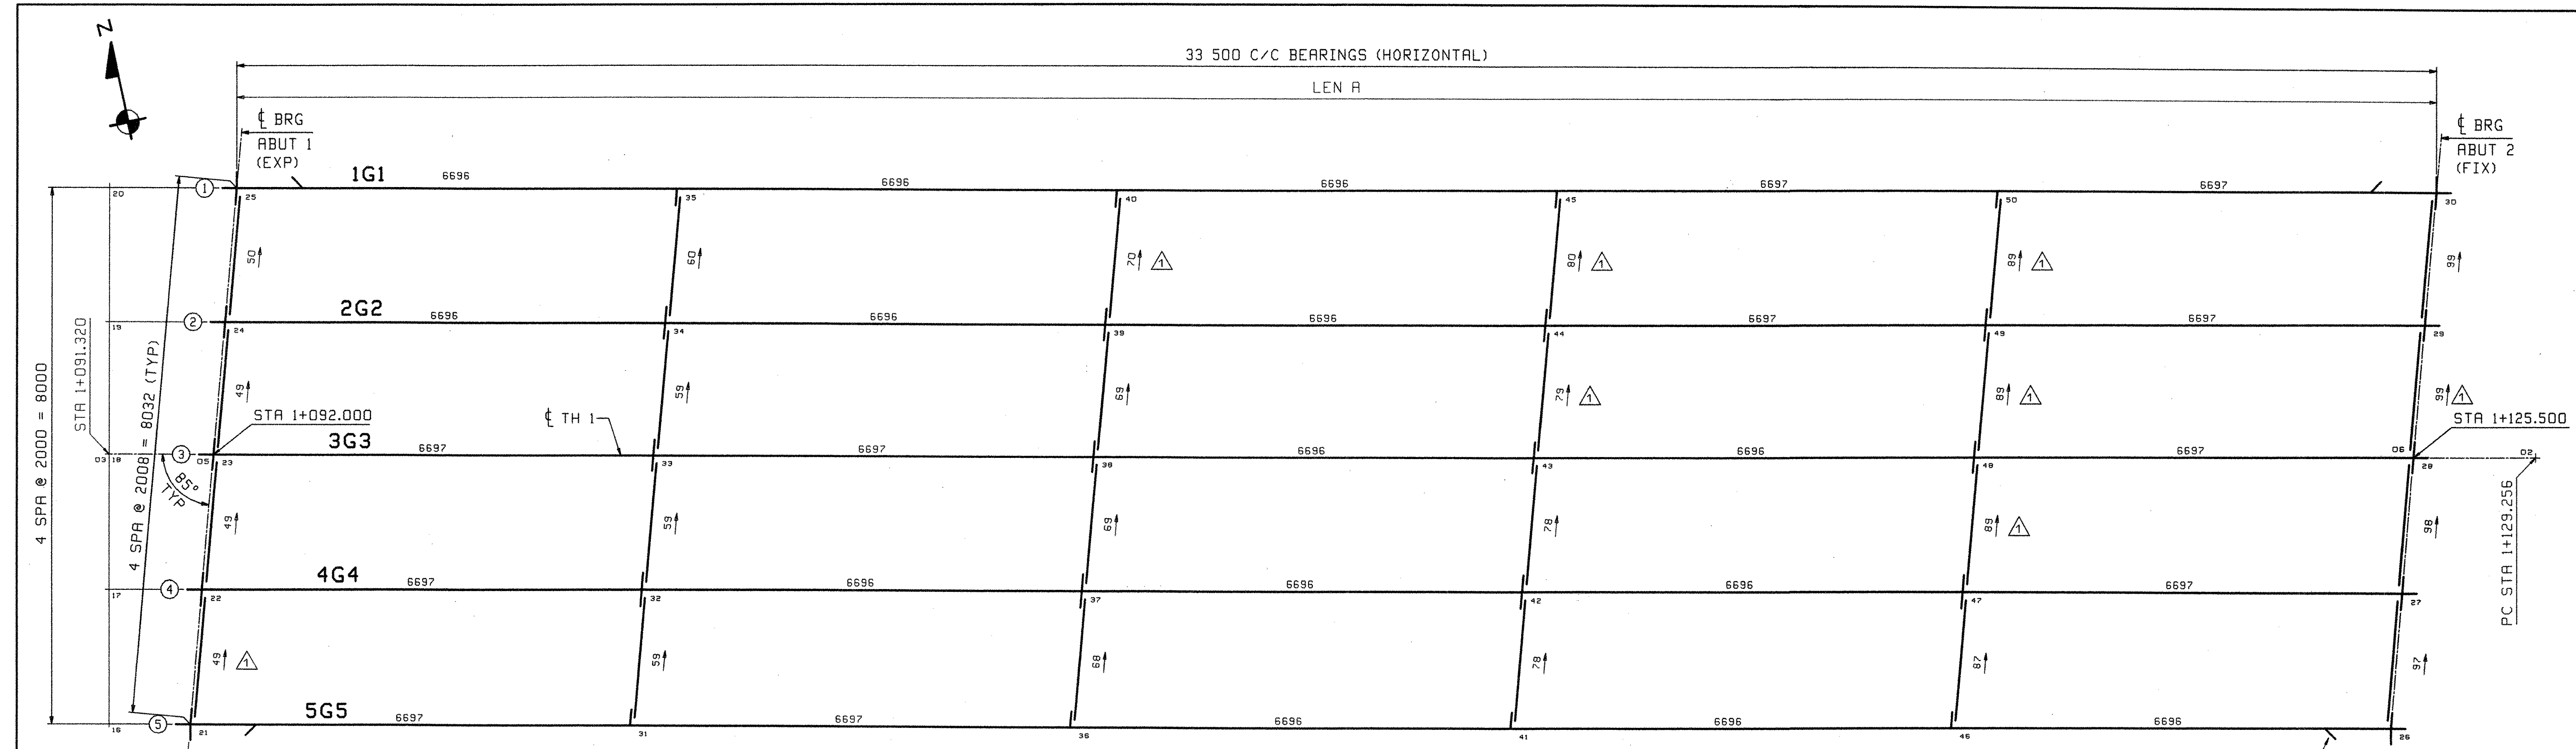


FRAMING PLAN

Line	LEN A	GRADE	
		ABUT 1	ABUT 2
1	33 482	.0011	-.0111
2	33 482	.0026	-.0096
3	33 483	.0040	-.0082
4	33 482	.0055	-.0067
5	33 482	.0069	-.0052

- CALCULATION PLAN NOTES:**
1. LONGITUDINAL DIMENSIONS ARE SLOPING ALONG BOTTOM OF GIRDER WITH CORRECTIONS MADE FOR VERTICAL CURVE, GRADE & DL CAMBER (UN).
 2. TRANSVERSE DIMENSIONS ARE IN A HORIZONTAL PLANE (UN).
 3. ARROW POINTS TOWARD LOW END OF MEMBER.
 4. ENDS OF GIRDERS AND BEARING STIFFENERS ARE VERTICAL AFTER DL ROTATION.
 5. DIAPHRAGM STIFFENERS ARE NORMAL TO GRADE.
 6. BOTTOM POINT NUMBERS = TOP POINT NUMBERS + 100
 7. COMBINE DIAPHRAGMS FOR DROPS +/- 2mm


DRIP BAR (SEE DES SHT 49)

**** NOTE ****
THE PURPOSE OF THIS DRAWING IS TO COORDINATE GEOMETRIC CONTROL INFORMATION. THIS DWG IS SUBMITTED FOR INFORMATION ONLY AND IS NOT INTENDED FOR SHOP FABRICATION.

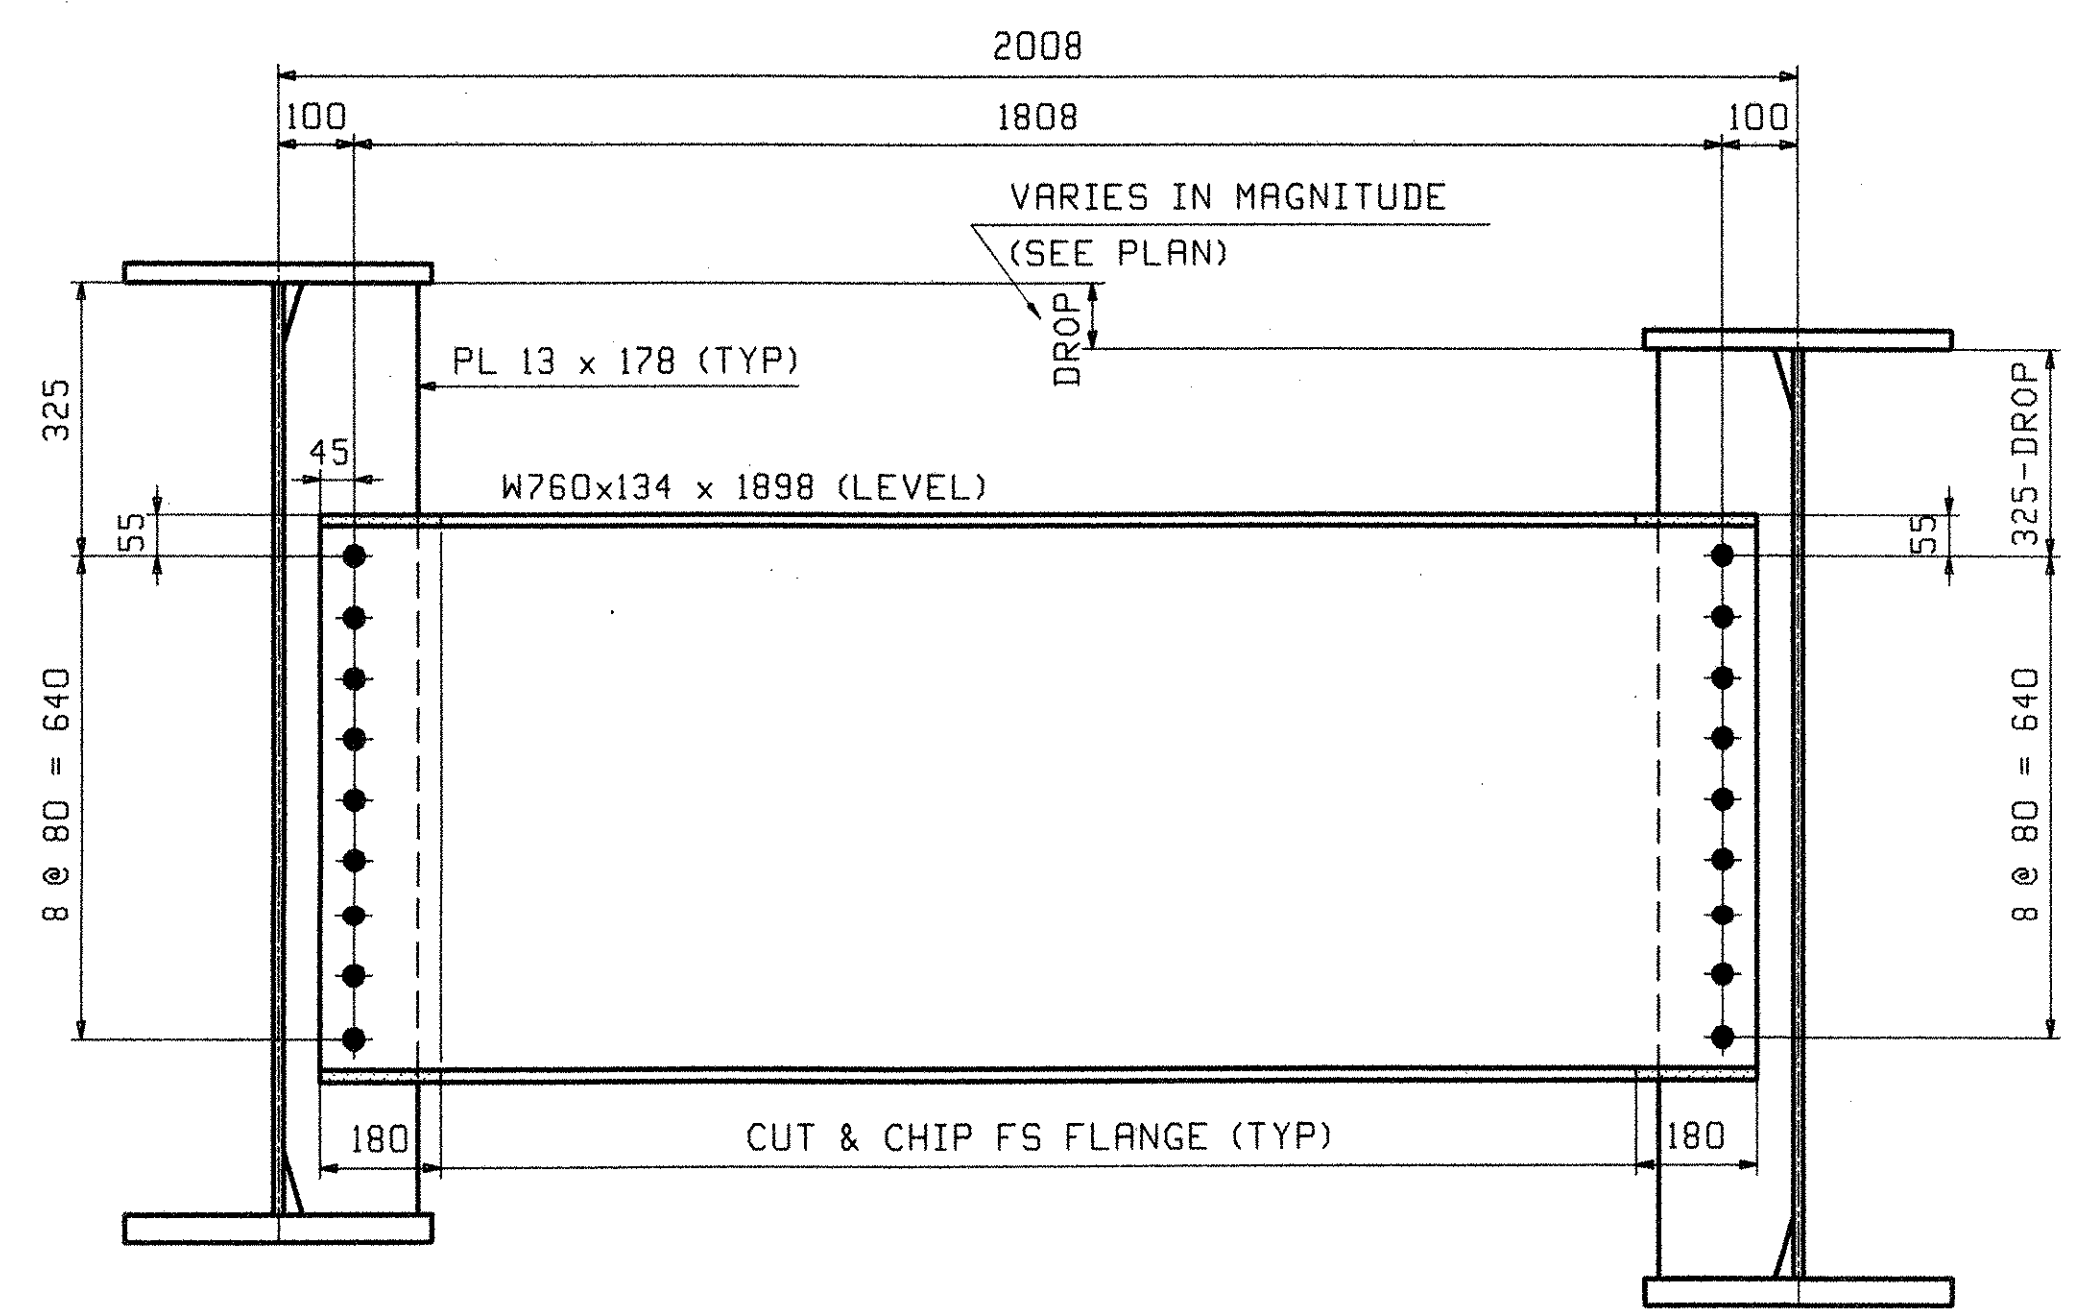

INT. DIAPHRAGM
LOOKING BACK-STATION (DEVELOPED)


- DIAPHRAGM NOTES:**
1. MATERIAL SHALL BE ASTM M270M GRADE 345W.
 2. ALL HOLES SHALL BE 15/16" Ø FOR 7/8" Ø HSB.

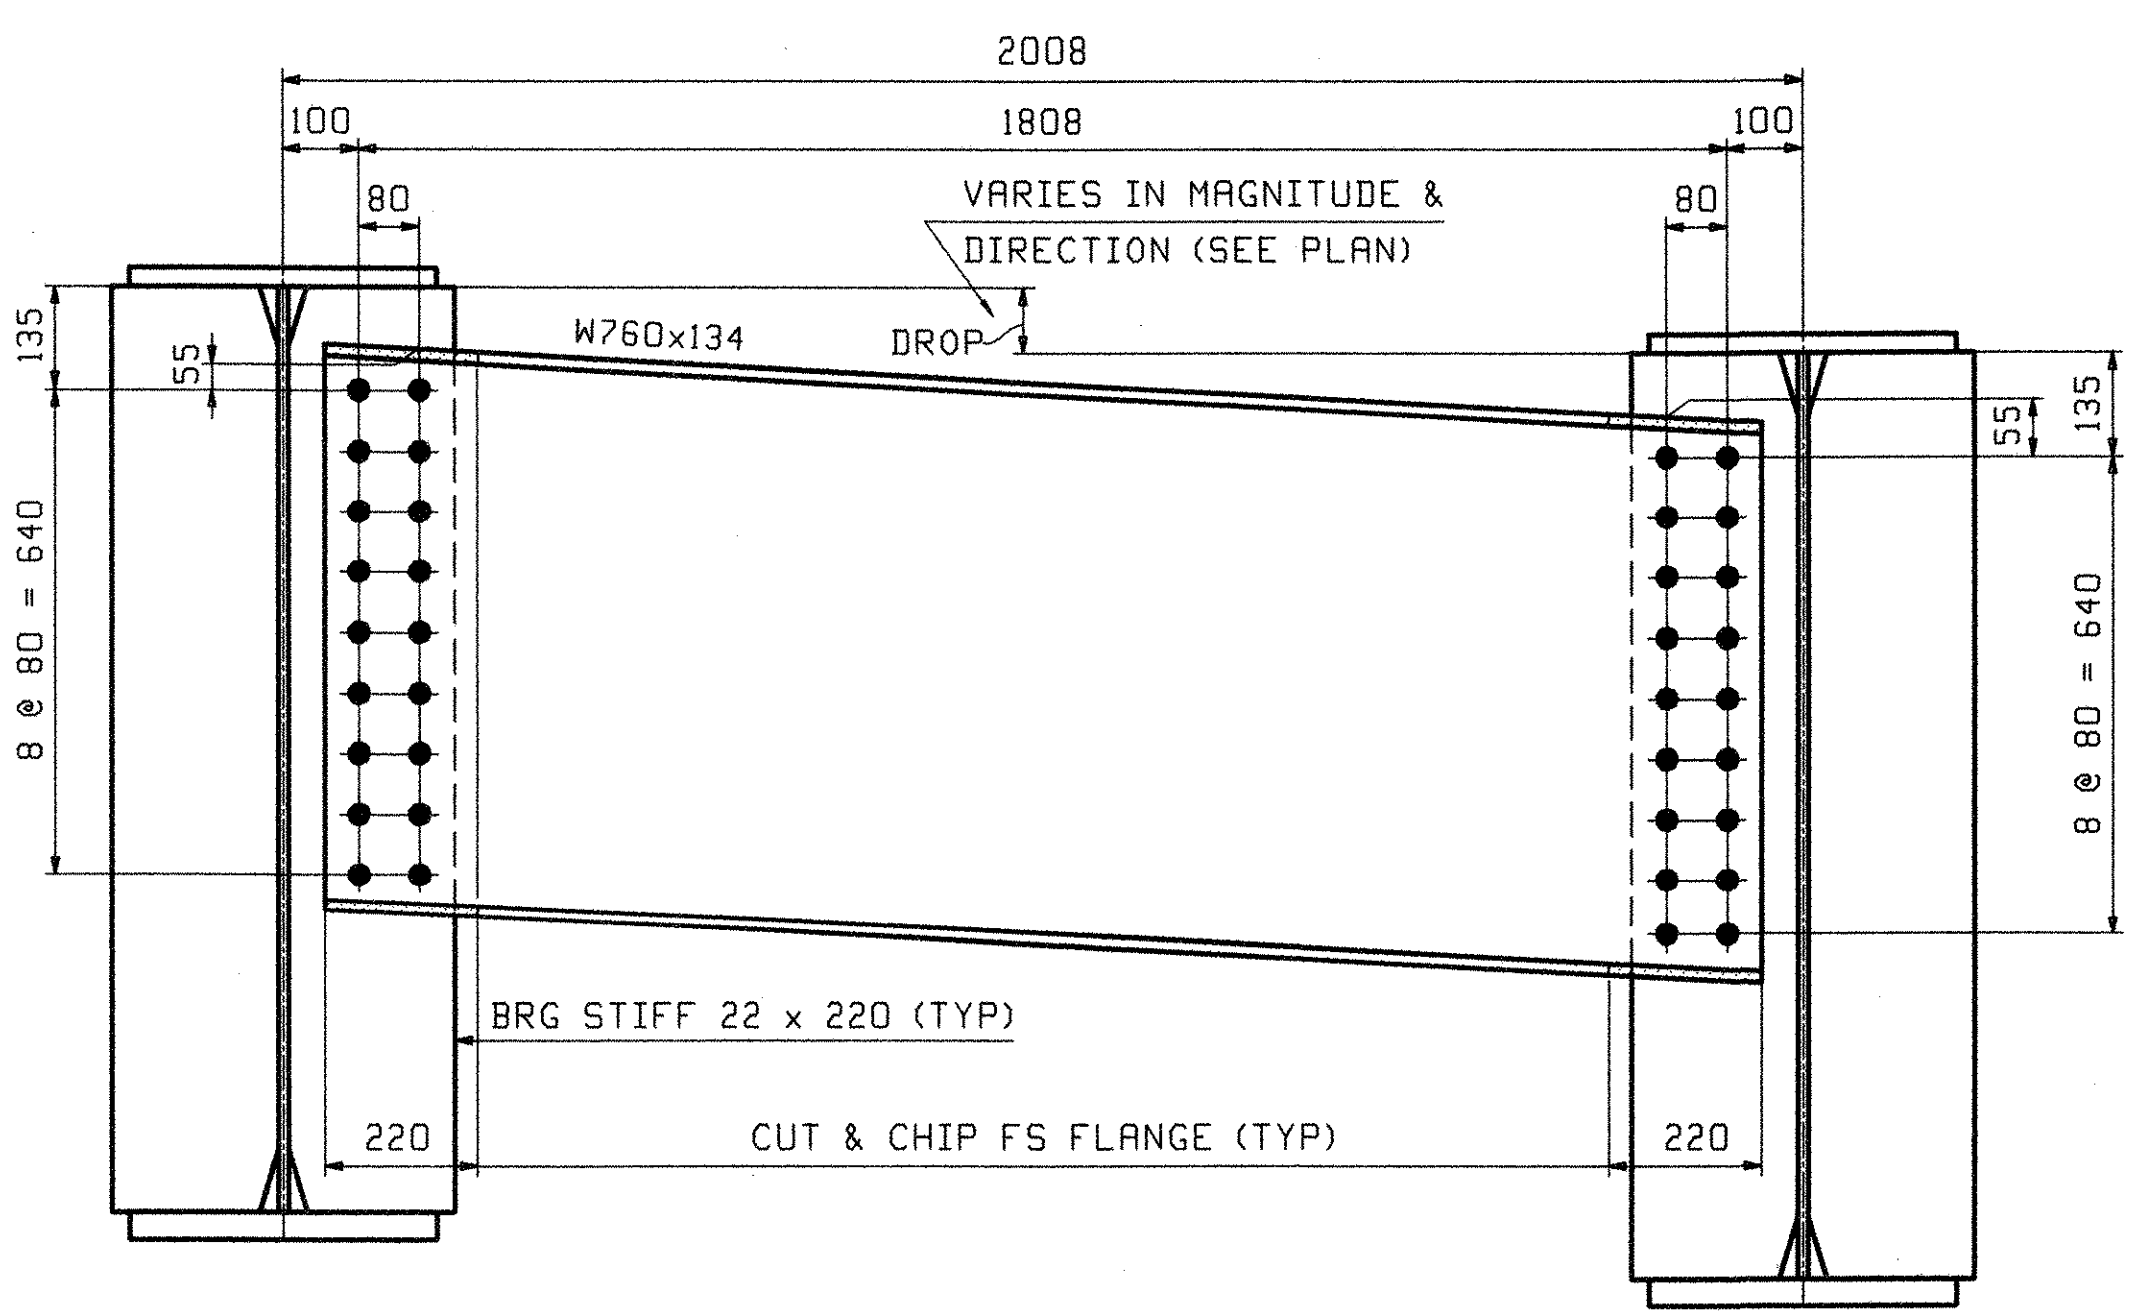

END DIAPHRAGM
LOOKING TOWARDS BACKWALL (DEVELOPED)


OUT FOR APPROVAL	12-28-05										
OUT FOR APPROVAL	2-27-06										
ISSUED TO SHOP											
FIELD & OFFICE											
APPROVAL COMMENTS	2/21	JTB	ELC								
REV.	REMARKS	DATE	DWN	CHK	APP	Q.A.	NO.	DIA.	LGT	TYPE	WASHER
MATERIAL:	ELECTRODES:										SHOP BOLTS:
SURFACE PREP. & PAINT:											
DESCRIPTION:	CALCULATION PLAN & LAYOUTS								DRAWN BY	DATE	
JOB:	TH 1 (FAS 160) OVER OTTER CREEK								JTB	11/08	
	TOWN OF LEICESTER, VERMONT								CHKD BY		
	COUNTY OF ADDISON								ELC	12/06	
	CONTRACTOR: BLOW & COTE								APPROV BY		
									SUPERVISOR	W. J. GATTI	
PROJ NO.	BRF D16D(3)5								Q.A.		
CUSTOMER:	VT ROT										
CASCO BAY STEEL STRUCTURES, INC.											
75 SPRING HILL ROAD	SACO, MAINE 04072				JOB NO.	285	DRG. NO.	WS1			
PHONE (207) 282-7360	FAX. (207) 282-1179				REV.	▲					

RECEIVED
MAR 03 2006
BY: [Signature] DATE: 3/1/06

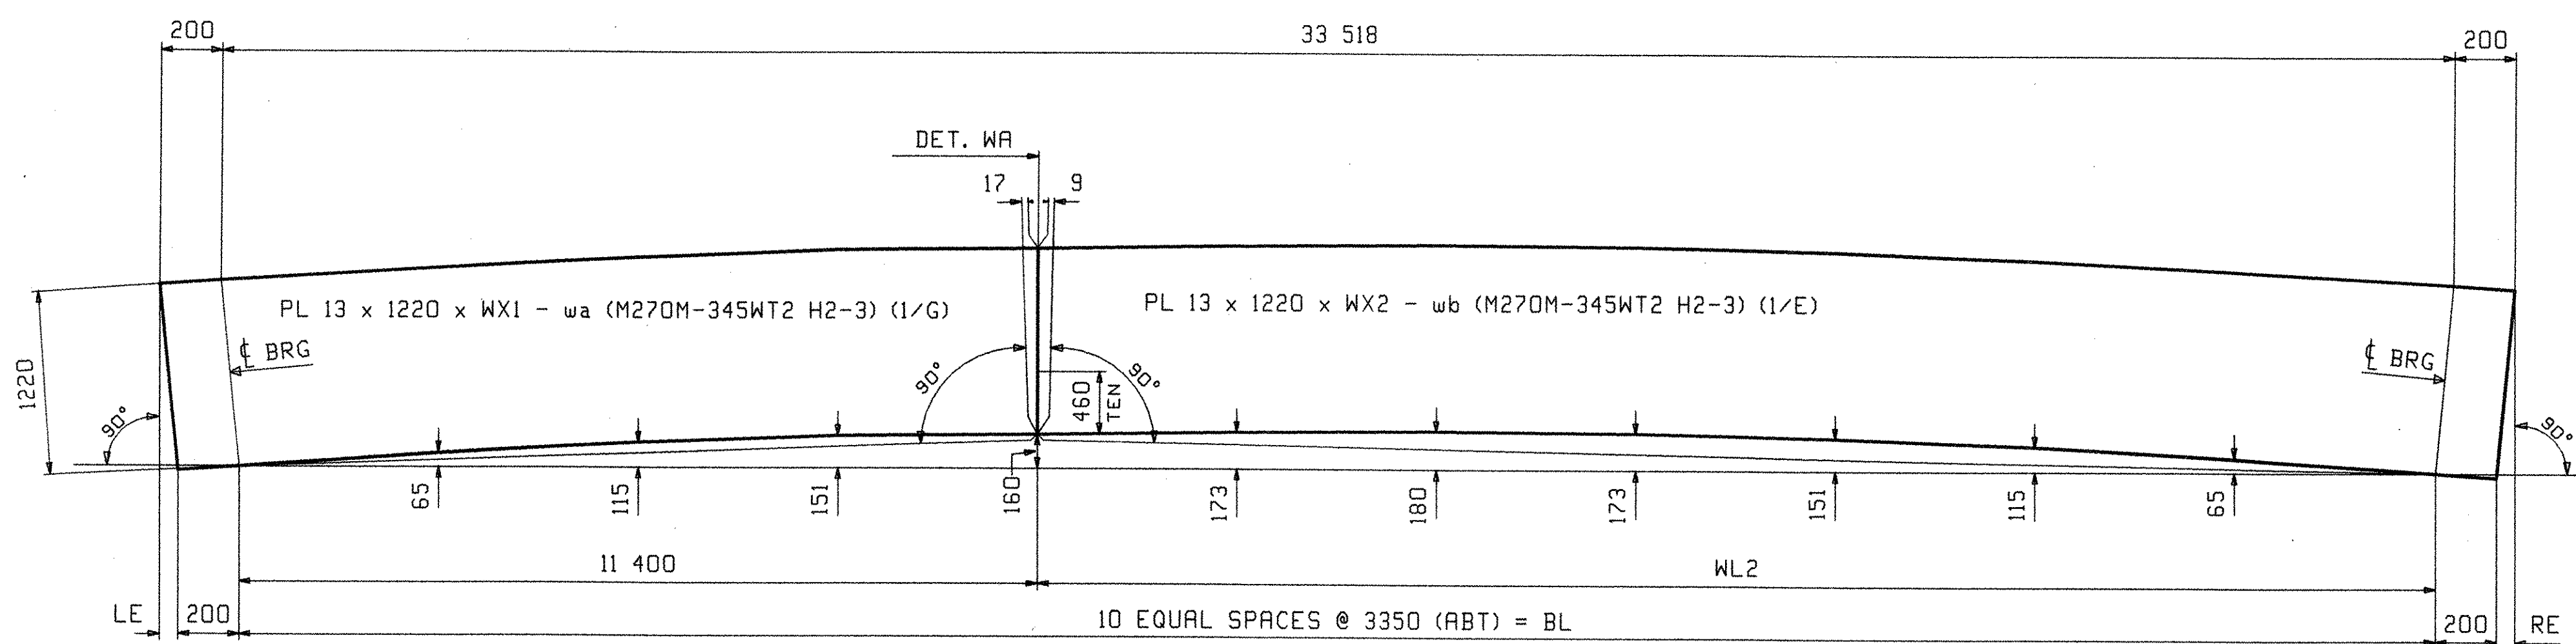


CAMBER DIAGRAM FOR 1G1 THRU 5G5

MARK	BL	LE	RE	WL2	WX1	WX2
1G1	33 482	24	12	22 082	11 625	22 295
2G2	33 482	22	14	22 082	11 623	22 297
3G3	33 483	20	15	22 083	11 621	22 299
4G4	33 482	19	17	22 083	11 619	22 301
5G5	33 482	17	19	22 082	11 618	22 302

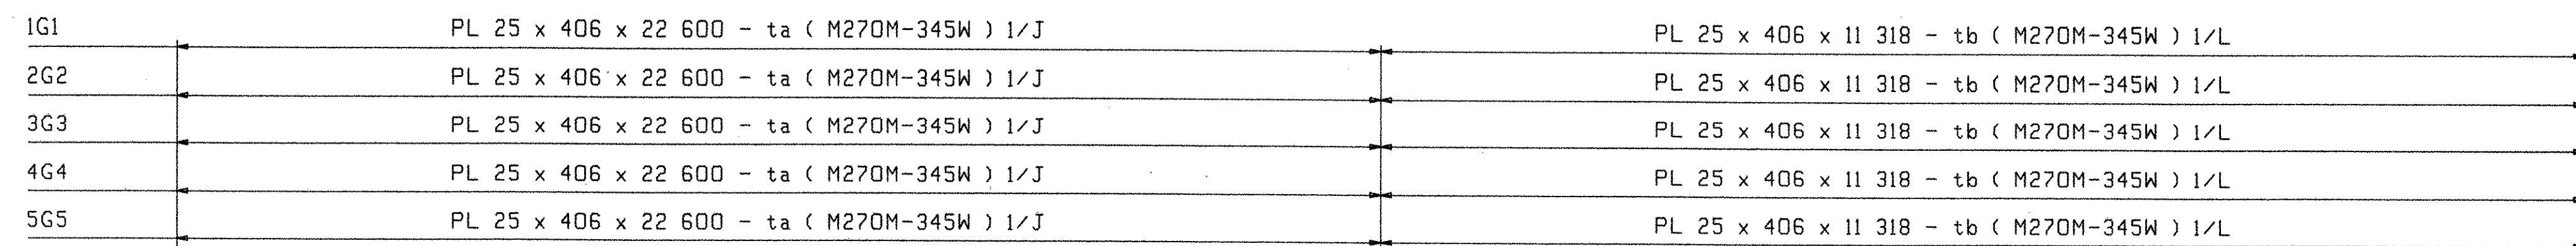

FLANGE DIAGRAM FOR 1G1 THRU 5G5

1G1	24	PL 35 x 406 x 22 600 - ba (M270M-345WT2 H2-3) 1/A	PL 35 x 406 x 11 282 - bb (M270M-345WT2 H2-3) 1/C
2G2	22	PL 35 x 406 x 22 600 - ba (M270M-345WT2 H2-3) 1/A	PL 35 x 406 x 11 282 - bb (M270M-345WT2 H2-3) 1/C
3G3	20	PL 35 x 406 x 22 600 - ba (M270M-345WT2 H2-3) 1/A	PL 35 x 406 x 11 283 - bb (M270M-345WT2 H2-3) 1/C
4G4	19	PL 35 x 406 x 22 600 - ba (M270M-345WT2 H2-3) 1/A	PL 35 x 406 x 11 282 - bb (M270M-345WT2 H2-3) 1/C
5G5	17	PL 35 x 406 x 22 600 - ba (M270M-345WT2 H2-3) 1/A	PL 35 x 406 x 11 282 - bb (M270M-345WT2 H2-3) 1/C

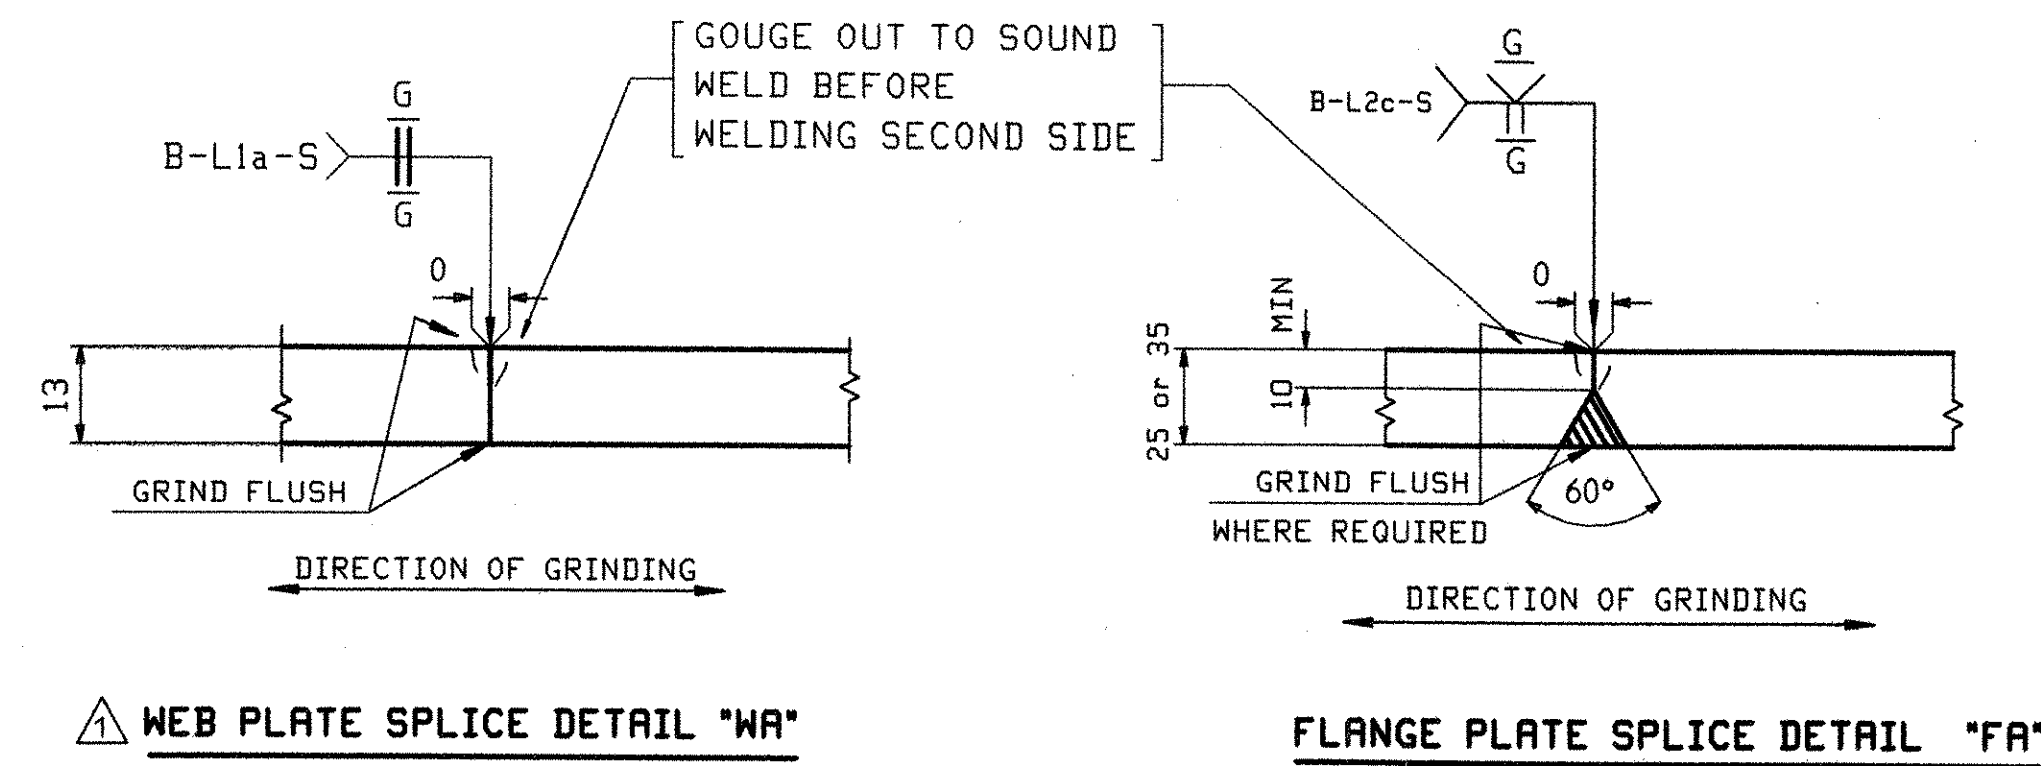

WEB PLATE SPLICE DETAIL "WA"



FLANGE PLATE SPLICE DETAIL "FA"

RECEIVED
 OK'D BY: [Signature] OK'D BY: [Signature]
 MAR 03 2006
 RESUBMIT APPROVED
 BY: [Signature] DATE: 3/16/06



NOTES:

- FOR GENERAL NOTES AND WELD DETAILS SEE DWG GNI.
- H2-3 DENOTES MATERIAL SUBJECT TO CHARPY V-NOTCH TEST AT H FREQ. FOR ZONE 2

OUT FOR APPROVAL	2-26-05																		
OUT FOR APPROVAL	2-27-06																		
ISSUED TO SHOP																			
FIELD & OFFICE																			
APPROVAL COMMENTS	2/21	JTB	ELC																
REV.	REMARKS	DATE	DWN	CHK	APP	Q.A.	NO.	DIA.	LGT	TYPE	WASHER								
MATERIAL:	M270M-345W (UN)	ELECTRODES:		HOLE:		SHOP BOLTS:													
SURFACE PREP. & PRINT:																			
SEE DRAWING GNI																			
DESCRIPTION:	CAMBER & FLANGE DIAGRAMS										DRAWN BY:	JTB	DATE:	11/08					
JOB:	TH 1 (FAS 160) OVER OTTER CREEK BRIDGE NO. 6 TOWN OF LEICESTER, VERMONT COUNTY OF ADDISON CONTRACTOR: BLOW & COTE										CHKD BY:	ELC	DATE:	12/06					
PROJ NO.	BRF 0160(3)S										APPROV BY:	W. J. GATTI	SUPERVISOR:	W. J. GATTI					
CUSTOMER:	VT ROT										Q.A.								
CASCO BAY STEEL STRUCTURES, INC.															JOB NO.	285	DRG. NO.	C1	
75 SPRING HILL ROAD SACO, MAINE 04072															PHONE:	(207) 282-7360	FAX:	(207) 282-1179	
															REV.				

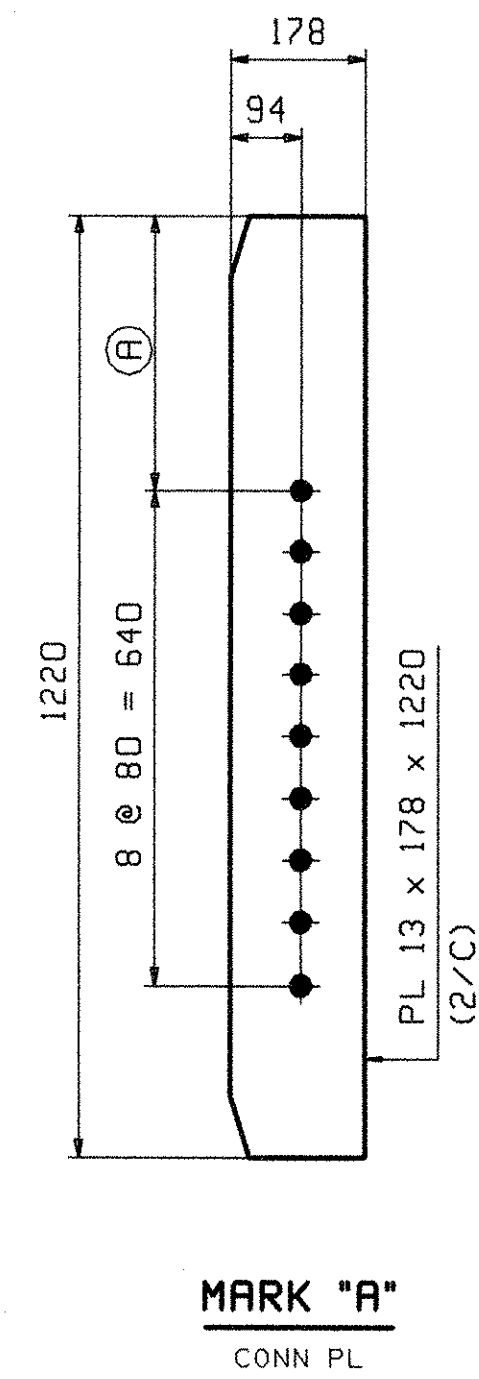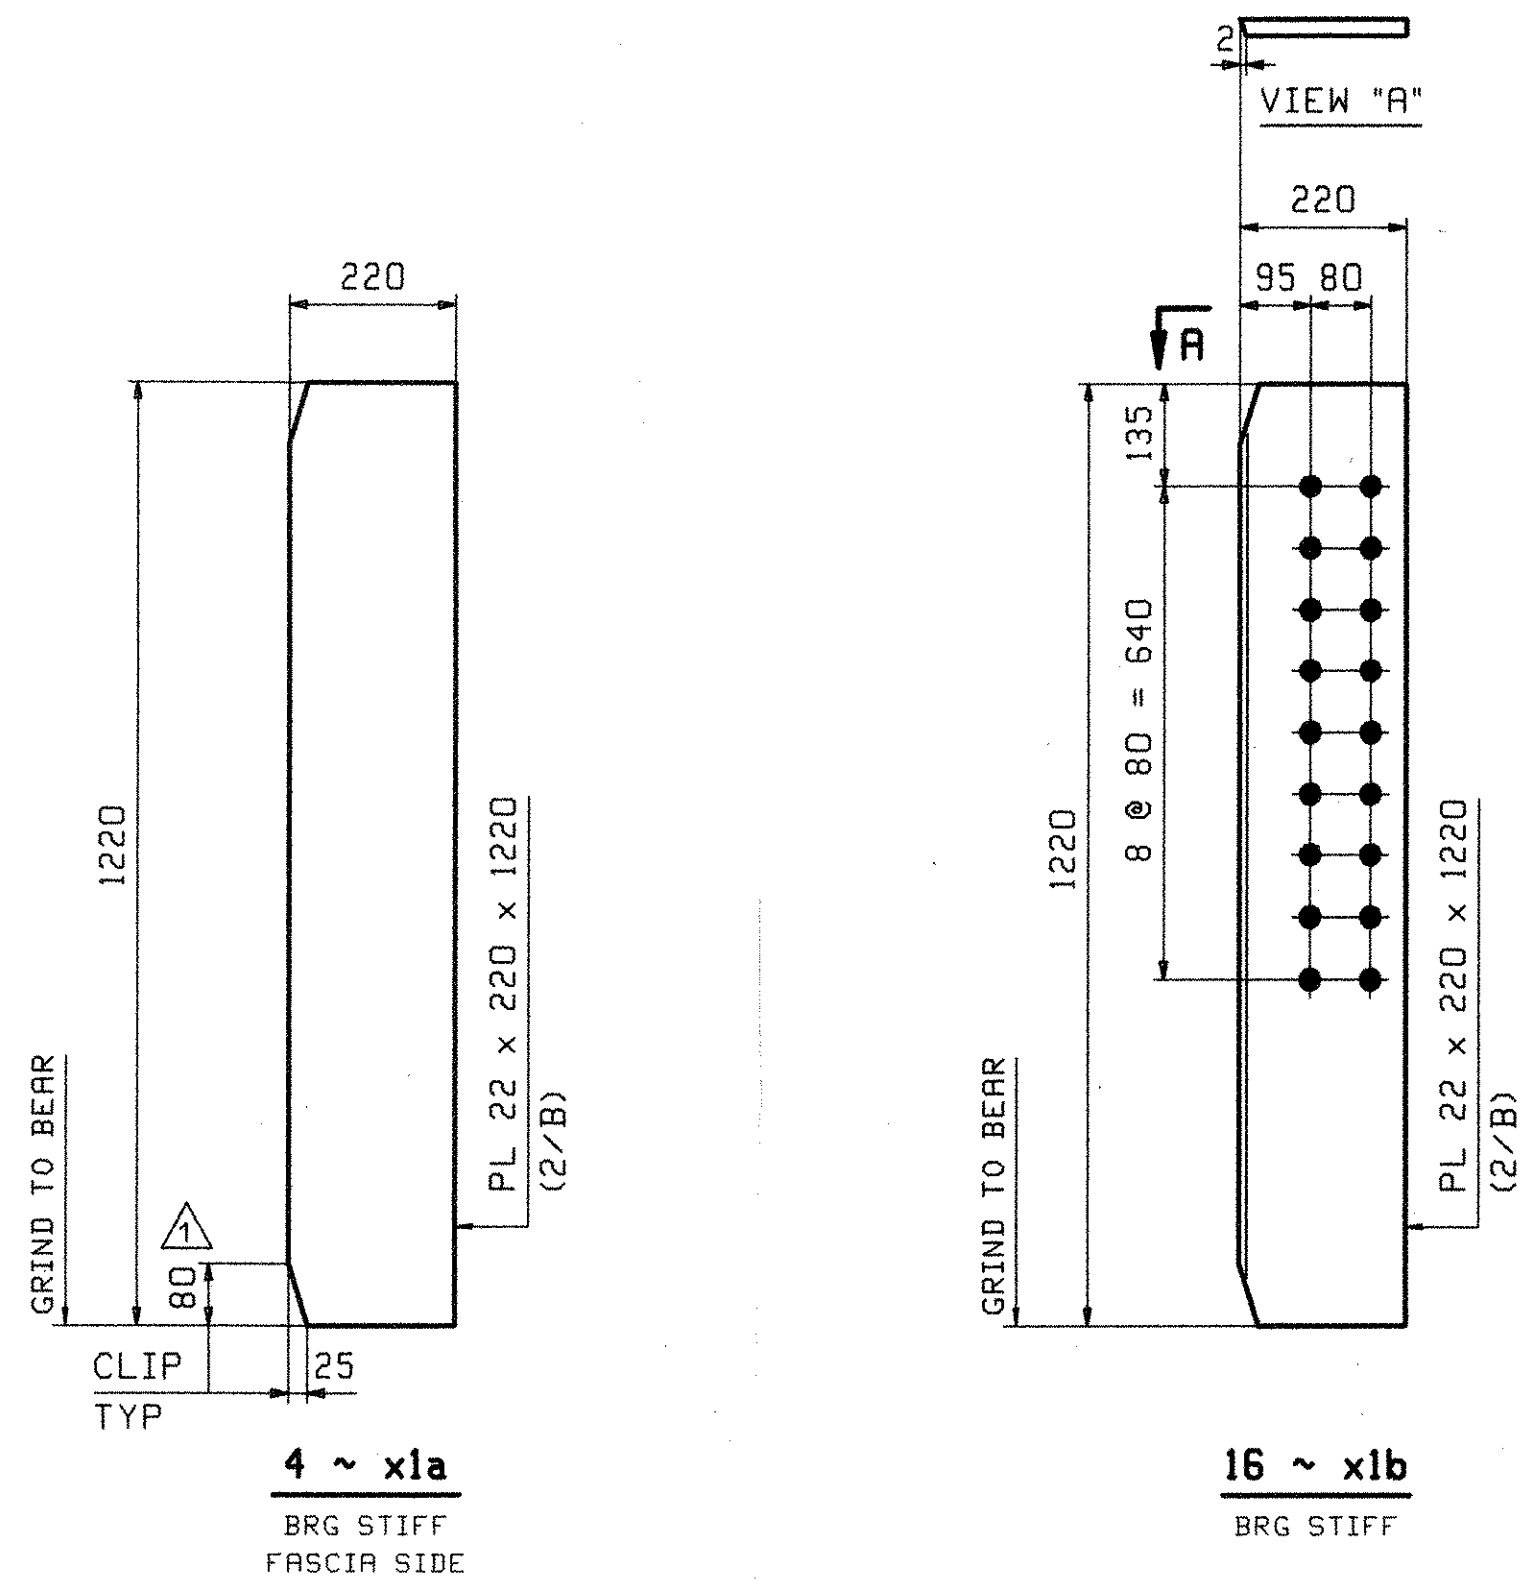

MARK "A"	QTY	(A)	
x1c	16	325	HIGH END
x1d	4	266	DROP - 59
x1f	4	256	DROP - 69
x1g	4	247	DROP - 78
x1k	4	236	DROP - 89

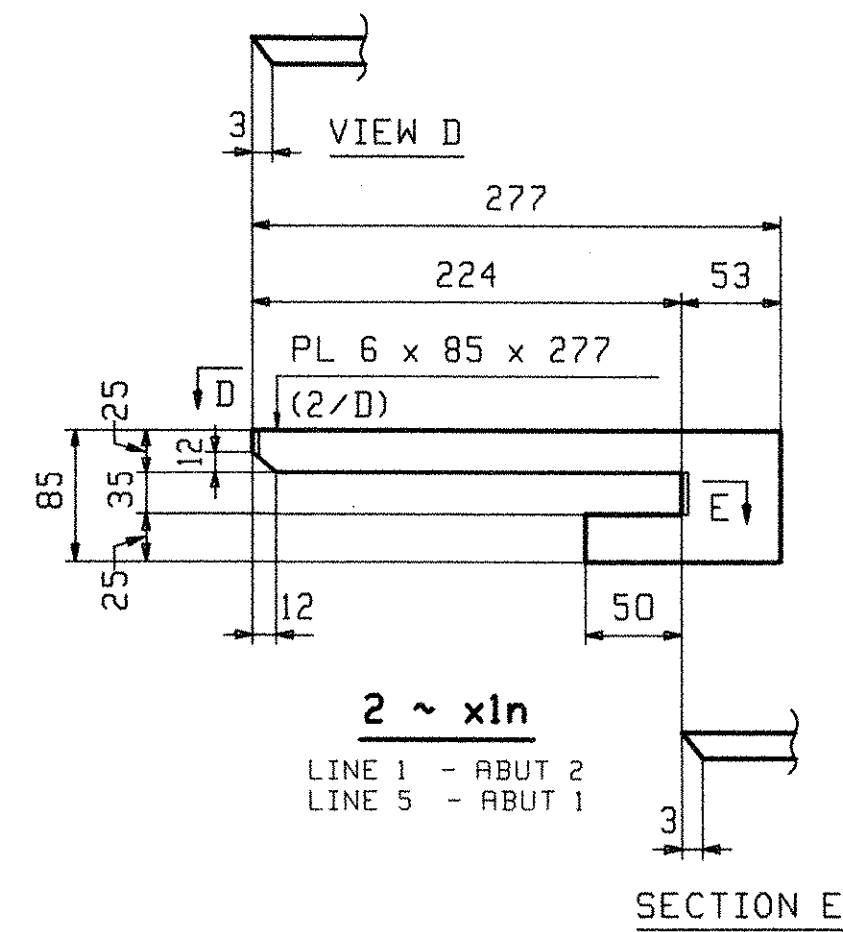
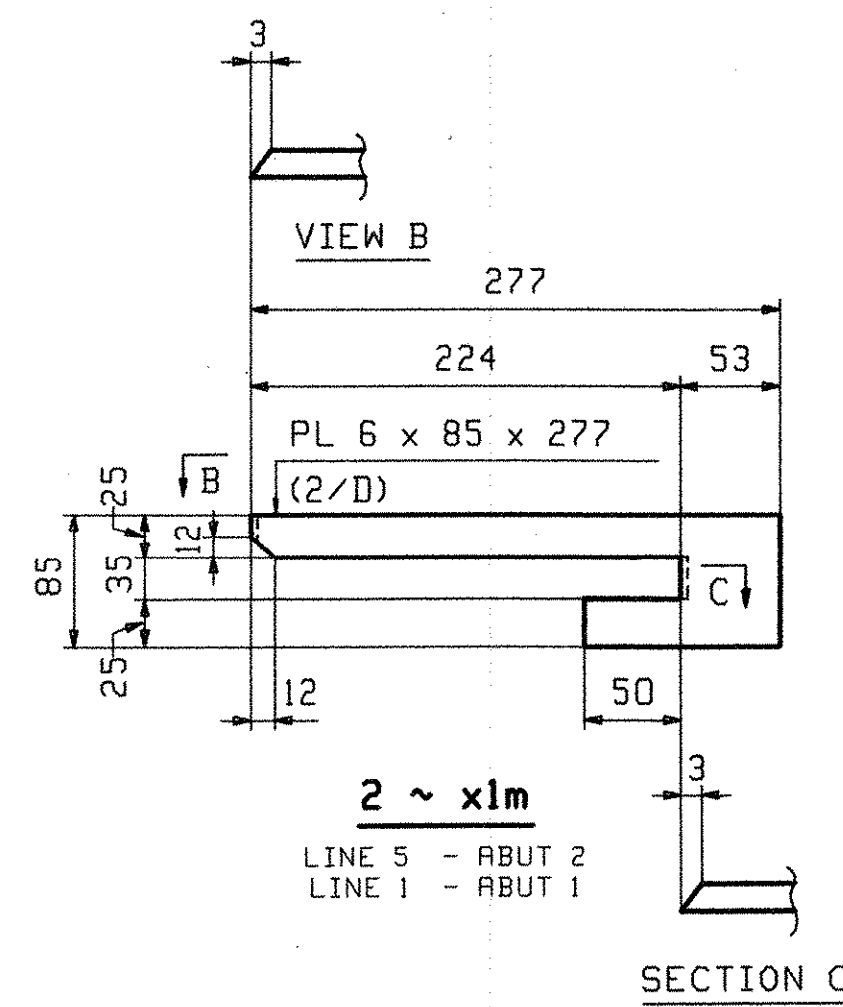


NOTES:
 ALL MATERIAL SHALL BE M270M-345W,
 ALL BOLT HOLES SHALL BE $\frac{15}{16}$ " ϕ FOR $\frac{7}{8}$ " HSB.
 FOR GENERAL NOTES SEE SHEET GNI.

OUT FOR APPROVAL	12-28-05										
OUT FOR APPROVAL	2-27-06										
ISSUED TO SHOP											
FIELD & OFFICE											
	APPROVAL COMMENTS	2/21	JTB	ELC							
REV.	REMARKS	DATE	DWN	CHK	APP	Q.A.	NO.	DIA.	LGT	TYPE	WASHER
	MATERIAL: M270M-345W										
	ELECTRODES:										
	HOLES:										
	SHOP BOLTS:										
	SURFACE PREP. & PAINT: SEE DRAWING GNI										
DESCRIPTION:	GIRDER STANDARDS							DRAWN BY	DATE		
JOB:	TH 1 (FAS 160) OVER OTTER CREEK							JTB	11/08		
	BRIDGE NO. 6							CHKD BY			
	TOWN OF LEICESTER, VERMONT							ELC	12/06		
	COUNTY OF ADDISON							APPROV BY			
	CONTRACTOR: BLOW & COTE							SUPERVISOR	W. J. GATTI		
PROJ NO.	BRF D160(3)S							Q.A.			
CUSTOMER:	VT AOT										
CASCO BAY STEEL STRUCTURES, INC.											
75 SPRING HILL ROAD	SACO, MAINE 04072			JOB NO.	285	DRG. NO.	X1				
PHONE (207) 282-7360	FAX. (207) 282-1179			REV.							






RECEIVED
 CK'D BY: OK'D BY: _____
 MAR 03 2006
 RESUBMIT: _____ APPROVED: _____
 BY: DATE: 3/6/06

ABM INFO		BILL OF MATERIAL				JOB NO.	DRAWING NO.	REV.	
PAGE	LINE	MARK	QTY	MARK	MATERIAL	LENGTH	REMARKS	WT	PROCUREMENT NOTES
						m			
						mm			
		IG1	1		GIRDER			10981 kg 24209 lb	
1	G		1	wa	PL 13x1220	11 625	(M270M-345HT2)	(H2-3)	
1	E		1	wb	PL 13x1220	22 295	(M270M-345HT2)	(H2-3)	
1	J		1	ta	PL 25x406	22 600			
1	L		1	tb	PL 25x406	11 318			
1	A		1	ba	PL 35x406	22 600	(M270M-345HT2)	(H2-3)	
1	C		1	bb	PL 35x406	11 282	(M270M-345HT2)	(H2-3)	
2	B		2	xia	PL 22x220	1 220		MIE	
2	B		2	xib	PL 22x220	1 220		MIE	
2	C		1	xid	PL 13x178	1 220			
2	C		1	xif	PL 13x178	1 220			
2	C		1	xig	PL 13x178	1 220			
2	C		1	xik	PL 13x178	1 220			
2	D		1	xim	PL 6x85	0 277			
2	D		1	xin	PL 6x85	0 277			

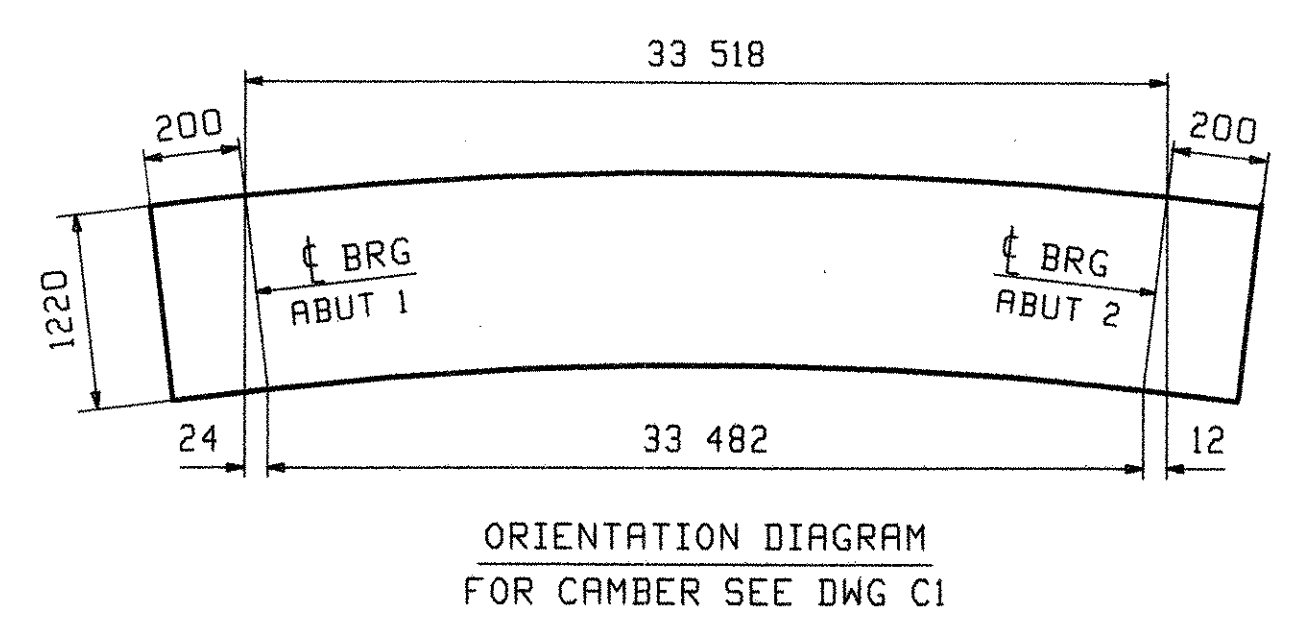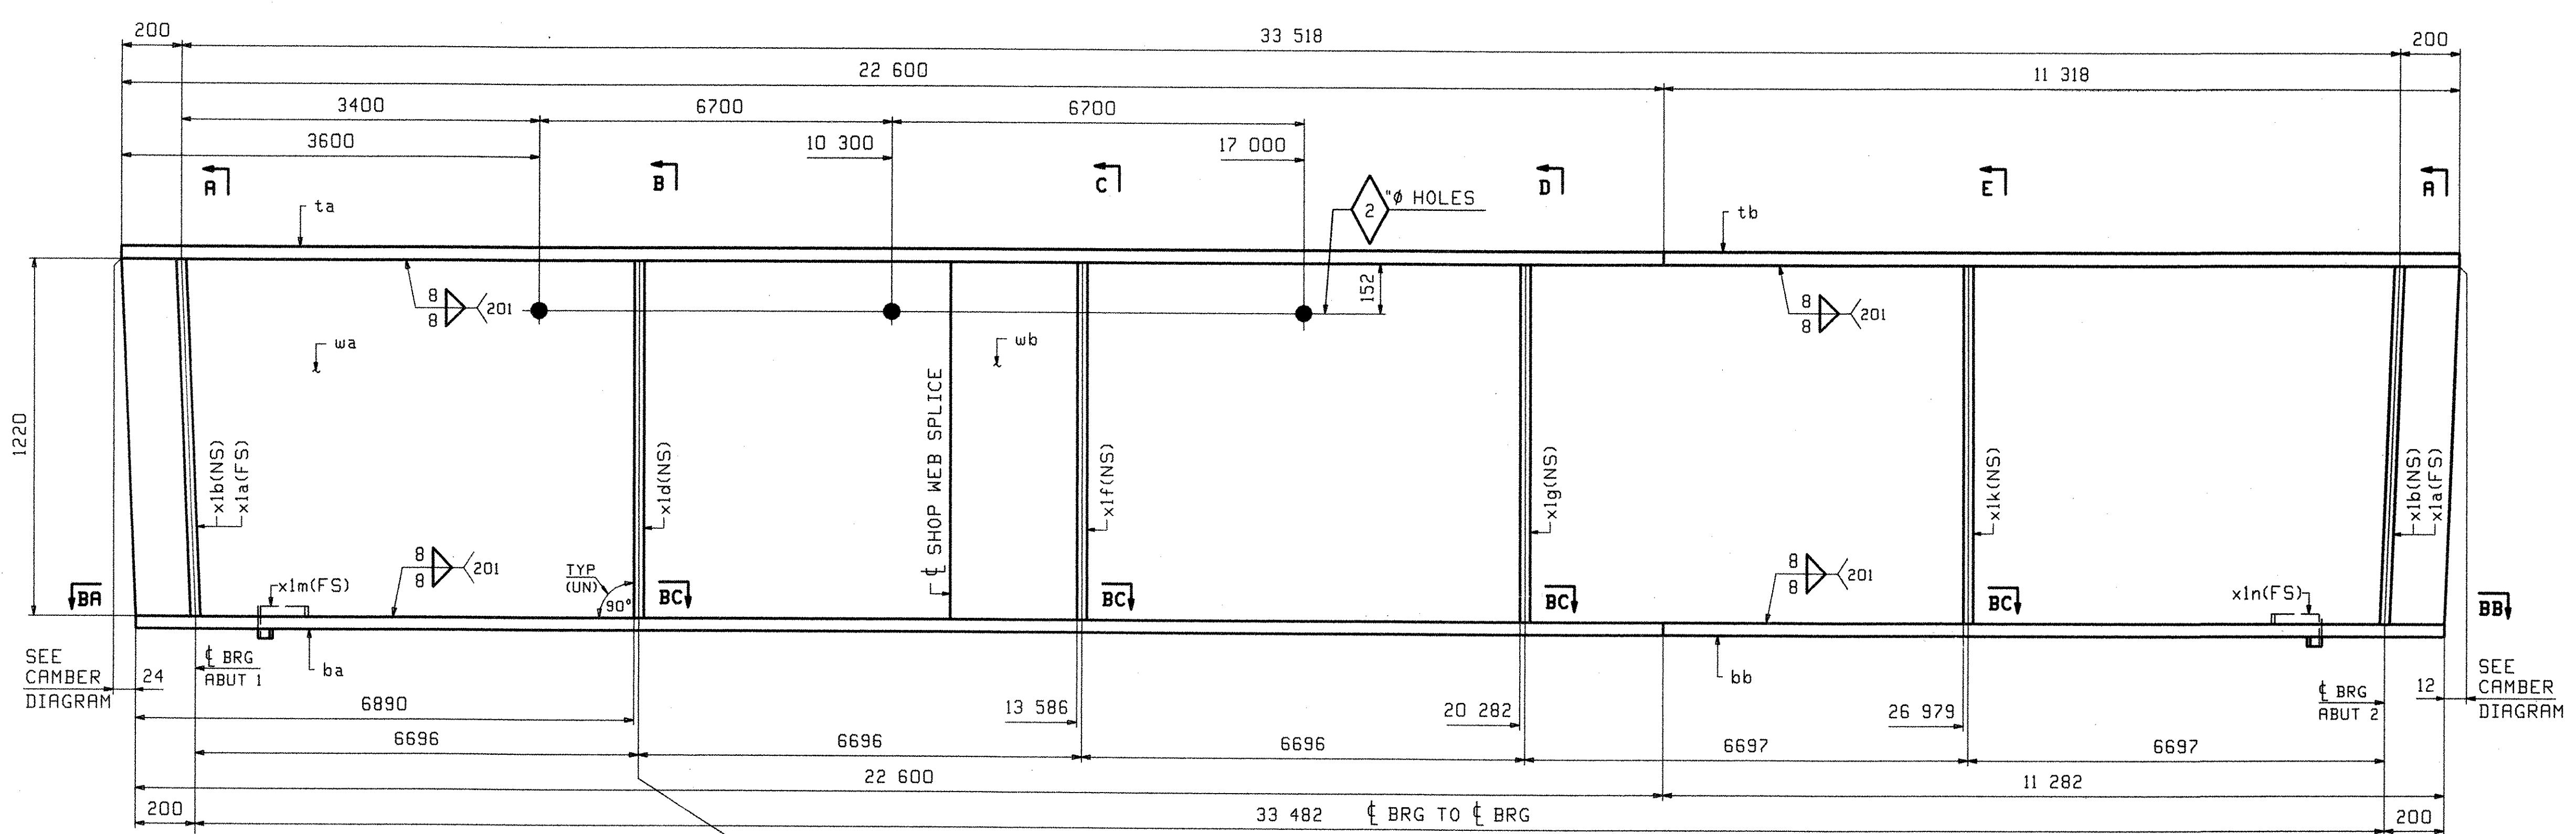


ONE - GIRDER - IG1

FOR GIRDER STANDARD DETAILS SEE DRAWING X1.
 FOR CAMBER DIAGRAM SEE DRAWING C1.
 FOR GENERAL NOTES SEE DRAWING GNI.
 H2-3 DENOTES MATERIAL SUBJECT TO CHАРY V-NOTCH TESTING.

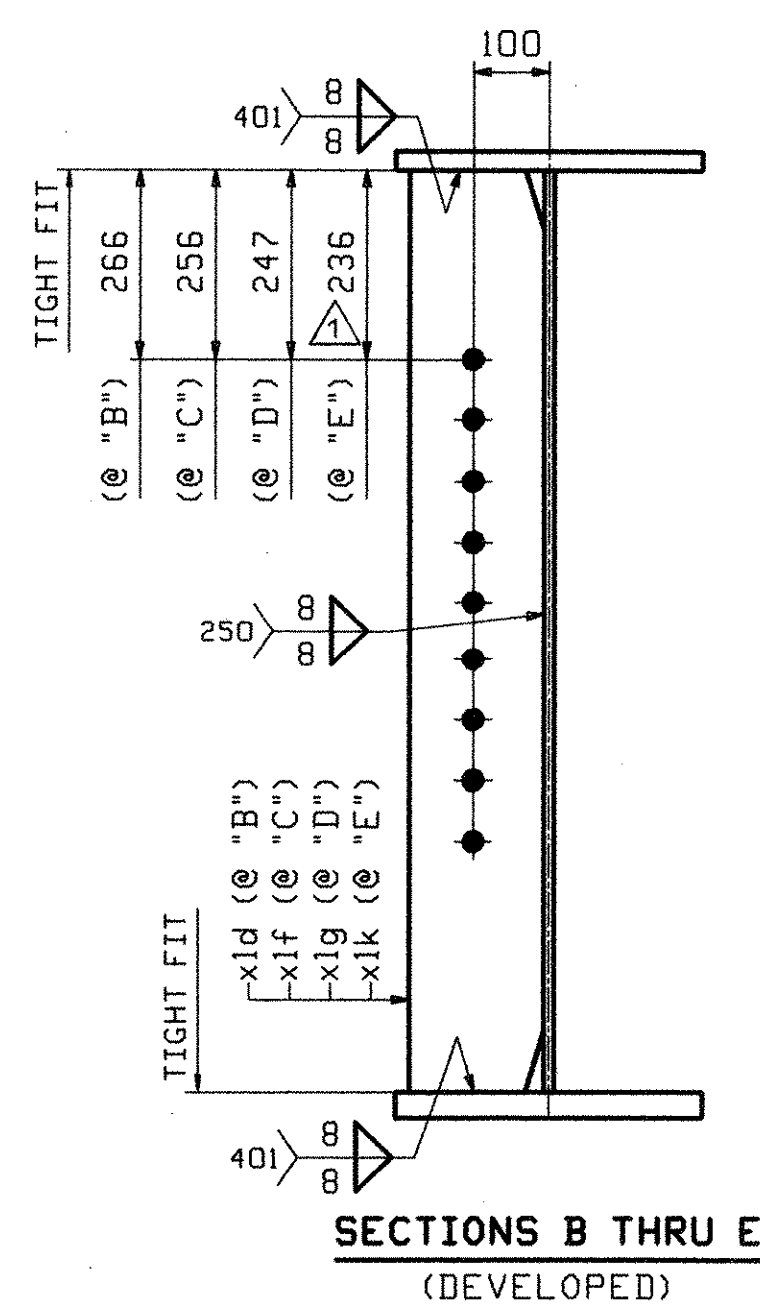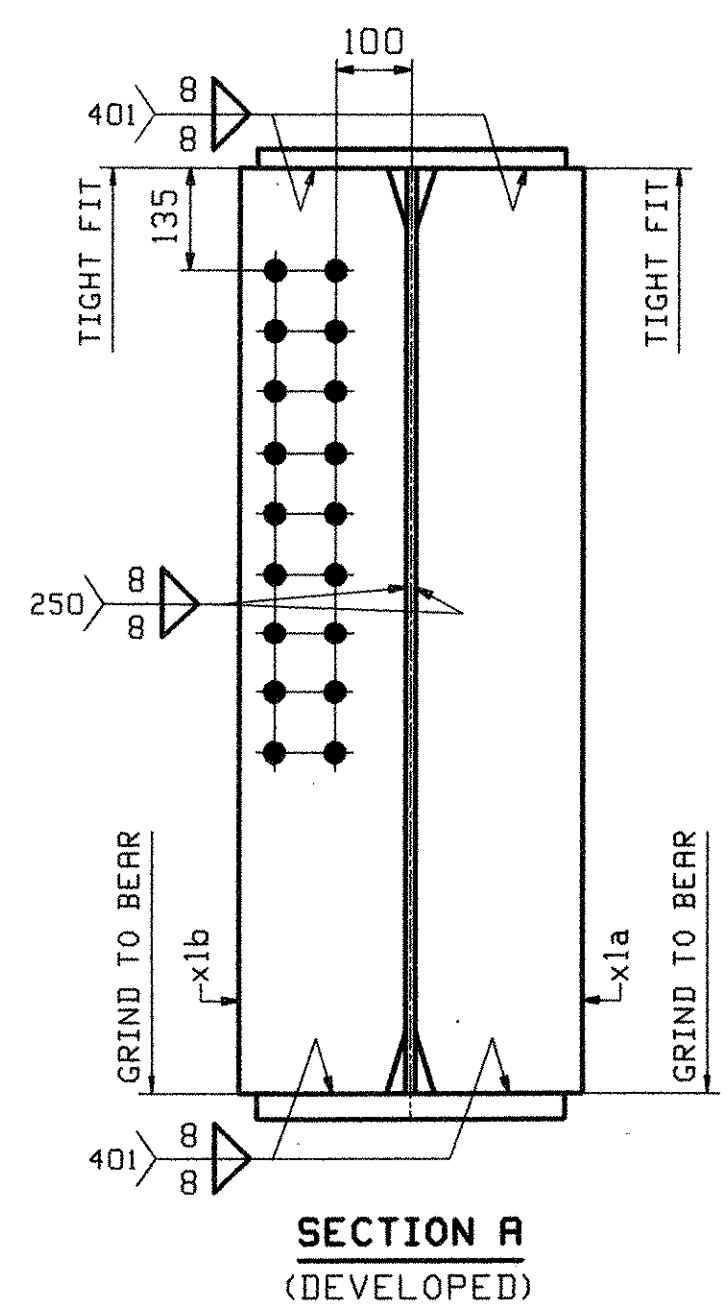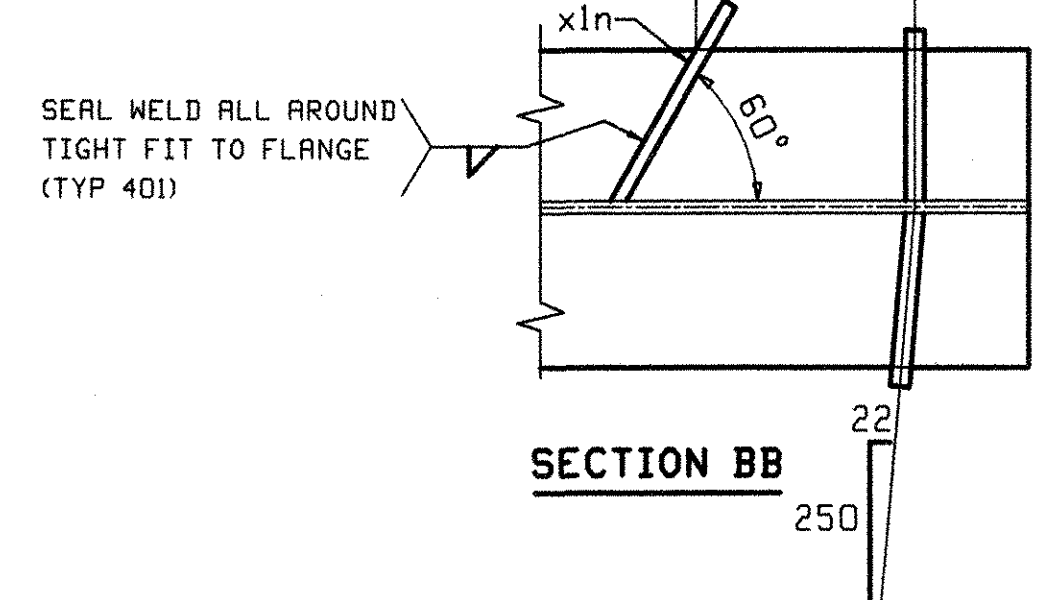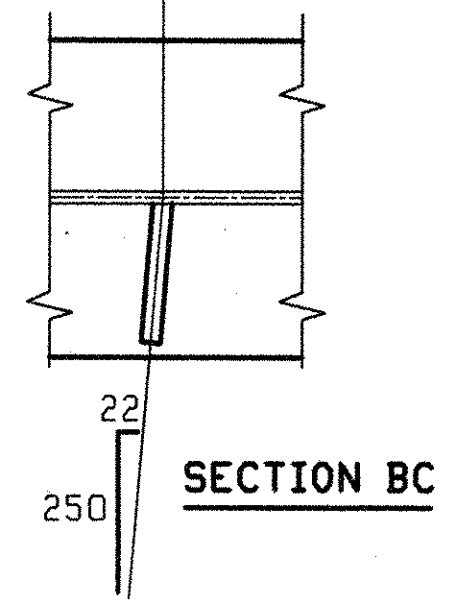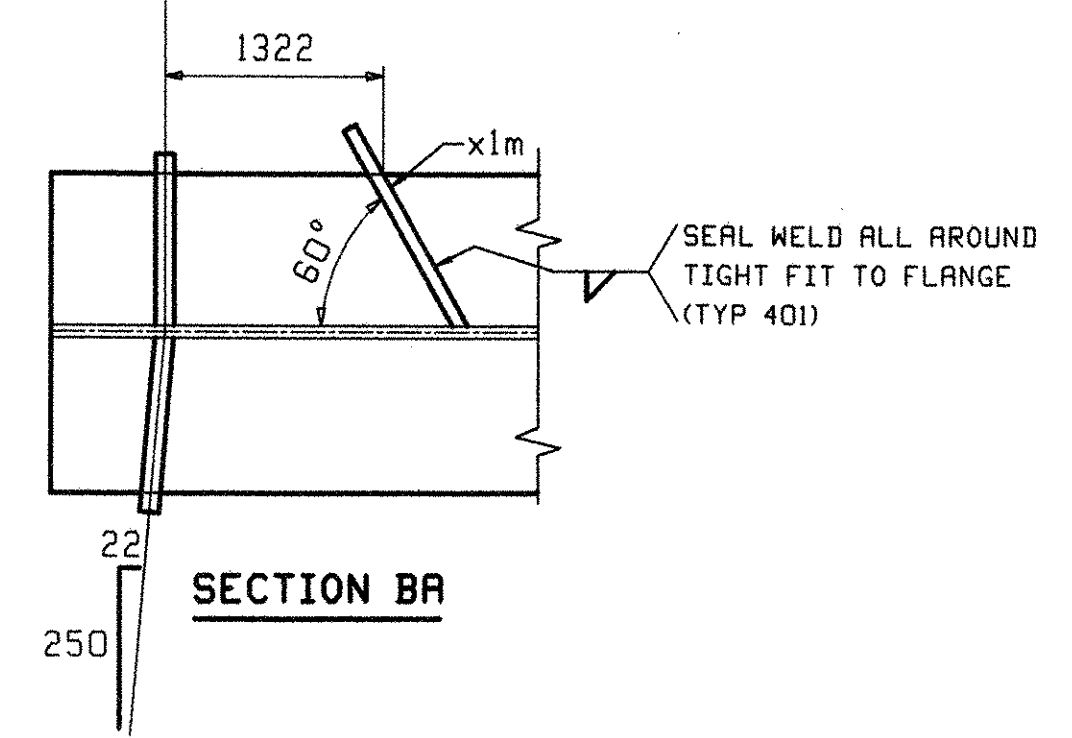

OUT FOR APPROVAL	12-28-05										
OUT FOR APPROVAL	2-27-06										
ISSUED TO SHOP											
FIELD & OFFICE											
APPROVAL COMMENTS	2/21	JTB	ELC								
REV.	REMARKS	DATE	DWN	CHK	APP	Q.A.	NO.	DIA.	LGT	TYPE	WASHER
	MATERIAL:										
	M270M GR 345W									15 16φ (UN)	NONE
SURFACE PREP. & PAINT:											
SEE DRAWING GNI											
DESCRIPTION: GIRDER - IG1										DRAWN BY	DATE
JOB: TH 1 (FAS 160) OVER OTTER CREEK										JTB	11/08
BRIDGE NO. 6										CHKD BY	
TOWN OF LEICESTER, VERMONT										ELC	12/06
COUNTY OF ADDISON										APPROV BY	
CONTRACTOR: BLOW & COTE										SUPERVISOR	W. J. GATTI
PROJ NO. BRF 0160(3)S										Q.A.	
CUSTOMER: VT ROT											
CASCO BAY STEEL STRUCTURES, INC.										JOB NO.	DRG. NO.
75 SPRING HILL ROAD										285	1
PHONE (207) 282-7360										SACO, MAINE 04072	
										FAX. (207) 282-1179	REV. ▲


RECEIVED
 CR'D BY: [Signature] OK'D BY: [Signature]
 MAR 03 2006
 RESUBMIT APPROVED
 BY: [Signature] DATE: 3/6/06

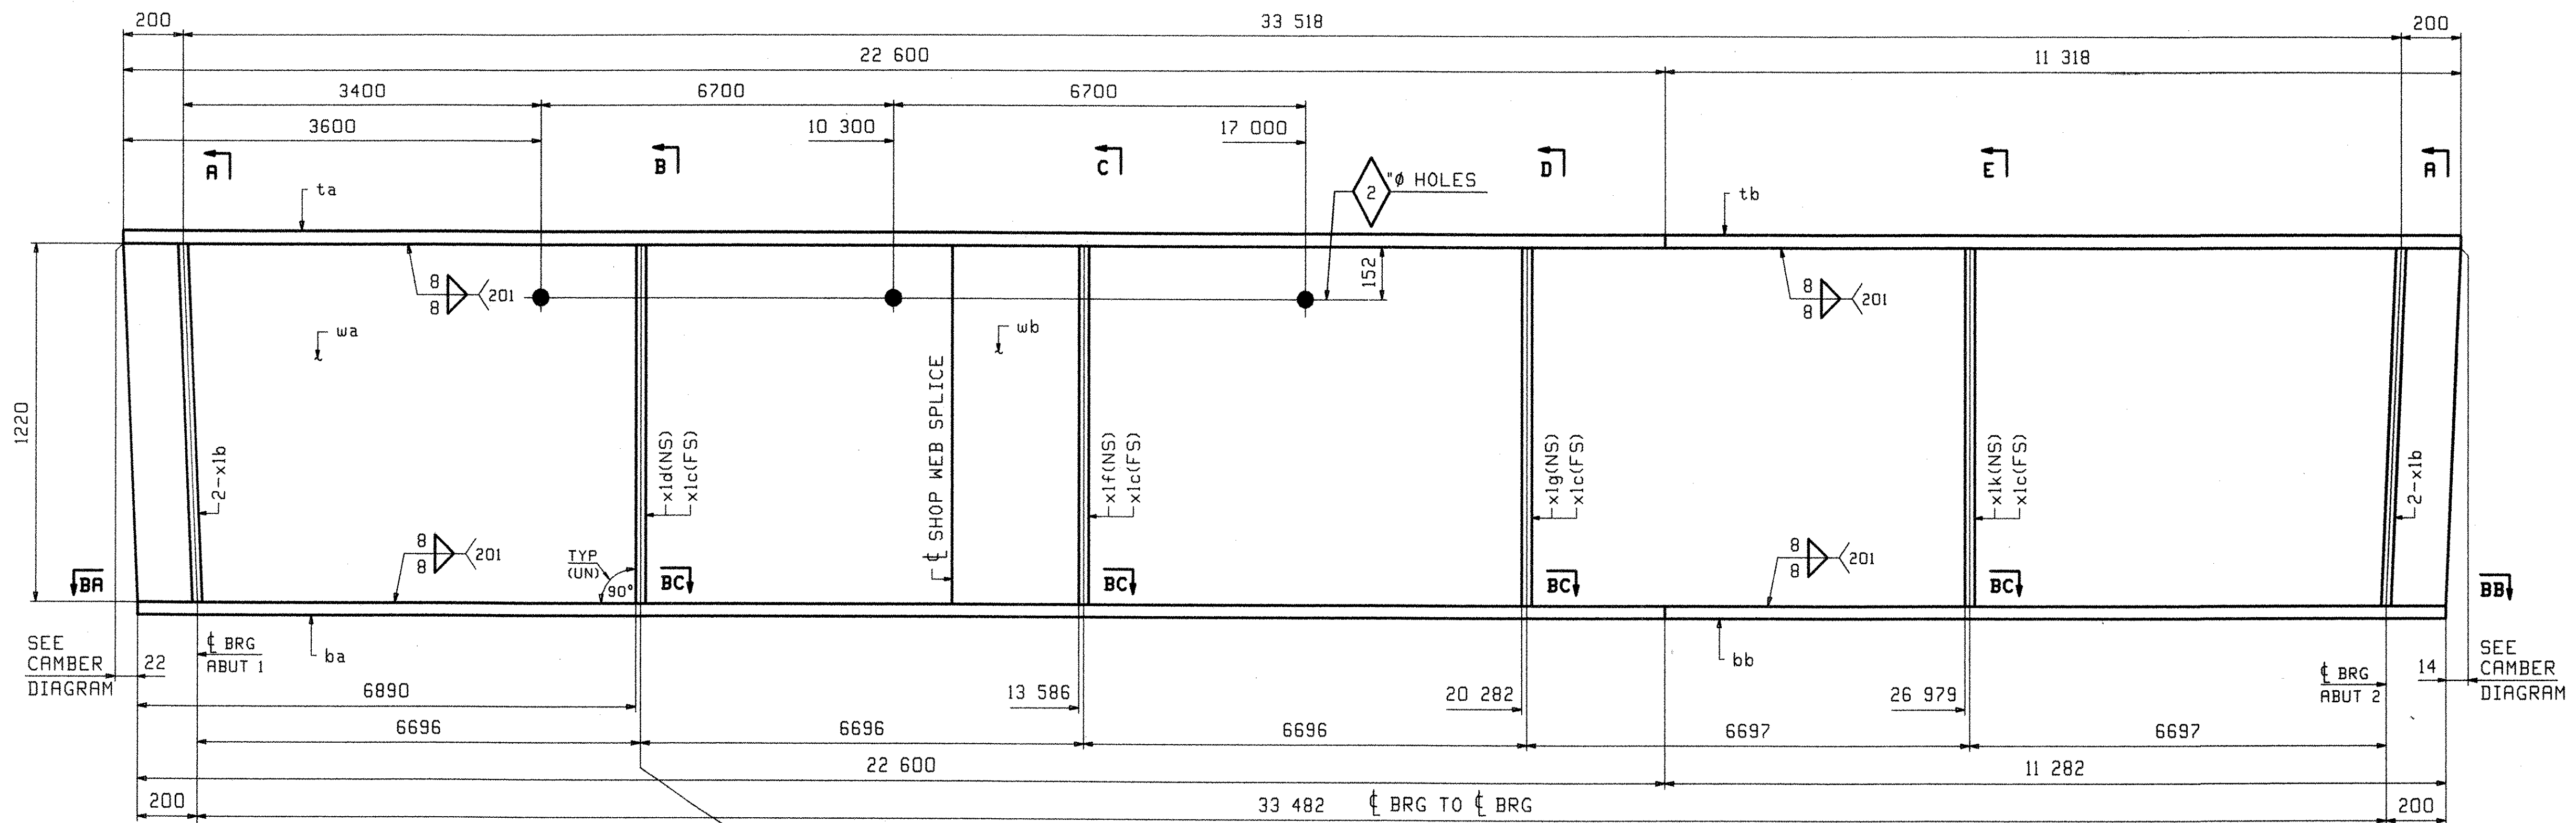


ABM INFO		SHIP		BILL OF MATERIAL				JOB NO.	DRAWING NO.	REV.
								285	2	
PAGE	LINE	MARK	QTY	MARK	MATERIAL	LENGTH		REMARKS	WT	PROCUREMENT NOTES
						m	mm			
		2G2	1		GIRDER				1068 kg 23400 lb	
1	G		1	wa	PL 13x1220	11	623	(M270M-345HT2)	(H2-3)	
1	E		1	wb	PL 13x1220	22	297	(M270M-345HT2)	(H2-3)	
1	J		1	ta	PL 25x406	22	600			
1	L		1	tb	PL 25x406	11	318			
1	A		1	ba	PL 35x406	22	600	(M270M-345HT2)	(H2-3)	
1	C		1	bb	PL 35x406	11	282	(M270M-345HT2)	(H2-3)	
2	B		4	x1b	PL 22x220	1	220	M/E		
2	C		4	x1c	PL 13x178	1	220			
2	C		1	x1d	PL 13x178	1	220			
2	C		1	x1f	PL 13x178	1	220			
2	C		1	x1g	PL 13x178	1	220			
2	C		1	x1k	PL 13x178	1	220			

ONE - GIRDER - 2G2


FOR GIRDER STANDARD DETAILS SEE DRAWING XI.
 FOR CAMBER DIAGRAM SEE DRAWING C1.
 FOR GENERAL NOTES SEE DRAWING GNI.
 H2-3 DENOTES MATERIAL SUBJECT TO CHARPY V-NOTCH TESTING.

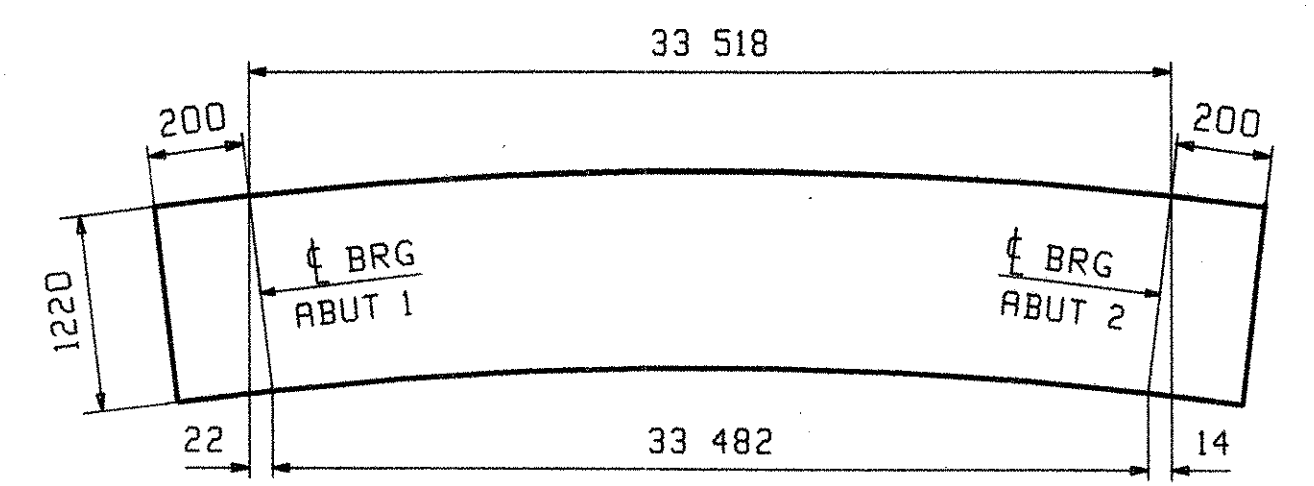


ORIENTATION DIAGRAM
FOR CAMBER SEE DWG C1

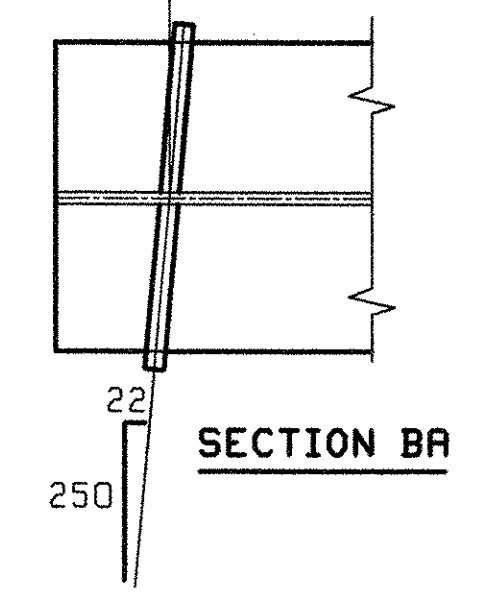


SECTION BA

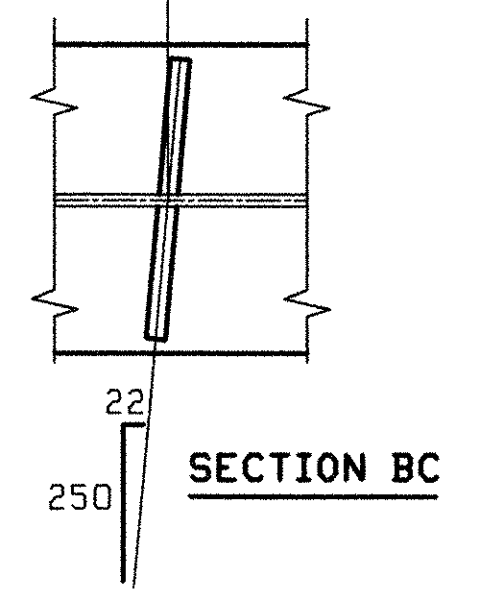


SECTION BC

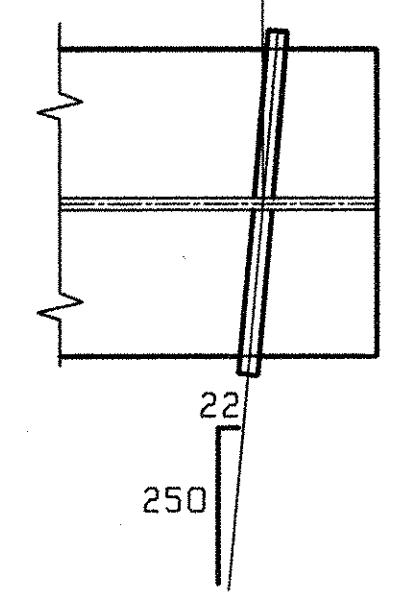

SECTION BB

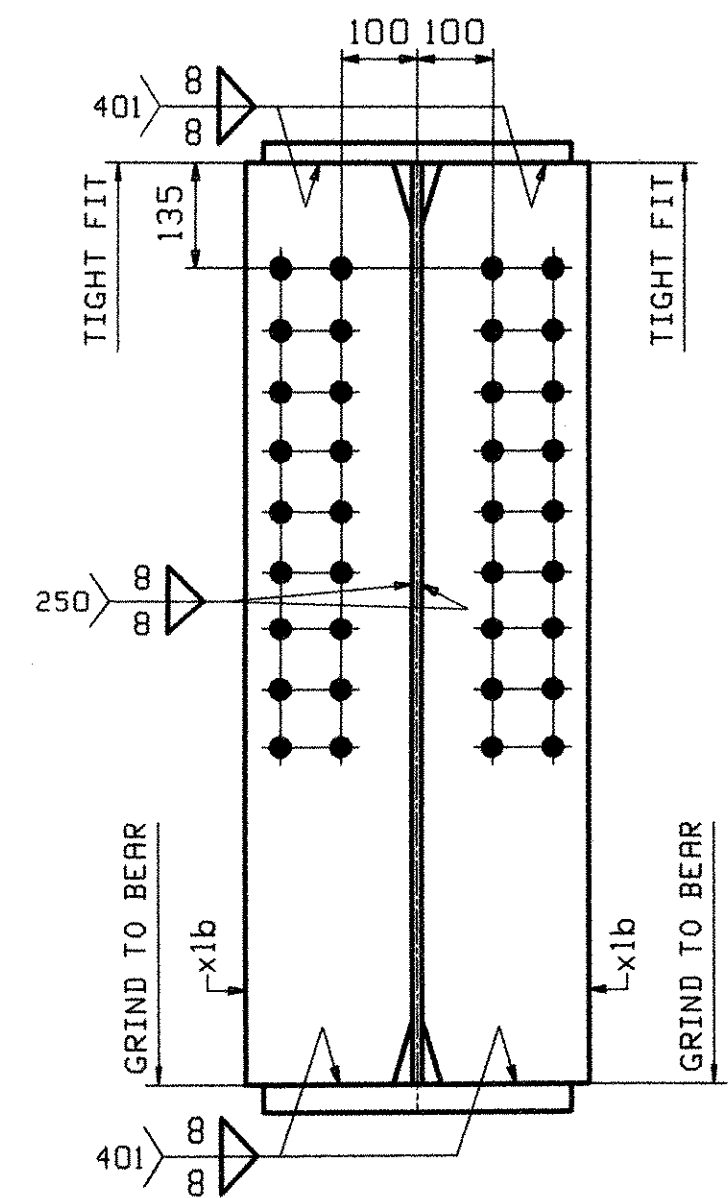

SECTION A (DEVELOPED)

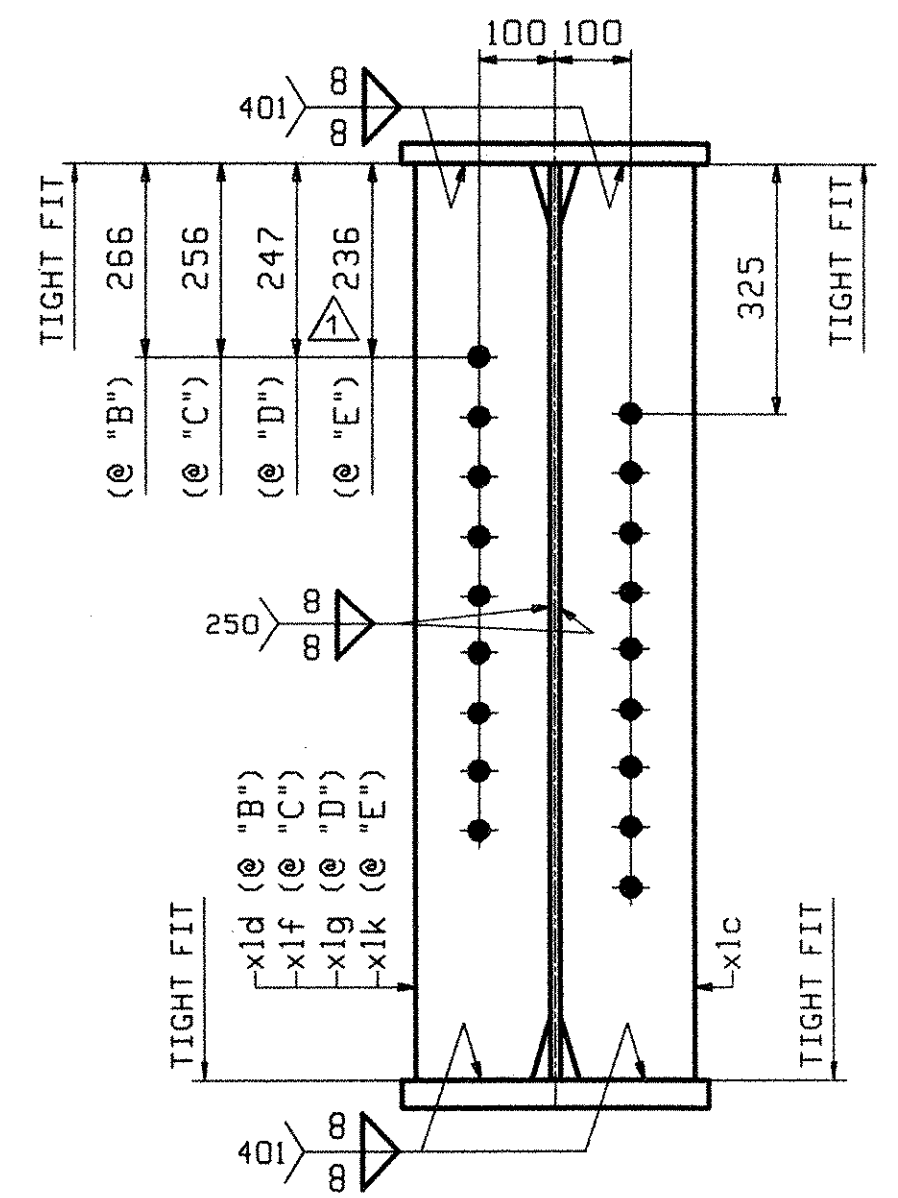

SECTIONS B THRU E (DEVELOPED)


OUT FOR APPROVAL	8-28-05										
OUT FOR APPROVAL	8-27-06										
ISSUED TO SHOP											
FIELD & OFFICE											
APPROVAL COMMENTS	2/21	JTB	ELC								
REV.	REMARKS	DATE	DWN	CHK	APP	Q.A.	NO.	DIA.	LGT	TYPE	WASHER
MATERIAL:		ELECTRODES:		HOLES:		SHOP BOLTS:					
M270M GR 345W				15 16 (UN)		NONE					

SURFACE PREP. & PAINT:
SEE DRAWING GNI


DESCRIPTION:	GIRDER - 2G2	DRAWN BY	JTB	DATE	11/08
JOB:	TH 1 (FAS 160) OVER OTTER CREEK	CHKD BY	ELC	DATE	12/06
	BRIDGE NO. 6	APPROV BY	W. J. GATTI		
	TOWN OF LEICESTER, VERMONT	SUPERVISOR			
	COUNTY OF ADDISON				
	CONTRACTOR: BLOW & COTE				
PROJ NO.	BRF D160(3)S	Q.A.			
CUSTOMER:	VT ROT				

CASCO BAY STEEL STRUCTURES, INC.
 75 SPRING HILL ROAD SACO, MAINE 04072
 PHONE (207) 282-7360 FAX. (207) 282-1179

RECEIVED
 OK'D BY: [Signature] OK'D BY: [Signature]
 MAR 03 2006
 RESUBMIT APPROVED
 BY: [Signature] DATE: 3/6/06

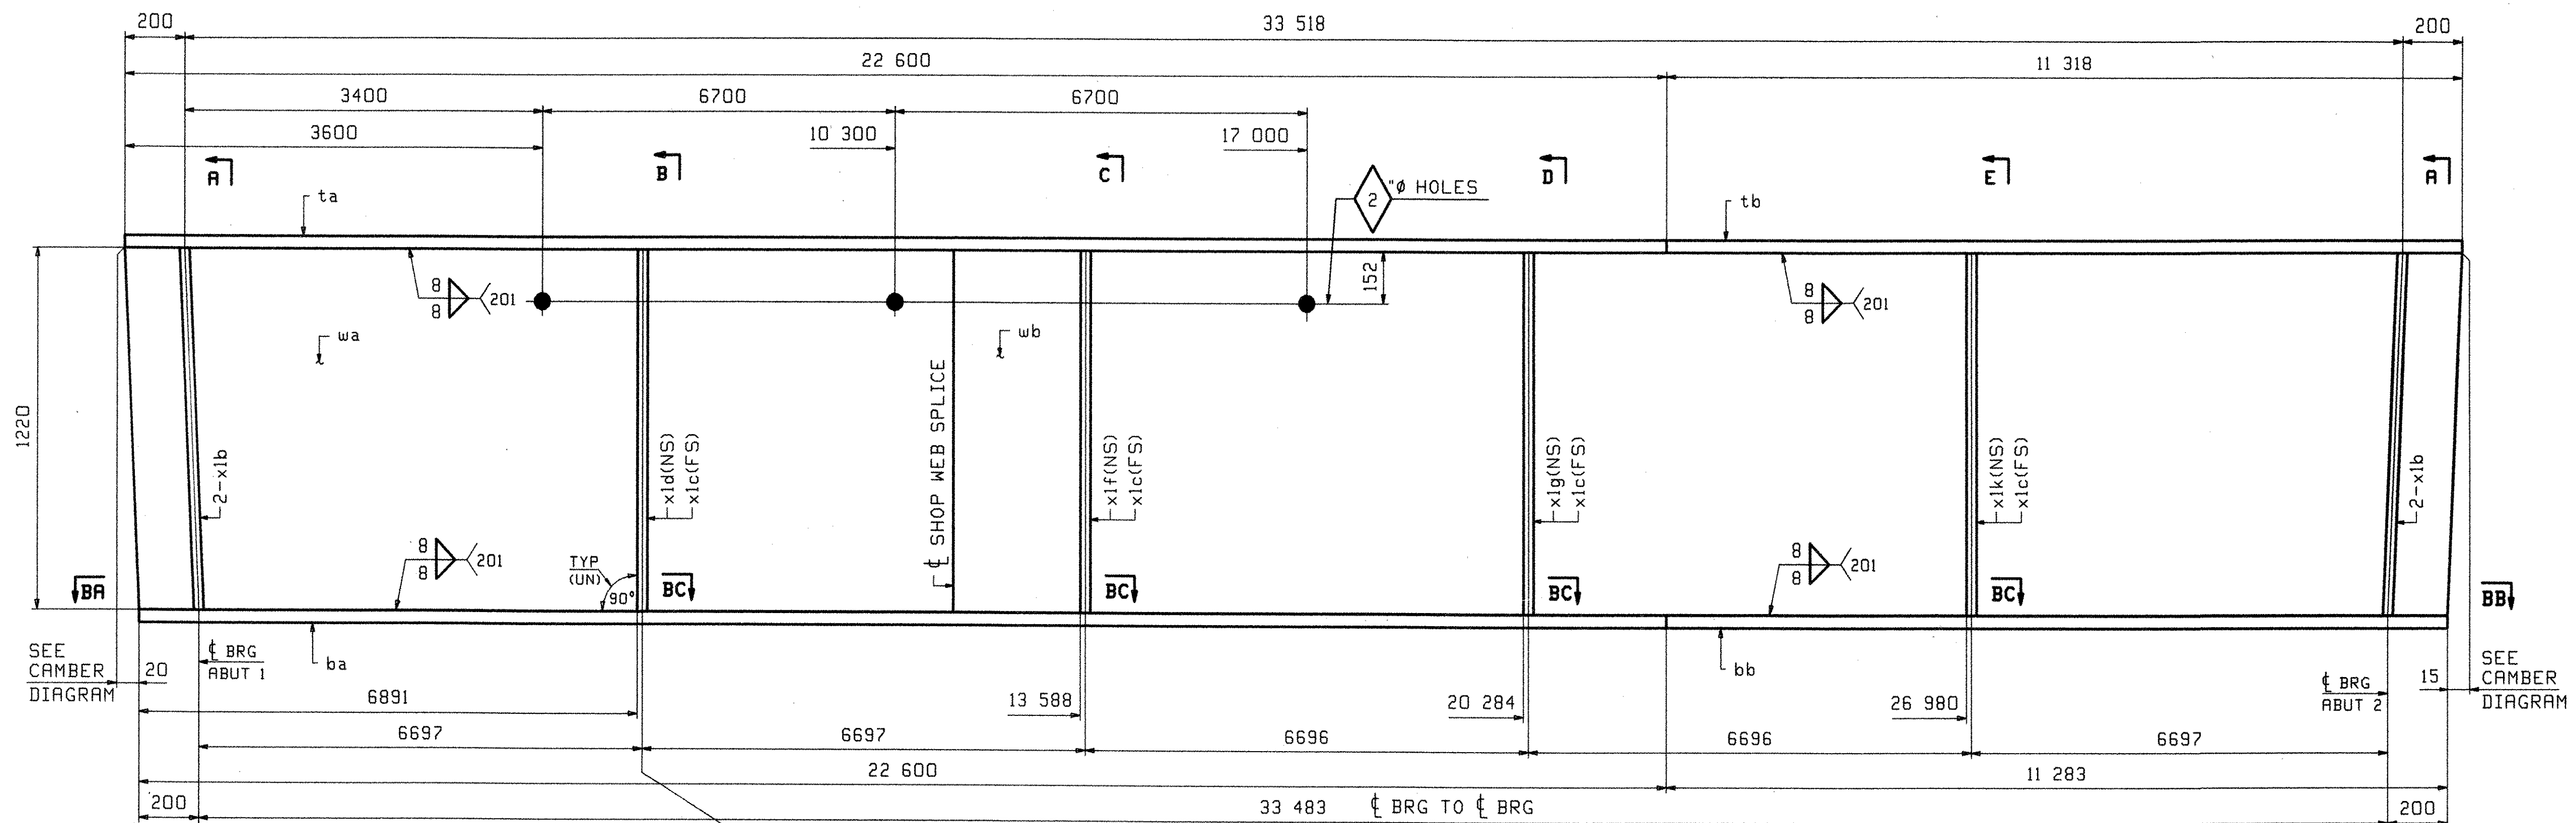


ABM INFO		SHIP		BILL OF MATERIAL				JOB NO.	DRAWING NO.	REV.
								285	3	
PAGE	LINE	MARK	QTY	MARK	MATERIAL	LENGTH	REMARKS	WT	PROCUREMENT NOTES	
						m				
						mm				
		3G3	1		GIRDER			1088 kg 24400 lb		
1	G		1	wa	PL 13x1220	11 621	(M270M-345HT2)	(H2-3)		
1	E		1	wb	PL 13x1220	22 299	(M270M-345HT2)	(H2-3)		
1	J		1	ta	PL 25x406	22 600				
1	L		1	tb	PL 25x406	11 318				
1	A		1	ba	PL 35x406	22 600	(M270M-345HT2)	(H2-3)		
1	C		1	bb	PL 35x406	11 283	(M270M-345HT2)	(H2-3)		
2	B		4	x1b	PL 22x220	1 220		MIF		
2	C		4	x1c	PL 13x178	1 220				
2	C		1	x1d	PL 13x178	1 220				
2	C		1	x1f	PL 13x178	1 220				
2	C		1	x1g	PL 13x178	1 220				
2	C		1	x1k	PL 13x178	1 220				

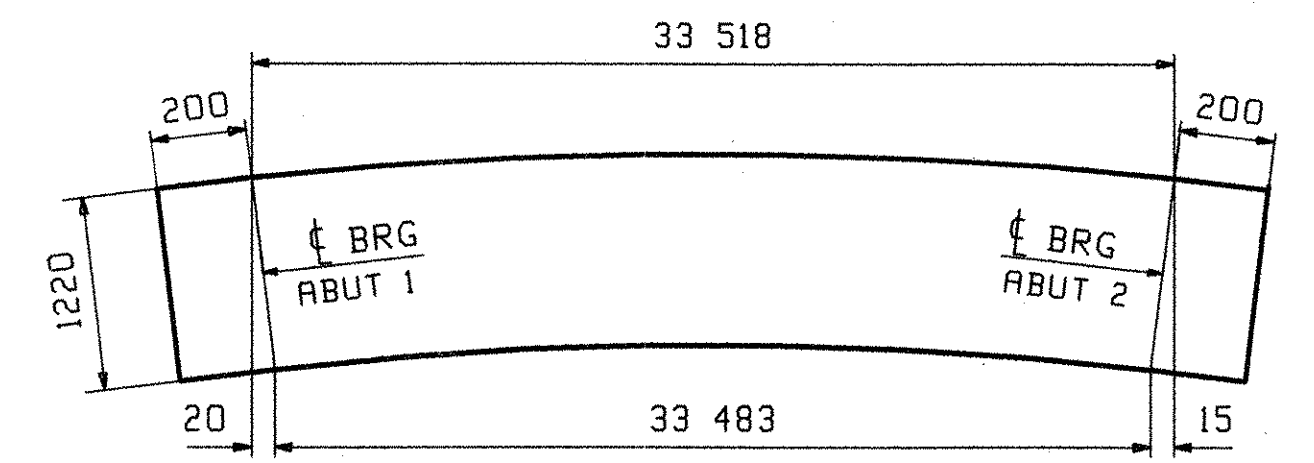


ORIENTATION DIAGRAM FOR CAMBER SEE DWG C1

ONE - GIRDER - 3G3


FOR GIRDER STANDARD DETAILS SEE DRAWING XI.
 FOR CAMBER DIAGRAM SEE DRAWING C1.
 FOR GENERAL NOTES SEE DRAWING GNI.
 H2-3 DENOTES MATERIAL SUBJECT TO CHARPY V-NOTCH TESTING.

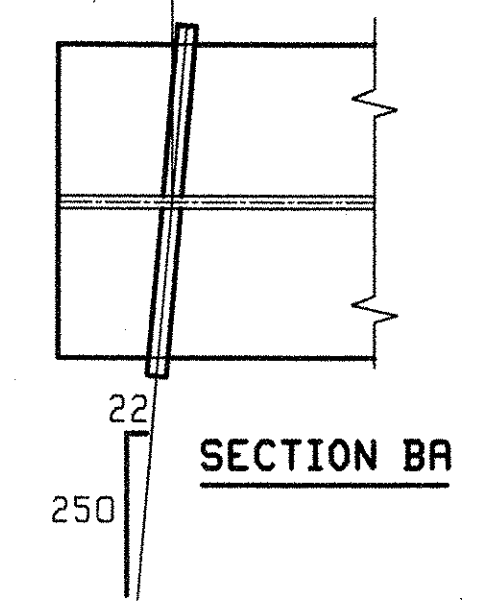


SECTION BA

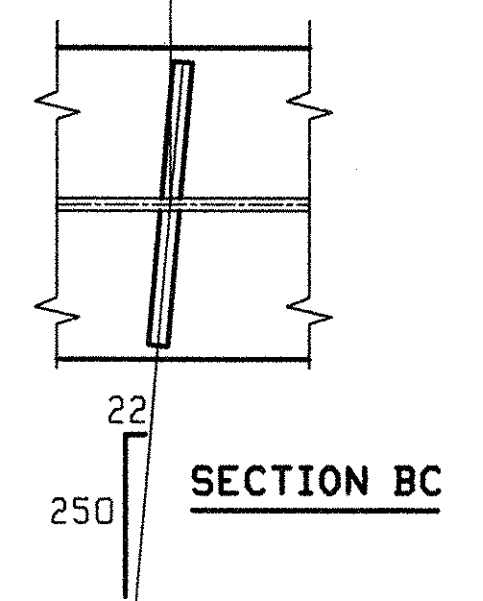


SECTION BC

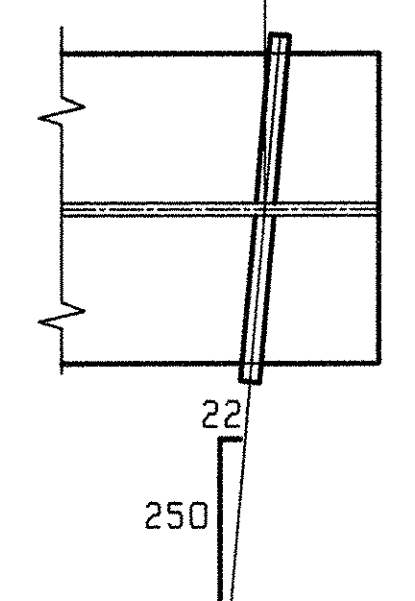

SECTION BB

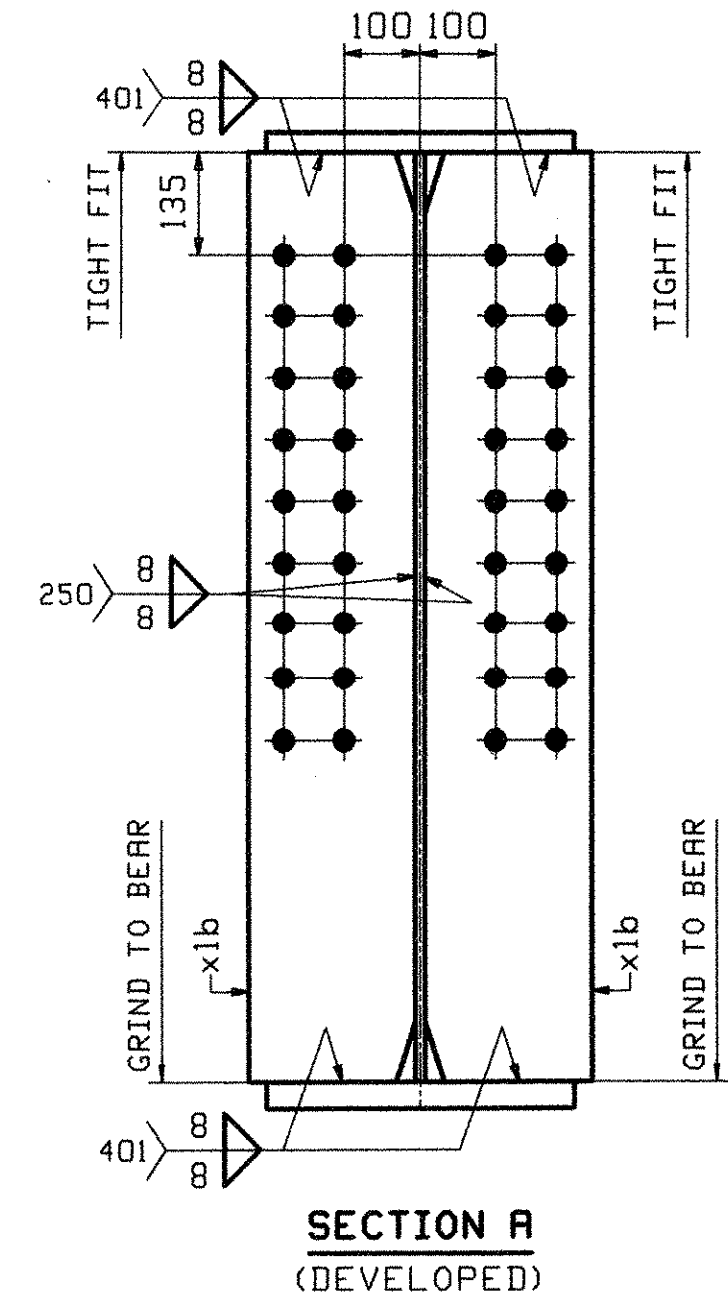

SECTION A (DEVELOPED)

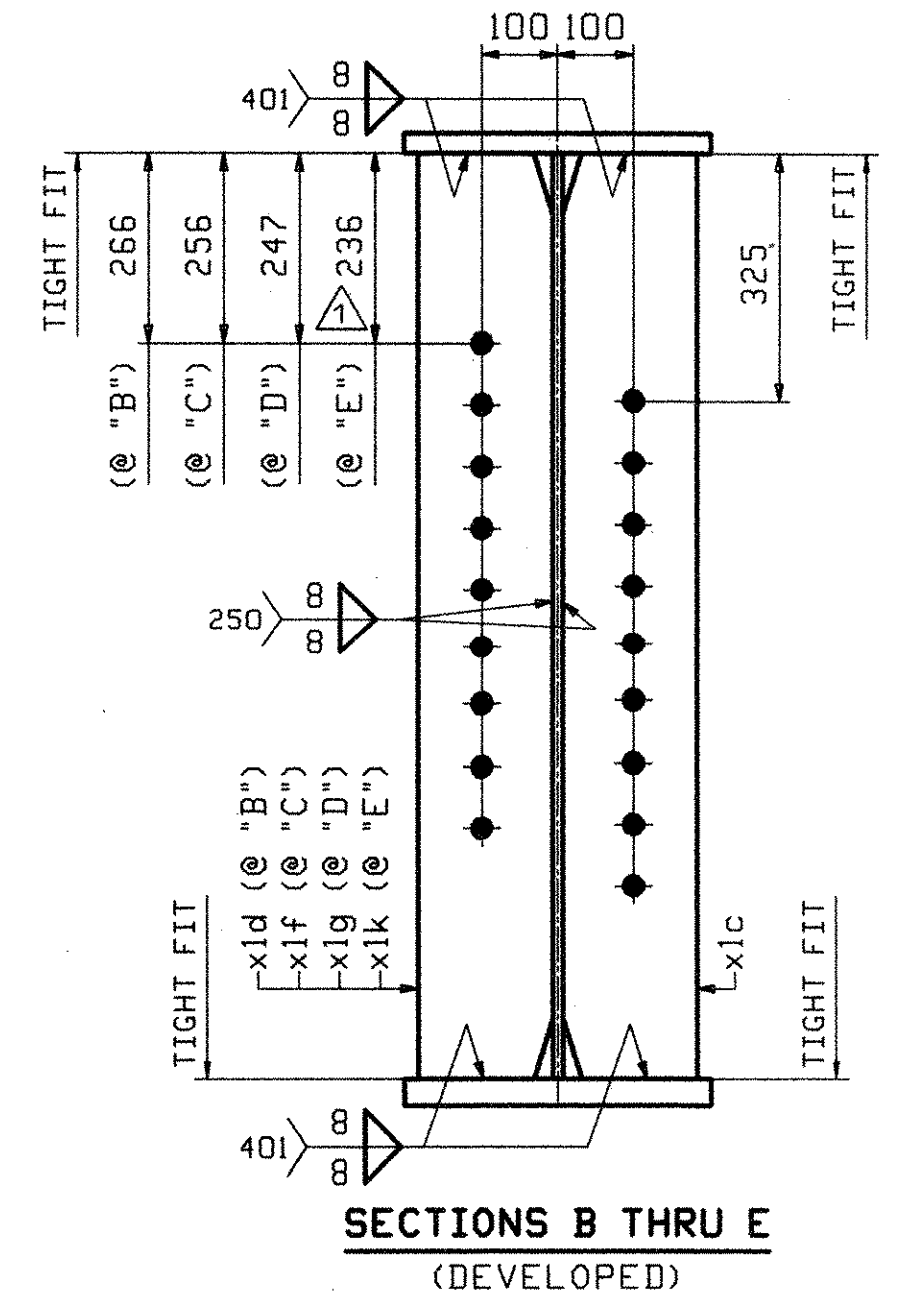


SECTIONS B THRU E (DEVELOPED)

RECEIVED
 OK'D BY: [Signature] OK'D BY: [Signature]
 MAR 03 2006
 RESUBMIT: [Signature] APPROVED: [Signature]
 BY: [Signature] DATE: 3/6/06






OUT FOR APPROVAL	12-28-05																			
OUT FOR APPROVAL	2-27-06																			
ISSUED TO SHOP																				
FIELD & OFFICE																				
APPROVAL COMMENTS	2/21	JTB	ELC																	
REV.	REMARKS	DATE	DNW	CHK	APP	Q.A.	NO.	DIA.	LGT	TYPE	WASHER									
	MATERIAL:																			
	M270M GR 345W																			
	ELECTRODES:																			
	HOLES:																			
	15																			
	16																			
	(UN)																			
	SHOP BOLTS:																			
	NONE																			
SURFACE PREP. & PAINT:																				
SEE DRAWING GNI																				
DESCRIPTION: GIRDER - 3G3											DRAWN BY		DATE							
JOB: TH 1 (FAS 160) OVER OTTER CREEK											JTB		11/08							
BRIDGE NO. 6											CHKD BY									
TOWN OF LEICESTER, VERMONT											ELC		12/06							
COUNTY OF ADDISON											APPROV BY									
CONTRACTOR: BLOW & COTE											SUPERVISOR		W. J. GATTI							
PROJ NO. BRF 0160(3)S											Q.A.									
CUSTOMER: VT AOT																				
CASCO BAY STEEL STRUCTURES, INC.											JOB NO.		DRG. NO.							
75 SPRING HILL ROAD											285		3							
PHONE (207) 282-7360											SACO, MAINE 04072									
											FAX. (207) 282-1179									
											REV.		[Symbol]							

ELC The File 23 0840028 CST 2006 -server/ghw/2003/41 Rev1

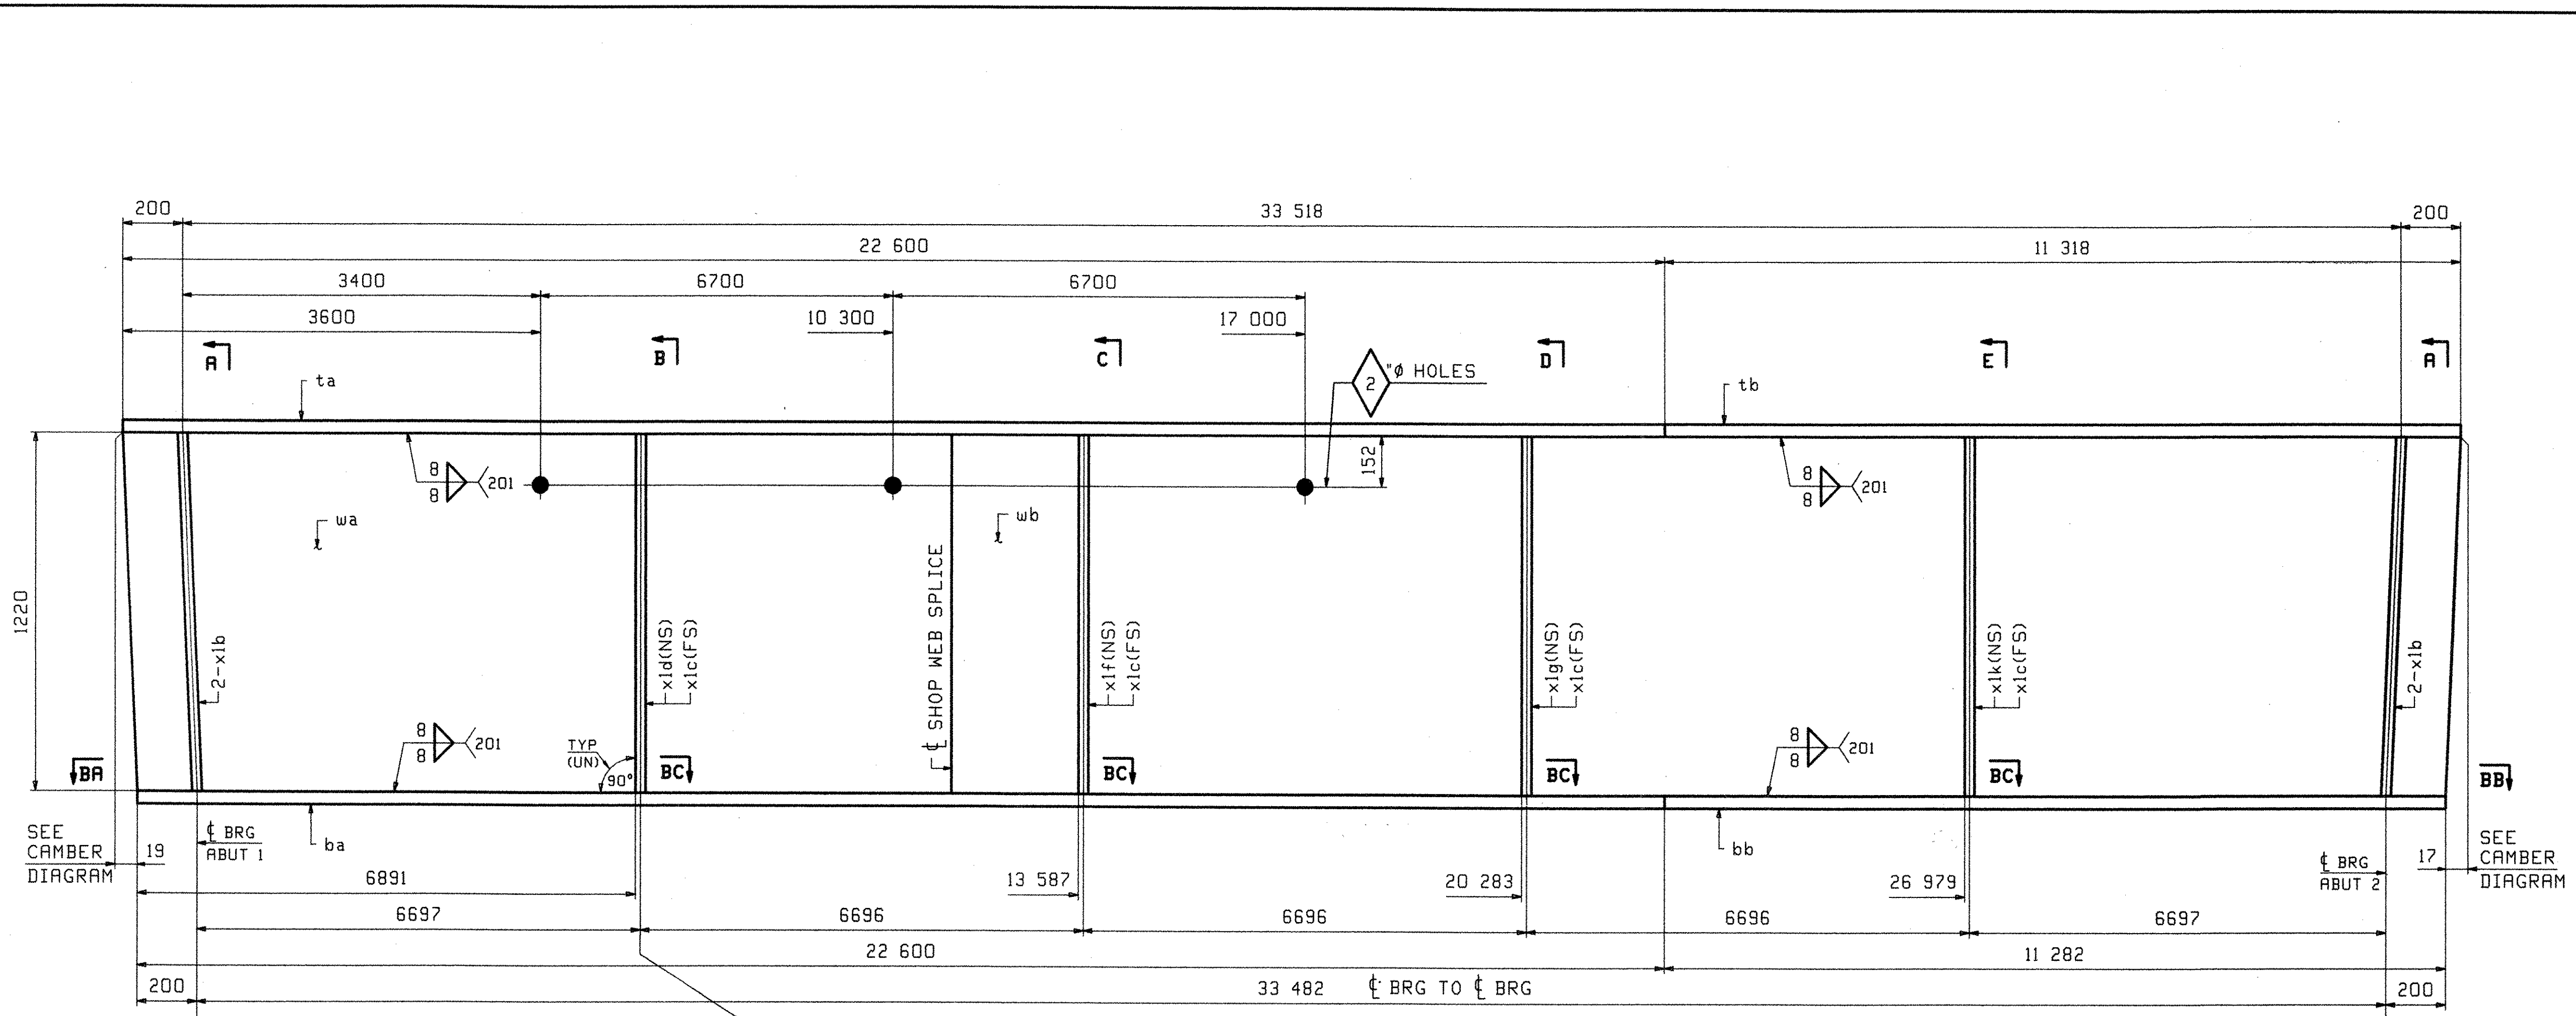


ONE - GIRDER - 4G4

FOR GIRDER STANDARD DETAILS SEE DRAWING XI.
 FOR CAMBER DIAGRAM SEE DRAWING C1.
 FOR GENERAL NOTES SEE DRAWING GNI.
 H2-3 DENOTES MATERIAL SUBJECT TO CHARPY V-NOTCH TESTING.

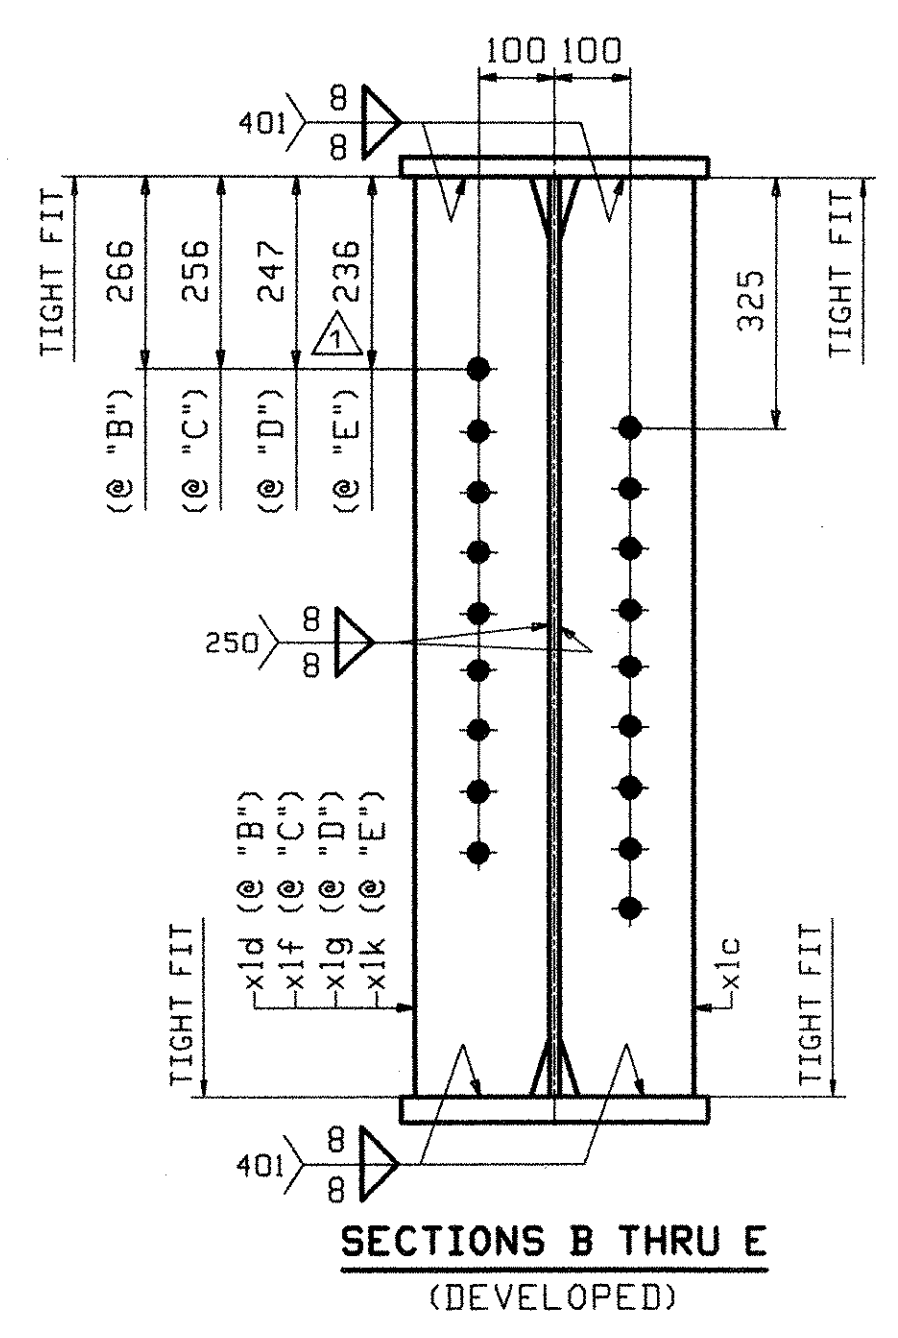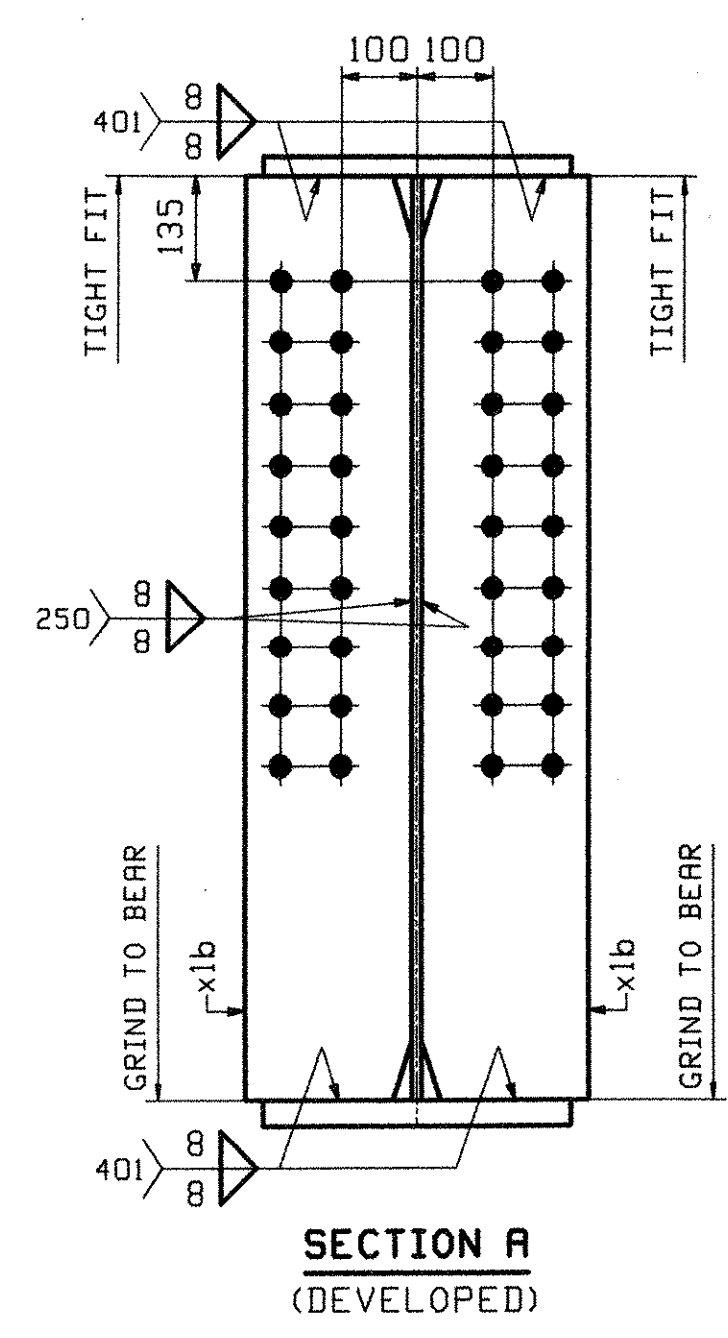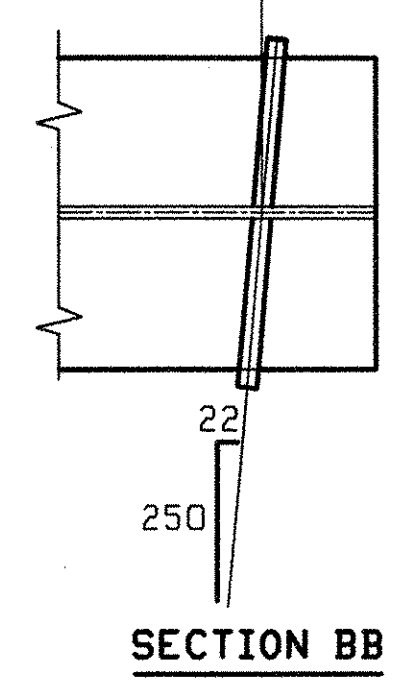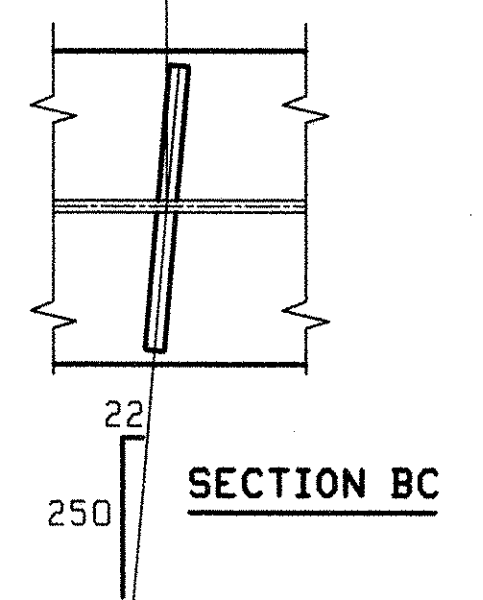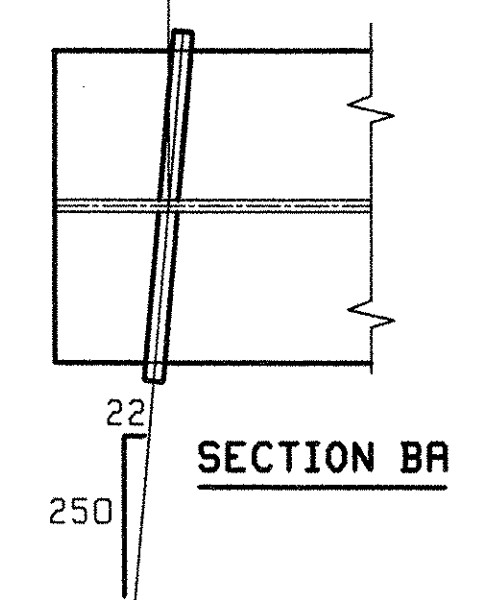


ABM INFO		SHTP		BILL OF MATERIAL				JOB NO.	DRAWING NO.	REV.
								285	4	
PAGE	LINE	MARK	QTY	MARK	MATERIAL	LENGTH		REMARKS	WT	PROCUREMENT NOTES
						m	mm			
		4G4	1		GIRDER				1058 kg 23400 lb	
1	G		1	wa	PL 13x1220	11	619	(M270M-345WT2)		(H2-3)
1	E		1	wb	PL 13x1220	22	301	(M270M-345WT2)		(H2-3)
1	J		1	ta	PL 25x406	22	600			
1	L		1	tb	PL 25x406	11	318			
1	A		1	ba	PL 35x406	22	600	(M270M-345WT2)		(H2-3)
1	C		1	bb	PL 35x406	11	282	(M270M-345WT2)		(H2-3)
2	B		4	x1b	PL 22x220	1	220			MIE
2	C		4	x1c	PL 13x178	1	220			
2	C		1	x1d	PL 13x178	1	220			
2	C		1	x1f	PL 13x178	1	220			
2	C		1	x1g	PL 13x178	1	220			
2	C		1	x1k	PL 13x178	1	220			


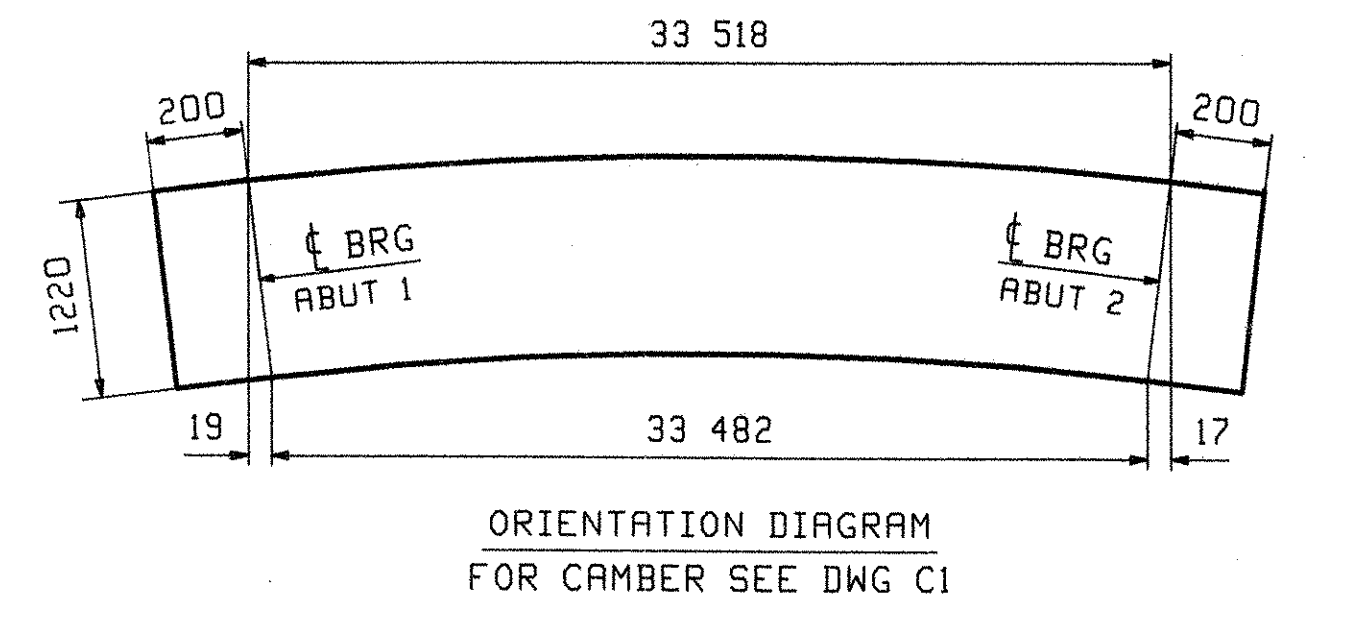


OUT FOR APPROVAL	12-28-05										
OUT FOR APPROVAL	2-27-06										
ISSUED TO SHOP											
FIELD & OFFICE											
APPROVAL COMMENTS	2/21	JTB	ELC								
REV.	REMARKS	DATE	DWN	CHK	APP	O.A.	NO.	DIA.	LGT	TYPE	WASHER
MATERIAL:	M270M GR 345W	ELECTRODES:		HOLES:	15 16	(UN)	SHOP BOLTS:				NONE
SURFACE PREP. & PAINT: SEE DRAWING GNI											
DESCRIPTION:	GIRDER - 4G4							DRAWN BY	DATE		
JOB:	TH 1 (FAS 160) OVER OTTER CREEK							JTB	11/08		
	BRIDGE NO. 6							CHKD BY			
	TOWN OF LEICESTER, VERMONT							ELC	12/06		
	COUNTY OF ADDISON							APPROV BY			
	CONTRACTOR: BLOW & COTE							SUPERVISOR	W. J. GATTI		
PROJ NO.	BRF 0160(3)S							O.A.			
CUSTOMER: VT AOT											
CASCO BAY STEEL STRUCTURES, INC.										JOB NO.	DRG. NO.
75 SPRING HILL ROAD					SACO, MAINE 04072					285	4
PHONE (207) 282-7360					FAX. (207) 282-1179						REV.

RECEIVED
 MKD BY: JTB MKD BY: JTB
 MAR 03 2006
 RESUBMIT APPROVED
 BY: JTB DATE: 3/16/06

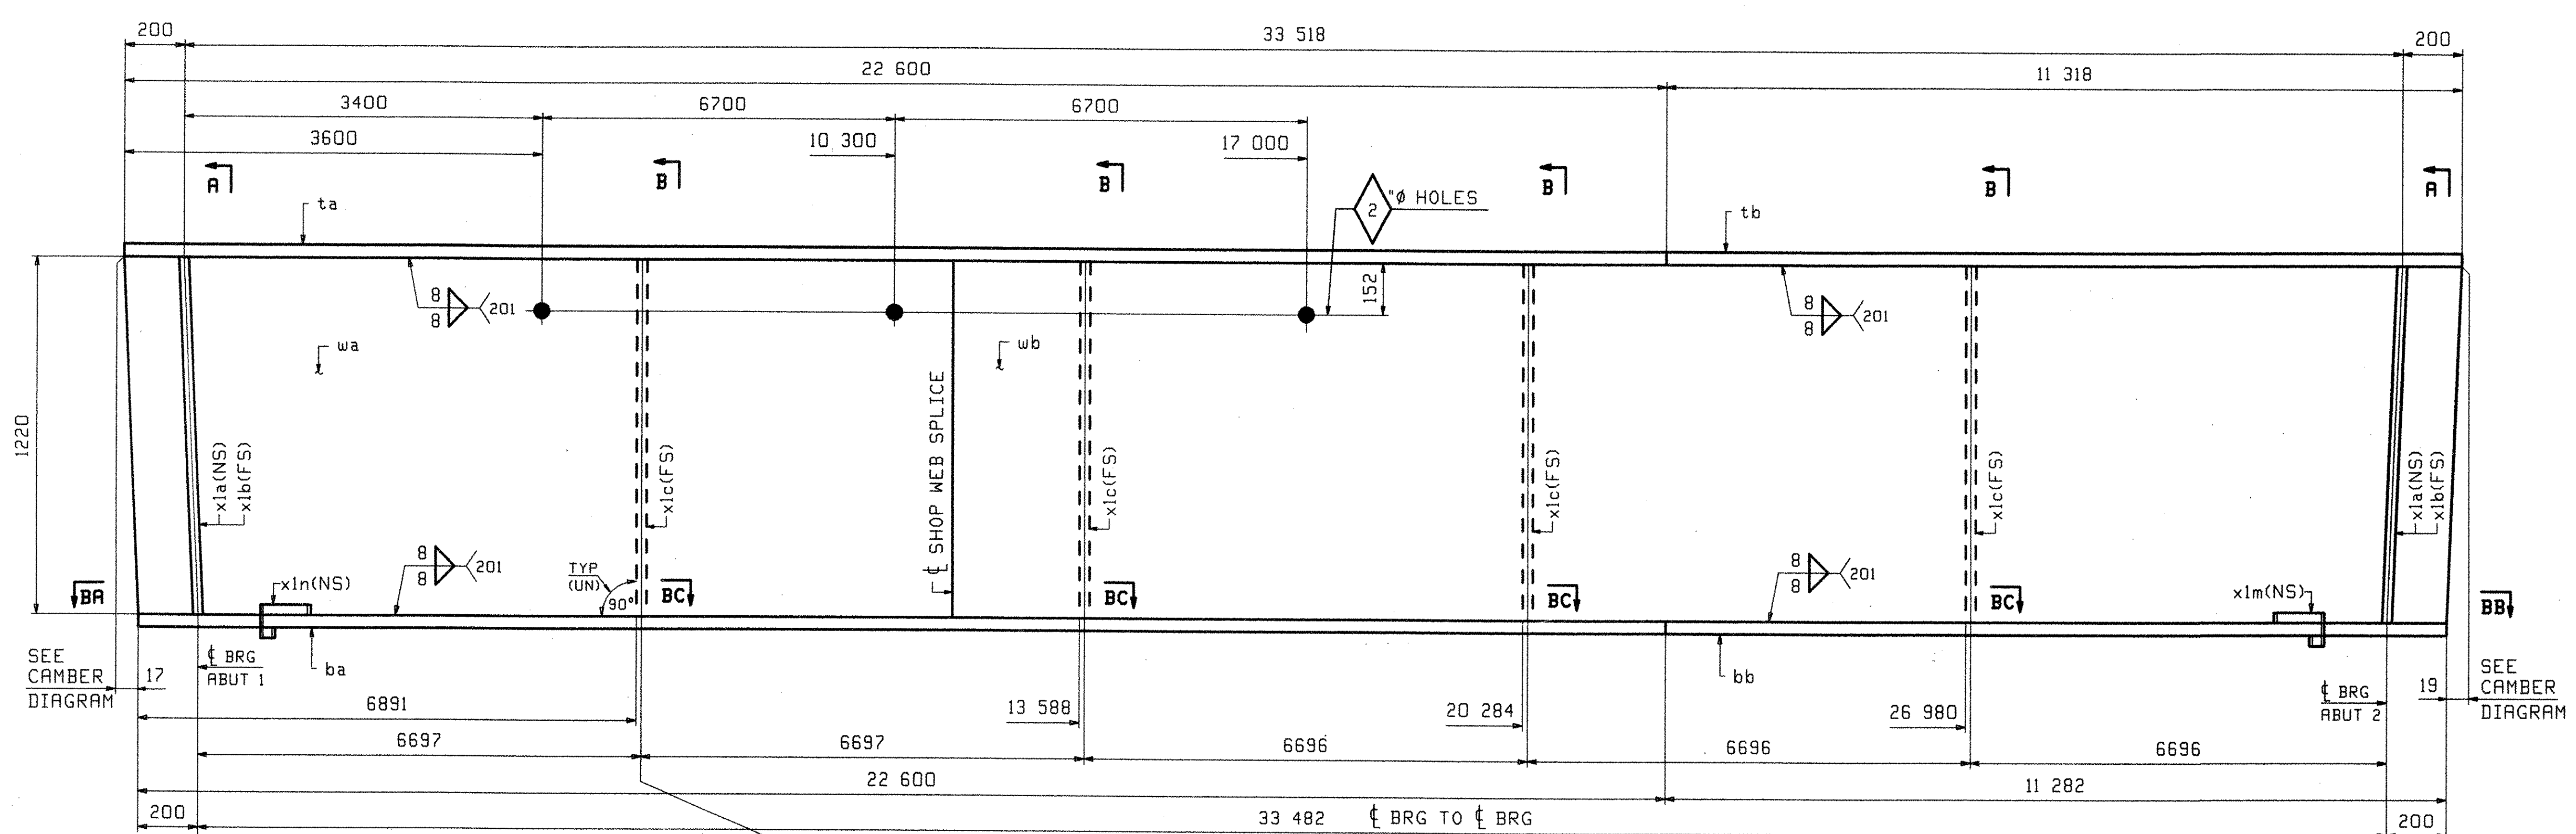

ABM INFO		BILL OF MATERIAL				JOB NO.	DRAWING NO.	REV.	
PAGE	LINE	MARK	QTY	MARK	MATERIAL	LENGTH	REMARKS	WT	PROCUREMENT NOTES
						m			
		5G5	1		GIRDER				1981 kg 24208 lb
1	G		1	wa	PL 13x1220	11 618	(H270M-345HT2)		(H2-3)
1	E		1	wb	PL 13x1220	22 302	(H270M-345HT2)		(H2-3)
1	J		1	ta	PL 25x406	22 600			
1	L		1	tb	PL 25x406	11 318			
1	A		1	ba	PL 35x406	22 600	(H270M-345HT2)		(H2-3)
1	C		1	bb	PL 35x406	11 282	(H270M-345HT2)		(H2-3)
2	B		2	x1a	PL 22x220	1 220		MIE	
2	B		2	x1b	PL 22x220	1 220		MIE	
2	C		4	x1c	PL 13x178	1 220			
2	D		1	x1m	PL 6x85	0 277			
2	D		1	x1n	PL 6x85	0 277			

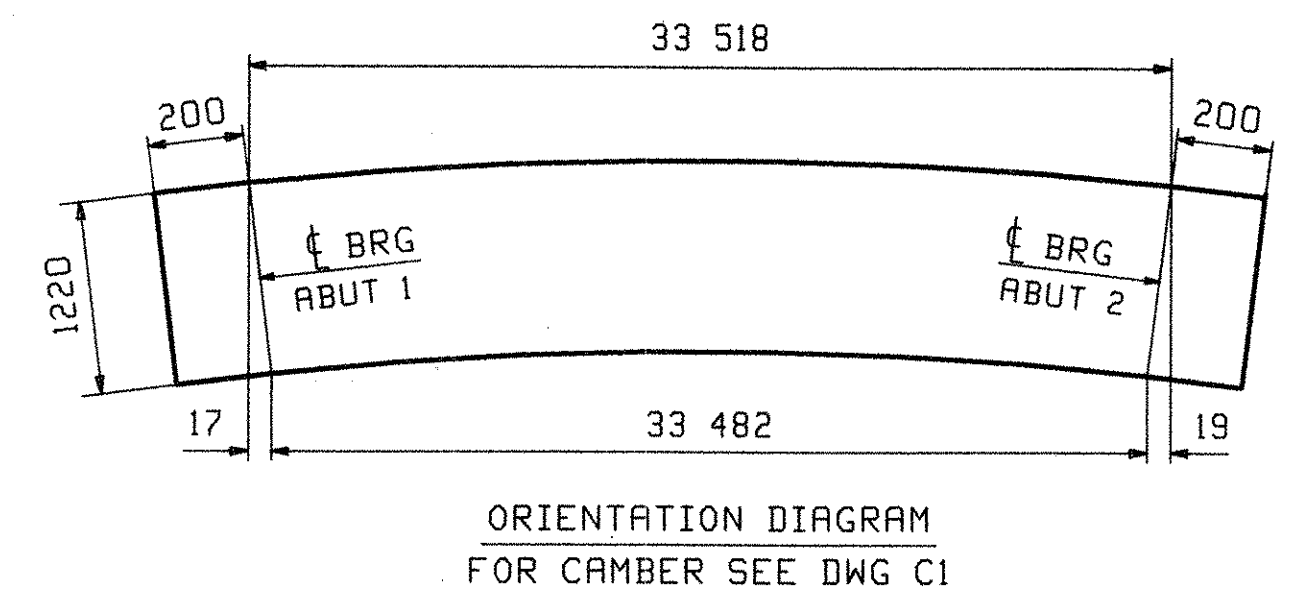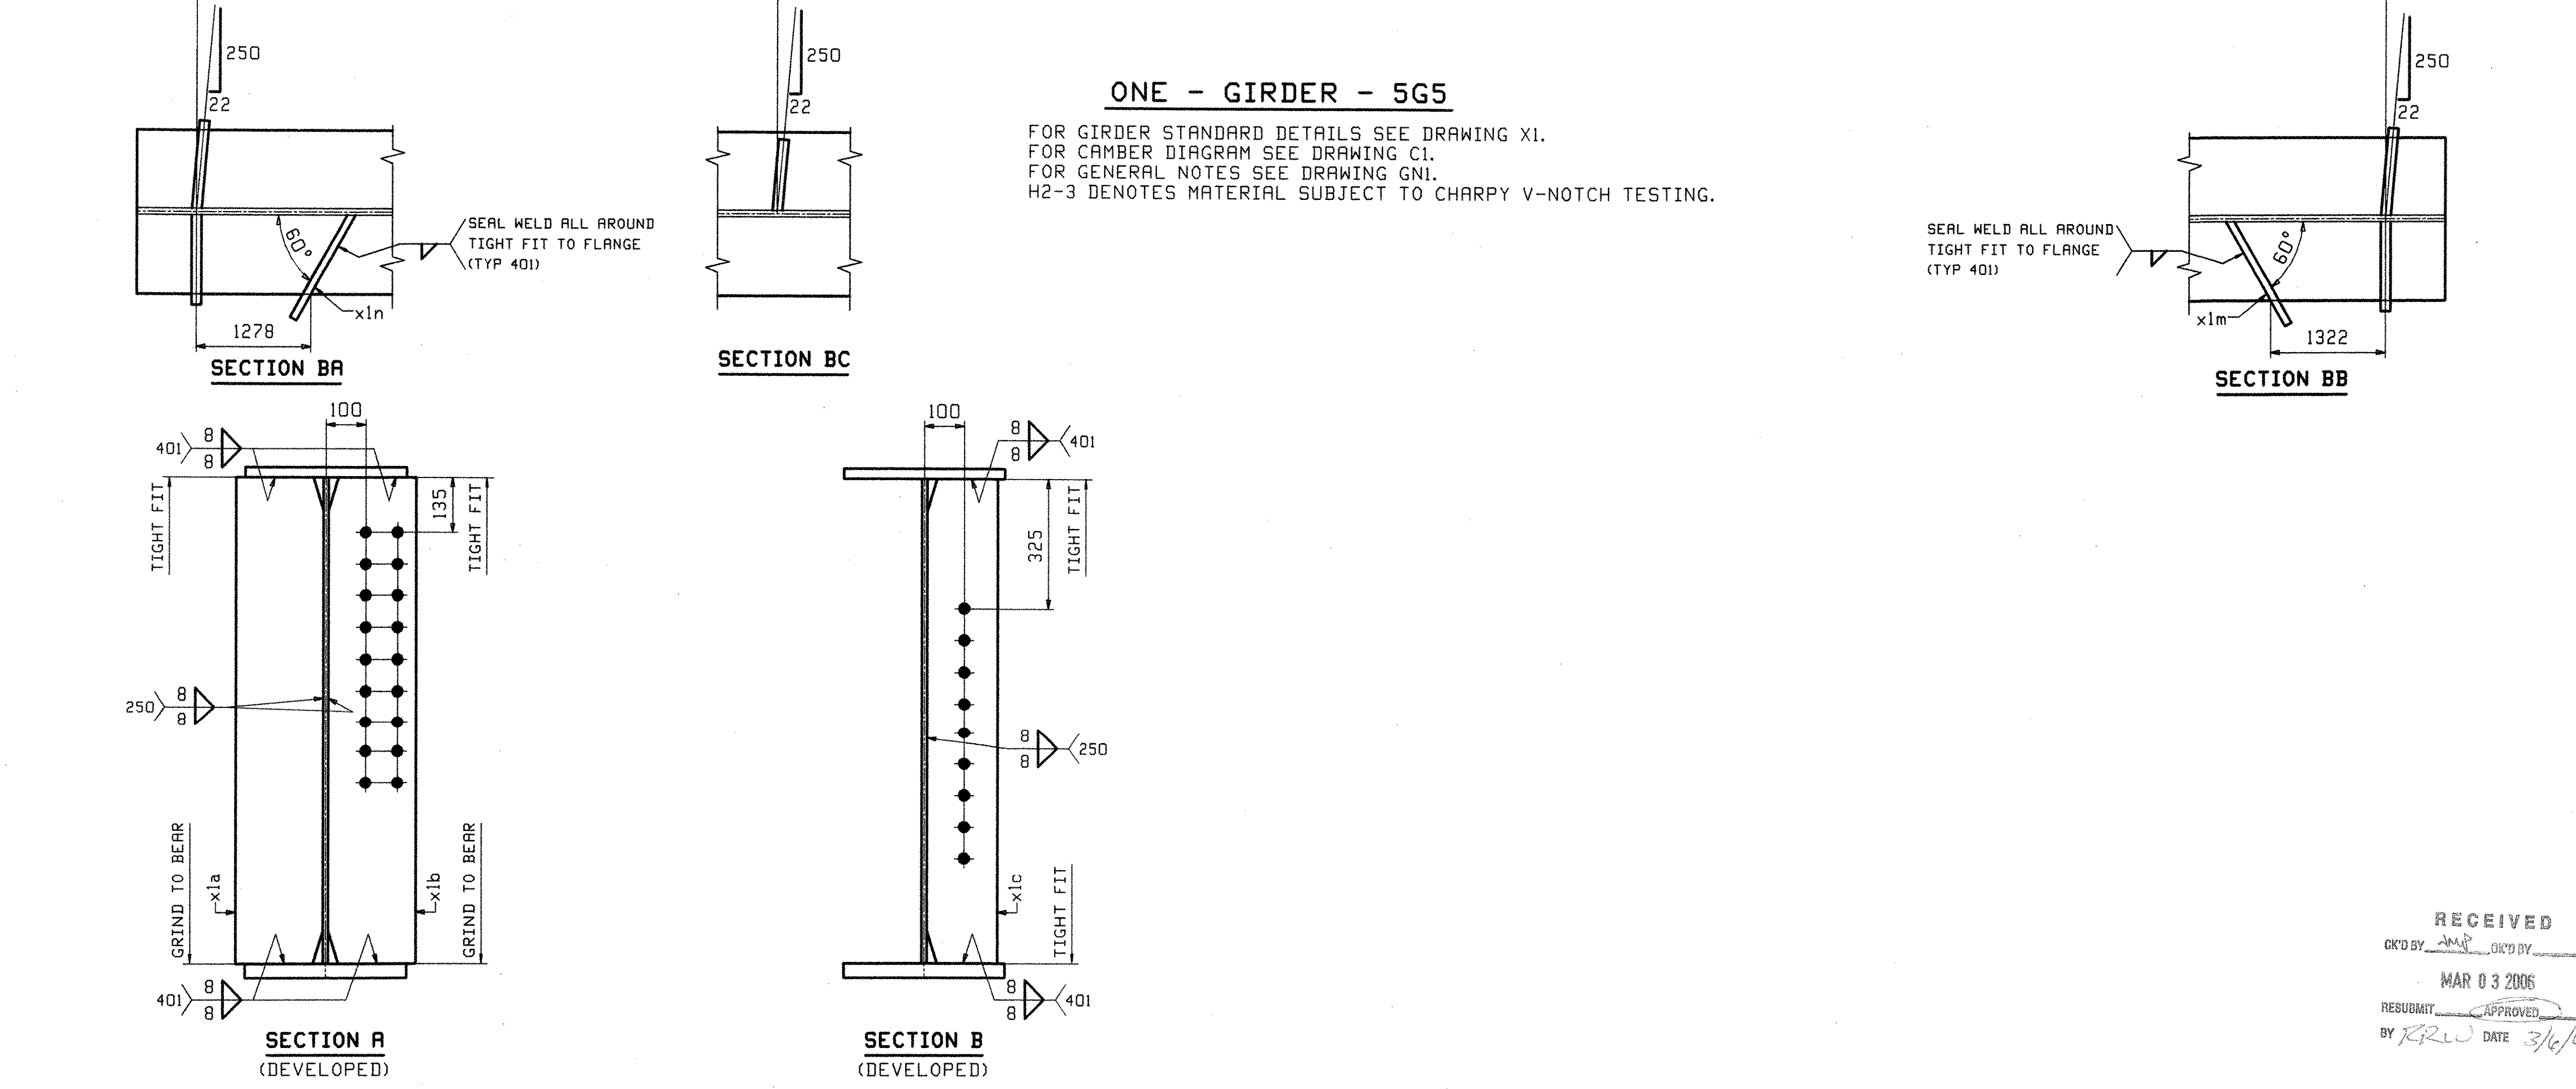


OUT FOR APPROVAL	12-22-05								
OUT FOR APPROVAL	2-27-06								
ISSUED TO SHOP									
FIELD & OFFICE									

REV.	REMARKS	DATE	DWN	CHK	APP	Q.A.	NO.	DIA.	LGT	TYPE	WASHER
	MATERIAL:										
	M270M GR 345W										
	ELECTRODES:										
	HOLES:										
	15 16Ø (UN)										
	SHOP BOLTS:										
	NONE										


SURFACE PREP. & PAINT:											
SEE DRAWING GNI											
DESCRIPTION:	GIRDER - 5G5	DRAWN BY	DATE								
JOB:	TH 1 (FAS 160) OVER OTTER CREEK	JTB	11/08								
	BRIDGE NO. 6	CHKD BY									
	TOWN OF LEICESTER, VERMONT	ELC	12/06								
	COUNTY OF ADDISON	APPROV BY									
	CONTRACTOR: BLOW & COTE	SUPERVISOR	W. J. GATTI								
PROJ NO.	BRF 0160(3)S	Q.A.									
CUSTOMER:	VT ROT										
CASCO BAY STEEL STRUCTURES, INC.		JOB NO.	DRG. NO.								
75 SPRING HILL ROAD		285	5								
PHONE (207) 282-7360		FAX.	(207) 282-1179								
		REV.	△								

RECEIVED
MAR 03 2006
BY KRW DATE 3/6/06


ABM INFO		SHIP		BILL OF MATERIAL				JOB NO.	DRAWING NO.	REV.
								285	6	
PAGE	LINE	MARK	QTY	MARK	MATERIAL	LENGTH	REMARKS	WT	PROCUREMENT	
						m			NOTES	
					DIAPHRAGMS					
2	J	6D1	3		W 760x134	1 921	PAINTED	287 kg 588 lbs		
2	J	6DIM	1		W 760x134	1 921	PAINTED	287 kg 588 lbs		
2	J	6D2	3		W 760x134	1 946		281 kg 575 lbs		
2	J	6D2M	1		W 760x134	1 946		281 kg 575 lbs		
2	K	6D3	16		W 760x134	1 898		294 kg 599 lbs		

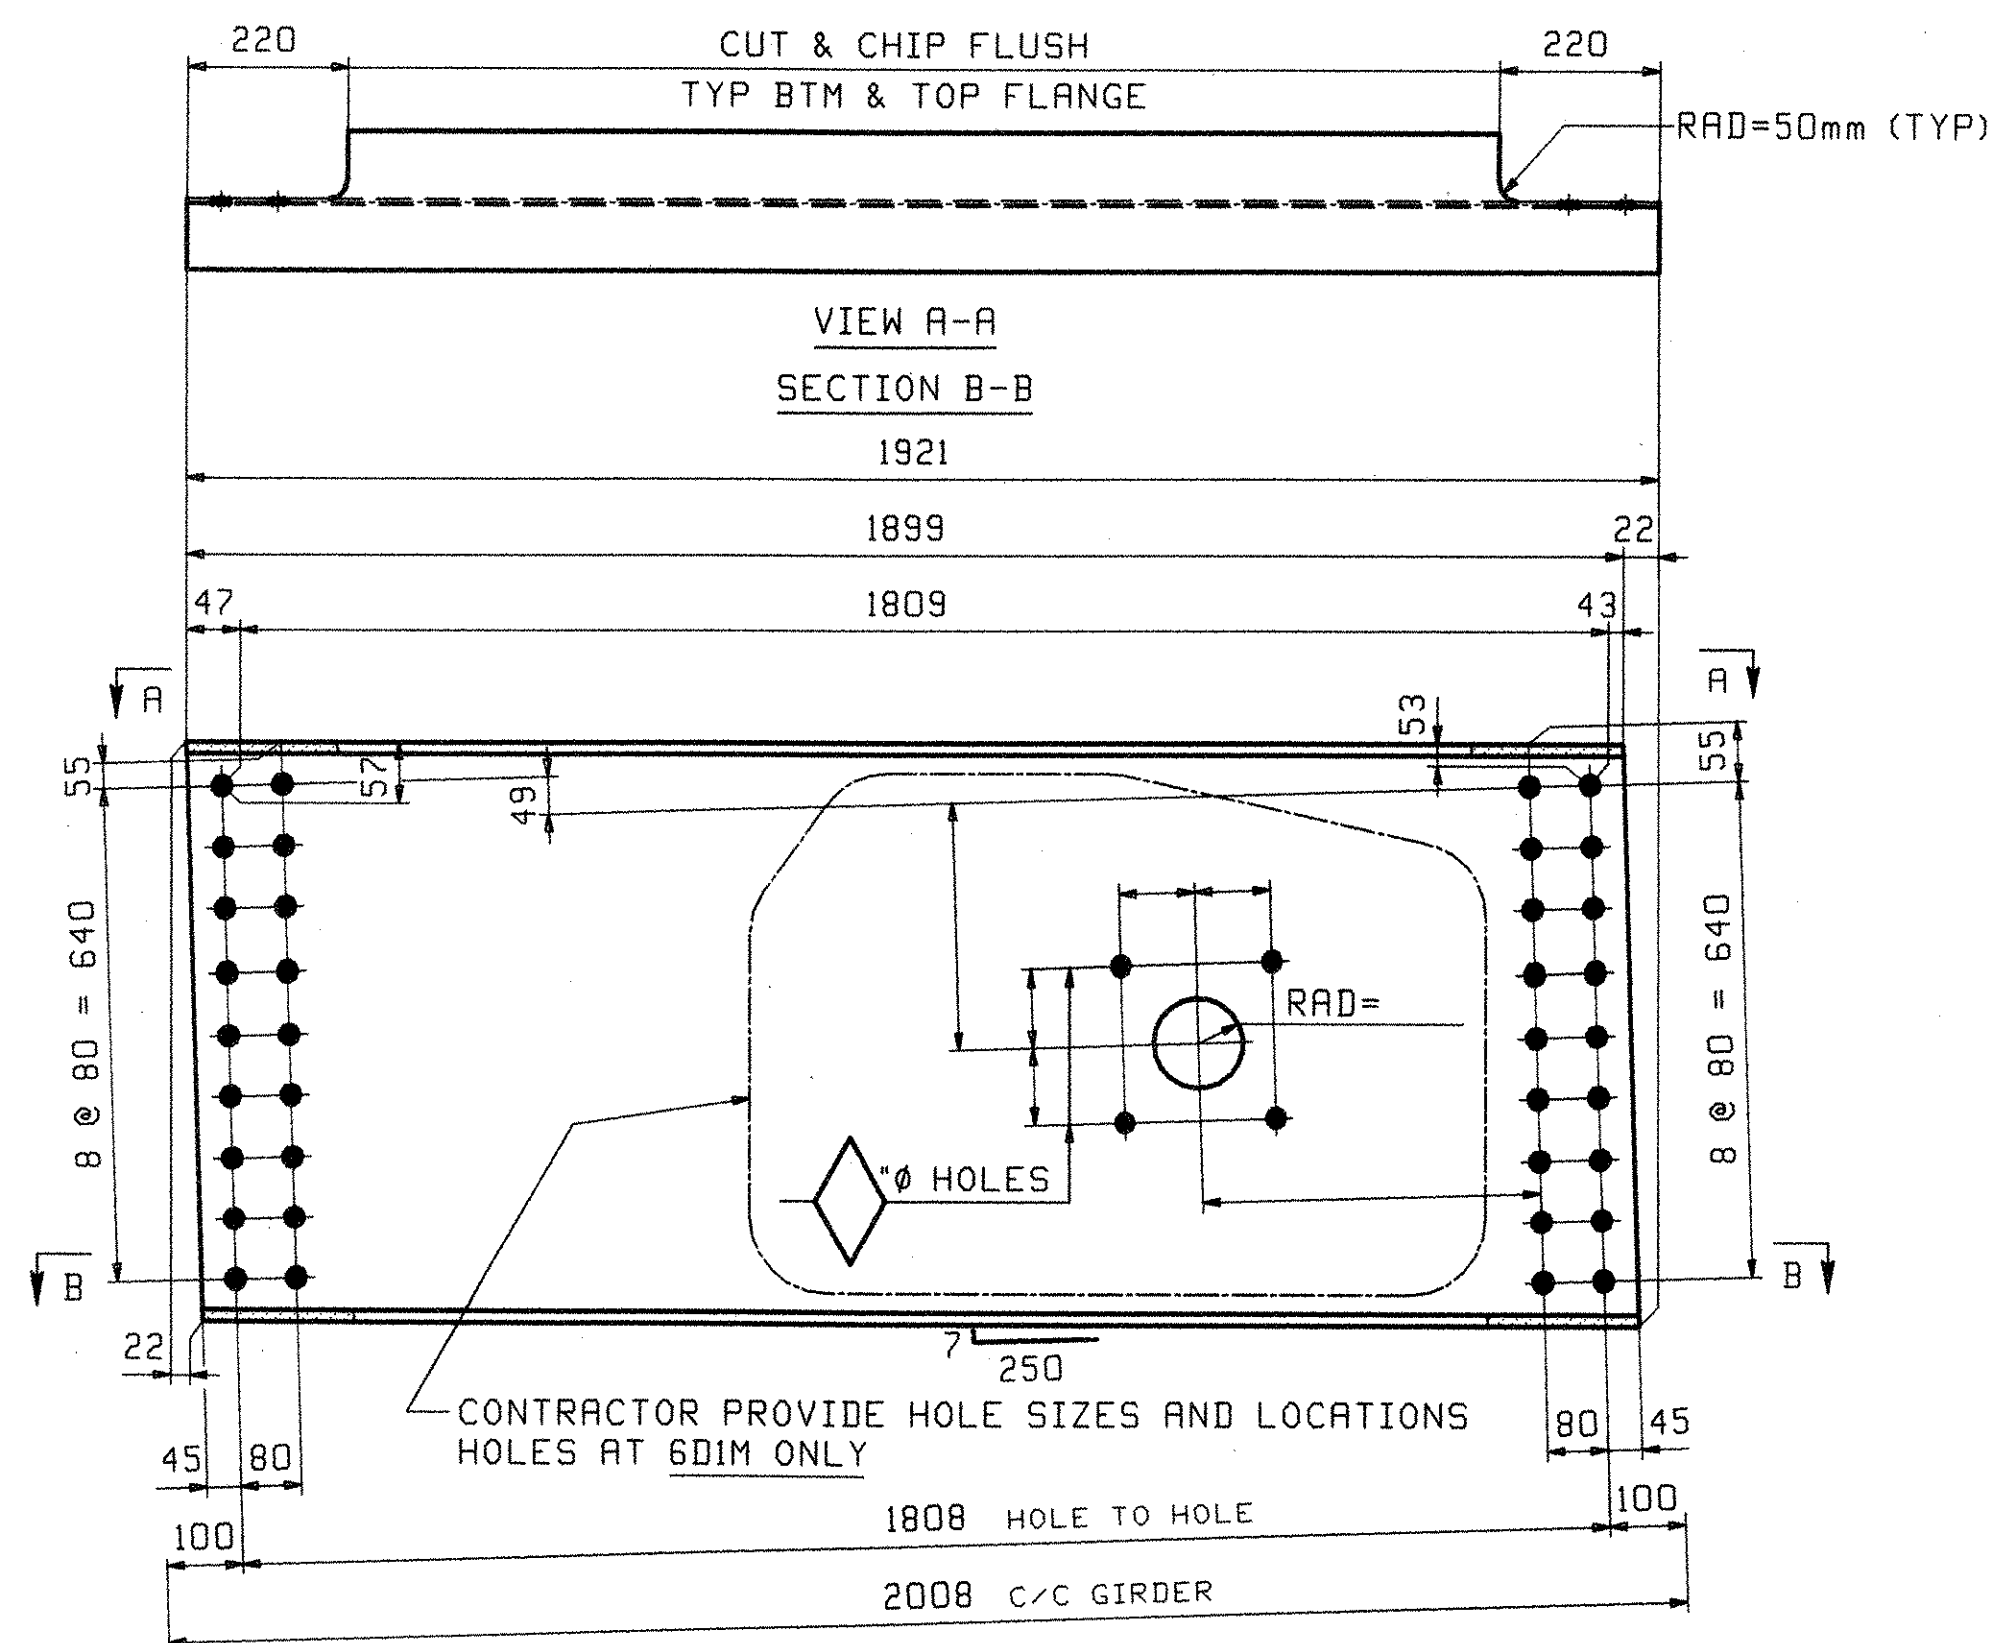

3 ~ END DIAPHRAGMS - 6D1 PAINTED (SEE DWG GNI)
 LOOKING TOWARDS BACKWALL - ABUT 1
1 ~ END DIAPHRAGM - 6DIM PAINTED (SEE DWG GNI)
 LOOKING TOWARDS BACKWALL - ABUT 1 (LINES 3-4)

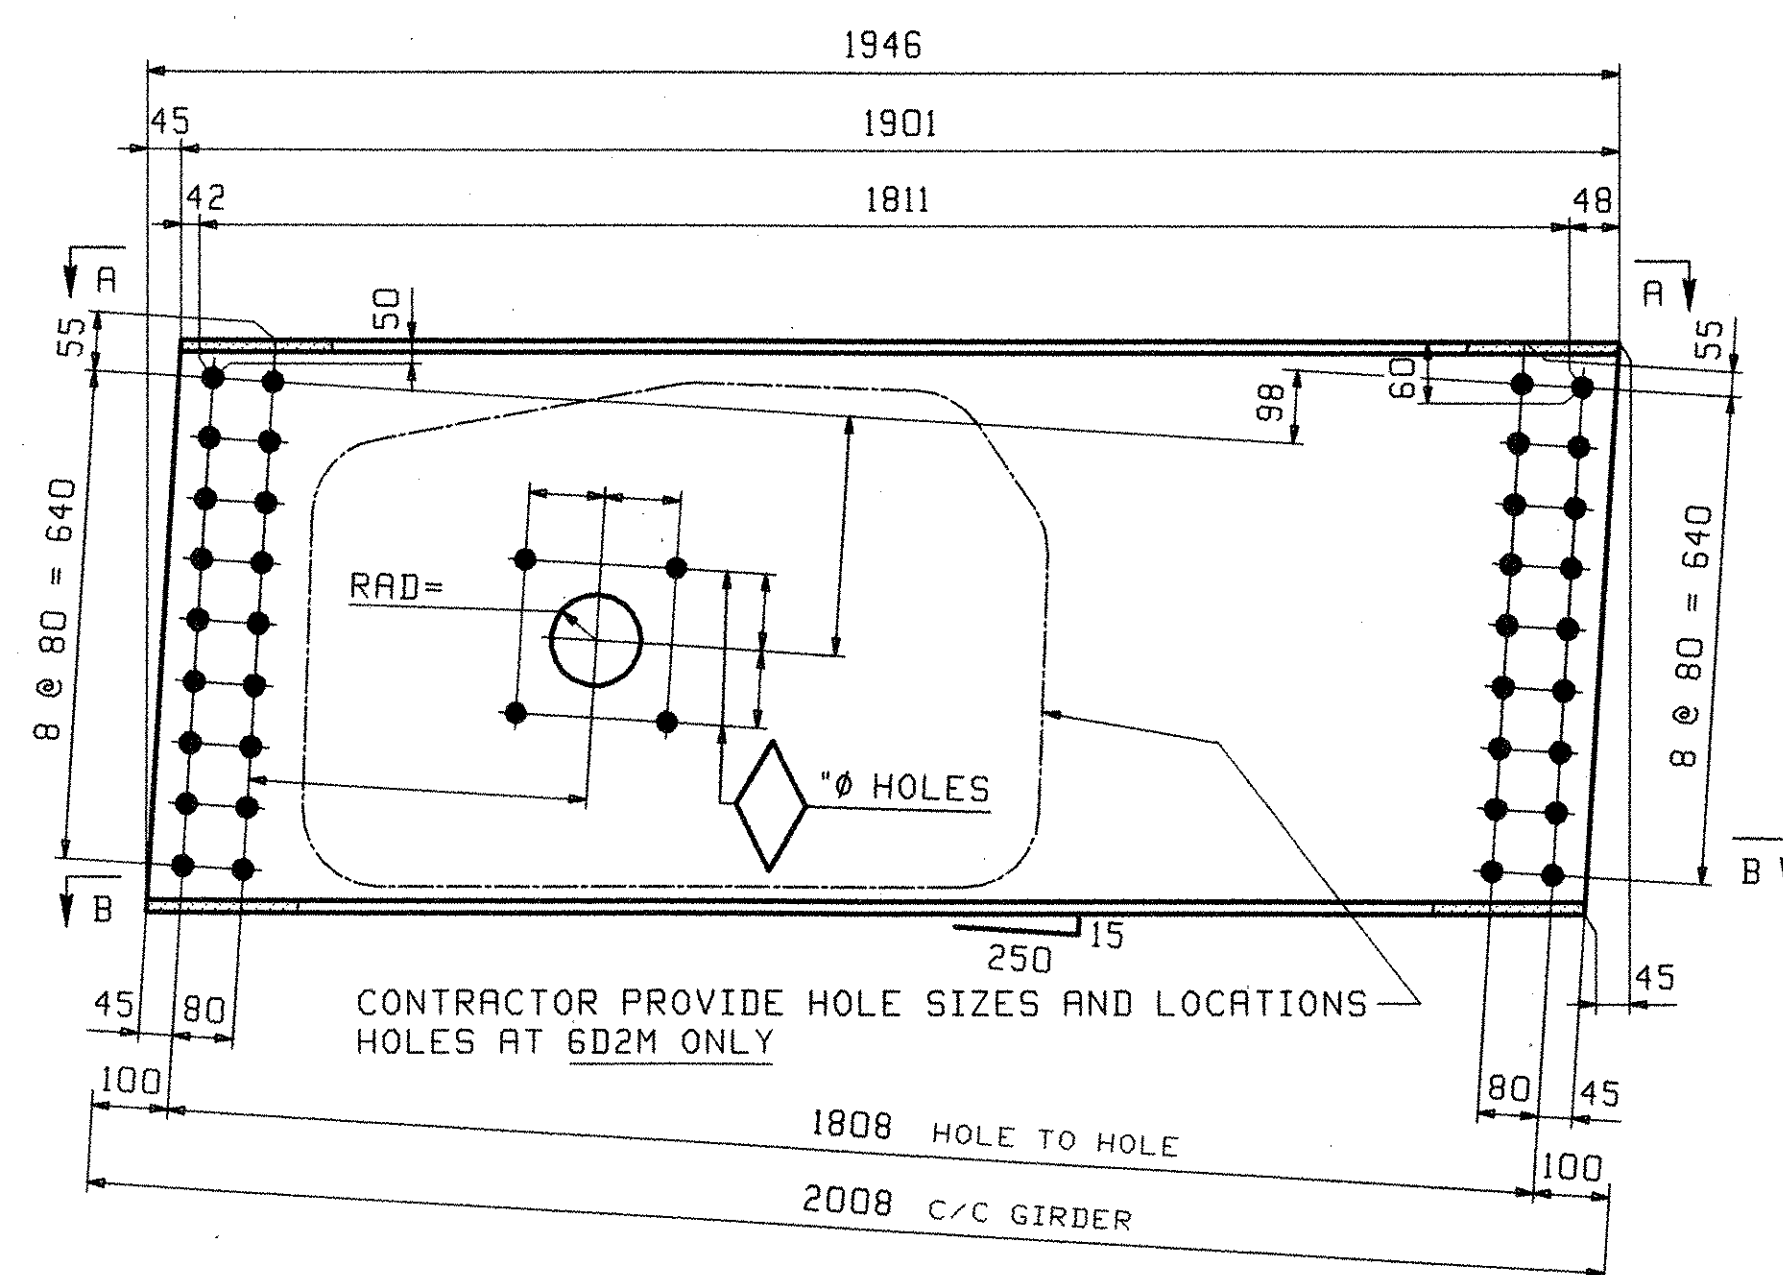

3 ~ END DIAPHRAGMS - 6D2
 LOOKING TOWARDS BACKWALL - ABUT 2
1 ~ END DIAPHRAGM - 6D2M
 LOOKING TOWARDS BACKWALL - ABUT 2 (LINES 3-4)

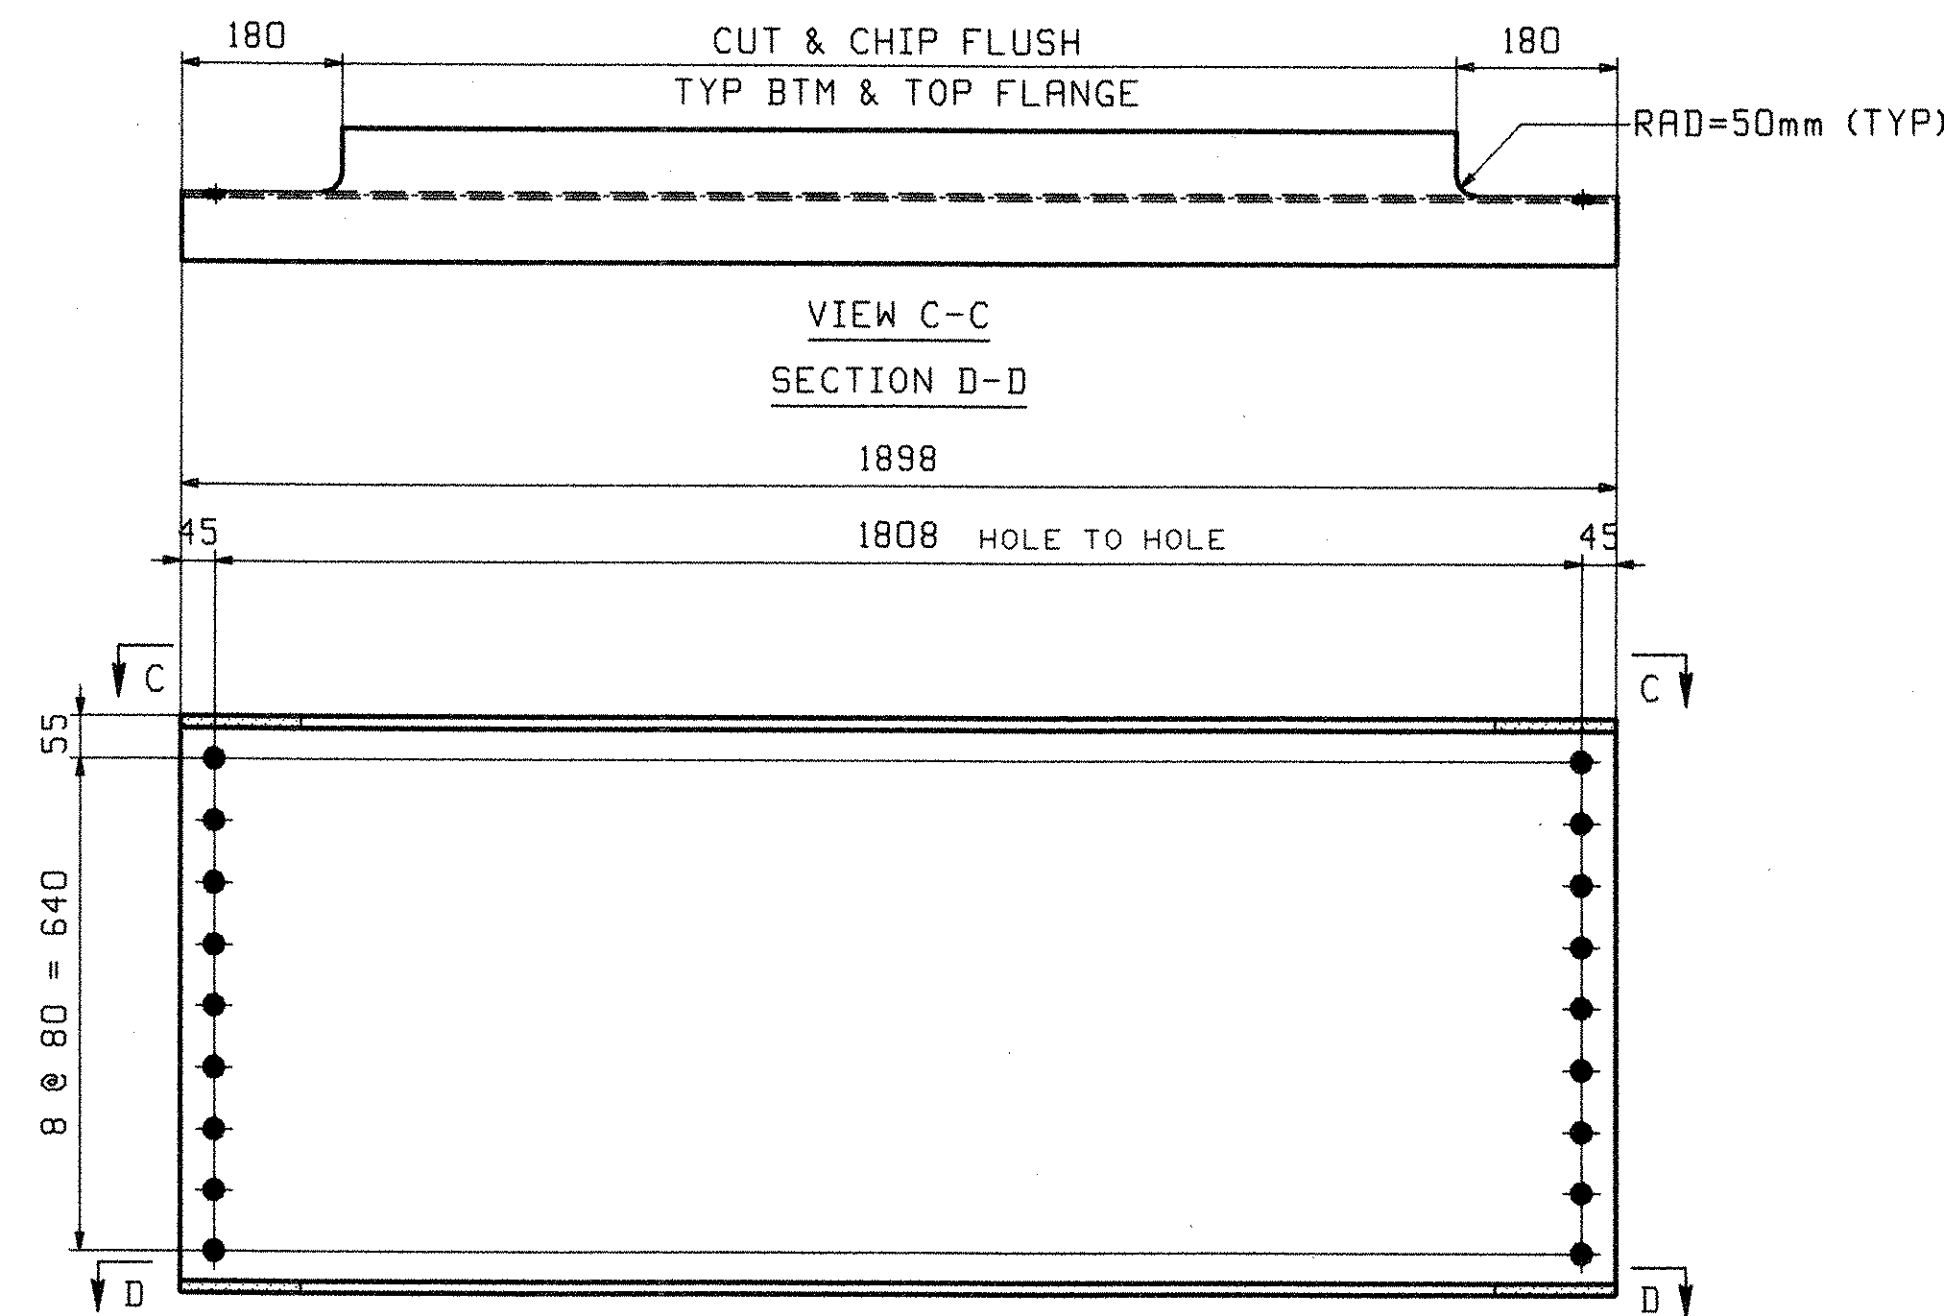

16 ~ INT. DIAPHRAGMS - 6D3
 LOOKING BACK-STATION

OUT FOR APPROVAL	12.28.05								
OUT FOR APPROVAL	2.27.06								
ISSUED TO SHOP									
FIELD & OFFICE									

REV.	REMARKS	DATE	DWN	CHK	APP	Q.A.	NO.	DIA.	LGT	TYPE	WASHER
	MATERIAL:										
	M270M GR 345W										
	ELECTRODES:										
	HOLES:										
	15										
	16 Ø (UN)										
	SHOP BOLTS:										
	NONE										

SURFACE PREP. & PAINT:
 SEE DRAWING GNI

DESCRIPTION:	DIAPHRAGMS	DRAWN BY	DATE
JOB:	TH 1 (FAS 160) OVER OTTER CREEK	JTB	11/08
	BRIDGE NO. 6	CHKD BY	
	TOWN OF LEICESTER, VERMONT	ELC	12/06
	COUNTY OF ADDISON	APPROV BY	
	CONTRACTOR: BLOW & COTE	SUPERVISOR	W. J. GATTI

PROJ NO.	BRF 0160(3)S	Q.A.	
CUSTOMER:	VT ROT		
CASCO BAY STEEL STRUCTURES, INC.		JOB NO.	DRG. NO.
75 SPRING HILL ROAD	SACO, MAINE 04072	285	6
PHONE (207) 282-7360	FAX. (207) 282-1179	REV.	△


RECEIVED
 CK'D BY: [Signature] OK'D BY: [Signature]
 MAR 03 2006
 RESUBMIT: [Signature] APPROVED: [Signature]
 BY: [Signature] DATE: 3/3/06

Highway Safety Corporation
Glastonbury, CT

Welding Procedure Specification


Material specification A572 gr 50, ASTM A709 Gr 50, AASHTO M222
Welding process Gas Metal Arc Welding (GMAW)
Manual, semi-automatic, or automatic Semi-Automatic
Position of welding Flat (1F) or Horizontal (2F)
Filler metal specification AWS A5.18
Filler metal classification ER70S-3
Electrode and manufacturer Lincoln Electric Lincoln Weld L-50
Flux and manufacturer N/A
Shielding gas 85% Argon / 15% CO2 Flow rate 19-27 L / min
Single or multiple pass Single
Single or multiple arc Single
Welding current DCEP
Polarity Reverse - electrode positive
Welding progression Stringers
Root treatment None
Preheat and interpass temperature base metal up to 3/4" (50°F) ; over 3/4 thru 1-1/2" (150°F) ; over 1-1/2" thru 2-1/2" (225°F)
Postheat treatment None
Electrode extension 3/4" ± 1/4"

WELDING PROCEDURE

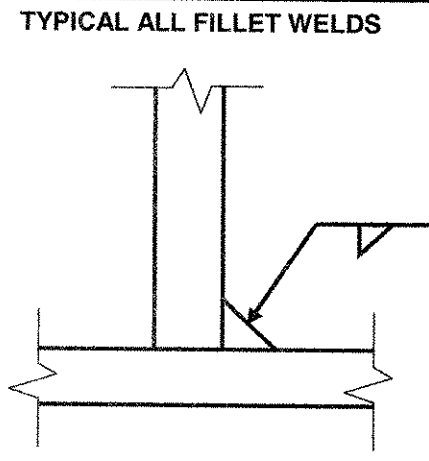Weld size	Pass no.	Electrode size	Welding parameters		Travel speed	Joint detail
			Amperes	Volts		
1/4"	1	.062"	350 A ± 30	28 V ± 2	12 ipm ± 2	 <p>TYPICAL ALL FILLET WELDS</p>
<p>TRANS RECEIVED CK'D BY _____ DK'D BY <u>JWC</u> AUG 04 2006 RESUBMIT APPROVED ✓ BY _____ DATE <u>8-8-06</u></p>						

This procedure may vary due to fabrication sequence, fit-up, pass size, etc. within the limitation of variables given in section 5 of latest edition AWS D1.5

WPS no. W-1562B Fabricator Highway Safety Corporation
Revision no. 0 Authorized by Paul Radice
Supporting PQR no. pre-qualified Date 7/28/06
Project Name Montgomery, Vermont Project Number BRO 1448 (20)

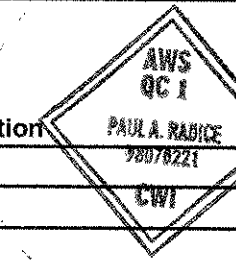


157RR

Highway Safety Corporation
Glastonbury, CT
Welding Procedure Specification


Material specification ASTM A500 Gr B
 Welding process Shielded Metal Arc Welding (SMAW)
 Manual, semi-automatic, or automatic Manual
 Position of welding Flat (1G)
 Filler metal specification AWS A5.1
 Filler metal classification ER7018
 Electrode and manufacturer Lincoln Electric Jet LH 78 MR
 Flux and manufacturer N/A
 Shielding gas N/A Flow rate N/A
 Single or multiple pass Multiple
 Single or multiple arc Single
 Welding current AC
 Polarity N/A
 Welding progression Stringers
 Root treatment None
 Preheat and interpass temperature 50°F (min)
 Postheat treatment None
 Electrode extension N/A

WELDING PROCEDURE

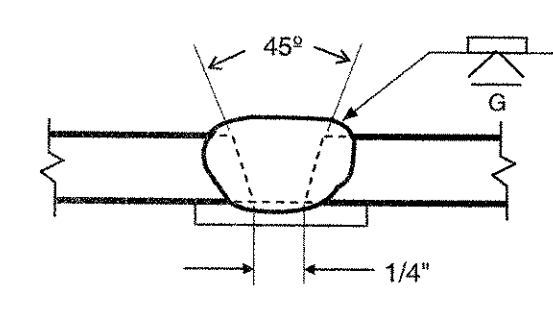Weld size	Pass no.	Electrode size	Welding parameters Amperes Volts	Travel speed	Joint detail
	ALL	5/32"	150 A to 220 A	VARIES	B-U2a 
			TRANS RECEIVED		
			OK'D BY: <u>Juc</u>		
			AUG 04 2006		
			RESUBMIT APPROVED ✓		
			BY: <u>B-B-06</u> DATE: <u>8-3-06</u>		

This procedure may vary due to fabrication sequence, fit-up, pass size, etc. within the limitation of variables given in section 5 of latest edition AWS D1.1

WPS no. W-1562A Fabricator Highway Safety Corporation
 Revision no. 0 Authorized by Paul Radice
 Supporting PQR no. Pre-Qualified Date 7/28/06
 Project Name Montgomery, Vermont Project Number BRO 1448 (20)

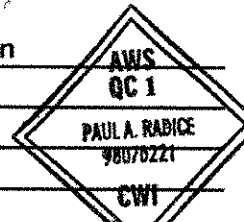

VTRANS
RECEIVED
CHKD BY _____ OK'D BY Jue
AUG 04 2006
RESUBMIT _____ APPROVED
BY _____ DATE 8-14-06

August 6, 2006

Highway Safety Corp.
239 Commerce St.
Glastonbury, CT 06033

RE: Colorzinq® Coating over Galvanized surface.

Dear Mamie Sniezko,

The following is our proposed high performance coating system for the following project:
MONTGOMERY 1448 (20) HSC Job Reference # 1562

Material to be galvanized to the ASTM A123, A153 galvanizing standards and coated with a Duplex System; Color: Brown Federal #20059, standard 595.

Our QC inspects all incoming material to check for damage from shipping and assure venting is suitable for the galvanizing process.

Material is cleaned of all oxidation, dirt and oils through repeated dipping in hot Alkali solutions. Next, any scale or rust is removed from the cleaned steel by dipping in a diluted ambient temperature Hydrochloric Solution. The pickled material is then transferred into a Zinc Ammonium chloride flux, (Dry Kettle Process) step.

The fluxed product is then completely immersed in a bath consisting of minimum 98% pure molten zinc.

After Galvanizing the material is air cooled, no quenching allowed on any material requiring Duplex Coatings.

153BR

V & S Colorzinc® galvanizing and coating operations are all enclosed inside the same environmentally controlled facility. After galvanizing, the material is transported directly into the coating room.

The galvanized surfaces are prepared using the most current ASTM method D 6386-99 as described under Section 5.4.1. The method of lightly sweep abrading the zinc surface immediately before applying the primer removes even minute amounts of oxides that have formed. We use a proprietary media that complies with the D 6386-99 guidelines. Our light sweep abrade at low pressure cleans the surface and provides a profile of 1.0 to 1.5 mills anchor pattern. Immediately material is transported via our automated over head rail system into the Primer booth. These steps will commence within a 24 hour window to further insure surface preparation integrity. This positive action approach to surface preparation eliminates any variables associated with a time sensitive surface preparation method.

Coatings are applied at a film thickness International Paint recommends. The epoxy prime coat of Intercure 420 Epoxy Primer will be applied at 5 - 6 mils DFT followed by a finish urethane coat of Interthane 990HS applied at 2-3 mils DFT. When applied to 4 mils of hot dip zinc, a total system thickness of 11 - 13 mils will be achieved. All coats will be cured by heating in our enclosed paint facility to promote maximum performance of the system. Our controlled heat curing process eliminates the variables normally associated with relying on existing ambient drying conditions.

International Paint is our proposed paint system and is not only equal to the other listed paint systems in performance but in many ways superior. International Paint is a division of the Akzo Nobel Corp. who is a global leader in innovative high performance coatings. All proposed coatings are well below the 3.5 lb. /gallon V.O.C. limit. The most important feature of our coating system is the Intercure 420® Micaceous Iron Oxide prime coat. With MIO plating effect, we have achieved superior barrier protection and adhesion to hot dip galvanize compared to conventional epoxy primers. The Interthane 990HS ® Urethane Finish is listed on the current N.E.P.C.O.A.T approved listing and is used to protect many of the projects painted by area State

Departments of Transportation. These structures are exposed to many harsh environments and their coating systems are designed to withstand these conditions for many years. International Palnt has a field technician available for our use during startup and throughout the duration of the project as needed.

Voigt and Schweitzer is an ISO 9002 company and as such are very comfortable with any inspections you may want to make. Our lead paint mechanics each have many years experience in the application of complex coating systems. All processes are documented and available to the project authorities.

Thank you for the opportunity. Voigt & Schweitzer are uniquely qualified to present a single source location for the galvanizing and coating of your project. If you need further information or clarifications please call me at (860) 294-1030.

Best regards,
Jay J. Besozzi
V&S Taunton Galvanizers, LLC.

Intercure® 420

Rapid Recoat Epoxy



WORLD WIDE PRODUCT RANGE

PRODUCT DESCRIPTION A two component, high solids, low VOC epoxy micaceous iron oxide coating formulated on proprietary polymer technology which provides rapid cure and overcoating even under low temperature conditions.

INTENDED USES As a high build intermediate to provide excellent barrier protection as part of a high performance system suitable for use in aggressive environments including offshore bridges, chemical and petrochemical plants, power stations, pulp and paper mills and industrial building.

Can be used as a barrier coating applied direct to steel where the environment is non aggressive.

The incorporation of plate-like micaceous iron oxide pigment, both increases the barrier effect and improves long term overcoating properties of the system making this material ideally suitable for application in the fabrication shop, prior to shipping, with final overcoating at site.

The rapid curing and overcoating properties of Intercure 420 provide production flexibility, making this product suitable for use both in new construction and on site as a maintenance coating.

PRACTICAL INFORMATION FOR INTERCURE 420

Color Natural MIO, Silver gray, Light gray

Gloss Level Matte

Volume Solids 70%

Typical Thickness 4-7 mils (100-175 microns) dry equivalent to 5.7-10.0 mils (143-250 microns) wet

Theoretical Coverage 225 sq.ft./US gallon at 5 mils d.f.t. and stated volume solids
5.60 m²/liter at 125 microns d.f.t. and stated volume solids

Practical Coverage Allow appropriate loss factors

Method of Application Airless spray, Air spray, Brush, Roller

Drying Time

Temperature	Touch Dry		Hard Dry		Overcoating interval with recommended topcoats	
	Minimum	Maximum	Minimum	Maximum	Minimum	Maximum
41°F (5°C)	75 minutes	7 hours	5 hours	Extended*		
59°F (15°C)	50 minutes	4 hours	3 hours	Extended*		
77°F (25°C)	40 minutes	2 hours	2 hours	Extended*		
104°F (40°C)	30 minutes	1 hour	1 hour	Extended*		

*See International Protective Coatings Definitions and Abbreviations

REGULATORY DATA

Finish Point	Beeb (Part A)	C/A (Part B)	Mixed
	84°F (29°C)	79°F (26°C)	81°F (27°C)
Weight	15.27-13.69 lb/gal (1.59-1.64 kg/l) (range)		
VOC	2.76 lb/gal (330 g/l) USA - EPA Method 24		
Weight	320 g/l UK - PG6/23(92), Appendix 3		

International Protective Coatings, a world leader in coating technology, is pleased to offer you this innovative product across the globe.

160BR

Intercure® 420
Rapid Recoat Epoxy

PRODUCT CHARACTERISTICS

Low Temperature Curing
Intercure 420 is capable of curing at temperatures below 32°F (0°C). However, this product should not be applied at temperatures below 32°F (0°C) where there is a possibility of ice formation on the substrate.

Temperature	Touch Dry	Hard Dry	Overcoating interval with recommended topcoats	
			Minimum	Maximum
23°F (5°C)	2 hours	20 hours	20 hours	Extended*
32°F (0°C)	90 minutes	12 hours	12 hours	Extended*

*See International Protective Coatings Definitions and Abbreviations
Touch dry times shown above are actual drying times due to chemical cure, rather than physical set due to solidification of the coating film at temperatures below 32°F (0°C).
This product must only be thinned using International thinners. The use of alternative thinners, particularly those containing ketones, can severely inhibit the curing mechanism of the coating.
Surface temperature must always be a minimum of 5°F (3°C) above dew point.
In common with all epoxies Intercure 420 will chalk and discolor on exterior exposure. However, these phenomena are not detrimental to anti-corrosive performance.
This product is frequently used as a "travel coat" prior to final overcoating on site. To ensure best extended overcoating properties ensure over-application does not occur and that the surface is fully cleaned of any contamination which may be present in the surface texture due to the coarse nature of the micaceous iron oxide pigmentation.
As with all products with high micaceous iron oxide levels, only relatively dark colors can be formulated, consequently with some colors of thin film finishes two coats may be needed to give good coverage.
Absolute measured adhesion of topcoats to aged Intercure 420 is less than that to fresh material, however, it is adequate for the specified end use.

SYSTEMS COMPATIBILITY

Please consult International Protective Coatings for specific information regarding application to prefabrication primers.
The following primers are recommended for Intercure 420:
Intercure 200
Intergard 251
Intergard 269
Intersinc 12 (mist coat or tie coat recommended)*
Intersinc 22 (mist coat or tie coat recommended)*
Intersinc 42
Intersinc 52
Intersinc 315
The following topcoats are recommended for Intercure 420:
Intercryl 530
Interline 629 HS
Intergard 740
Interrhane 890
For other suitable primers/topcoats, please consult International Protective Coatings.
* See relevant product data sheet for details.

Intercure® 420
Rapid Recoat Epoxy

SURFACE PREPARATION

All surfaces to be coated should be clean, dry and free from contamination. Prior to paint application all surfaces should be assessed and treated in accordance with ISO 8504:1992.

Oil or grease should be removed in accordance with SSPC-SP1 solvent cleaning.

Abrasive Blast Cleaning

Abrasive blast clean to SSPC-SP6 or Sa2½ (ISO 8501-1:1988). If oxidation has occurred between blasting and application of Intercure 420, the surface should be retreated to the specified visual standard.

Surface defects revealed by the blast cleaning process, should be ground, filled, or treated in the appropriate manner.

Shop Primed Surfaces

Weld seams and damaged areas should be blast cleaned to SSPC-SP6 or Sa2½ (ISO 8501-1:1988). If the shop primer shows extensive or widely scattered breakdown overall sweep blasting may be necessary.

Zinc Primed Surfaces

Ensure that the surface of the primer is clean, dry and free from contamination and zinc salts before application of Intercure 420. Ensure zinc primers are fully cured before overcoating.

APPLICATION

Mixing Material is supplied in two containers as a unit. Always mix a complete unit in the proportions supplied. Once the unit has been mixed it must be used within the working pot life specified.

- (1) Agitate Base (Part A) with a power agitator.
- (2) Combine entire contents of Curing Agent (Part B) with Base (Part A) and mix thoroughly with power agitator.

Mix Ratio 3 parts - 1 part by volume

Working Pot Life	41°F (5°C)	59°F (15°C)	77°F (25°C)	104°F (40°C)
	8 hours	4 hours	2 hours	45 minutes

Airless Spray Recommended

- Tip range 17-21 thou (0.43-0.53 mm)
- Total output fluid pressure at spray tip not less than 2,500 p.s.i. (176 kg/cm²)

Air Spray (Pressure Pot) Recommended

	Gun	DeVilbiss M5C or JCA
	Air Cap	704 or 765
	Fluid Tip	E

Brush Suitable - small areas only. Typically 3 mils (75 microns) can be achieved.

Roller Suitable - small areas only. Typically 2-3 mils (50-75 microns) can be achieved.

Thinner International GTA415 (or GTA230). Do not thin more than allowed by local environmental legislation.

Cleaners International GTA415 (or GTA822).

Work Stoppages Do not allow material to remain in hoses, gun or spray equipment. Thoroughly flush all equipment with International GTA415. Once units of paint have been mixed they should not be resealed and it is advised that after prolonged stoppages work recommences with freshly mixed units.

Clean Up Clean all equipment immediately after use with International GTA415. It is good working practice to periodically flush out spray equipment during the course of the working day. Frequency of cleaning will depend upon amount sprayed, temperature and elapsed time, including any delays. All surplus materials and empty containers should be disposed of in accordance with appropriate regional regulations/legislation.

162BR

Intercure® 420
Rapid Recoat Epoxy

ADDITIONAL INFORMATION Further information regarding industry standards, terms and abbreviations used in this data sheet can be found in the following sections of the International Protective Coatings data manual:

- Definitions & Abbreviations
- Surface Preparation
- Paint Application
- Theoretical & Practical Coverage

Individual copies of these information sections are available upon request.

SAFETY PRECAUTIONS: This product is intended for use only by professional applicators in industrial situations in accordance with the advice given on this sheet, the Material Safety Data Sheet and the container (s), and should not be used without reference to the Material Safety Data Sheet (MSDS) which International Protective Coatings has provided to its customers.

All work involving the application and use of this product should be performed in compliance with all relevant national, Health, Safety & Environmental standards and regulations.

In the event welding or flame cutting is performed on metal coated with this product, dust and fumes will be emitted which will require the use of appropriate personal protective equipment and adequate local exhaust ventilation.

If in doubt regarding the suitability of use of this product, consult International Protective Coatings for further advice.

PACK SIZE	4 gallon unit	Intercure 420 Base	Intercure 420 Curing Agent	3 gallons in a 5 gallon container
	20 liter unit	Intercure 420 Base	Intercure 420 Curing Agent	15 liters in a 20 liter container
				5 liters in a 5 liter container

For availability of other pack sizes contact International Protective Coatings

SHIPPING WEIGHT	U.N. Shipping No.	1.263
4 gallon unit	49.4 lb (22.4 kg) Base (Part A)	8.9 lb (4.0 kg) Curing Agent (Part B)
20 liter unit	65.0 lb (29.5 kg) Base (Part A)	11.5 lb (5.2 kg) Curing Agent (Part B)

STORAGE	Shelf Life	12 month minimum at 77°F (25°C). Subject to re-inspection thereafter. Store in dry, shaded conditions away from sources of heat and ignition.
---------	------------	---

Disclaimer
The information given on this sheet is not intended to be definitive and any person using the product for any purpose other than that specifically recommended in this sheet without first obtaining written confirmation from us as to the suitability of the product for the intended purpose shall do so at his own risk. Any warranty, if given, is specific. Terms & Conditions of Sale are contained in International Protective Coatings' Conditions of Sale, a copy of which can be obtained on request. While we believe that the advice we give about this product (whether in this sheet or otherwise) is correct we have no control over either the quality or condition of the substrate or the state of the surface before the use and application of the product. Therefore, we specifically agree in writing to disclaim, on the one hand, any liability whatsoever for damages resulting from the performance of the product or the use of the advice given and, on the other hand, any liability whatsoever for damages resulting from the performance of the product. The information contained in this sheet is liable to modification from time to time in the light of experience and our policy of continuous product development.

It is the user's responsibility to check that this sheet is current prior to using the product. Issue date: 1st June 1997
Copyright © International Protective Coatings. All rights reserved. No part of this document may be reproduced without written permission.

Worldwide Availability
International Protective Coatings

World/Continent	USA/Canada	South America	Europe	Asia/Pacific	Africa
USA/Canada	111 Howe Road London, ON N4C 2B9 Canada	111 Howe Road London, ON N4C 2B9 Canada	111 Howe Road London, ON N4C 2B9 Canada	111 Howe Road London, ON N4C 2B9 Canada	111 Howe Road London, ON N4C 2B9 Canada
South America	111 Howe Road London, ON N4C 2B9 Canada	111 Howe Road London, ON N4C 2B9 Canada	111 Howe Road London, ON N4C 2B9 Canada	111 Howe Road London, ON N4C 2B9 Canada	111 Howe Road London, ON N4C 2B9 Canada
Europe	111 Howe Road London, ON N4C 2B9 Canada	111 Howe Road London, ON N4C 2B9 Canada	111 Howe Road London, ON N4C 2B9 Canada	111 Howe Road London, ON N4C 2B9 Canada	111 Howe Road London, ON N4C 2B9 Canada
Asia/Pacific	111 Howe Road London, ON N4C 2B9 Canada	111 Howe Road London, ON N4C 2B9 Canada	111 Howe Road London, ON N4C 2B9 Canada	111 Howe Road London, ON N4C 2B9 Canada	111 Howe Road London, ON N4C 2B9 Canada
Africa	111 Howe Road London, ON N4C 2B9 Canada	111 Howe Road London, ON N4C 2B9 Canada	111 Howe Road London, ON N4C 2B9 Canada	111 Howe Road London, ON N4C 2B9 Canada	111 Howe Road London, ON N4C 2B9 Canada

Tel: (416) 717-8200 Fax: (416) 717-8201
Tel: (416) 717-8200 Fax: (416) 717-8201
USA Toll-Free Number: (800) 368-1327
www.internationalpc.com

Interthane® 990 HS

International
Protective Coatings

Polyurethane

PRODUCT DESCRIPTION A low VOC, two component acrylic polyurethane high performance finish coat with excellent gloss and color retention on exterior exposure for use over correctly prepared and primed surfaces.

INTENDED USES As a durable high gloss finish coat for exposed steelwork in a wide range of aggressive environments including chemical and petrochemical plants, offshore structures, bridges, pulp and paper mills, power plants and refineries.
For use over correctly prepared primed steel and masonry surfaces in both new construction and maintenance situations.
Exhibits superior application properties, environmental durability and chemical resistance. Gives excellent gloss and color retention on exterior exposure.

PRACTICAL INFORMATION FOR INTERTHANE 990 HS

Color	Wide range via the Chromascan® system			
Gloss Level	High gloss			
Volume Solids	68% ± 3% (depends on color)			
Typical Thickness	2.3 mils (50.75 microns) dry equivalent to 2.9-4.4 mils (74-110 microns) wet			
Theoretical Coverage	545 sq. ft./US gallon at 2 mils d.f.t. and stated volume solids 13.6 m ² /liter at 50 microns d.f.t. and stated volume solids			
Practical Coverage	Allow appropriate loss factors			
Method of Application	Airless spray, Air spray, Brush, Roller			
Drying Time	Overcoating Interval Interthane 990 HS with Self Minimum Maximum			
Temperature	Touch Dry	Hard Dry		
50°F (10°C)	3 1/4 hours	30 hours	30 hours	30 days
59°F (15°C)	3 hours	22 hours	22 hours	30 days
77°F (25°C)	2 hours	12 hours	12 hours	30 days
104°F (40°C)	1 hour	4 hours	4 hours	30 days

REGULATORY DATA

Flash Point	Base (Part A) 100°F (38°C)	C/A (Part B) 135°F (57°C)	Mixed 103°F (39°C)
Product Weight	12.5 lb/gal (1.5 kg/l)		
VOC	2.73 lb/gal (327 g/l)	USA - EPA Method 24 330 g/l	
		UK - PG6/23(92), Appendix 3	

164

Interthane® 990 HS
Polyurethane

SURFACE PREPARATION All surfaces to be coated should be clean, dry and free from contamination. Prior to paint application all surfaces should be assessed and treated in accordance with ISO 8504:1992.

Primed Surfaces

Interthane 990 HS should always be applied over a recommended anti-corrosive coating scheme. The primer surface should be dry and free from all contamination, and Interthane 990 HS must be applied within the overcoating interval specified (consult the relevant product data sheet).

Areas of breakdown, damage etc., should be prepared to the specified standard (e.g. SSPC-SP6 or Sa2½ (ISO 8501-1:1988). Abrasive Blasting, or SSPC-SP11, Power Tool Cleaning) and patch primed prior to the application of Interthane 990 HS.

APPLICATION **Mixing** Material is supplied in two containers as a unit. Always mix a complete unit in the proportions supplied. Once the unit has been mixed it must be used within the working pot life specified.

- (1) Agitate Base (Part A) with a power agitator.
- (2) Combine entire contents of Curing Agent (Part B) with Base (Part A) and mix thoroughly with power agitator.

Mix Ratio	9 parts : 1 part by volume			
Working Pot Life	50°F (10°C) 7 hours	59°F (15°C) 6 hours	77°F (25°C) 3 hours	104°F (40°C) 1 hour

Airless Spray Recommended Tip range 15-19 thou (0.38-0.48 mm)
Total output fluid pressure at spray tip not less than 2,000 p.s.i. (141 kg/cm²)

Air Spray (Pressure Pot) Recommended Gun DeVilbiss MBC or JGA
Air Cap 704 or 765
Fluid Tip E

Brush Suitable Typically 1.5-2.0 mils (40-50 microns) can be achieved

Roller Suitable Typically 1.5-2.0 mils (40-50 microns) can be achieved

Thinner International GTA056 Do not thin more than allowed by local (or GTA713) environmental legislation.

Cleaner International GTA056 (or GTA713)

Work Stoppages Do not allow material to remain in hoses, gun or spray equipment. Thoroughly flush all equipment with International GTA056. Once units of paint have been mixed they should not be resealed and it is advised that after prolonged stoppages work recommences with freshly mixed units.

Clean Up Clean all equipment immediately after use with International GTA056. It is good working practice to periodically flush our spray equipment during the course of the working day. Frequency of cleaning will depend upon amount sprayed, temperature and elapsed time, including any delays.
All surplus materials and empty containers should be disposed of in accordance with appropriate regional regulations/legislation.

Interthane® 990 HS

Polyurethane

PRODUCT CHARACTERISTICS Level of sheen and surface finish is dependent on application method. Avoid using a mixture of application methods whenever possible. Best results in terms of gloss and appearance will always be obtained with air spray application.

For brush and roller application, and in some colors, two coats of Interthane 990 HS may be required to give uniform coverage, especially when applying Interthane 990 HS over dark undercoats, and when using certain lead free bright colors such as yellows and oranges. Best practice is to use a color compatible intermediate or anti-corrosive coating under the Interthane 990 HS.

Application at high film thickness, i.e. greater than 4 mils (100 microns) is likely to detract from appearance, due to surface defects. At low film build 1.5 mils (40 microns) dry film thickness opacity will be insufficient to give good coverage, with a number of colors resulting in an uneven finish appearance.

Over-application of Interthane 990 HS will extend both the minimum overcoating periods and handling times, and may be detrimental to long term overcoating properties.

When surface temperatures are greater than 104°F (40°C) for periods greater than 72 hours then pretreatment may be required before application of a further coat of Interthane 990 HS. When recoating beyond 30 days at any surface temperature additional surface preparation may be required. Contact International Protective Coatings for recommendations.

Application at excessively high relative humidity, or under conditions where condensation is likely to occur, may result in immediate or premature loss of gloss. Best results will always be obtained by applying with RH less than 85% and with surface temperatures at least 5°F (3°C) above dew point.

Condensation occurring during or immediately after application may result in a matt finish and an inferior film.

Premature exposure to ponding water will cause a color change, especially in dark colors.

This product has the following specification approvals:

USDA approval for incidental food contact surface in federally inspected meat and poultry plants. Subject to Inspector-in-charge approval.

SYSTEMS COMPATIBILITY The following primers/intermediate coats are recommended for Interthane 990 HS:

Intercure 200	Interplus 770
Intercure 420	Interplus 880
Intergard 251	Interseal 670 HS
Intergard 269	Interzinc 42
Intergard 270	Interzinc 59
Intergard 401	Interzinc 315
Intergard 475 HS	Interzone 505
Interplus 256	Interzone 954
Interplus 356	Interzone 1000

Interthane 990 HS is designed to be topcoated with itself.

For other suitable primers/intermediate coats/topcoats, consult International Protective Coatings.

HOT STOCKS ON THE STREET

Aug 2006 Global Beverage Solutions Inc. (OTCBB:GBVS) Issue #136

History Is Set To Repeat: FOX News Features Global Beverage Solutions On It's Day Side Show. Is This The Next Hansen Natural?

At Hot Stocks on the Street, there are two things we absolutely require in any stock that we feature for our readers:

- 1. The Company must have a breakthrough technology or specific conditions that virtually guarantee the stock is about to go through the roof.**
- 2. The Company must be a small-cap stock that Wall Street hasn't spotted yet. These undiscovered gems can provide our investors with short-term explosive gains.**

You have to love FOX News. In a summer of stock market bummer, it likely found a huge winner... a company that history indicates could return investors massive profits over the next weeks, months and year. In fact, this grossly undervalued company is ready to pop as early as this July. That's why FOX News featured it in late June.

Because many Wall Street insiders consider it on the brink of becoming the next Hansen Natural (Beverages). You know the Hansen story, right? It's all over TV, Jim Cramer and MSNBC.

That's because back on Oct. 1, 2003, Hansen (HANS) was at \$5.83... less than two years later, on July 5, 2005 HANS opened at \$105.80. That's right \$106.80... if split 5 days later, but undiluted, those shares are worth about \$140. That's nearly 2,300% PROFIT in less than two years. WOW!!! Even wilder is that on July 6, 2006, those same HANS shares traded at \$210. And on July 12 the stock split again, this time 4 for 1.

So, you can just imagine the huge pile of money that smart, early-investors made on HANS. And, that's why FOX News featured a new young beverage company on it June 28 DaySide show.

They made a big thing over a com-

pany is called Global Beverage Solutions (GBVS). It has a super hot product today in a market that is getting flooded because drinks have too much sugar and U.S. kids are too fat.

FOX News featured GBVS because it made big news recently, and caught Wall Street by surprise when its Rudy Beverages division rolled out a great tasting, but low sugar, sports drink... one that parents and teachers approve of not only because the drinks are low in sugar, but because the Rudy in Rudy Beverages is none other than a legendary sports hero named Rudy Ruessiger... yup, Rudy from the movies... a name that means integrity...

And, as we're sure you have guessed, Rudy Beverages is a wholly owned subsidiary of Global Beverage Solutions (GBVS), the one everyone thinks is the next huge beverage sector winner.

Even better for you is that Rudy isn't GBVS' only star. The other star - the name that should make you rich - is a man named Drew Carver. No one's made a movie about him, but maybe they should have. Because while you may have never heard of him, Wall Street sure has.

And, you've certainly heard of the products he made famous. You see, Drew is the genius who look

As of July 25, 2006:
GLOBAL BEVERAGE SOLUTIONS INC.
Symbol: GBVS
Shares outstanding: 43,439,105
Current share price: \$0.65
Website: www.globalbeveragesolutions.com
Industry: Beverage—markets RUDY brand sports drinks and EON Water.
52 Week Range: \$0.40-\$2.04
Target Price: \$2.80

the Arizona Ice Tea Company from 750,000 cases a year to approximately 7 million and then to a whopping 20,000,000 cases in just two years. Then he moved on to SoBe. That's where Drew grew the company so fast that PepsiCo started feeling the pain. It swooped in to snap up SoBe for a sweet \$350 million! You can only imagine how well investors in SoBe did.


Now, Drew Carver has his winning hands on the helm of the Global Beverage Solutions, and truth be told, even though its products are in high demand, Carver may be the real reason everyone so high on the company.

Best of all for you today, is that Global Beverage Solution is amazingly cheap. That means you can take a hearty stake in GBVS and it won't break the bank. With Rudy Beverages, GBVS has built a solid foundation and embraced a winning philosophy... As you've seen, this is a proven recipe for outstanding success. Buy GBVS at the market today... then sit back and hold on tight.

To be removed from "Hot Stocks on the Street" please call our toll-free service at 800-308-1390

Hot Stocks on the Street, which is distributed by Pathfinder Marketing Inc. (Pathfinder), provides financial and general public relations services for small and micro-cap companies. Information concerning the subjects of this report was gathered from sources generally deemed reliable, and may include information publicly disclosed by the subject or information provided by shareholders, consultants and others, some of which they may have obtained directly from the subject by reason of their relationship therewith. The information contained herein is not guaranteed to be accurate and should not be considered all inclusive. Pathfinder is not a securities broker, investment advisor or financial analyst. The securities discussed herein are for high risk individuals only and not the general public. All material is for informational purposes only and should not be construed as an offer or solicitation to buy or sell securities. You should seek professional advice from a registered financial adviser before you do anything related with buying or selling stocks. Readers are cautioned not to place reliance on forward looking statements that suggest future results since they are based on assumptions and expectations that involve risks and uncertainties. A company's actual results could differ materially from those described in any forward looking statements. Pathfinder was paid \$150,000 for the distribution of this report. These fees were paid by Gemini Market News, Inc., who paid the fees on behalf of certain shareholders of the subject companies. Pathfinder owns no shares in the above profiled company and has been compensated in cash only. Gemini Market News, Inc.'s affiliates, officers, directors or employees may own shares of the companies described herein and in that event intend to sell said shares.




VTrans OFFICE MEMORANDUM
PROGRAM DEVELOPMENT DIVISION - Structures Design Section

TO: Chris Slesar, Environmental Specialist
FROM: Carolyn W. Carlson, Project Engineer 
DATE: August 23, 2006
SUBJECT: Salisbury-Cornwall BHO 1445(27)

Attached are the updated erosion control sheets which address the comments that we discussed on August 22, 2006.

If you have any questions or concerns, please contact us.

cc: Roger R. Whitcomb, Project Manager

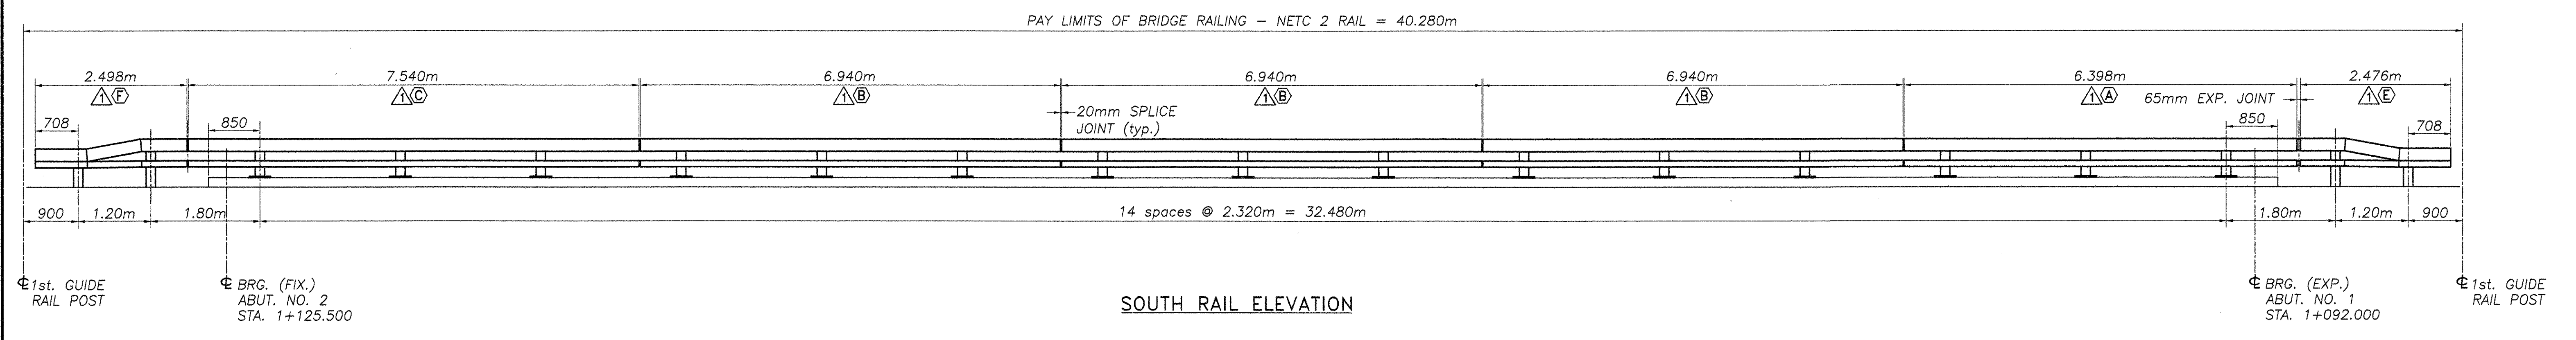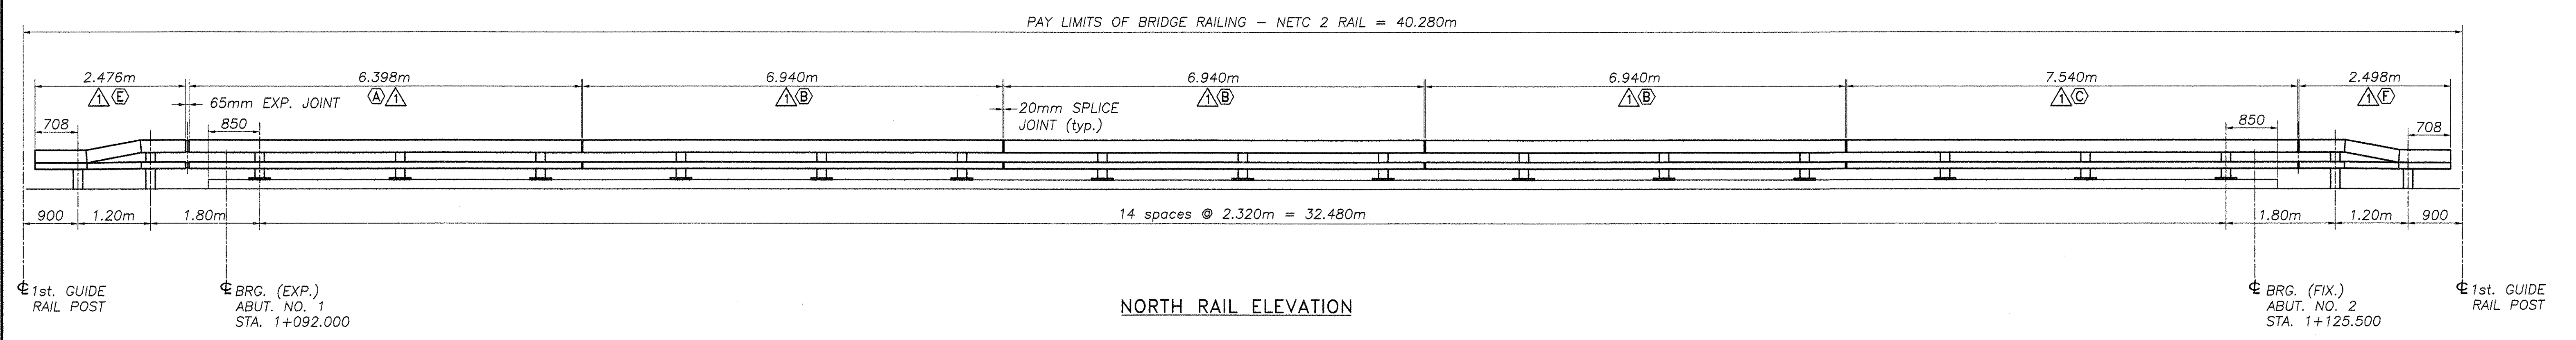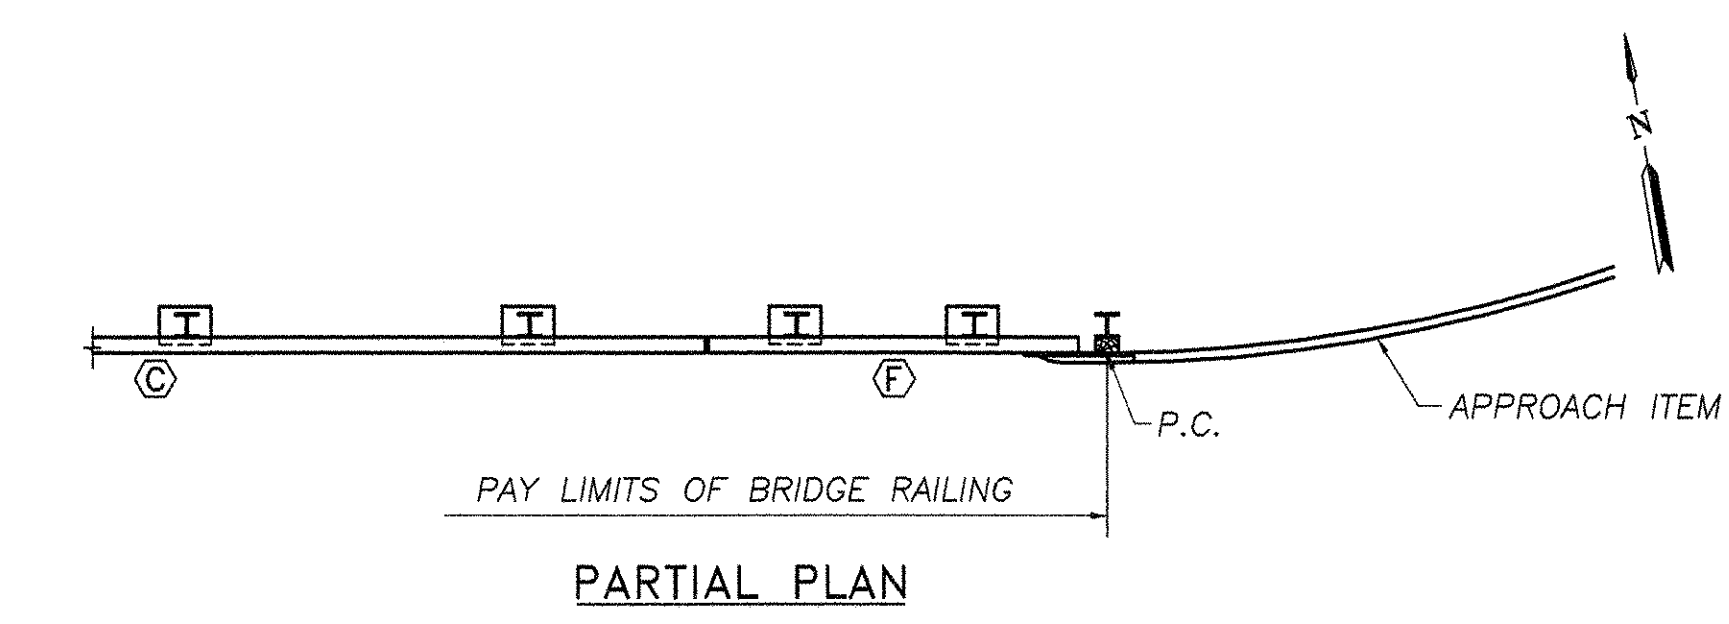

BILL OF MATERIAL (BOTH SIDES OF BRIDGE)

Mark #	Qty.	Description	Material
	30	W150x37.1 POST W/BASEPLATE (610mm) OAL	A709M Gr. 345
	4	W150x37.1 DRIVEN POST (2.135m) OAL	A709M Gr. 345
	4	W150x37.1 DRIVEN POST (1.980m) OAL	A709M Gr. 345
(A)	2	TS 203 x 102 x 8 (6.398m) OAL	A500 Gr. B
	2	TS 102 x 102 x 6 (6.398m) OAL	A500 Gr. B
(B)	6	TS 203 x 102 x 8 (6.940m) OAL	A500 Gr. B
	6	TS 102 x 102 x 6 (6.940m) OAL	A500 Gr. B
(C)	2	TS 203 x 102 x 8 (7.540m) OAL	A500 Gr. B
	2	TS 102 x 102 x 6 (7.540m) OAL	A500 Gr. B
(E)	2	TS 203 x 102 x 8 (2.476) UPPER DROP END TUBE	A500 Gr. B
	2	TS 102 x 102 x 6 (2.476) LOWER DROP END TUBE	A500 Gr. B
(F)	2	TS 203 x 102 x 8 (2.498) UPPER DROP END TUBE	A500 Gr. B
	2	TS 102 x 102 x 6 (2.498) LOWER DROP END TUBE	A500 Gr. B
	12	TS 178 x 76 x 10 SPLICE TUBE 500 LONG	A500 Gr. B
	12	TS 76 x 76 x 8 SPLICE TUBE 500 LONG	A500 Gr. B
	30	3mm BEARING PAD	NEOPRENE
	4	BACK UP PLATE	A709M Gr. 250
	4	TERMINAL CONNECTOR	M180 B2
	176	M20 ROUND HEAD BOLT, 152 LONG	M164M
	176	M20 HEX NUT	A563 DH
	176	M20 WASHER	F436M
	96	M16 SPLICE BOLT, 50 LONG	M164M
	96	M16 PLAIN HARDENED WASHER	F436M
	48	M16 NUT WELDED TO SPLICE TUBE	A563A
	16	M20 x 15 SCH. 40 PIPE SPACER	A53 Gr. B
	120	M24 ANCHOR STUD, 300 LONG	F568M CL. 8.8
	120	M24 WASHER	F436M
	120	M24 JAMB NUT	A563 DH
	240	M24 HEX NUT	A563 DH
	30	SPACER PLATE	A709M Gr. 250

NOTES:
 1. ITEMS MARKED "*" ARE NOT SUPPLIED BY HIGHWAY SAFETY CORPORATION, AND THEY ARE SHOWN ONLY FOR REFERENCE.

REVISIONS		
No.	Remarks	Date
0	Initial submittal	7-18-06
1	VT DOT Corrections	8-08-06

VT TRANS RECEIVED
 CHECKED BY: *Grey*
 AUG 21 2006
 RESUBMIT: _____ APPROVED: _____
 BY: _____ DATE: _____
 - RECORD PLANS -


HIGHWAY SAFETY CORP.
 GLASTONBURY, CT

ITEM 525.33 - BRIDGE RAILING-NETC 2 RAIL
 PROJECT No. AC BRF 0160(3)S
 TOWN OF LEICESTER Br. No. 6
 ADDISON COUNTY, ROUTE: TH 1 (FAS 160)


GENERAL CONTRACTOR: *190 BR*
 SUB CONTRACTOR: F.R. LAFAYETTE, INC.

DRAWN: MHM
 CHECKED: _____
 DATE: 7-18-06
 SCALE: NONE
 HSC REFERENCE NO.: 1560
 SHEET NO.: 1 of 2



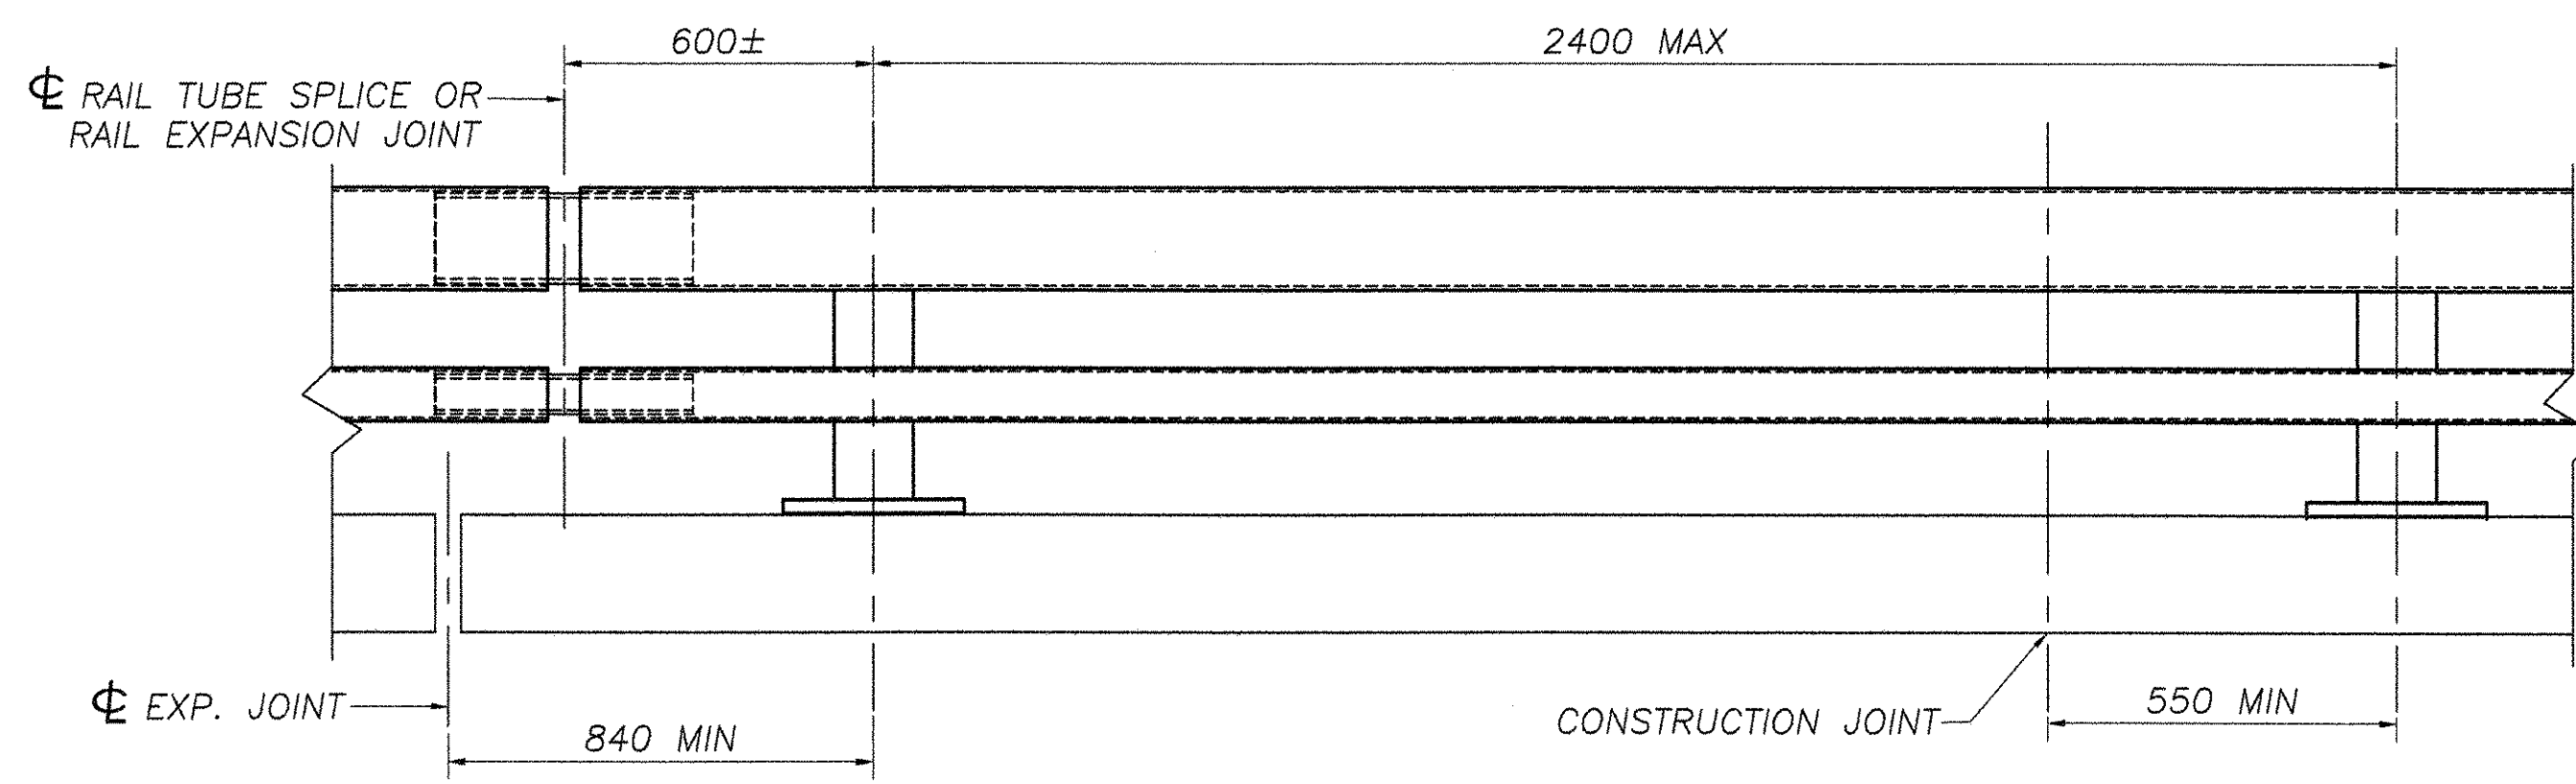


BRIDGE RAILING ELEVATION

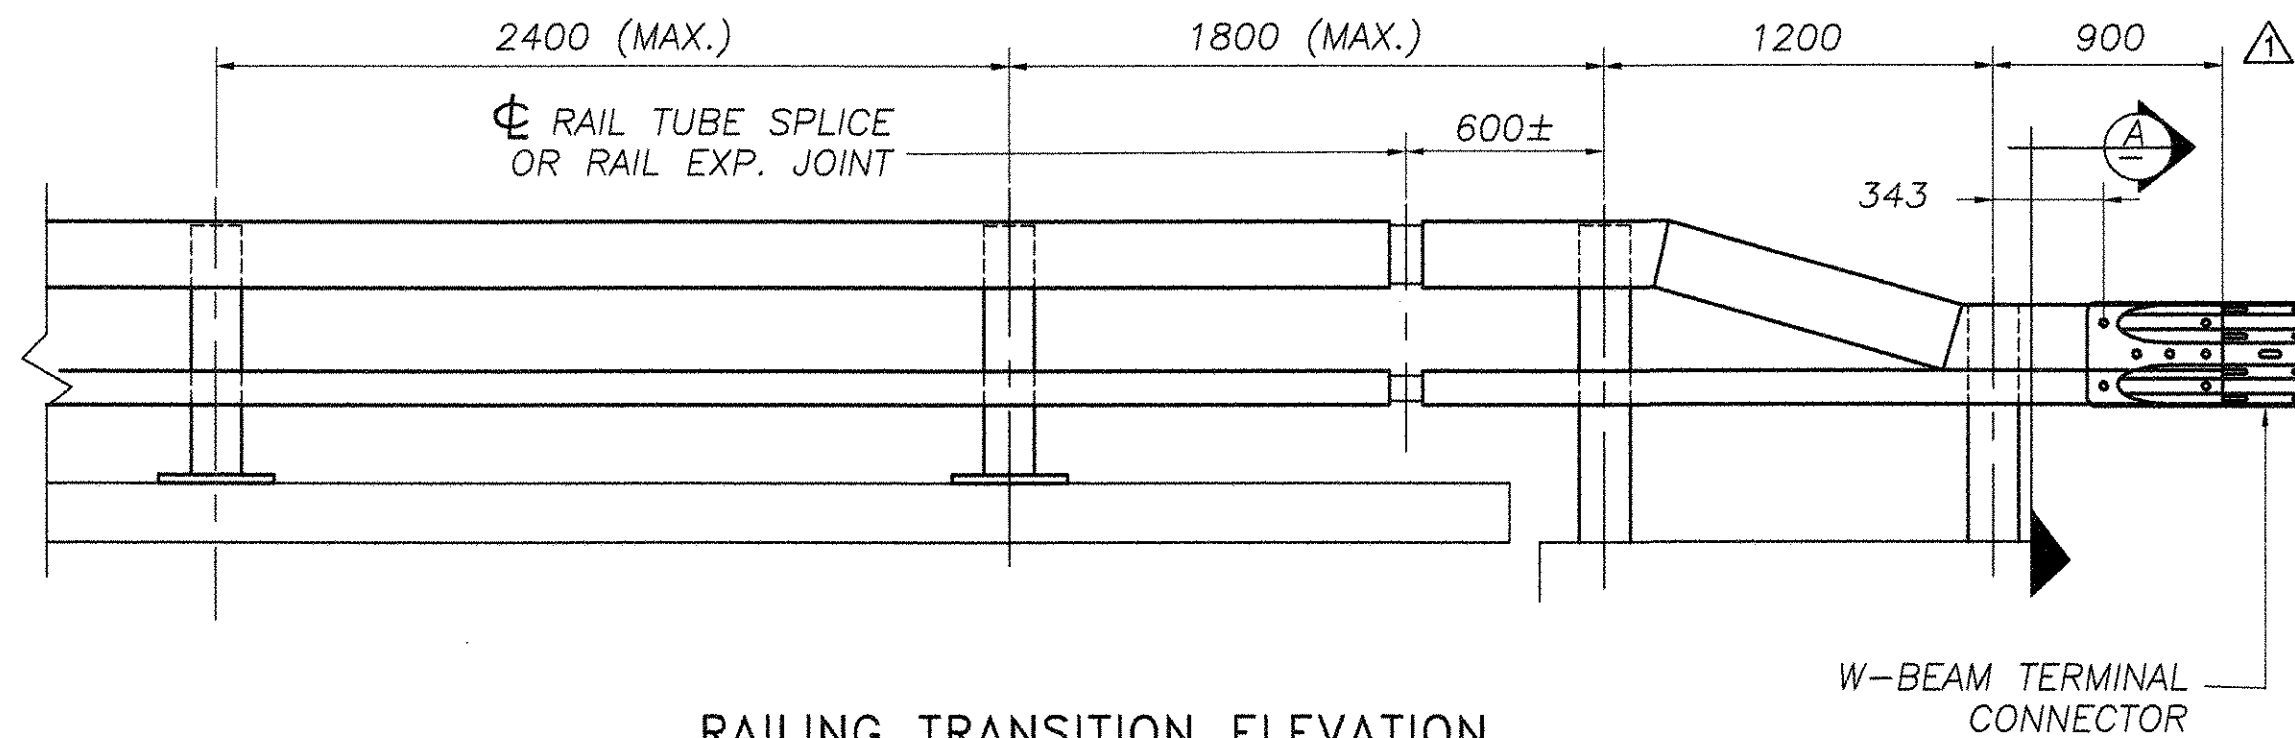


RAILING TRANSITION ELEVATION (BOTH ENDS OF BRIDGE)

- NOTES:**
1. ALL RAILINGS AND MATERIALS SHALL CONFORM TO THE PROVISION OF SECTION 525, "RAILINGS OF THE STANDARD SPECIFICATION FOR CONSTRUCTION".
 2. TUBING AND POSTS SHALL MEET THE REQUIREMENTS OF SECTION 732, "RAILING MATERIALS OR THE STANDARD SPECIFICATION FOR CONSTRUCTION," EXCEPT THAT THE DROP-WEIGHT TEAR TEST IN SECTION 732 SHALL NOT APPLY TO THE STRUCTURAL TUBING SHOWN ON THIS SHEET.
 3. PRIOR TO GALVANIZING, ALL EXPOSED CUT OR SHEARED EDGES SHALL BE ROUNDED TO A 2mm RADIUS AND BE FREE OF BURRS.
 4. RAIL POSTS SHALL BE SET NORMAL TO GRADE.
 5. SECTIONS OF RAIL TUBE SHALL BE ATTACHED TO A MINIMUM OF TWO (2) RAIL POSTS AND PREFERABLY TO AT LEAST FOUR (4) POSTS.
 6. RAIL TUBE EXPANSION JOINT SHALL BE PROVIDED IN ANY RAIL BAY SPANNING A SUPERSTRUCTURE EXPANSION JOINT. EXPANSION JOINT WIDTH SHALL BE "X" AT 7°C AND WILL BE ADJUSTED IN THE FIELD BY THE ENGINEER FOR OTHER TEMPERATURES.
 7. ALL PARTS SHALL BE GALVANIZED AFTER FABRICATION IN ACCORDANCE WITH AASHTO M111, EXCEPT HARDWARE, WHICH SHALL MEET THE REQUIREMENTS OF AASHTO M232M.
 8. RAIL POST ANCHORING NUTS SHALL BE TIGHTENED TO A SNUG FIT AND GIVEN AN ADDITIONAL ONE-EIGHTH TURN.
 9. RAIL TUBES SHALL BE ATTACHED USING M20 FULL DIAMETER BODY AASHTO M164M (TYPE 1) ROUND HEAD BOLT INSERTED THROUGH THE FACE OF THE TUBE. HOLES IN POSTS SHALL BE 2mm LARGER THAN THE BOLT SIZE.
 10. HOLES IN RAILS FOR RAIL TUBE ATTACHMENT MAY BE FIELD-DRILLED. HOLES SHALL BE COATED WITH AN APPROVED ZINC-RICH PAINT PRIOR TO ERECTION.
 11. IF THERE IS A CONFLICT BETWEEN THE DETAILS SHOWN ON THIS SHEET AND THE DESIGN, THE REQUIREMENTS OF THE DESIGN DRAWINGS SHALL BE FOLLOWED.
 12. ANY BENDING OF RAIL SHALL BE BY SHOP PROCEDURE ONLY.
 13. THE FABRICATOR SHALL SUBMIT SHOP DRAWINGS, INCLUDING WELDING PROCEDURES TO THE STRUCTURES SECTION FOR APPROVAL IN ACCORDANCE WITH THE PROVISION OF 506.04, SHOP DRAWINGS. ALL WELDING SHALL CONFORM WITH SECTION 506.10.
 14. RAIL POSTS AND BASE PLATES SHALL BE TESTED FOR IMPACT PROPERTIES IN ACCORDANCE WITH ASTM A370 CHARPY IMPACT TESTING USING TYPE A SPECIMENS.
 15. TO FACILITATE FIELD FIT - UP OF THE TRANSITION RAILING, POSTS SHALL BE SET LOOSELY INTO FIBER FORM TUBES WHILE TRANSITION PARTS ARE BEING ASSEMBLED. POST HOLES SHALL BE BACKED FILLED WITH A CONCRETE MIX APPROVED BY THE ENGINEER. PAYMENT FOR COMPONENTS, INCLUDING BACKUP PLATE AND END TERMINAL CONNECTOR FOR GUARD RAIL, AUGERING, FIBER FORM TUBES AND CONCRETE, AND INSTALLATION SHALL BE CONSIDERED INCIDENTAL TO ITEM 525.33, "BRIDGE RAILING - NETC 2 RAILING".
 16. ALL APPROACH RAIL SPLICES SHALL BE LAPPED ON THE DIRECTION OF TRAFFIC FLOW.

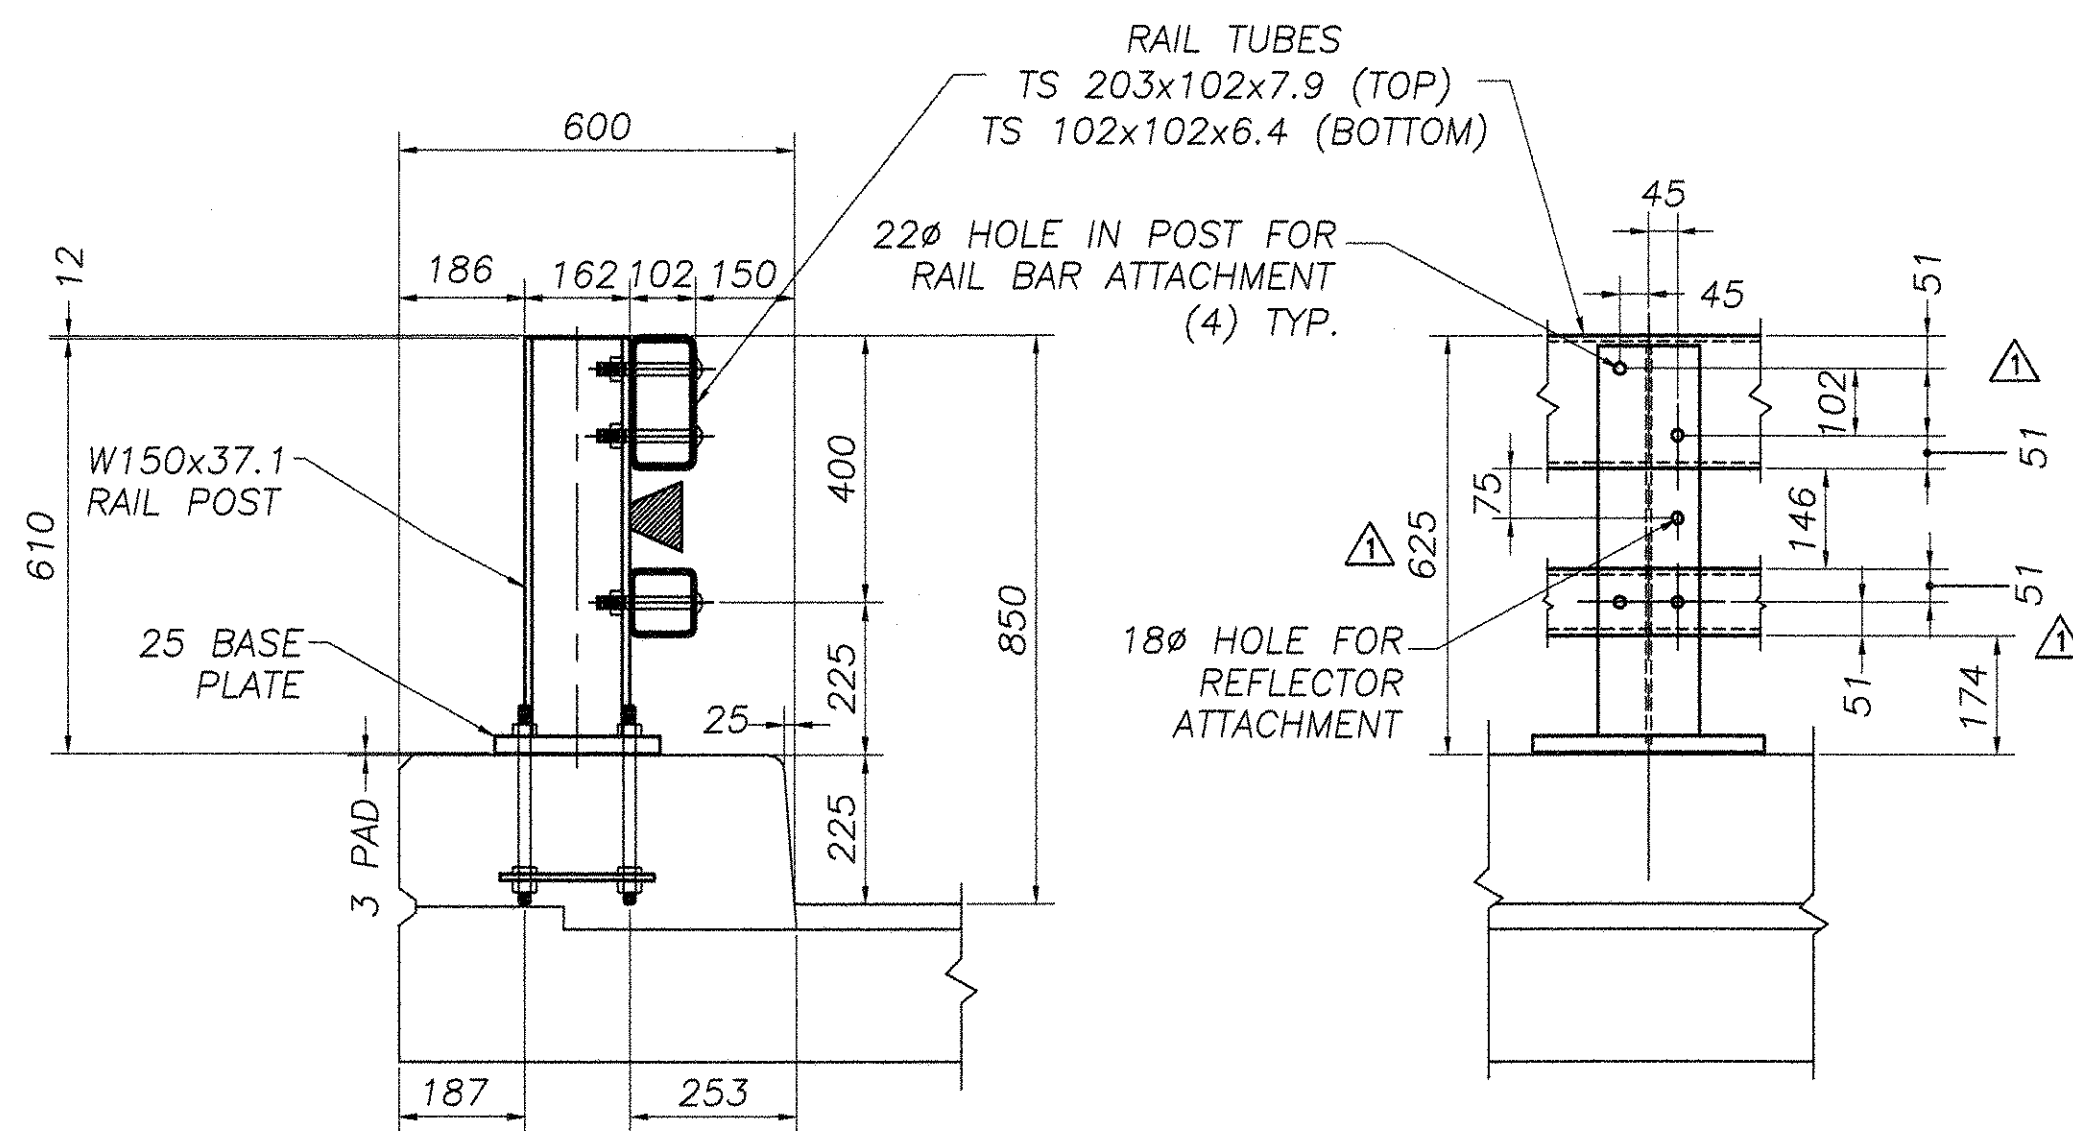


TYPICAL SECTION


ELEVATION

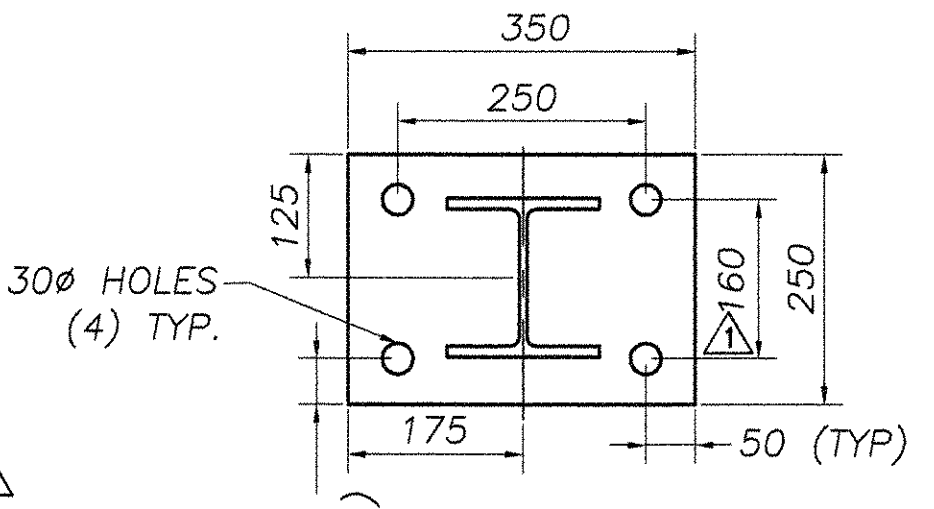


POST AND BASE PLATE

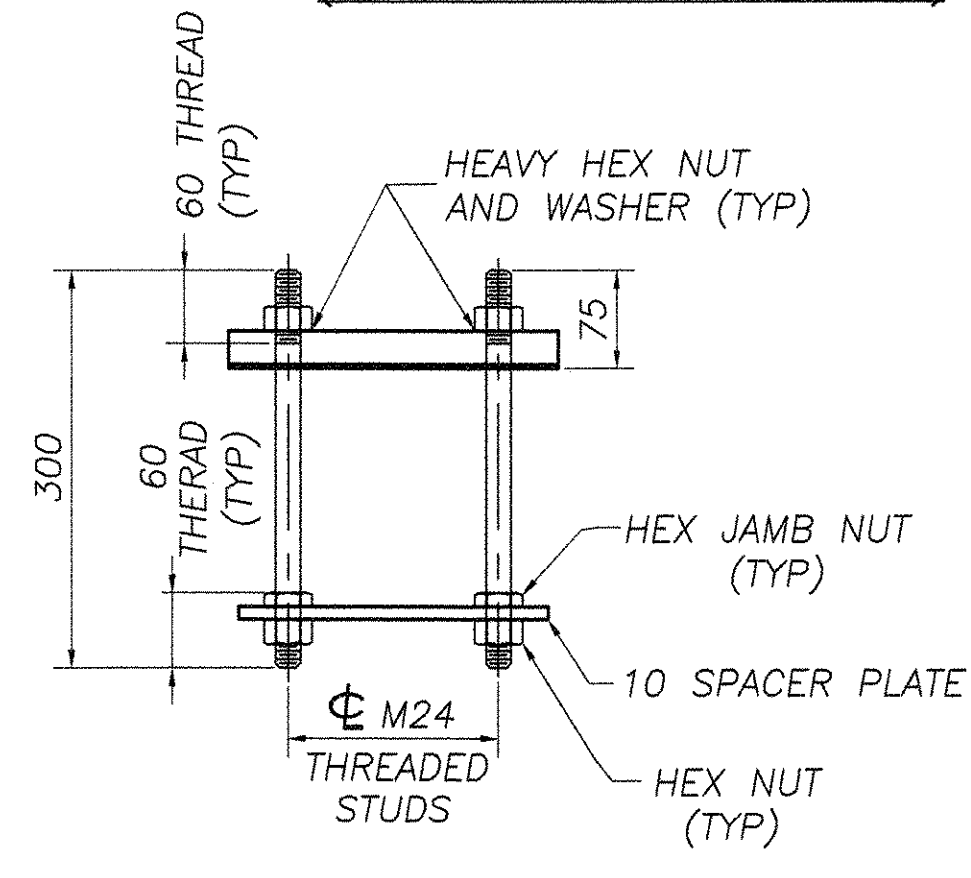


RAIL POST ANCHORAGE (BY OTHERS)

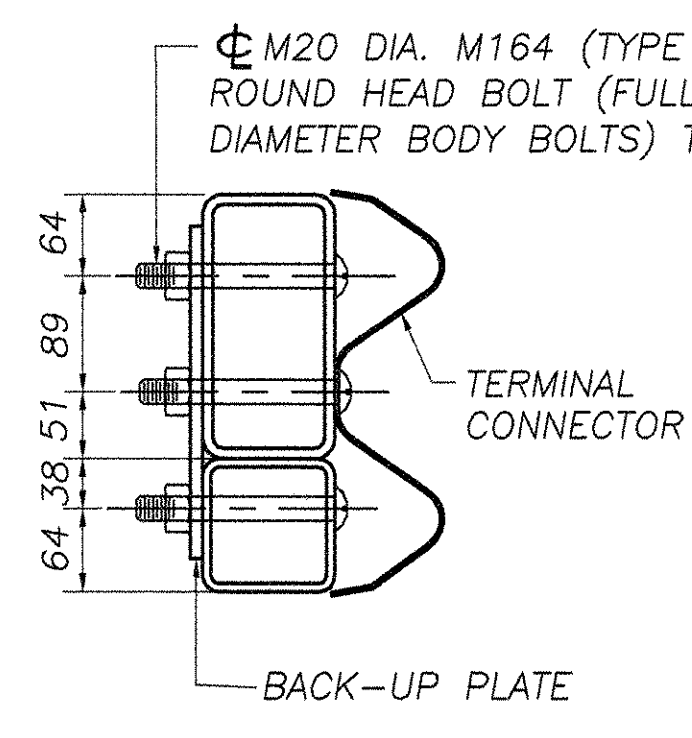


SECTION A

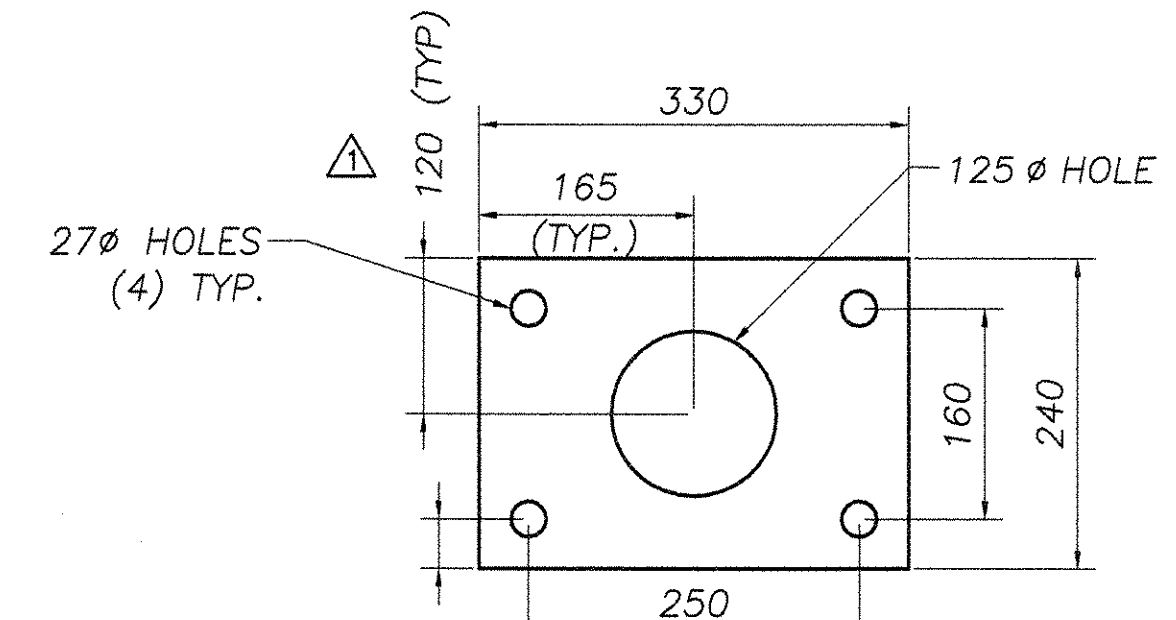


SPACER PLATE (BY OTHERS)

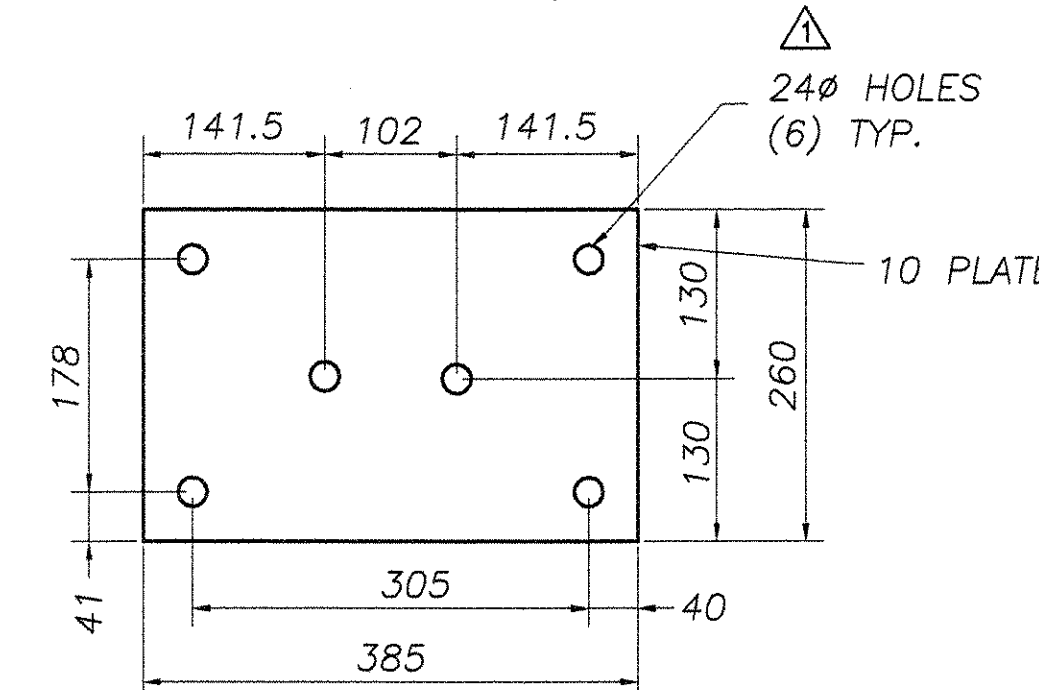


BACK-UP PLATE

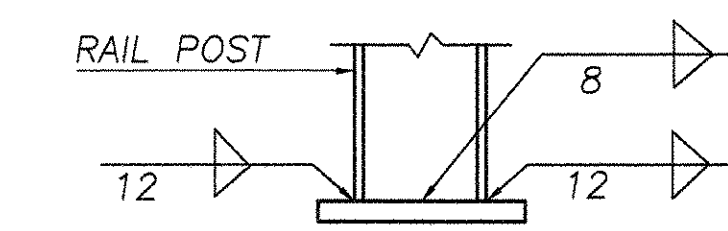

BASE WELD DETAIL

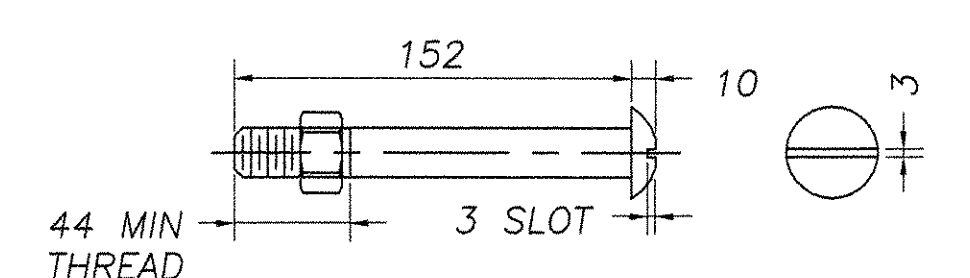


M20 DIA. M164M (TYPE 1) ROUND HEAD BOLT (WITH WASHER AND PREVAILING TORQUE TYPE LOCK NUT) (SEE NOTE #9) ONLY FULL DIAMETER BODY BOLTS WILL BE ALLOWED.

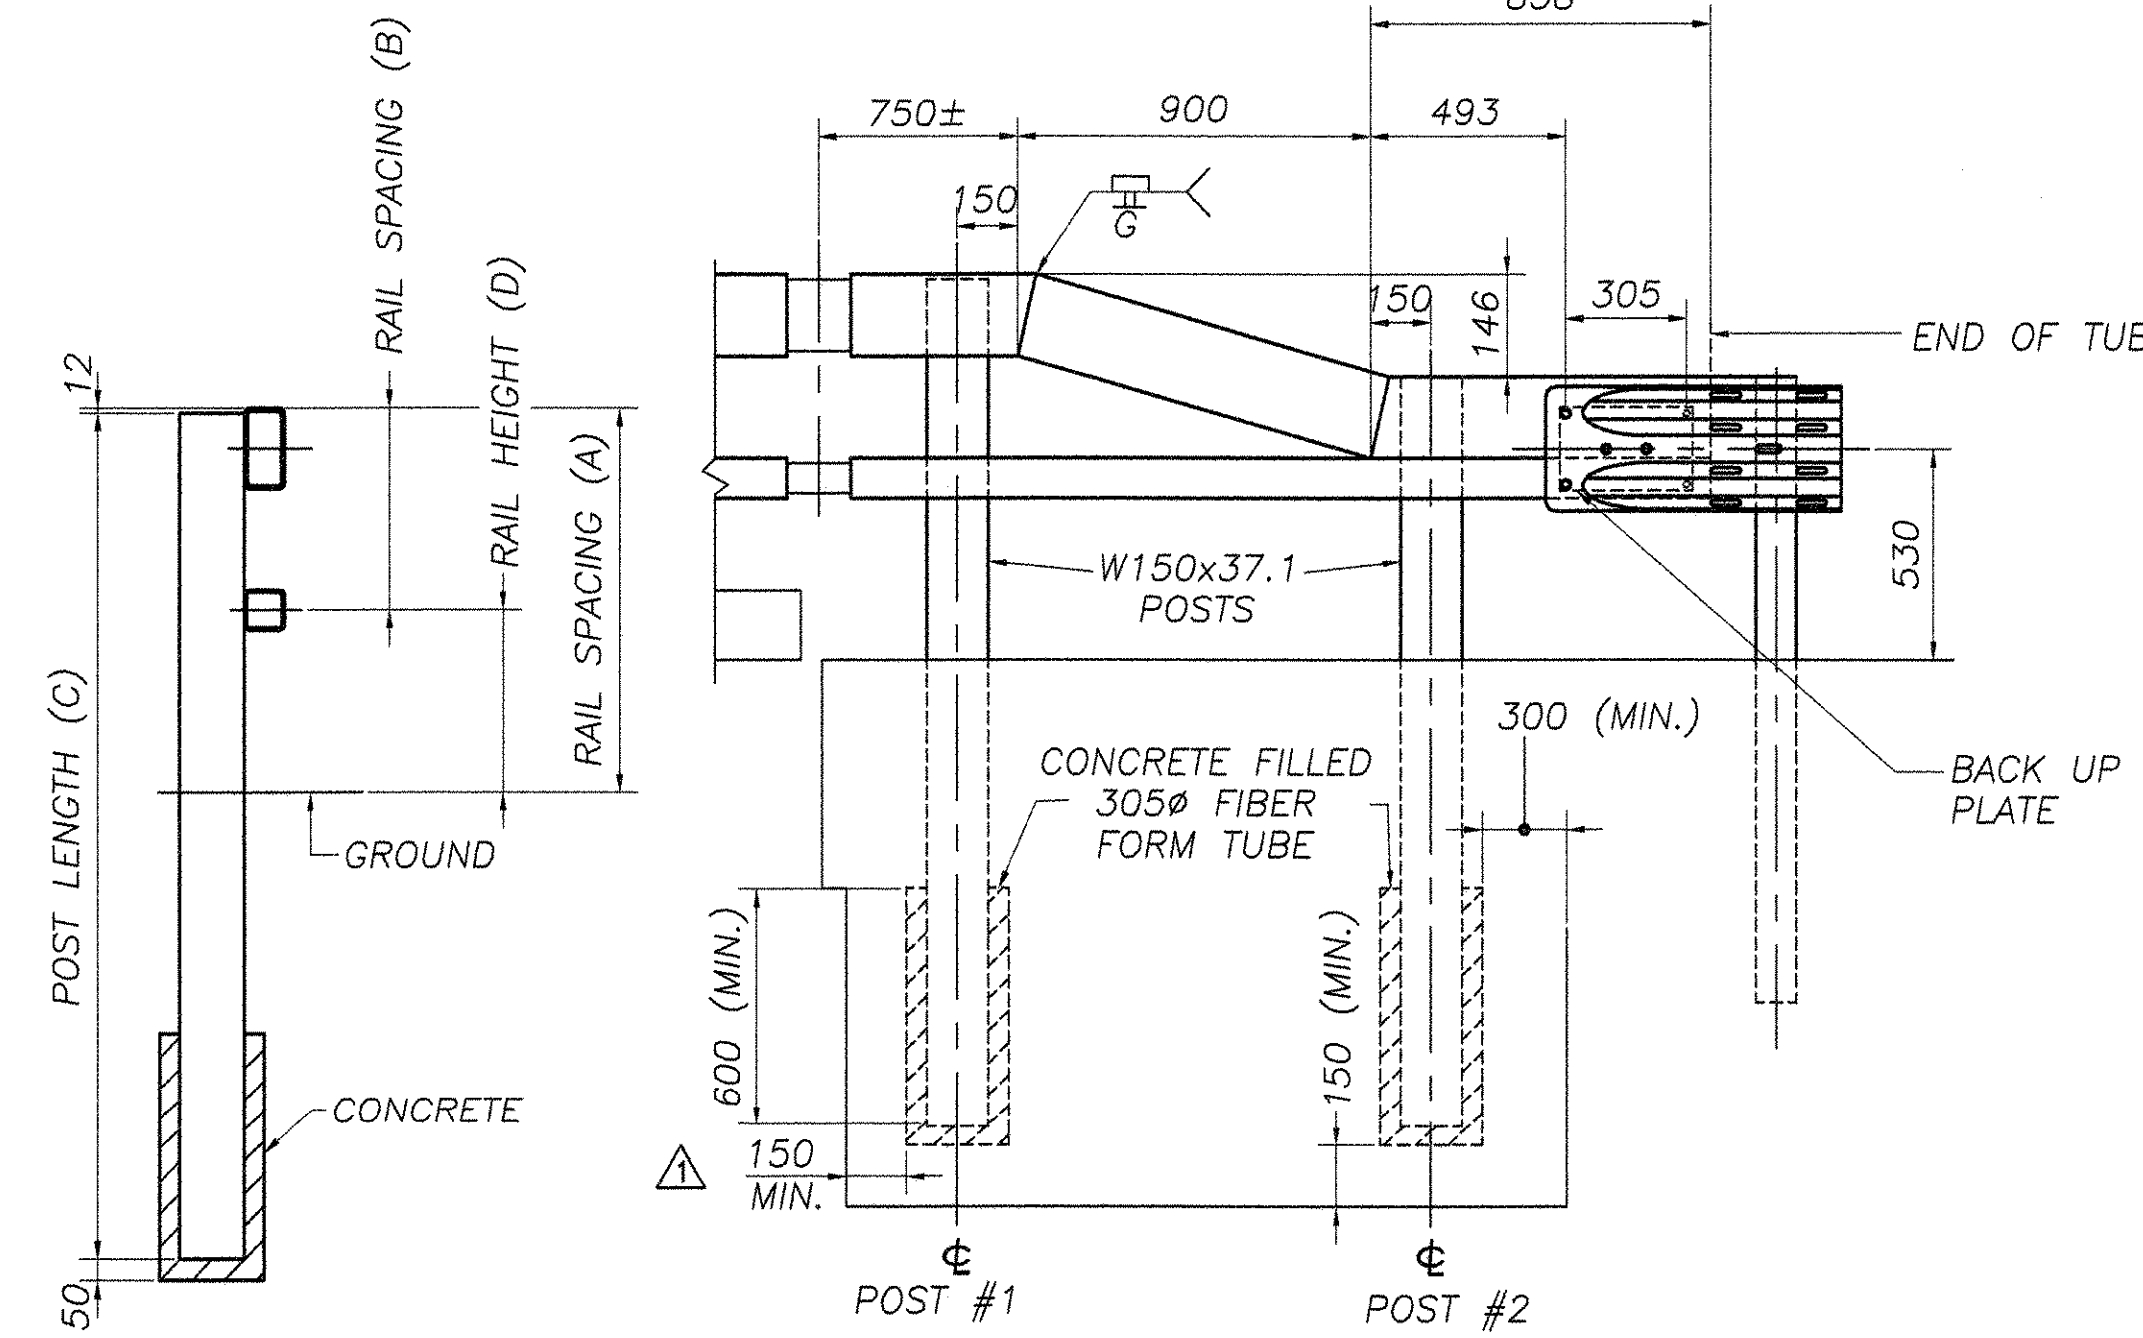


TYPICAL SECTION


ELEVATION

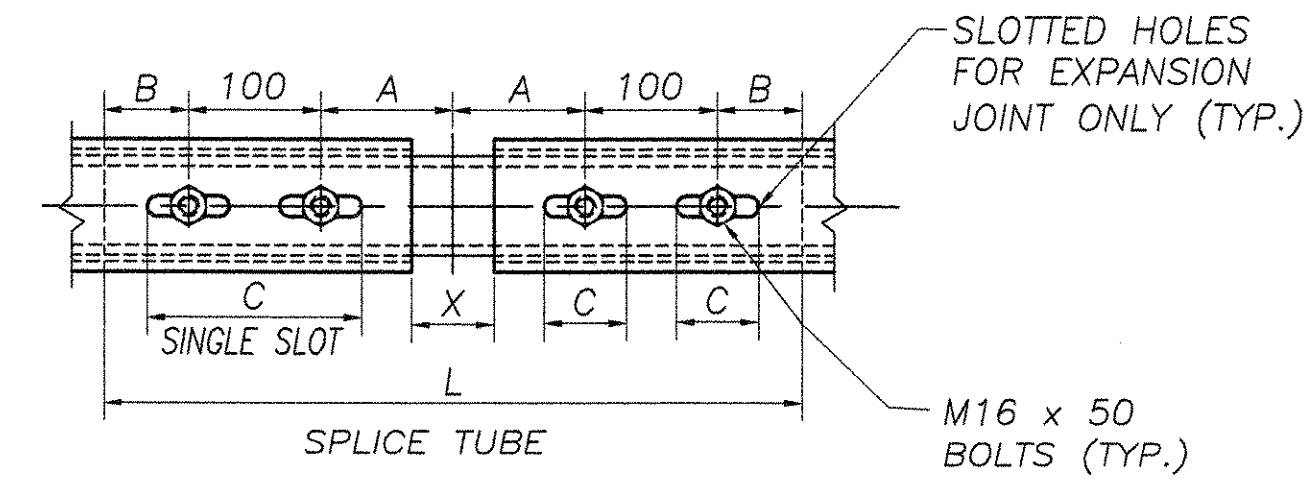


RAIL TUBE SPLICE AND RAIL EXPANSION JOINT DETAIL

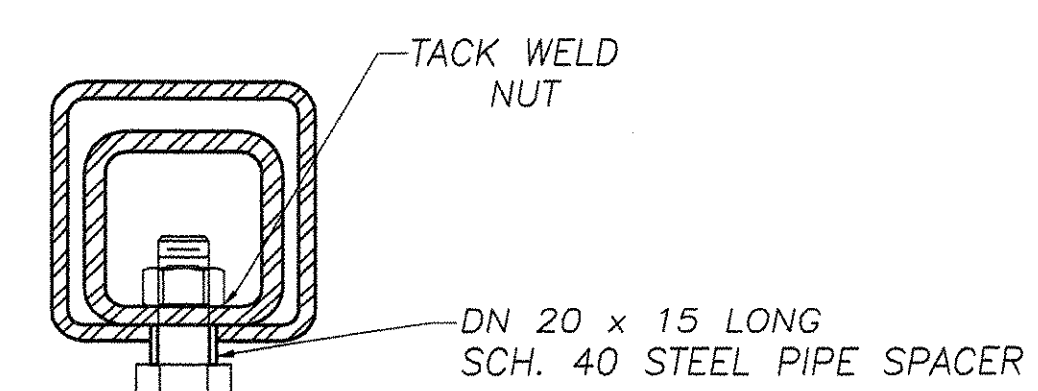

EXPANSION JOINT SECTION FOR DETAILS NOT SHOWN, SEE "RAIL TUBE SPLICE SECTION."

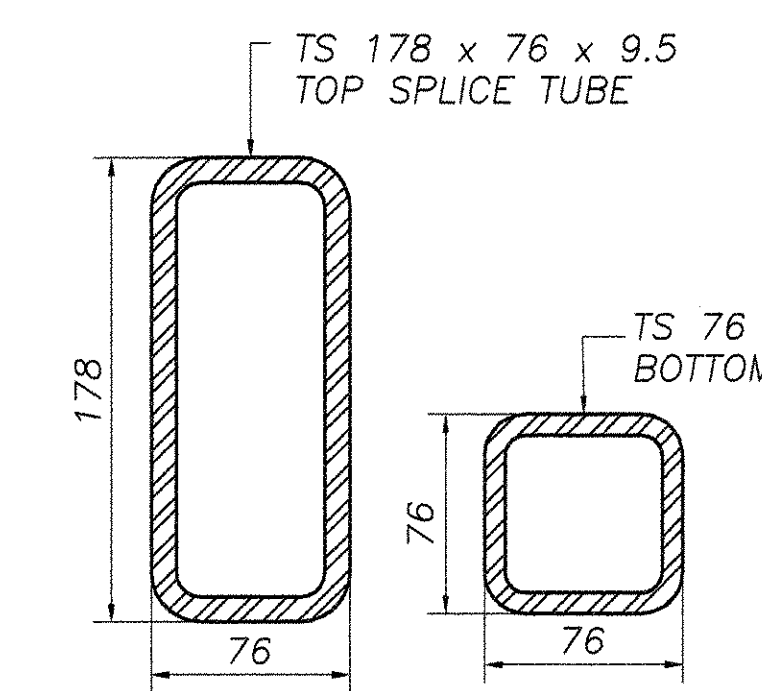

RAIL TUBE SPLICE SECTION

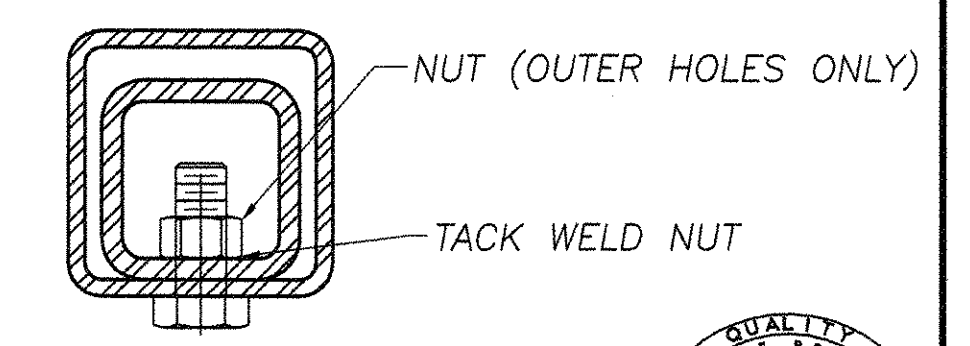

16mm TAPPED HOLE IN SPLICE TUBE & 20mm HOLE IN RAIL TUBE FOR M16 BOLT & PLAIN HARDENED WASHER



POST NUMBER	RAIL HEIGHT (A)	RAIL SPACING (B)	POST LENGTH (C)	RAIL HEIGHT (D)
1	850	400	2135	450
2	704	254	1990	450

SPLICE TABLE					
T	A	B	C	L	X
N/A	100	50	--	500	20
EXPANSION JOINT TABLE					
<100	100	50	65	500	65

T = TOTAL MOVEMENT BETWEEN BRIDGE EXPANSION JOINTS. SEE NOTE 6

* = SINGLE SLOT

REVISIONS		
No.	Remarks	Date
0	Initial submittal	7-18-06
1	VT DOT Corrections	8-08-06

RECEIVED
 AUG 21 2006
 RECORD PLANS

HIGHWAY SAFETY CORP.
 GLASTONBURY, CT

ITEM 525.33 - BRIDGE RAILING-NETC 2 RAIL

PROJECT No. AC BRF 0160(3)S
 TOWN OF LEICESTER Br. No. 6
 ADDISON COUNTY, ROUTE: TH 1 (FAS 160)

GENERAL CONTRACTOR: F.R. LAFAYETTE, INC.

DRAWN: MHM
 CHECKED: _____
 DATE: 7-18-06
 SCALE: NONE
 HSC REFERENCE NO.: 1560
 SHEET NO.: 2 of 2