


BEGIN R.O.W. PROJECT
STA. 2+003.5 7.4M(24')LT.

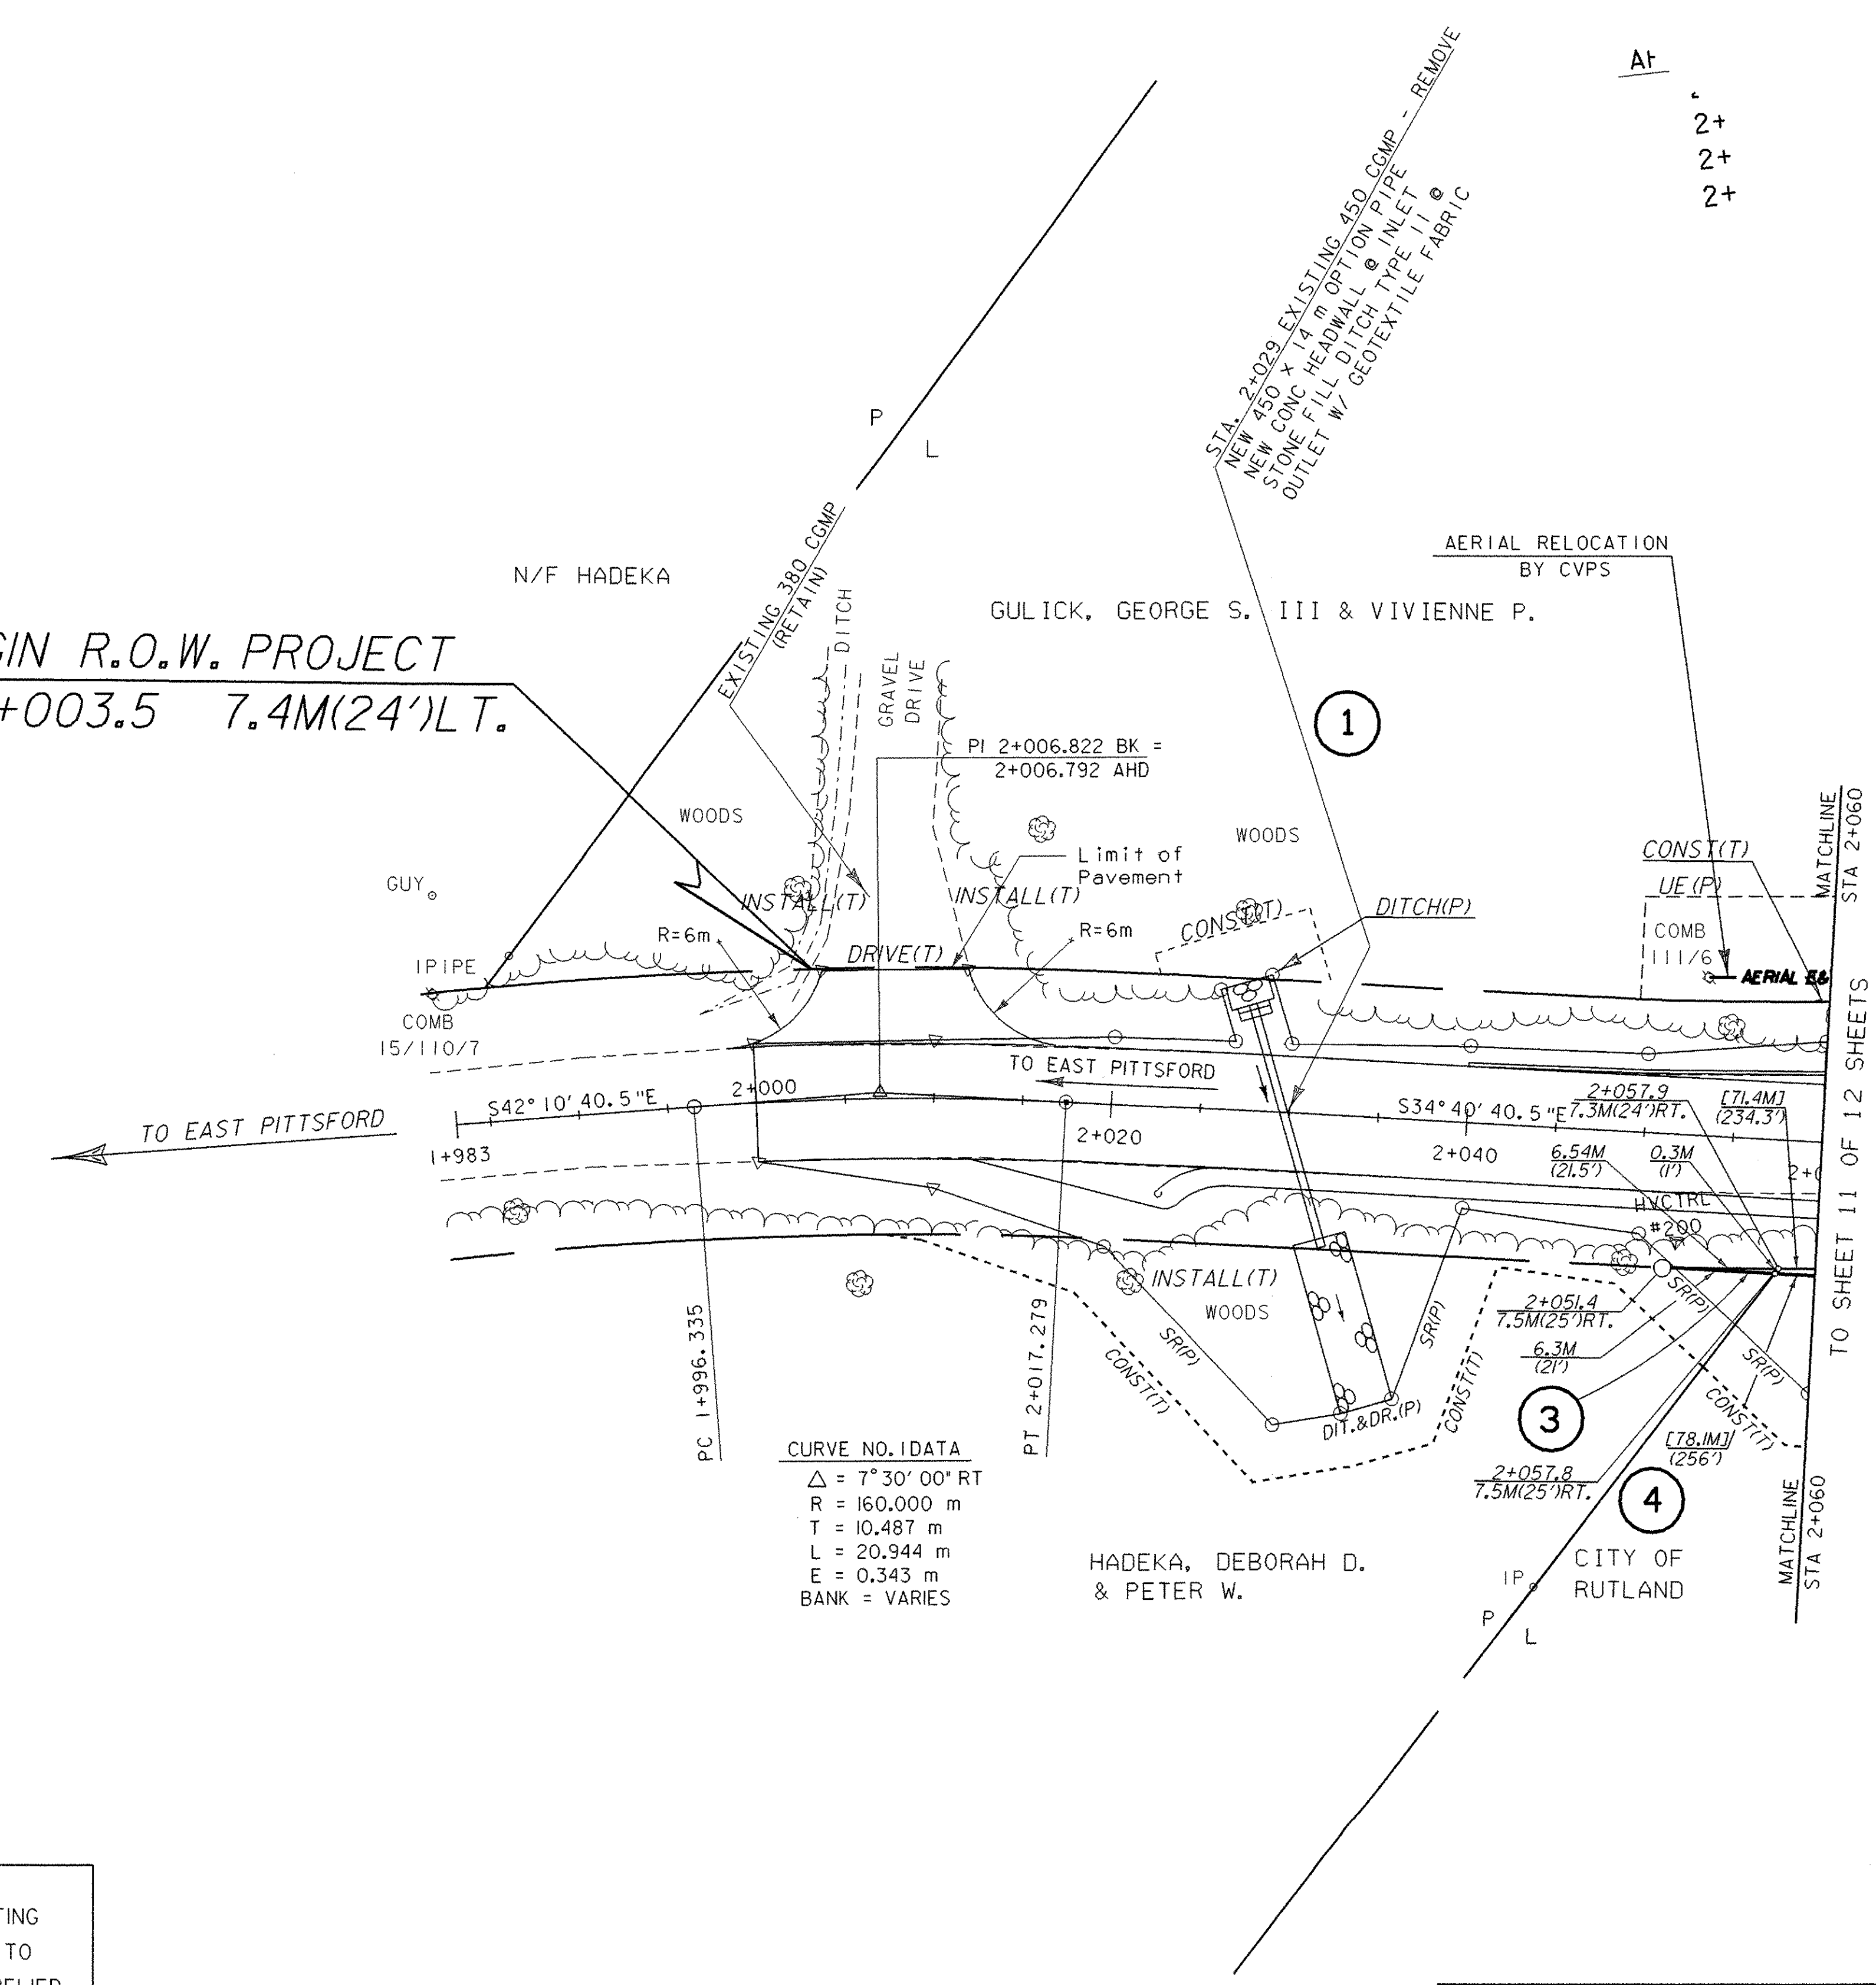

CURVE NO. 1 DATA

Δ = 7° 30' 00" RT
R = 160.000 m
T = 10.487 m
L = 20.944 m
E = 0.343 m
BANK = VARIES

LINES SHOWN ON THIS PLAN AS EXISTING PROPERTY LINES (P/L) ARE BELIEVED TO BE ACCURATE BUT SHOULD NOT BE RELIED UPON FOR PURPOSES UNRELATED TO THE TOWN OF MENDON ACQUISITION OF LAND AND RIGHTS FOR THIS PROJECT.

DATUM

VERTICAL	_____
HORIZONTAL	_____

FOR R.O.W. USE ONLY

PROJECT: MENDON	PROJECT NO.: BRO 1443(35)
DESIGN FILE NAME: /str5/95j290/sj290bdr.dgn	PLOT DATE: 18-NOV-2005
IPARM FILE NAME: SJ290LI.i	SURVEY DATE: 2/96
SURVEYED BY: L. ORVIS	DRAWN BY: R.H. PELLETT
SQUAD LEADER: C. KELLER	
R. O. W. SHEET 10 OF 12 SHEETS	SHEET 10 OF 94