


CURVE NO. 1 DATA
 $\Delta = 7^\circ 30' 00''$ RT
 R = 160.000 m
 T = 10.487 m
 L = 20.944 m
 E = 0.343 m
 BANK = VARIES

HVCTRL #4
 12.207 TIE CORNER OF HOUSE
 15.535 TIE CORNER OF HOUSE
 29.658 TIE COMB. 109/8

LAYOUT SHEET 1

DATUM	
VERTICAL	NAVD 88
HORIZONTAL	NAD 83/92

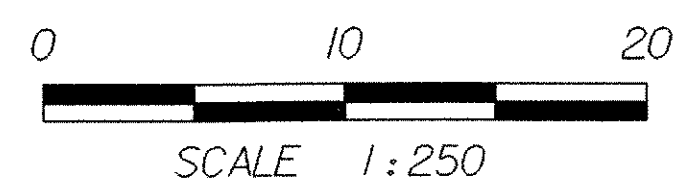

PROJECT: MENDON	PROJECT NO.: BRO 1443(35)
DESIGN FILE NAME: /s+r5/95j290/sj290bdr.dgn	PLOT DATE: 18-NOV-2005
IPARM FILE NAME: SJ290LI	SURVEYED BY: L. ORVIS
SURVEYED BY: L. ORVIS	SURVEY DATE: 2/96
SQUAD LEADER: C. KELLER	DRAWN BY: R.H.PELLETT
LAYOUT SHEET 1	SHEET: 14 OF 94