


**LAYOUT SHEET 3**

DATUM	
VERTICAL	NAVD88
HORIZONTAL	NAD 83/92

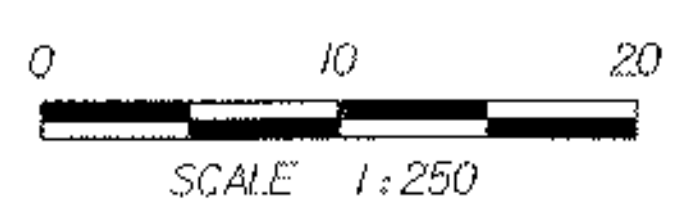

PROJECT: <b>MENDON</b>	PROJECT NO.: BRO 1443(35)
DESIGN FILE NAME: /str5/95j290/sj290bdr.dgn	PLOT DATE: 18-NOV-2005
IPARM FILE NAME: SJ290L3.I	SURVEY DATE: 2/96
SURVEYED BY: L. ORVIS	DRAWN BY: R.H. PELLETT
SQUAD LEADER: C. KELLER	SHEET: 16 OF 94
LAYOUT SHEET 3	