



PLAN

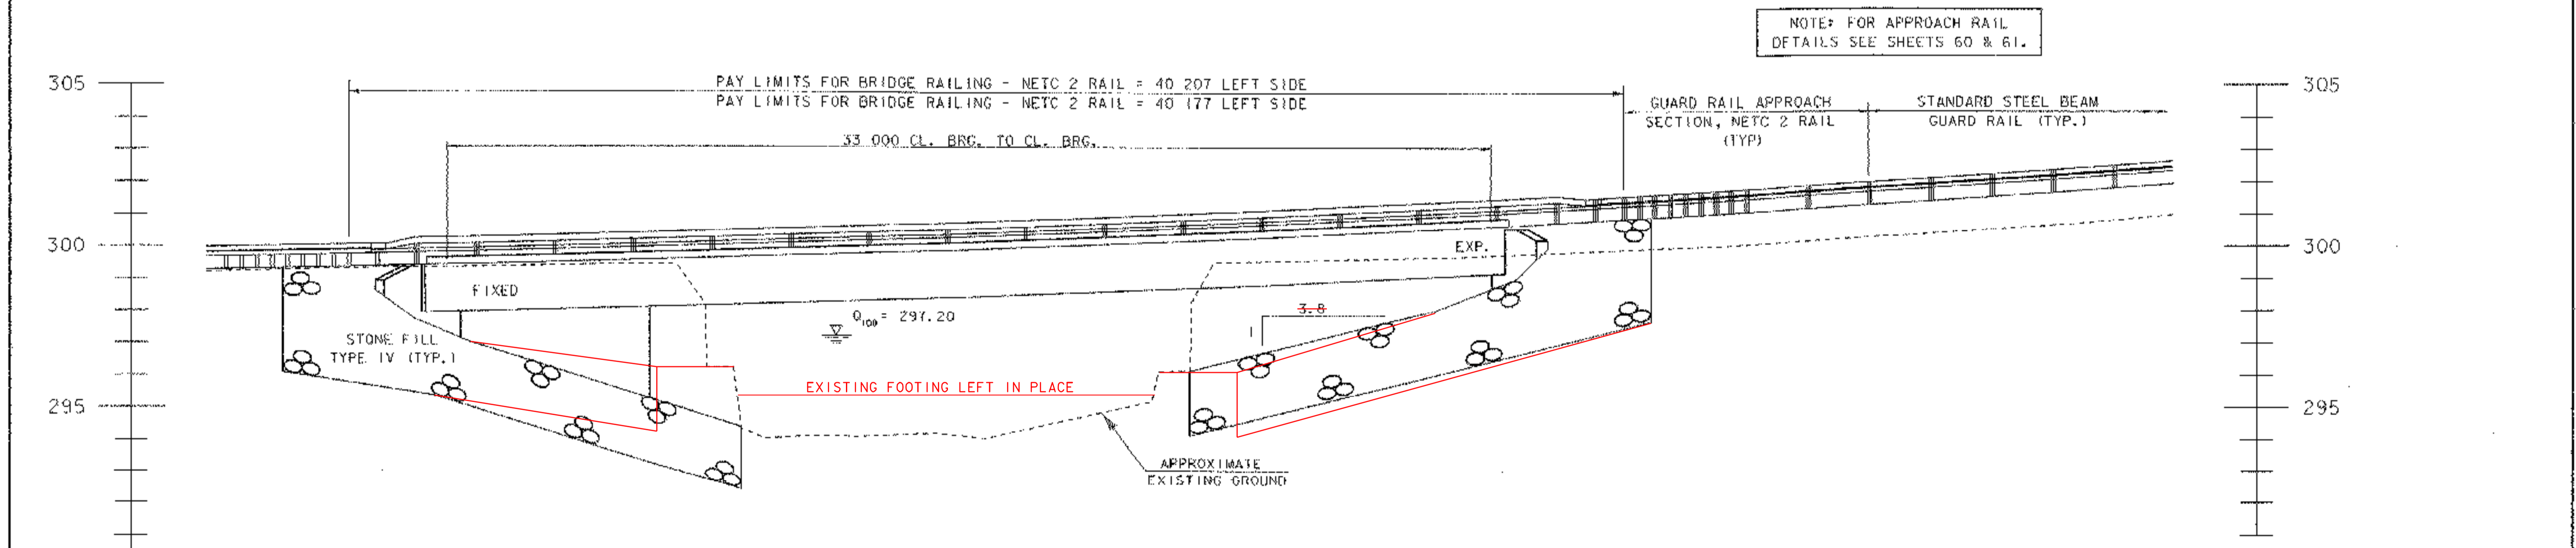

ELEVATION LOOKING UPSTREAM

DATUM	
VERTICAL	NAVD 88
HORIZONTAL	NAD 83/92

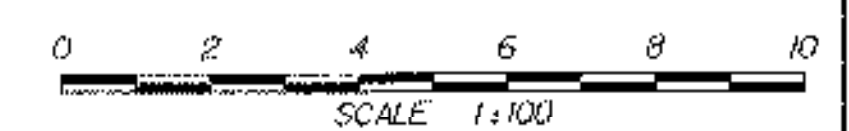

PLAN & ELEVATION SHEET	
PROJECT: MENDON	PROJECT NO. # BR0 1443(35)
DESIGN FILE NAME: /str/5/95/290/sj290pe.dgn	PLOT DATE: 18-NOV-2005
IPARM FILE NAME: SJ290PE.I	SURVEY DATE: 2/96
SURVEYED BY: L. ORVIS	DRAWN BY: G. SHANGRAW
SQUAD LEADER: C. KELLER	SHEET: 23 OF 94
PLAN & ELEVATION SHEET	