


CURVE NO. 1 DATA
 $\Delta = 7^\circ 30' 00''$ RT
 $R = 160.000$ m
 $T = 10.487$ m
 $L = 20.944$ m
 $E = 0.343$ m
 BANK = VARIES

CURVE NO. 2 DATA
 $\Delta = 10^\circ 00' 00''$ LT
 $R = 160.000$ m
 $T = 13.998$ m
 $L = 27.925$ m
 $E = 0.611$ m
 BANK = 7.5 % MAX.

NOTES
 1. PHASE 4 EROSION CONTROL MEASURES SHOWN ON THIS SHEET ARE IN ADDITION TO EROSION CONTROL MEASURES SHOWN FOR PHASES 1, 2 & 3.

DATUM
 VERTICAL NAVD 88
 HORIZONTAL NAD 83/92

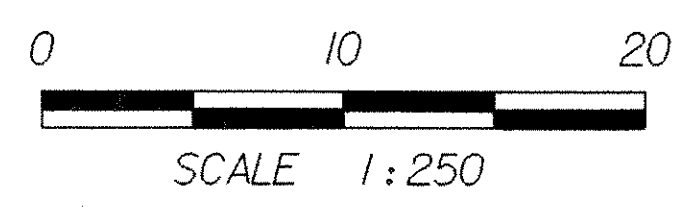

LEGEND

- DROP INLET PROTECTION
- SILT FENCE
- STONE BERMS
- STRAW MATTING

**PHASE 4
 ESTABLISH ROADWAY
 EROSION CONTROLS**

PROJECT: MENDON	PROJECT NO. : BRO 1443(35)
DESIGN FILE NAME: /str5/95j290/sj290ecbdr.dgn	PLOT DATE: 18-NOV-2005
IPARM FILE NAME: sj290ec06.i	SURVEY DATE: 2/96
SURVEYED BY: L. ORVIS	DRAWN BY: G. SHANGRAW
SQUAD LEADER: C. KELLER	SHEET: 38 OF 94