


**Note:**  
 This sheet shows the overall impacts to the immediate project area. Final Contours lines are not available, so slope indicators are shown at 20 meter intervals on both sides of the road.

**FINAL CONDITIONS**

<b>DATUM</b>	
VERTICAL	NAVD 88
HORIZONTAL	NAD 83/92

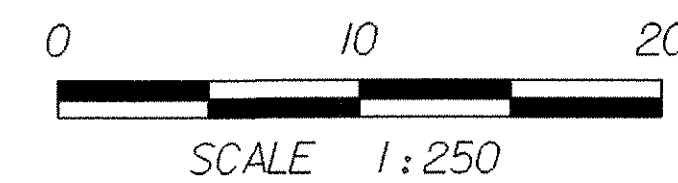

PROJECT: <b>MENDON</b>	PROJECT NO.: BRO 1443(35)
DESIGN FILE NAME: /s/r5/95j290/sj290ecbdr.dgn	PLOT DATE: 18-NOV-2005
IPARM FILE NAME: sj290ec09.i	SURVEY DATE: 2/96
SURVEYED BY: L. ORVIS	DRAWN BY: G. SHANGRAW
SQUAD LEADER: C. KELLER	SHEET: 41 OF 94