

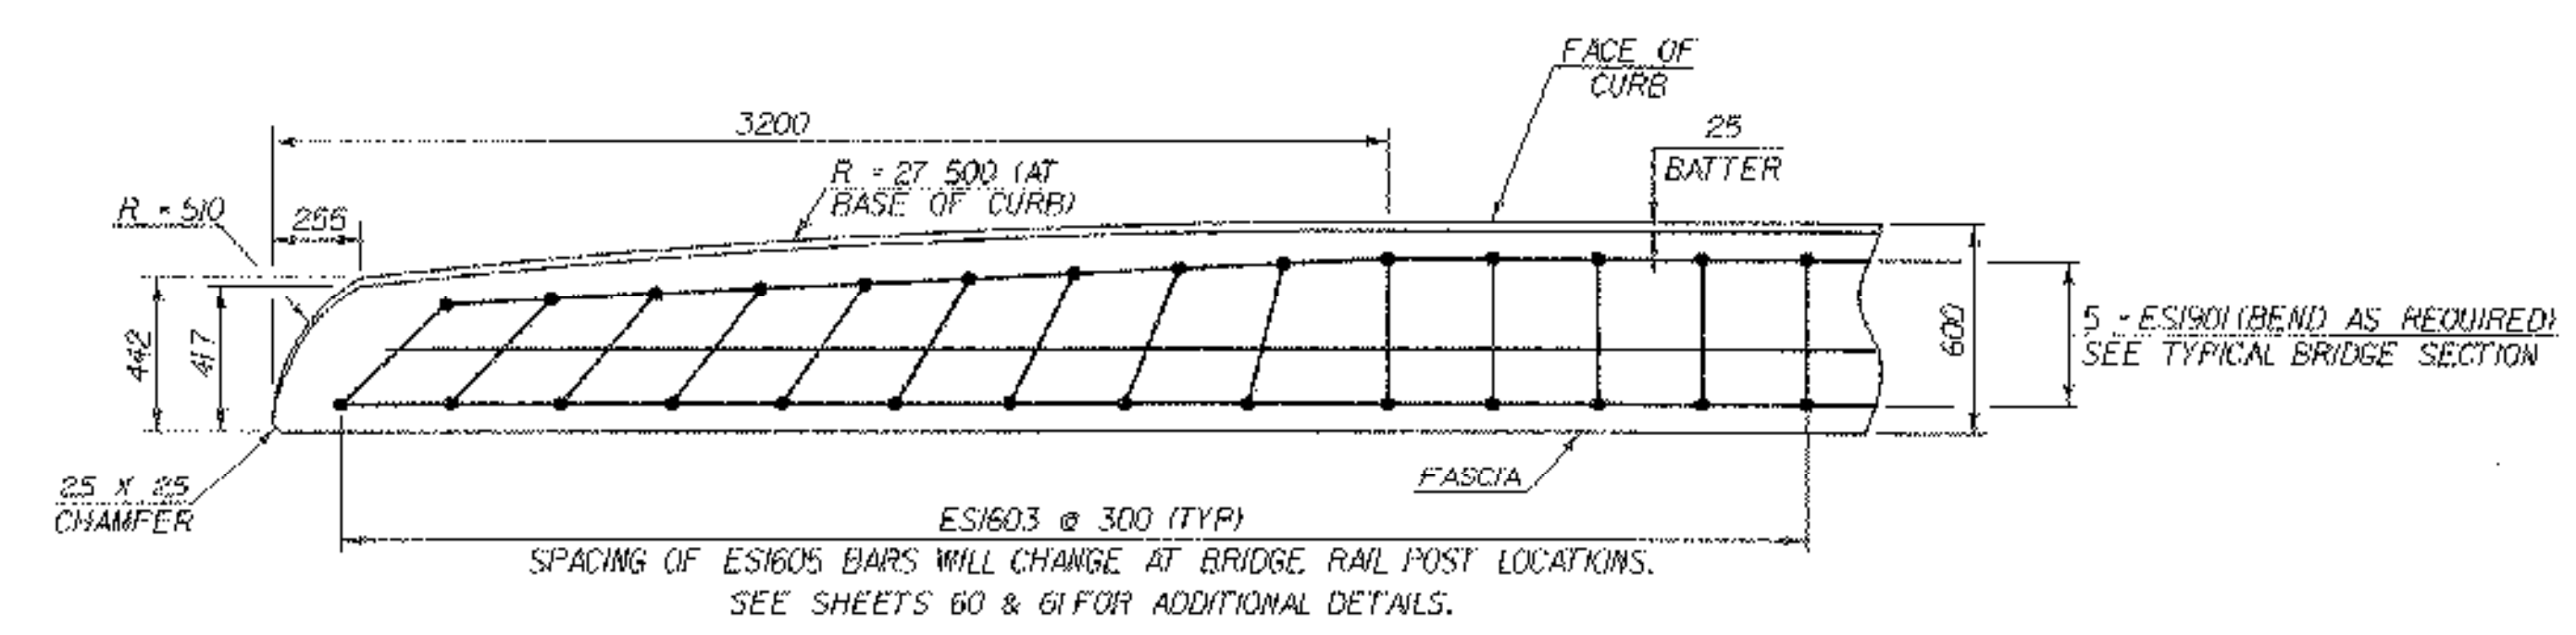


DECK PLAN

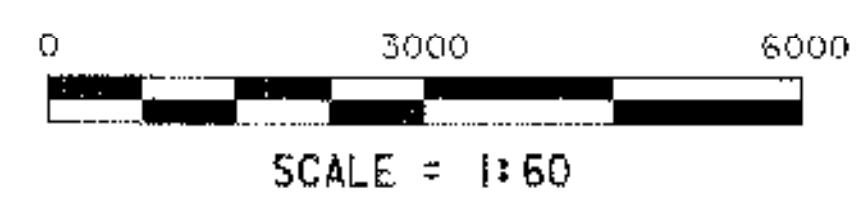

CURB END DETAIL

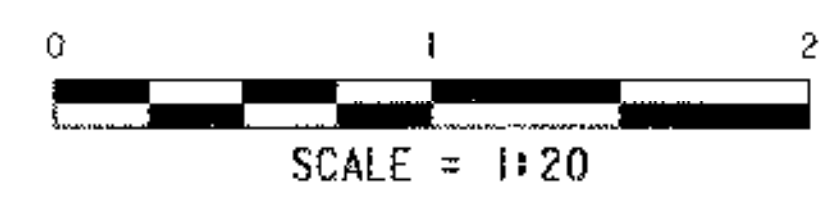

NOTE:

- NF - NEAR FACE
- FF - FAR FACE
- EF - EACH FACE
- ▲ - CUT TO FIT IN FIELD 75 CLR. UNLESS OTHERWISE SPECIFIED ON THE PLANS.

DECK PLAN SHEET

PROJECT NAME:	MENDON	PLOT DATE:	18-NOV-2005
PROJECT NUMBER:	BRO 1443 (35)	DRAWN BY:	K. RUTTER
FILE NAME:	/str/5/95/290/s/290sup.dgn	CHECKED BY:	T. SUMNER
PROJECT LEADER:	C. KELLER	SHEET	46 OF 94
DESIGNED BY:	M. EVANS-MONGEON		
	s/290deck.l		