

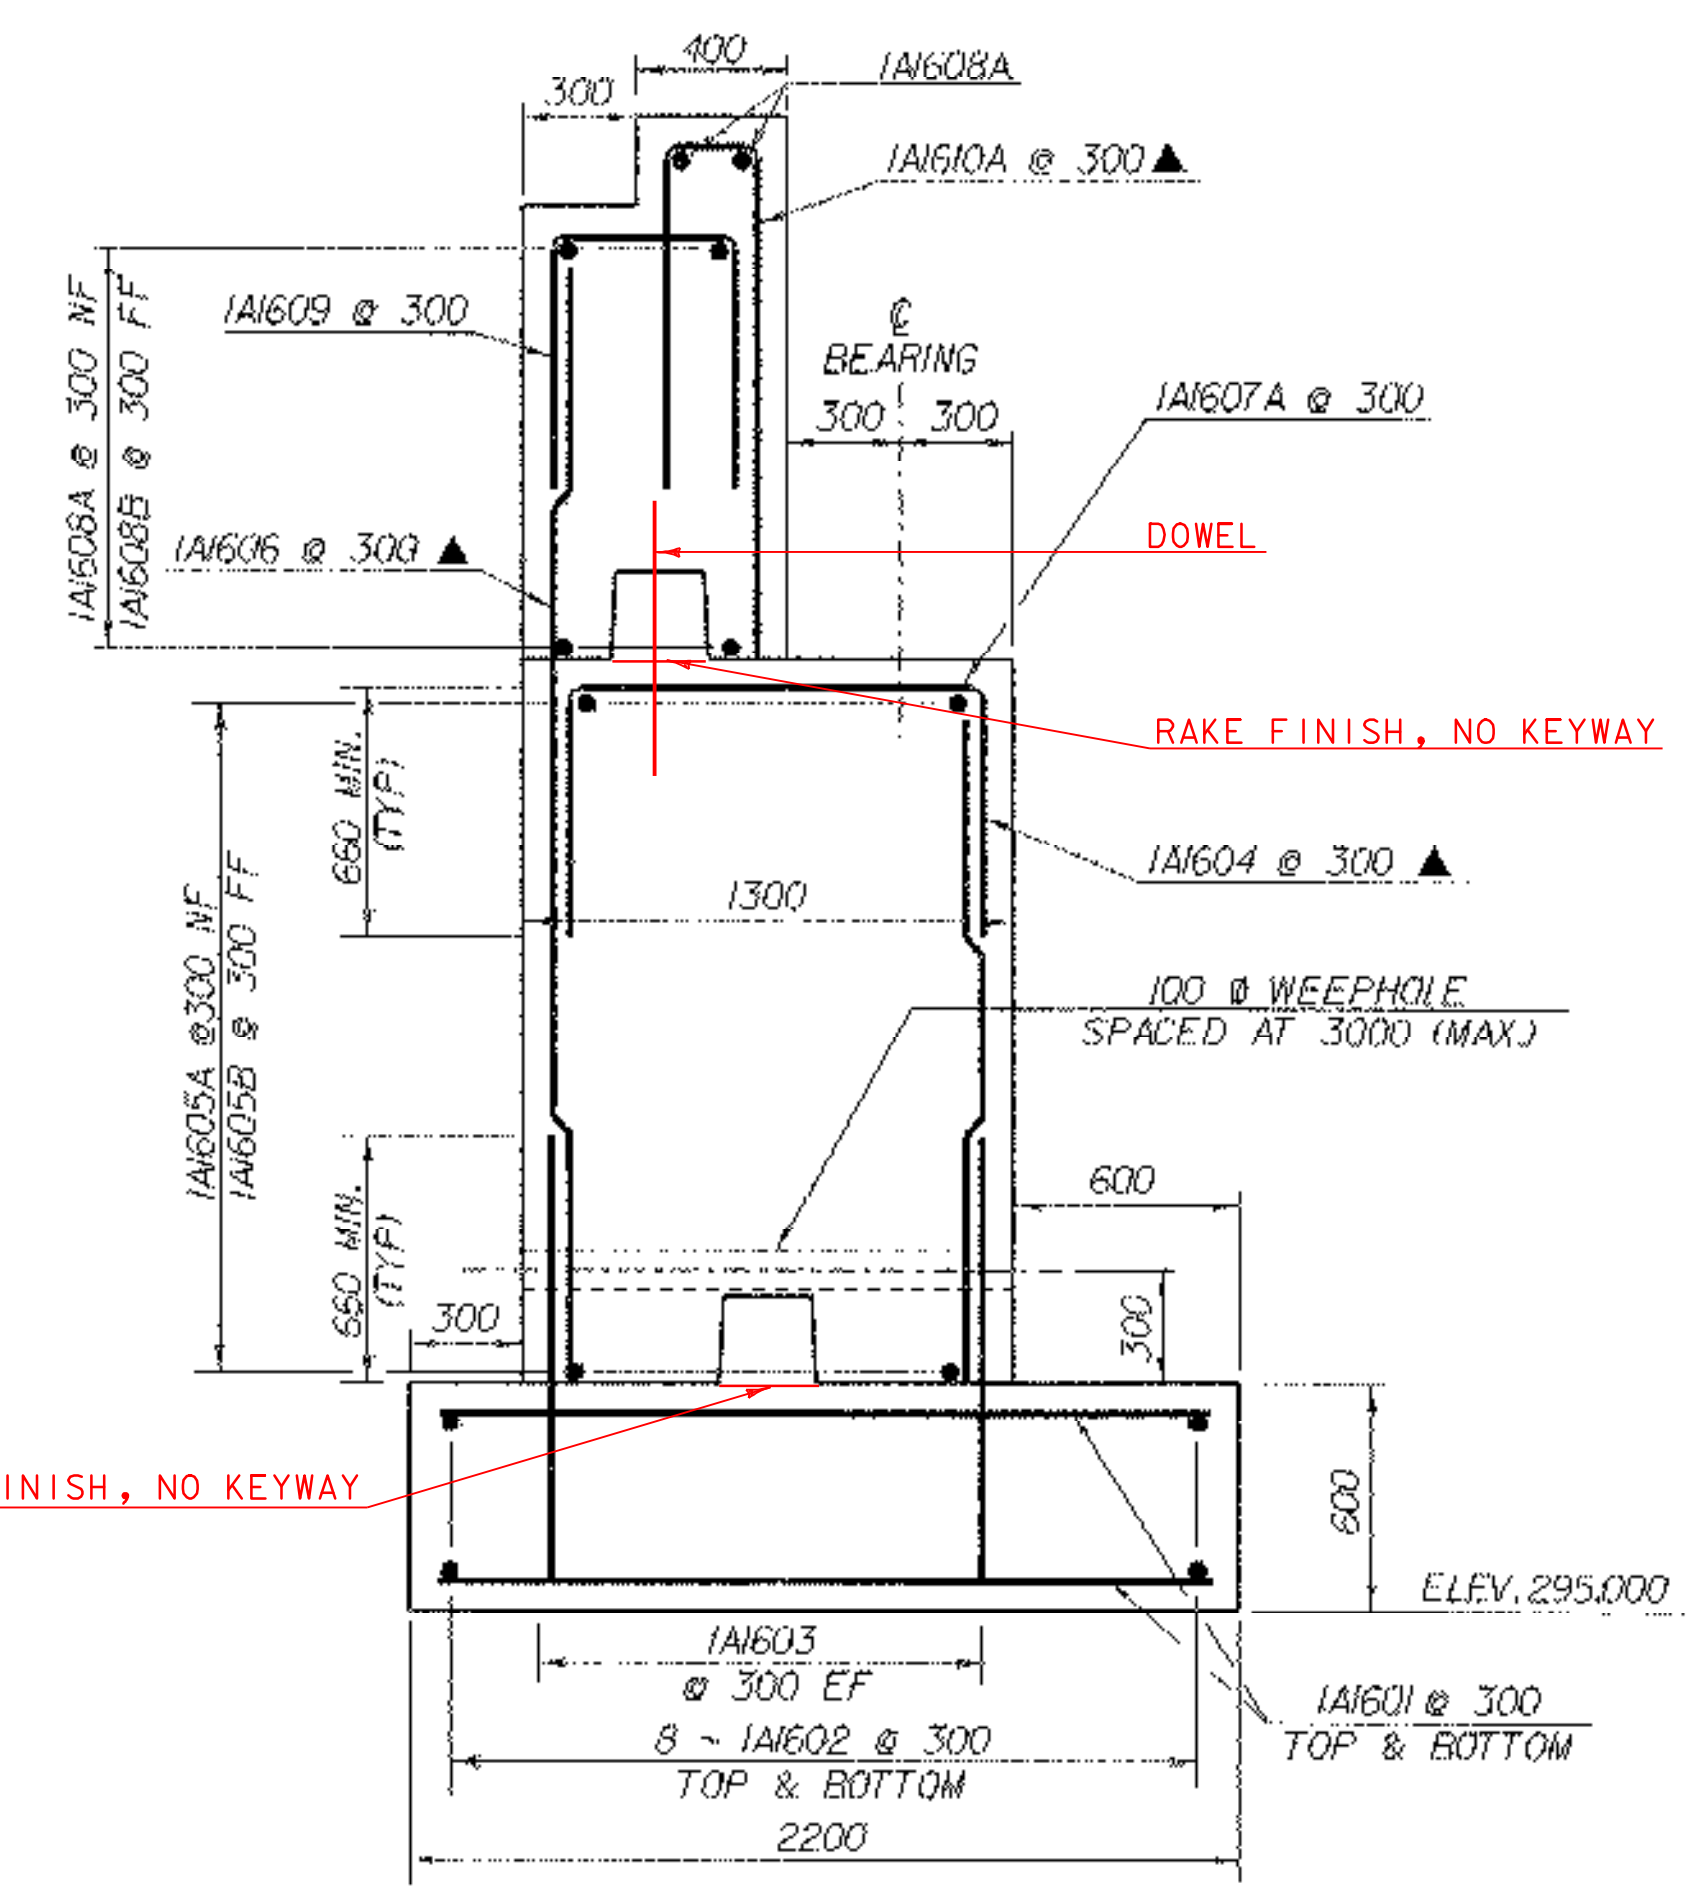
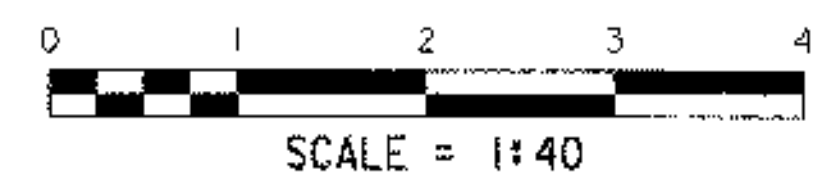



ABUTMENT NO.1 PLAN

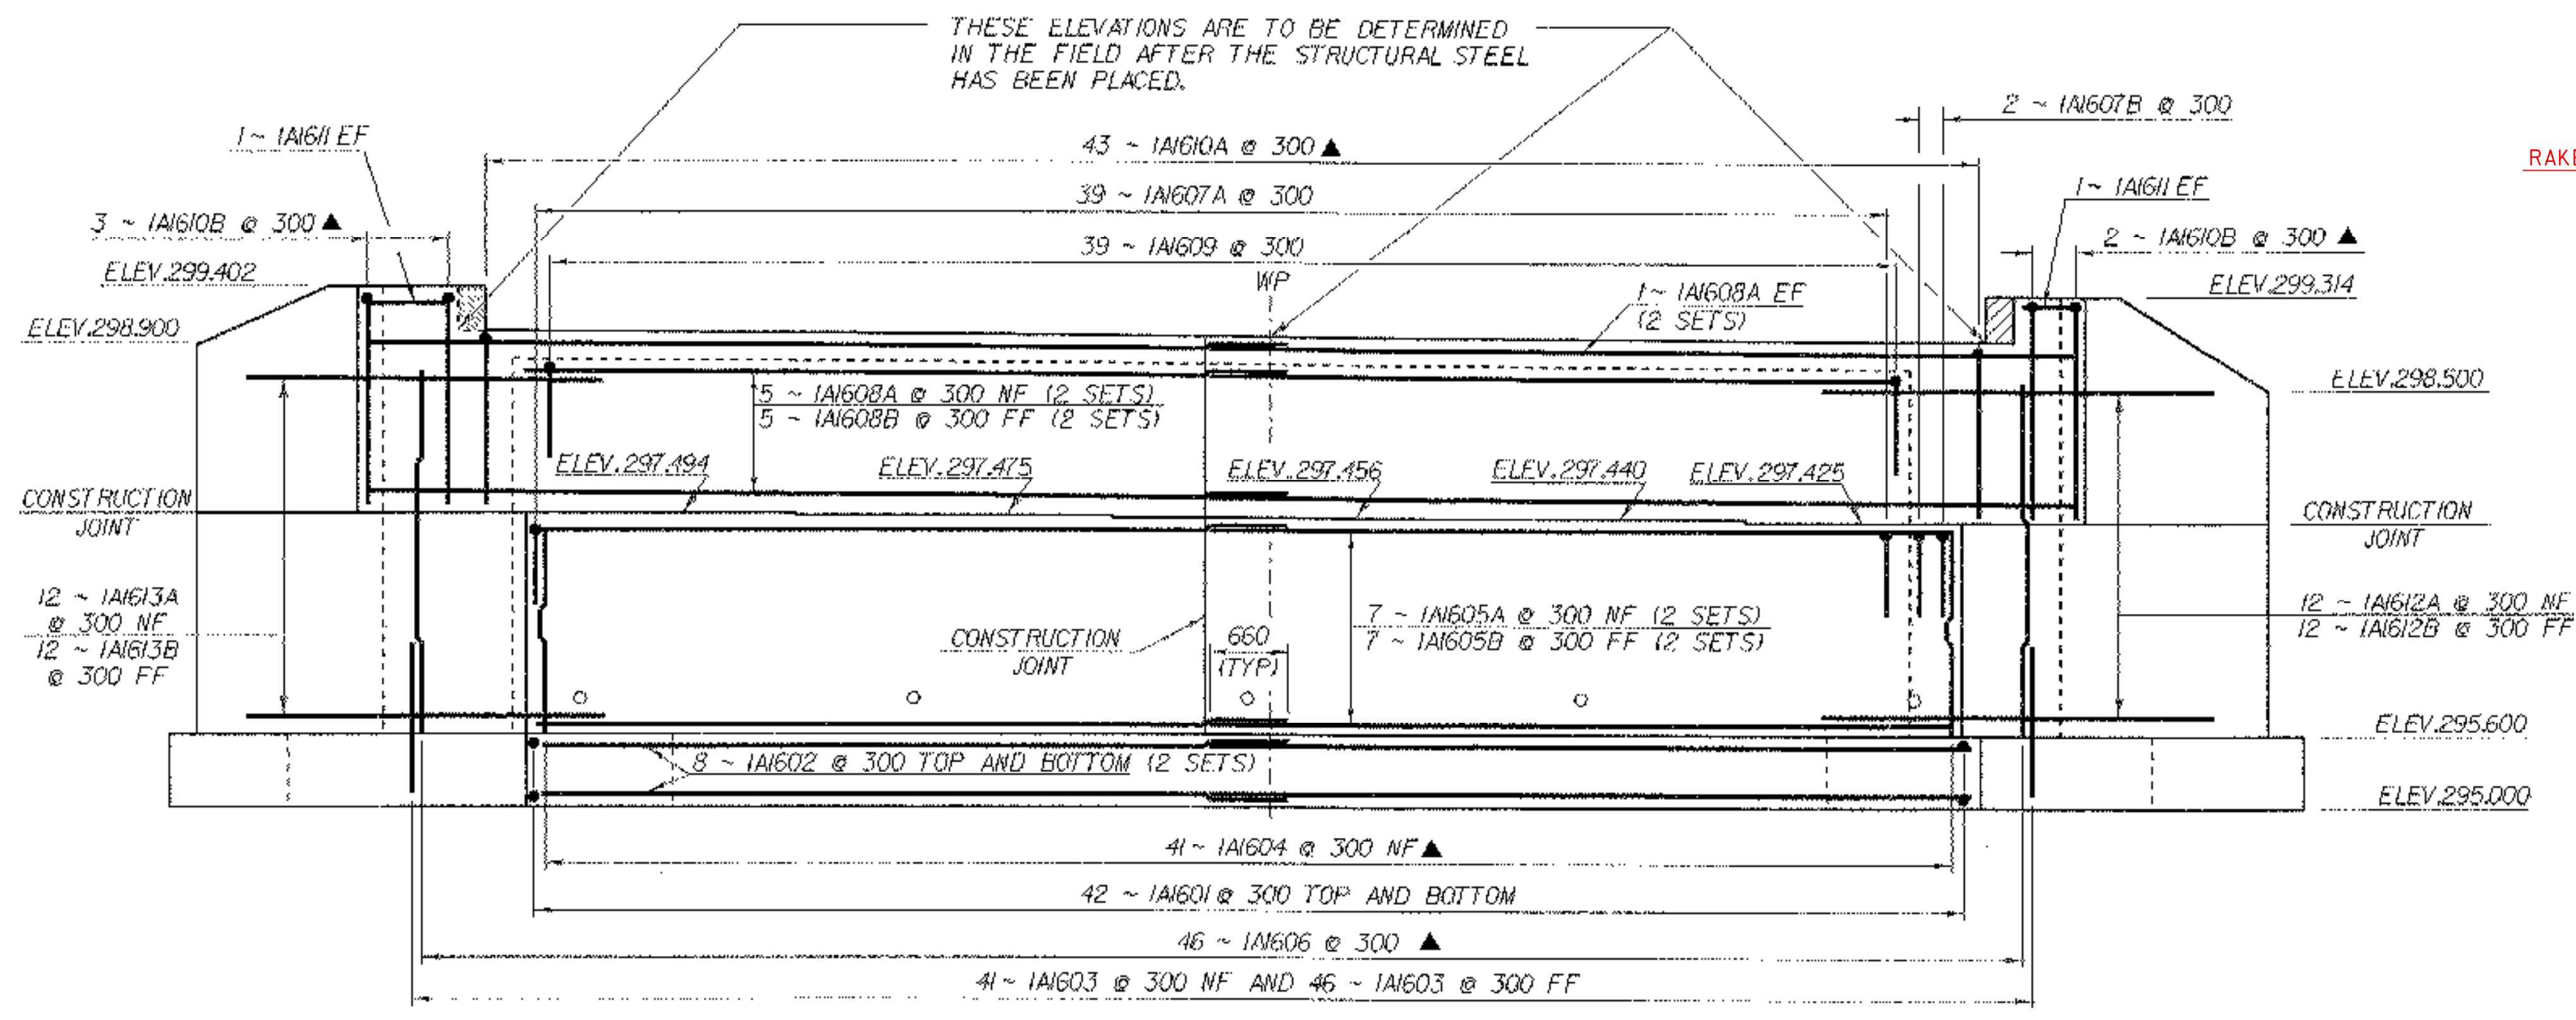

ABUTMENT NO.1 TYPICAL SECTION

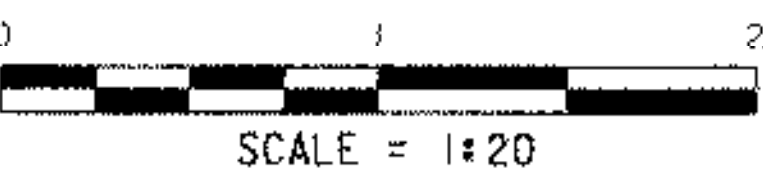

ABUTMENT NO.1 ELEVATION

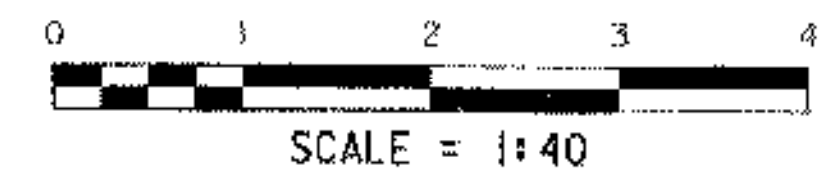

NOTE:

- NF - NEAR FACE
- FF - FAR FACE
- EF - EACH FACE
- ▲ - CUT TO FIT IN FIELD
- 75 CLR. UNLESS OTHERWISE SPECIFIED ON THE PLANS.

ABUTMENT NO.1 PLAN AND ELEVATION

PROJECT NAME:	MENDON	PLOT DATE:	18-NOV-2005
PROJECT NUMBER:	BRO 1443 (35)	DRAWN BY:	K. RUTTER
FILE NAME:	/s/j290/sj290sub.dgn	CHECKED BY:	T. SUMNER
PROJECT LEADER:	C. KELLER	SHEET	52 OF 94
DESIGNED BY:	M. EVANS-MONGEON		