

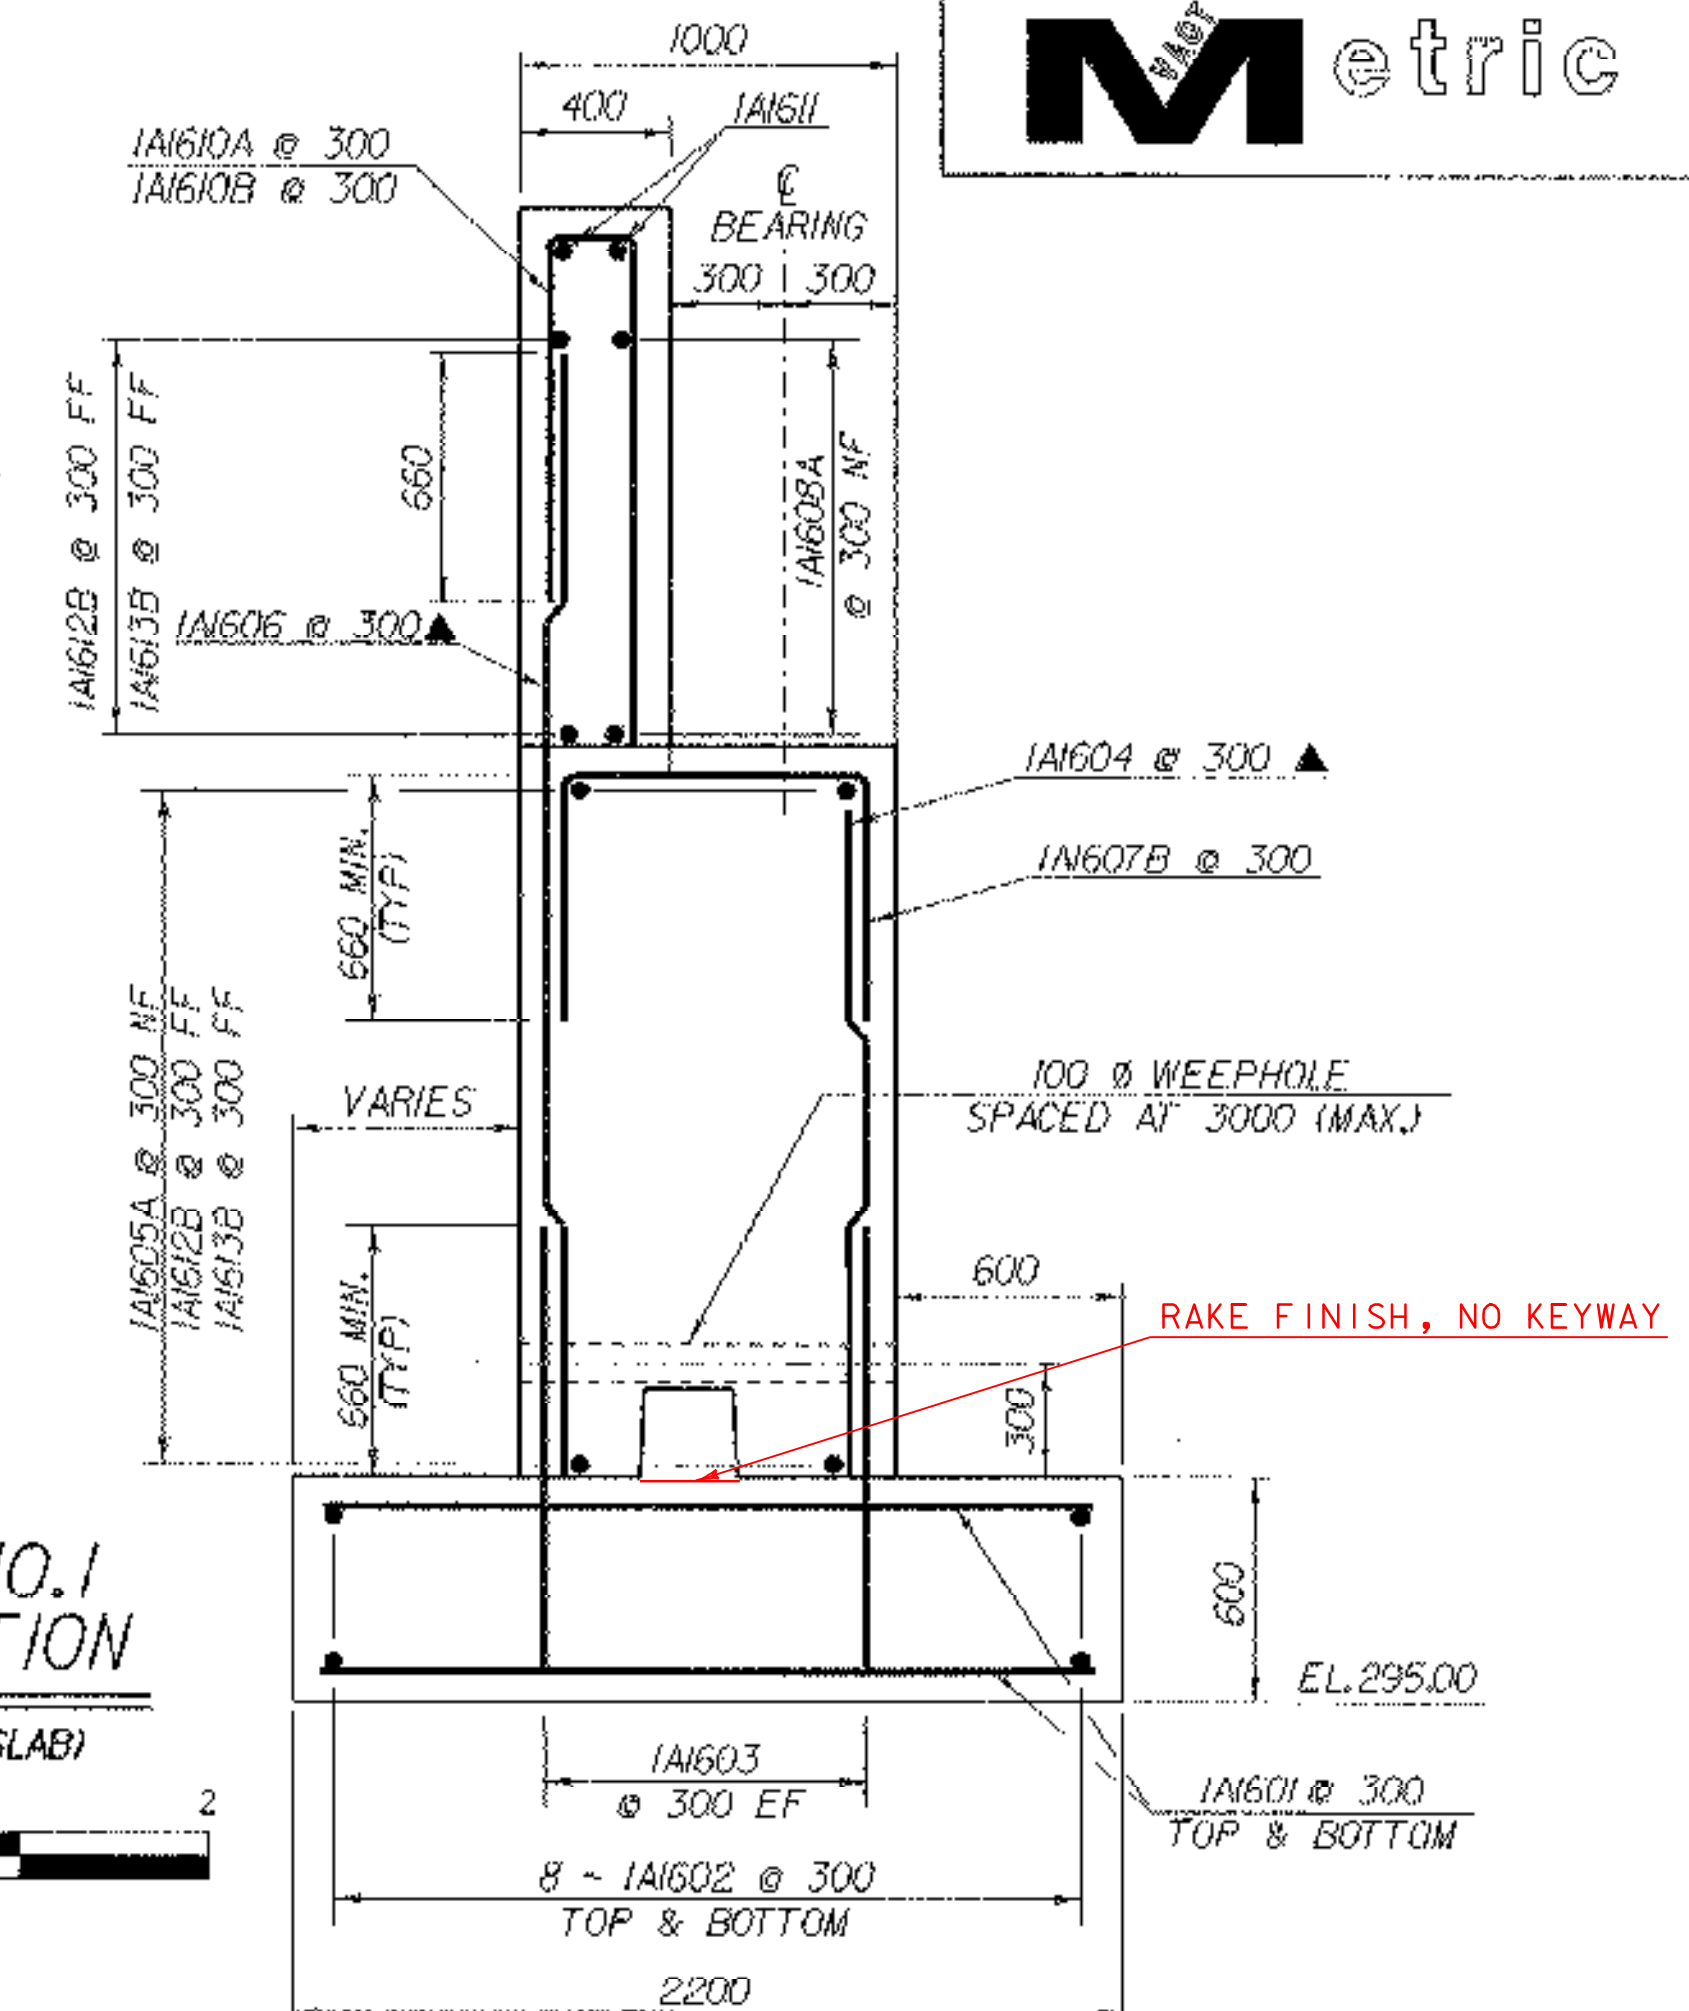
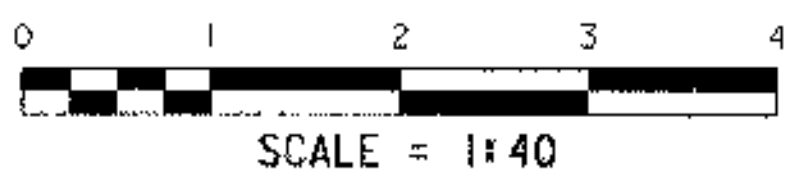




**ABUTMENT NO.1 FOOTING REINFORCING PLAN**

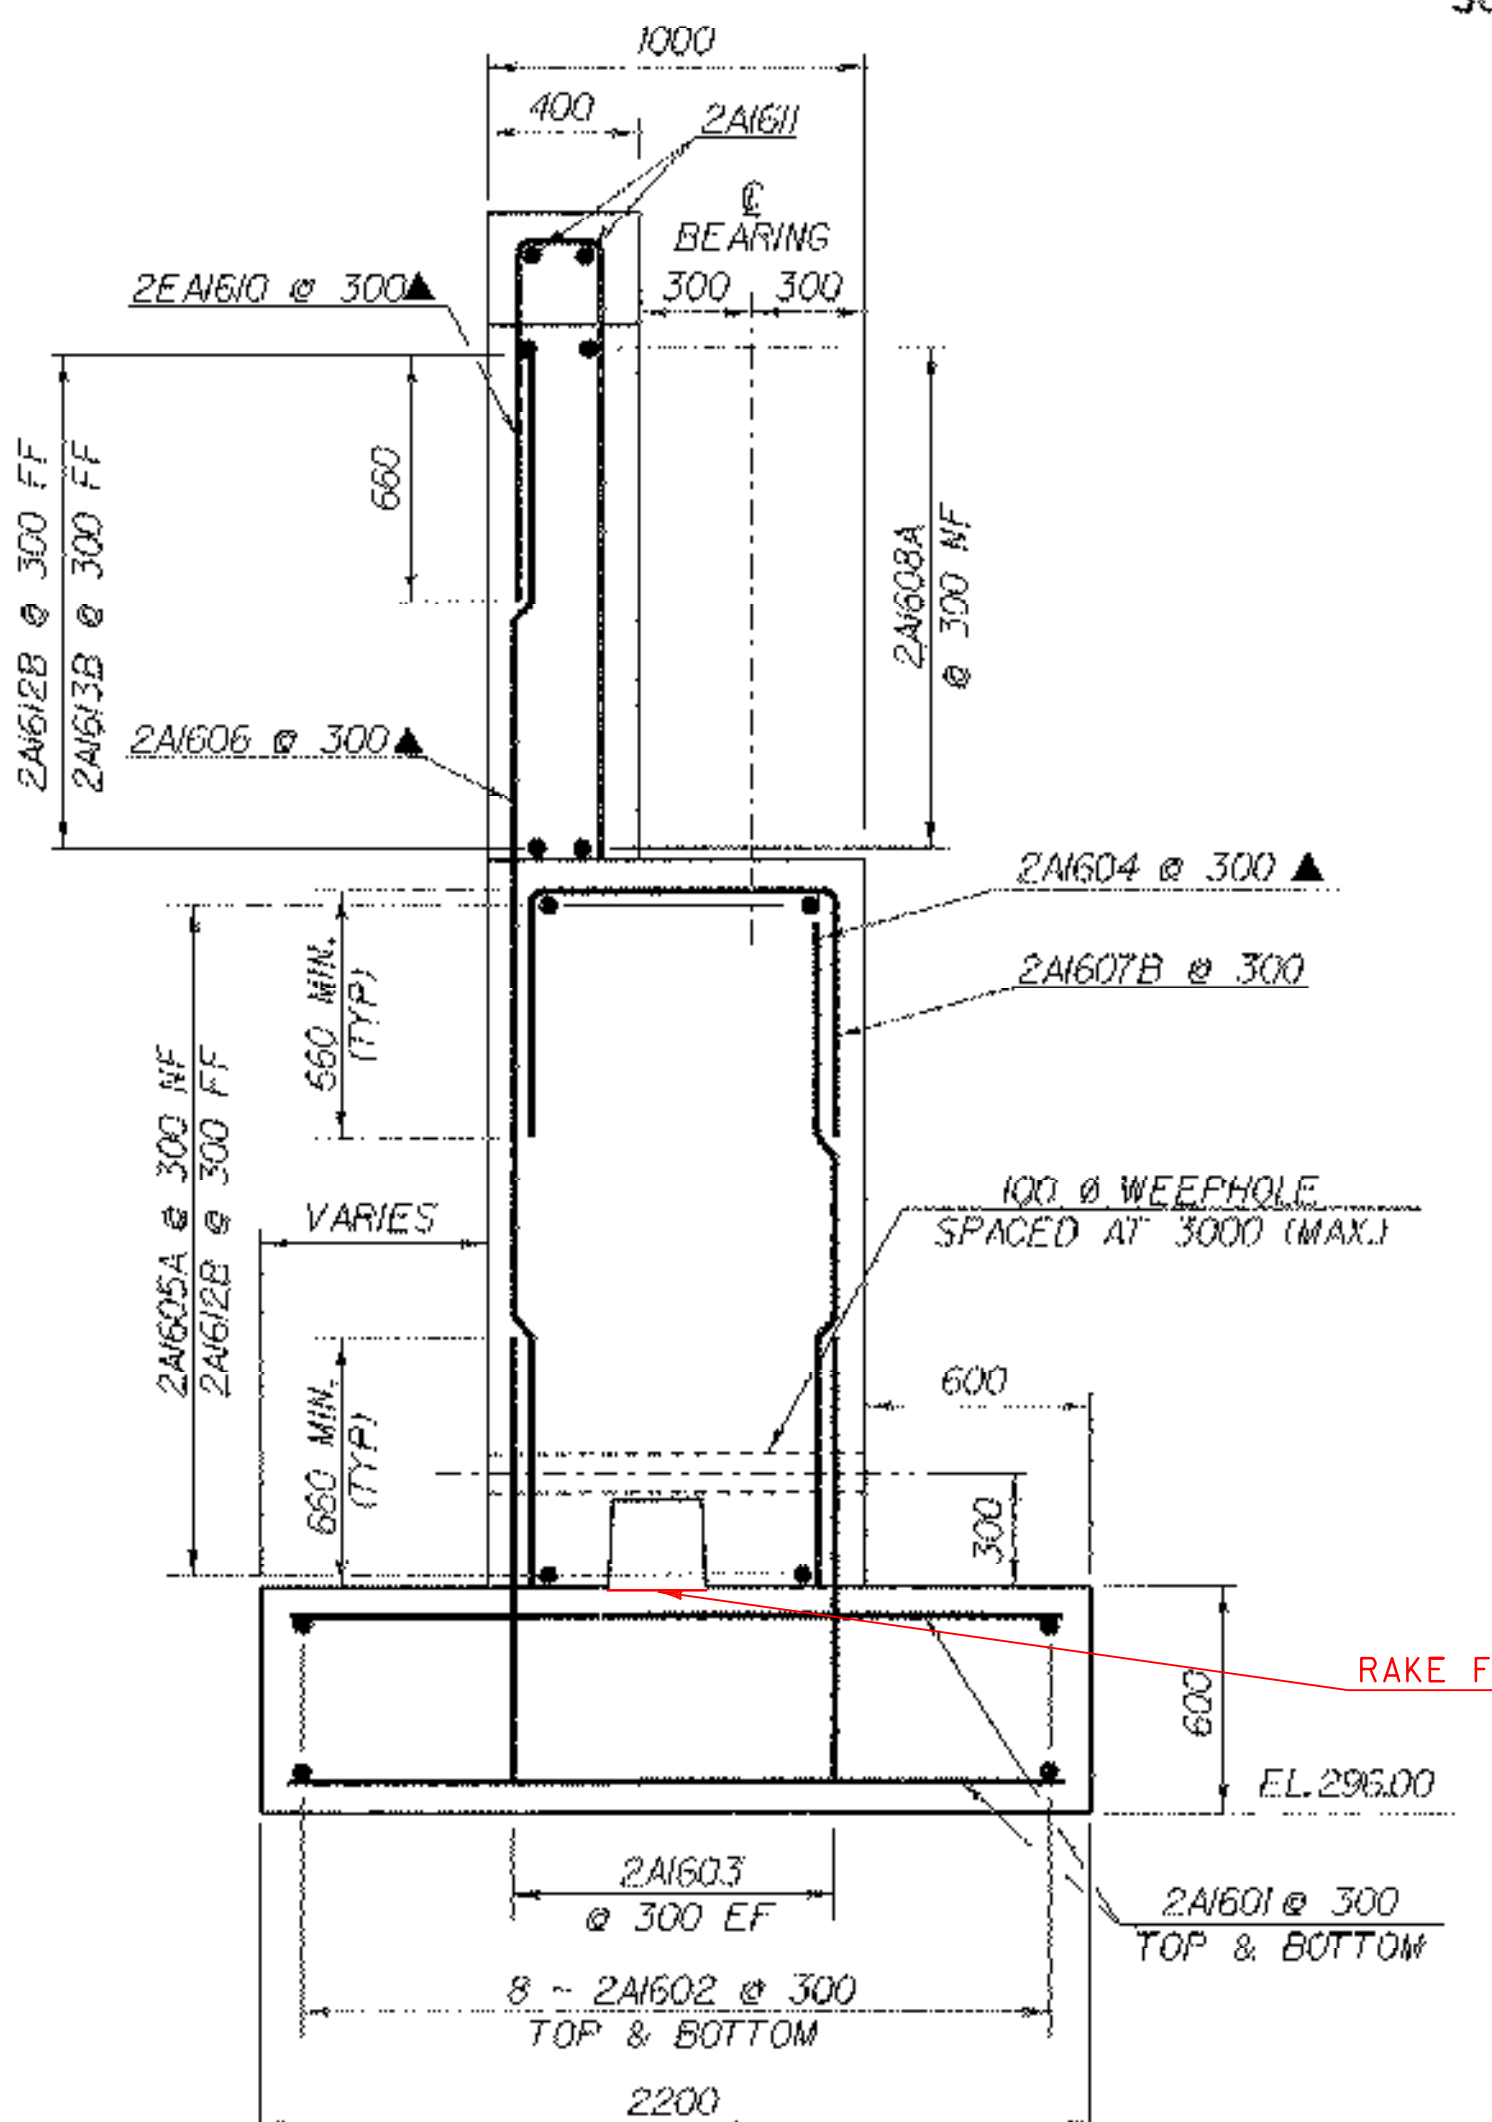


**ABUTMENT NO.1 TYPICAL SECTION (OUTSIDE APPROACH SLAB)**

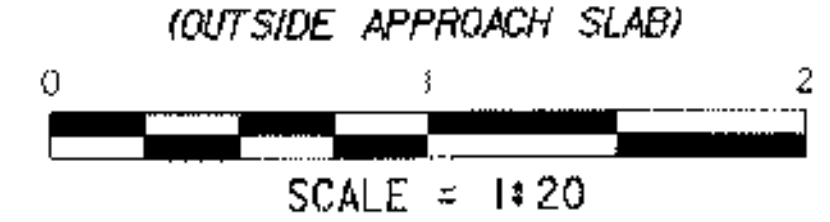

**ABUTMENT NO.2 TYPICAL SECTION (OUTSIDE APPROACH SLAB)**

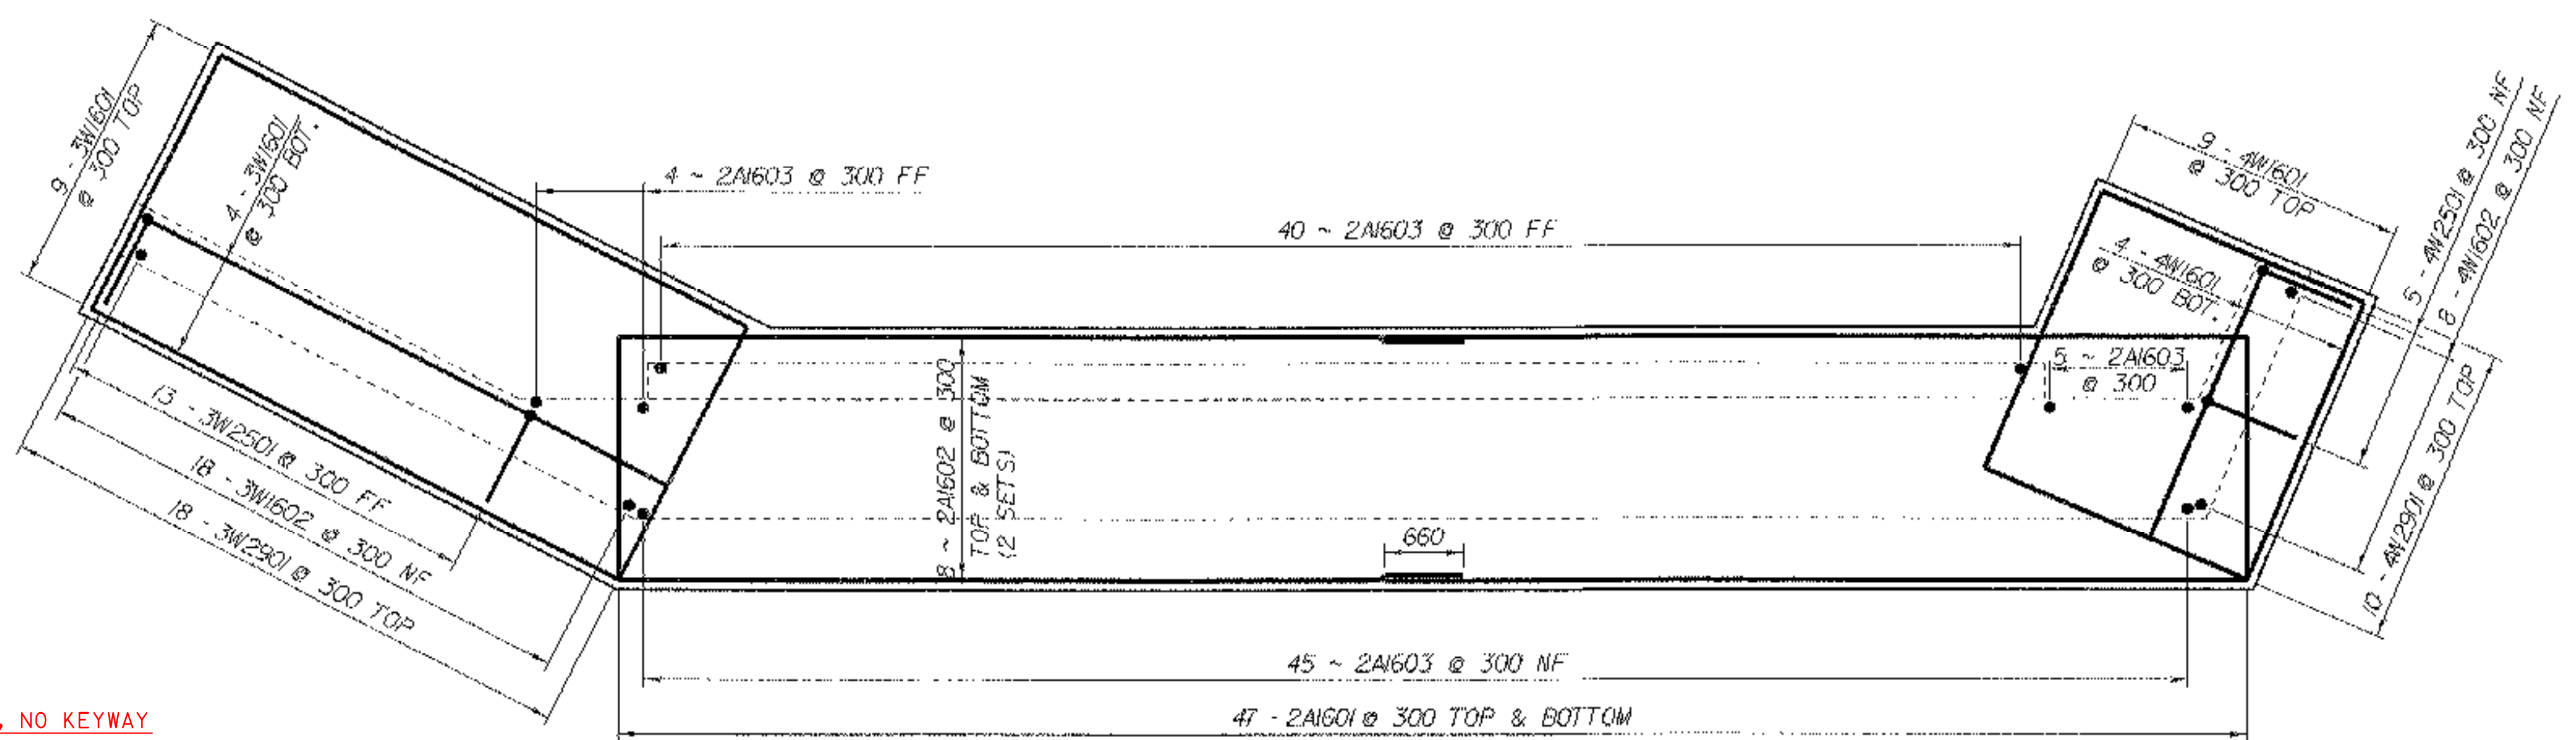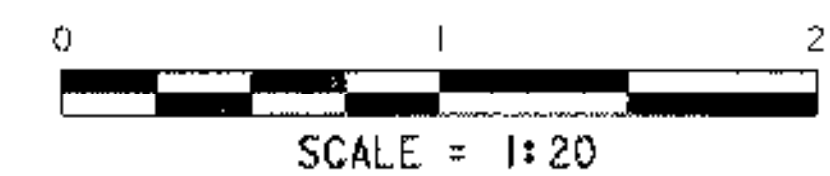

**ABUTMENT NO.2 FOOTING REINFORCING PLAN**

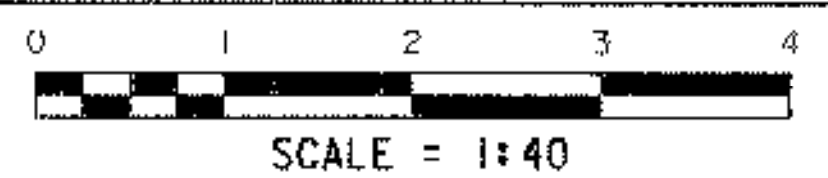

**NOTE:**

- NF = NEAR FACE
- FF = FAR FACE
- EF = EACH FACE
- ▲ = CUT TO FIT IN FIELD
- 75 CLR. UNLESS OTHERWISE SPECIFIED ON THE PLANS.

**ABUTMENT NO. 1 AND ABUTMENT NO. 2 REINFORCING**

PROJECT NAME:	MENDON	PLOT DATE:	18-NOV-2005
PROJECT NUMBER:	BRO 1443 (35)	DRAWN BY:	K. RUTTER
FILE NAME:	/s/r5/95j290/sj290sub.dgn	CHECKED BY:	T. SUMNER
PROJECT LEADER:	C. KELLER	SHEET	54 OF 94
DESIGNED BY:	M. EVANS-MONGEON		