

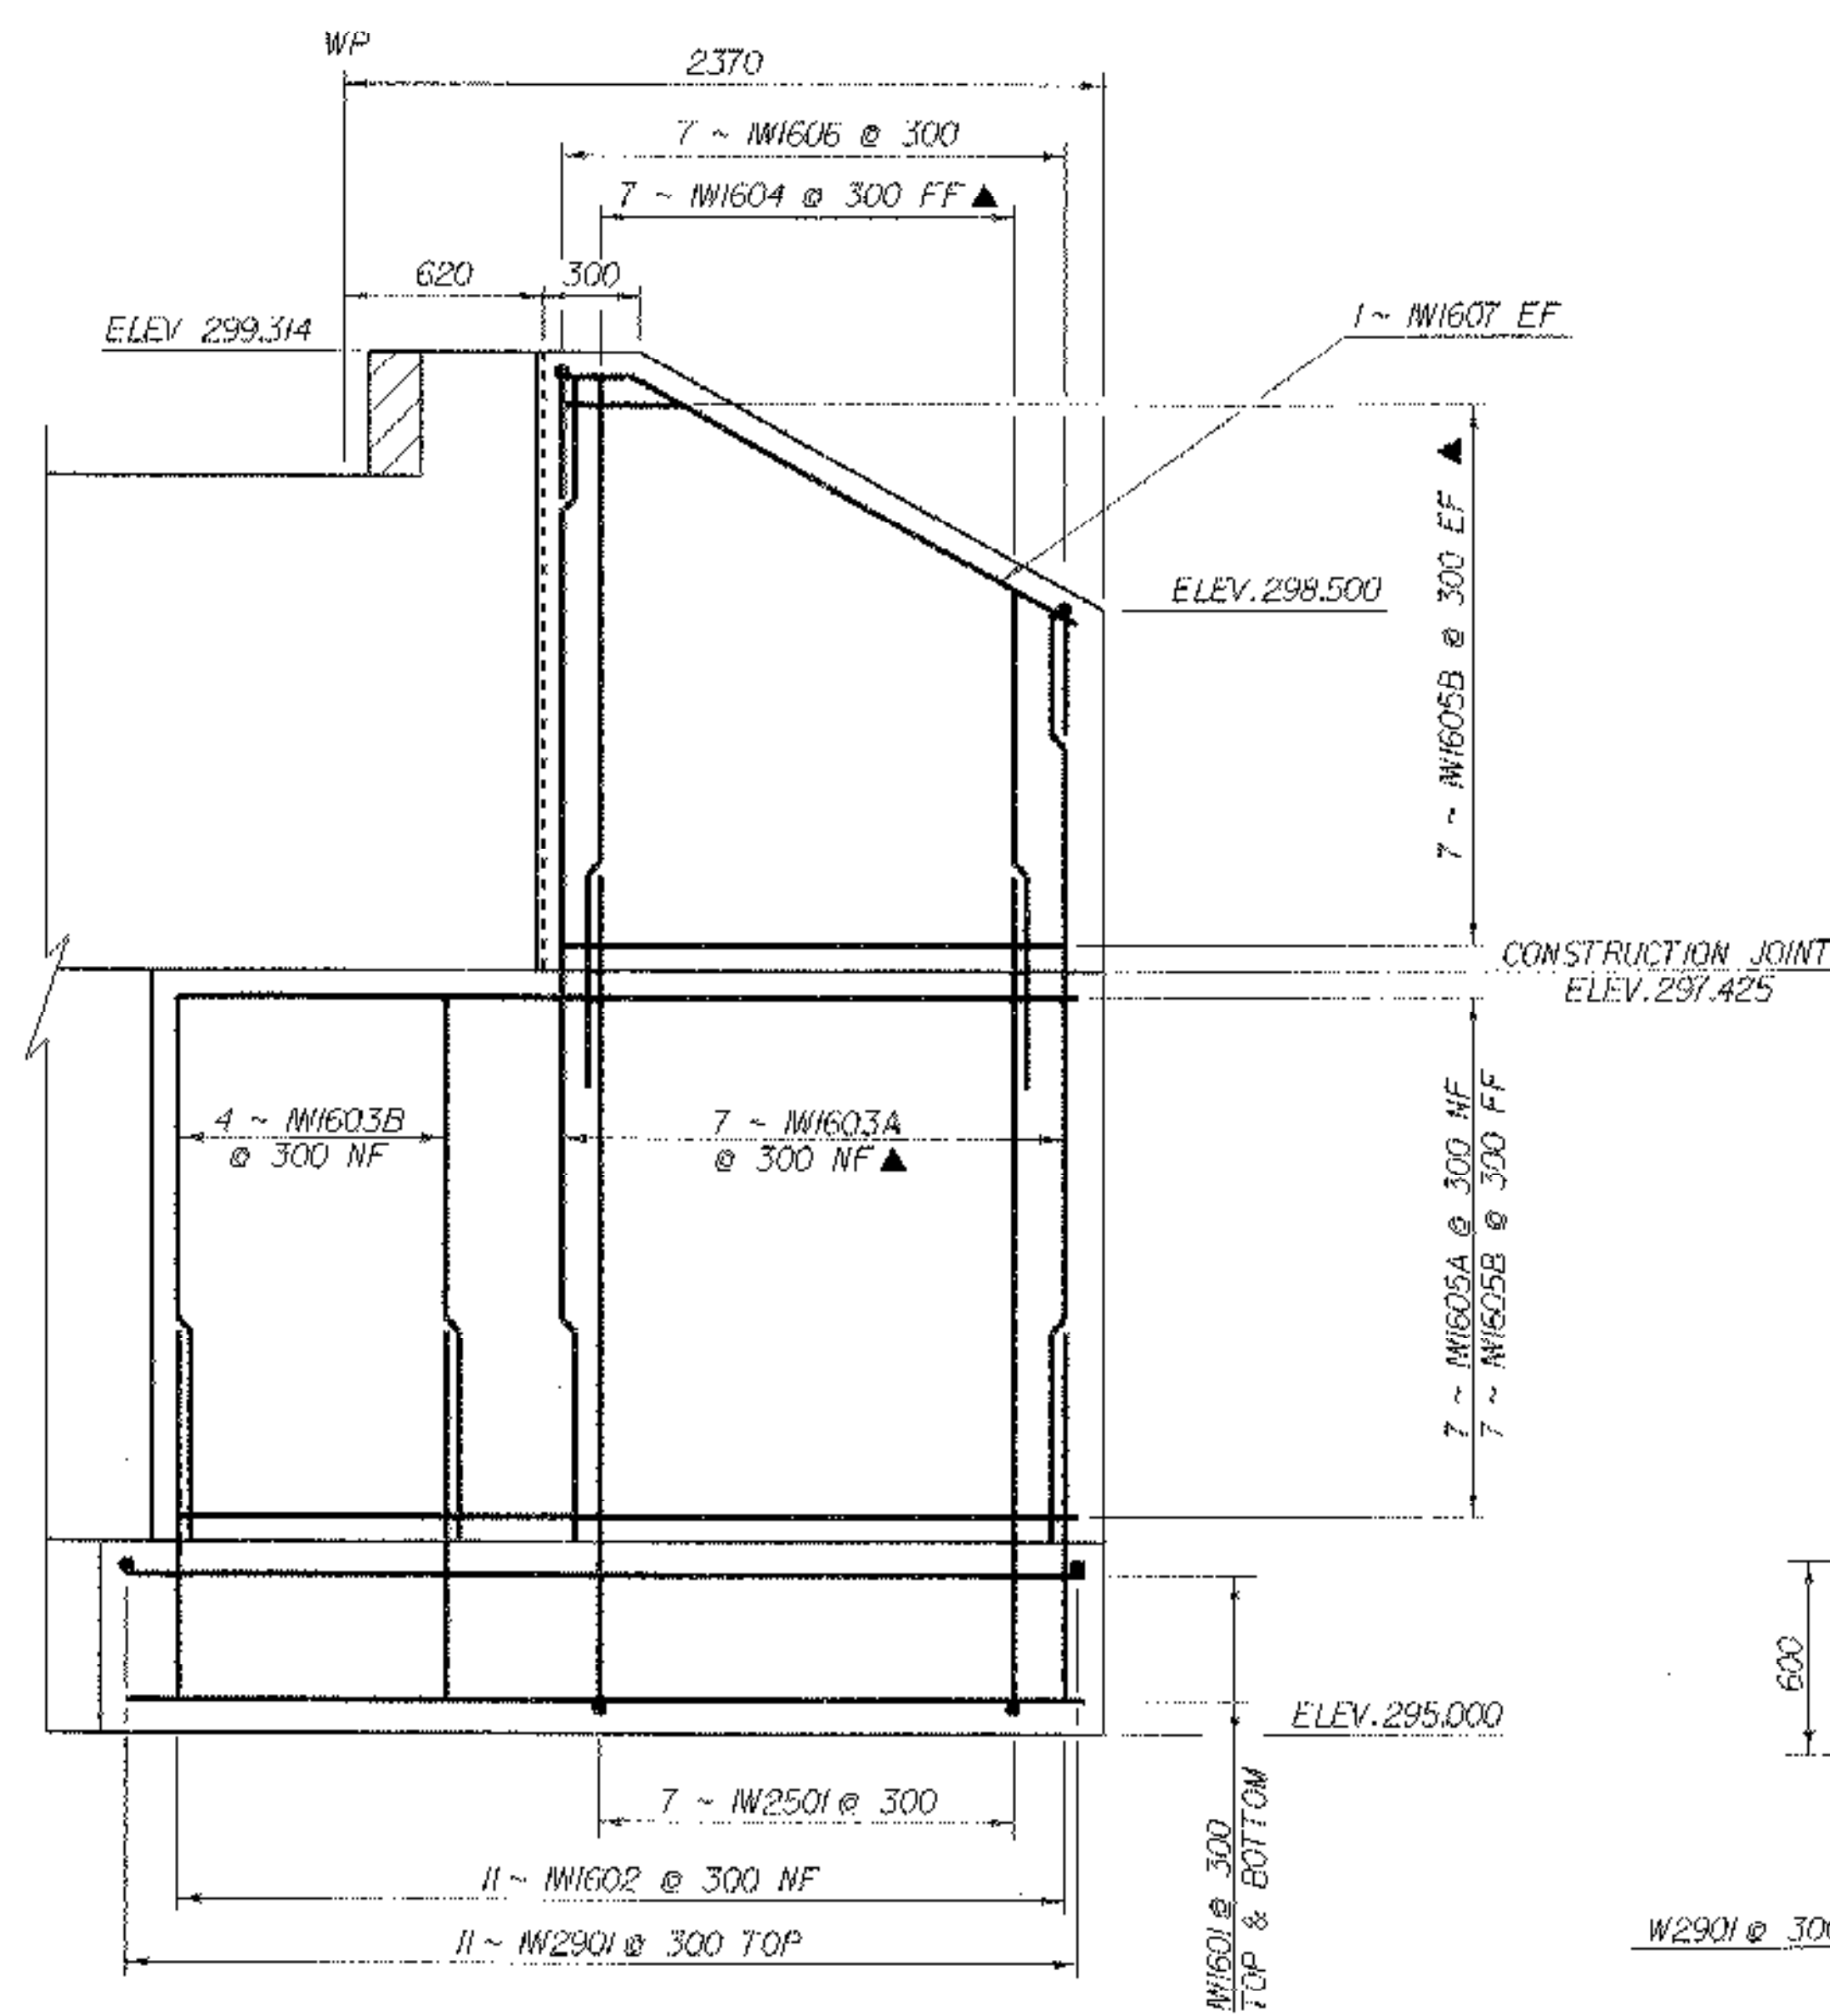
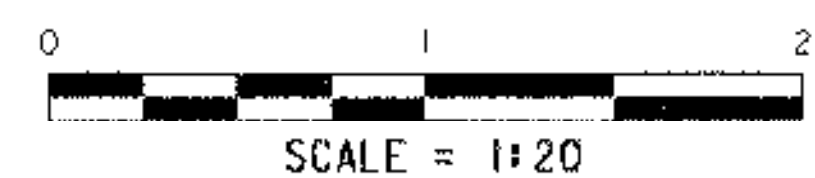




WINGWALL NO.2 ELEVATION

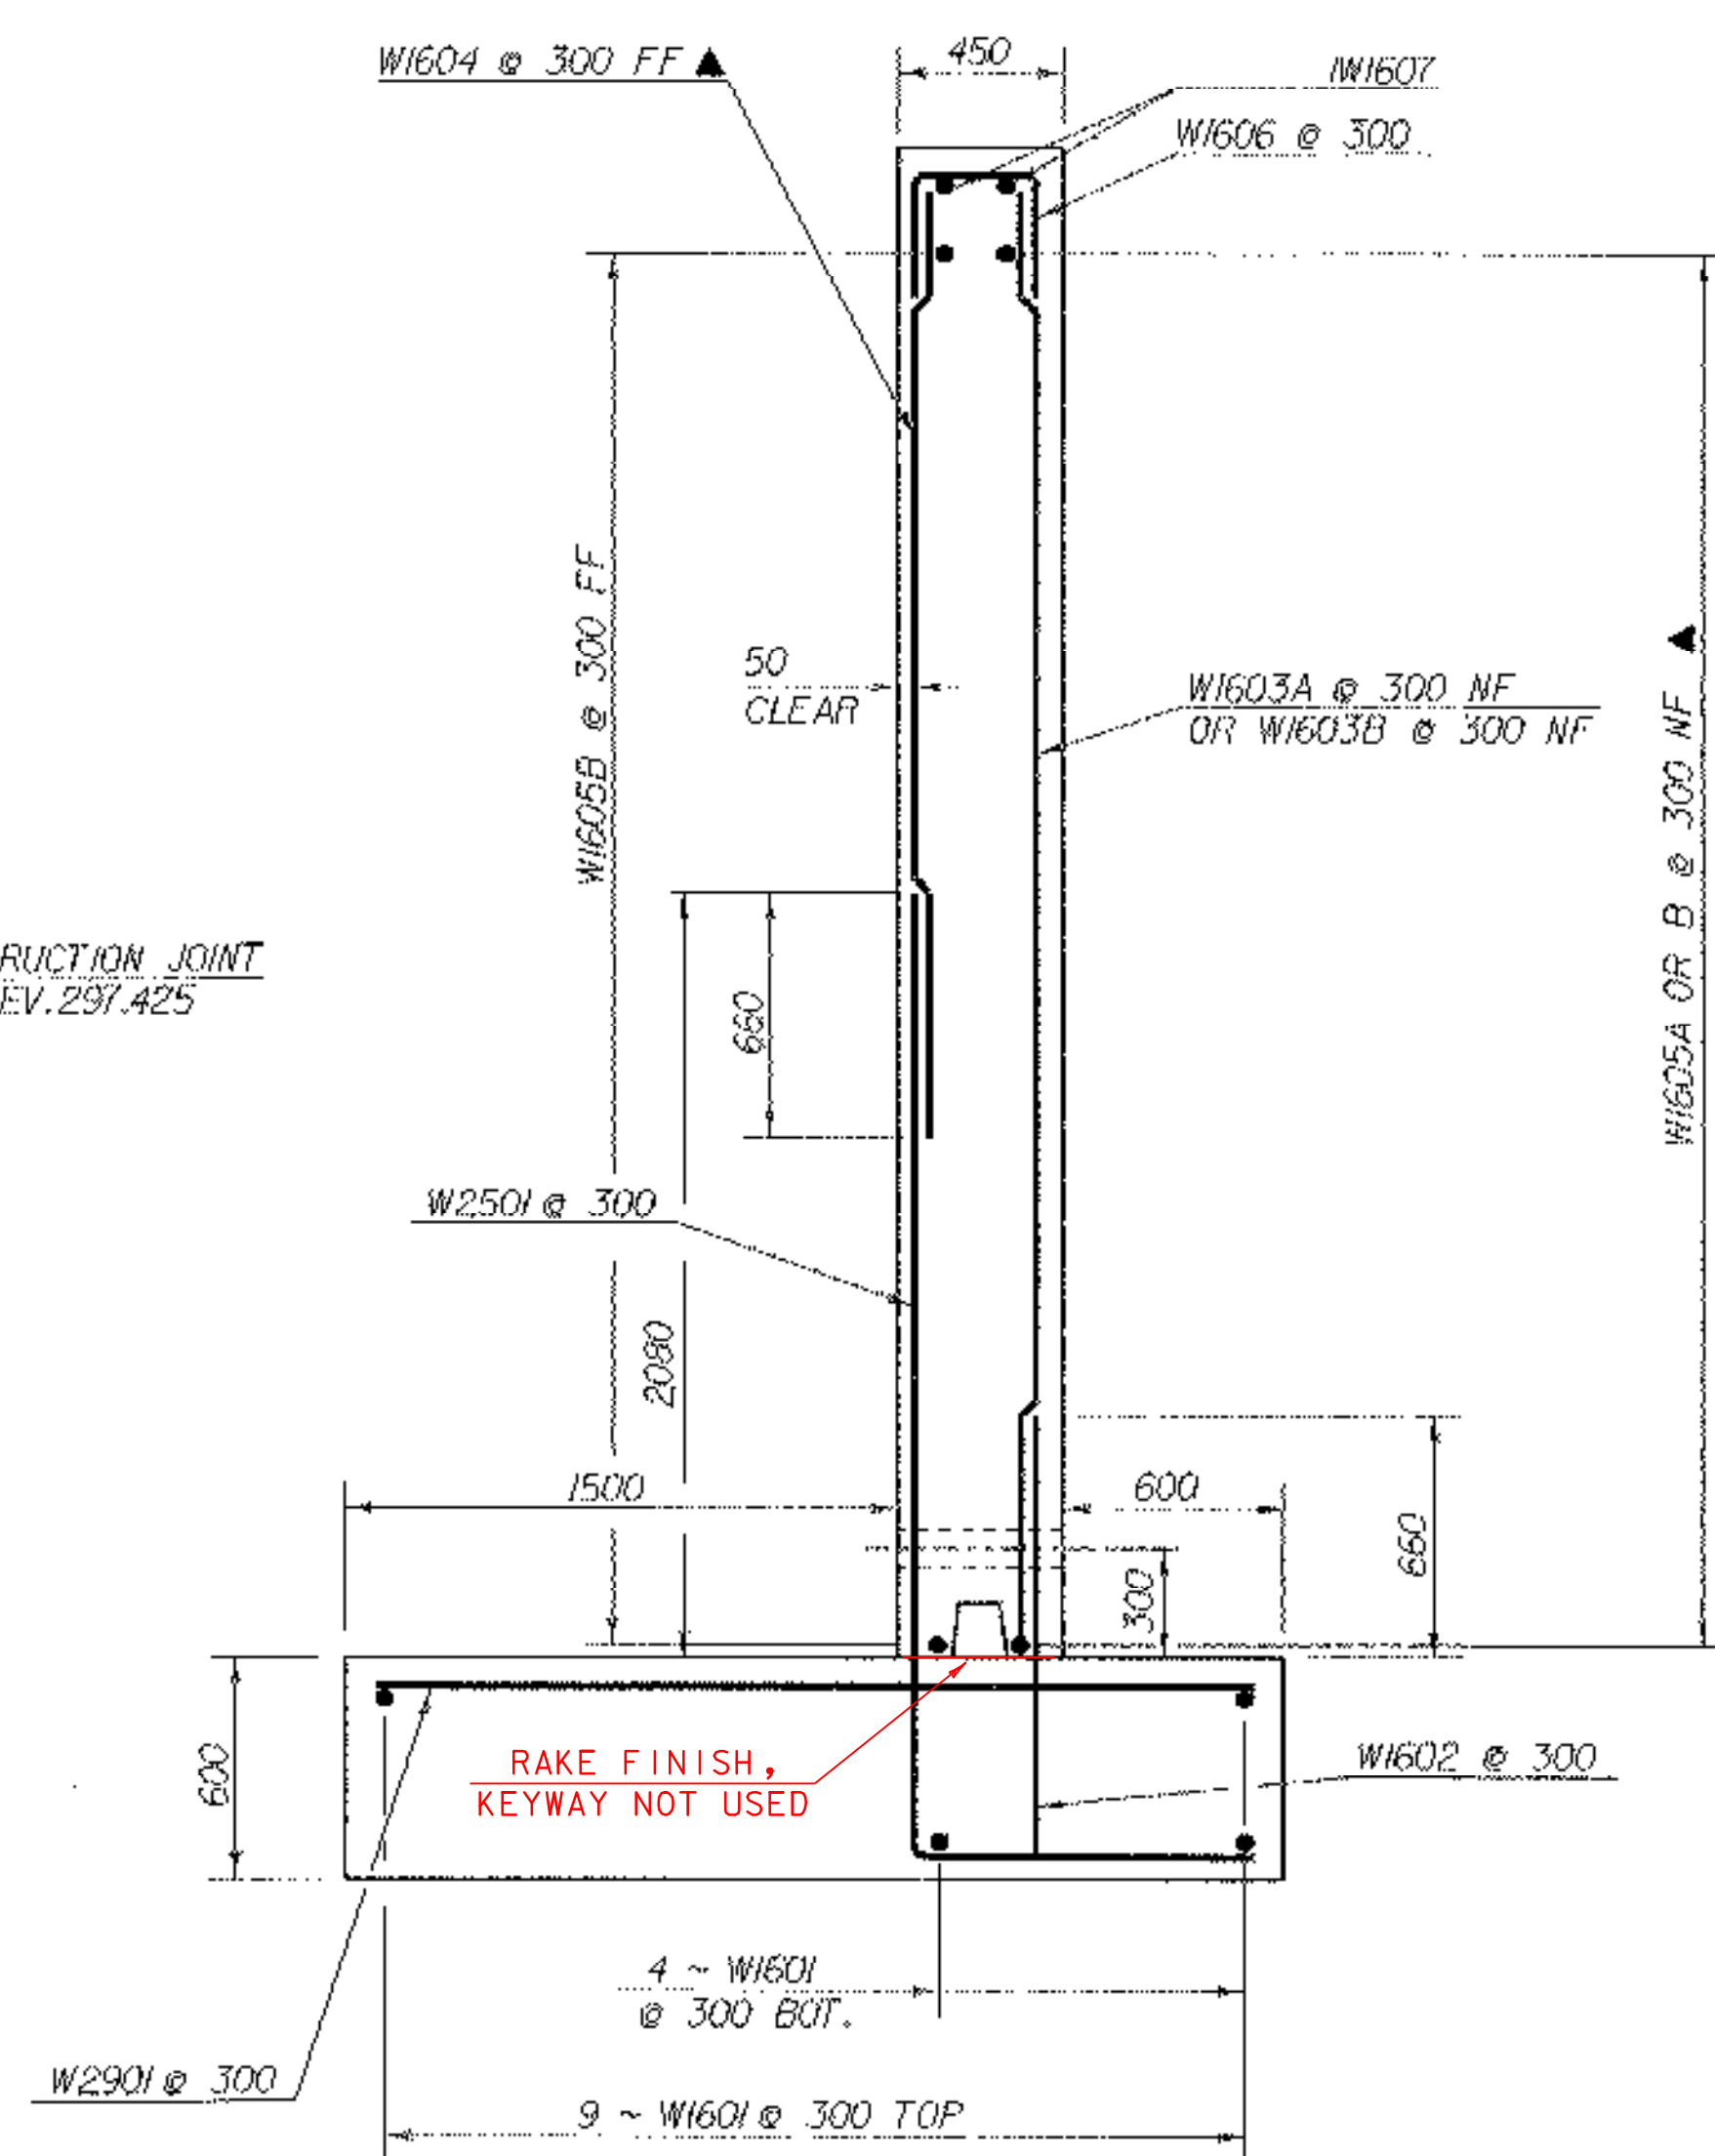


WINGWALL NO.1 ELEVATION

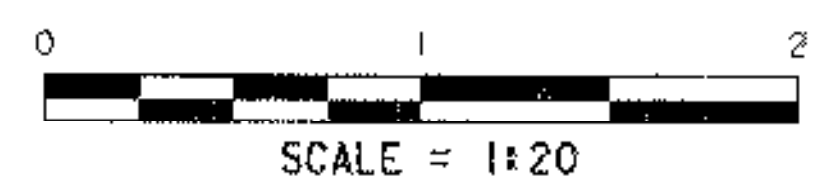

WINGWALL TYPICAL SECTION

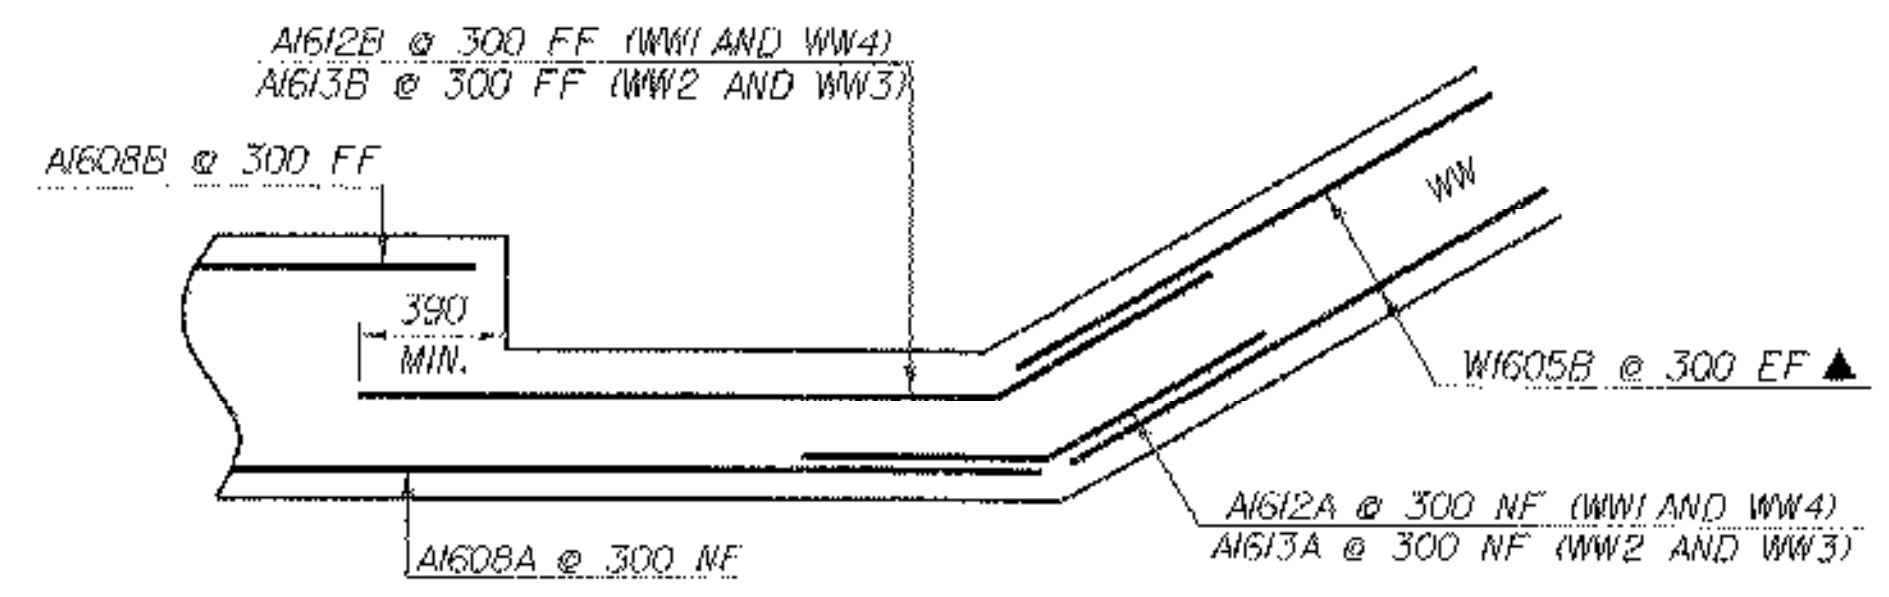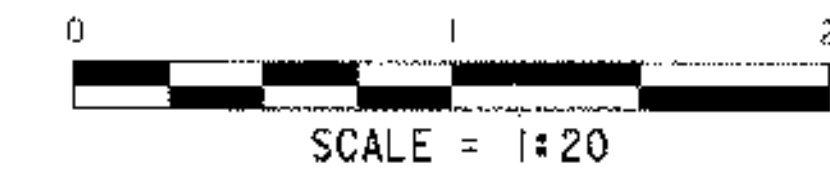

ABOVE BRIDGE SEAT CORNER DETAIL

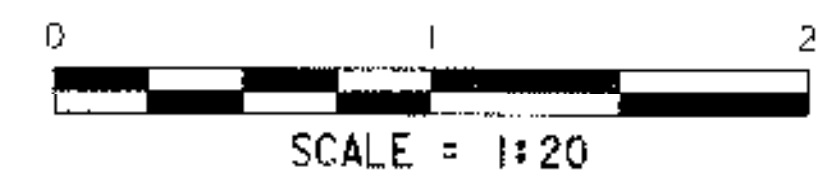

NOTE:
 NF = NEAR FACE
 FF = FAR FACE
 EF = EACH FACE
 ▲ = CUT TO FIT IN FIELD
 75 CLR. UNLESS OTHERWISE SPECIFIED ON THE PLANS.

WINGWALL NO. 1 AND NO. 2 DETAILS

PROJECT NAME:	MENDON	PLOT DATE:	18-NOV-2005
PROJECT NUMBER:	BRO 1443 (35)	DRAWN BY:	K. RUTTER
FILE NAME:	/str5/95j290/sj290sub.dgn	CHECKED BY:	T. SUMNER
PROJECT LEADER:	C. KELLER	SHEET	55 OF 94
DESIGNED BY:	M. EVANS-MONGEON		
	sj290ww.1		