


Mainline 2+000

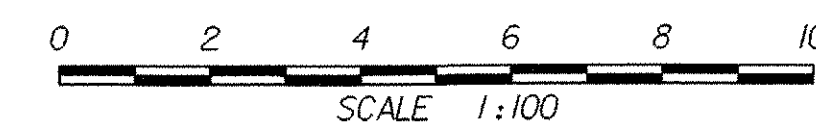

PROJECT: MENDON	PROJECT NO.: BRO 1443(35)
DESIGN FILE NAME: /str5/95j290/sj290bdr.dgn	PLOT DATE: 18-NOV-2005
IPARM FILE NAME: sj290M02.i	
MAINLINE CROSS SECTIONS	SHEET: 66 OF 94