


Mainline 2+050 - Mainline 2+060

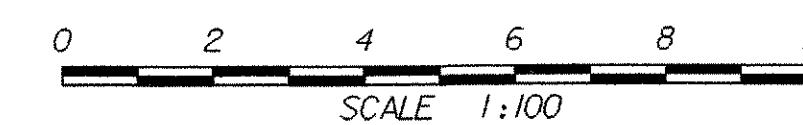

| | |
|---|------------------------------|
| PROJECT: MENDON | PROJECT NO.: BRO 1443(35) |
| DESIGN FILE NAME: /s+r5/95j290/sj290bdr.dgn | PLOT DATE: 18-NOV-2005 |
| IPARM FILE NAME: SJ290M05.i | |
| MAINLINE CROSS SECTIONS | |
| SHEET: 69 OF 94 | |