


Mainline 2+158.1 - Mainline 2+160

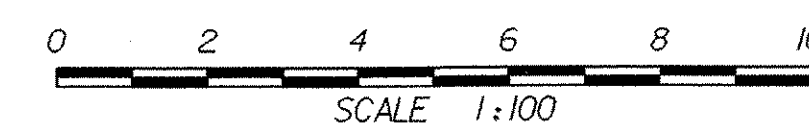

PROJECT: MENDON	PROJECT NO.: BRO 1443(35)
DESIGN FILE NAME: /s+r-5/95j290/sj290bdr.dgn	PLOT DATE: 18-NOV-2005
IPARM FILE NAME: SJ290MI2.1	
MAINLINE CROSS SECTIONS	
SHEET: 76 OF 94	