


Mainline 2+190 - Mainline 2+200

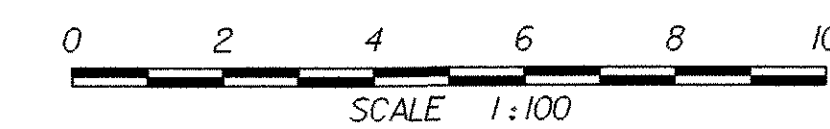

PROJECT: MENDON	PROJECT NO.: BRO 1443(35)
DESIGN FILE NAME: /str5/95j290/sj290bdr.dgn	PLOT DATE: 18-NOV-2005
IPARM FILE NAME: SJ290MI4.1	
MAINLINE CROSS SECTIONS	
SHEET: 78 OF 94	