


Mainline 2+210

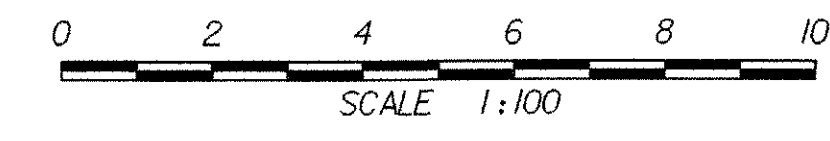

PROJECT: MENDON	PROJECT NO.: BRO 1443(35)
DESIGN FILE NAME: /s+r5/95j290/sj290bdr.dgn	PLOT DATE: 18-NOV-2005
IPARM FILE NAME: SJ290MI5.I	
MAINLINE CROSS SECTIONS	SHEET: 79 OF 94