


2+215  
END PROJECT  
BEGIN APPROACH

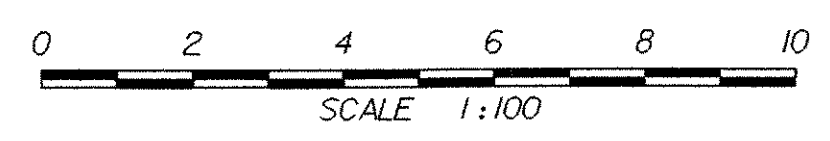

PROJECT: MENDON	PROJECT NO.: BRO 1443(35)
DESIGN FILE NAME: /str5/95j290/sj290bdr.dgn	PLOT DATE: 18-NOV-2005
IPARM FILE NAME: SJ290MI6.1	
MAINLINE CROSS SECTIONS	
SHEET: 80 OF 94	

Mainline 2+220