


Mainline 2+250

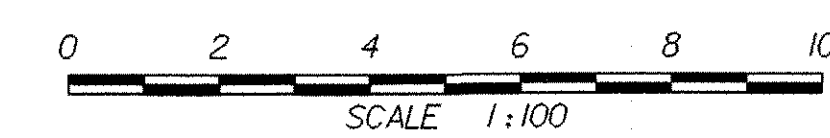

PROJECT: MENDON	PROJECT NO.: BRO 1443(35)
DESIGN FILE NAME: /str5/95j290/sj290bdr.dgn	PLOT DATE: 18-NOV-2005
IPARM FILE NAME: SJ290MI9.I	
MAINLINE CROSS SECTIONS	SHEET: 83 OF 94