


Mainline 2+270

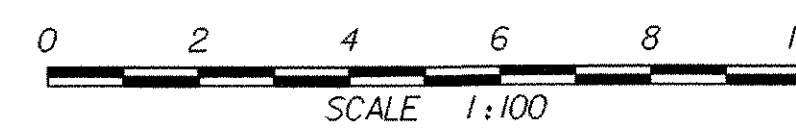

PROJECT: MENDON	PROJECT NO.: BRO 1443(35)
DESIGN FILE NAME: /str5/95j290/sj290bdr.dgn	PLOT DATE: 18-NOV-2005
IPARM FILE NAME: SJ290M2L1	
MAINLINE CROSS SECTIONS	SHEET: 85 OF 94