


Mainline 2+280

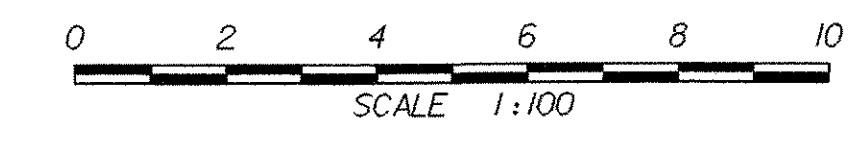

| | |
|---|------------------------------|
| PROJECT: MENDON | PROJECT NO.: BRO 1443(35) |
| DESIGN FILE NAME: /str5/95j290/sj290bdr.dgn | PLOT DATE: 18-NOV-2005 |
| IPARM FILE NAME: SJ290M22.I | |
| MAINLINE CROSS SECTIONS | |
| SHEET: 86 OF 94 | |