


Mainline 2+300

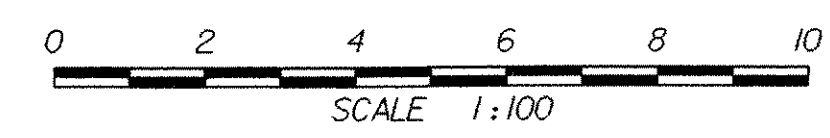

PROJECT: MENDON	PROJECT NO.: BRO 1443(35)
DESIGN FILE NAME: /str5/95j290/sj290bdr.dgn	PLOT DATE: 18-NOV-2005
IPARM FILE NAME: SJ290M24.I	
MAINLINE CROSS SECTIONS	
SHEET: 88 OF 94	