


CHANNEL 5+010 - 5+015

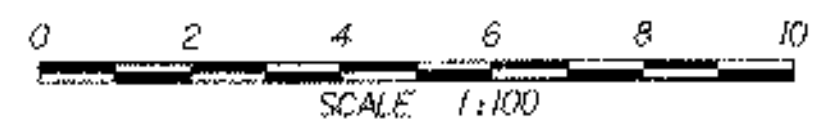

|  |                              |
|--|------------------------------|
| PROJECT:<br>MENDON                           | PROJECT NO.:<br>BRO 1443(35) |
| DESIGN FILE NAME: /str/5/95/290/ej290bdr.dgn | PLOT DATE: 18-NOV-2005       |
| IPARM FILE NAME: SJ290CH2.I                  |                              |
| CHANNEL CROSS SECTIONS                       | SHEET: 89 OF 94              |