


CHANNEL 5+030 - 5+035

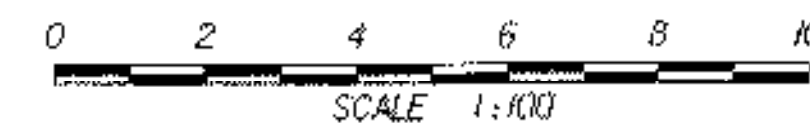

PROJECT: MENDON	PROJECT NO.: BRO 1443(35)
DESIGN FILE NAME: /s/r/5/95/290/sj290bdr.dgn	PLOT DATE: 18-NOV-2005
PARAM FILE NAME: SJ290CH4.I	
CHANNEL CROSS SECTIONS	SHEET: 91 OF 94