


CHANNEL 5+040 - 5+045

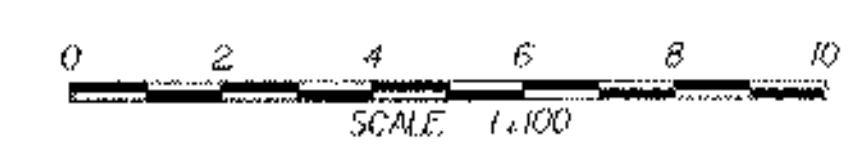

PROJECT: MENDON	PROJECT NO.: BRO 1443(35)
DESIGN FILE NAME: /str/5/95j290/sj290bdr.dgn	PLOT DATE: 18-NOV-2005
IPARM FILE NAME: SJ290CH5.i	
CHANNEL CROSS SECTIONS	SHEET: 92 OF 94