


CHANNEL 5+050 - 5+055

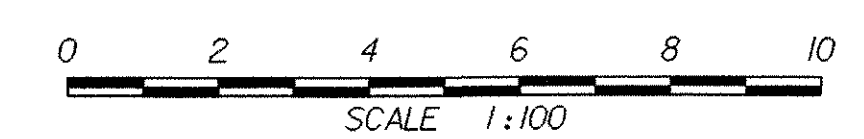

PROJECT: MENDON	PROJECT NO.: BRO 1443(35)
DESIGN FILE NAME: /str5/95j290/sj290bdr.dgn	PLOT DATE: 18-NOV-2005
IPARM FILE NAME: SJ290CH7.I	
CHANNEL CROSS SECTIONS	
SHEET: 93 OF 94	