


CHANNEL 5+060 - 5+065

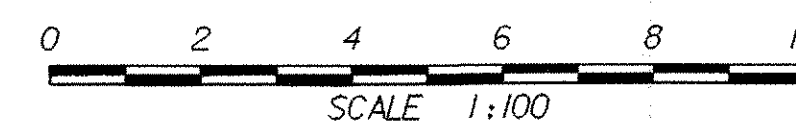

PROJECT: MENDON	PROJECT NO.: BRO 1443(35)
DESIGN FILE NAME: /s+r5/95j290/sj290bdr.dgn	PLOT DATE: 18-NOV-2005
IPARM FILE NAME: SJ290CH7.i	
CHANNEL CROSS SECTIONS	SHEET: 94 OF 94