



CAMBER DIAGRAM FOR ~ 2G2A

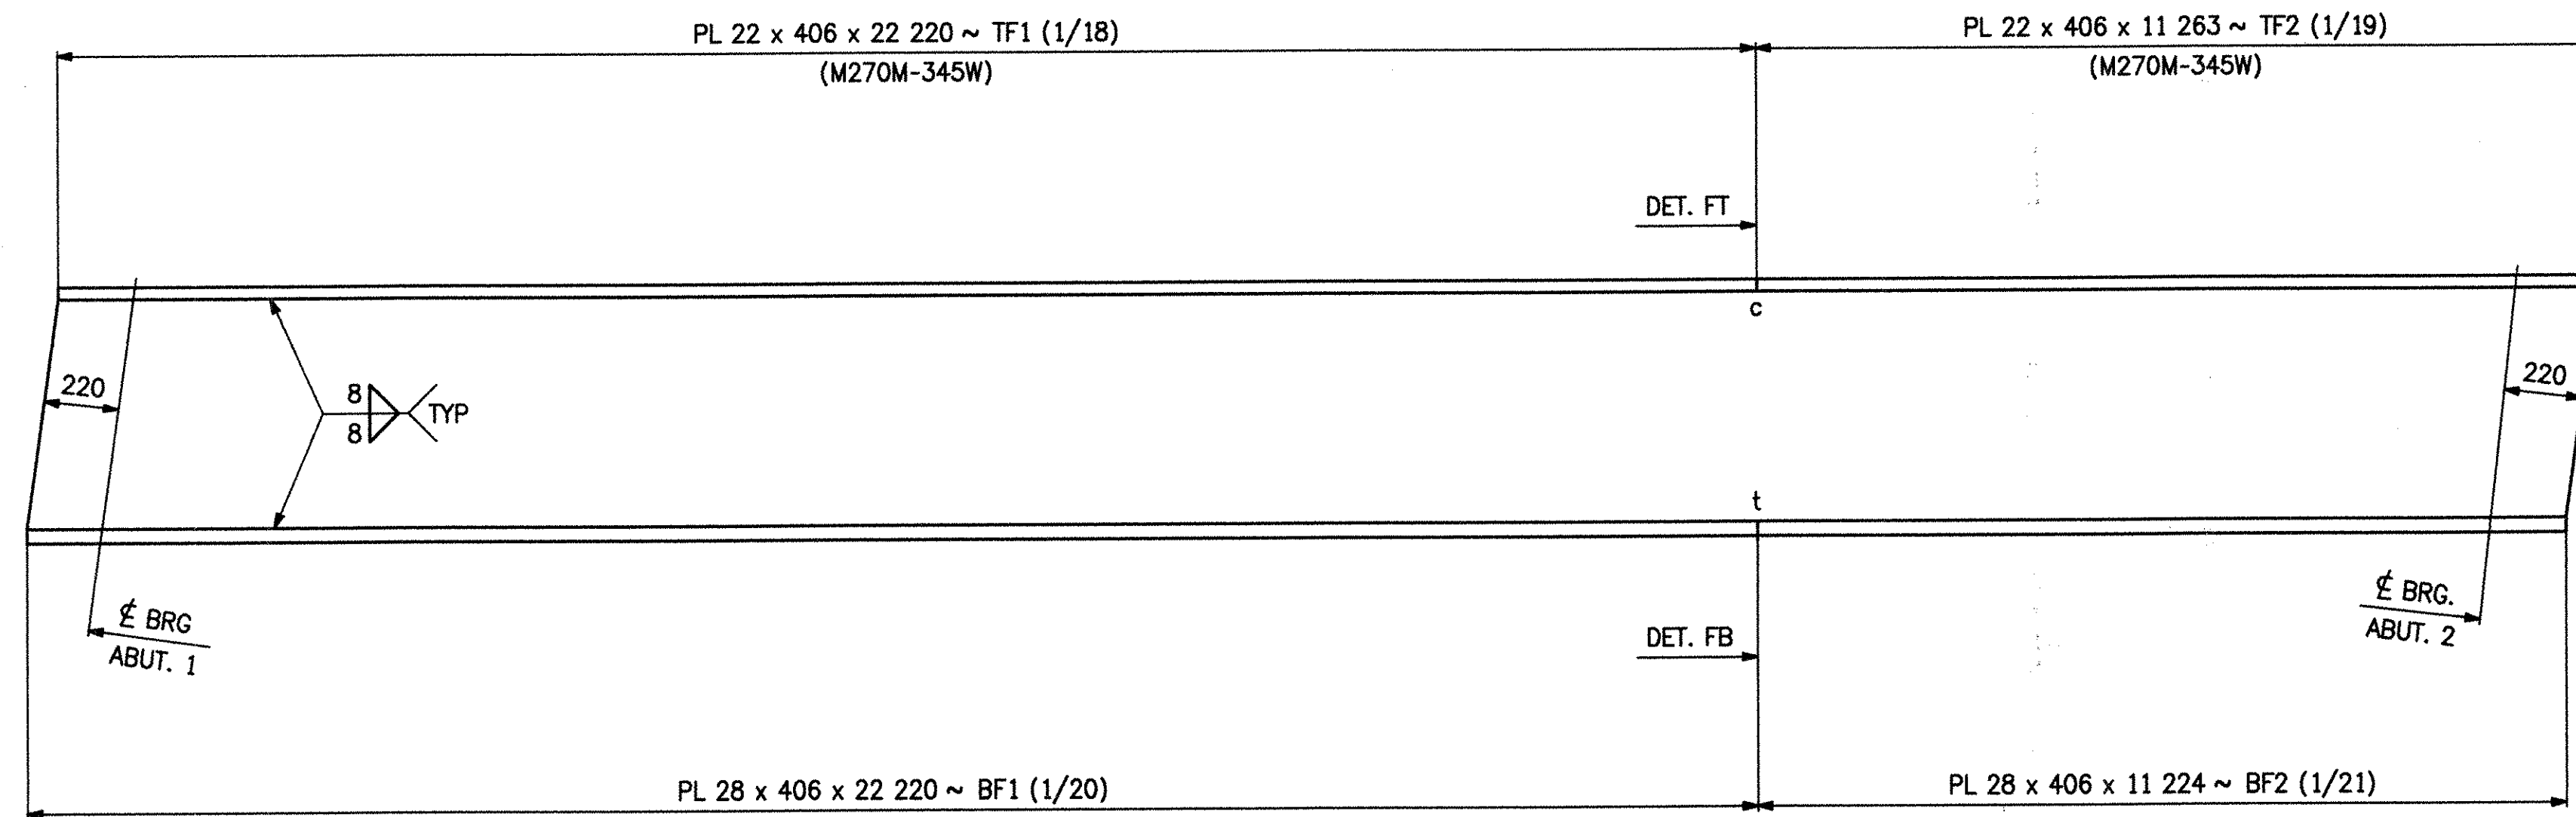

FLANGE DIAGRAM FOR ~ 2G2A

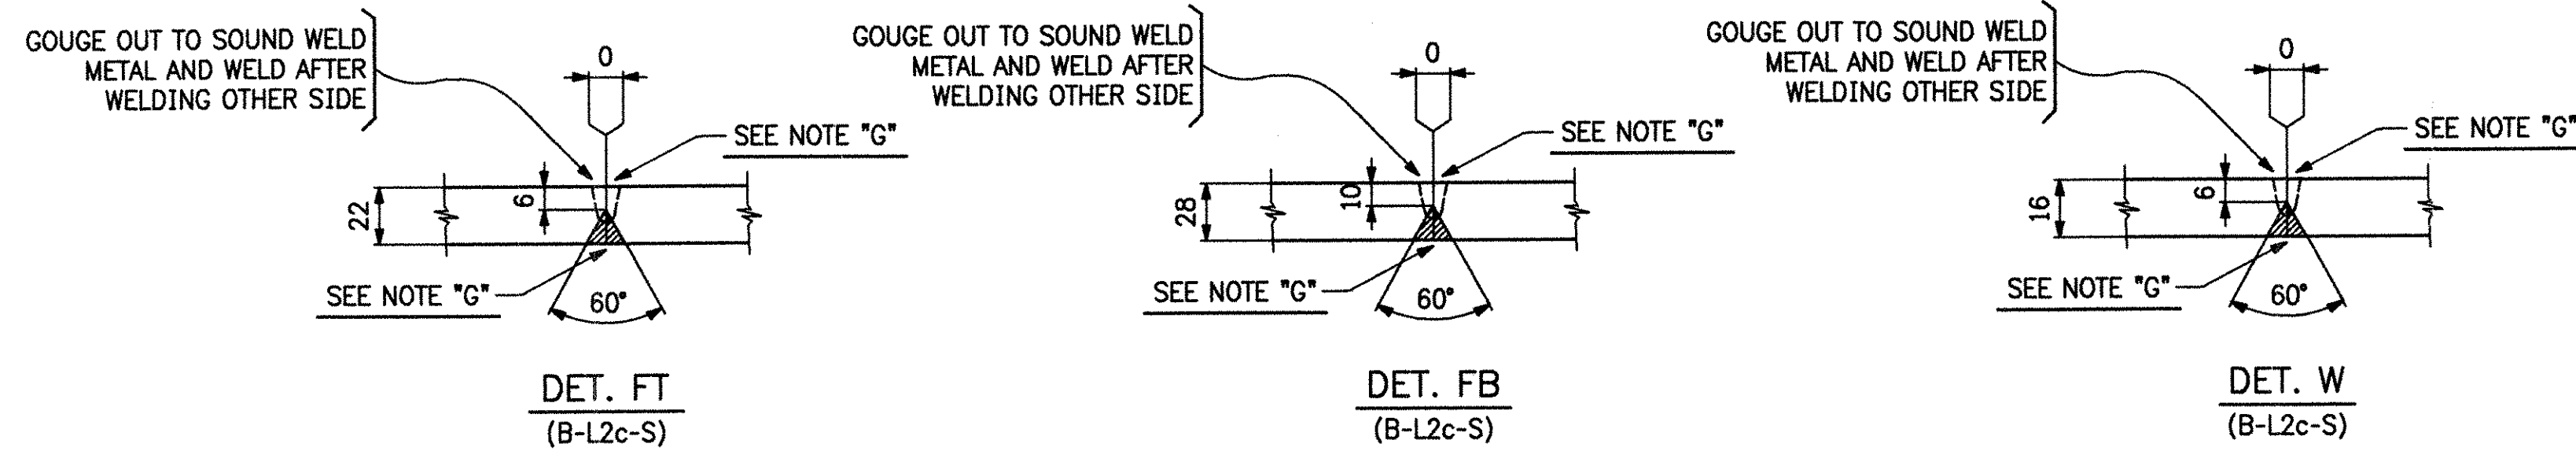

NOTE "G"

GRIND THE WELDS SMOOTH IN THE AREAS TO BE TESTED AND FOR THE FULL DEPTH OF WEB. ALL OTHER WELDS MAY HAVE A MAXIMUM REINFORCEMENT OF 3mm (1/8).

NOTES:

1. MATERIAL TO BE M270M-345WT2 (UN).
2. FOR GENERAL NOTES SEE SHT. GN1
3. THE LETTERS "t" & "c" AT FLANGE SPLICES INDICATE TENSION AND COMPRESSION SPLICES RESPECTIVELY.
4. (T) DENOTES TENSION AREA AT WEB SPLICE.

RECEIVED


CK'D BY: *WBS* CK'D BY: _____

MAY 18 2006

RESUBMIT: _____ APPROVED: _____

BY: *WFS* DATE: *6/19/06*

REV.	DATE	DESCRIPTION	QTY.	DATE	ISSUED TO	FOR

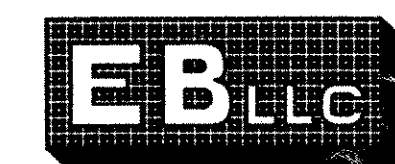

EASTERN BRIDGE LLC
RURAL RTE 2, BOX 302
CLAREMONT, NH 03743
603-542-5202

PROJECT:	T.H.1 OVER MENDON BROOK (BRIDGE NO. 3)
LOCATION:	TOWN OF MENDON, COUNTY OF RUTLAND
ENGINEER:	STATE OF VERMONT AGENCY OF TRANSPORTATION
CUSTOMER:	FRANK W WHITCOMB CONSTRUCTION
DRAWING TITLE:	WEB CAMBER & FLANGE DIAGRAMS
DRAWN BY:	MAY 4-13-06
CHECKED BY:	FM 5-1-06
JOB NUMBER:	6085
SHEET NUMBER:	WC2