
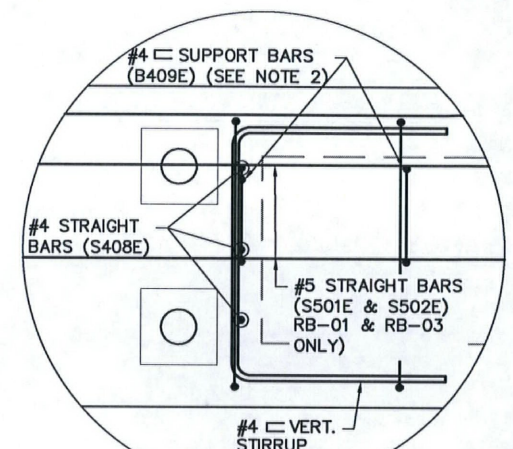


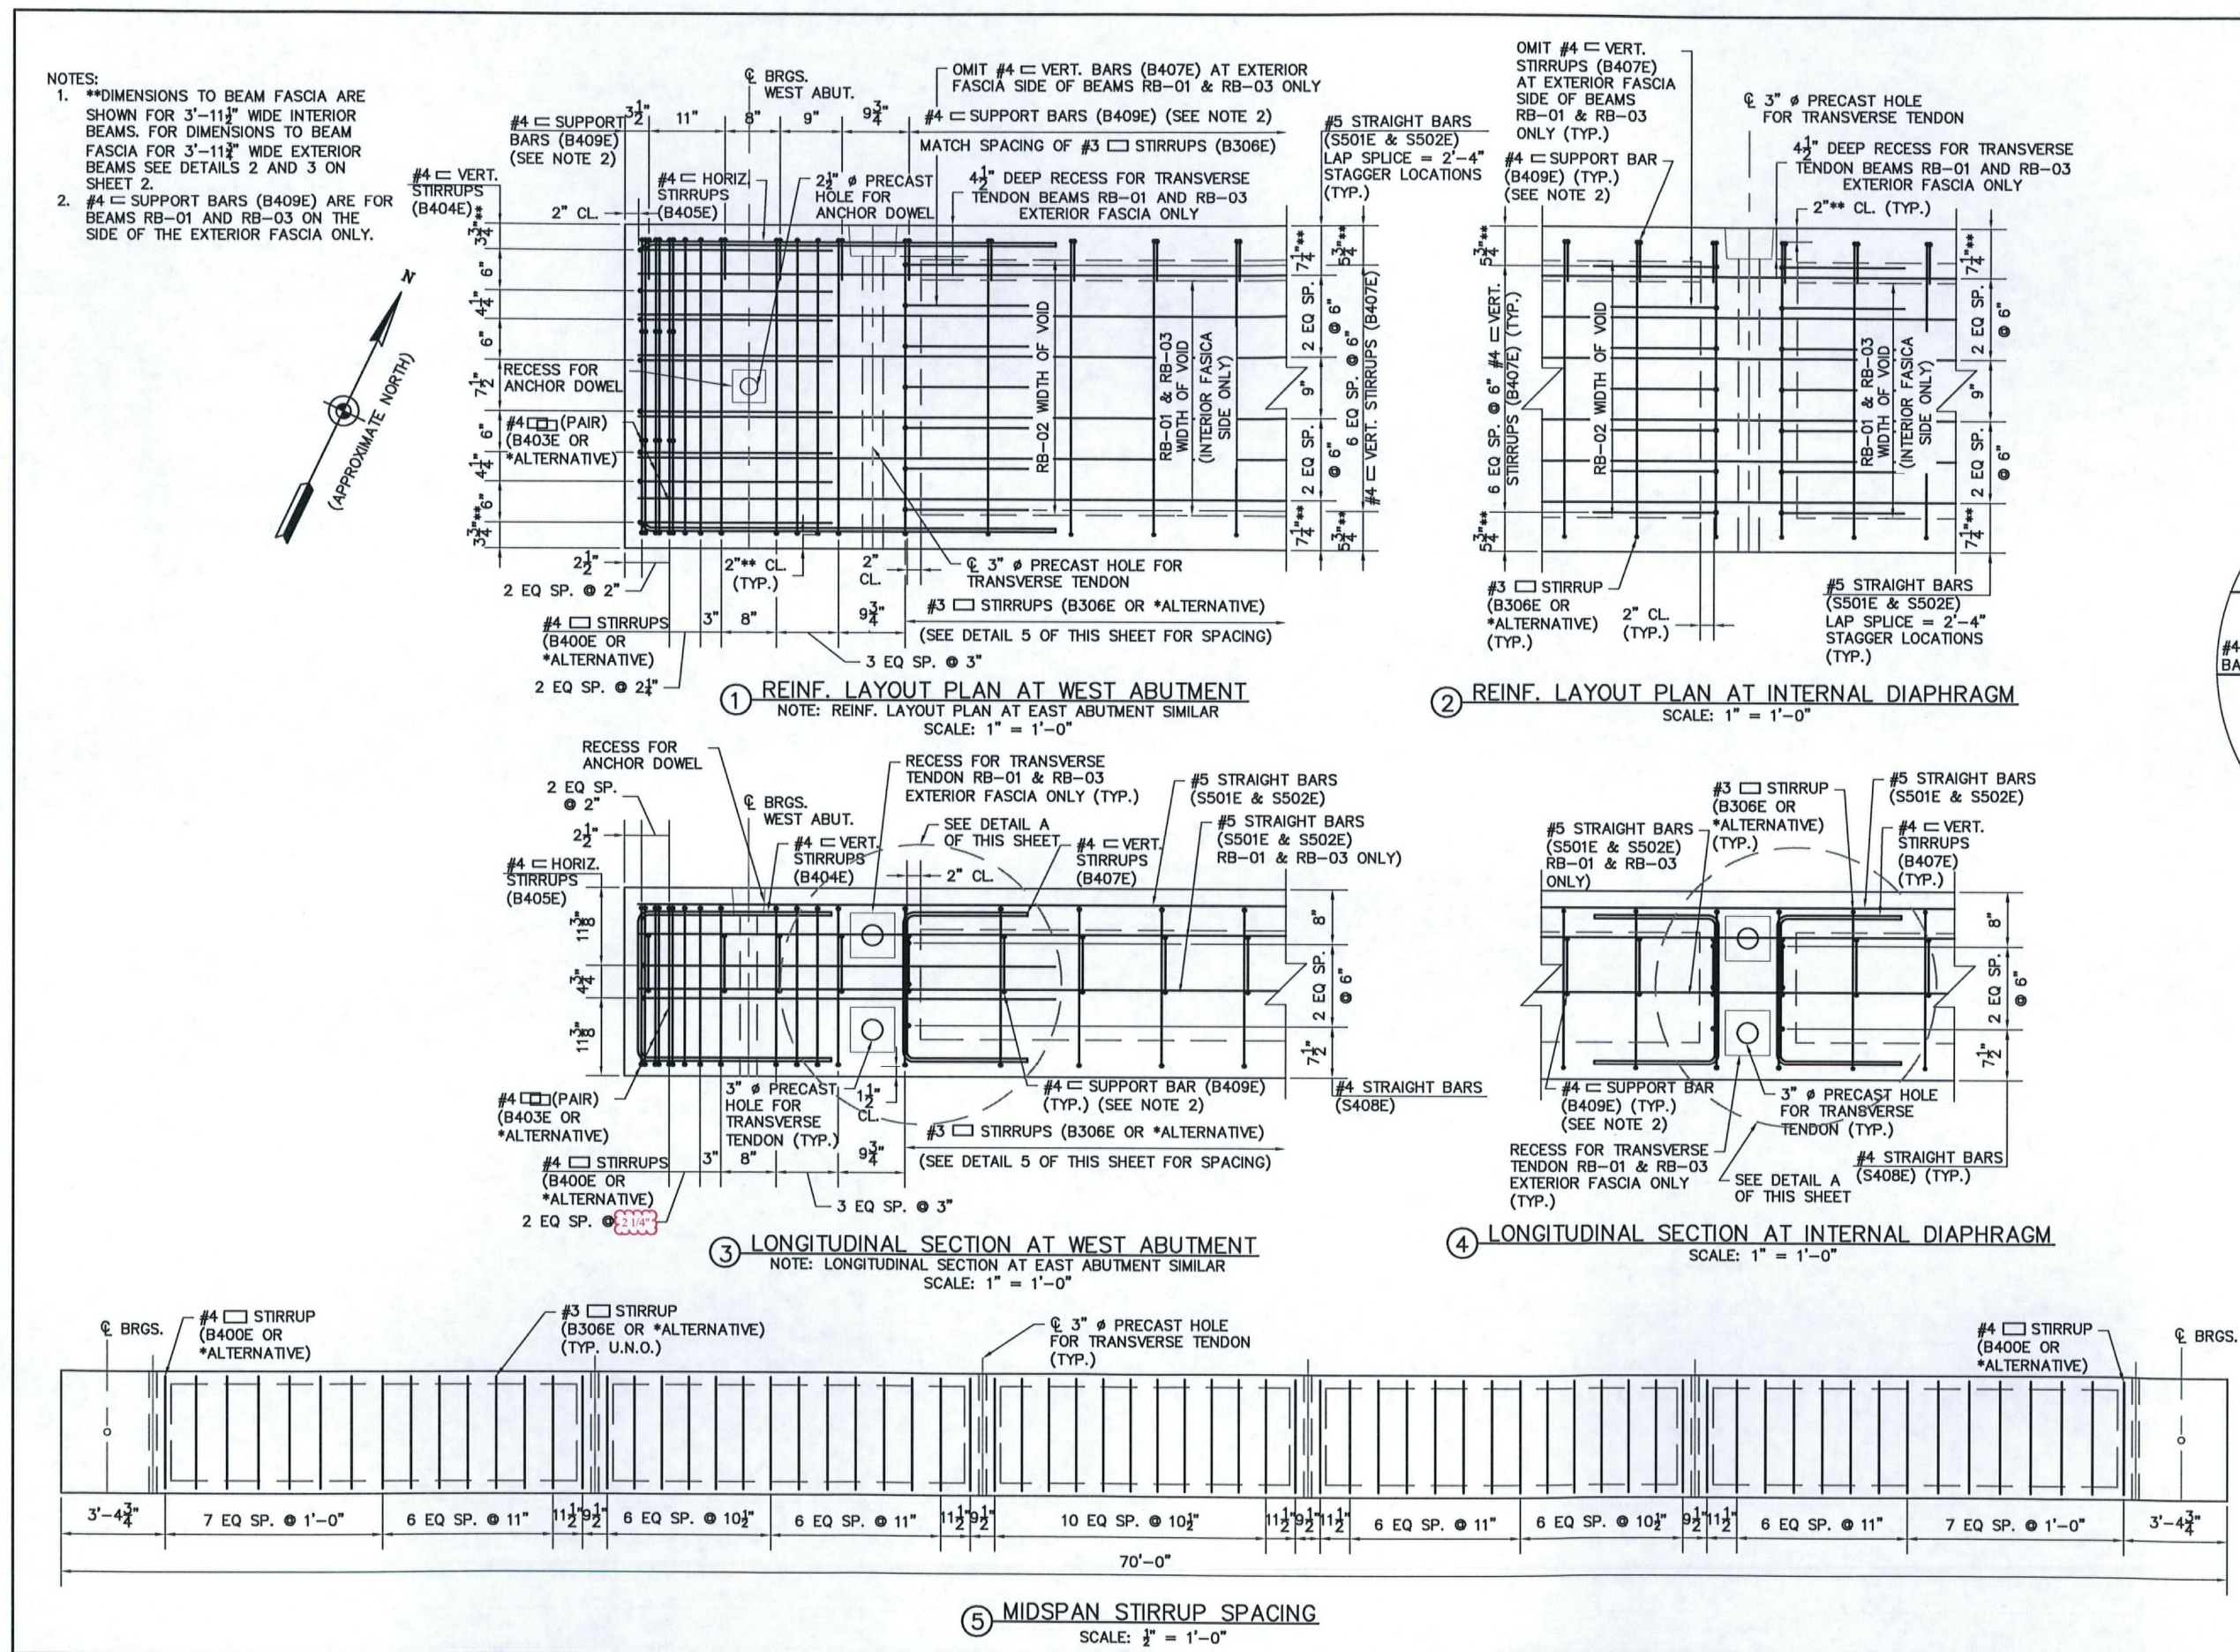

DETAIL A
SCALE: 1/2" = 1'-0"

Vermont Agency of Transportation
RECEIVED

CK'D BY: Timothy Filbach KXH

3:26 pm, Jul 21, 2010

RESUBMIT BY: KXH

APPROVED DATE: 7/23/2010

Hoyle, Tanner & Associates, Inc.

120 College Street, 4th Floor
Burlington, VT 05401
Tel: (802) 860-1331 Fax: (802) 860-8488
www.hoyletanner.com
© Copyright 2010 Hoyle, Tanner & Associates, Inc.

100% FULL REVIEW

WME DAILEY

PRECAST CONCRETE PRODUCTS

30 West Hill Street, New Bedford, MA 01905

BRAINTREE, VT

1.14 23 CLASS III

BRIDGE #12

PROJECT NO.: BRO 1444 (36)

SHEET 3 OF 5

034 Bat Beam